

 <p>شرکت کیمیا پارس خاورمیانه Middle East Kimya Pars Co.</p>	<p style="text-align: center;">HAZOP Study Review For Methanol Production Unit of MEKPC</p>	 <p>AFTAB IMEN PARTO CONSULTING ENGINEERS Ltd.</p>
July 2022	<p style="text-align: center;">Terms of Reference</p>	Page: 1

Terms of Reference Issued for HAZOP Meeting

HAZOP Study Review
For
Methanol Production Unit of MEKPC

The intent of “Terms of Reference” is only preparing team members for HAZOP Meetings.
The content of the document will be completed and elaborated in Final HAZOP Report.

Prepared by
AIPCECO
23 July 2022

The intent of “Term of Reference” is only preparing team members for HAZOP Meetings.
The content of the document will be completed and elaborated in Final HAZOP Report.

 <p>شirkat-e-kimya-i-pars-harbiyeh Middle East Kimya Pars Co.</p>	<p style="text-align: center;">HAZOP Study Review For Methanol Production Unit of MEKPC</p>	 <p>AFTAB IMEN PARTO CONSULTING ENGINEERS Ltd.</p>
July 2022	<p style="text-align: center;">Terms of Reference</p>	Page: 2

Table of Contents

1. BRIEF HAZOP PROCEDURE	3
1.1 STUDY METHOD	4
1.2. USUAL DEVIATIONS USED IN HAZOP'S.....	7
1.3. HAZOP ASSUMPTIONS	9
2. LIST OF DRAWINGS.....	12
3. LIST OF NODES	18
4. MARKED-UP P&IDS	21

 <p>شirkat-e-kimya-i-pars-harbiyan Middle East Kimya Pars Co.</p>	<p style="text-align: center;">HAZOP Study Review For Methanol Production Unit of MEKPC</p>	 <p>AFTAB IMEN PARTO CONSULTING ENGINEERS Ltd.</p>
July 2022	Terms of Reference	Page: 3

1

Brief HAZOP Procedure

The intent of “Term of Reference” is only preparing team members for HAZOP Meetings.
The content of the document will be completed and elaborated in Final HAZOP Report.

 <p>شرکت کیمیایی پارس خاورمیانه Middle East Kimya Pars Co.</p>	<p style="text-align: center;">HAZOP Study Review For Methanol Production Unit of MEKPC</p>	 <p>AFTAB IMEN PARTO CONSULTING ENGINEERS Ltd.</p>
July 2022	<p style="text-align: center;">Terms of Reference</p>	Page: 4

1.1. Study Method

The technique of Hazard and Operability studies, or in more common terms HAZOP, has been used and developed over approximately four decades for identifying potential hazards and operability problems caused by deviations from the design intent of both new and existing process plants. It is believed that HAZOP methodology is perhaps the most widely used aid to loss prevention.

Essentially, the HAZOP procedure involves taking a full description of a process and systematically questioning every part of it to establish how deviations from the design intent can arise. Once identified, an assessment is made as to whether such deviations and their consequences can have a negative effect upon the safe and efficient operation of the plant. If considered necessary, action is then recommended to be taken to remedy the situation.

This critical analysis is applied in a structured way by the HAZOP team, and it relies upon them releasing their imagination in an effort to discover credible causes of deviations.

In practice, many of the causes will be fairly obvious, such as pump failure causing a loss of circulation in a cooling water facility. However, the great advantage of the technique is that it encourages the team to consider other less obvious ways in which a deviation may occur, however unlikely they may seem at first consideration.

In this way, the study becomes much more than a mechanistic checklist-type review. The result is that there is a good chance that potential failures and problems will be identified, which had not previously been experienced in the type of plant being studied.

An essential feature in this process of questioning and systematic analysis is the use of guidewords and parameters to focus the attention of the team upon deviations and their possible causes. These are defined as follows:

Guidewords, which when combined with a parameter, suggest possible deviations.

Parameters, which focus attention upon a particular aspect of the design intent, an associated process condition or a parameter.

The entire technique of HAZOP revolves around the effective use of guidewords and parameters. So, their meaning and use must be clearly understood by the team.

 <p>شرکت کیمیایی پارس خاورمیانه Middle East Kimya Pars Co.</p>	HAZOP Study Review For Methanol Production Unit of MEKPC	 <p>AFTAB IMEN PARTO CONSULTING ENGINEERS Ltd.</p>
July 2022	Terms of Reference	Page: 5

Examples of often-used guidewords and parameters are listed below. These reflect both the process design intent and operating aspects of the plant being studied. Typical process-oriented words might be as follows.

Table 1. Process Parameters

Flow	Level
Pressure	Composition
Separation	Temperature
Reaction	Corrosion
Purity	Ph

The above list is purely illustrative, as the words employed in a review will depend upon the plant being studied. Added to the above might be relevant operating words such as:

Isolate	Drain	Start-up
Vent	Purge	Shutdown
Inspect	Maintain	

As mentioned above, certain guidewords are applied to the parameters to suggest potential deviations or problems. They tend to be a standard set, as listed below:

Table 2. HAZOP Guidewords

Guideword	Meaning
No	The design intent does not occur (e.g., Flow/No), or the operating aspect is not achievable (Isolate/No)
Less	A quantitative decrease in the design intent occurs (e.g., Pressure/Less)

 <p>شرکت کیمیایی پارس خاورمیانه Middle East Kimya Pars Co.</p>	HAZOP Study Review For Methanol Production Unit of MEKPC	 <p>AFTAB IMEN PARTO CONSULTING ENGINEERS Ltd.</p>
July 2022	Terms of Reference	Page: 6

More	A quantitative increase in the design intent occurs (e.g., Temperature/More)
Reverse	The opposite of the design intent occurs (e.g., Flow/Reverse)
As well as	The design intent is completely fulfilled, but in addition some other related activity occurs (e.g., Flow/As well as indicating contamination in a product stream)
Other than	The activity occurs, but not in the way intended (e.g., Flow/Other than could indicate a leak or product flowing where it should not, or Composition/Other than might suggest unexpected proportions in a feedstock)

In simple terms, the HAZOP study process involves applying in a systematic way all relevant deviations to the plant in question in an effort to uncover potential problems.

The deviations are applied to plants section by section to provide the necessary focus by limiting the scope of study to a certain part of the plant or unit in question each time. Each of these sections is called a ‘Node.’

The results of the study are recorded in tabular format under the following headings:

Node:			
Deviation:			
Causes	Consequences	Safeguards	Recommendations

A summarized description of these column headings follows:

Deviations:

The keyword combination being applied, e.g., No Flow. A list of usual deviations used in HAZOP studies is given in section 4.

Causes:

Potential causes that would result in the deviation occurring. There are some assumptions for causes:

Filters obstruction is not considered as a cause for No/Less Flow deviation.

For any deviations, it is supposed that bypass line of control valves is always open.

 <p>شرکت کیمیایی پارس خاورمیانه Middle East Kimya Pars Co.</p>	HAZOP Study Review For Methanol Production Unit of MEKPC	 <p>AFTAB IMEN PARTO CONSULTING ENGINEERS Ltd.</p>
July 2022	Terms of Reference	Page: 7

Failures in independent safety systems such as ESD and interlocks are not considered as causes.

Control valves and similar devices usually have known and assigned failure modes for power failure and/or instrument air failure. However, they may also fail mechanically, sometimes in the opposite direction of their known and designated failure modes.

Consequences:

The consequences that may arise from the effect of the deviation or if appropriate, from the cause itself.

Safeguards:

Any existing protective devices that either prevent the cause or safeguard against the adverse consequences would be recorded in this column. Safeguards need not be restricted to hardware. Where appropriate, credit can be taken for procedural aspects such as regular plant inspections.

Recommendations:

Where a credible cause results in a negative consequence, it must be decided whether some action should be taken. It is at this stage that consequences and associated safeguards are considered. If it is deemed that the protective measures are adequate, then no action need be taken, and words to that effect are recorded in the column.

1.2. Usual Deviations Used in HAZOP's

Deviations	Guide Word	Parameter
No/Less Flow	No/Less	Flow
More Flow	More	Flow
Reverse/Misdirected Flow	Reverse/Misdirected	Flow
Rupture	Other than	Flow
Leakage	As well as	Flow
High Temperature	High	Temperature
Low Temperature	Low	Temperature
High Discharge Pressure	High	Pressure
High Pressure	High	Pressure

July 2022

Terms of Reference

Page: 8

Deviations	Guide Word	Parameter
High Suction Pressure	High	Pressure
Low Pressure	Low	Pressure
Low Suction Pressure	Low	Pressure
High Level	High	Level
High/Excess Interface Level	High	Interface Level
High Interface Level	High	Interface Level
Low Interface Level	Low	Interface Level
Low/Reduced Interface Level	Low	Interface Level
High Bottoms Level	High	Level
Low Bottoms Level	Low	Level
Low Level	Low	Level
Low Tray Level	Low	Level
More/Excess Cooling	More	Cool
No/Less Cooling	Less	Cool
Corrosion Hazard	Other than	Corrosion
Fouling formation	Other than	Fouling
More/Excess Heating	More	Heat
More Fire/Explosion Risk	More	Heat
No/Less Heating	Less	Heat
High/Low heat value	High/Low	Heat Value
More Load on Structures	More	Load on Structures
More Load on Flare System	More	Load to Flare
Cavitations	As well as	Performance
Column Flooding/Foaming	Part of	Performance
Loss of Performance	Other than	Performance
High/Low pH	High/Low	pH
Extra phase/Phase missing	As well as/Part of	Phases
Impurities Present	As well as	Purity
Catalyst deactivated/inhibited	As well as	Purity

 <p>شرکت کیمیایی پارس خاورمیانه Middle East Kimya Pars Co.</p>	HAZOP Study Review For Methanol Production Unit of MEKPC	 <p>AFTAB IMEN PARTO CONSULTING ENGINEERS Ltd.</p>
July 2022	Terms of Reference	Page: 9

Deviations	Guide Word	Parameter
High Reaction Rate	More	Reaction
Low Reaction Rate	Less	Reaction
Too much/Too fast Reaction	Other than	Reaction
Too little/Too slow Reaction	Other than	Reaction
Start-up/Shutdown hazards	Other than	Start-up/Shutdown
High Agitation/Recirculation	High	Agitation
Low Agitation/Recirculation	Low	Agitation
No/Less Component Separation	Less	Component Separation
Contaminants	As well as	Composition
Contaminants Enter Compressor	As well as	Composition
Contamination	As well as	Composition
High Concentration of Impurities	As well as	Composition
High Contaminants	As well as	Composition
Start-up/Shutdown Hazards	Other than	Start-up/Shutdown
Failure of service	Other than	Utility
High vibration	High	Vibration
Isolation Problem	Other than	Maintenance
Purging Problem	Other than	Maintenance
Evacuation Problem	Other than	Maintenance
Maintenance Hazards	Other than	Maintenance

1.3. HAZOP Assumptions

The following assumptions are usually taken into consideration during HAZOP studies. Following the usual practice of HAZOP studies and to the best of leader experience, these assumptions facilitate the study and help the team avoid unnecessary duplication of items to study, if applicable:

1. Plant will be operated at or below design rates.
2. The facility will be operated and maintained by qualified, experienced personnel using appropriate operating and maintenance procedures that will be written (or updated) to reflect current design prior to commissioning.

The intent of “Term of Reference” is only preparing team members for HAZOP Meetings.
The content of the document will be completed and elaborated in Final HAZOP Report.

 <p>شرکت کیمیایی پارس خاورمیانه Middle East Kimya Pars Co.</p>	HAZOP Study Review For Methanol Production Unit of MEKPC	 <p>AFTAB IMEN PARTO CONSULTING ENGINEERS Ltd.</p>
July 2022	Terms of Reference	Page: 10

3. Process chemistry is understood and plant model (heat & mass balance) are accurate.
4. Control valves are assumed to operate only in automatic rather than manual mode. Control valves that are operated manually, if any, are reviewed during the study and changing their operation mode from manual to automatic is discussed.
5. Control valves and similar devices usually have known and assigned failure modes for power failure and/or instrument air failure. However, they may also fail mechanically, sometimes in the opposite direction of their known and designated failure modes.
6. All drain and bleed valves are plugged or capped on their open ends. Thus, drains or vent valves will not normally be considered a potential hazard source except in special cases.
7. Simultaneous failure of several equipment items will not be considered. Actually, the probability of such a circumstance is usually very low.
8. Failure of a safeguard will not be considered as a cause of a deviation. The only exception is that when the team realizes the weaknesses of the design, in which case improvement options will be discussed and recorded.
9. In cases where the expression "same as above" appears under Consequences and safeguards column is empty, it means that all consequences of the previous cause (and only that cause) and related safeguards are valid for the case.
10. Whenever the same expression "same as above" is given in Consequences column but not in Safeguards column, any listed safeguards are assumed to be the only ones relevant to the case, although the consequences were the same.
11. Opening of PSV's or bleeding valves is a consequence of overpressure, so it will not be considered as a cause of 'Less Pressure' or 'Misdirected Flow'.
12. Incorrect set point will lead to consequences such as control system failure. So, it will not be considered as an independent cause.
13. Erroneous opening of two valves in series or valves with poor access is considered to be rare cases and will not be considered in the study.

 <p>شرکت کیمیا پارس خاورمیانه Middle East Kimya Pars Co.</p>	<p style="text-align: center;">HAZOP Study Review For Methanol Production Unit of MEKPC</p>	 <p>AFTAB IMEN PARTO CONSULTING ENGINEERS Ltd.</p>
July 2022	<p style="text-align: center;">Terms of Reference</p>	Page: 11

14. Error in opening of all lines and connections that are shown blank-off in P&ID's during normal operation will not be considered in the HAZOP study.
15. The inadvertent Opening/ Closing of a LC/LO/CSC/CSO valves will not be considered because administrative controls are considered adequate safeguard to prevent this situation.
16. Relief valves will not be blocked and removed from service during plant operations unless plant will be designed to allow servicing of relief devices while plant is operating.
17. In new plants where advanced control technologies are employed, enough safeguards are usually present in the form of automatic control systems, secondary safety barriers (like NRV's and PSV's), the ESD system itself, alarms and interlocks. So, local instruments will not generally be considered as safeguards, except for those cases where the operator has enough time to check without being exposed to high risk and the device is effective enough to show the deviation precisely.
18. Line rupture or major leak is not considered a cause of flow reduction, although actually they can. The reason is that possible fire or explosion as a result of such events is far more important than a simple low flow.
19. Wherever the expression "See relevant node" is used it means the reader of the document to refer to the corresponding node for detail causes, consequences and safeguards if applicable.

 <p>شirkat-e-kimya-i-pars-harbiyan Middle East Kimya Pars Co.</p>	<p style="text-align: center;">HAZOP Study Review For Methanol Production Unit of MEKPC</p>	 <p>AFTAB IMEN PARTO CONSULTING ENGINEERS Ltd.</p>
July 2022	<p style="text-align: center;">Terms of Reference</p>	Page: 12

2

List of Drawings

The intent of “Term of Reference” is only preparing team members for HAZOP Meetings.
The content of the document will be completed and elaborated in Final HAZOP Report.



**HAZOP Study Review
For
Methanol Production Unit of MEKPC**



July 2022

Terms of Reference

Page: 13

Drawing	Rev.	Title	Place(s) Used [Nodes]
MKP-11-AS-9000-PR-PID-001	Z01	Symbols and Identifications for Piping and Instrument Diagram (1)	
MKP-11-AS-9000-PR-PID-002	Z01	Symbols and Identifications for Piping and Instrument Diagram (2)	
MKP-11-AS-9000-PR-PID-003	Z01	Symbols and Identifications for Piping and Instrument Diagram (3)	
MKP-11-AS-1000-PR-PID-001	Z01	Gas Station	1
MKP-11-AS-1000-PR-PID-002	Z01	Natural Gas Distribution	1
MKP-11-AS-1000-PR-PID-003	Z01	Desulphurisation	2
MKP-11-AS-6000-PR-PID-001	Z01	Steam Condensate Return	3
MKP-11-AS-6000-PR-PID-002	Z01	NG Saturation I	3
MKP-11-AS-6000-PR-PID-003	Z01	NG Saturation II	3
MKP-11-AS-6000-PR-PID-004	Z01	NG Saturation III	3, 4
MKP-11-AS-2000-PR-PID-001	Z01	Process Oxygen	7
MKP-11-AS-2000-PR-PID-002	Z01	Oxygen Preheating	7
MKP-11-AS-2000-PR-PID-003	Z01	S/C Ratio Control I	5
MKP-11-AS-2000-PR-PID-004	Z01	S/C Ratio Control II	5
MKP-11-AS-2000-PR-PID-005	Z01	Flue Gas WHS I	9, 10
MKP-11-AS-2000-PR-PID-006	Z01	Flue Gas WHS II	2, 9, 11, 12
MKP-11-AS-2000-PR-PID-007	Z01	Flue Gas WHS III	2, 5, 6, 11
MKP-11-AS-2000-PR-PID-008	Z01	Prereforming	5
MKP-11-AS-2000-PR-PID-009	Z01	Tubular Reformer	6, 8, 9, 11
MKP-11-AS-2000-PR-PID-010	Z01	Secondary Reformer	7
MKP-11-AS-2000-PR-PID-011	Z01	Secondary Reformer II	13, 14
MKP-11-AS-2000-PR-PID-012	Z01	Steam Superheater	13, 14
MKP-11-AS-2000-PR-PID-013	Z01	Steam Generation	14
MKP-11-AS-2000-PR-PID-014	Z01	Gas Cooling and Separation I	13, 14
MKP-11-AS-2000-PR-PID-015	Z01	Gas Cooling and Separation II	17
MKP-11-AS-2000-PR-PID-016	Z01	Gas Cooling and Separation III	17
MKP-11-AS-2000-PR-PID-017	Z01	Fuel System	8
MKP-11-AS-2000-PR-PID-018	Z01	Start-Up Blower	18
MKP-11-AS-2000-PR-PID-019	Z01	H2 Recycle System	19
MKP-11-AS-2000-PR-PID-020	Z01	Air Cooler AE 2026 Detail	17
MKP-11-AS-3000-PR-PID-001	Z01	Synthesis Gas Compressor	
MKP-11-AS-3000-PR-PID-002	Z01	Synthesis Part I	
MKP-11-AS-3000-PR-PID-003	Z01	Methanol Synthesis	
MKP-11-AS-3000-PR-PID-004	Z01	Methanol R/E Exchanger	
MKP-11-AS-3000-PR-PID-005	Z01	Synthesis Gas Cooling	
MKP-11-AS-3000-PR-PID-006	Z01	Synthesis Part II	
MKP-11-AS-3000-PR-PID-007	Z01	Raw Product Flash	
MKP-11-AS-3000-PR-PID-008	Z01	Air Cooler AE 3002 Detail 1/2/3 Detail	
MKP-11-AS-3000-PR-PID-027	Z01	Synthesis Gas Compressor Package	
MKP-11-AS-3000-SF-PID-001	Z01	Sprinkler System in Unit 3000	
MKP-11-AS-4000-PR-PID-001	Z01	Methanol Tanks (1)	
MKP-11-AS-4000-PR-PID-002	Z01	Methanol Tanks (2)	
MKP-11-AS-4000-SF-PID-001	Z01	Foam System in Unit 4000	

The intent of “Term of Reference” is only preparing team members for HAZOP Meetings.
The content of the document will be completed and elaborated in Final HAZOP Report.



**HAZOP Study Review
For
Methanol Production Unit of MEKPC**



July 2022

Terms of Reference

Page: 14

Drawing	Rev.	Title	Place(s) Used [Nodes]
MKP-11-AS-4000-SF-PID-002	Z01	Sprinkler System in Unit 4000	
MKP-11-AS-4000-SF-PID-003	Z01	Sprinkler System for Pumps in Unit 4000	
MKP-11-AS-5000-PR-PID-001	Z01	Crude Methanol Tank	
MKP-11-AS-5000-PR-PID-002	Z01	Stabilizer Column	
MKP-11-AS-5000-PR-PID-003	Z01	Stabilizer Column Reboiler	
MKP-11-AS-5000-PR-PID-004	Z01	Stabilizer Column OH System	
MKP-11-AS-5000-PR-PID-005	Z01	Stabilizer Column Pumps	
MKP-11-AS-5000-PR-PID-006	Z01	LP Methanol Column	
MKP-11-AS-5000-PR-PID-007	Z01	LP Methanol Column Reboiler	
MKP-11-AS-5000-PR-PID-008	Z01	LP Methanol Column OH System	
MKP-11-AS-5000-PR-PID-009	Z01	MP Methanol Column Feed Pump	
MKP-11-AS-5000-PR-PID-010	Z01	MP Methanol Column	
MKP-11-AS-5000-PR-PID-011	Z01	MP Column Reboilers	
MKP-11-AS-5000-PR-PID-012	Z01	MP Methanol Column OH System	
MKP-11-AS-5000-PR-PID-013	Z01	MP Methanol Column by Product	
MKP-11-AS-5000-PR-PID-014	Z01	Methanol Product	
MKP-11-AS-5000-PR-PID-015	Z01	Methanol Product Buffer Tank I	
MKP-11-AS-5000-PR-PID-016	Z01	Methanol Product Buffer Tank II	
MKP-11-AS-5000-PR-PID-017	Z01	Liquid Off-Stream Tank	
MKP-11-AS-5000-PR-PID-018	Z01	Closed Drain Collection	
MKP-11-AS-5000-PR-PID-019	Z01	Slops Collection	
MKP-11-AS-5000-PR-PID-020	Z01	NaOH Dosing Unit X 5003 Utility Diagram	
MKP-11-DE-5000-PR-PID-023	Z01	Air Cooler AE 5005 Detail Part 1	
MKP-11-AS-5000-PR-PID-023	Z01	Air Cooler AE 5005 Detail Part 2	
MKP-11-AS-5000-PR-PID-023	Z01	Air Cooler AE 5005 Detail Part 3	
MKP-11-AS-5000-PR-PID-023	Z01	Air Cooler AE 5005 Detail Part 4	
MKP-11-AS-5000-PR-PID-024	Z01	Air Cooler AE 5004 Detail	
MKP-11-AS-5000-PR-PID-026	Z01	Air Cooler AE 5006 Detail	
MKP-11-AS-5000-SF-PID-001	Z01	Foam System in Unit 5000	
MKP-11-AS-5000-SF-PID-002	Z01	Sprinkler System in Unit 5000	
MKP-11-AS-5000-SF-PID-002	Z01	Sprinkler System in Unit 5000	
MKP-11-AS-5000-SF-PID-003	Z01	Sprinkler System for Pumps in Unit 5003	
MKP-11-AS-5000-SF-PID-004	Z01	Sprinkler System for Pumps in Unit 5001	
MKP-11-AS-7000-PR-PID-006	Z01	HHP-HP Steam Control System	
MKP-11-AS-7000-PR-PID-007	Z01	HP Steam Export/ Import	
MKP-11-AS-7000-PR-PID-008	Z01	MP & LP Steam Control System	
MKP-11-AS-7000-PR-PID-009	Z01	LP Steam Control	
MKP-11-AS-7000-PR-PID-010	Z01	HHP & HP Steam Header	

The intent of “Term of Reference” is only preparing team members for HAZOP Meetings.
The content of the document will be completed and elaborated in Final HAZOP Report.



**HAZOP Study Review
For
Methanol Production Unit of MEKPC**



July 2022

Terms of Reference

Page: 15

Drawing	Rev.	Title	Place(s) Used [Nodes]
MKP-11-AS-7000-PR-PID-011	Z01	LP Steam Header	
MKP-11-AS-7000-PR-PID-012	Z01	Deaerator	
MKP-11-AS-7000-PR-PID-013	Z01	BFW Pumps	
MKP-11-AS-7000-PR-PID-014	Z01	BFW Header	
MKP-11-AS-7000-PR-PID-015	Z01	Process Condensate Storage	
MKP-11-AS-7000-PR-PID-016	Z01	Cooling Water Header I Utility Diagram	
MKP-11-AS-7000-PR-PID-017	Z01	Nitrogen Header Utility Diagram	
MKP-11-AS-7000-PR-PID-018	Z01	Plant Air Header Utility Diagram	
MKP-11-AS-7000-PR-PID-019	Z01	Instrument Air Header Utility Diagram	
MKP-11-AS-7000-PR-PID-020	Z01	Demineralized Header Utility Diagram	
MKP-11-AS-7000-PR-PID-021	Z01	Service Water Header Utility Diagram	
MKP-11-AS-7000-PR-PID-022	Z01	Potable Water Header Utility Diagram	
MKP-11-AS-7000-PR-PID-023	Z01	Phosphate Dosing Unit-X 7001 Utility Diagram	
MKP-11-AS-7000-PR-PID-024	Z01	Amonia Dosing Unit-X 7002 Utility Diagram	
MKP-11-AS-7000-PR-PID-025	Z01	Oxygen Scav.Dosing Unit-X 7003 Utility Diagram	
MKP-11-AS-7000-PR-PID-026	Z01	Boiler Blow Down Utility Diagram	
MKP-11-AS-7000-PR-PID-027	Z01	Steam Condensate Recovery Unit	
MKP-11-AS-7000-PR-PID-028	Z01	P7001 A/B BFW Pump	
MKP-11-AS-7000-PR-PID-029	Z01	P7001 C BFW Pump	
MKP-11-AS-7000-PR-PID-030	Z01	Cooling Water Header II Utility Diagram	
MKP-11-AS-7000-PR-PID-031	Z01	Cooling Water Header III Utility Diagram	
MKP-11-AS-7000-PR-PID-032	Z01	Hose Station System I Utility Diagram	
MKP-11-AS-7000-PR-PID-033	Z01	Hose Station System II Utility Diagram	
MKP-11-AS-8000-PR-PID-001	Z01	Pipe Rack and Pipe Net System	
MKP-11-AS-8500-PR-PID-001	Z01	Utility Distribution Diagram Flare Header I	
MKP-11-AS-8500-PR-PID-002	Z01	Utility Distribution Diagram Flare Header II	
MKP-11-AS-8500-PR-PID-003	Z01	Flare K.O Drum	
MKP-11-AS-8500-PR-PID-004	Z01	Flare Stack I	
MKP-11-AS-8500-PR-PID-005	Z01	Flare Stack II	
MKP-11-AS-9400-PR-PID-002	Z01	POC	
MKP-11-AS-9400-PR-PID-003	Z01	Sanitary Wastewater	
MKP-11-AS-0201-SF-PID-001	Z01	Gas Fire Extinguishing System In Unit 0201	
MKP-11-AS-0202-SF-PID-001	Z01	Gas Fire Extinguishing System In Unit 0202	
MKP-11-AS-0300-SF-PID-001	Z01	Foam Station	
MKP-11-AS-0500-PR-PID-001	Z01	Cooling Water Tower	
MKP-11-AS-0500-PR-PID-002	Z01	Cooling Water Turbine Pump 1	
MKP-11-AS-0500-PR-PID-003	Z01	Cooling Water Turbine Pump 2	
MKP-11-AS-0500-PR-PID-004	Z01	Cooling Water Pump	

The intent of “Term of Reference” is only preparing team members for HAZOP Meetings.
The content of the document will be completed and elaborated in Final HAZOP Report.



**HAZOP Study Review
For
Methanol Production Unit of MEKPC**



July 2022

Terms of Reference

Page: 16

Drawing	Rev.	Title	Place(s) Used [Nodes]
MKP-11-AS-0500-PR-PID-005	Z01	Cooling Water Filter	
MKP-11-AS-0500-PR-PID-006	Z01	Chemical Dosing Unit	
MKP-11-DE-7200-PR-PID-001	C1	Filter and Heat Exchanger	
MKP-11-DE-7200-PR-PID-002	C1	Mixed-Ion Exchanger	
MKP-11-DE-7200-PR-PID-003	C1	DMW Storage and Feeding	
MKP-11-DE-7200-PR-PID-004	C1	Acid and Alkali Regeneration	
MKP-11-DE-7200-PR-PID-005	C1	Neutralization	
MKP-VD-9000-301-002-A1-G (1 of 14)	G	Cover Sheet	
SOK0880159 (2 of 14)	6	Symbols and Legend	
SOK0880159 (3 of 14)	6	General Notes	
SOK0880159 (4 of 14)	6	Connection List	
SOK0880159 (5 of 14)	6	Lube Oil Console System	
SOK0880159 (6 of 14)	6	Lube Oil Machine System	
SOK0880159 (7 of 14)	6	Control Oil System	
SOK0880159 (8 of 14)	6	Steam System (Condensing)	
SOK0880159 (9 of 14)	6	Steam Condensing System	
SOK0880159 (10 of 14)	6	BCL606/N Seal Gas System	
SOK0880159 (11 of 14)	6	BCL606/N Seal Gas Treatment System	
SOK0880159 (12 of 14)	6	2BCL606/N Seal Gas System	
SOK0880159 (13 of 14)	6	2BCL606/N Seal Gas Treatment System	
SOK0880159 (14 of 14)	6	Casing Seals Monitoring System	
MKP-VD-9000-301-066-A1-0 (1 of 7)	0	Syngas & Recycle Gas Compression	
SOK0887013 (1 of 7)	5	Syngas & Recycle Gas	
SOK0887013 (2 of 7)	5	Syngas & Recycle Gas Compression	
SOK0887013 (3 of 7)	5	Syngas & Recycle Gas Compression	
SOK0887013 (4 of 7)	5	Syngas & Recycle Gas Compression	
SOK0887013 (5 of 7)	5	Syngas & Recycle Gas Compression	
SOK0887013 (6 of 7)	5	Syngas & Recycle Gas Compression	
SOK0887013 (7 of 7)	5	Syngas & Recycle Gas Compression	
MKP-VD-9000-308-049-A4-0	0	Dry Gas Seal System	
MKP-VD-9000-308-053-A4-0	0	Lube Oil System	
MKP-VD-9000-308-060-A4-0	0	Process Gas System	
MKP-VD-9000-306-003-A1	0	C 2002_H2 Recycle Compressor Purge Gas	
MKP-VD-9000-306-004-A1	0	C 2002_H2 Recycle Compressor Process Gas System	
MKP-VD-9000-306-005-A1	0	C 2002_H2 Recycle Compressor Cooling Water System	
MKP-VD-9000-306-006-A1	0	C 2002_H2 Recycle Compressor Unloading Control System	
MKP-VD-9000-306-007-A1	0	C 2002_H2 Recycle Compressor Lube Oil System	
MKP-VD-9000-303-150-A3	2	P7001AB_BFW_PUMP	

The intent of “Term of Reference” is only preparing team members for HAZOP Meetings.
The content of the document will be completed and elaborated in Final HAZOP Report.



شرکت کیمیایی پارس خاورمیانه
Middle East Kimya Pars Co.

HAZOP Study Review
For
Methanol Production Unit of MEKPC



July 2022

Terms of Reference

Page: 17

Drawing	Rev.	Title	Place(s) Used [Nodes]
MKP-VD-9000-303-155-A3	2	P7001C_BFW_PUMP	
MKP-VD-9000-311-200-A3	2	P0502_1/2_CW_PUMP	
MKP-VD-9000-311-205-A3	1	P0502A/B_CW_PUMP	
MKP-VD-9000-302-120-A1 (1 of 5)	C	Turbine: 1155 Ce (FT-2002)	
MKP-VD-9000-302-120-A1 (2 of 5)	C	Turbine: 1155 Ce (FT-2002)	
MKP-VD-9000-302-120-A1 (3 of 5)	C	Turbine: 1155 Ce (FT-2002)	
MKP-VD-9000-302-120-A1 (4 of 5)	C	Turbine: 1155 Ce (FT-2002)	
MKP-VD-9000-302-120-A1 (5 of 5)	C	Turbine: 1155 Ce (FT-2002)	
MKP-VD-9000-302-145-A1 (1 of 5)	C	Turbine: 685 CeH (FT-2001)	
MKP-VD-9000-302-145-A1 (2 of 5)	C	Turbine: 685 CeH (FT-2001)	
MKP-VD-9000-302-145-A1 (3 of 5)	C	Turbine: 685 CeH (FT-2001)	
MKP-VD-9000-302-145-A1 (4 of 5)	C	Turbine: 685 CeH (FT-2001)	
MKP-VD-9000-302-145-A1 (5 of 5)	C	Turbine: 685 CeH (FT-2001)	
MKP-VD-9000-302-302-A0-B	B3	Fan (F-2001)	
MKP-VD-9000-302-302-A0-B	B3	Fan (F-2002)	

Note: This list would be completed during HAZOP. “Place(s) Used [Nodes]” column of table will be completed during HAZOP.

 <p>شirkat kimiya'i pars, khawarizm Middle East Kimya Pars Co.</p>	<p style="text-align: center;">HAZOP Study Review For Methanol Production Unit of MEKPC</p>	 <p>AFTAB IMEN PARTO CONSULTING ENGINEERS Ltd.</p>
July 2022	<p style="text-align: center;">Terms of Reference</p>	Page: 18

3

List of Nodes

The intent of “Term of Reference” is only preparing team members for HAZOP Meetings.
The content of the document will be completed and elaborated in Final HAZOP Report.



**HAZOP Study Review
For
Methanol Production Unit of MEKPC**



July 2022

Terms of Reference

Page: 19

Nodes	Note(s)	Node Color	Type	Equipment IDs	Drawings
1. Natural Gas Station & Distribution		Yellow	Line	X-19011; D-1001;	MKP-11-AS-1000-PR-PID-002
			Filter		MKP-11-AS-1000-PR-PID-001
			Drum		
2. Hydrogenator & Sulphur Absorber		Red	Line	R-1001; R-1002 1/2; E-2004; E-2006;	MKP-11-AS-1000-PR-PID-003
			Reactor		MKP-11-AS-2000-PR-PID-006
			Heater		MKP-11-AS-2000-PR-PID-007
3. NG Saturation		Green	Line	P-6002A; T-6001 1; X-6001A; X-6002A; D-6001; E-6001; P- 6001A; E-6004; E- 6002;	MKP-11-AS-6000-PR-PID-001
			Saturator		MKP-11-AS-6000-PR-PID-002
			Drum		MKP-11-AS-6000-PR-PID-003
			Filter		
			Heat Exchanger		MKP-11-AS-6000-PR-PID-004
4. Saturator Blow Down Drum		Orange	Centrifugal Pump	D-6002; E-6003; P- 7003A;	
			Line		
			Drum		MKP-11-AS-6000-PR-PID-004
			Heat Exchanger		
5. Prereforming		Pink	Centrifugal Pump	E-2002; R-2003;	
			Line		MKP-11-AS-2000-PR-PID-003
			Reactor		MKP-11-AS-2000-PR-PID-004
6. Tubular Reformer		Orange	Heater	E-2001; H-2001;	MKP-11-AS-2000-PR-PID-007
			Line		MKP-11-AS-2000-PR-PID-009
			Reformer		
7. Secondary Reformer		Blue	Heater	X-2001A; X-2002A; E-2008; D-2011; R- 2004;	MKP-11-AS-2000-PR-PID-001
			Line		MKP-11-AS-2000-PR-PID-002
			Reformer		
			Heat Exchanger		MKP-11-AS-2000-PR-PID-010
			Filter		
8. Fuel Gas System		Green	Drum	X-2003;	
			Line		MKP-11-AS-2000-PR-PID-009
			Static Mixer		MKP-11-AS-2000-PR-PID-017
9. Combustion Air		Blue	Line	F-2002; E-2007; H- 2001;	MKP-11-AS-2000-PR-PID-005
			Blower		MKP-11-AS-2000-PR-PID-006
			Heater		MKP-11-AS-2000-PR-PID-009
10. Steam Turbine FT-2002		Orange	Line	FT-2002;	MKP-11-AS-2000-PR-PID-005
			Turbine		
11. Flue Gas System		Violet	Blower	H-2001; E-2001; E- 2002; E-2004; E-2006; E-2007; F-2001; S- 2001;	MKP-11-AS-2000-PR-PID-006
			Heater		MKP-11-AS-2000-PR-PID-007
			Reformer		MKP-11-AS-2000-PR-PID-009
			Stack		
12. Steam Turbine FT-2001		Green	Line	FT-2001;	MKP-11-AS-2000-PR-PID-006
			Turbine		
13. Process Gas Cooling and 1st Separator		Yellow	Line	E-2020 1; E-2021 1&3; E-2022 1~3; D- 2002; P-2001A;	MKP-11-AS-2000-PR-PID-011
			Heat Exchanger		MKP-11-AS-2000-PR-PID-012
			Drum		MKP-11-AS-2000-PR-PID-014
			Centrifugal Pump		
14. HHP Steam Production		Red	Line	E-2020 1; E-2021 1&3; D-2001; E-2022 1~3;	MKP-11-AS-2000-PR-PID-011
			Drum		MKP-11-AS-2000-PR-PID-012
			Heat Exchanger		MKP-11-AS-2000-PR-PID-013
15. Process Gas Cooling and 2nd Separator		Pink	Line	D-2003; E-5023;	MKP-11-AS-2000-PR-PID-014
			Drum		
			Heat Exchanger		

The intent of “Term of Reference” is only preparing team members for HAZOP Meetings.

The content of the document will be completed and elaborated in Final HAZOP Report.

 شرکت کیمیا پارس خاورمیانه Middle East Kimya Pars Co.	HAZOP Study Review For Methanol Production Unit of MEKPC	 AFTAB IMEN PARTO CONSULTING ENGINEERS Ltd.
July 2022	Terms of Reference	Page: 20

Nodes	Note(s)	Node Color	Type	Equipment IDs	Drawings
16. Process Gas Cooling and 3rd Separator		Violet	Line	D-2004; E-5024 1; P-2002A;	
			Drum		
			Heat Exchanger		
			Centrifugal Pump		
17. Process Gas Cooling and Final Separator		Orange	Line	D-2005; E-2025; E-2027; P-2003A; AE-2026;	MKP-11-AS-2000-PR-PID-015
			Drum		MKP-11-AS-2000-PR-PID-016
			Heat Exchanger		MKP-11-AS-2000-PR-PID-020
			Centrifugal Pump		
18. Start-up Nitrogen Compressor		Blue	Line	C-2001;	
			Centrifugal Compressor		MKP-11-AS-2000-PR-PID-018
19. Hydrogen Recycle Compressor		Violet	Line	C-2002;	
			Centrifugal Compressor		MKP-11-AS-2000-PR-PID-019

Note: This list and Marked-up P&IDs would be completed during HAZOP.

 <p>شirkat kimyai pars, kharanbeh Middle East Kimya Pars Co.</p>	<p style="text-align: center;">HAZOP Study Review For Methanol Production Unit of MEKPC</p>	 <p>AFTAB IMEN PARTO CONSULTING ENGINEERS Ltd.</p>
July 2022	<p style="text-align: center;">Terms of Reference</p>	Page: 21


4

Marked-Up P&IDs

The intent of “Term of Reference” is only preparing team members for HAZOP Meetings.
The content of the document will be completed and elaborated in Final HAZOP Report.

SYMBOLS FOR PROCESS AND INSTRUMENTATION		SYMBOLS FOR PIPING ELEMENTS			LETTER CODE FOR INSTRUMENTATION		LETTER CODE FOR PROCESS EQUIPMENT ANG PIPING FITTINGS		IDENTIFICATION:		GENERAL NOTES:		LIST OF DIAGRAMS		
PIPS		LINE SYMBOLS			FIRST LETTER		PROCESS EQUIPMENT		PIPE NUMBER:		DIAGRAM NUMBER		TITLE		DWG. NO.
A	MAIN PROCESS LINE		CONTROL VALVE		GATE VALVE		SPRAY NOZZLE	MEASURED OR INITIATING VARIABLES	MODIFIER	A	PROCESS FILTER	12-SG-50-01-B23-H1	1) LOOP TAG NUMBERING EG.FHS,FHIC.		
	OTHER LINE		CONTROL VALVE WITH POSITIONER		GLOBE VALVE		SIGHT GLASS	A B C D E F G H I J K L M N O P Q R S T U V W X Y Z	DIFFERENTIAL	AE COOLER, CONDENSER	INSULATION CLASS	F = LOOP DESIGNATION	SYMBOLS AND IDENTIFICATIONS		
	STEAM TRACING		CONTROL VALVE WITH MANUAL OPERATION DEVICE		NEEDLE VALVE		SPool PIECE	VOLTAGE (EMF)	RATIO (FRACTION)	B BLOWER, DRUM	INSULATION PURPOSE	H = HAND	P01	NATURAL GAS DISTRIBUTION	1341709
	ELECTRIC TRACED		AIR CYLINDER OPERATED VALVE		BALL VALVE		SWING ELBOW	FLOW RATE		C COMPRESSOR	PIPE CLASS CODE	S = SWITCH	P02	PROCESS OXYGEN	1341711
	TRACED-MEDIA UNSPECIFIED		HAND OPERATED CONTROL VALVE		PLUG VALVE			HAND (MANUALLY INITIATED)	SEQUENCE NUMBER	D VESSEL, SEPARATOR	SEQUENCE NUMBER	I = INDICATING	P03	OXYGEN PREHEATING	1341712
	STEAM JACKETED		SOLENOID VALVE		DIAPHRAGM VALVE			CURRENT (ELECTRICAL)	UNIT NUMBER	E HEAT EXCHANGER	UNIT NUMBER	C = CONTROLLER	P04	DESLUPHURISATION	1341714
	SLOPE DOWN		ELECTRIC MOTOR OPERATED VALVE		BUTTERFLY VALVE			POWER	FLUID CODE	F TURBINE	NOMINAL DIAMETER		P05	STEAM CONDENSATE RETURN	1341715
	SLOPE UP		SELF OPERATING BACK PRESSURE REGULATING VALVE		VALVE CAN'T BE FULLY CLOSED			TIME, TIME SCHEDULE		G ALTERNATOR			P06	NG SATURATION I	1341716
	FREE DRAINING		SELF OPERATING PRESSURE REDUCING VALVE		VALVE WITH ELECTRIC TRACING			LEVEL		H HEATER			P07	NG SATURATION II	1341717
	INSTRUMENT LINES		SOLENOID VALVE		NON-RETURN OR CHECK VALVE			MONITORING (MOTORS)		I NOT TO BE USED			P08	NG SATURATION III	1341718
B	CONNECT TO PROCESS OR UNDEFINED SIGNAL		ELECTRIC MOTOR OPERATED VALVE		ANGLE VALVE			PRESSURE, VACUUM		J EJECTOR			P09	S C RATIO CONTROL I	1341719
	PNEUMATIC SIGNAL		SELF OPERATING BACK PRESSURE REGULATING VALVE		3-WAY VALVE			QUANTITY		L ELECTRICAL EQUIPMENT			P10	S C RATIO CONTROL II	1341720
	ELECTRIC SIGNAL		SELF OPERATING PRESSURE REDUCING VALVE		MINIMUM FLOW AND CHECK VALVE			RADIOACTIVITY		M PUMP			P11	FLUE GAS WHS I	1341721
	ELECTRIC BINARY SIGNAL		SPRING VALVE		TEE WITH PIPE CLASS CHANGE			SPEED, FREQUENCY		N CONVEYER			P12	FLUE GAS WHS II	1341722
	CAPILLARY TUBE		SPRING LOADED RELIEF VALVE		VALVE CAN'T BE FULLY CLOSED			TEMPERATURE		O NOT TO BE USED			P13	FLUE GAS WHS IV	1341723
	HYDRAULIC SIGNAL		SPRING LOADED QUICK CLOSING VALVE - INTERMITTENT BLOW DOWN		OPEN VENT			MULTIVARIABLE VIBRATION		P PUMPKIN			P14	PREREFORMING	1341724
	DATA LINE OR SOFTWARE		SPRING LOADED SAFETY RELIEF VALVE		LIQUID SEAL			WEIGHT, FORCE		Q AVAILABLE			P15	TUBULAR REFORMER	1341725
	MECHANICAL LINK		SPRING LOADED SPRING LOADED		FLAME ARRESTOR/DEMISTER			UNCLASSIFIED		R REACTOR, CONVERTER			P16A	SECONDARY REFORMER I	1341726
	BY VENDOR (B. V.)		RELIEF VALVE		AIR INTAKE			POSITION, DIMENSION		S STACK, STRUCTURE			P16B	SECONDARY REFORMER II	1341756
	AUTOMATIC MANIFOLD		VALVE CAN'T BE FULLY CLOSED		QUENCH NOZZLE			ML RUNNING		T COLUMN, TOWER			P17	STEAM SUPERHEATER	1341727
C	INSTRUMENT OR FUNCTION		SPRING LOADED VACUUM RELIEF VALVE		SPECIAL PIPING ELEMENT			Y EVENT, STATE, PRESENCE		U FOUNDATION			P18	STEAM GENERATION	1341728
	INSTRUMENT SURROUNDED BY BOX IS PART OF DISTRIBUTED CONTROL SYSTEM / ESD SYSTEM		BREATHER VALVE		BIRD SCREEN			Z POSITION, DIMENSION		U* FOUNDATION (PREFIX TO B, D, E, F, H, R, T ETC.)			P19	GAS COOLING AND SEPARATION I	1341729
	FIELD MOUNTED		EMERGENCY RELIEF MANHOLE		CORROSION COUPON			Y INTERNAL (HARDWARE)		V VENT, FLARE			P20	GAS COOLING AND SEPARATION II	1341730
	PRIMARY LOCATION (MAIN PANEL)		RUPTURE DISC		MULTIFUNCTION HYDRAULIC CONTROL VALVE			Z INTERNAL (CATALYST)		W CRANE, ELEVATOR			P21	GAS COOLING AND SEPARATION III	1341731
	BEHIND-PANEL DEVICE (NORM. INACCESSIBLE)		ORIFICE		OVERFLOW			Z* INTERNAL (CATALYST) (PREFIX TO R)		X MISCELLANEOUS EQUIPMENT			P22	SYNTHESIS GAS COMPRESSOR	1341732
	AUXILIARY LOCATION (LOCAL PANEL)		VENTURI		RESIN TRAPPER			Y* INTERNAL (HARDWARE) (PREFIX TO E, F, H, R, T ETC.)		Y INTERNAL (HARDWARE)			P23	SYNTHESIS, PART I	1341733
	INTERLOCK FUNCTION (GROUP 1)		FLOW NOZZLE		FLEXIBLE CONNECTION			Z* INTERNAL (CATALYST) (PREFIX TO R)		Z INTERNAL (CATALYST)			P24	METHANOL SYNTHESIS	1341734
	ESD SYSTEM (GROUP 1)		ROTAMETER		FOR SUMP			MCV MULTIFUNCTIONAL HYDRAULIC CONTROL VALVE		Y INTERNAL (HARDWARE)			P25	METHANOL F-E EXCHANGER	1341735
	INTERLOCK LOGIC (GROUP 1)		TURBINE OR PROPELLER TYPE FLOW METER		CALIBRATION POT			PD POND		Z INTERNAL (CATALYST)			P26	SYNTHESIS, PART II	1341736
	SWITCH		ANNULBAR TYPE FLOW ELEMENT		DESICCANT VENT			RT RESIN TRAPPER		CD CLOSED DRAIN			P27	FAILURE OPEN	1341737
D	INSTRUMENT WITH ELECTRIC TRACING		AVERAGE PILOT TUBE OR ANNULAR		BLIND			SU FOR SUMP		CD CLOSED DRAIN			P28	FAILURE CLOSED	1341738
	SIGNAL FOR VENDOR TO PLC		POSITIVE DISPLACEMENT METER		OFF PAGE CONNECTOR			DR DRain		CH CHANGES OF SCOPE (FOR PIPE)			P29	RAW PRODUCT FLASH	1341739
	TYPICAL EQUIPMENT SYMBOLS		VORTEX FLOWMETER		SPACER			EW ELECTRIC		CH CHANGES OF SCOPE (FOR PIPE)			P30	CRUDE METHANOL TANK	1341740
	CENTRIFUGAL PUMP		ULTRASONIC FLOWMETER		MANIFOLD/COLLECTOR			EW ELECTRIC		CH CHANGES OF SCOPE (FOR PIPE)			P31	STABILIZER COLUMN	1341741
	RECIPROCATING PUMP		CORIOLIS FLOWMETER		MANIFOLD			EW ELECTRIC		CH CHANGES OF SCOPE (FOR PIPE)			P32	STABILIZER COLUMN OH SYSTEM	1341742
	SUBMERGED PUMP		AIR BLOWER		FLANGED CONNECTION			EW ELECTRIC		CH CHANGES OF SCOPE (FOR PIPE)			P33	STABILIZER COLUMN PUMPS	1341743
	AIR BLOWER		VERTICAL PUMP		FLANGED END			EW ELECTRIC		CH CHANGES OF SCOPE (FOR PIPE)			P34	LP METHANOL COLUMN	1341744
	VERTICAL PUMP		MOTOR		CAPPED END			EW ELECTRIC		CH CHANGES OF SCOPE (FOR PIPE)			P35	LP METHANOL COLUMN REBOILER	1341745
	EJECTOR		3-WAY SOLENOID VALVE: ARROW INDICATES STATE WHEN DE-ENERGIZED		SCREWED CAP			EW ELECTRIC		CH CHANGES OF SCOPE (FOR PIPE)			P36	LP METHANOL COLUMN OH SYSTEM	1341746
	TURBINE		INSTRUMENT WITH DIAPHRAGM SEAL		VALVE WITH BLIND FLANGE			EW ELECTRIC		CH CHANGES OF SCOPE (FOR PIPE)			P37	MP METHANOL COLUMN FEED PUMP	1341747
E	ROOT'S COMPRESSOR		ELECTRO/PNEUMATIC CONVERTER		PLUG			EW ELECTRIC		CH CHANGES OF SCOPE (FOR PIPE)			P38	MP METHANOL COLUMN	1341748
	CRANE		DAMPER		MULTIVANE LOUVER			EW ELECTRIC		CH CHANGES OF SCOPE (FOR PIPE)			P39	MP COLUMN REBOILERS	1341749
	TEST POINT				4"X3"			EW ELECTRIC		CH CHANGES OF SCOPE (FOR PIPE)			P40	MP METHANOL COLUMN OH SYSTEM	1341750
					4"X3"			EW ELECTRIC		CH CHANGES OF SCOPE (FOR PIPE)			P41	MP METHANOL COLUMN BY PRODUCT	1341751
					4"X3"			EW ELECTRIC		CH CHANGES OF SCOPE (FOR PIPE)			P42	METHANOL PRODUCT	1341752
					4"X3"			EW ELECTRIC		CH CHANGES OF SCOPE (FOR PIPE)			P43	METHANOL PRODUCT BUFFER TANK I	1341753
					4"X3"			EW ELECTRIC		CH CHANGES OF SCOPE (FOR PIPE)			P44	METHANOL PRODUCT BUFFER TANK II	1341754
					4"X3"			EW ELECTRIC		CH CHANGES OF SCOPE (FOR PIPE)			P45	LIQUID OFF STREAM TANK	1341755
					4"X3"			EW ELECTRIC		CH CHANGES OF SCOPE (FOR PIPE)			P46	FUEL SYSTEM	1341

VARIOUS SYMBOLS

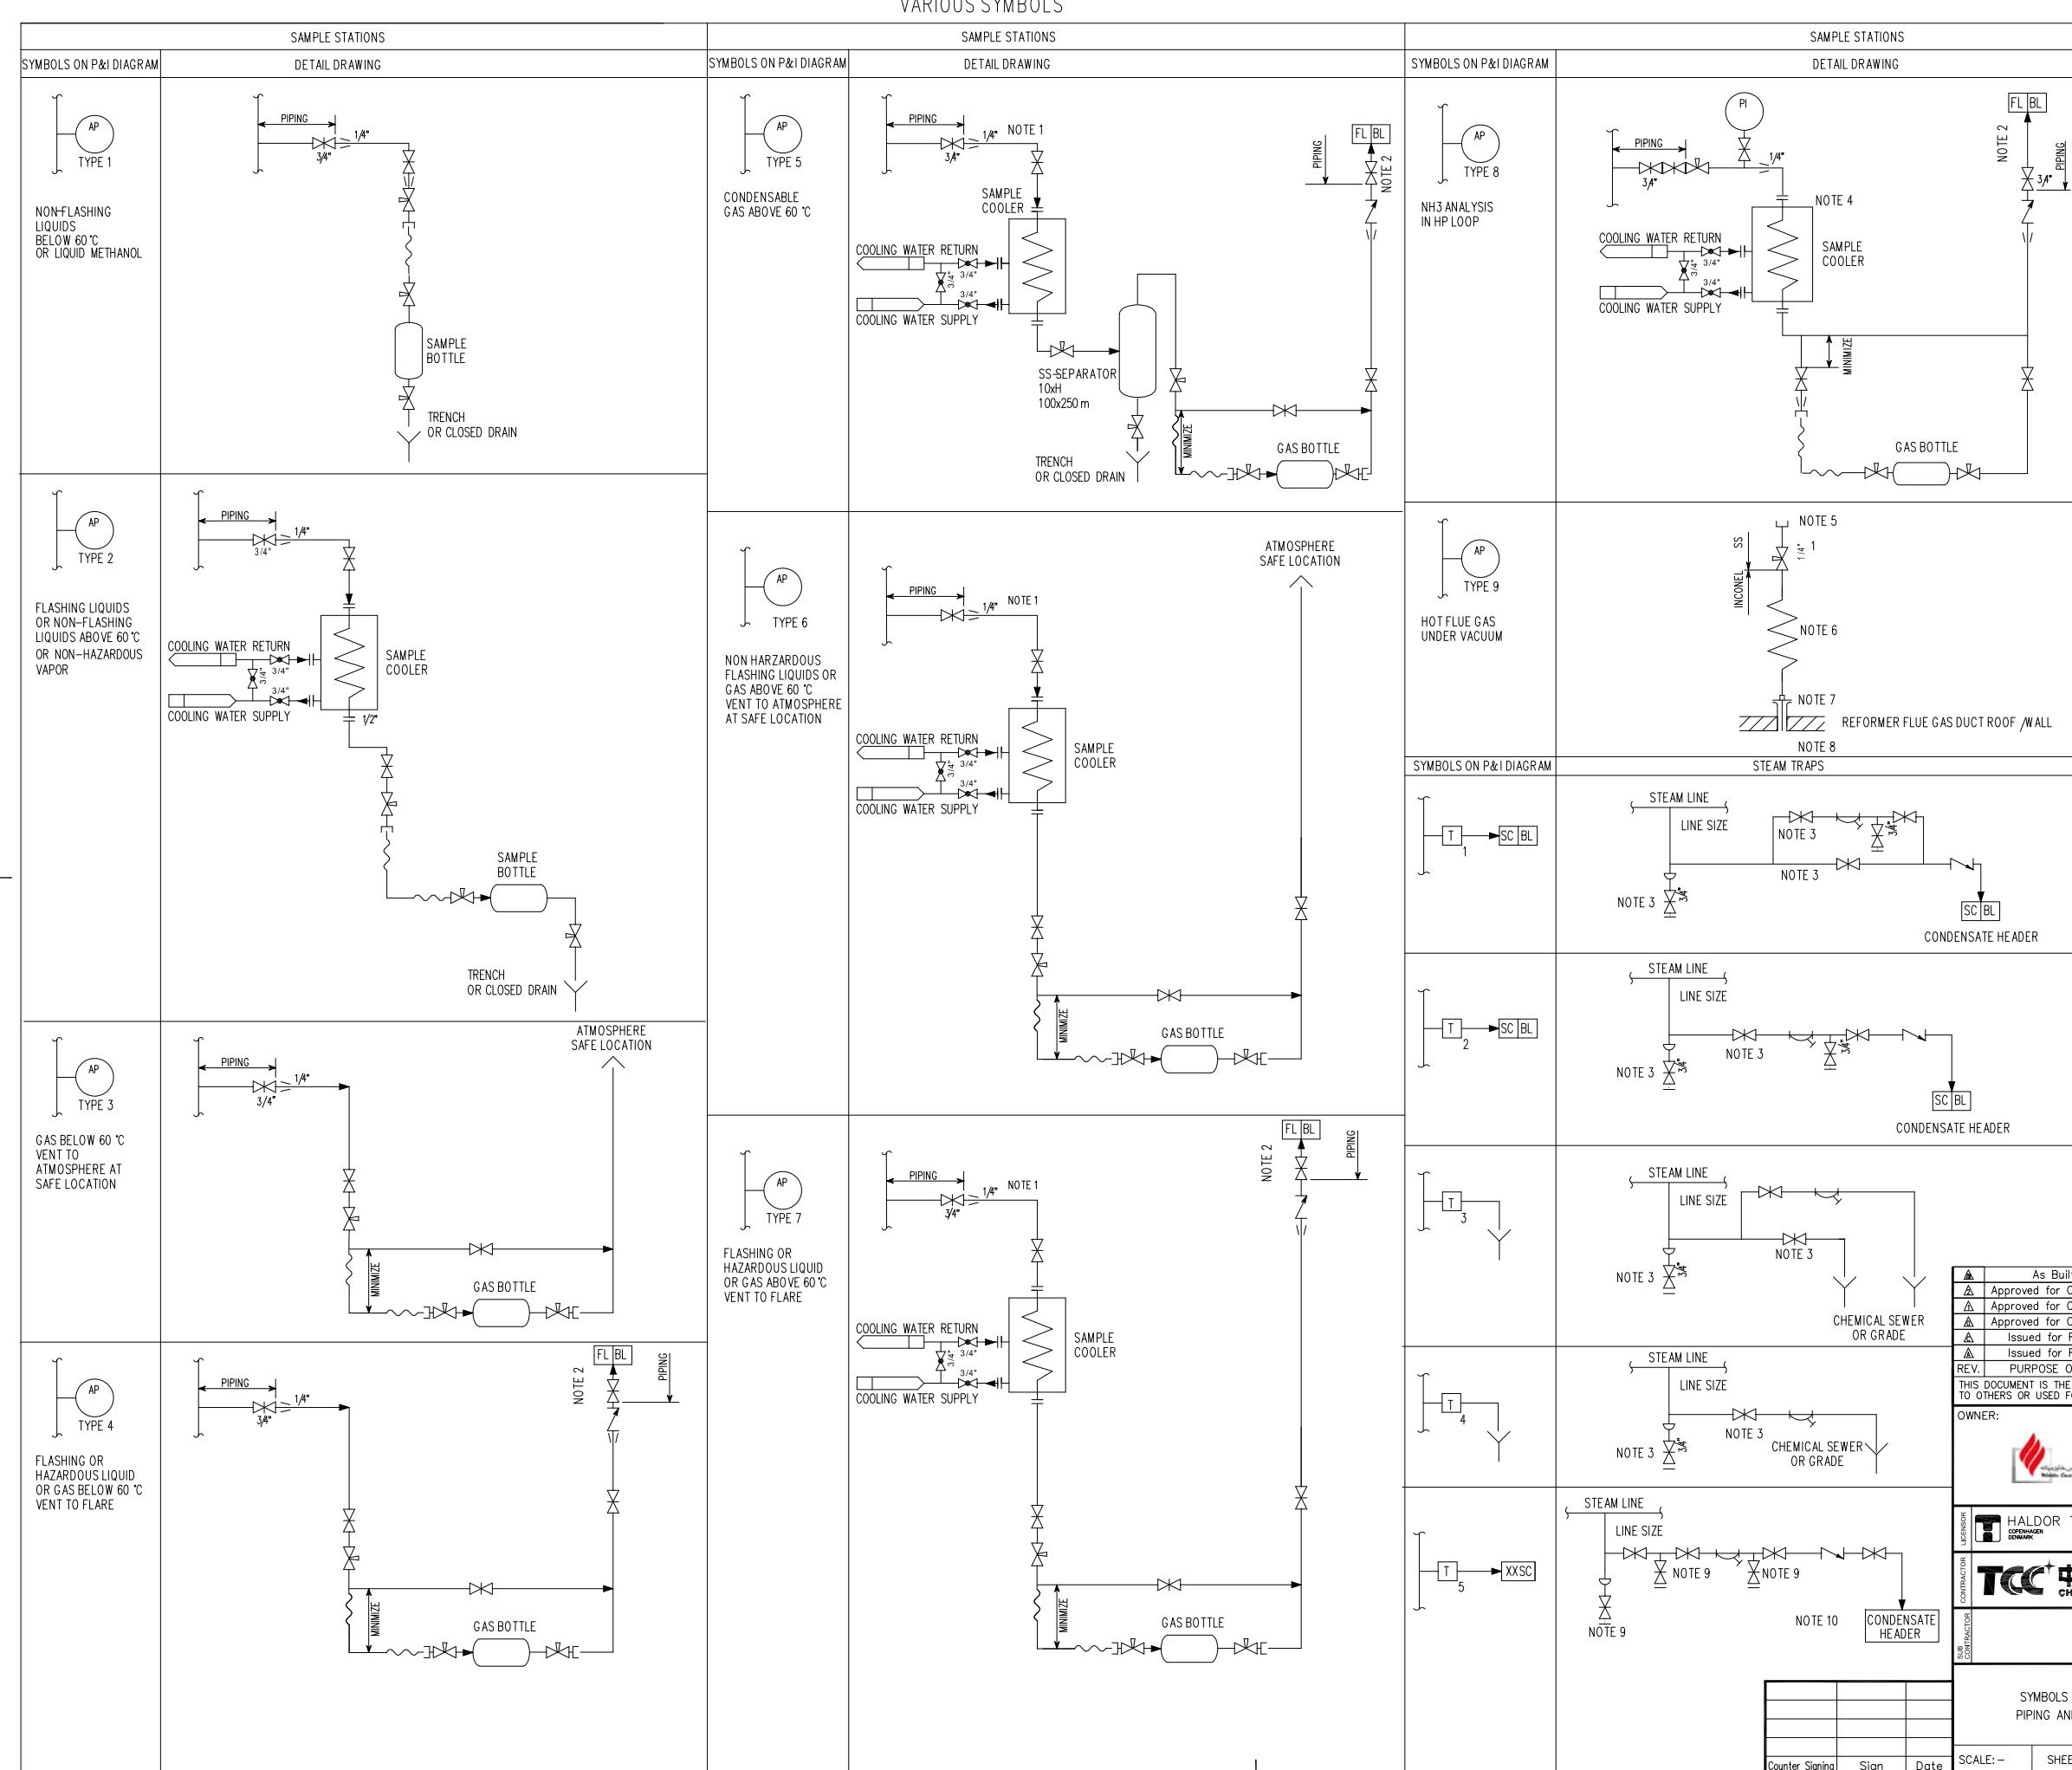


NOTES:

- 1) MINIMUM 4m BARE TUBE FOR AIR COOLING BEFORE ENTERING WATER COOLER.
- 2) VALVE TO FLARE TO BE IN ACCORDANCE WITH PROCESS PIPECLASS.
- 3) VALVES TO BE DOUBLED IN HIGH PRESSURE SYSTEMS.
- 4) SAMPLE COOLER TO BE OMITTED IF TEMPERATURE <60°C.
- 5) CONNECTION TO SUIT PORTABLE SAMPLE BOTTLE WITH VACUUM PUMP OR PORTABLE ANALYSER.
- 6) MIN 4m of BARE 1/4" INCONEL TUBE.
- 7) CONAX FITTING WITH LAVA SEAL.
- 8) TUBE INSERTED CLOSE TO EDGE OF BRICK WORK.
- 9) THE PRINCIPLE FOR DRAIN VALVES AS FOLLOWS:
 - A. USING ONE SHUT-OFF VALVE AND THREADED PIPE CAP IF PIPE CLASS LESS THAN CLASS 600.
 - B. USING TWO SHUT-OFF VALVES AND BLIND FLANGE IF PIPE CLASS EQUAL OR MORE THAN CLASS 600, BUT LESS THAN CLASS 1500.
 - C. USING TWO WELDING SHUT-OFF VALVES AND ONE SHORT PIPE IN THE END IF PIPE CLASS EQUAL CLASS 1500.
- 10) THE PRINCIPLE FOR STEAM CONDENSATE HEADER AS FOLLOWS:
 - A. FOR HHPS STEAM PIPE, CONDENSATE HEADER HHPS.
 - B. FOR HPS AND MPS STEAM PIPE, CONDENSATE HEADER HPS.
 - C. FOR LPS STEAM PIPE, CONDENSATE HEADER LPS.


GENERAL NOTES:


- 1) REQUIREMENTS FOR TRACING TO BE CONSIDERED.
- 2) ALL SAMPLE CONNECTIONS SHALL BE FROM TOP OF PROCESS PIPE.
- 3) ALL SAMPLE TUBING TO BE 1/4" SS.


▲ As Built	30.04.2020	Xu Yekun	Xu Hong	Liu Shengkai
▲ Approved for Construction	06.11.2017	Xu Yekun	Xu Hong	Liu Shengkai
▲ Approved for Construction	22.03.2017	Xu Yekun	Xu Hong	Liu Shengkai
▲ Issued for Review	10.10.2016	Jiang Yu	Xu Hong	Liu Shengkai
▲ Issued for Review	25.06.2016	Jiang Yu	Xu Hong	Liu Shengkai
REV.	PURPOSE OF ISSUE	DATE	DESIGN	DRAW CHECK REVIEW APPROVE
THIS DOCUMENT IS THE PROPERTY OF TCC. NO PART OF THIS DOCUMENT SHALL BE REPRODUCED OR DISCLOSED TO OTHERS OR USED FOR ANY PURPOSE WHATSOEVER EXCEPT WITH THE PRIOR WRITTEN PERMISSION OF TCC.				
OWNER:				
Middle East Kimiaye Pars Company				
CONTRACTOR: HALDOR TOPSØE A/S	DOCUMENT NAME: SYMBOLS AND IDENTIFICATIONS FOR PIPING AND INSTRUMENT DIAGRAM(2)	JOB NO.: S-02115	DOC. NO.: 42	REV. 2
		DWG. NO.: 1341709		
CONTRACTOR DRAWING NO.				
TCC + CHINA TIANCHEN ENGINEERING CORPORATION				
SUB-CONTRACTORS	PROJECT: MKP Methanol Project	UNIT: General Technical	PHASE: As Built Drawing	
SYMBOLS AND IDENTIFICATIONS FOR PIPING AND INSTRUMENT DIAGRAM(2)				
Counter Signing	Sign	Date	SCALE: -	SHEET: 1 / TOTAL: 1 / SIZE: A1
OWNER DWG NO.	MKP-11-AS-9000-PR-PID-002			

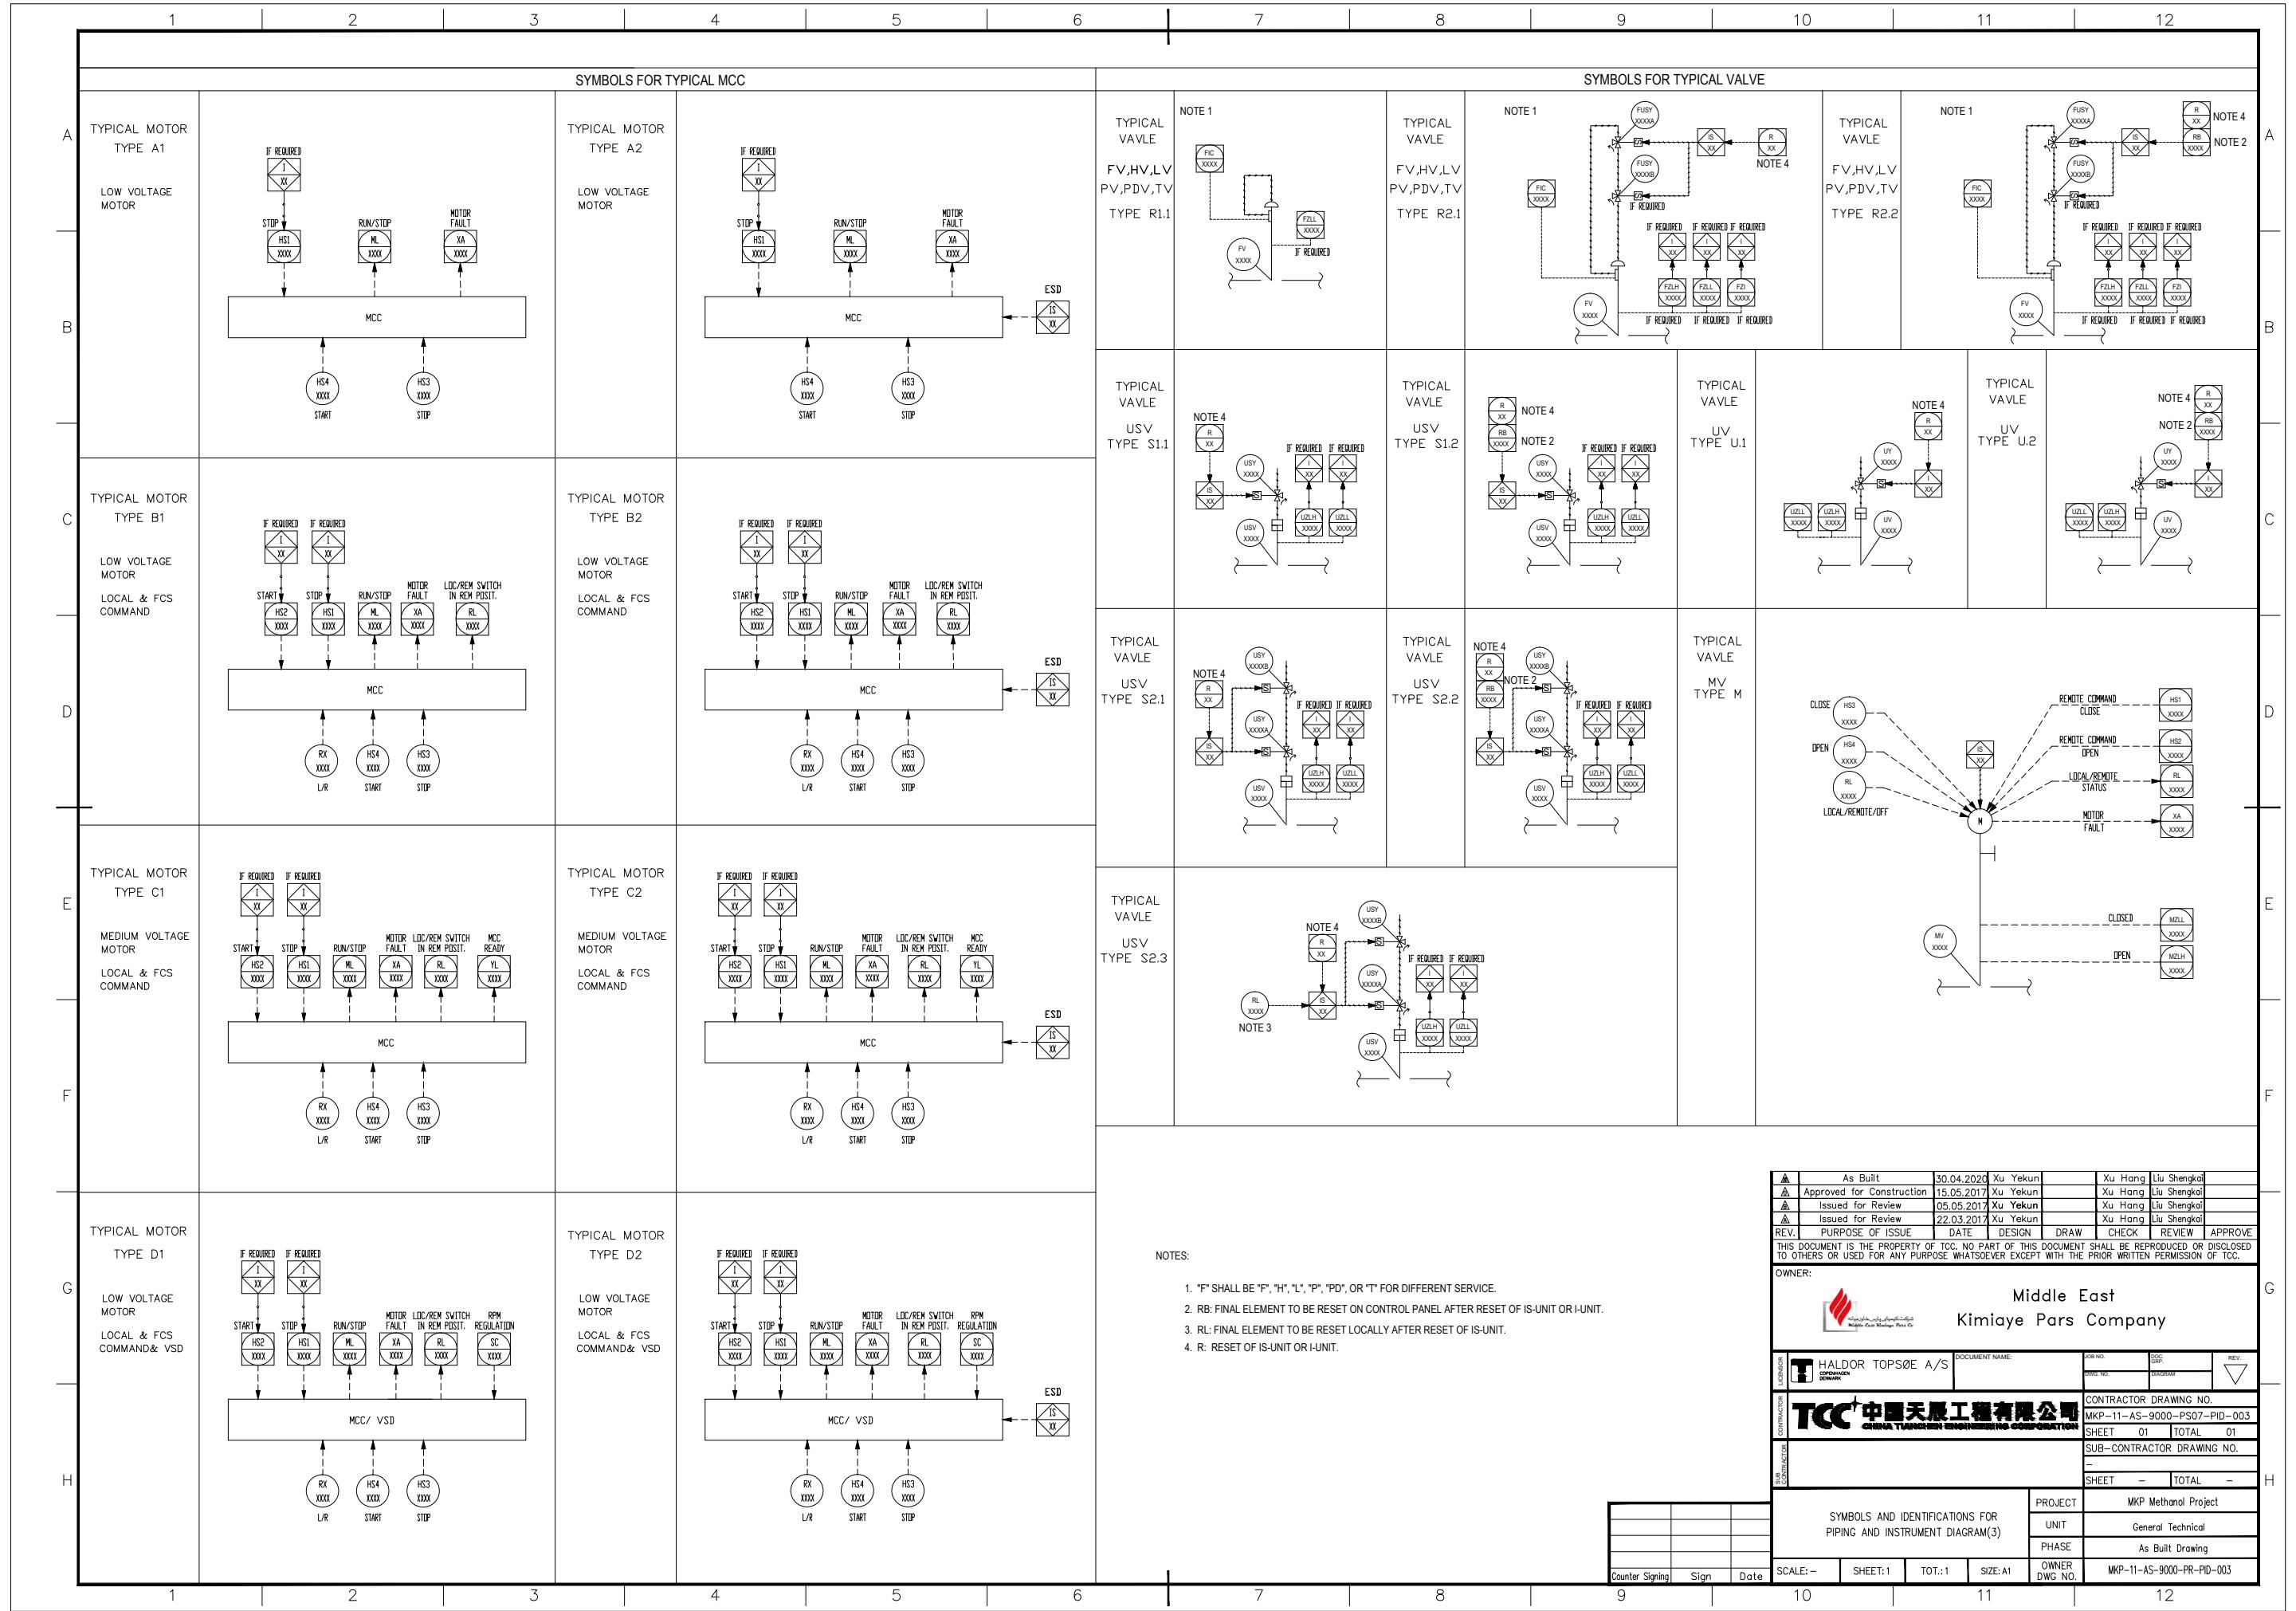


REV.		PURPOSE OF ISSUE	DATE	DESIGN	DRAW	CHECK	REVIEW	APPROVE
THIS DOCUMENT IS THE PROPERTY OF TCC. NO PART OF THIS DOCUMENT SHALL BE REPRODUCED OR DISCLOSED TO OTHERS OR USED FOR ANY PURPOSE WHATSOEVER EXCEPT WITH THE PRIOR WRITTEN PERMISSION OF TCC.								
OWNER:								
 Middle East Kimiaye Pars Company								
LICENSOR	HALDOR TOPSOE A/S	CONTRACTOR	CHINA TIANQIEN ENGINEERING CORPORATION	DOCUMENT NAME	DOC	REV.		
DRWS. NO.	DRAGAM	CONTRACTOR DRAWING NO.	MKP-11-AS-9000-PS07-PID-003					
SUB-CONTRACTOR		SHEET	01	TOTAL	01			
		SUB-CONTRACTOR DRAWING NO.						
		SHEET	-	TOTAL	-			
SYMBOLS AND IDENTIFICATIONS FOR PIPING AND INSTRUMENT DIAGRAM(3)								
PROJECT		MKP Methanol Project						
UNIT		General Technical						
PHASE		As Built Drawing						
OWNER DWG NO.		MKP-11-AS-9000-PR-PID-003						
Counter Signing	Sign	Date	SCALE:-	SHEET:1	TOT:1	SIZE: A1	OWNER DWG NO.	

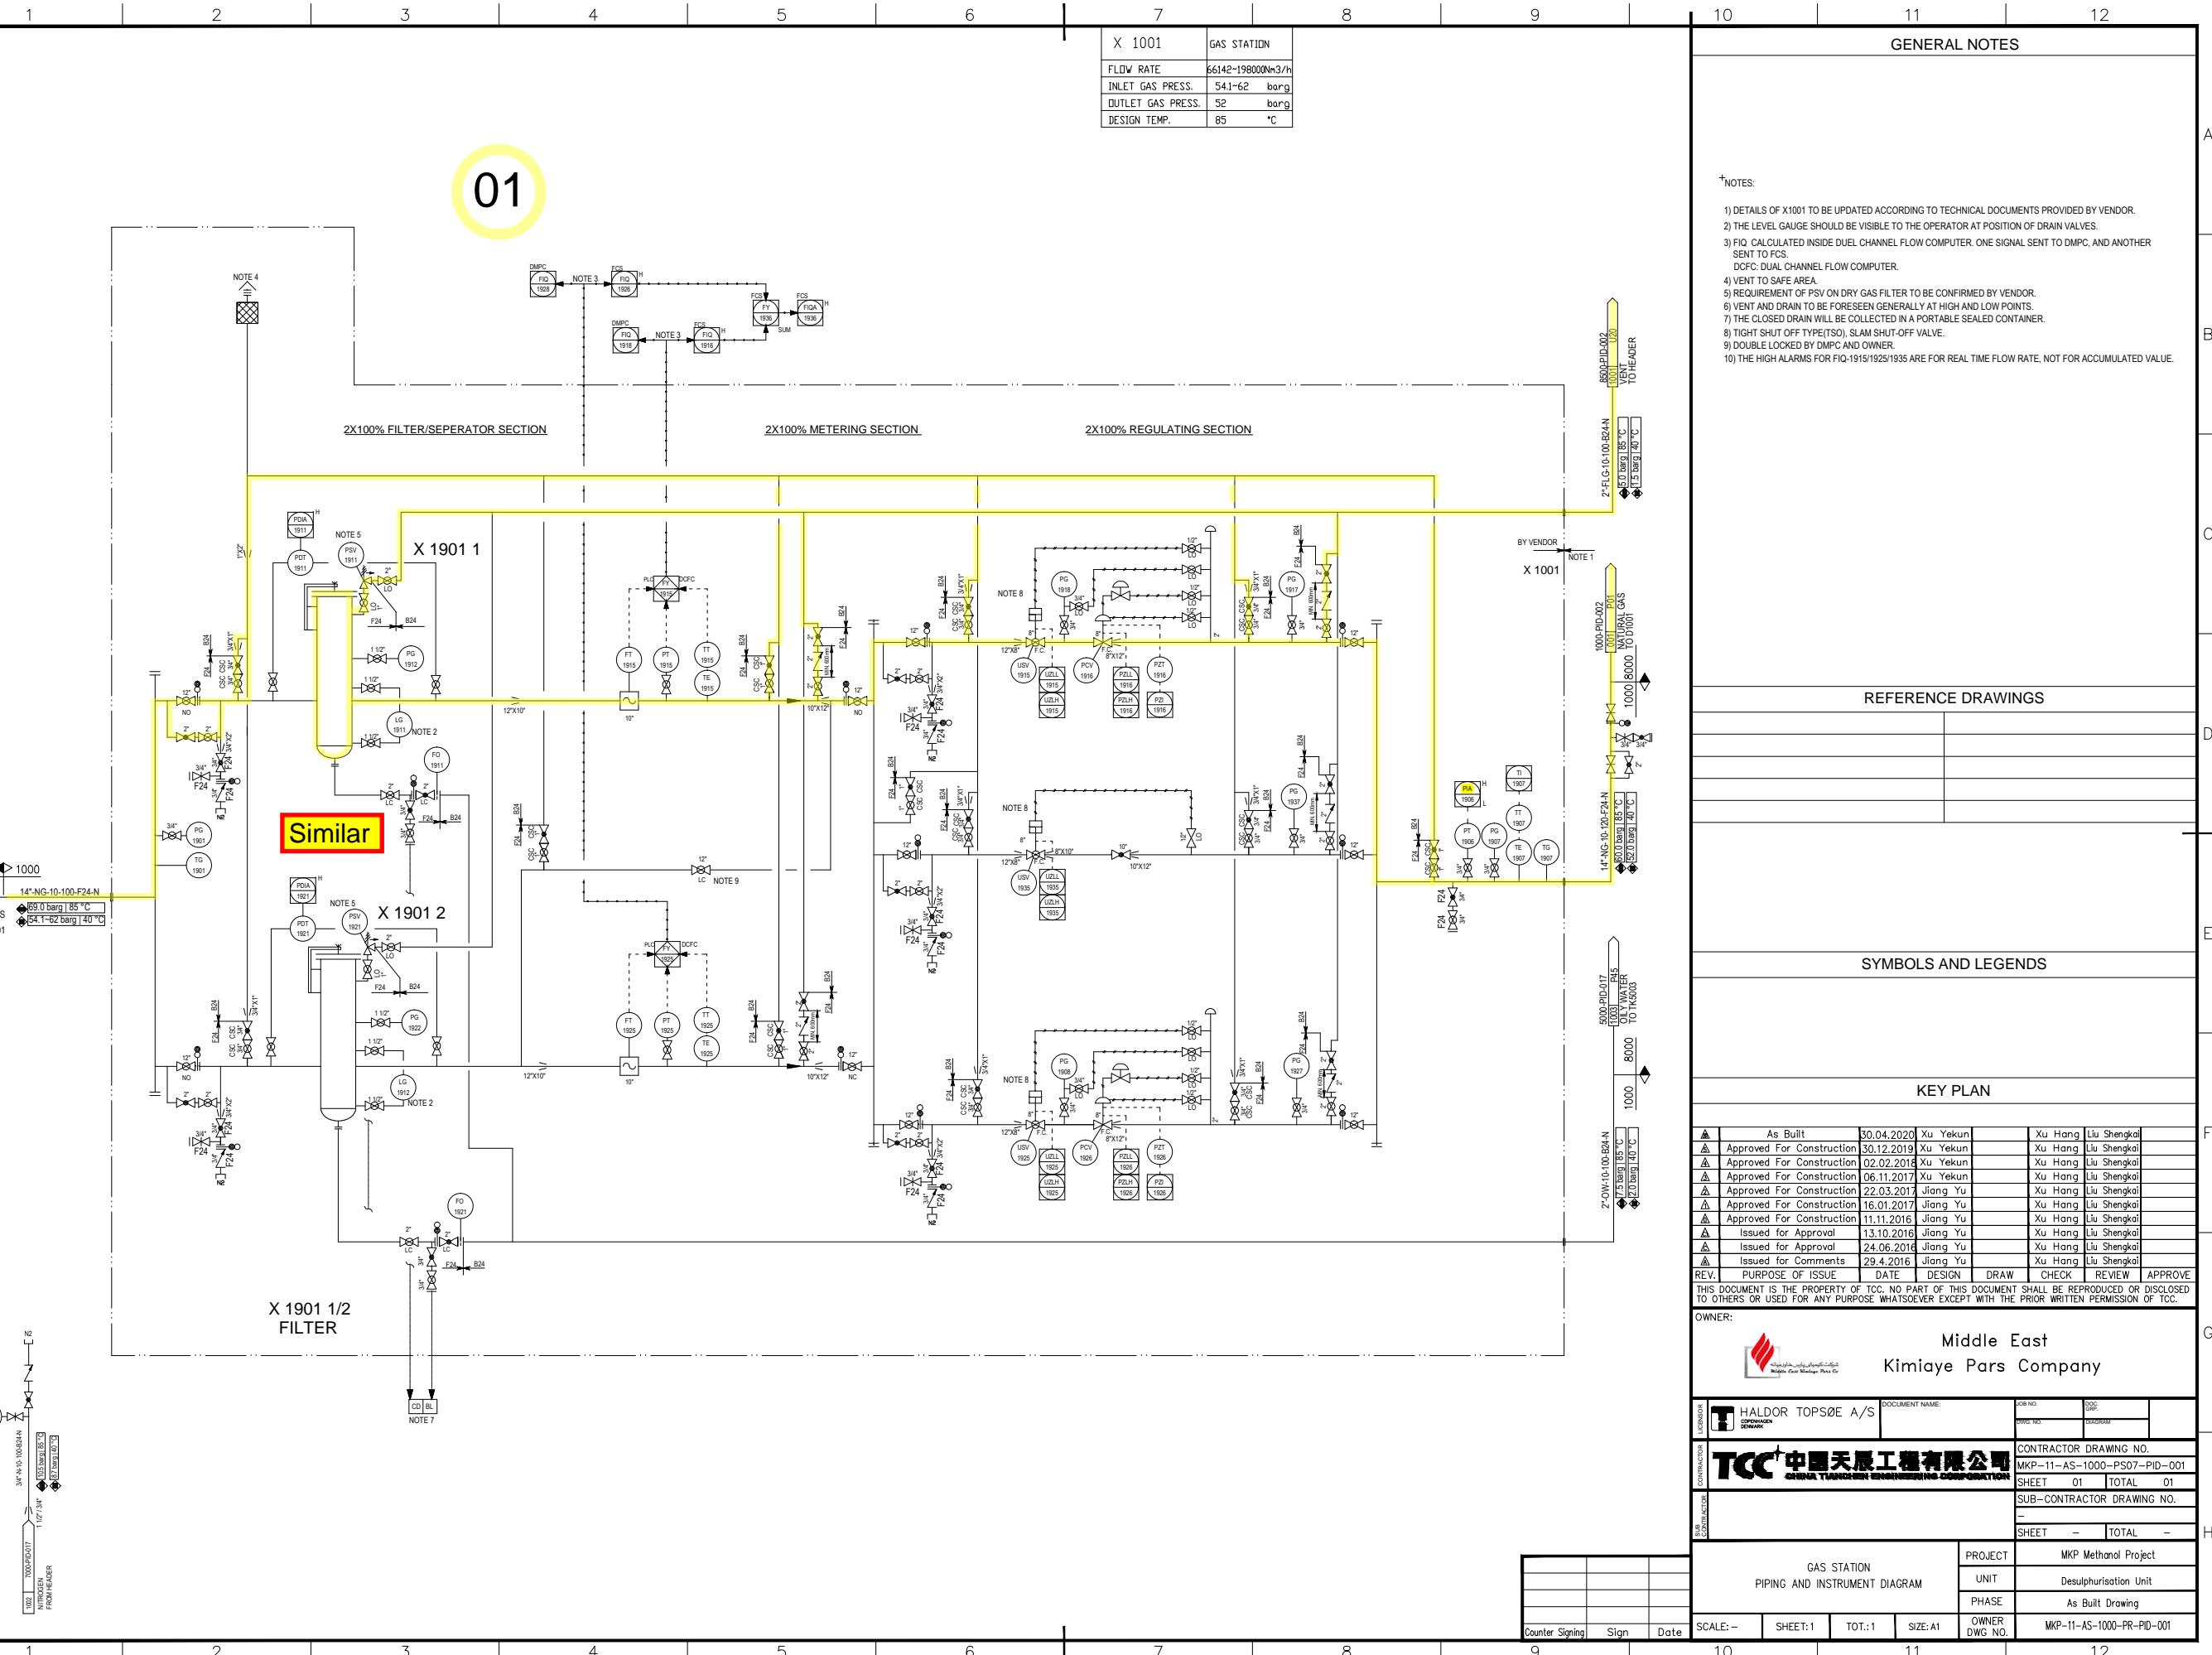


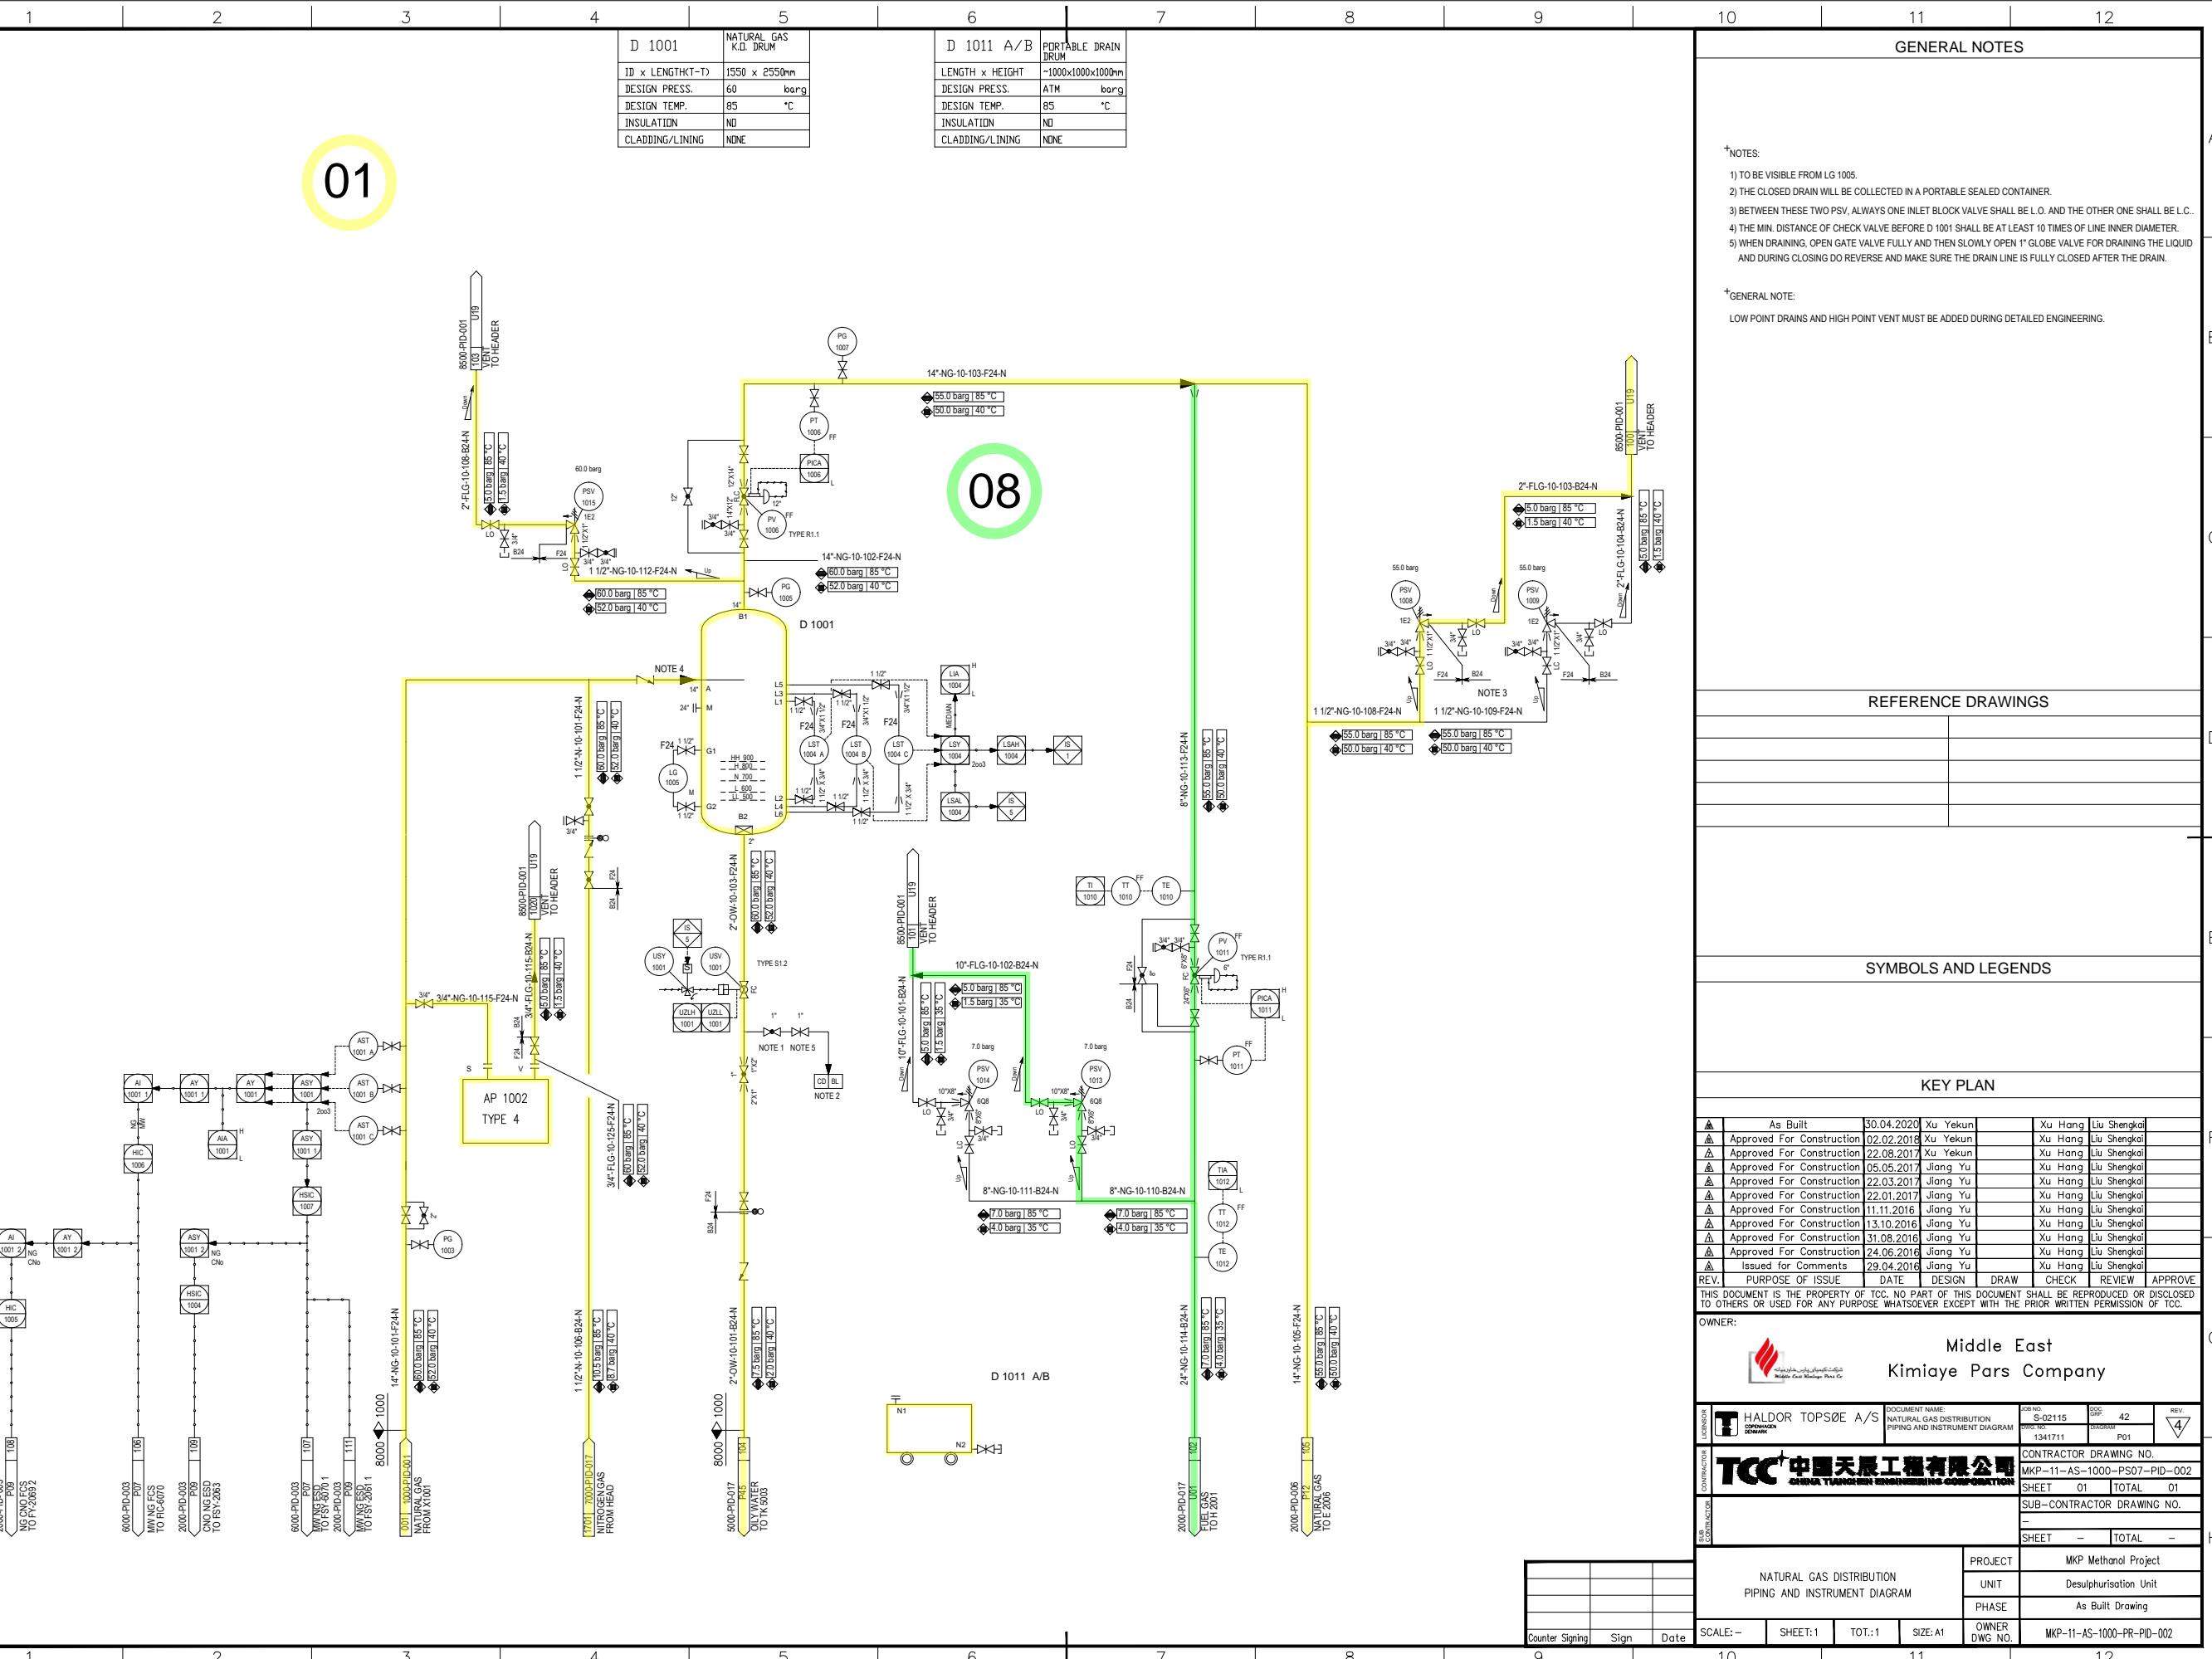


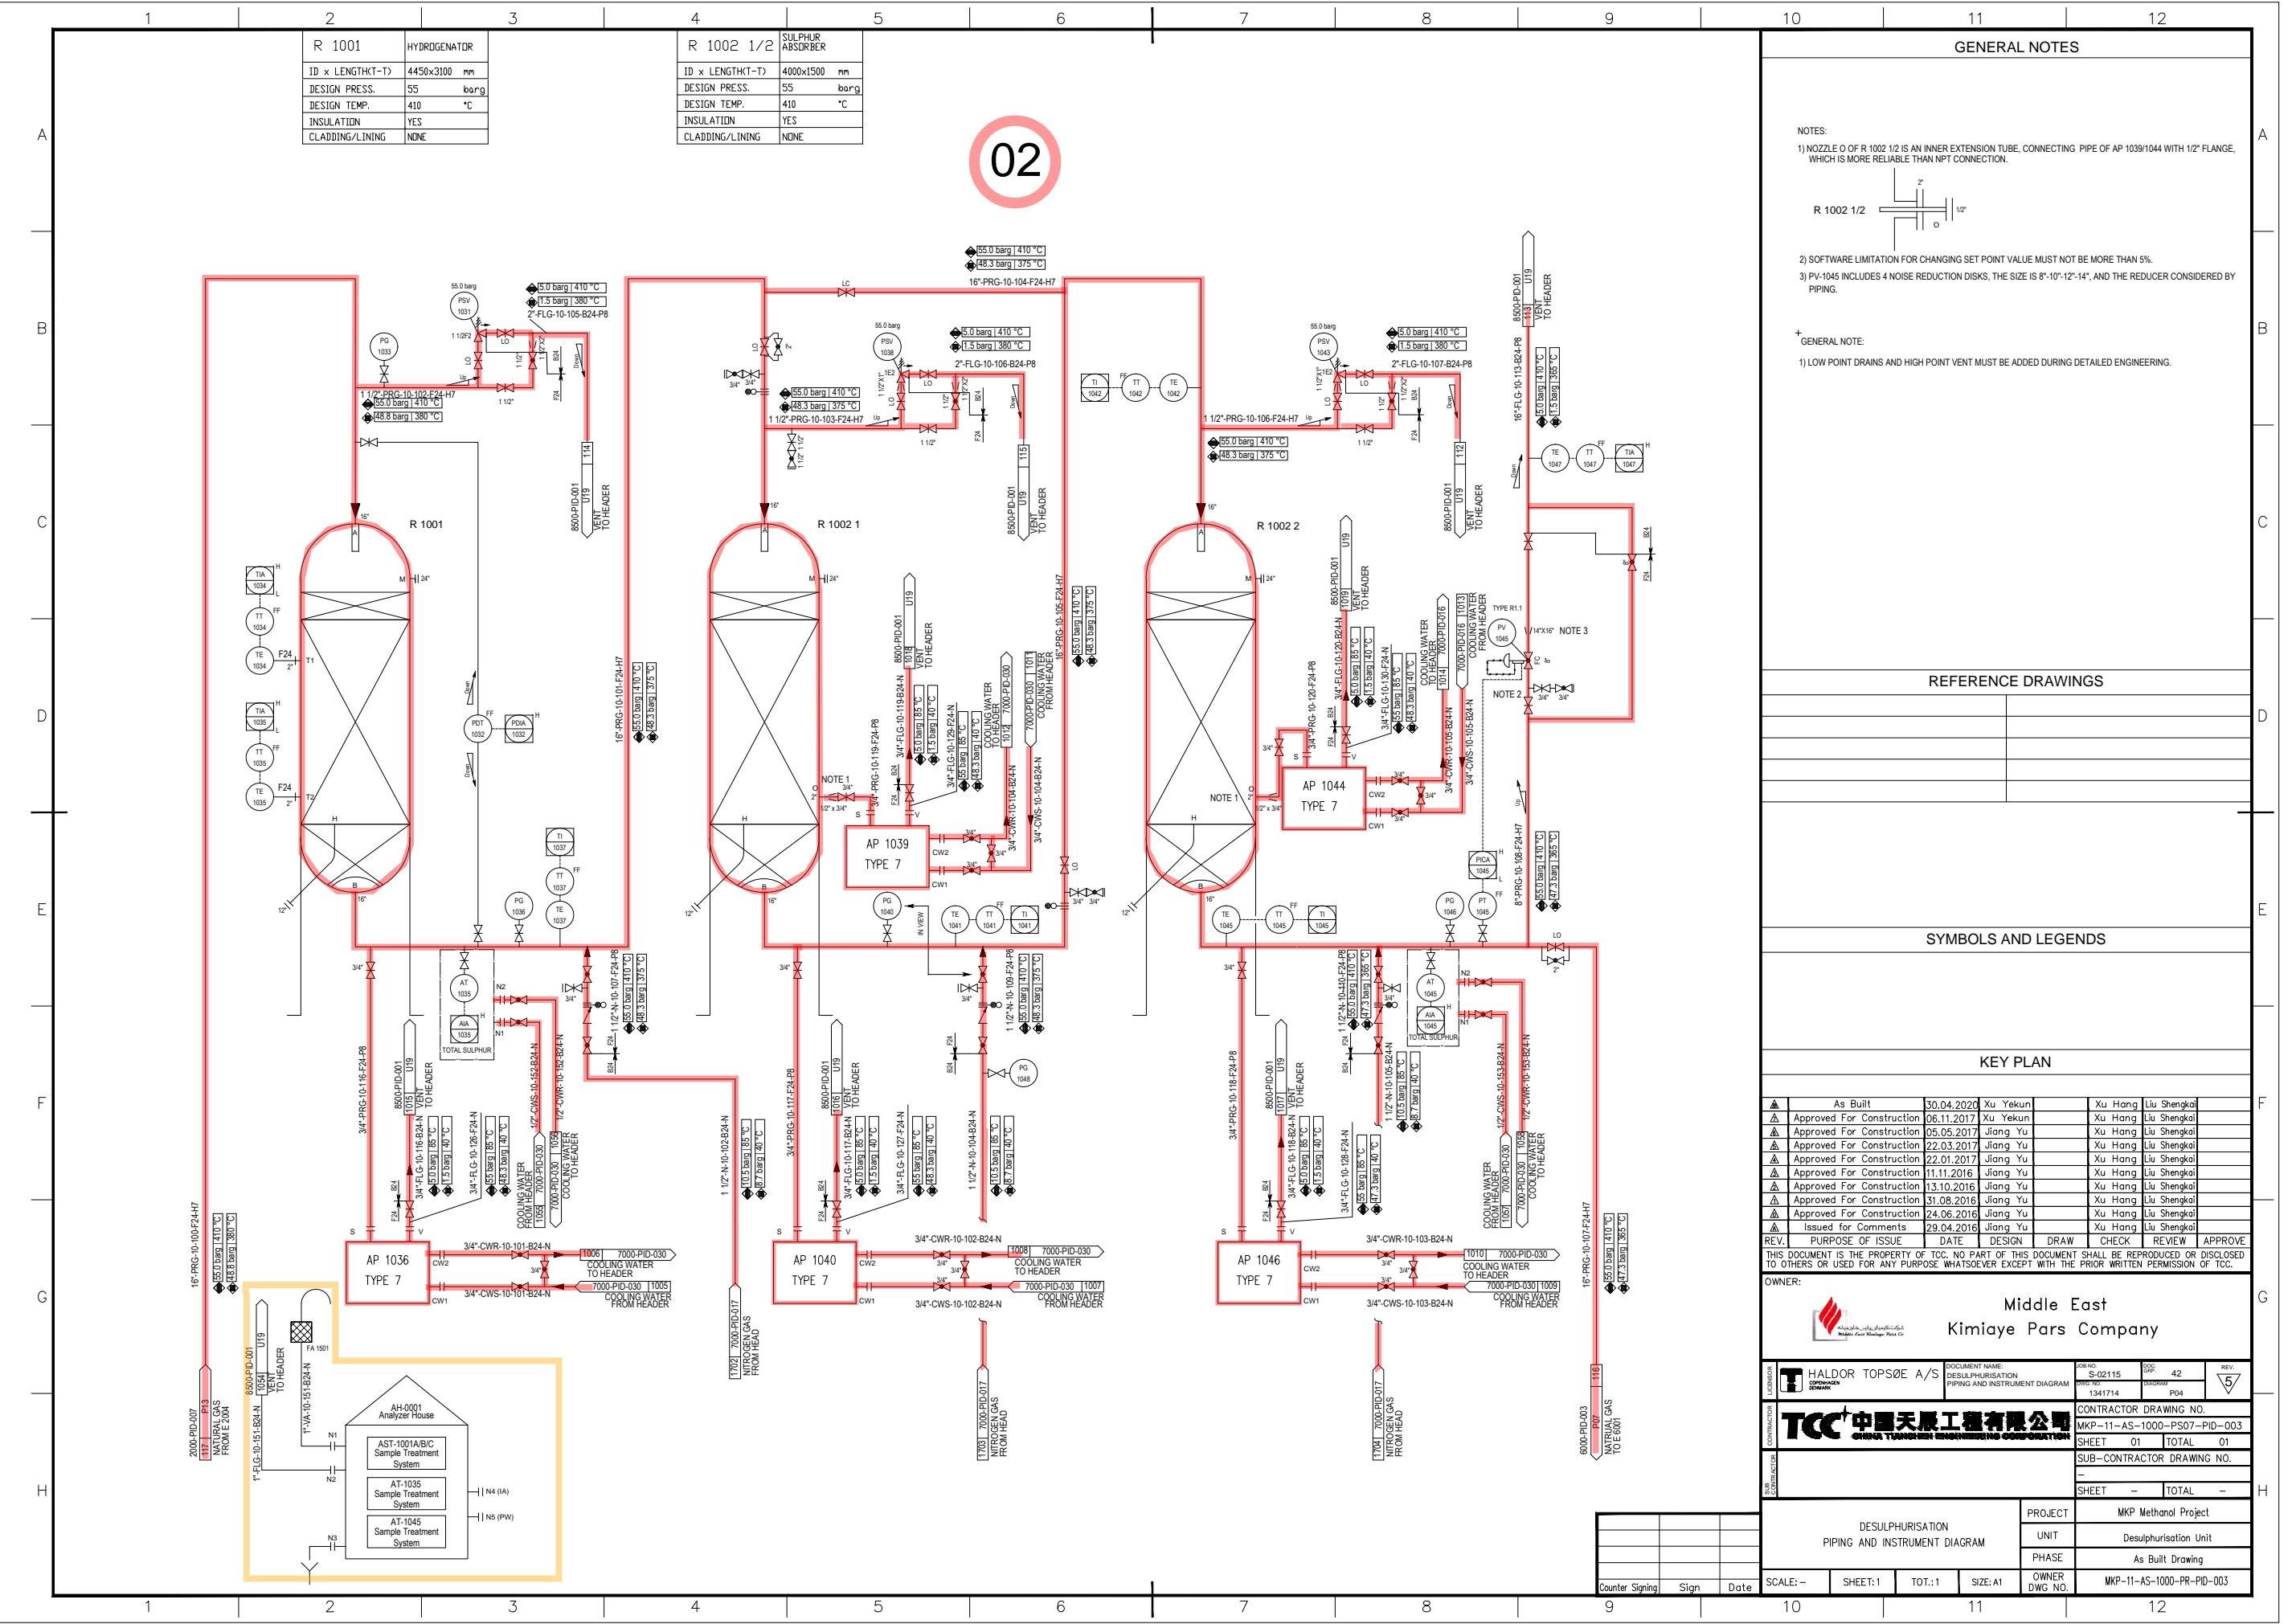


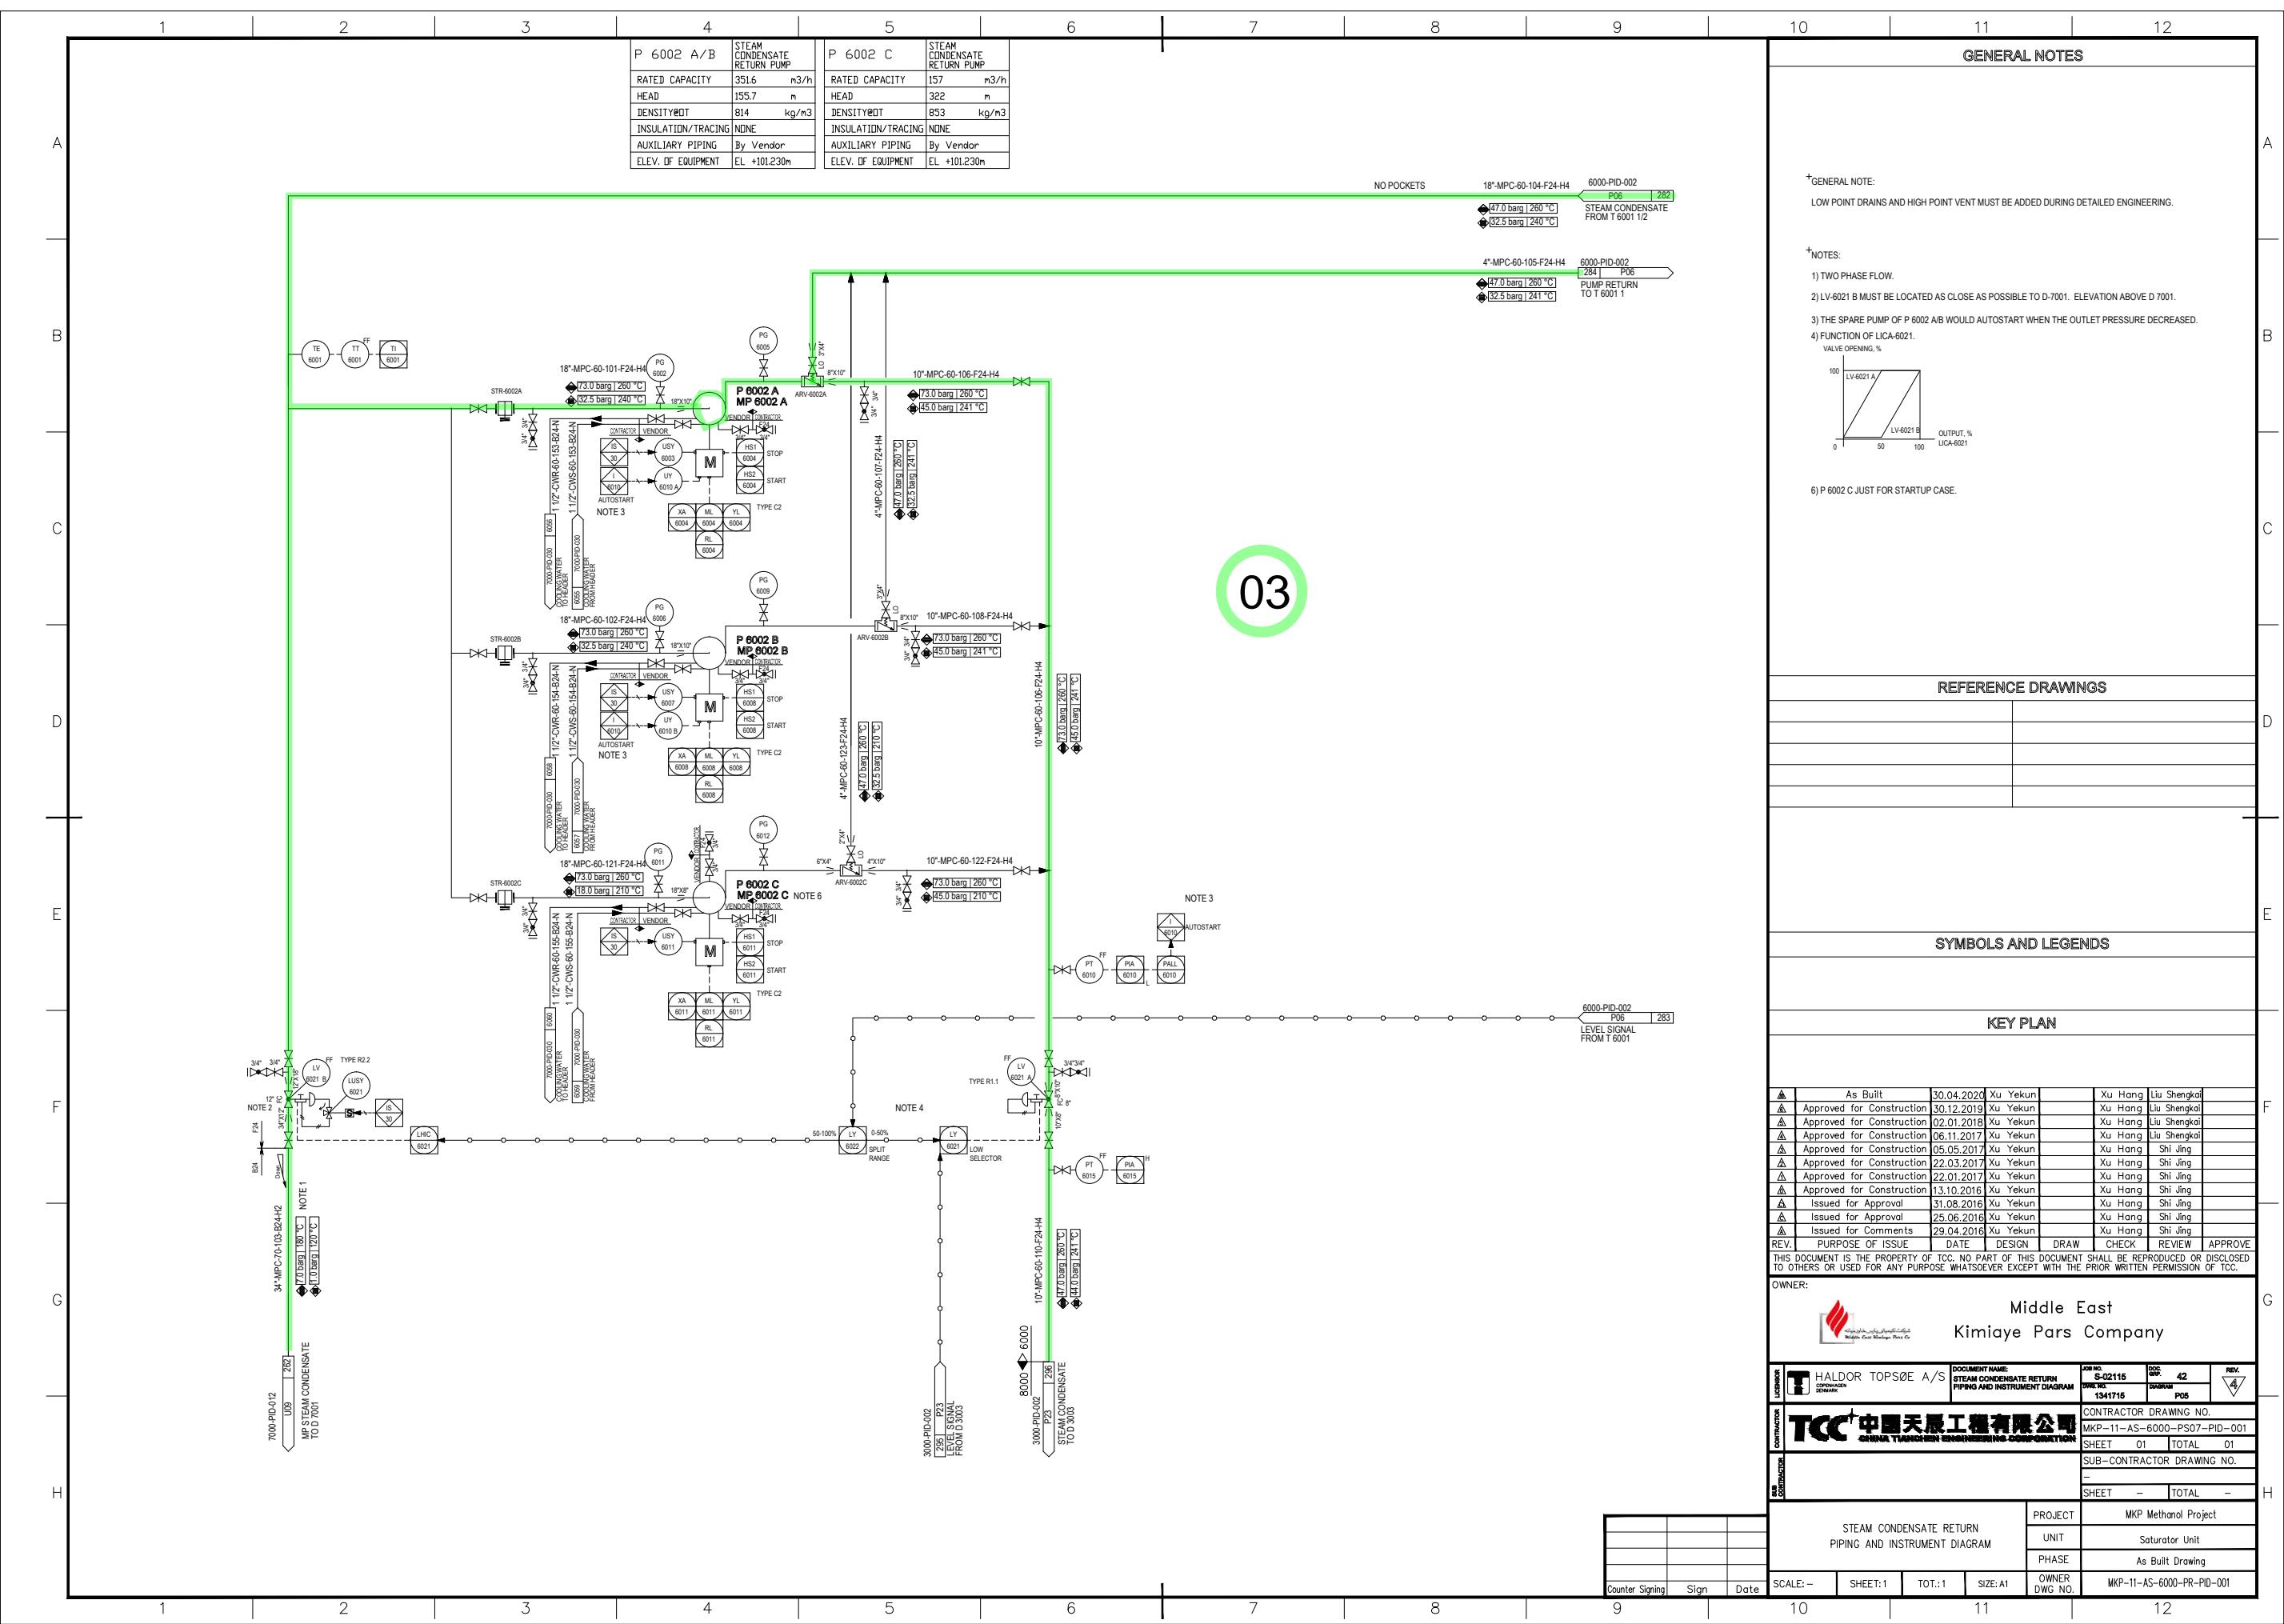



03

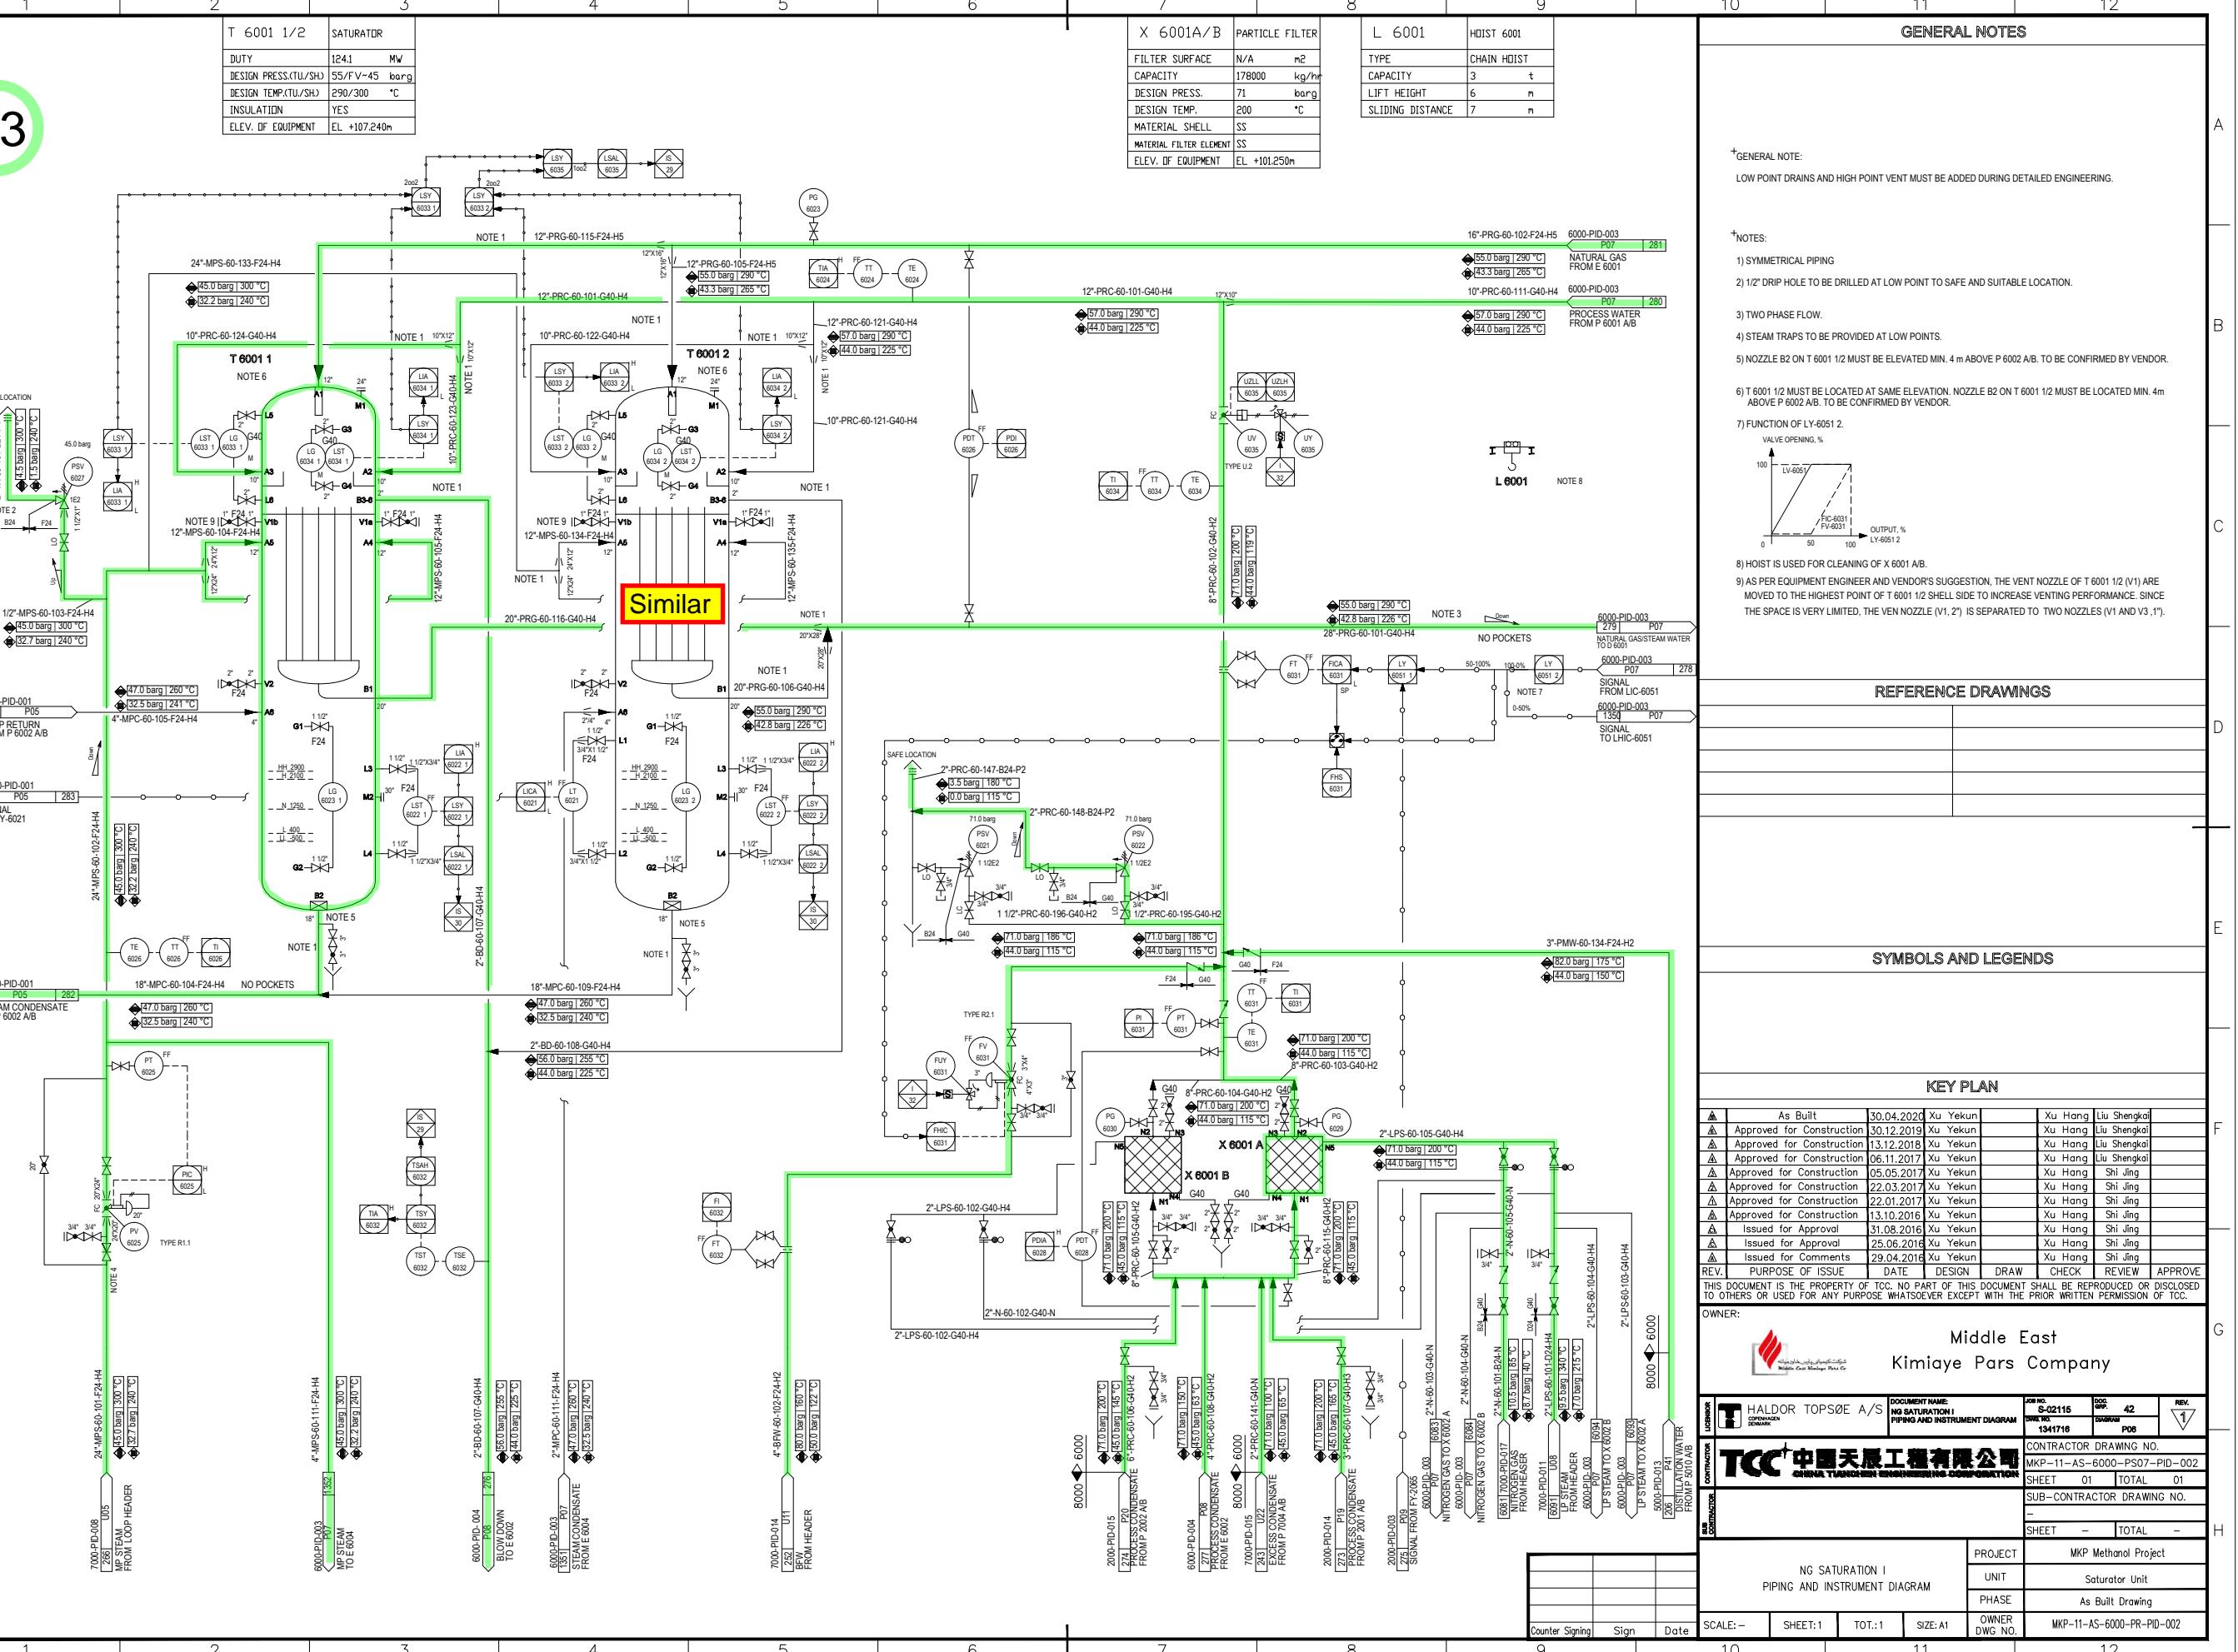

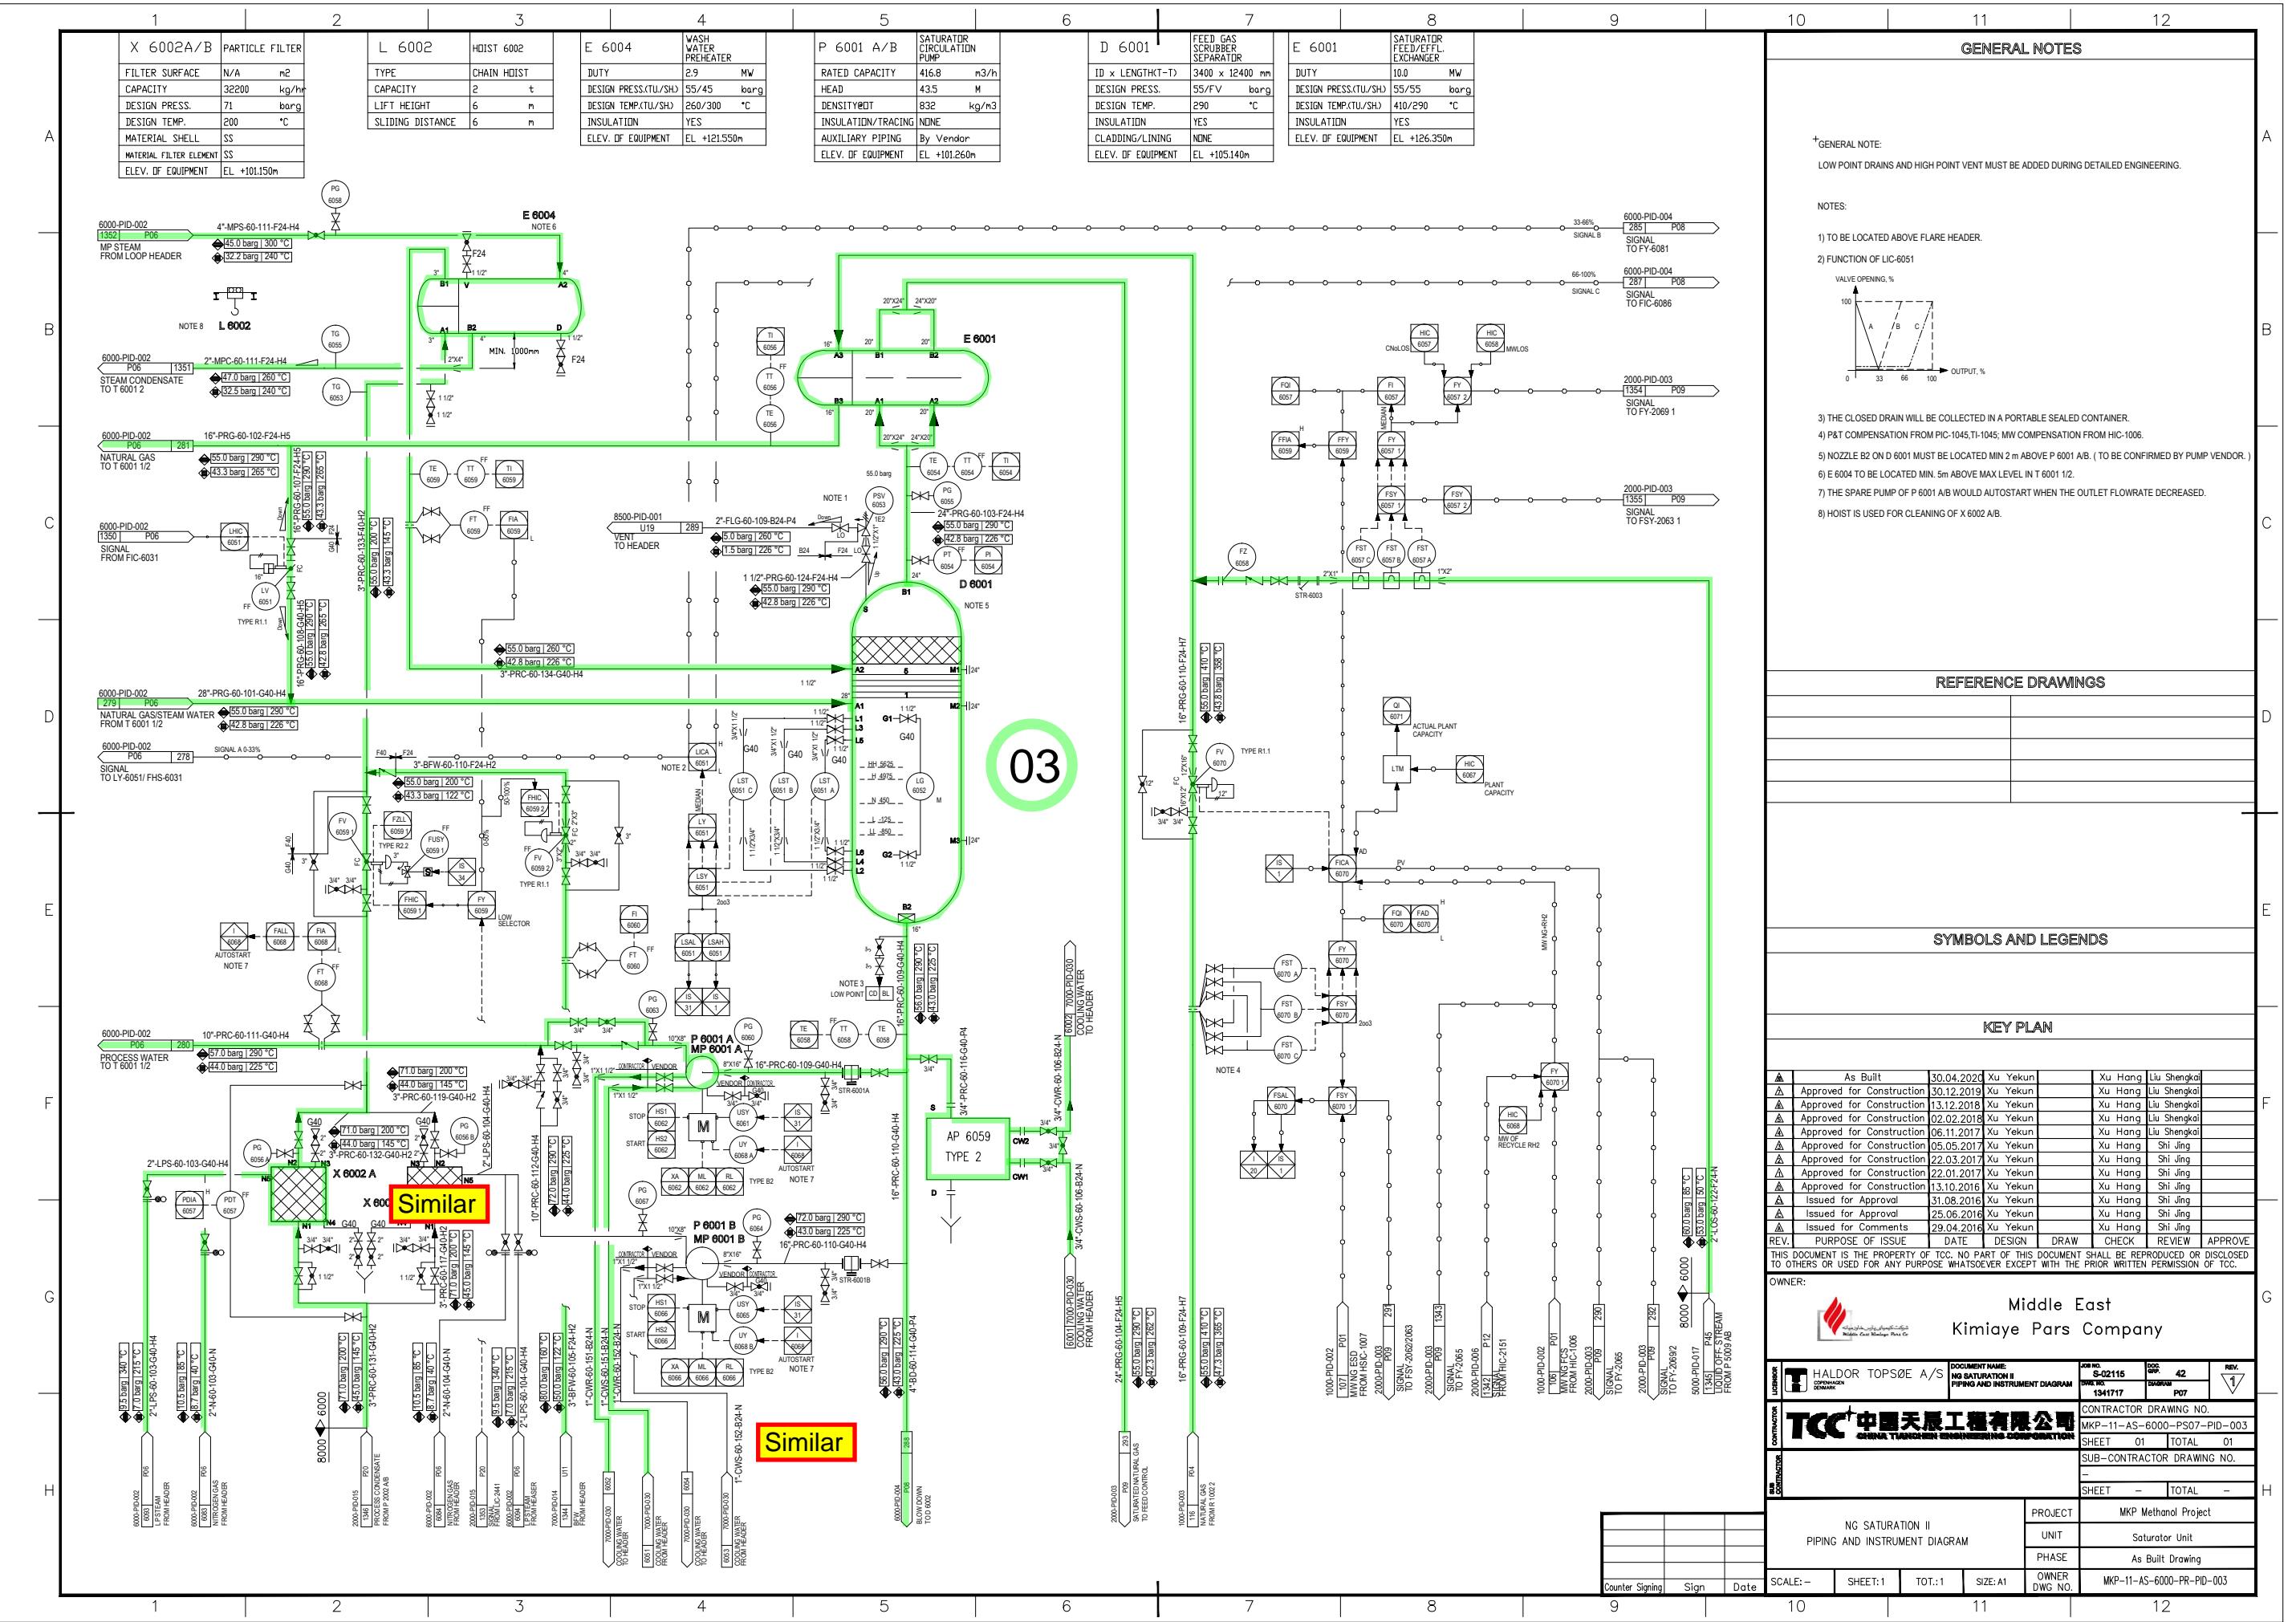

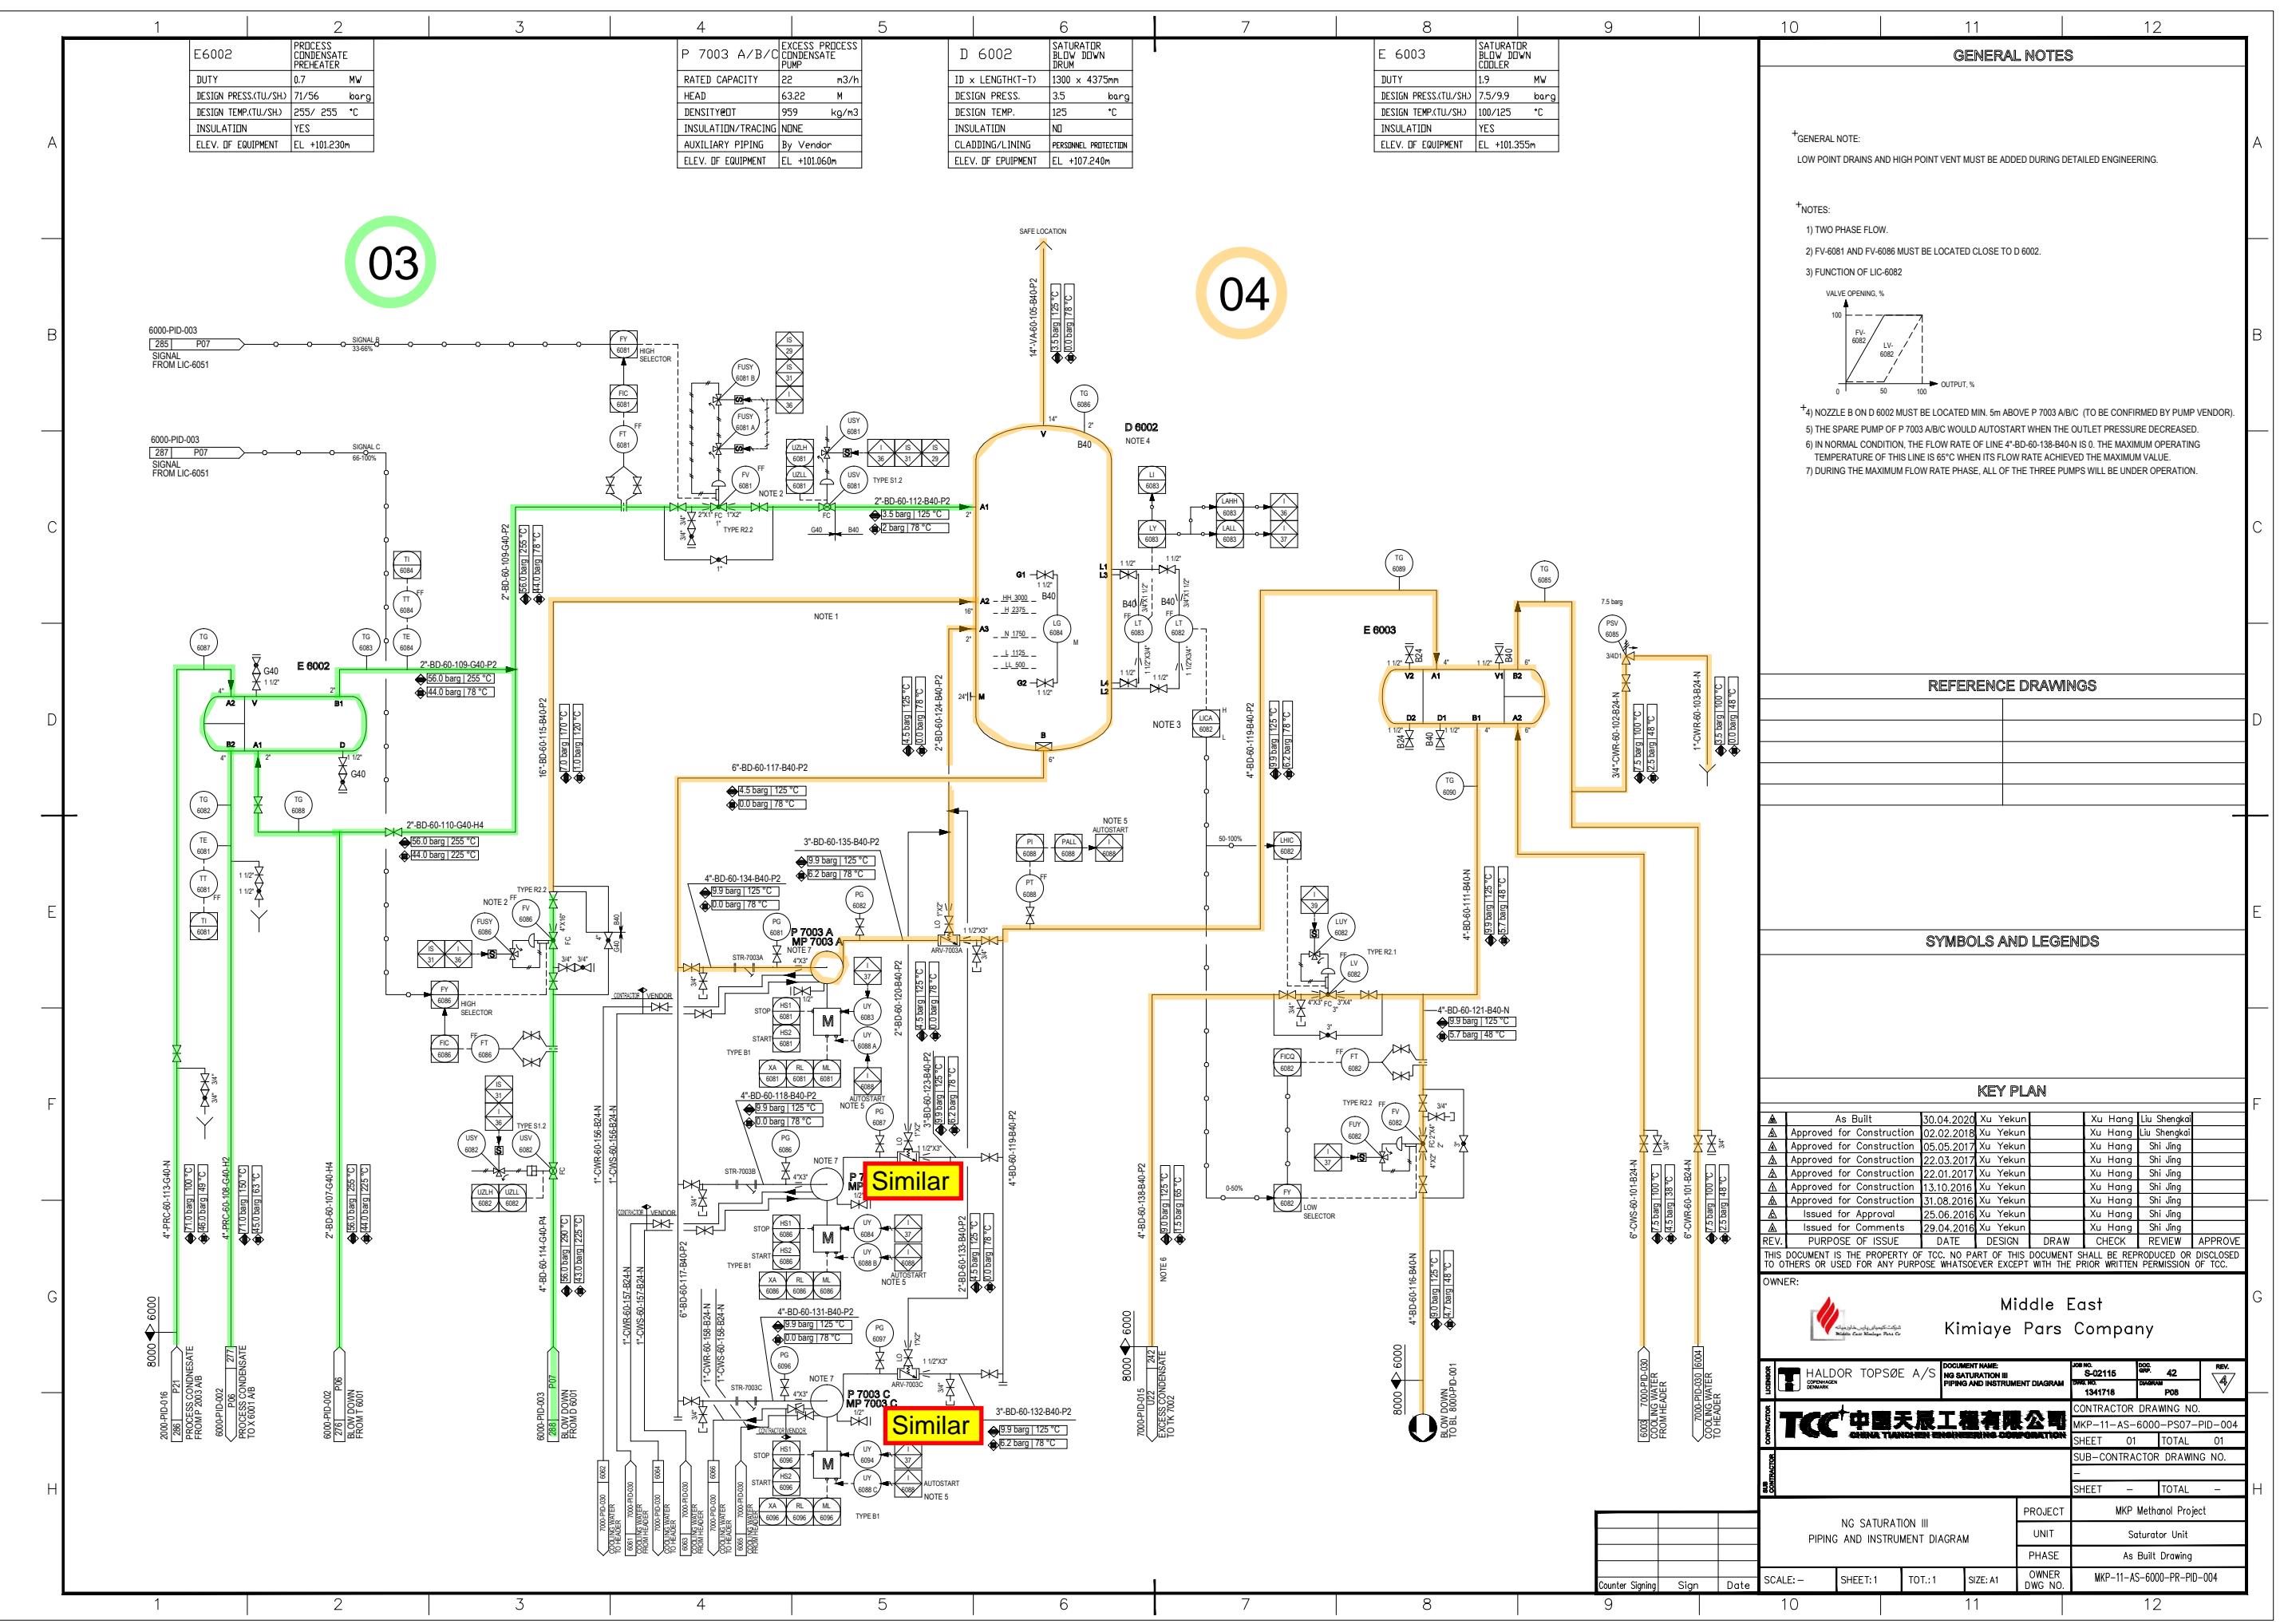


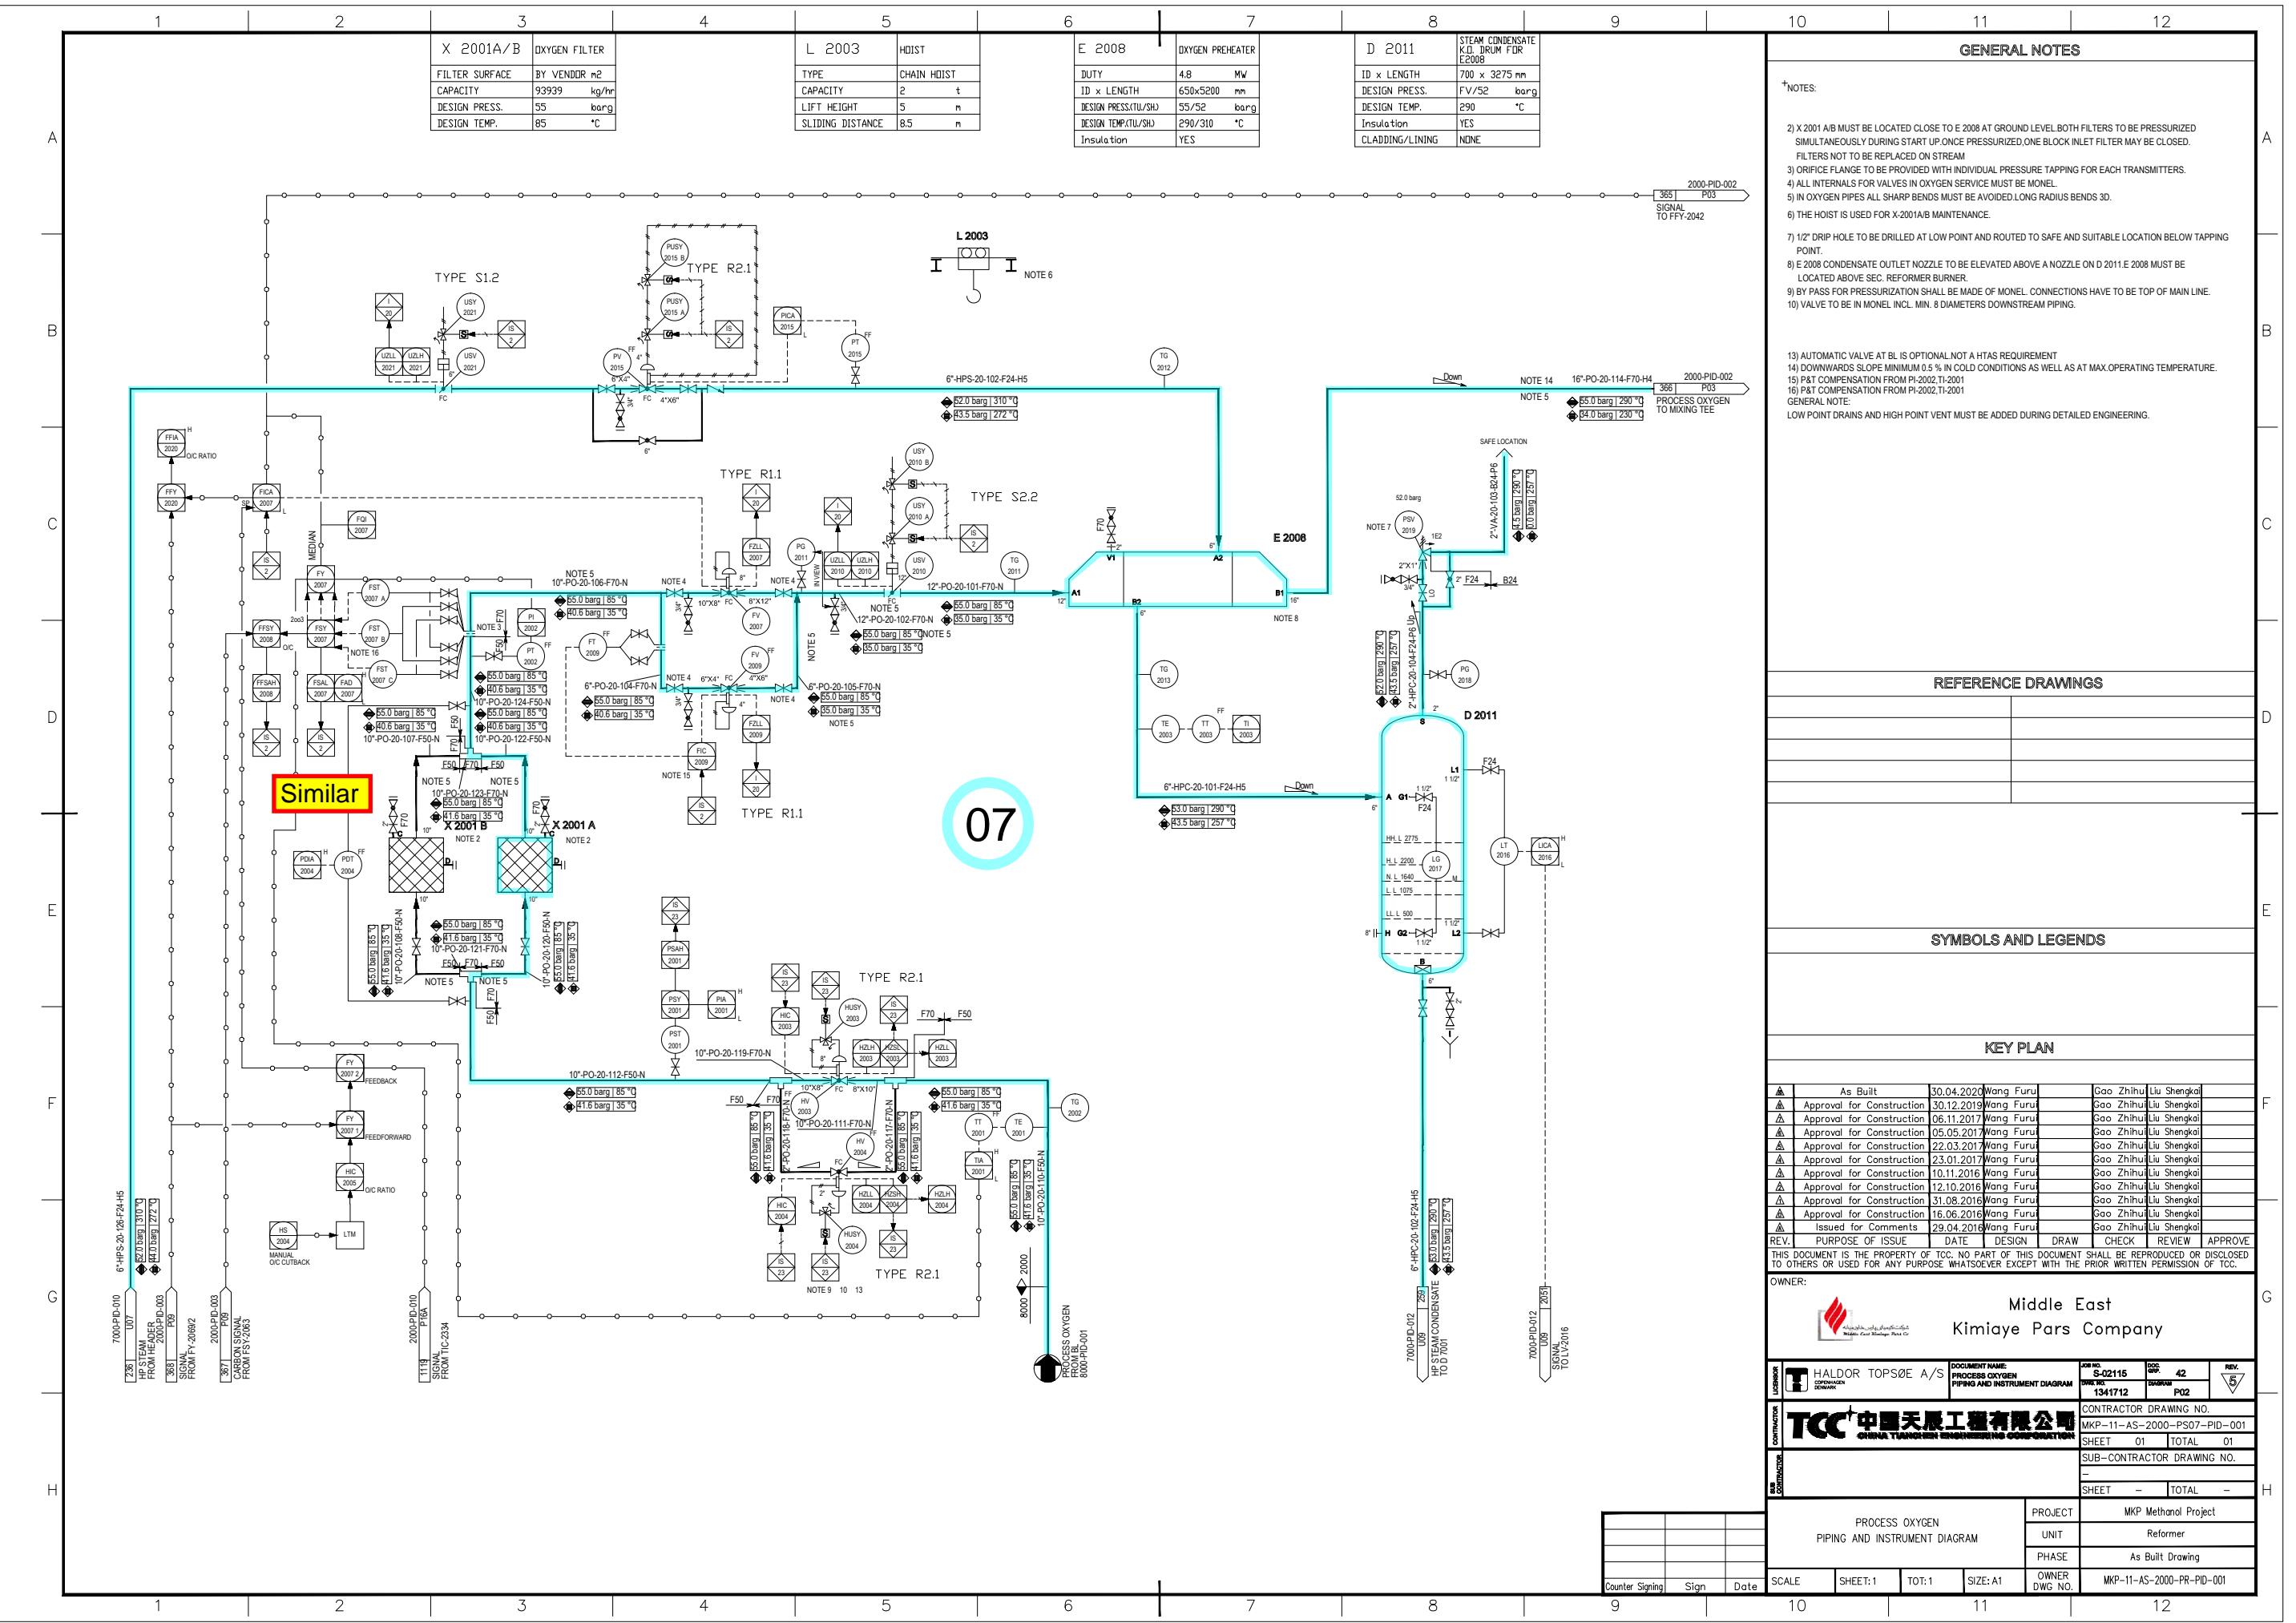


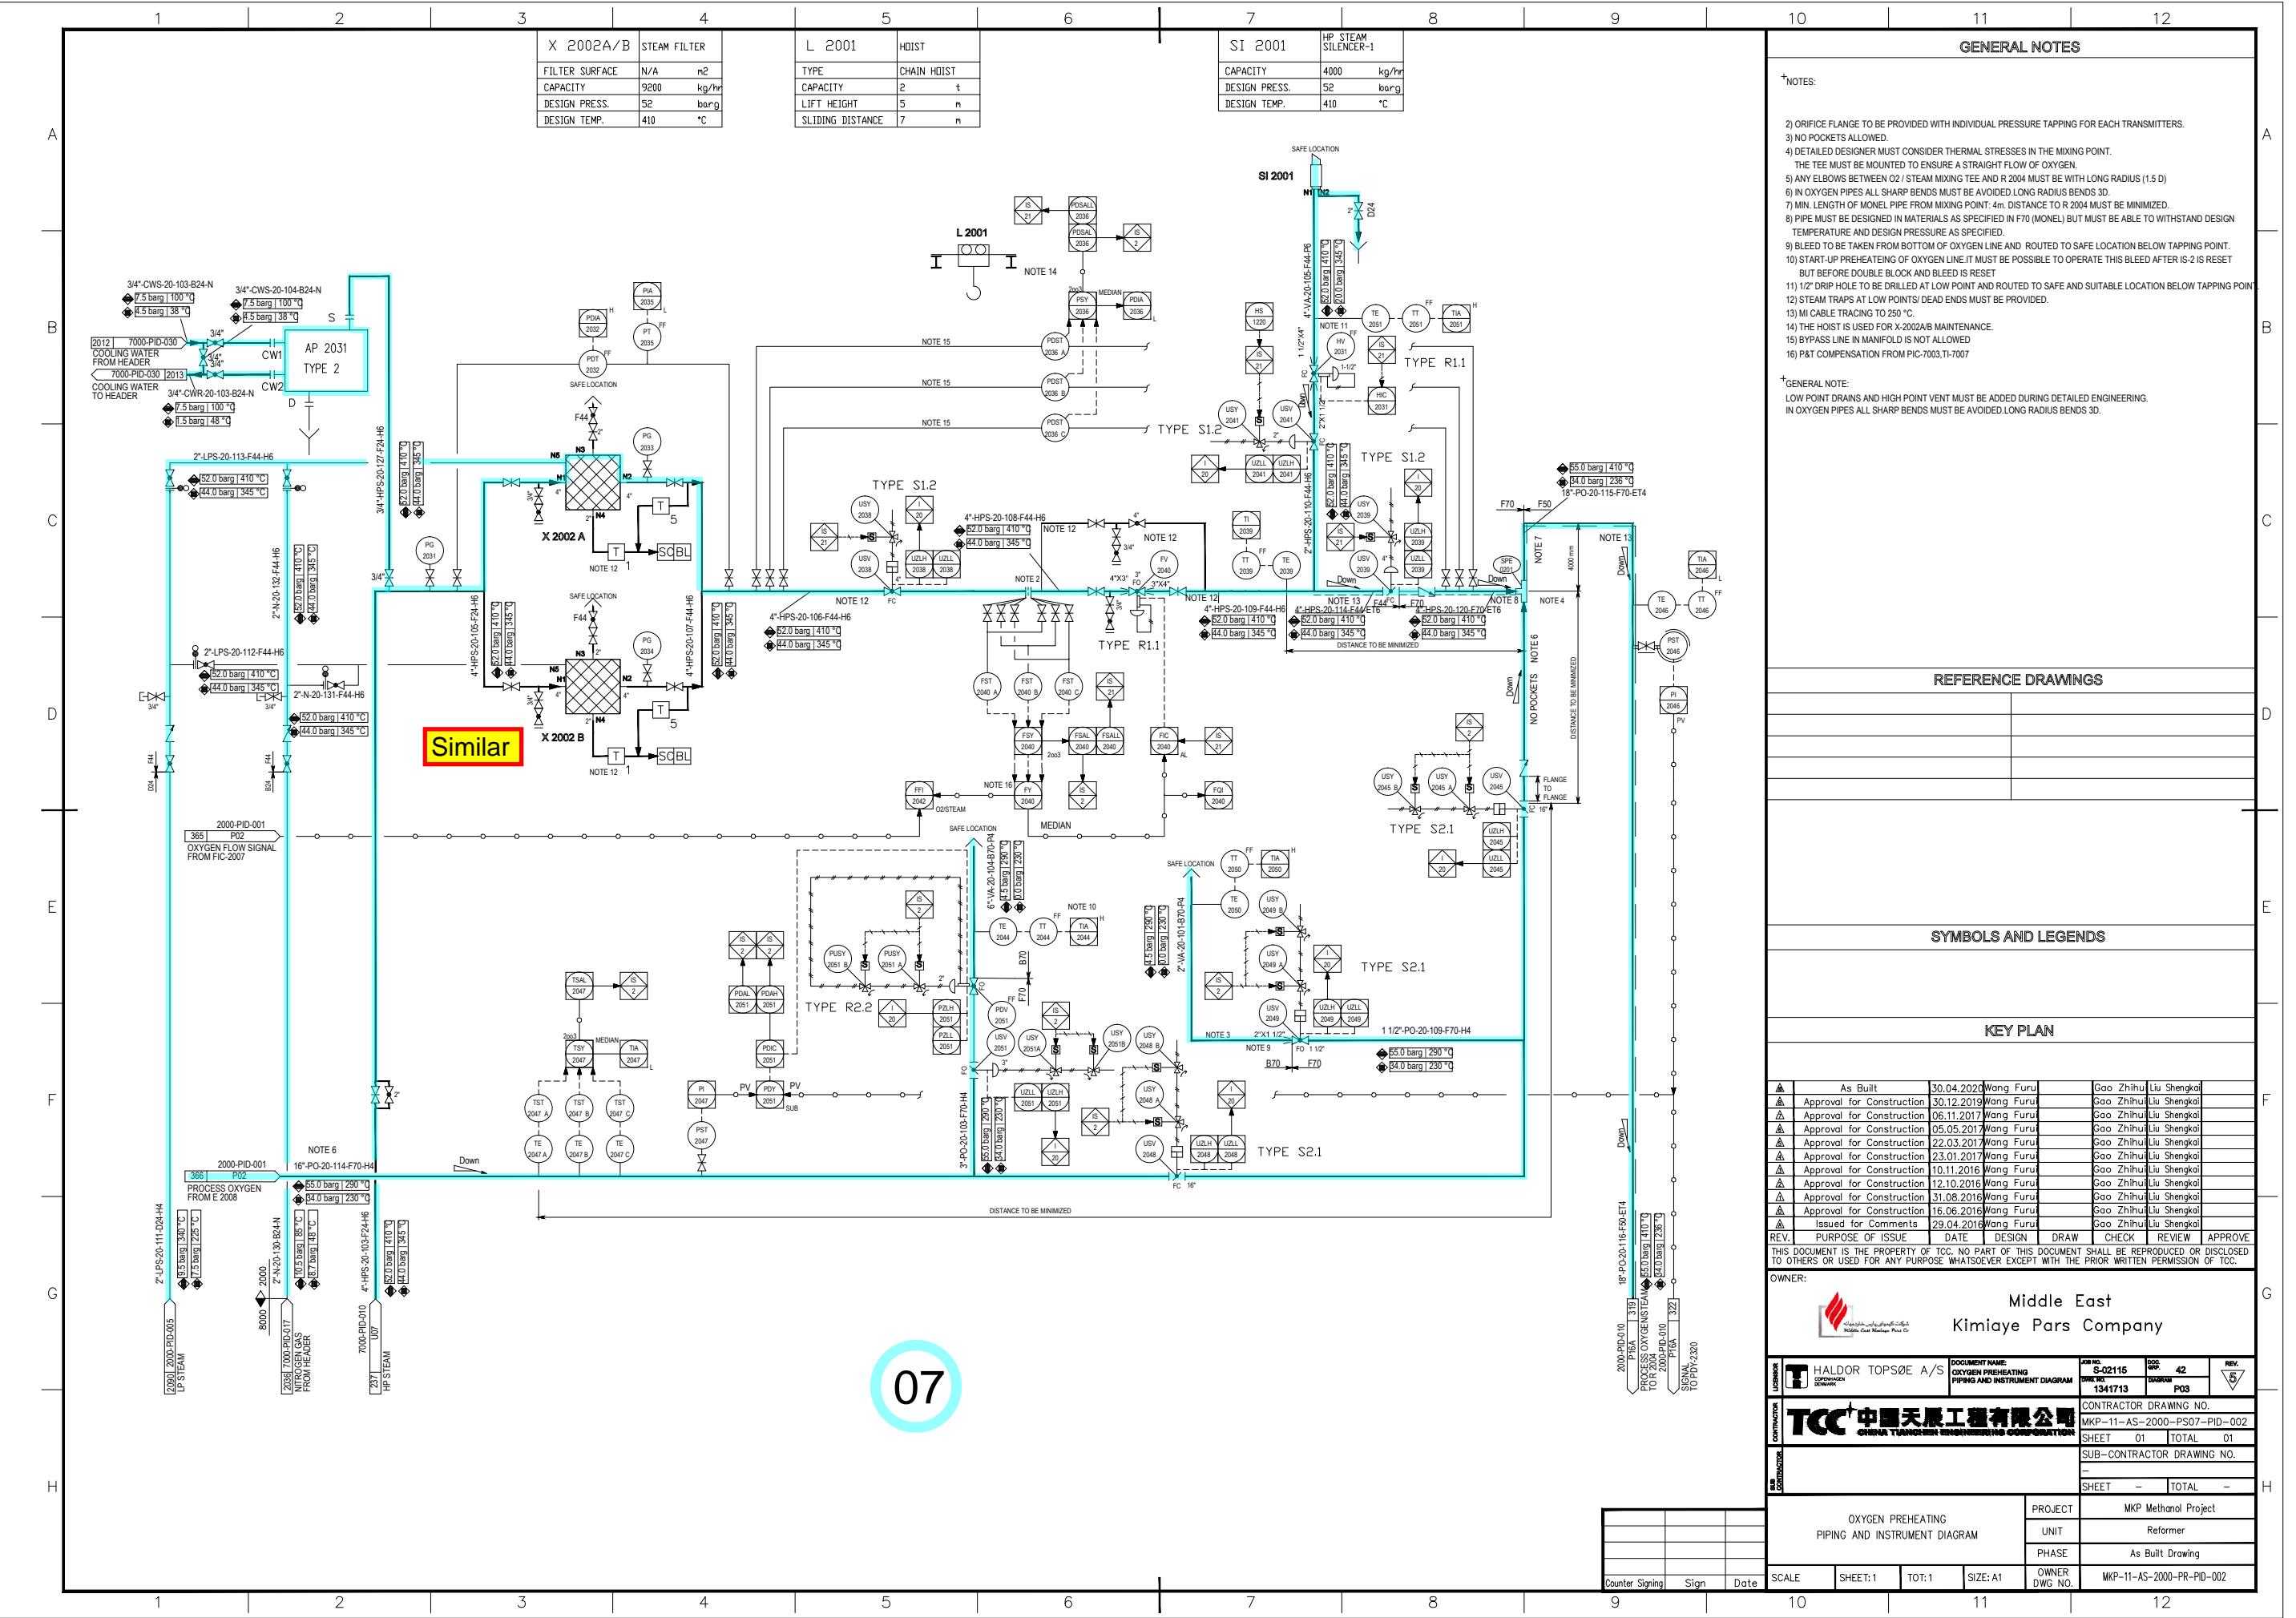



07


Page 12

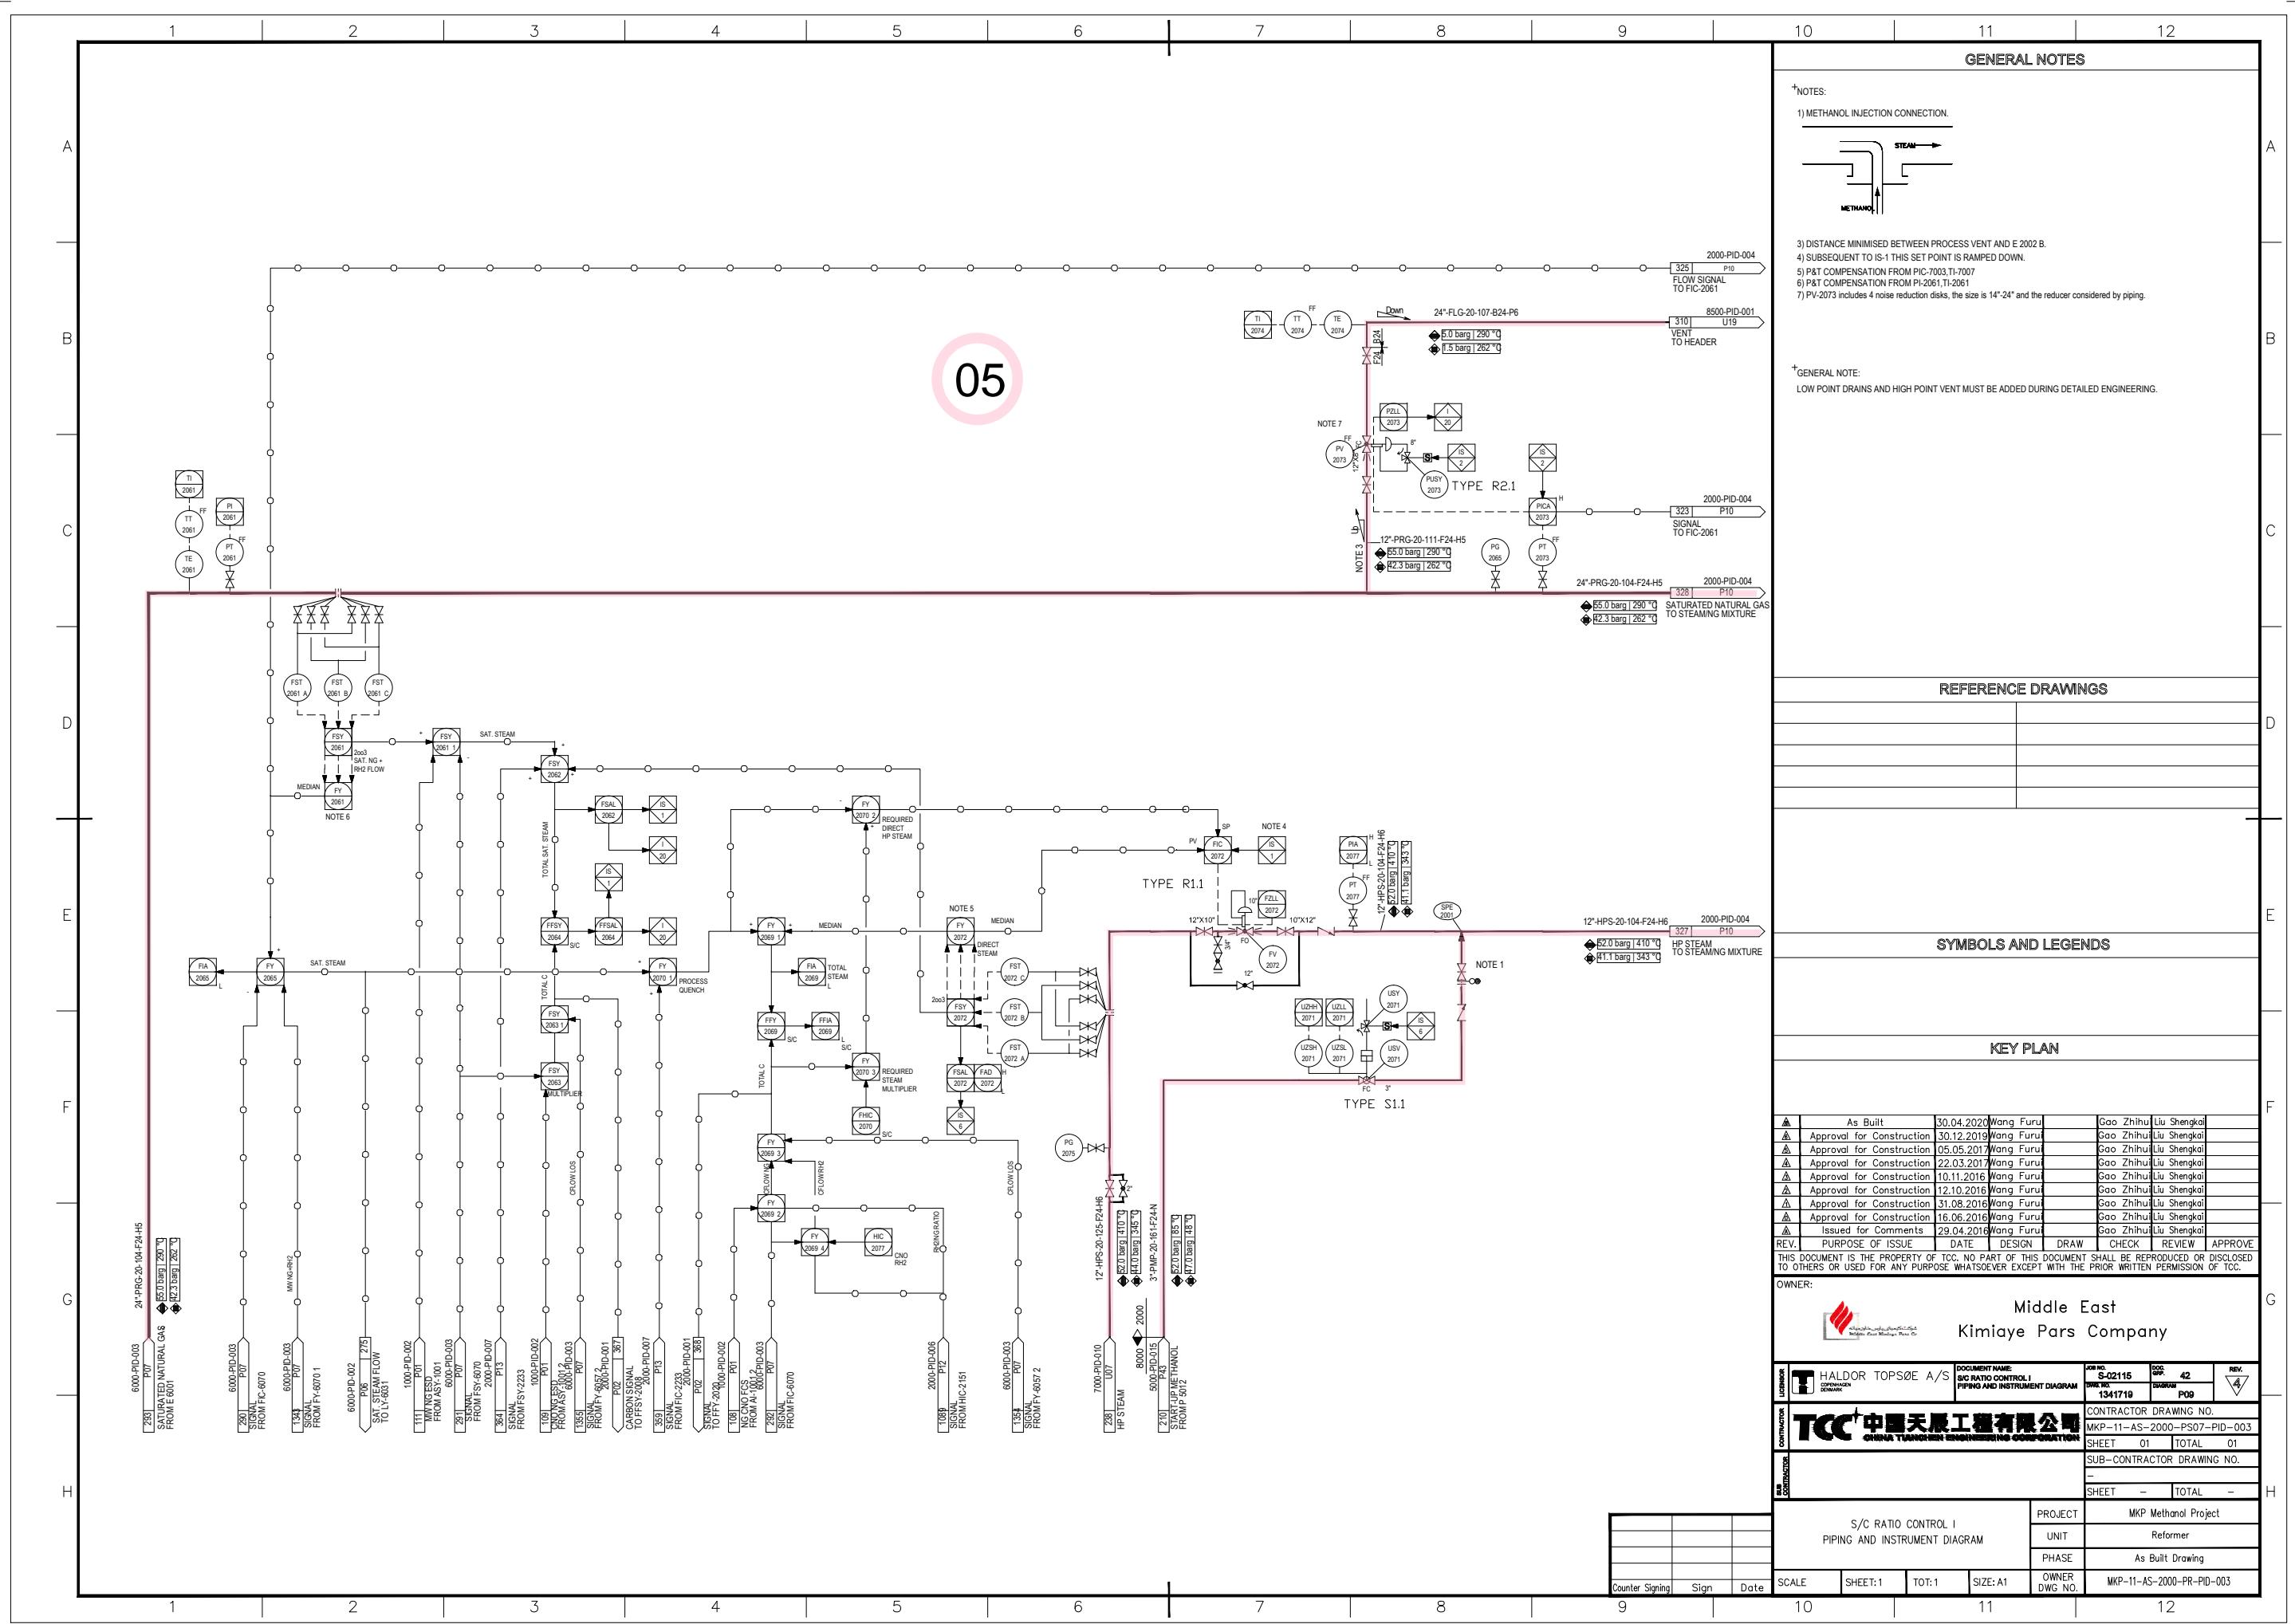


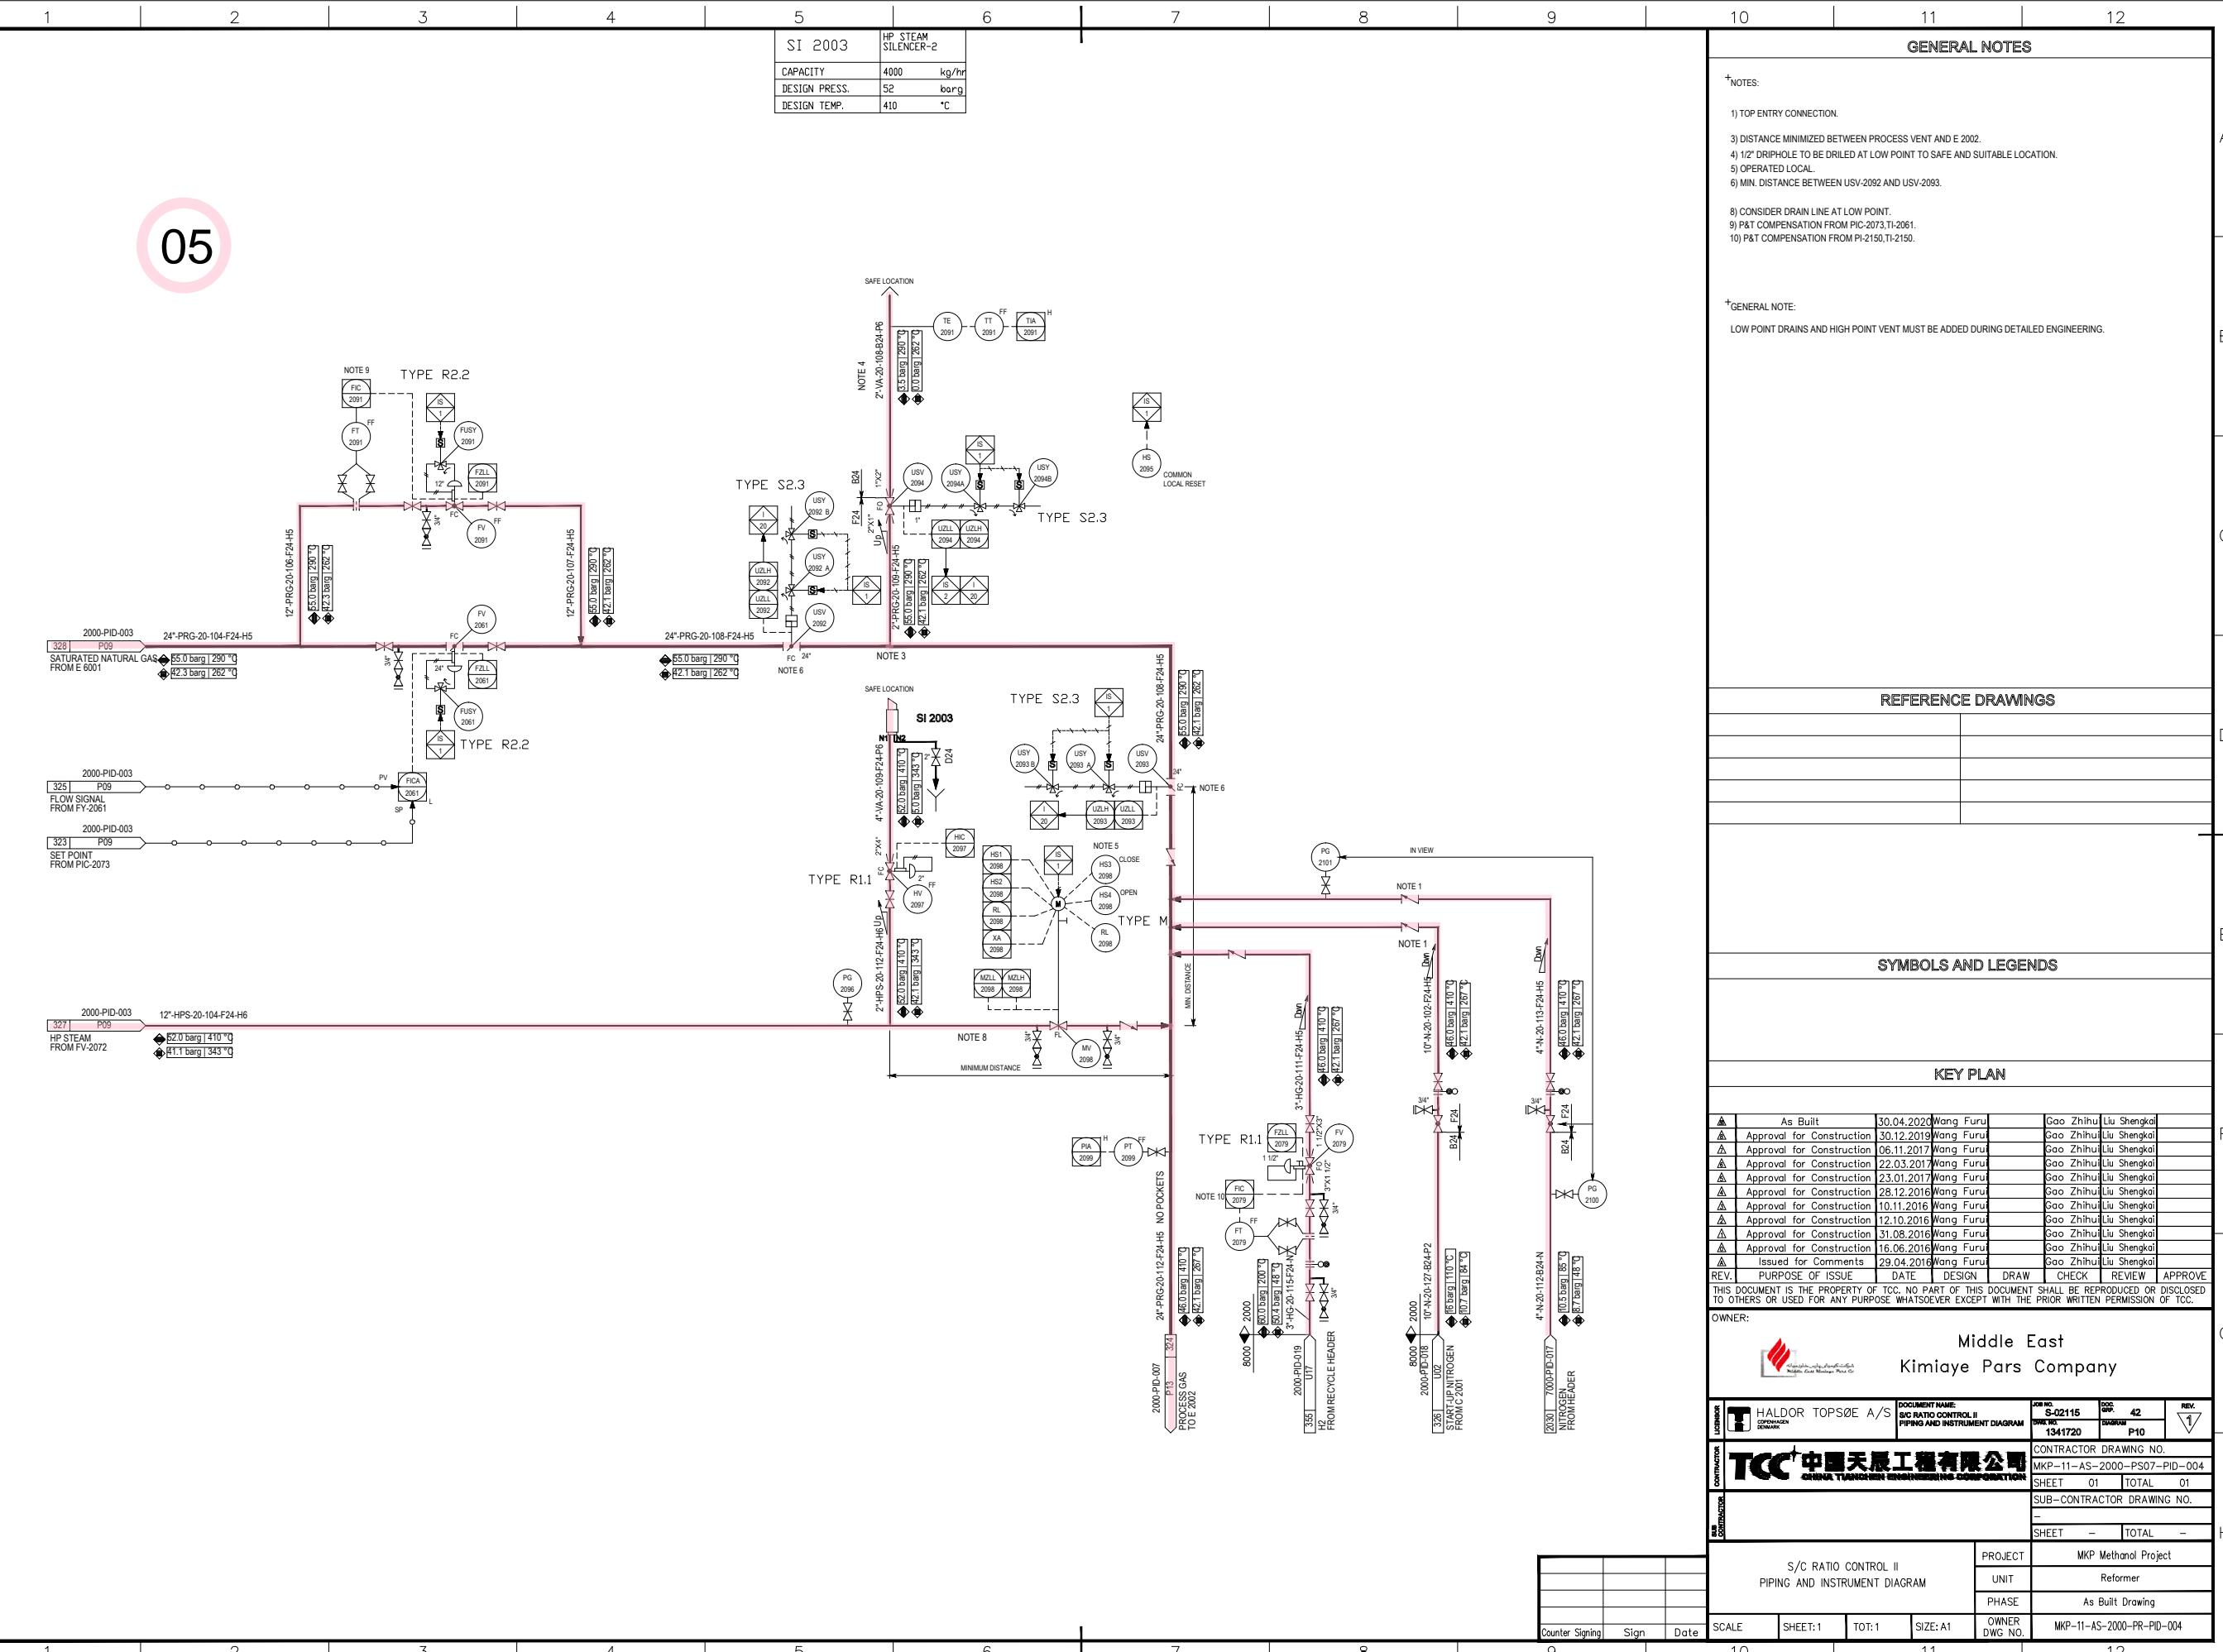


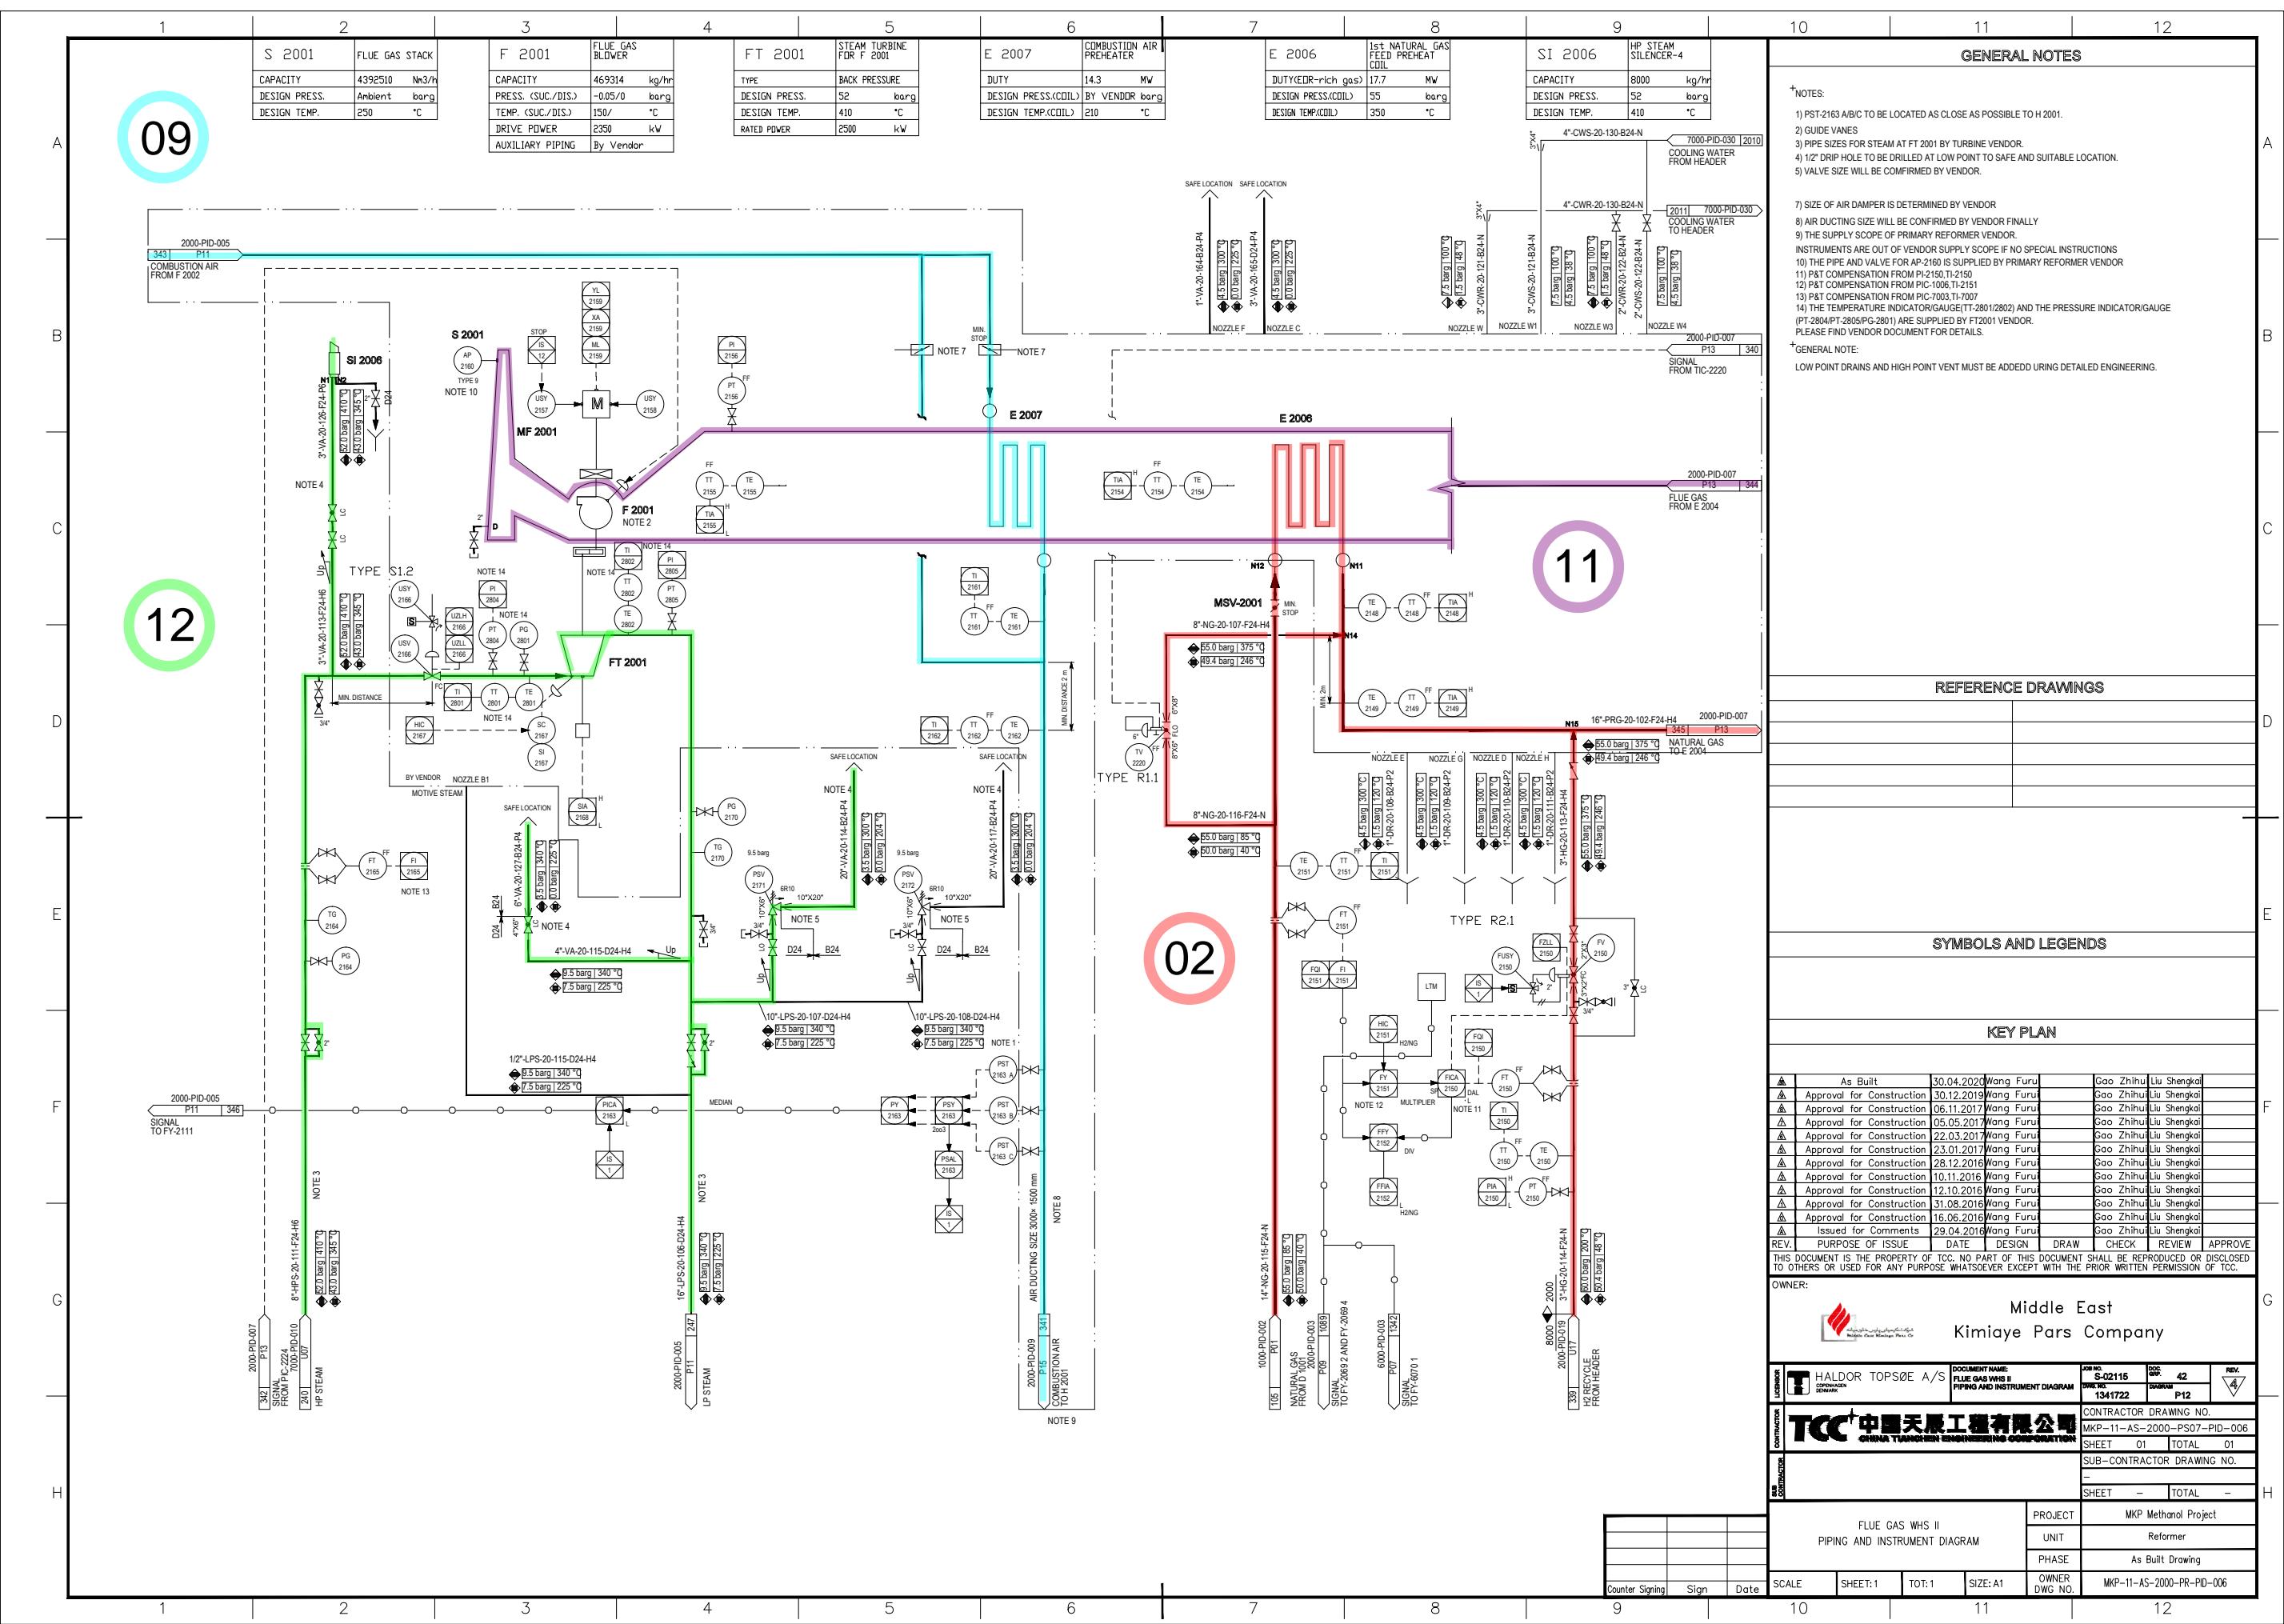


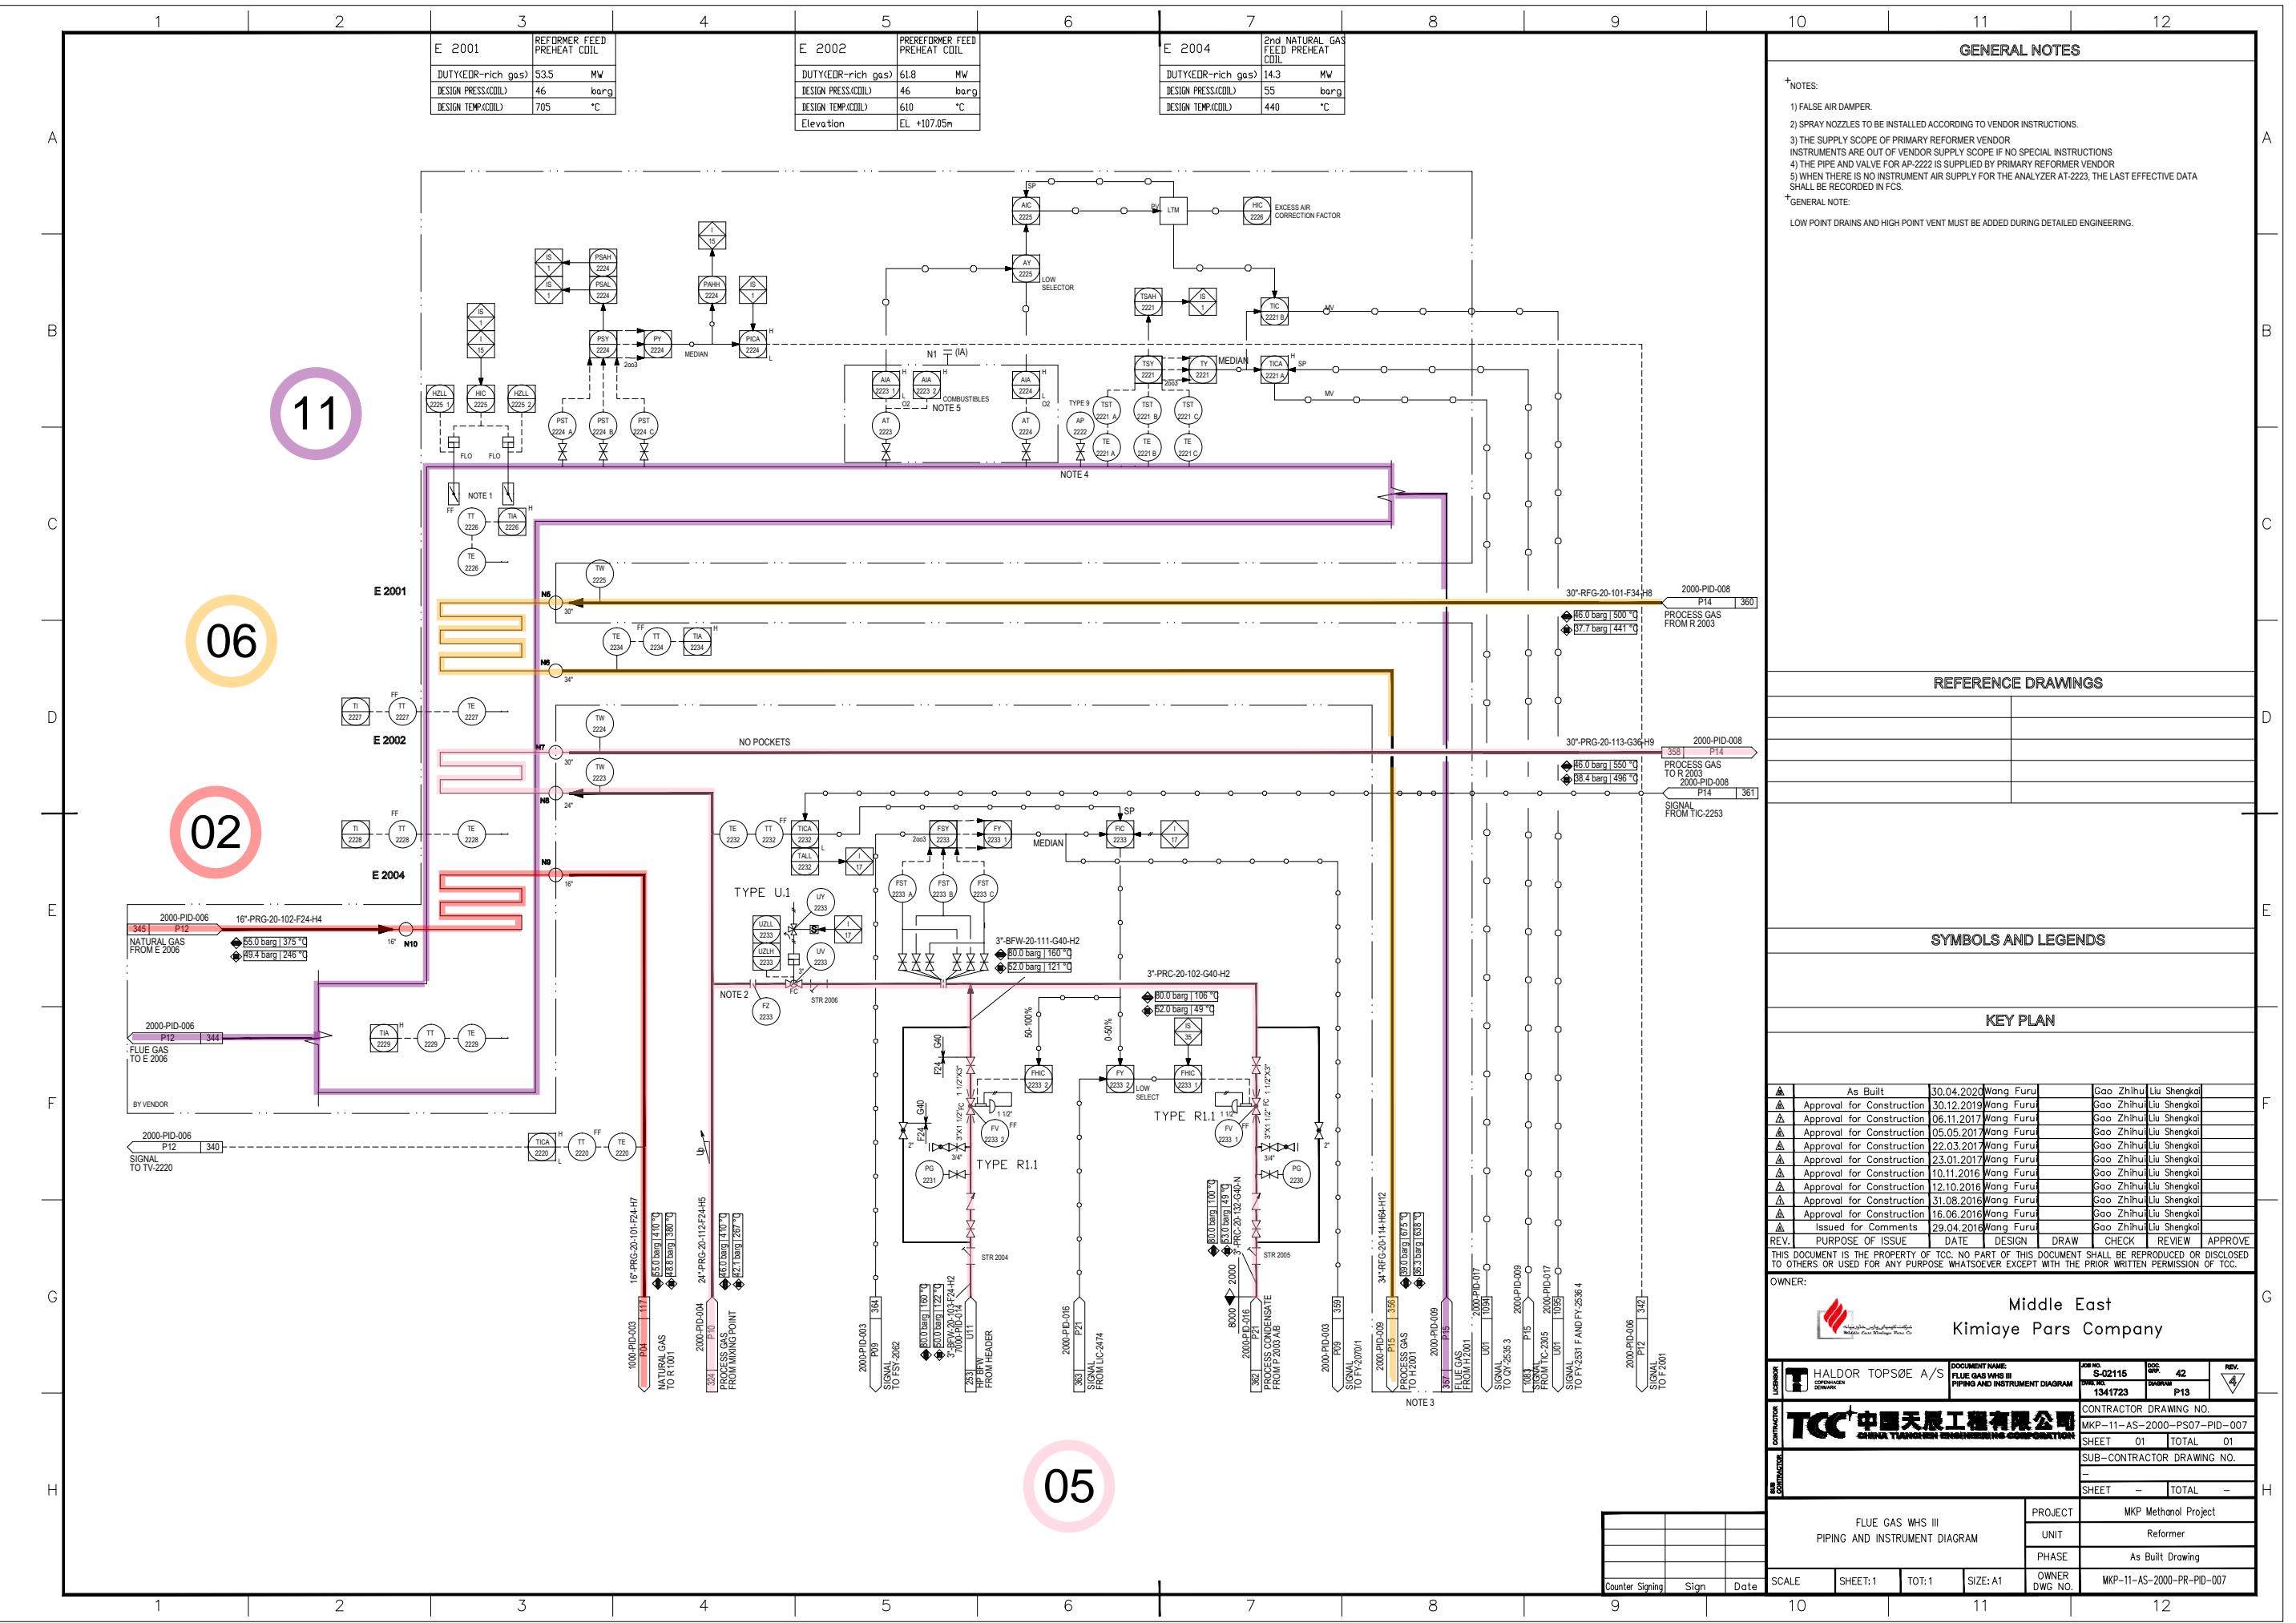


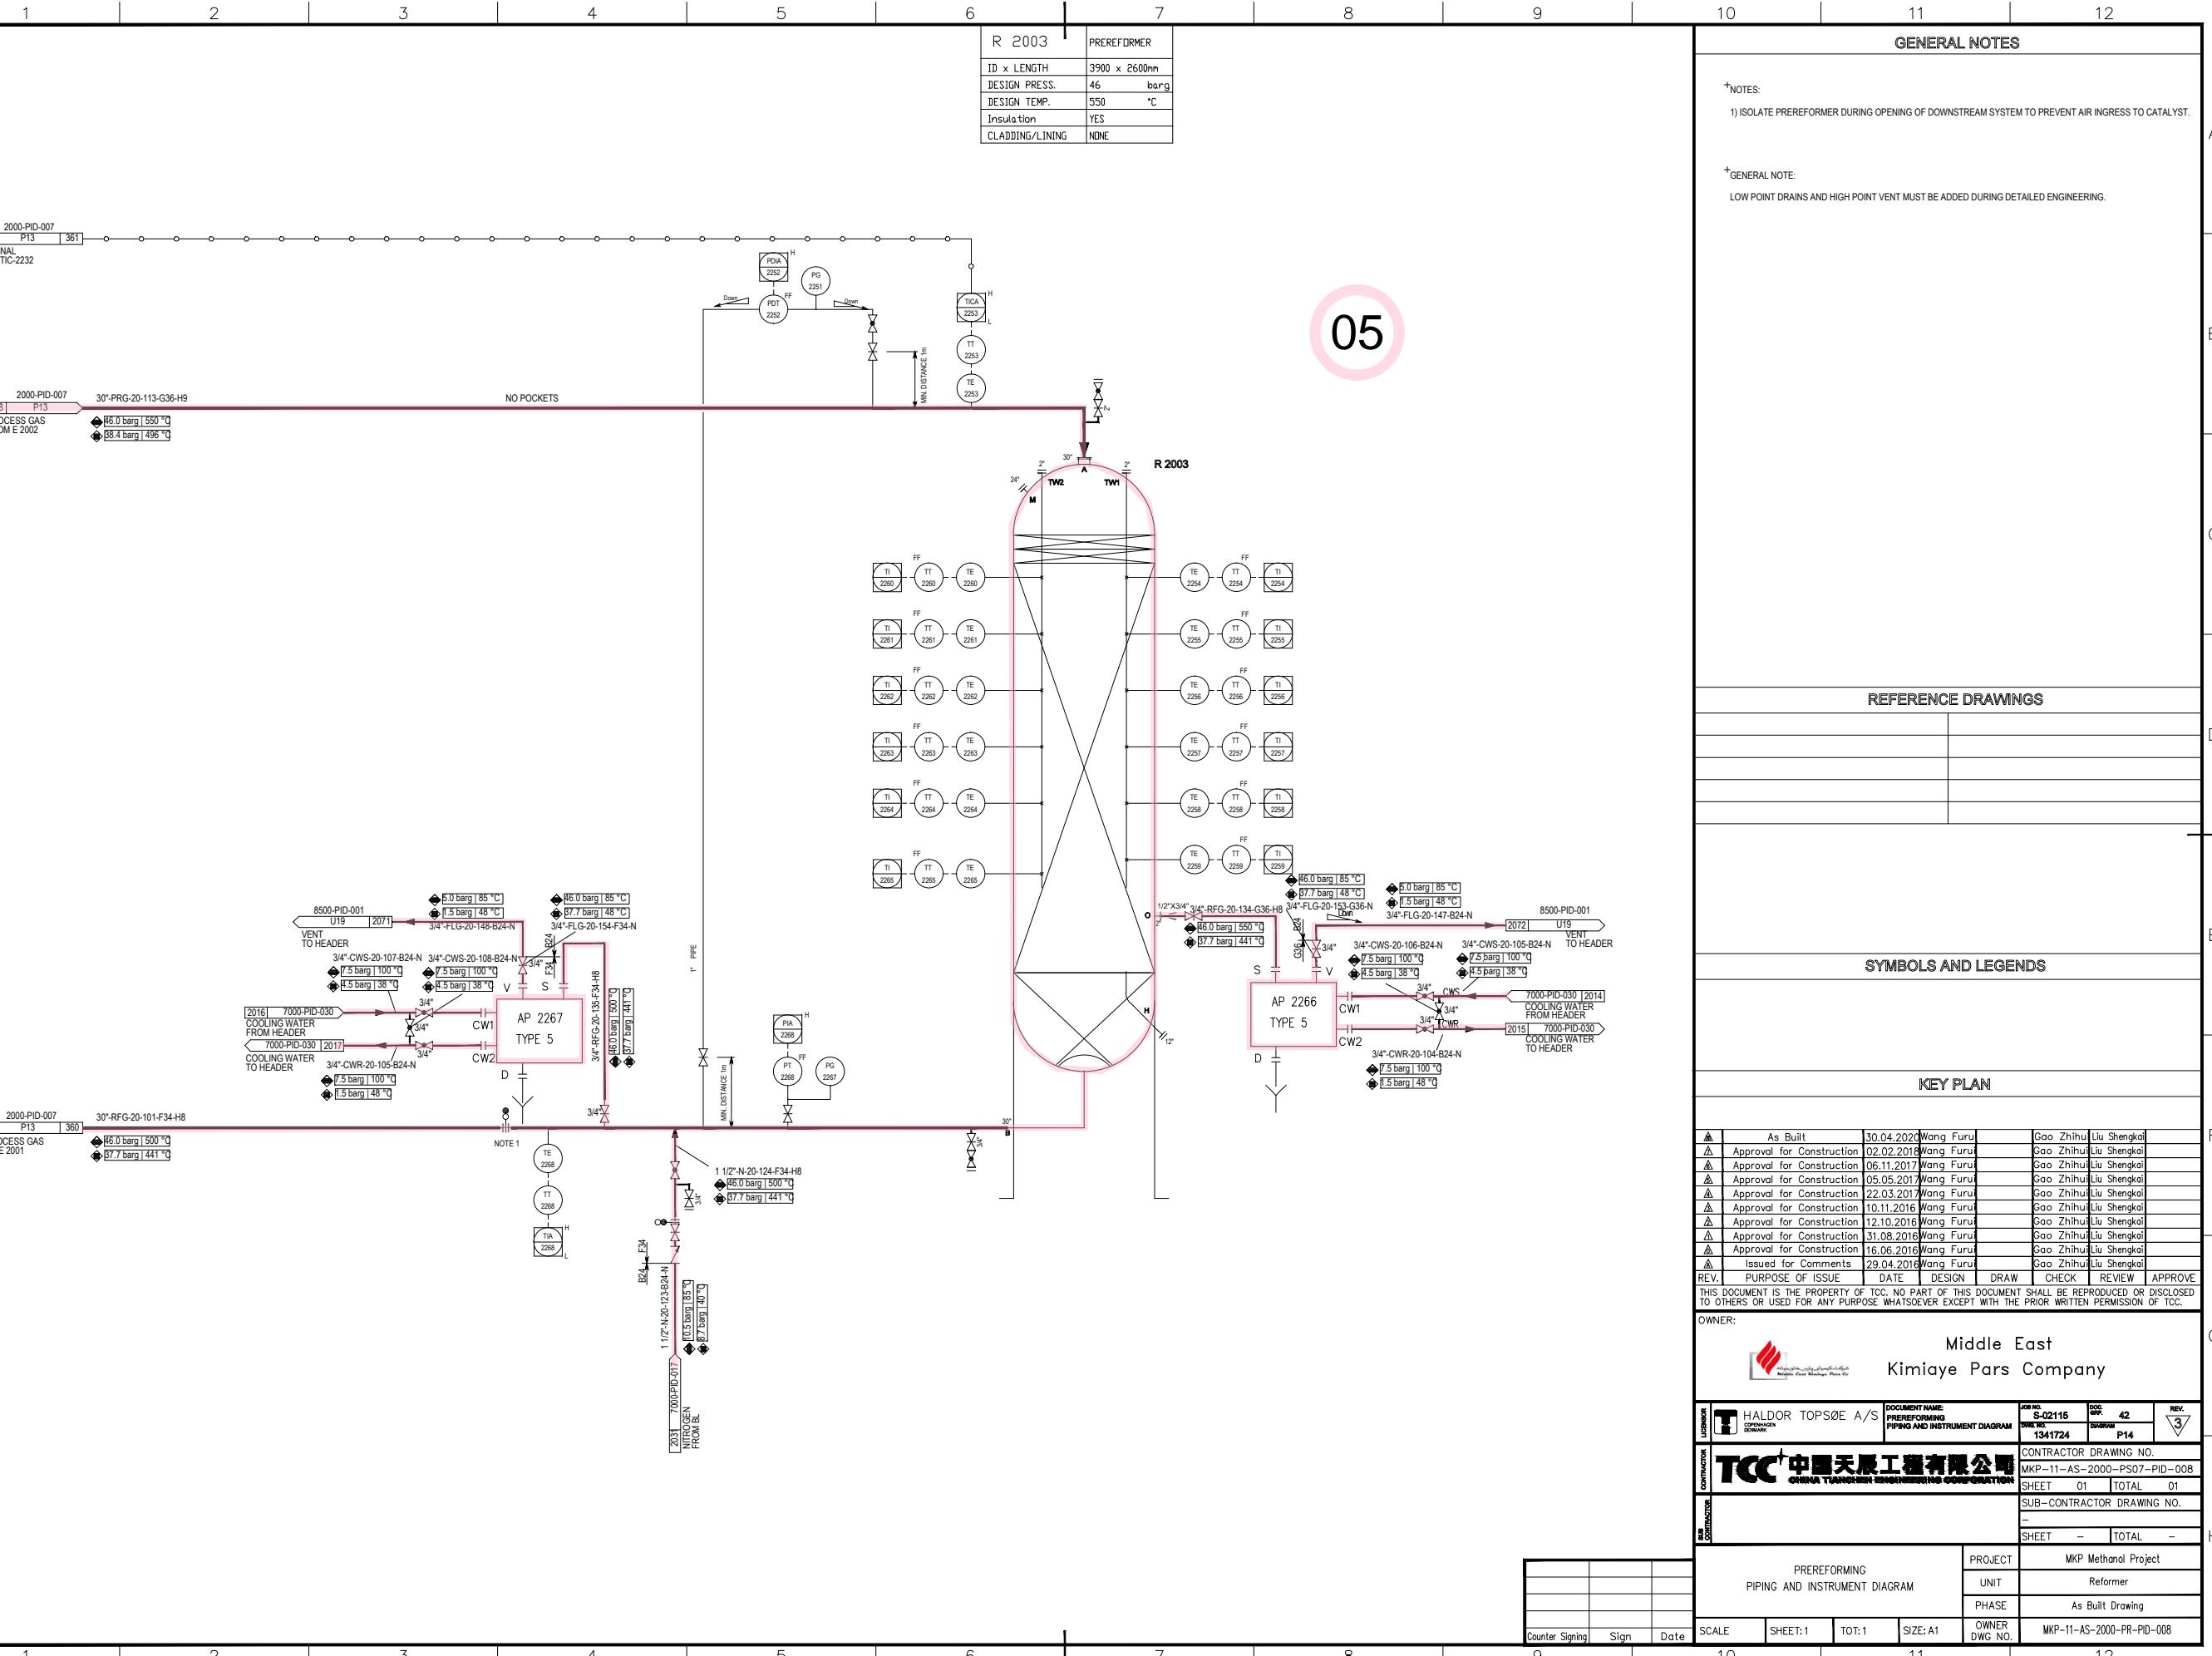


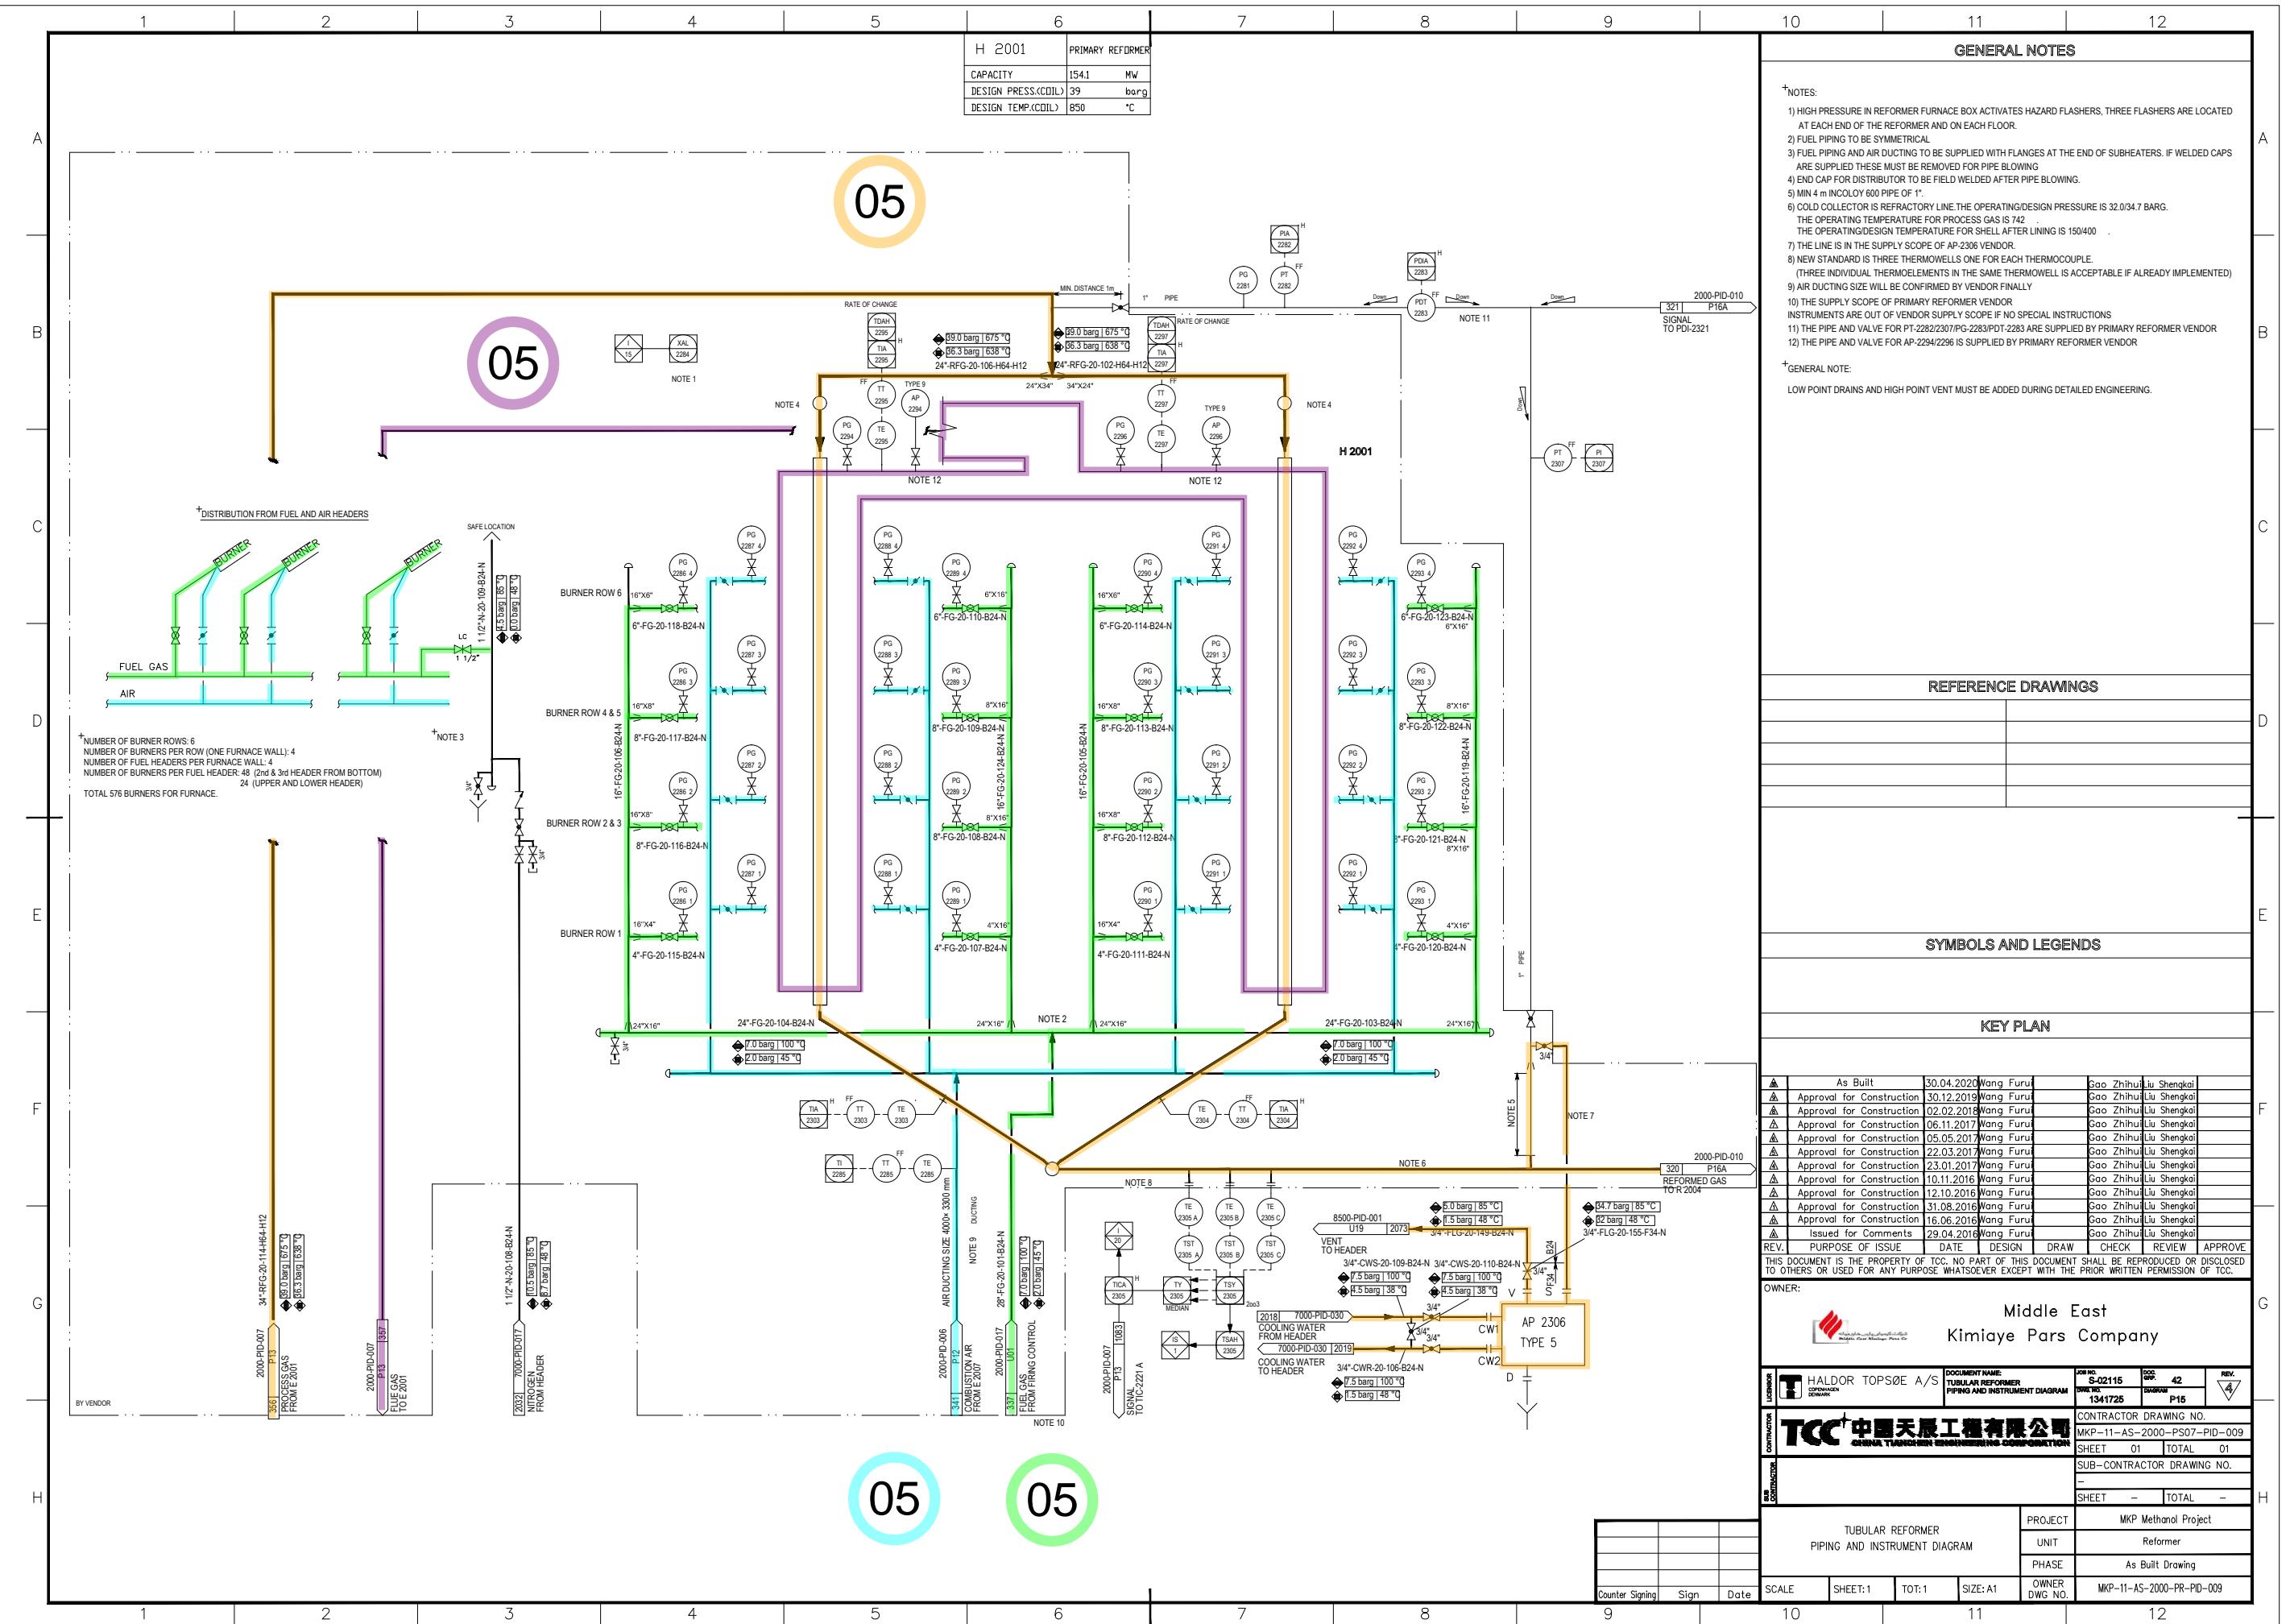


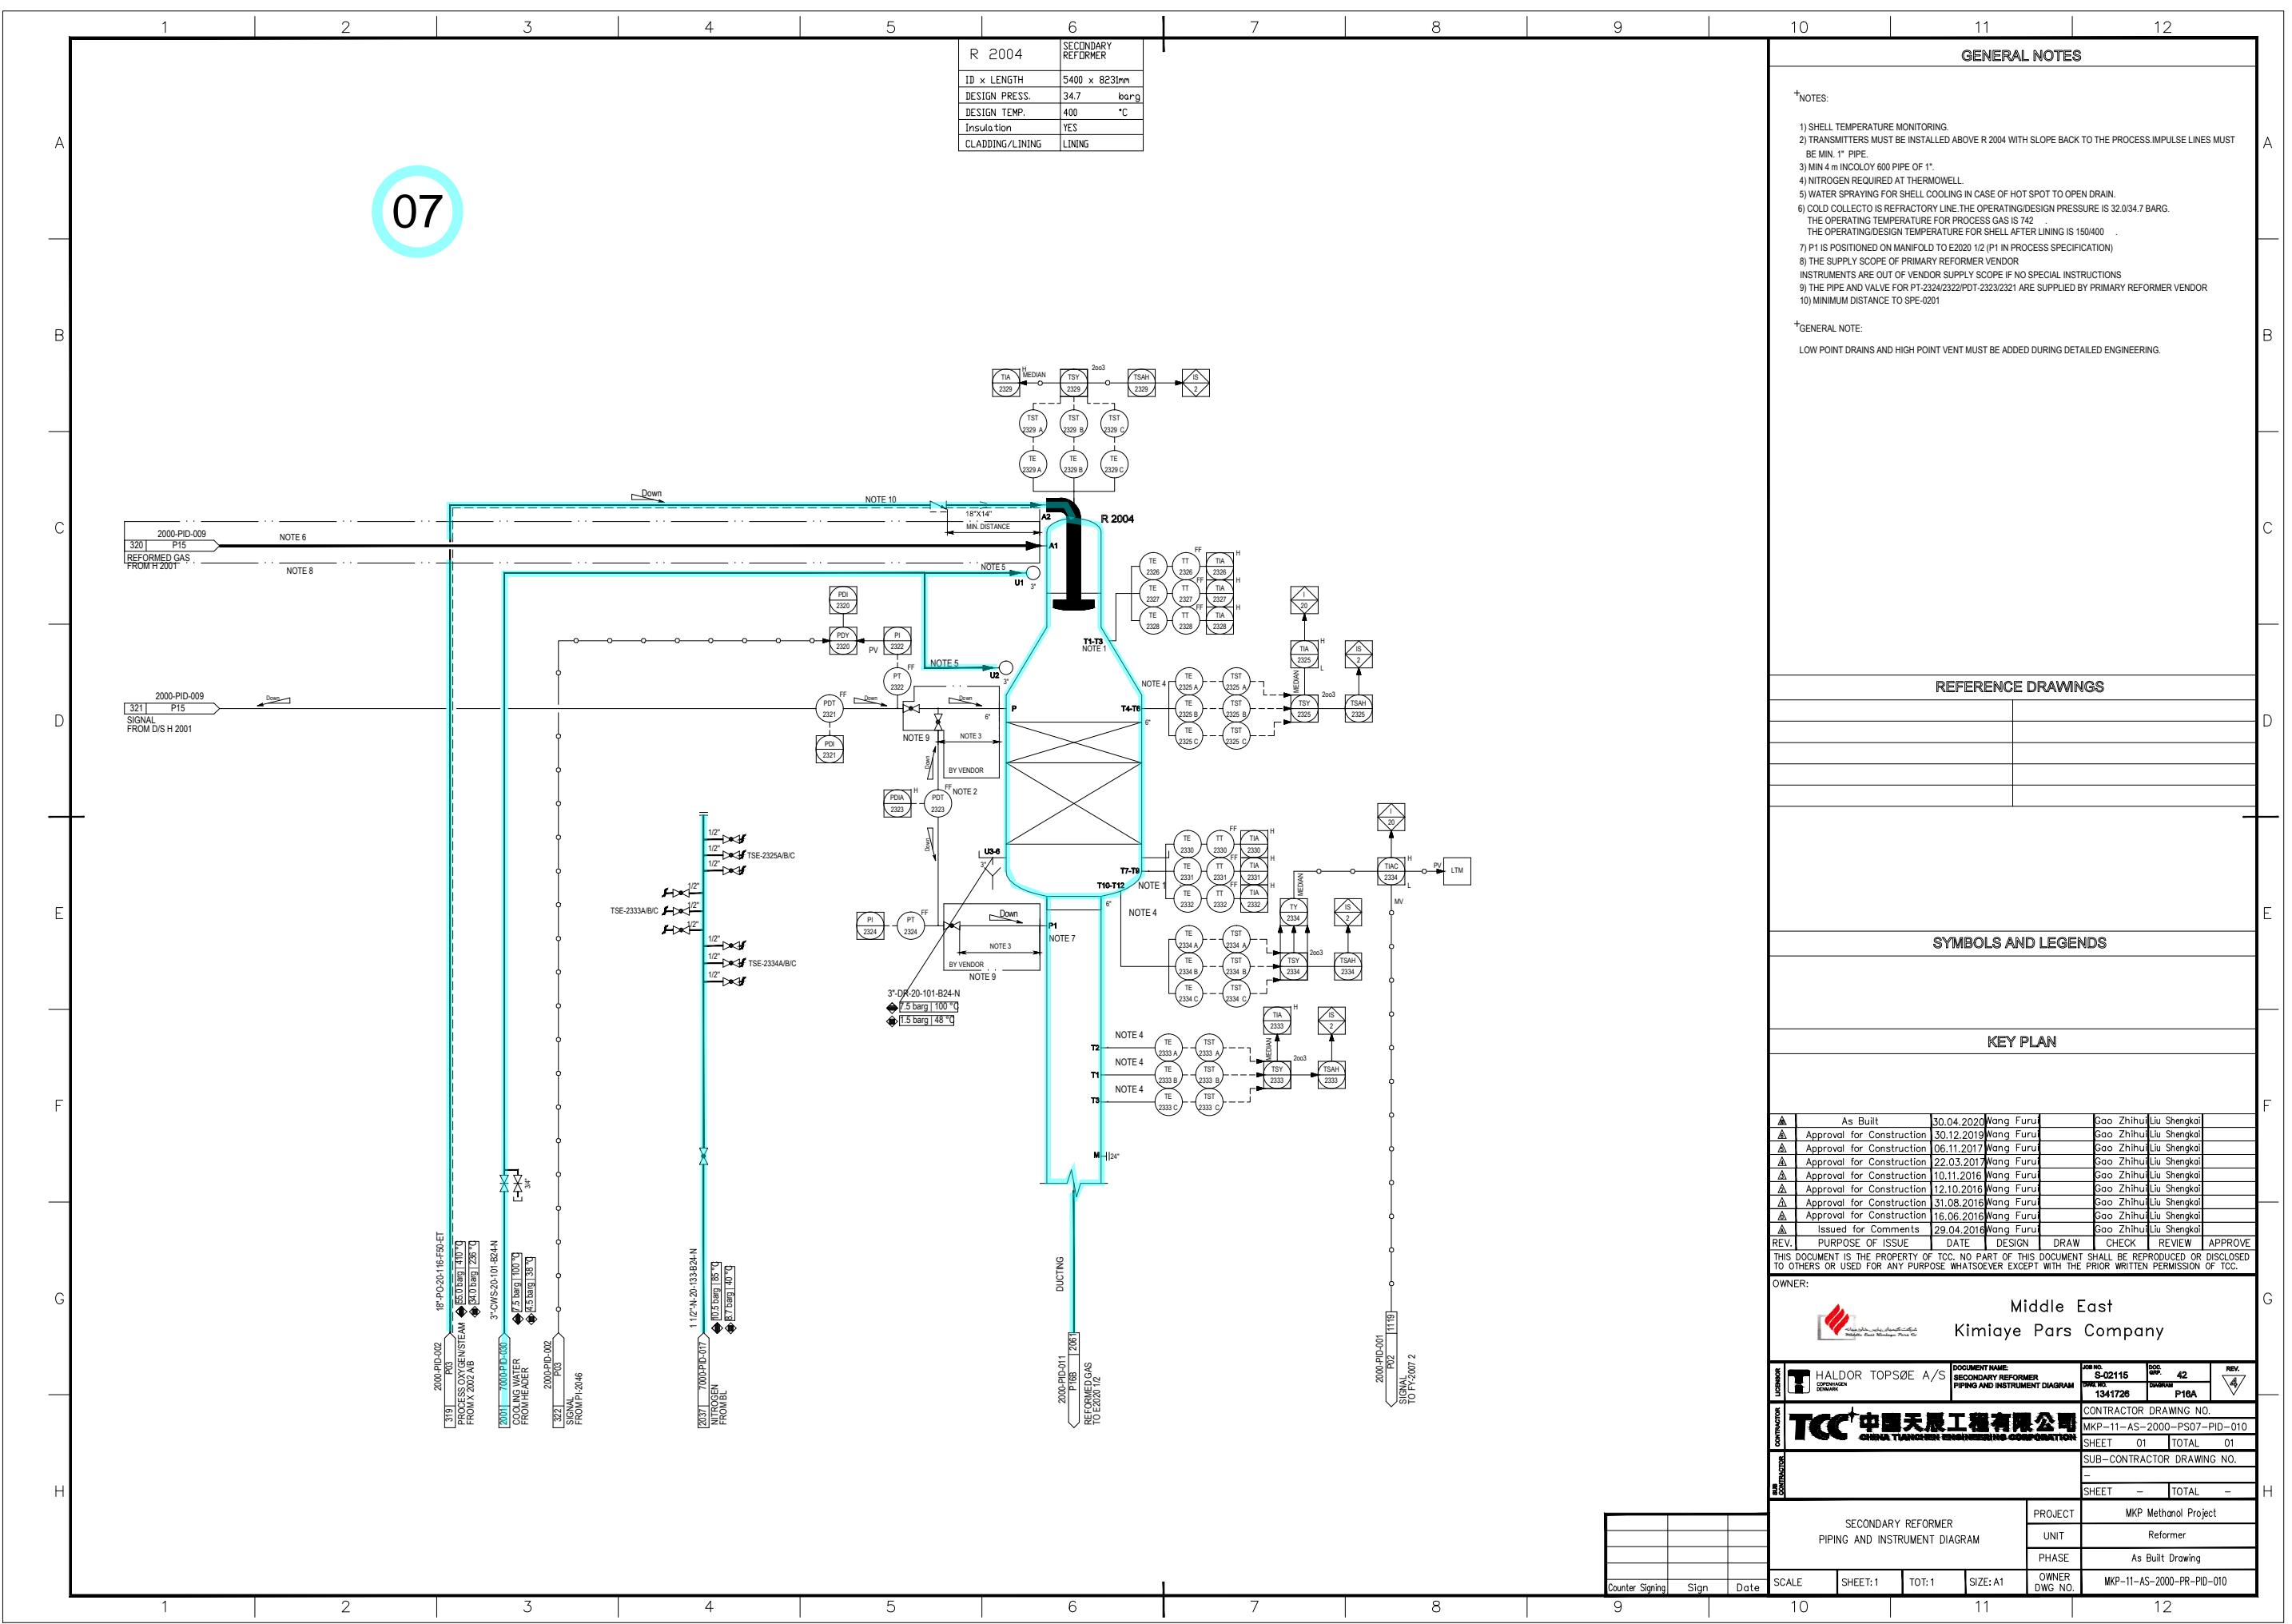


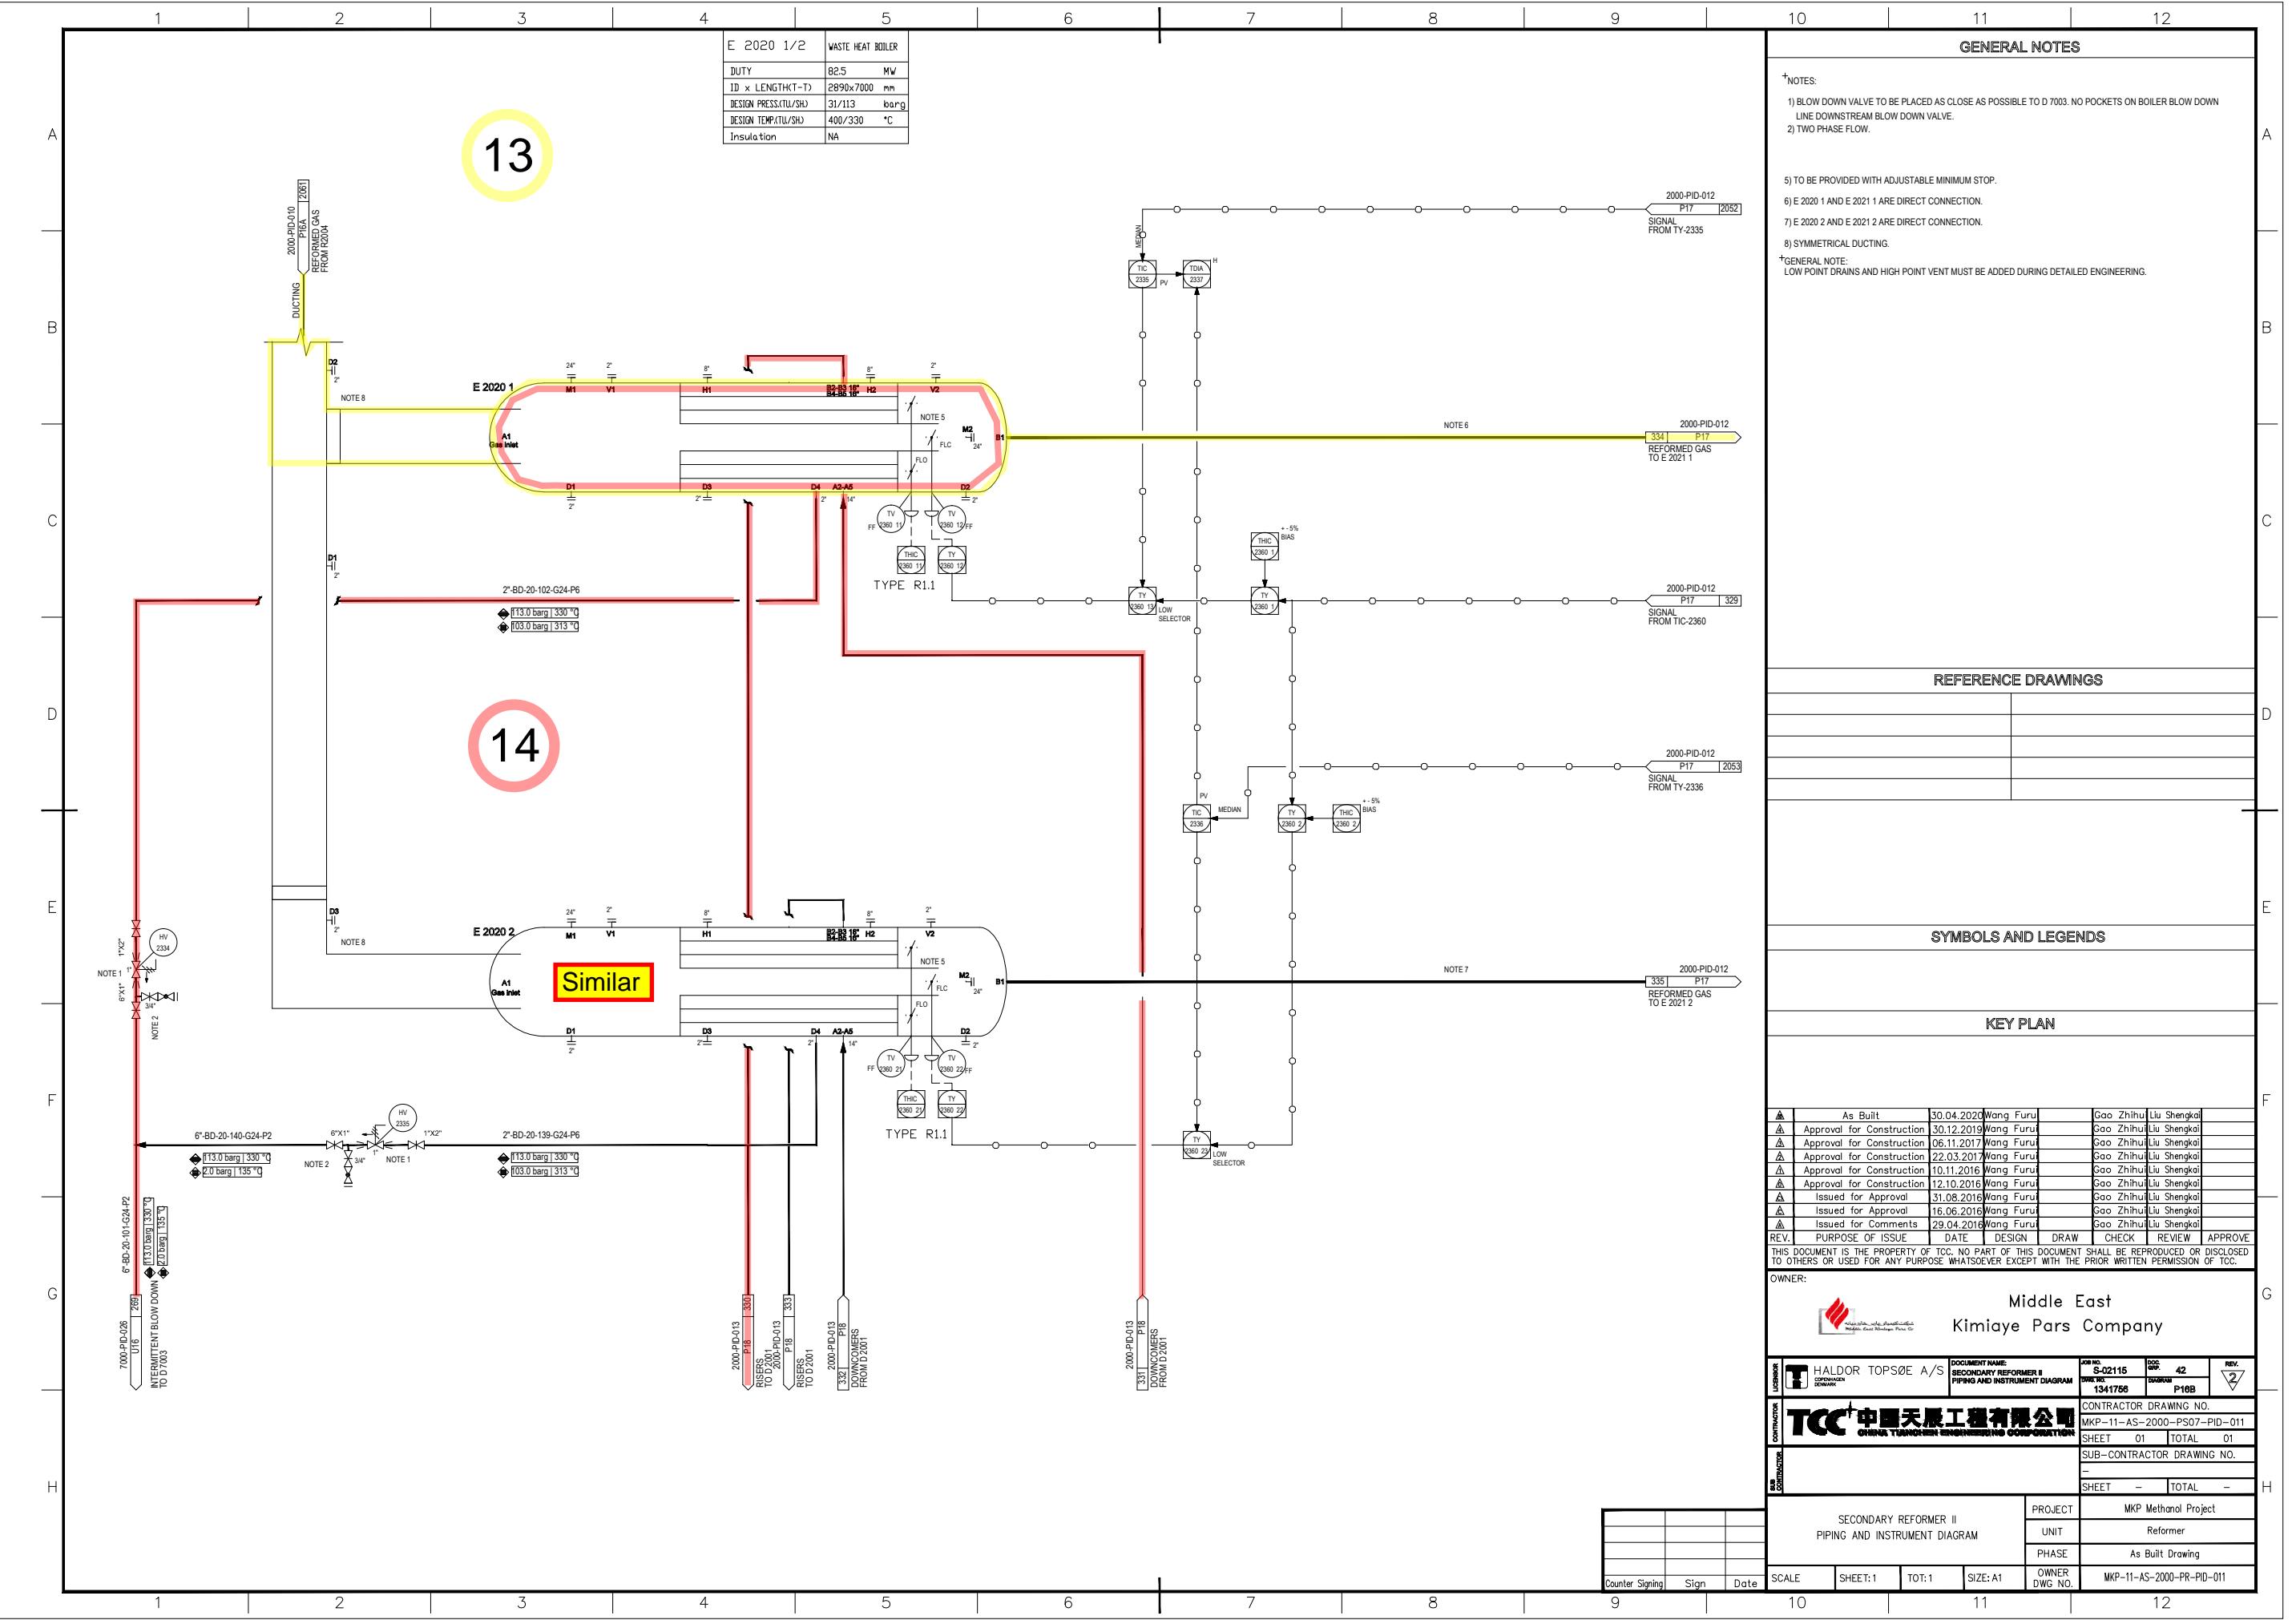

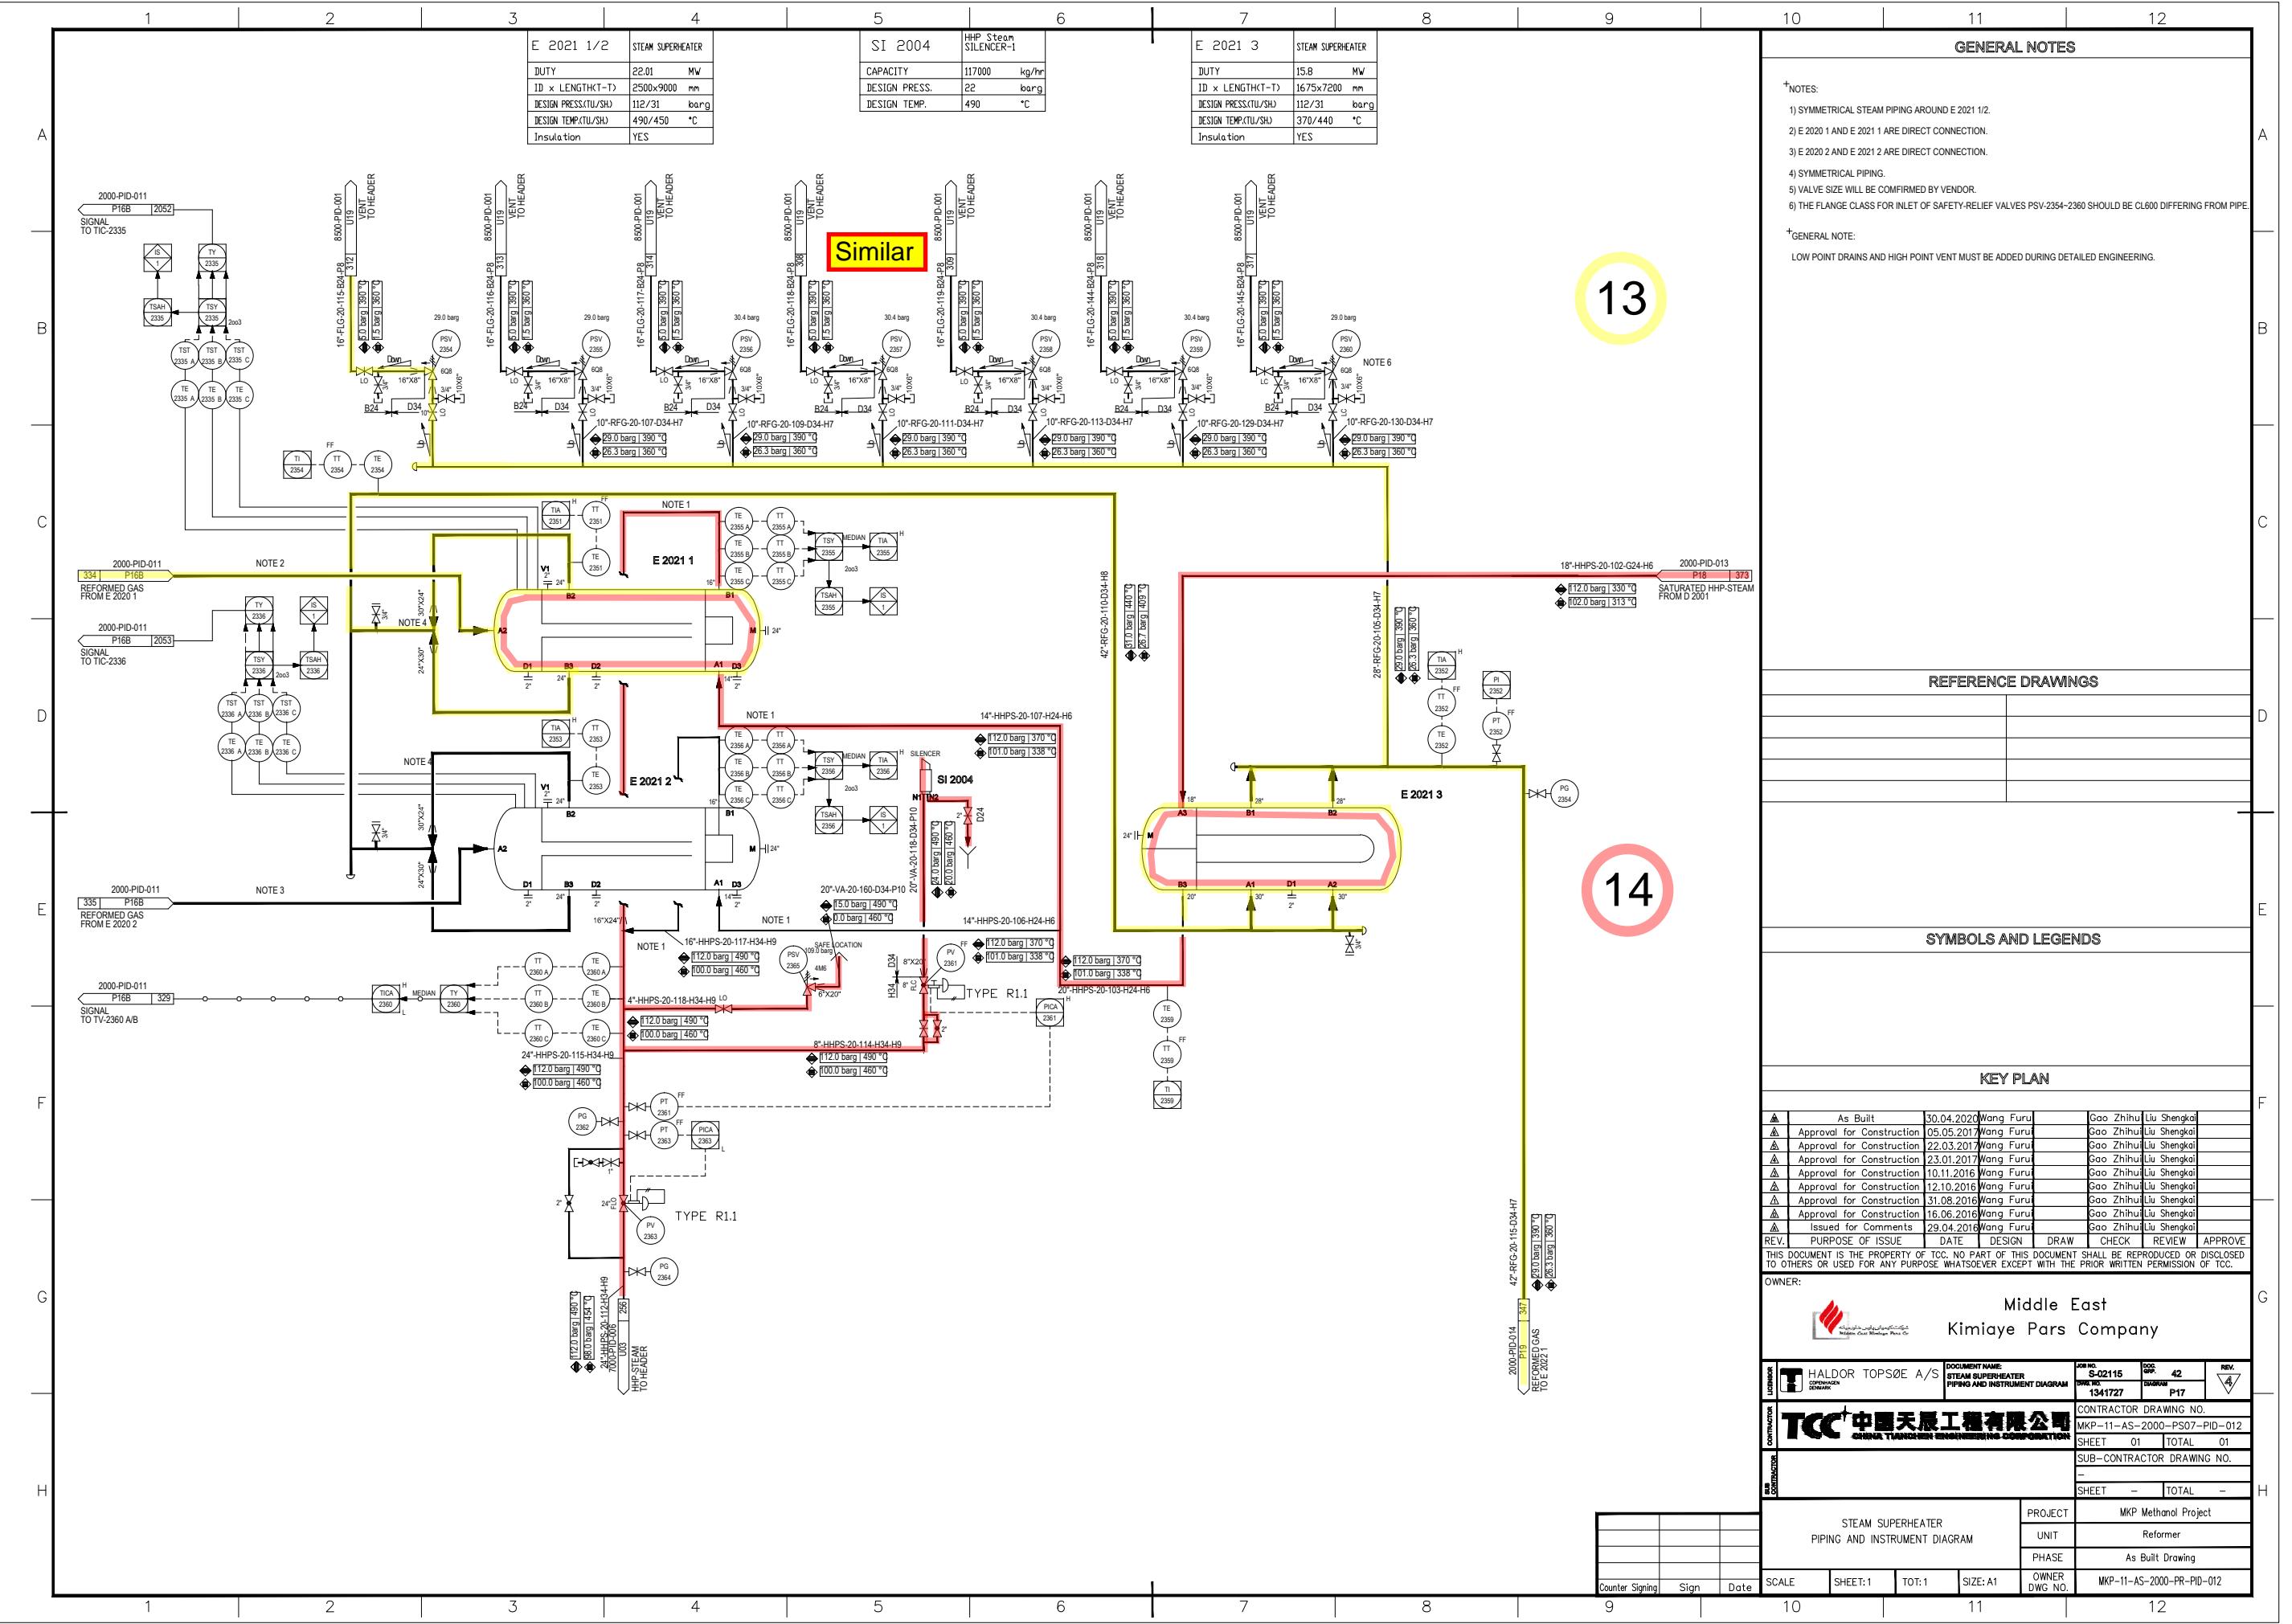


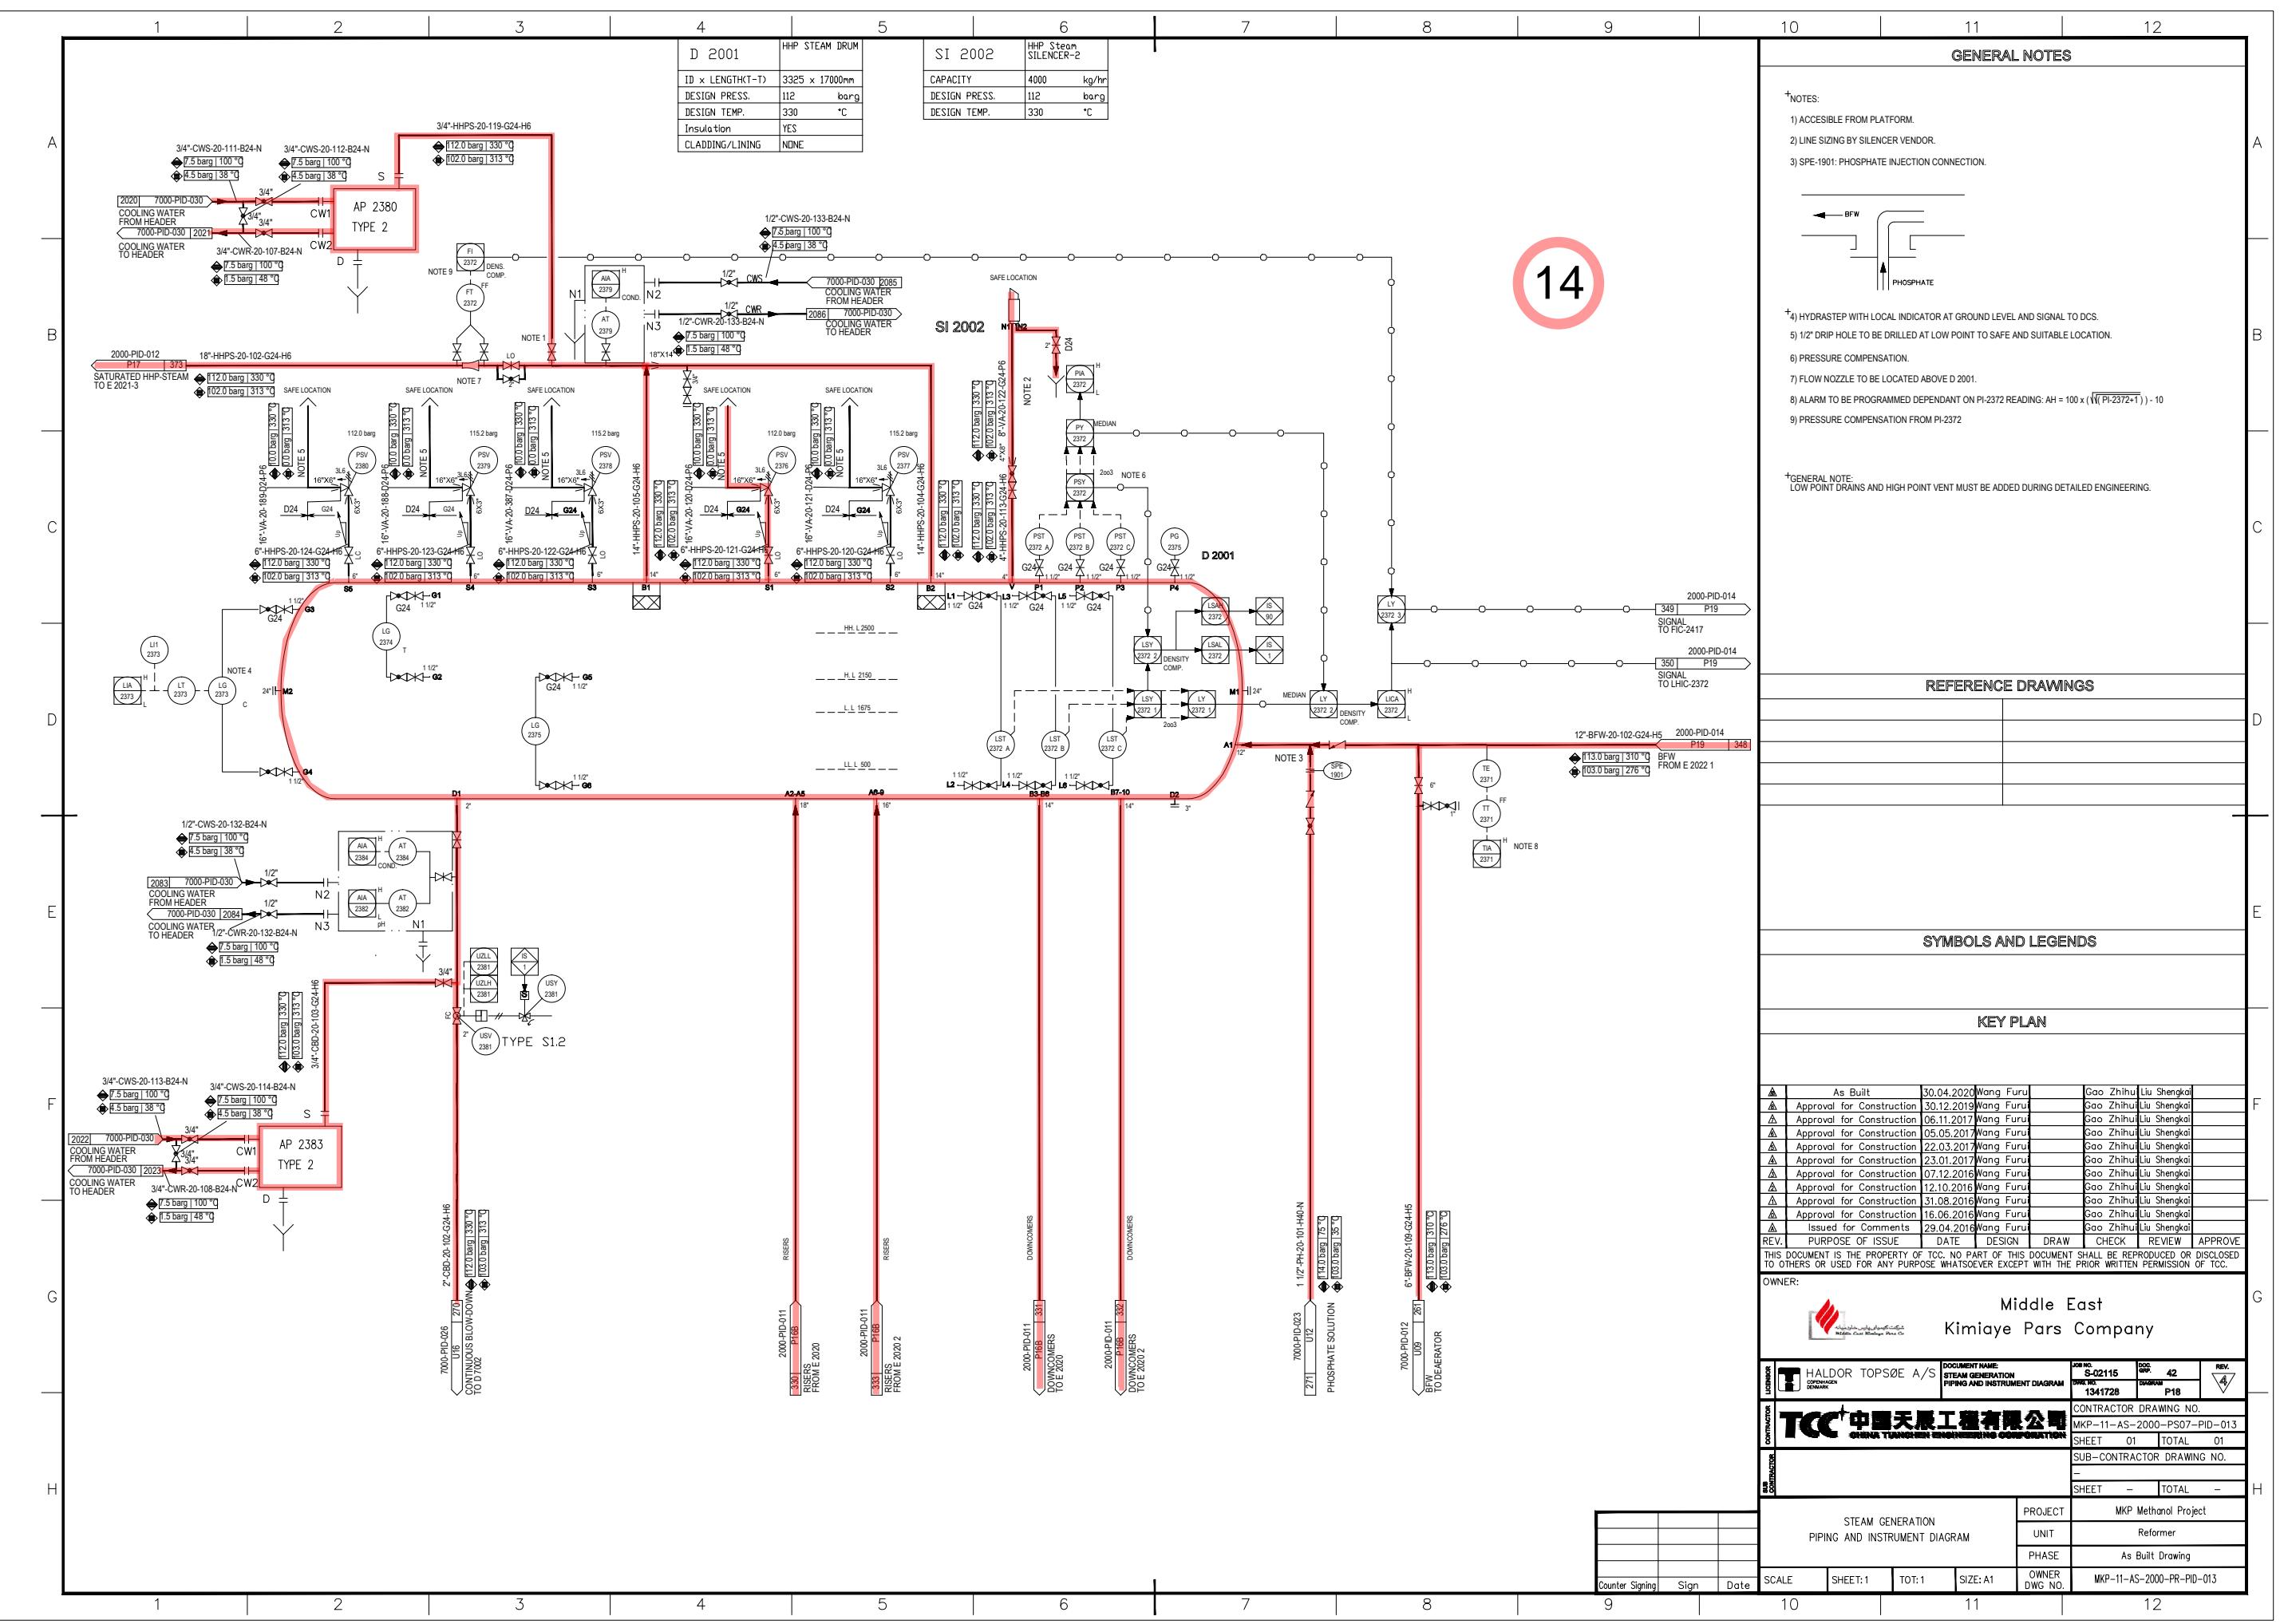

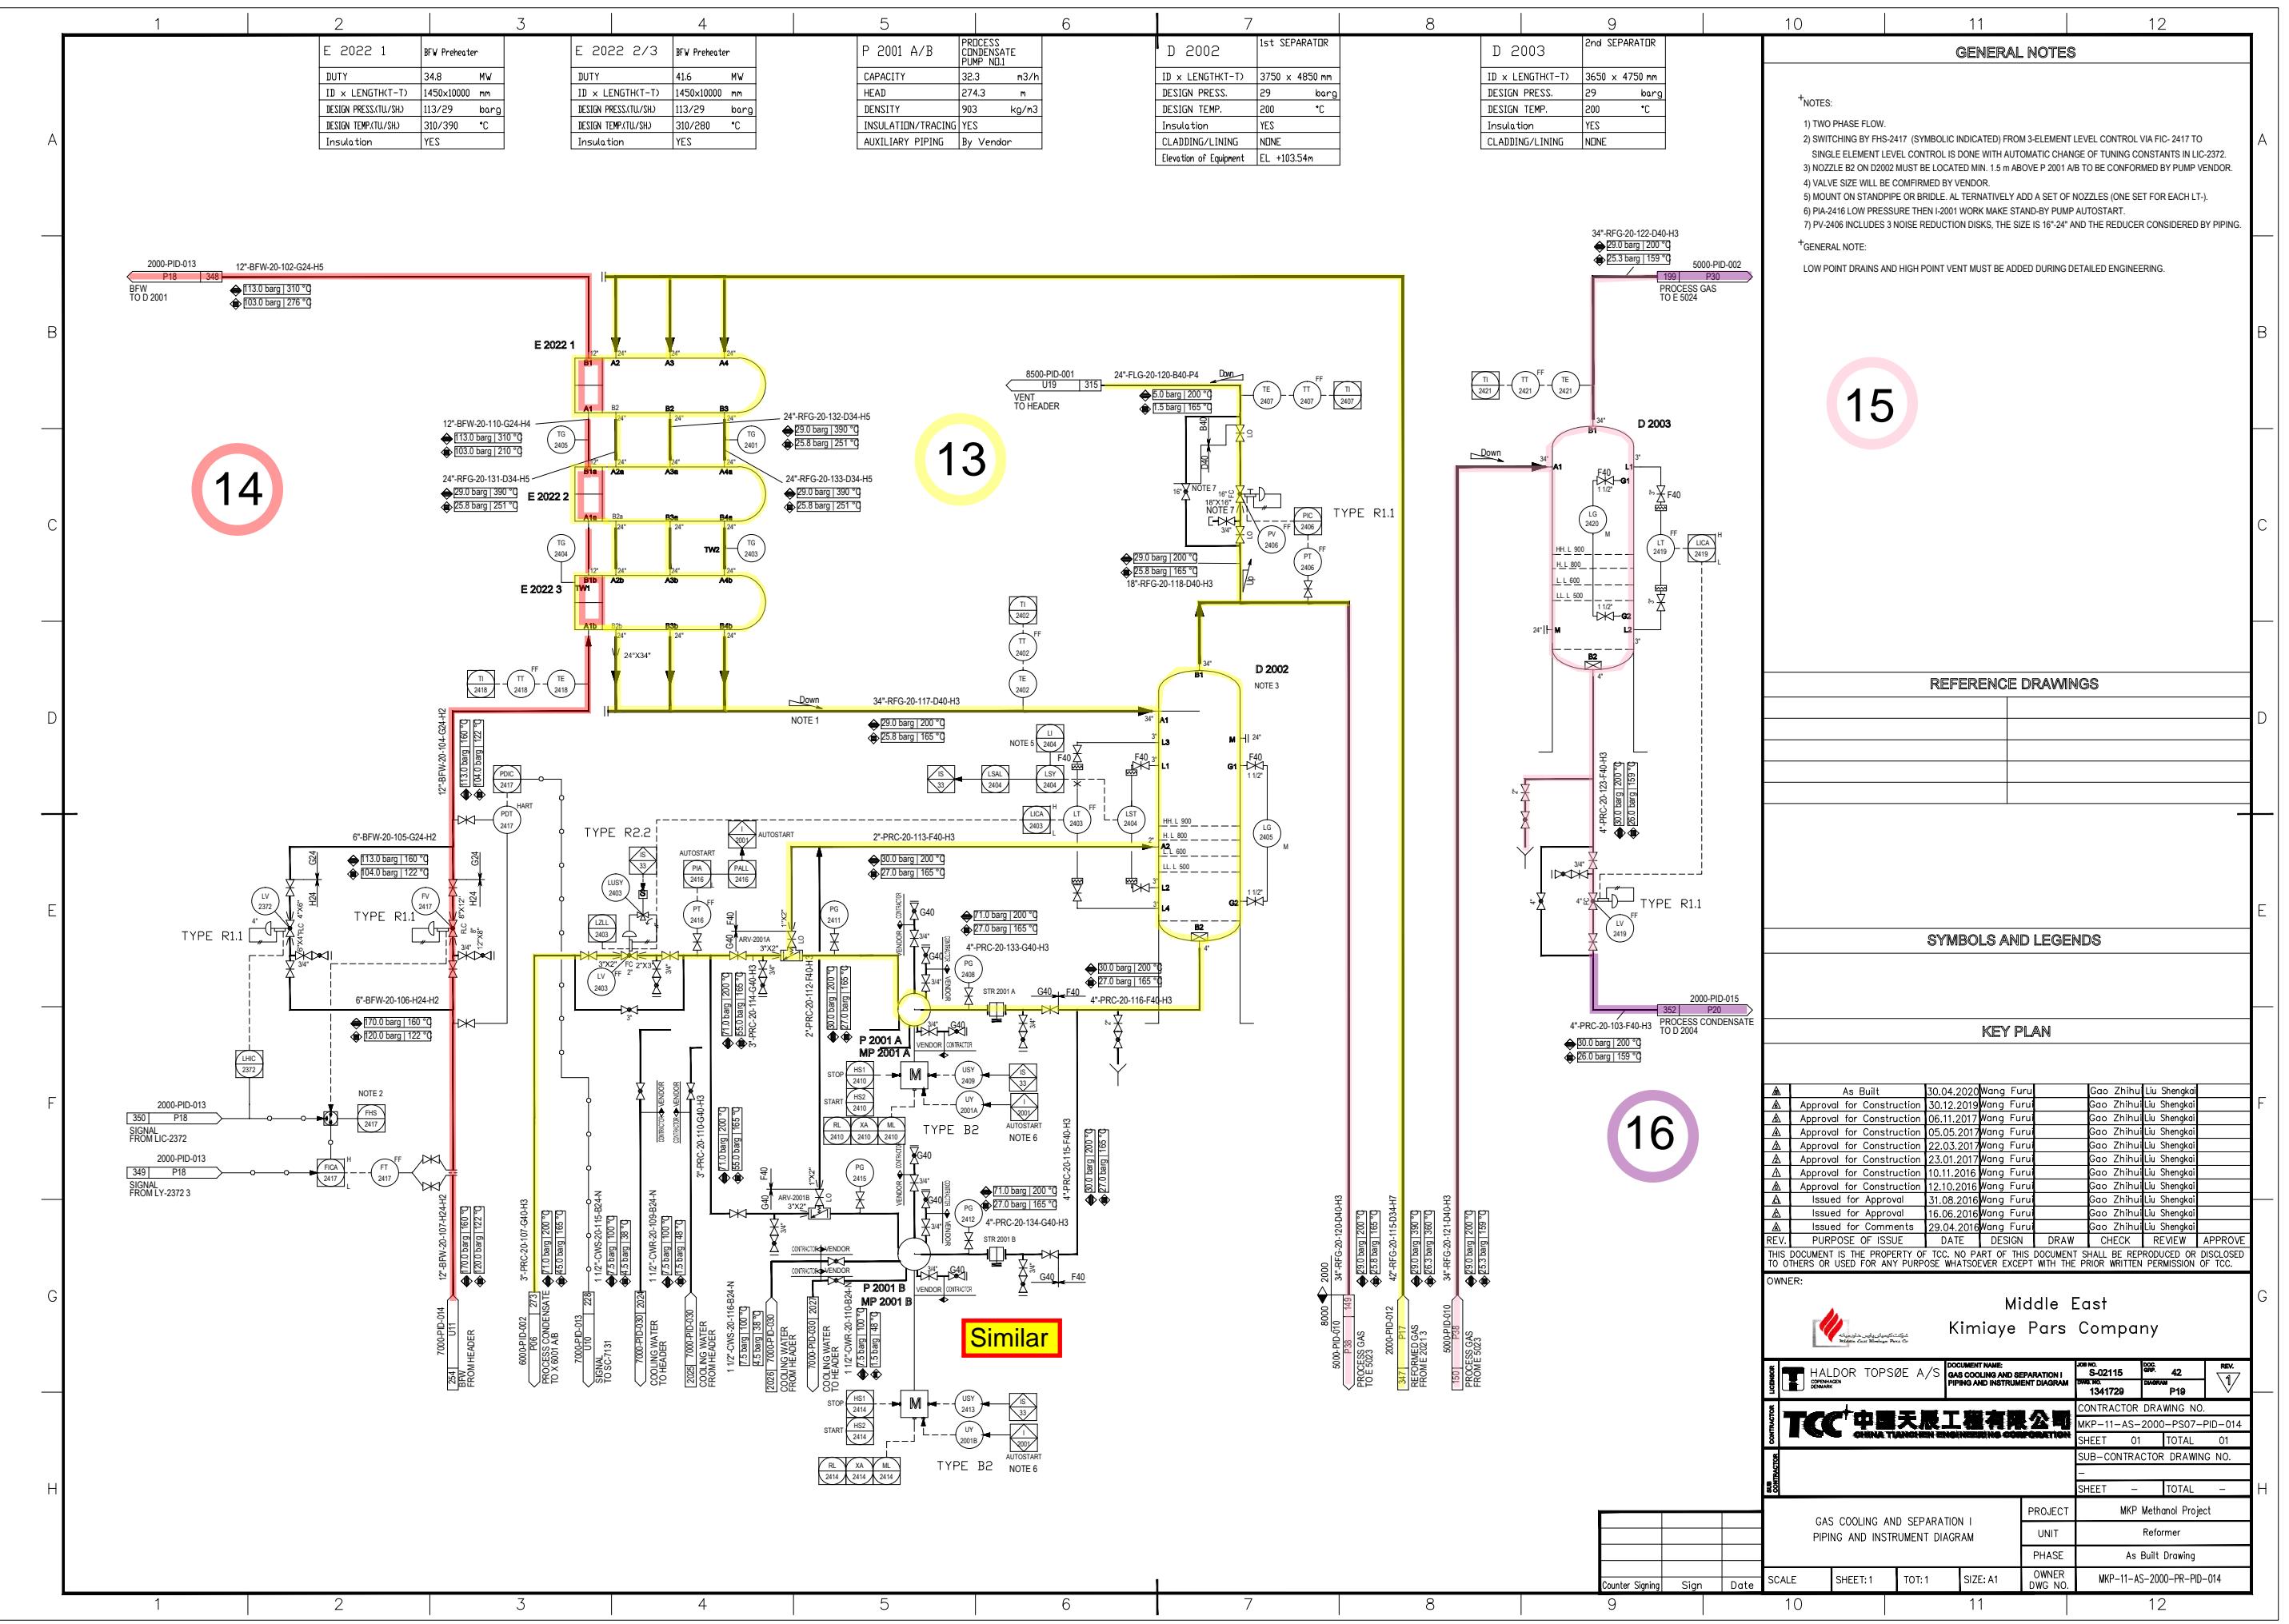

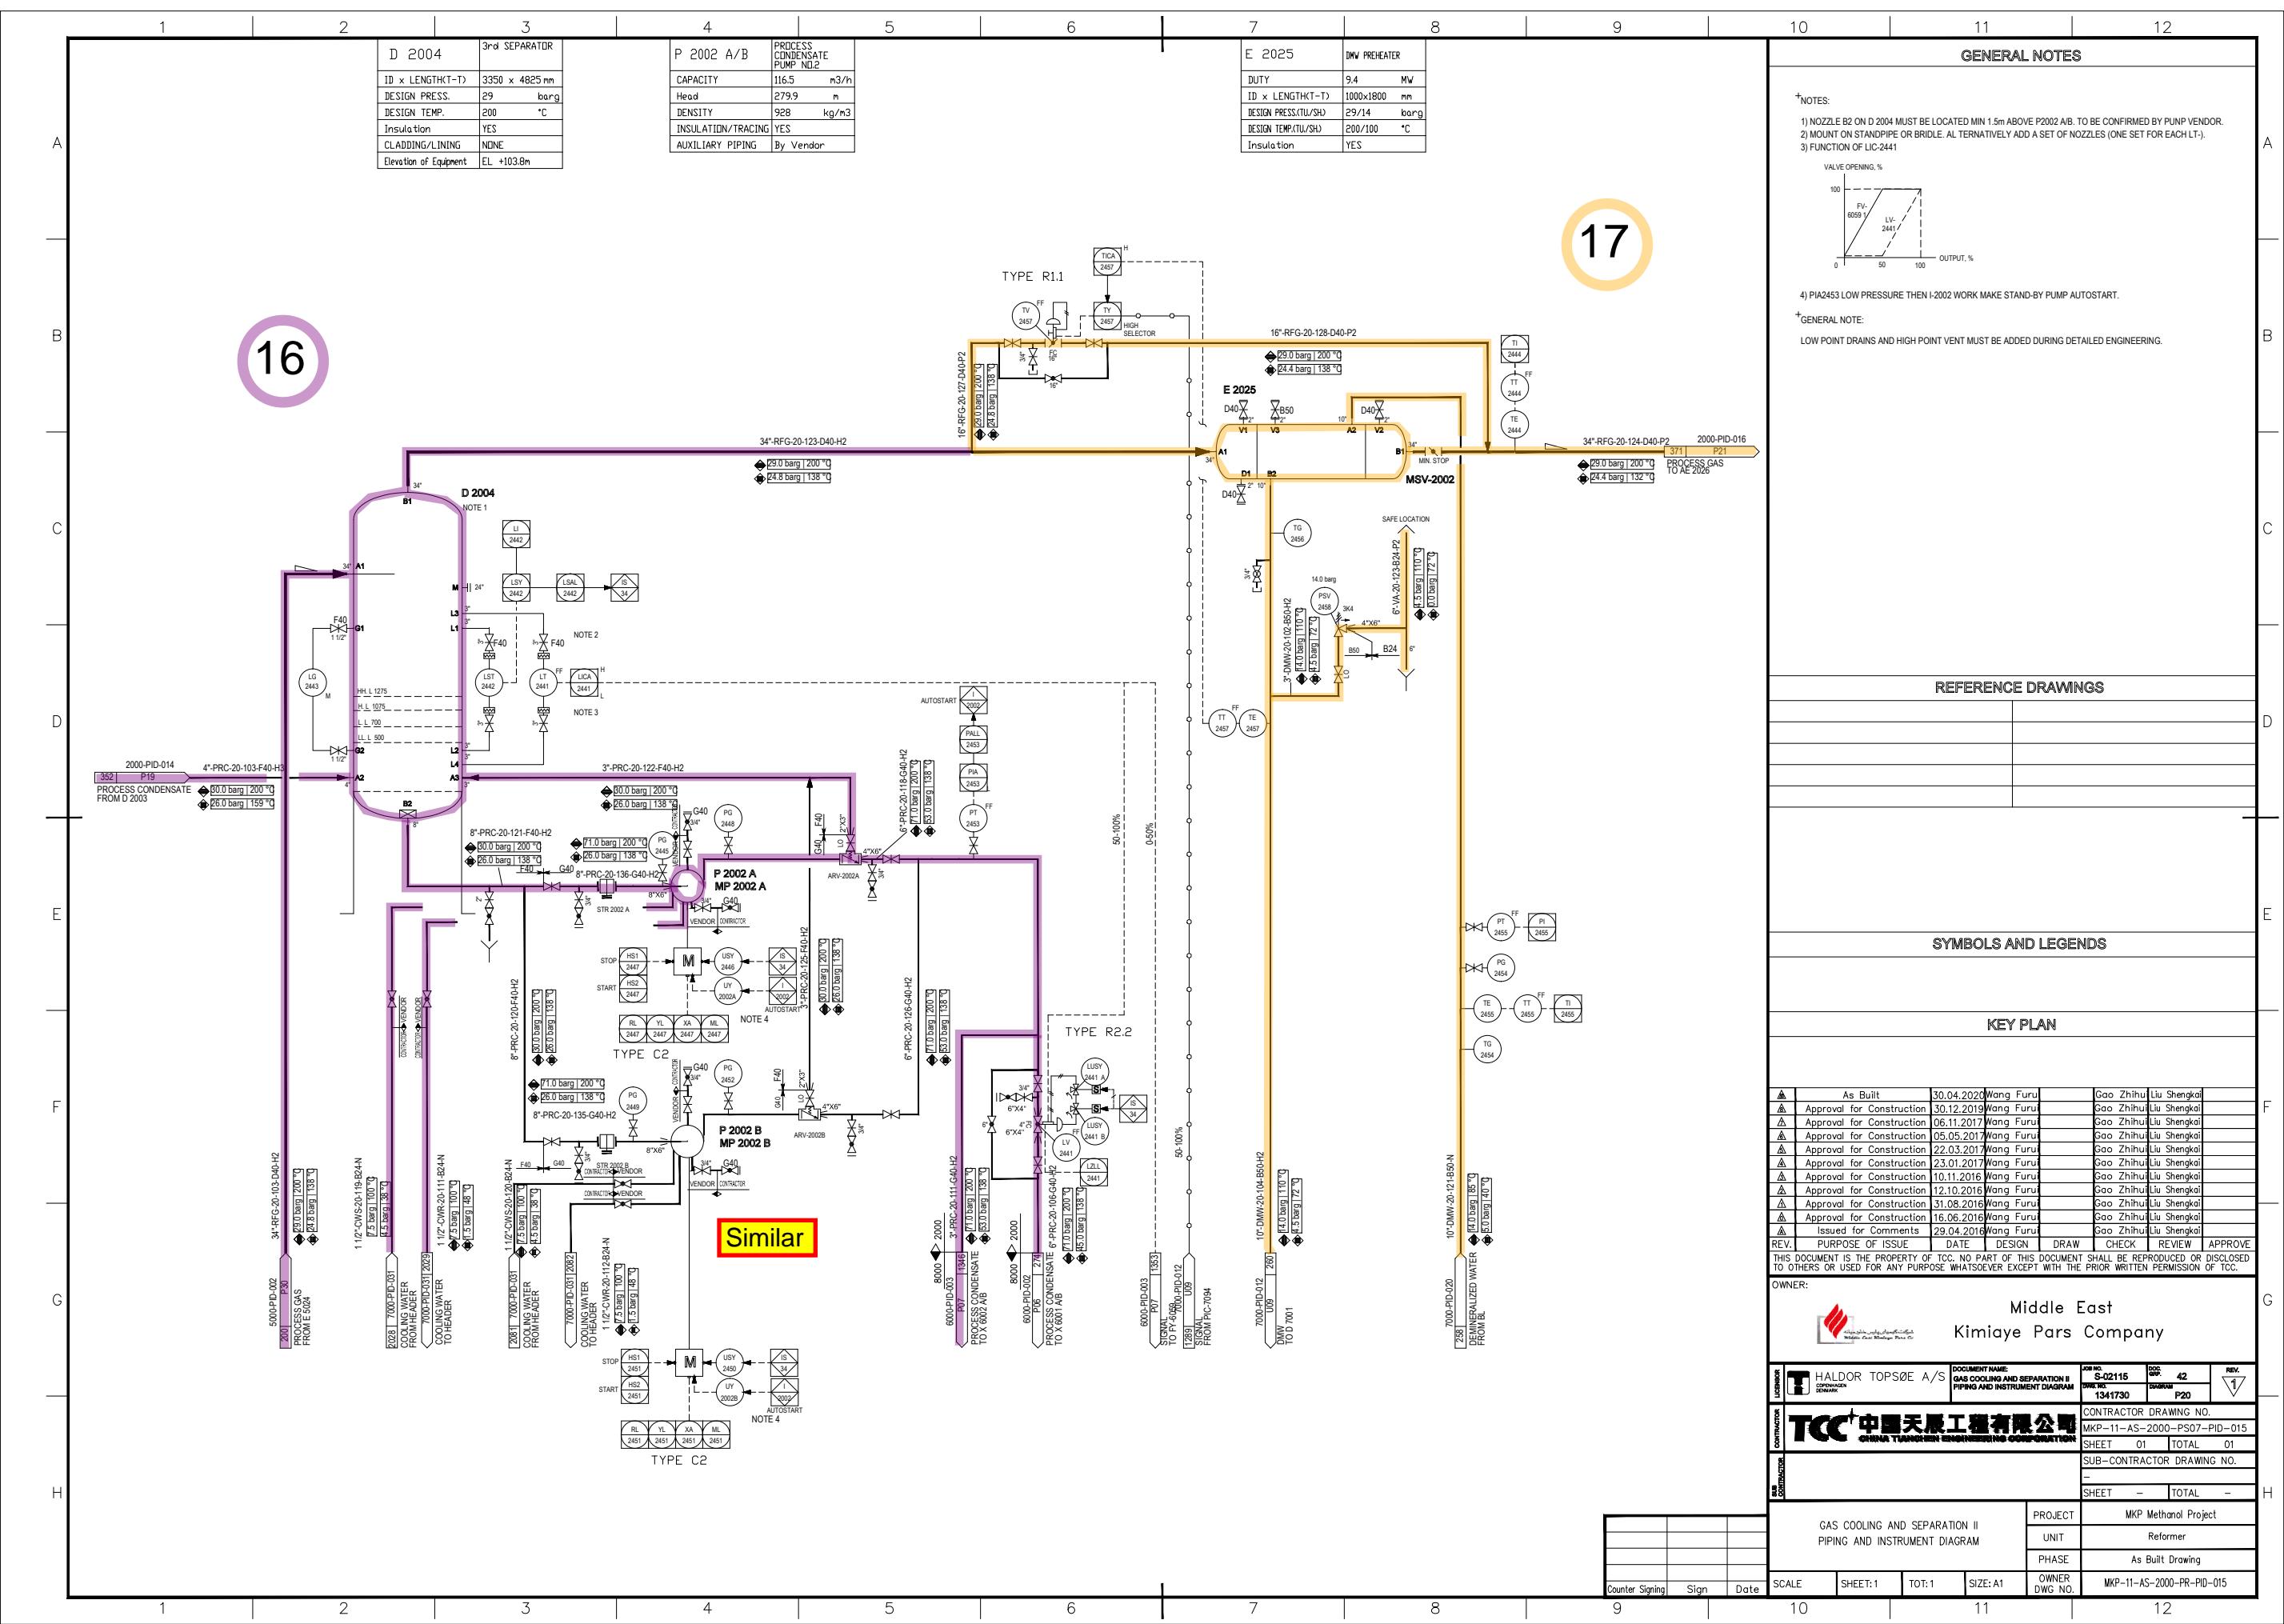

17

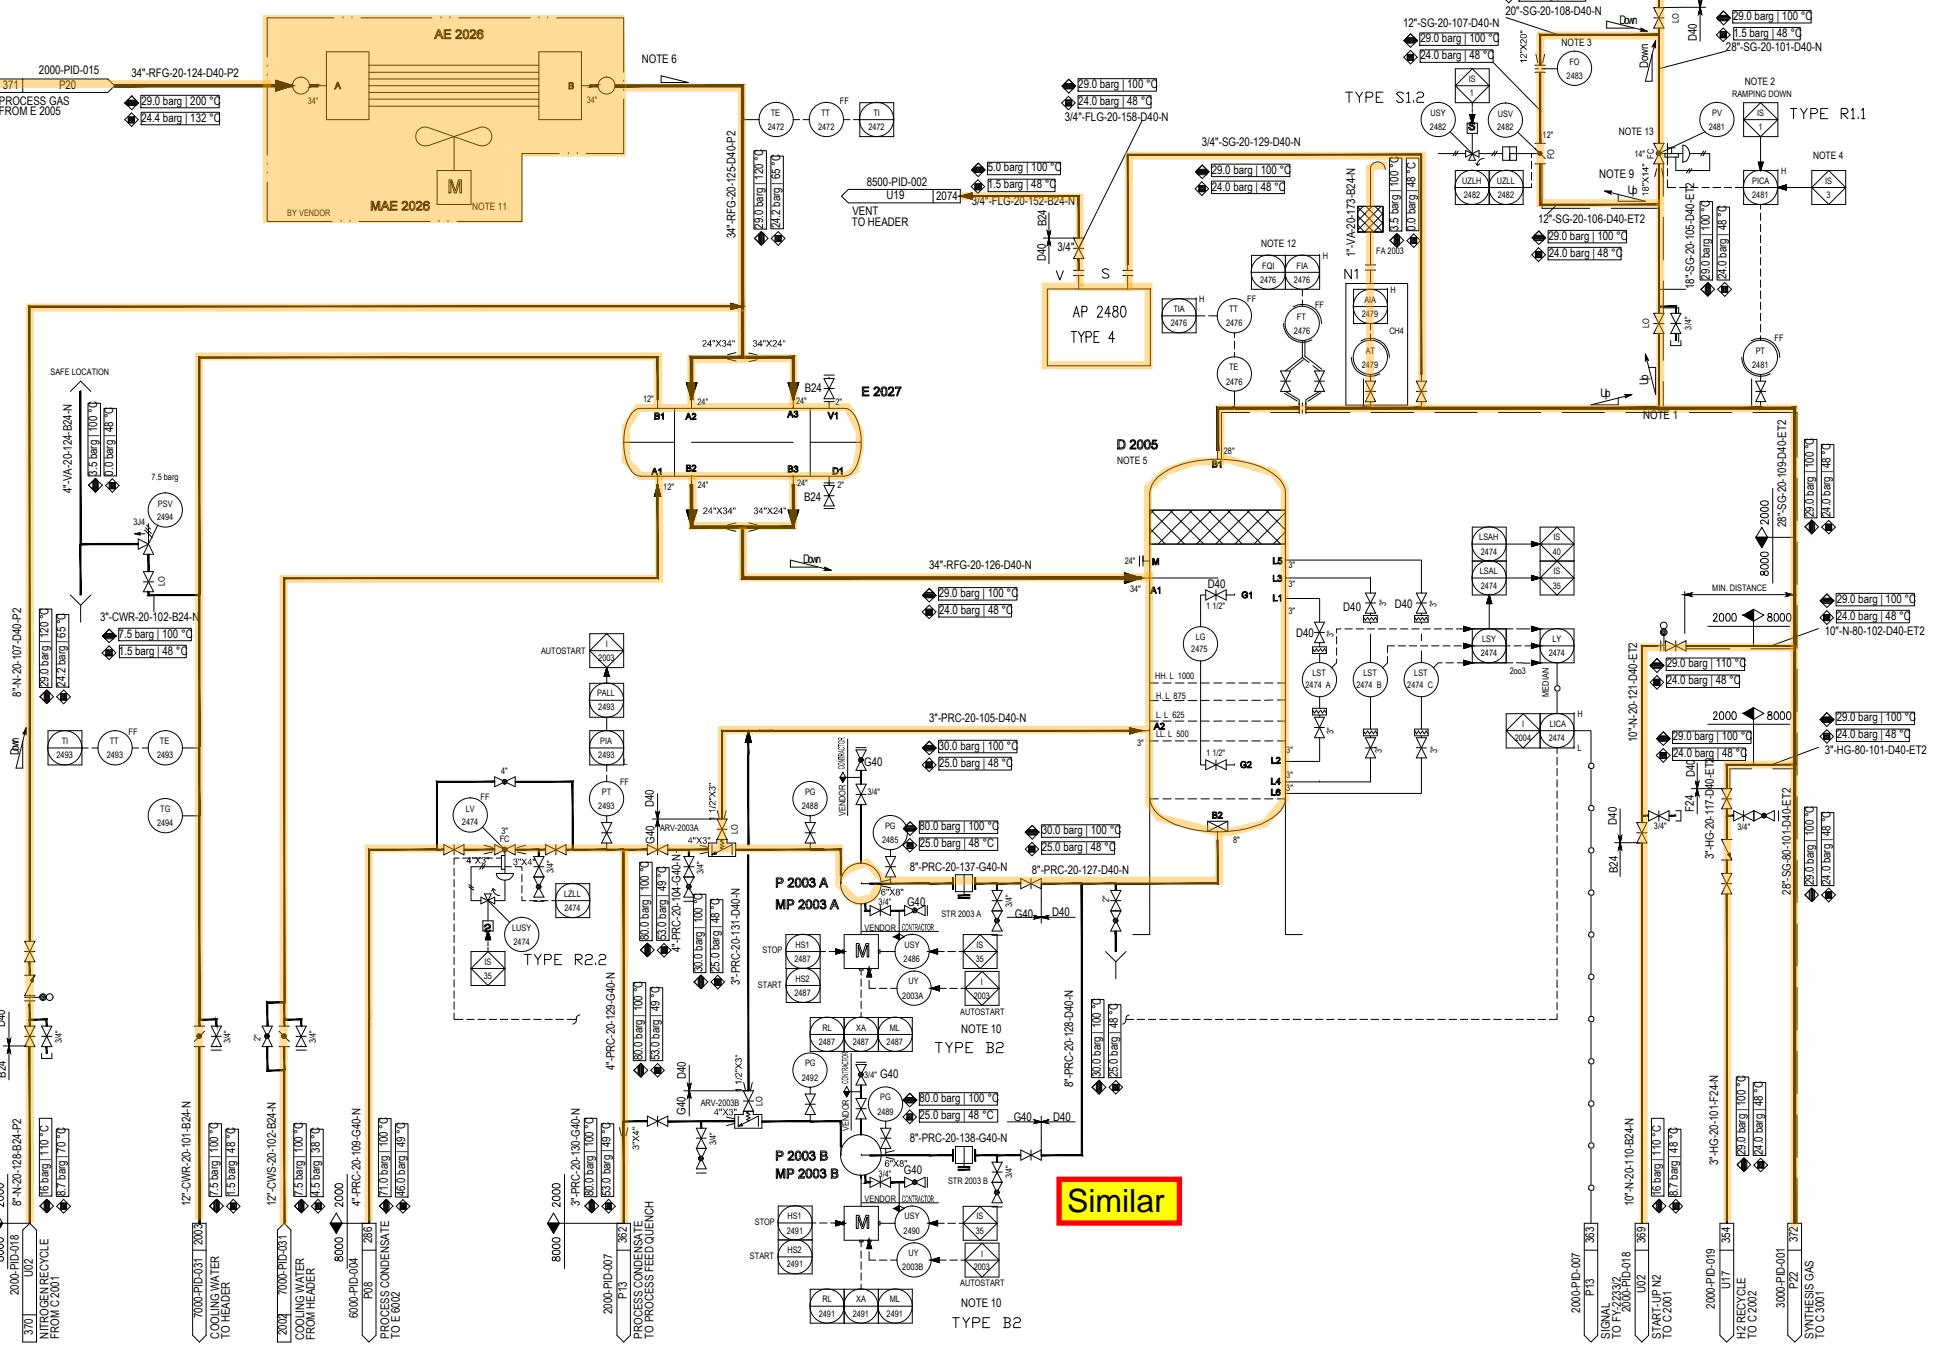

Similar

GENERAL NOTES											
+NOTES:											
1) TOP EXIT CONNECTION.											
2) CONTROLLER TO AUTO WHEN SIGNAL FROM IS-1. SETPOINT EQUAL TO PROCESS VALUE BEFORE TRIP. SETPOINT MUST BE RAMPED DOWN TO 3 barg OVER 10 min.											
3) PRESSURE TO BE HALVED EVERY 4 MINUTES OF DEPRESSURISATION.											
4) IS-3 TO PUT CONTROLLER IN MANUAL OPEN VALVE TO AN OPENING CORRESPONDING TO THE FLOW AT TIME OF TRIP THEN PIC-2481 IS PUT IN AUTO WITH SET POINT EQUAL TO ACTUAL PRESSURE AT TIME OF TRIP.											
5) D 2005 TO BE LOCATED CLOSE TO C 3001. NOZZLE B2 ON D 2005 MUST BE LOCATED MIN 1.5m ABOVE P 2003 A/B. TO BE CONFIRMED BY PUMP VENDOR.											
6) TW IS TO BE INSTALLED ON EACH OUTLET HEADER FROM AE 2026.											
9) VALVE SIZE WILL BE CONFIRMED BY VENDOR.											
10) PIA2493 LOW PRESSURE THEN I-2003 WORK MAKE STAND-BY PUMP AUTOSTART.											
11) DETAIL DRAWING FOR AE 2026 PLEASE SEE MKP-11-DE-2000-PR-PD-020											
12) P&T COMPENSATION FROM PI-2481,TI-2476											
13) PV-2481 INCLUDES 3 NOISE REDUCTION DISKS, THE SIZE IS 16"-28" AND THE REDUCER CONSIDERED BY PIPING.											
+GENERAL NOTE: LOW POINT DRAINS AND HIGH POINT VENT MUST BE ADDED DURING DETAILED ENGINEERING.											

REFERENCE DRAWINGS

SYMBOLS AND LEGENDS


KEY PLAN

▲	As Built	30.04.2016	Wang Furui	Gao Zhihu Liu Shengkai
▲	Approval for Construction	30.12.2019	Wang Furui	Gao Zhihu Liu Shengkai
▲	Approval for Construction	06.11.2017	Wang Furui	Gao Zhihu Liu Shengkai
▲	Approval for Construction	05.05.2017	Wang Furui	Gao Zhihu Liu Shengkai
▲	Approval for Construction	22.03.2017	Wang Furui	Gao Zhihu Liu Shengkai
▲	Approval for Construction	23.01.2017	Wang Furui	Gao Zhihu Liu Shengkai
▲	Approval for Construction	28.12.2016	Wang Furui	Gao Zhihu Liu Shengkai
▲	Approval for Construction	12.10.2016	Wang Furui	Gao Zhihu Liu Shengkai
▲	Issued for Review	31.08.2016	Wang Furui	Gao Zhihu Liu Shengkai
▲	Issued for Review	16.06.2016	Wang Furui	Gao Zhihu Liu Shengkai
▲	Issued for Comments	29.04.2016	Wang Furui	Gao Zhihu Liu Shengkai

REV. PURPOSE OF ISSUE DATE DESIGN DRAW CHECK REVIEW APPROVE


THIS DOCUMENT IS THE PROPERTY OF TCC. NO PART OF THIS DOCUMENT SHALL BE REPRODUCED OR DISCLOSED TO OTHERS OR USED FOR ANY PURPOSE WHATSOEVER EXCEPT WITH THE PRIOR WRITTEN PERMISSION OF TCC.


OWNER:

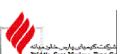

Middle East
Kimiaye Pars Company

CONTRACTOR	Haldor Topsøe A/S	DOCUMENT NAME: GAS COOLING AND SEPARATION III PIPING AND INSTRUMENT DIAGRAM	JOB NO. S-02115	DOC. NO. 42
LICENSOR			DRAWING NO. 1341731	REV. P21
CONTRACTOR DRAWING NO. MKP-11-AS-2000-PS07-PID-016		SHEET 01 TOTAL 01		
SUB-CONTRACTOR DRAWING NO. -		SUB-CONTRACTOR DRAWING NO. -		
SCALE	SHEET:1	TOT:1	SIZE:A1	OWNER DWG NO. MKP-11-AS-2000-PR-PID-016

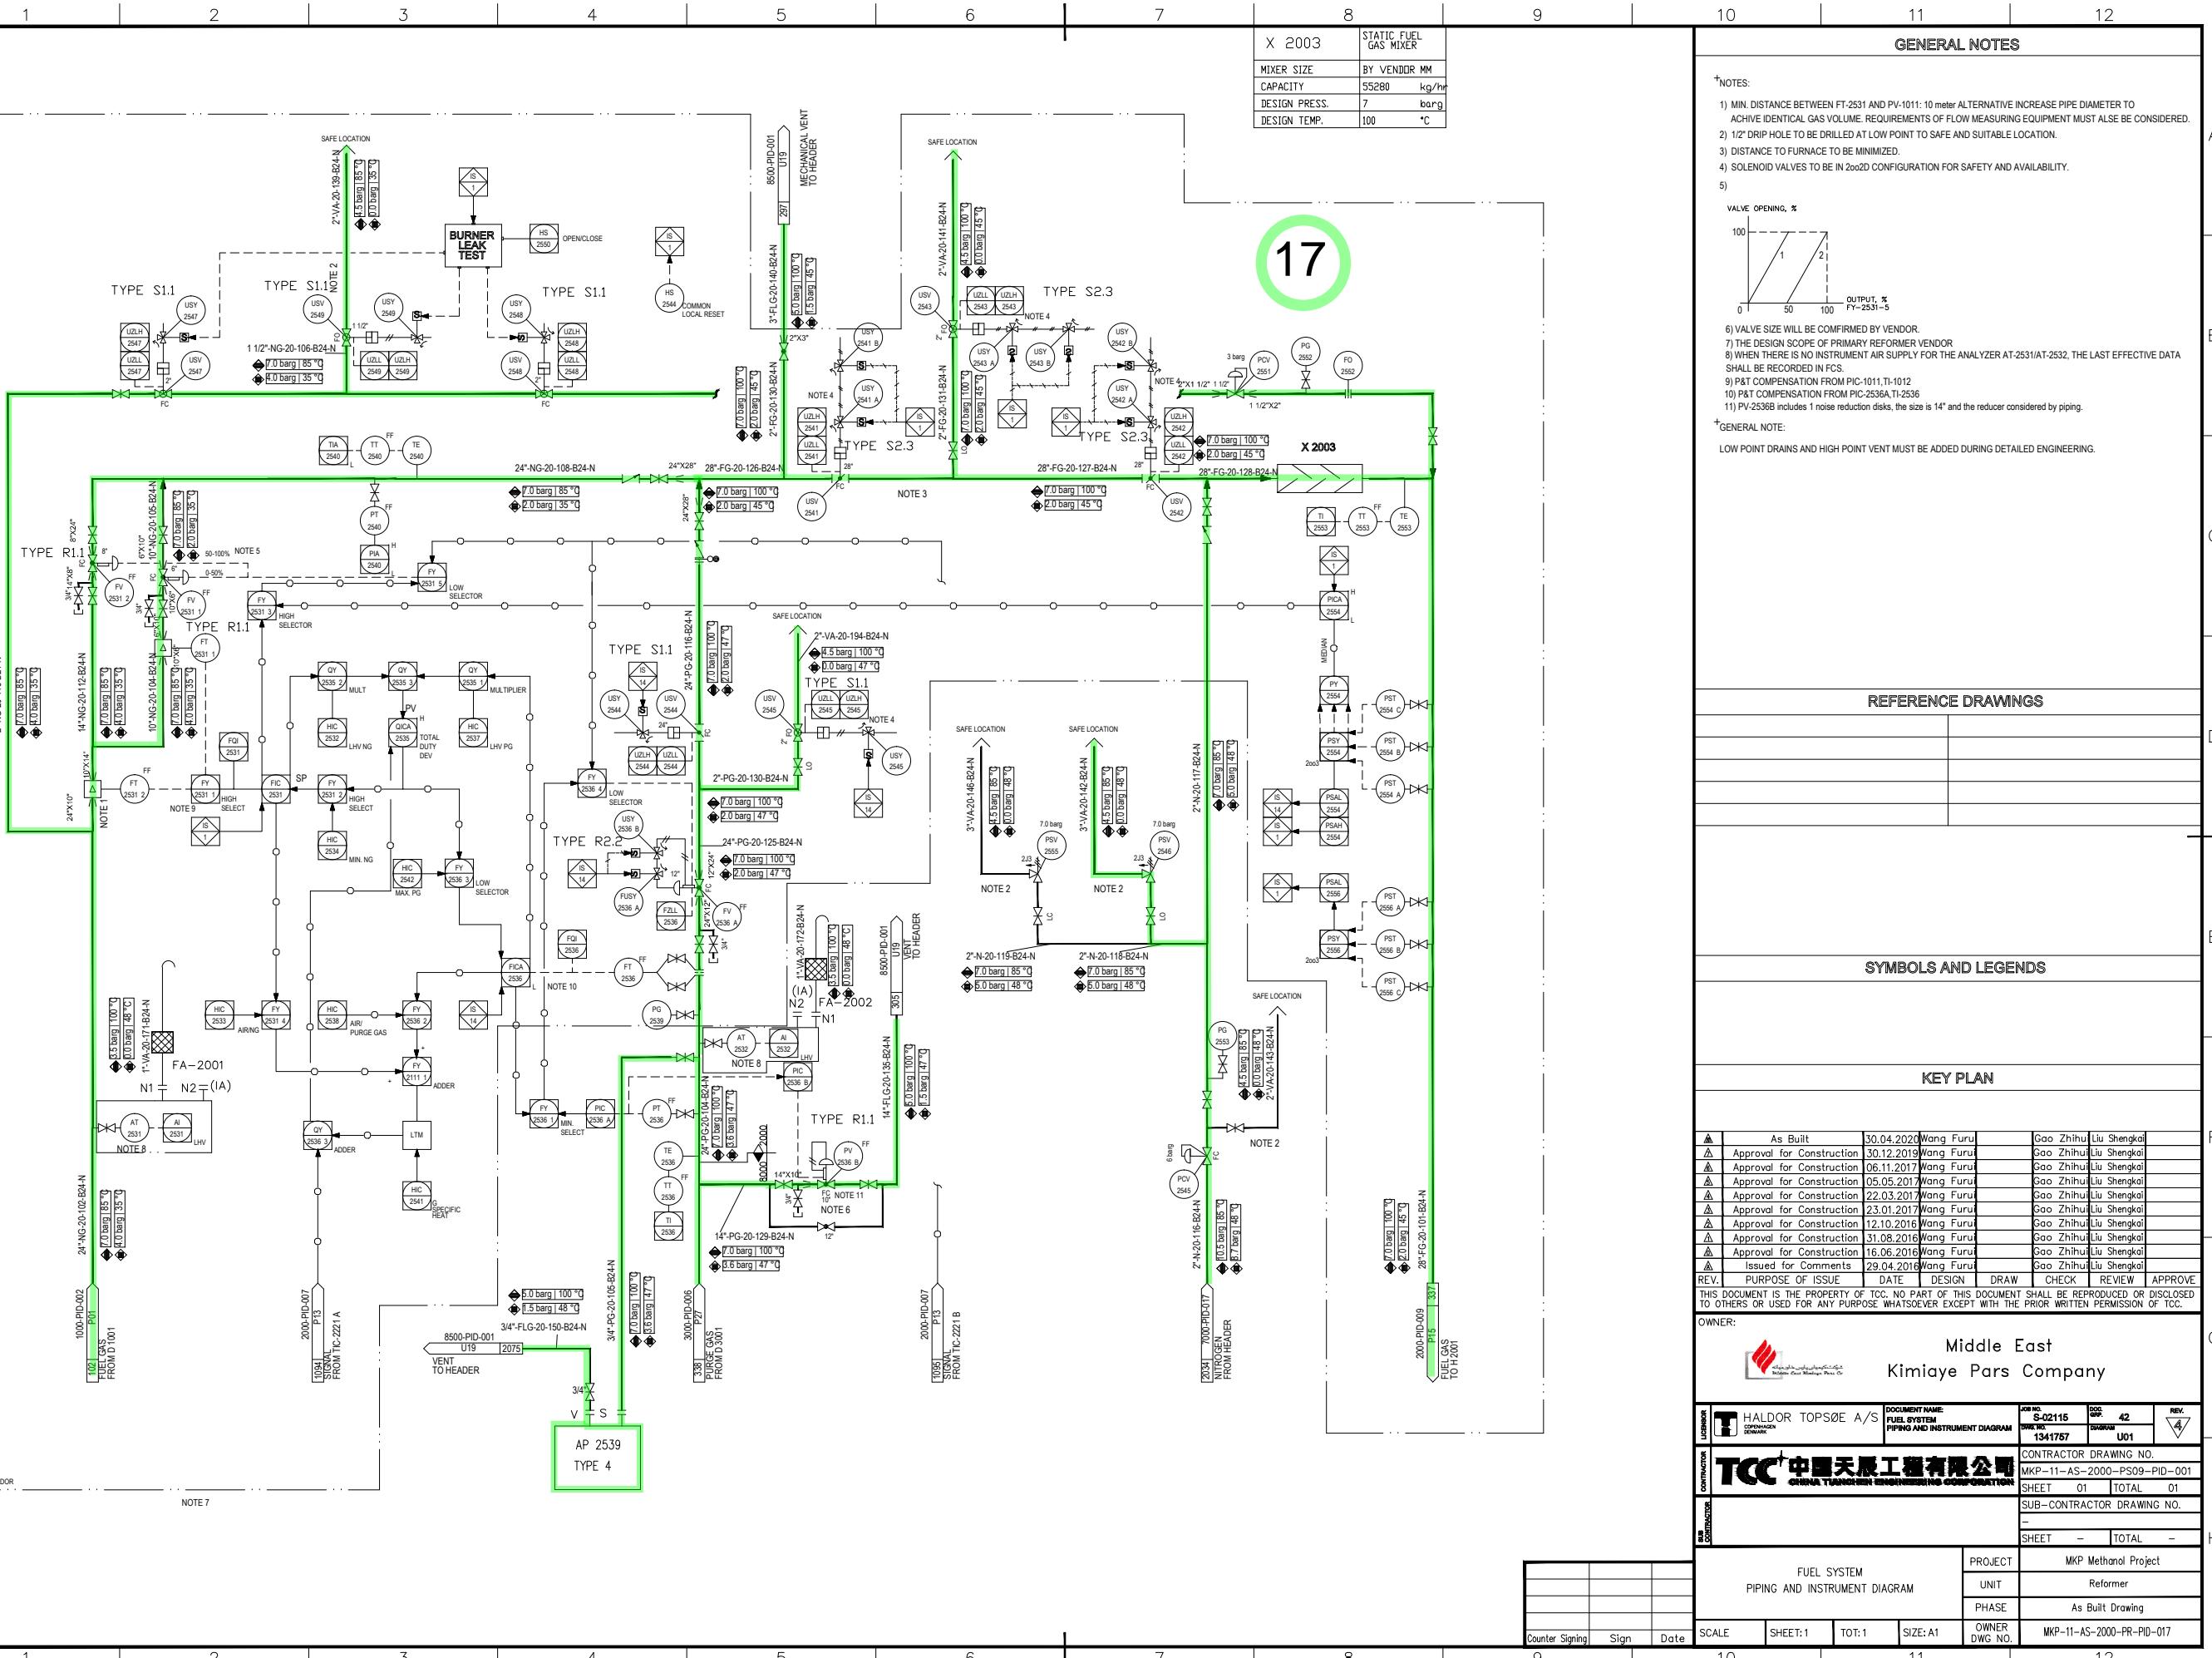

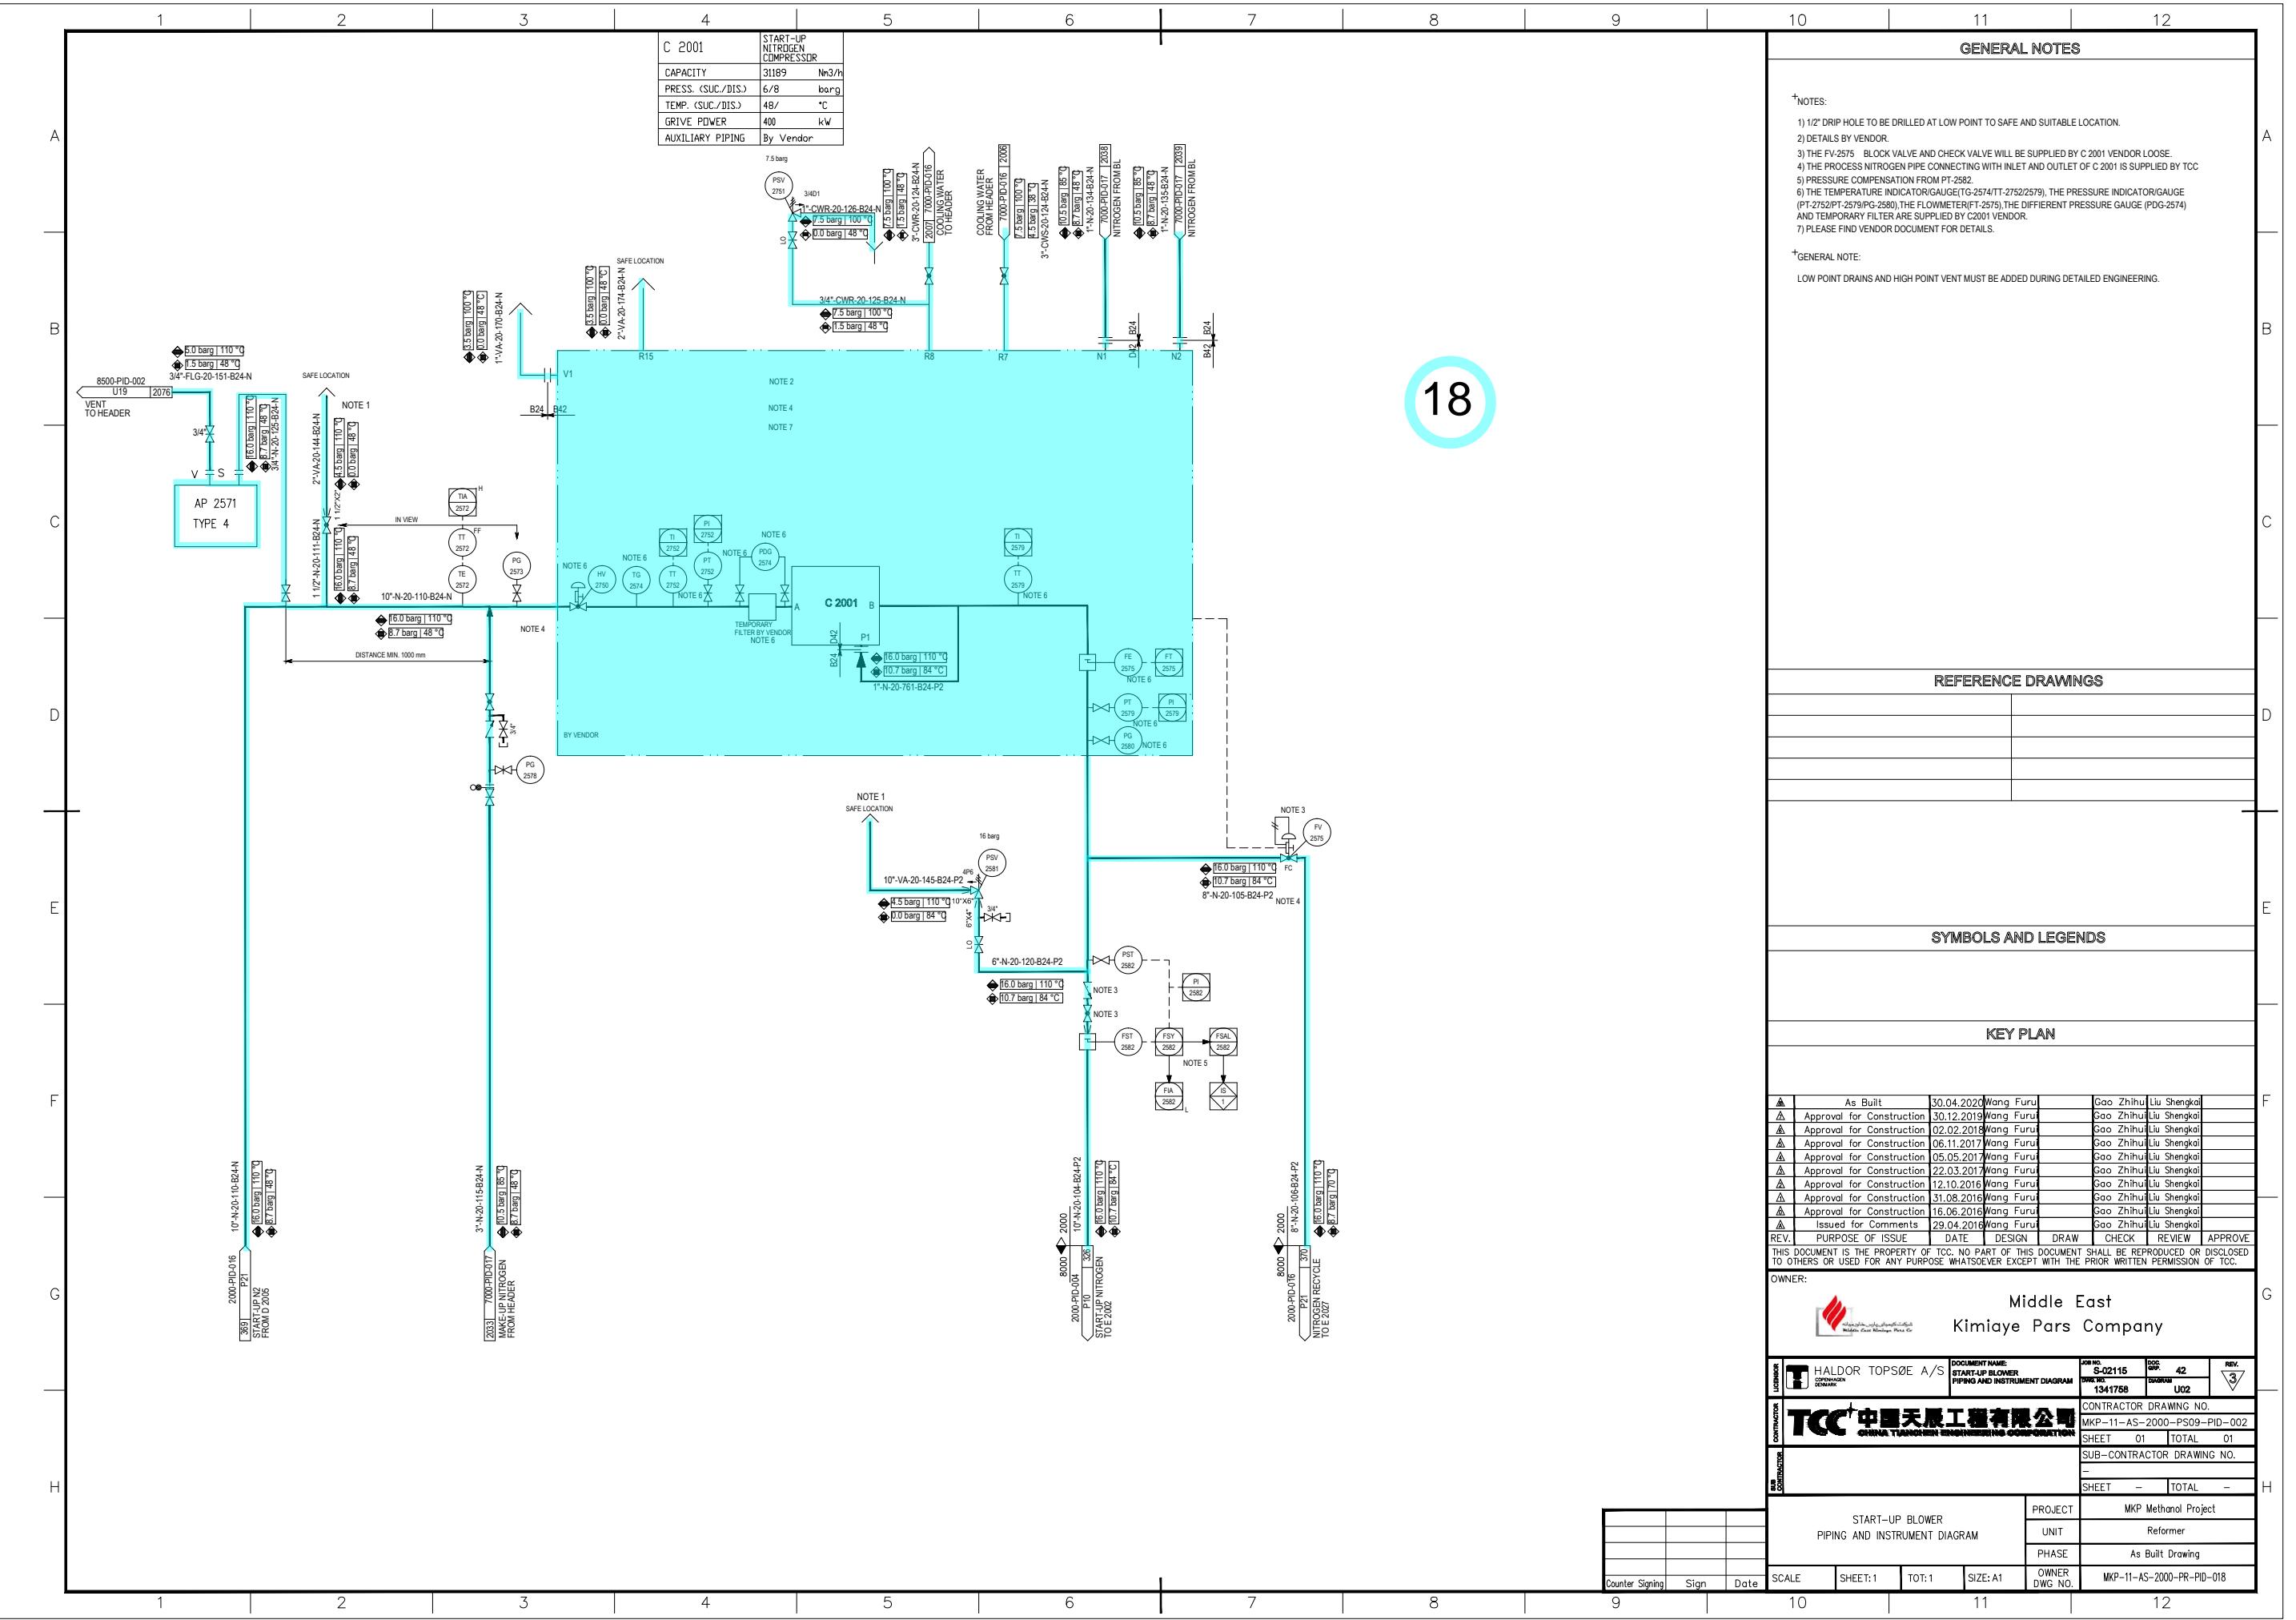


1 2 3 4 5 6 7 8 9 10 11 12

GENERAL NOTES

- ⁺NOTES:
 1) P&T COMPENSATION FROM PI-2607, TI-2607
 2) PSV-2701 IS SUPPLIED BY C2002 VENDOR
 3) PLEASE FIND VENDOR DOCUMENT FOR DETAILS.

⁺GENERAL NOTE:
 LOW POINT DRAINS AND HIGH POINT VENT MUST BE ADDED DURING DETAILED ENGINEERING.

19

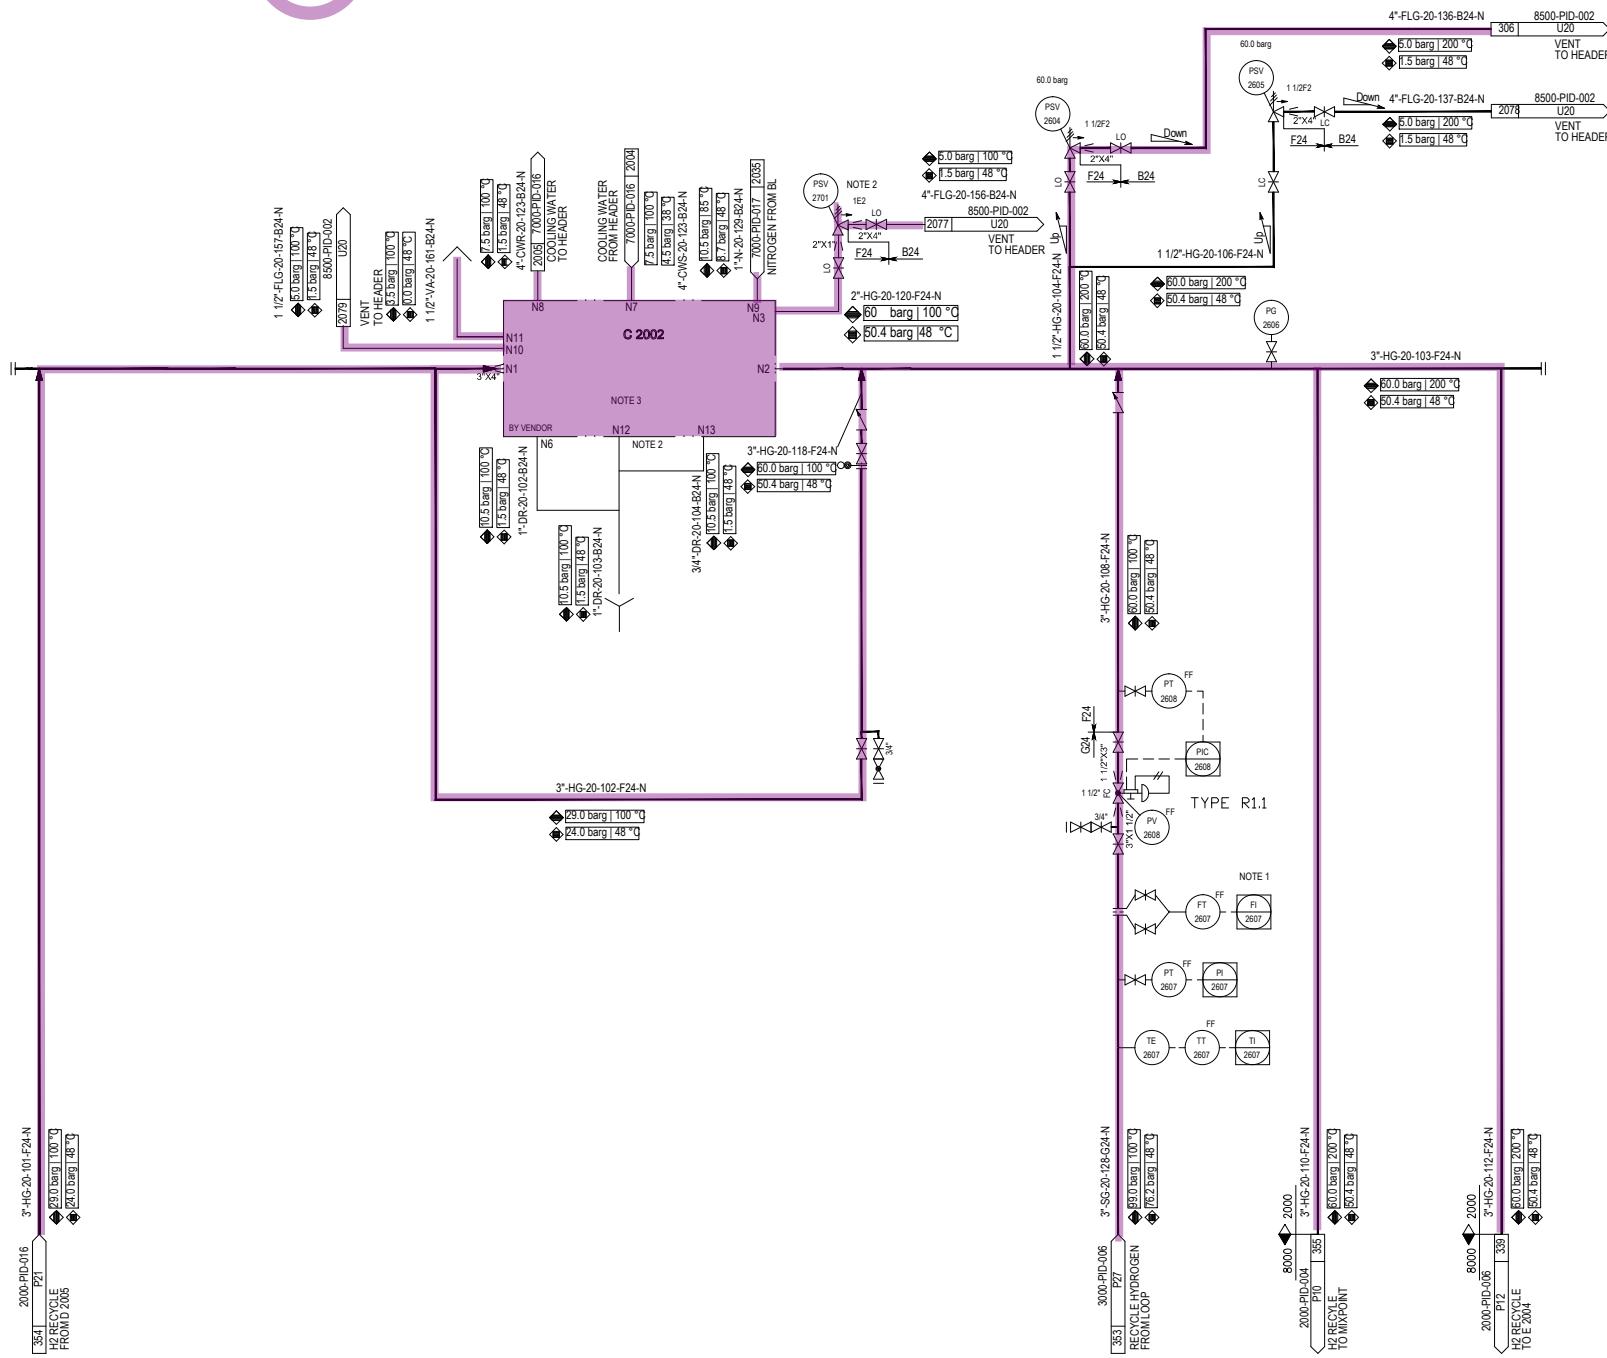

REFERENCE DRAWINGS

SYMBOLS AND LEGENDS

KEY PLAN

▲	As Built	30.04.2020 Wang Furui	Gao Zhihu Liu Shengkai
▲	Approval for Construction	30.12.2019 Wang Furui	Gao Zhihu Liu Shengkai
▲	Approval for Construction	02.02.2018 Wang Furui	Gao Zhihu Liu Shengkai
▲	Approval for Construction	06.11.2017 Wang Furui	Gao Zhihu Liu Shengkai
▲	Approval for Construction	05.05.2017 Wang Furui	Gao Zhihu Liu Shengkai
▲	Approval for Construction	22.03.2017 Wang Furui	Gao Zhihu Liu Shengkai
▲	Approval for Construction	23.01.2017 Wang Furui	Gao Zhihu Liu Shengkai
▲	Approval for Construction	10.11.2016 Wang Furui	Gao Zhihu Liu Shengkai
▲	Approval for Construction	12.10.2016 Wang Furui	Gao Zhihu Liu Shengkai
▲	Approval for Construction	31.08.2016 Wang Furui	Gao Zhihu Liu Shengkai
▲	Approval for Construction	16.06.2016 Wang Furui	Gao Zhihu Liu Shengkai
▲	Issued for Comments	29.04.2016 Wang Furui	Gao Zhihu Liu Shengkai

REV. PURPOSE OF ISSUE DATE DESIGN DRAW CHECK REVIEW APPROVE
 THIS DOCUMENT IS THE PROPERTY OF TCC. NO PART OF THIS DOCUMENT SHALL BE REPRODUCED OR DISCLOSED
 TO OTHERS OR USED FOR ANY PURPOSE WHATSOEVER EXCEPT WITH THE PRIOR WRITTEN PERMISSION OF TCC.

OWNER:

Middle East
 Kimiaye Pars Company

CONTRACTOR	LICENSOR	DOCUMENT NAME:		JOB NO. S-02115	DOC. NO. 42	DRAWN BY U17	REV. □
		CONTRACTOR DRAWING NO.	DRAWN BY				
HALDOR TOPSOE A/S CONTRACTOR DENMARK		MRK-11-AS-2000-PS09-PID-003					
TCC CHINA TIANJIN ENGINEERING CORPORATION		SHEET 01 TOTAL 01					
		SUB-CONTRACTOR DRAWING NO.					
		-					
		SHEET - TOTAL -					
H2 RECYCLE SYSTEM PIPING AND INSTRUMENT DIAGRAM		PROJECT MKP Methanol Project					
		UNIT Reformer					
		PHASE As Built Drawing					
		SCALE SHEET:1 TOT:1 SIZE:A1 OWNER DWG NO.					
		MKP-11-AS-2000-PR-PID-019					

Counter Signing	Sign	Date

GENERAL NOTES

+NOTES:

1) THERMOWELL TABLE IS SHOWED BELOW (ONE TW FOR EACH TUBE BOX OUTLET):

MAE2026A, MAE2026B, MAE2026C, MAE2026D, MAE2026E, MAE2026F, MAE2026G, MAE2026H	B1 TW2473A	B13 TW2473G
	B3 TW2473B	B15 TW2473H
	B5 TW2473C	B17 TW2473I
	B7 TW2473D	B19 TW2473J
	B9 TW2473E, MAE2026F, MAE2026G, MAE2026H	B21 TW2473K
	B9 TW2473F	B23 TW2473L

2) CANTILEVER CRANE IS USED FOR AE-2026 MAINTENANCE.

REFERENCE DRAWINGS

SYMBOLS AND LEGENDS

KEY PLAN

REV. PURPOSE OF ISSUE DATE DESIGN DRAW CHECK REVIEW APPROVE
 THIS DOCUMENT IS THE PROPERTY OF TCC. NO PART OF THIS DOCUMENT SHALL BE REPRODUCED OR DISCLOSED TO OTHERS OR USED FOR ANY PURPOSE WHATSOEVER EXCEPT WITH THE PRIOR WRITTEN PERMISSION OF TCC.

OWNER:
 Middle East
 Kimiaye Pars Company

LICENSOR DOCUMENT NAME: JDN NO. DCS REV.
 SHELF NO. CHASRAN

CONTRACTOR DRAWING NO.
 MKP-11-AS-2000-PS07-PID-017
 SHEET 01 TOTAL 01

SUB-CONTRACTOR DRAWING NO.
 -
 SHEET - TOTAL -

PROJECT MKP Methanol Project
 UNIT Reformer
 PHASE As Built Drawing

AIR COOLER AE 2026 DETAIL
 PIPING AND INSTRUMENT DIAGRAM

Counter Signing Sign Date
 SCALE SHEET:1 TOT:1 SIZE: A1
 OWNER DWG NO. MKP-11-AS-2000-PR-PID-020

17

1 **2** **3** **4** **5** **6** **7** **8** **9** **10** **11** **12**

L 2004 CANTILEVER CRANE
 TYPE COLUMN CANTILEVER
 CAPACITY 1 t
 LIFT HEIGHT 20 m
 SLIDING DISTANCE 1.8 m

AE 2026 AIR COOLER
 DUTY 51.3 MW
 ID x LENGTH(T-T) BY VENDOR mm
 DESIGN PRESS.(TU/SH) 29 barg
 DESIGN TEMP.(TU/SH) 200 °C

NOTE 2

34"-RFG-20-124-D40-P2
 29.0 barg | 200 °C
 24.4 barg | 132 °C

Similar **Similar** **Similar** **Similar** **Similar**

MAE 2026 B **MAE 2026 A** **MAE 2026 D** **MAE 2026 C** **MAE 2026 F** **MAE 2026 E** **MAE 2026 G** **MAE 2026 H** **MAE 2026 J** **MAE 2026 I** **MAE 2026 K** **MAE 2026 L** **MAE 2026 M**

MAE 2026 D40-P2
 29.0 barg | 120 °C
 24.2 barg | 65 °C

NOTE 1

NOTE 2

NOTE 3

NOTE 516

NOTE