

DATA SHEET OF CO2 EXTINGUISHING SYSTEM						
PROTECTION AREA	VOLUME (TOTAL) m <sup>3</sup>	VOLUME FACTOR kg/m <sup>3</sup>	CO <sub>2</sub> REQUIRED (SAFETY FACTOR 10%) kg	QUANTITY OF CYLINDER (42kg)		
				MAIN	RESERVE	
1	Cable room(MCC)	3132	1.33	4583	110	120
2	Battery room(MCC)	248	1.33	363	9	
3	0.4kV SWG room(MCC)	3430	1.33	5018	120	
4	6kV SWG room(MCC)	1992	1.33	2914	70	
5	Cabinet room(CCR)	147	1.33	243	9	
	UPS room(CCR)	18				

- ### GENERAL NOTES
- ALL RELEVANT EQUIPMENT, INSTRUMENTATION, PIPING, NUMBER OF CYLINDERS AND ALL REQUIRED FACILITIES WITHIN THIS DIAGRAM SHALL BE DESIGNED AND FINALIZED BY VENDOR/ SUPPLIER;
  - QUANTITY AND SIZE OF NOZZLES AND RELEVANT PIPING SHALL BE DEFINED BY VENDOR. INDICATED NUMBERS OF CYLINDERS AND NOZZLES ARE SCHEMATIC;
  - A HAND SWITCH SELECTOR BETWEEN MAIN AND RESERVED CYLINDERS SHALL BE CONSIDERED ON PANEL BY VENDOR;
  - THE SYSTEM SHALL DISCHARGE AFTER A SUITABLE WARNING DELAY AFTER INITIATION AND CONFIRMED CLOSURE OF DAMPERS AND SHUTDOWN OF THE LOCAL HVAC SYSTEMS. INTERFACES BETWEEN TOTAL FLOODING AND F&G SYSTEMS SHALL BE CONSIDERED BY VENDOR.
  - APPROPRIATE AND SUFFICIENT LOCAL ALARM DEVICES (AUDIBLE & VISUAL) SUCH AS ALARMS FOR "ENTRY FORBIDDEN / IMMEDIATELY EXIT" FOR EACH ROOM SHALL BE CONSIDERED BY VENDOR.
  - APPROPRIATE AND SUFFICIENT ALARM DEVICES AND OTHER RELEVANT REQUIREMENTS ON CONTROL PANEL SHALL BE CONSIDERED BY VENDOR.
  - A PRESSURE ALARM HIGH SHALL BE CONSIDERED ON CONTROL PANEL BY VENDOR.
  - A WEIGHT ALARM LOW SHALL BE CONSIDERED ON CONTROL PANEL BY VENDOR.
  - VENDOR SHALL FINALIZE THE DISCHARGE LOCATION OF PSV. PSV SHALL BE DISCHARGED TO SAFE LOCATION.
  - APPROPRIATE AND SUFFICIENT RESET AND SILENCE SWITCH, LOCAL MANUAL DISCHARGE AND INHIBITION DEVICES AND OTHER RELEVANT REQUIREMENTS SHALL BE CONSIDERED BY VENDOR.
  - VENT PLUG SHALL BE PROVIDED FOR THE LAST CYLINDER BY VENDOR.
  - SUPPLIERS CAN ONLY PROPOSE N2 PILOTTED SYSTEM.
  - SIGNALS FROM CO2 EXTINGUISHING CONTROL PANEL WOULD BE SENT TO FACP WHICH WILL BE LOCATED IN CONTROL BUILDING.
  - AUTO/MANUAL/INHIBIT SWITCH & MANUAL RELEASE SHALL BE CONSIDERED FOR EACH PROTECTION AREA.
  - REQUIREMENTS OF NFPA-12 SHALL BE CONSIDERED COMPLETELY.
  - TEST & COMMISSIONING SHALL BE IN ACCORDANCE WITH REQUIREMENTS OF NFPA.
  - PROPOSED PACKAGE SHOULD HAD BEEN CERTIFIED OR APPROVED BY ONE OF THE LEADING FIRE FIGHTING AUTHORITIES.
  - FOR PRELIMINARY CALCULATIONS REFER TO DATA SHEET.
  - THE PIPE BETWEEN MCC AND CCR WILL BE ARRANGED UNDERGROUND.
  - ONCE FIRE OCCURS, BOTH OF THE TWO PROTECTION AREA IN CCR WILL BE INJECTED CO2 TOGETHER.

### REFERENCE DRAWINGS

MKP-11-DE-0202-SF-PID-001
---------------------------

### SYMBOLS AND LEGENDS

	Safety relief valve	WSL	Weight switch low
	Gas check valve		Auto/Manual/Inhibit switch
	Cylinder valve		Manual discharge
	Solenoid cylinder valve		Alarm unit (Entry forbidden)
	Selector valve		Alarm unit (Immediately exit)
	Gas flow direction		Siren
	Gas nozzle		

As built	30.04.2020	Liu Jian		Cui Yanjun	Deng Wenhui		
Approved for Construction	14.12.2016	Li Yang		Cui Yanjun	Deng Wenhui		
Approved for Construction	23.09.2016	Li Yang		Cui Yanjun	Deng Wenhui		
Approved for Construction	02.09.2016	Li Yang		Cui Yanjun	Deng Wenhui		
REV.	PURPOSE OF ISSUE	DATE	DESIGN	DRAW	CHECK	REVIEW	APPROVE

THIS DOCUMENT IS THE PROPERTY OF TCC. NO PART OF THIS DOCUMENT SHALL BE REPRODUCED OR DISCLOSED TO OTHERS OR USED FOR ANY PURPOSE WHATSOEVER EXCEPT WITH THE PRIOR WRITTEN PERMISSION OF TCC.

OWNER:

Middle East  
Kimiaye Pars Company

LICENSOR <b>T</b> HALDOR TOPSØE A/S	DOCUMENT NAME:	JOB NO.	DOC. GRP.	REV.
CONTRACTOR <b>TCC</b> 中国天辰工程有限公司 CHINA TIANCHEN ENGINEERING CORPORATION	CONTRACTOR DRAWING NO.			
	MKP-11-AS-0201-PF03-PID-001			
SUB-CONTRACTOR	SUB-CONTRACTOR DRAWING NO.			
	-			
SCALE N/A SHEET 1		TOT. 1	SIZE A1	OWNER MKP-11-AS-0201-SF-PID-001
PROJECT MKP Methanol Project		UNIT MCC Substation		
PHASE As built drawing		OWNER MKP-11-AS-0201-SF-PID-001		
DWG NO.				

Counter	Sign	Date

Total Flooding CO2 Fire Extinguishing System  
X-9701

**DATA SHEET OF CO2 EXTINGUISHING SYSTEM**

PROTECTION AREA	VOLUME (TOTAL) m <sup>3</sup>	VOLUME FACTOR kg/m <sup>3</sup>	CO <sub>2</sub> REQUIRED (SAFETY FACTOR 10%) kg	QUANTITY OF CYLINDER (42kg)	
				MAIN	RESERVE
1 Cable room(MCC)	3132	1.33	4583	110	120
2 Battery room(MCC)	248	1.33	363	9	
3 0.4kV SWG room(MCC)	3430	1.33	5018	120	
4 6kV SWG room(MCC)	1992	1.33	2914	70	
5 Cabinet room(CCR)	147	1.33	243	9	
UPS room(CCR)	18				

**GENERAL NOTES**

- ALL RELEVANT EQUIPMENT, INSTRUMENTATION, PIPING, NUMBER OF CYLINDERS AND ALL REQUIRED FACILITIES WITHIN THIS DIAGRAM SHALL BE DESIGNED AND FINALIZED BY VENDOR/ SUPPLIER;
- QUANTITY AND SIZE OF NOZZLES AND RELEVANT PIPING SHALL BE DEFINED BY VENDOR. INDICATED NUMBERS OF CYLINDERS AND NOZZLES ARE SCHEMATIC;
- A HAND SWITCH SELECTOR BETWEEN MAIN AND RESERVED CYLINDERS SHALL BE CONSIDERED ON PANEL BY VENDOR.
- THE SYSTEM SHALL DISCHARGE AFTER A SUITABLE WARNING DELAY AFTER INITIATION AND CONFIRMED CLOSURE OF DAMPERS AND SHUTDOWN OF THE LOCAL HVAC SYSTEMS. INTERFACES BETWEEN TOTAL FLOODING AND F&G SYSTEMS SHALL BE CONSIDERED BY VENDOR.
- APPROPRIATE AND SUFFICIENT LOCAL ALARM DEVICES (AUDIBLE & VISUAL) SUCH AS ALARMS FOR "ENTRY FORBIDDEN / IMMEDIATELY EXIT" FOR EACH ROOM SHALL BE CONSIDERED BY VENDOR.
- APPROPRIATE AND SUFFICIENT ALARM DEVICES AND OTHER RELEVANT REQUIREMENTS ON CONTROL PANEL SHALL BE CONSIDERED BY VENDOR.
- A PRESSURE ALARM HIGH SHALL BE CONSIDERED ON CONTROL PANEL BY VENDOR.
- A WEIGHT ALARM LOW SHALL BE CONSIDERED ON CONTROL PANEL BY VENDOR.
- VENDOR SHALL FINALIZE THE DISCHARGE LOCATION OF PSV. PSV SHALL BE DISCHARGED TO SAFE LOCATION.
- APPROPRIATE AND SUFFICIENT RESET AND SILENCE SWITCH, LOCAL MANUAL DISCHARGE AND INHIBITION DEVICES AND OTHER RELEVANT REQUIREMENTS SHALL BE CONSIDERED BY VENDOR.
- VENT PLUG SHALL BE PROVIDED FOR THE LAST CYLINDER BY VENDOR.
- SUPPLIERS CAN ONLY PROPOSE N2 PILOTED SYSTEM.
- SIGNALS FROM CO2 EXTINGUISHING CONTROL PANEL WOULD BE SENT TO FAC WHICH WILL BE LOCATED IN CONTROL BUILDING.
- AUTO/MANUAL/INHIBIT SWITCH & MANUAL RELEASE SHALL BE CONSIDERED FOR EACH PROTECTION AREA.
- REQUIREMENTS OF NFPA-12 SHALL BE CONSIDERED COMPLETELY.
- TEST & COMMISSIONING SHALL BE IN ACCORDANCE WITH REQUIREMENTS OF NFPA.
- PROPOSED PACKAGE SHOULD HAD BEEN CERTIFIED OR APPROVED BY ONE OF THE LEADING FIRE FIGHTING AUTHORITIES.
- FOR PRELIMINARY CALCULATIONS REFER TO DATA SHEET.
- THE PIPE BETWEEN MCC AND CCR WILL BE ARRANGED UNDERGROUND.
- ONCE FIRE OCCURS, BOTH OF THE TWO PROTECTION AREA IN CCR WILL BE INJECTED CO2 TOGETHER.

**REFERENCE DRAWINGS**

MKP-11-DE-0201-SF-PID-001

**SYMBOLS AND LEGENDS**

	Gas flow direction		
	Gas nozzle		

REV.	PURPOSE OF ISSUE	DATE	DESIGN	DRAW	CHECK	REVIEW	APPROVE
△	As built	30.04.2020	Liu Jian		Cui Yanjun	Deng Wenhui	
△	Approved for Construction	14.12.2016	Li Yang		Cui Yanjun	Deng Wenhui	
△	Approved for Construction	23.09.2016	Li Yang		Cui Yanjun	Deng Wenhui	
△	Approved for Construction	02.09.2016	Li Yang		Cui Yanjun	Deng Wenhui	

THIS DOCUMENT IS THE PROPERTY OF TCC. NO PART OF THIS DOCUMENT SHALL BE REPRODUCED OR DISCLOSED TO OTHERS OR USED FOR ANY PURPOSE WHATSOEVER EXCEPT WITH THE PRIOR WRITTEN PERMISSION OF TCC.

OWNER:




Middle East  
Kimiaye Pars Company

LICENSOR	HALDOR TOPSØE A/S	DOCUMENT NAME:	JOB NO.	DOC. GRP.	REV.
			DWG. NO.	DATE	


CONTRACTOR	TCC 中国天辰工程有限公司 CHINA TIANCHEN ENGINEERING CORPORATION	CONTRACTOR DRAWING NO.	
		MKP-11-AS-0202-PF03-PID-001	
		SHEET 01	TOTAL 01

SUB-CONTRACTOR	SUB-CONTRACTOR LOGO	SUB-CONTRACTOR DRAWING NO.	
		-	
		SHEET -	TOTAL -

PROJECT	P&ID FOR GAS FIRE EXTINGUISHING SYSTEM IN UNIT 0202		PROJECT	MKP Methanol Project
			UNIT	Control Room
			PHASE	As built drawing
SCALE	N/A	SHEET 1	TOT. 1	SIZE A1
COUNTER SIGNING	Sign	Date	OWNER DWG NO.	MKP-11-AS-0202-SF-PID-001

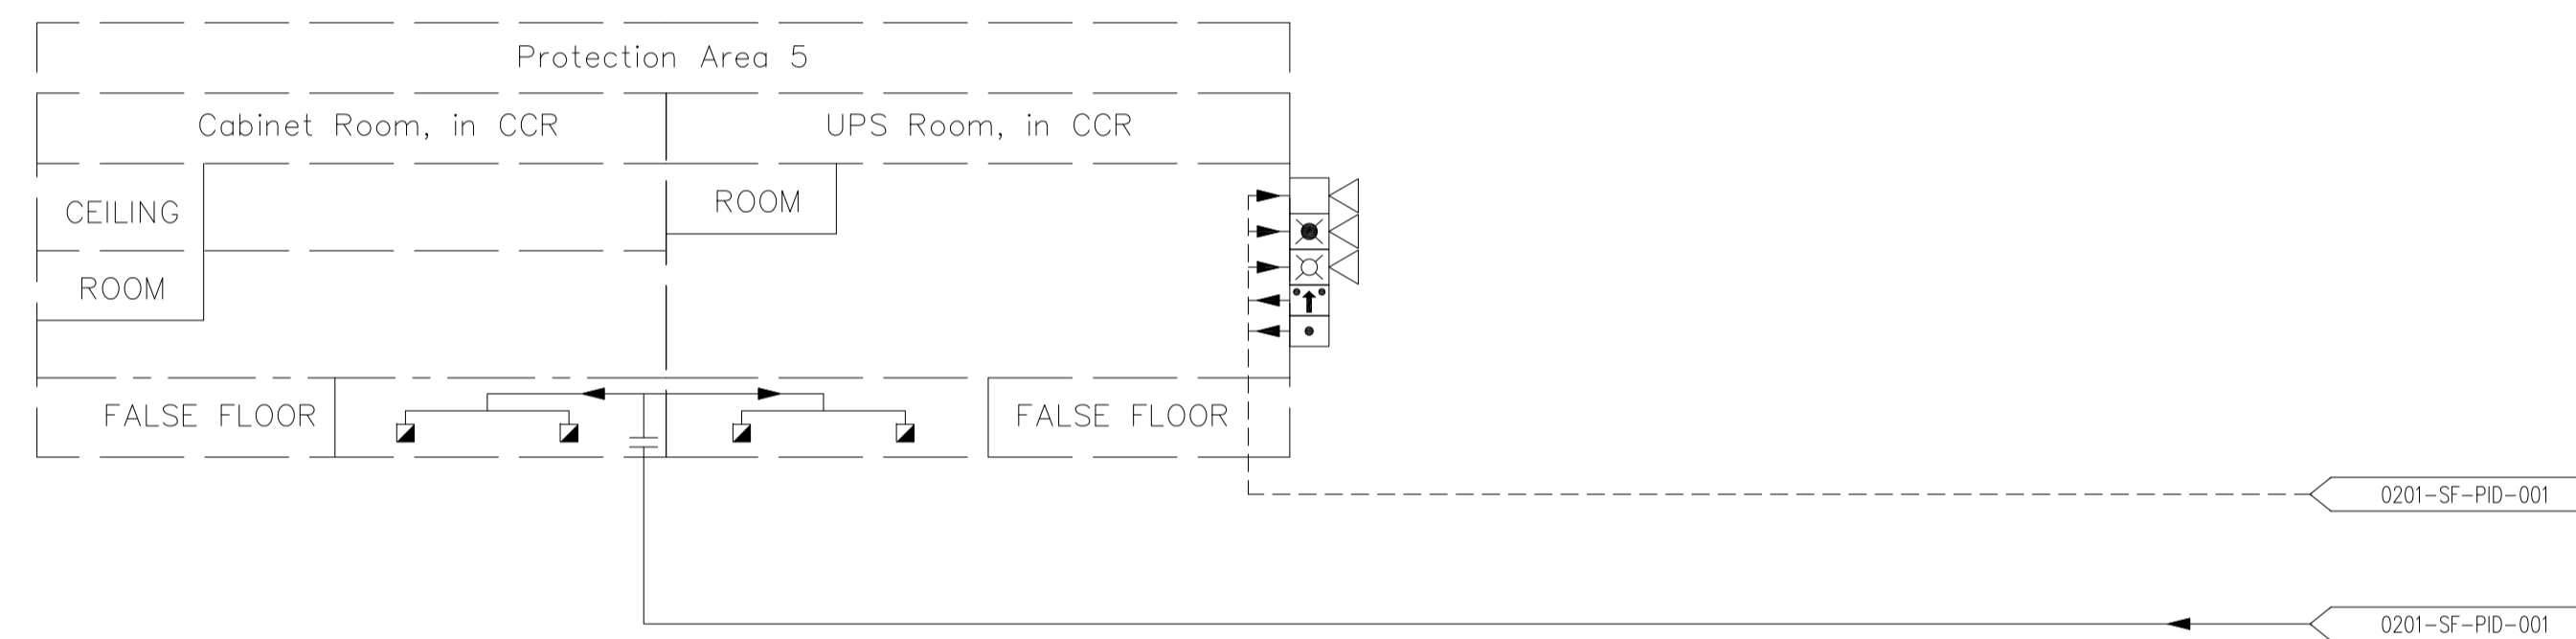



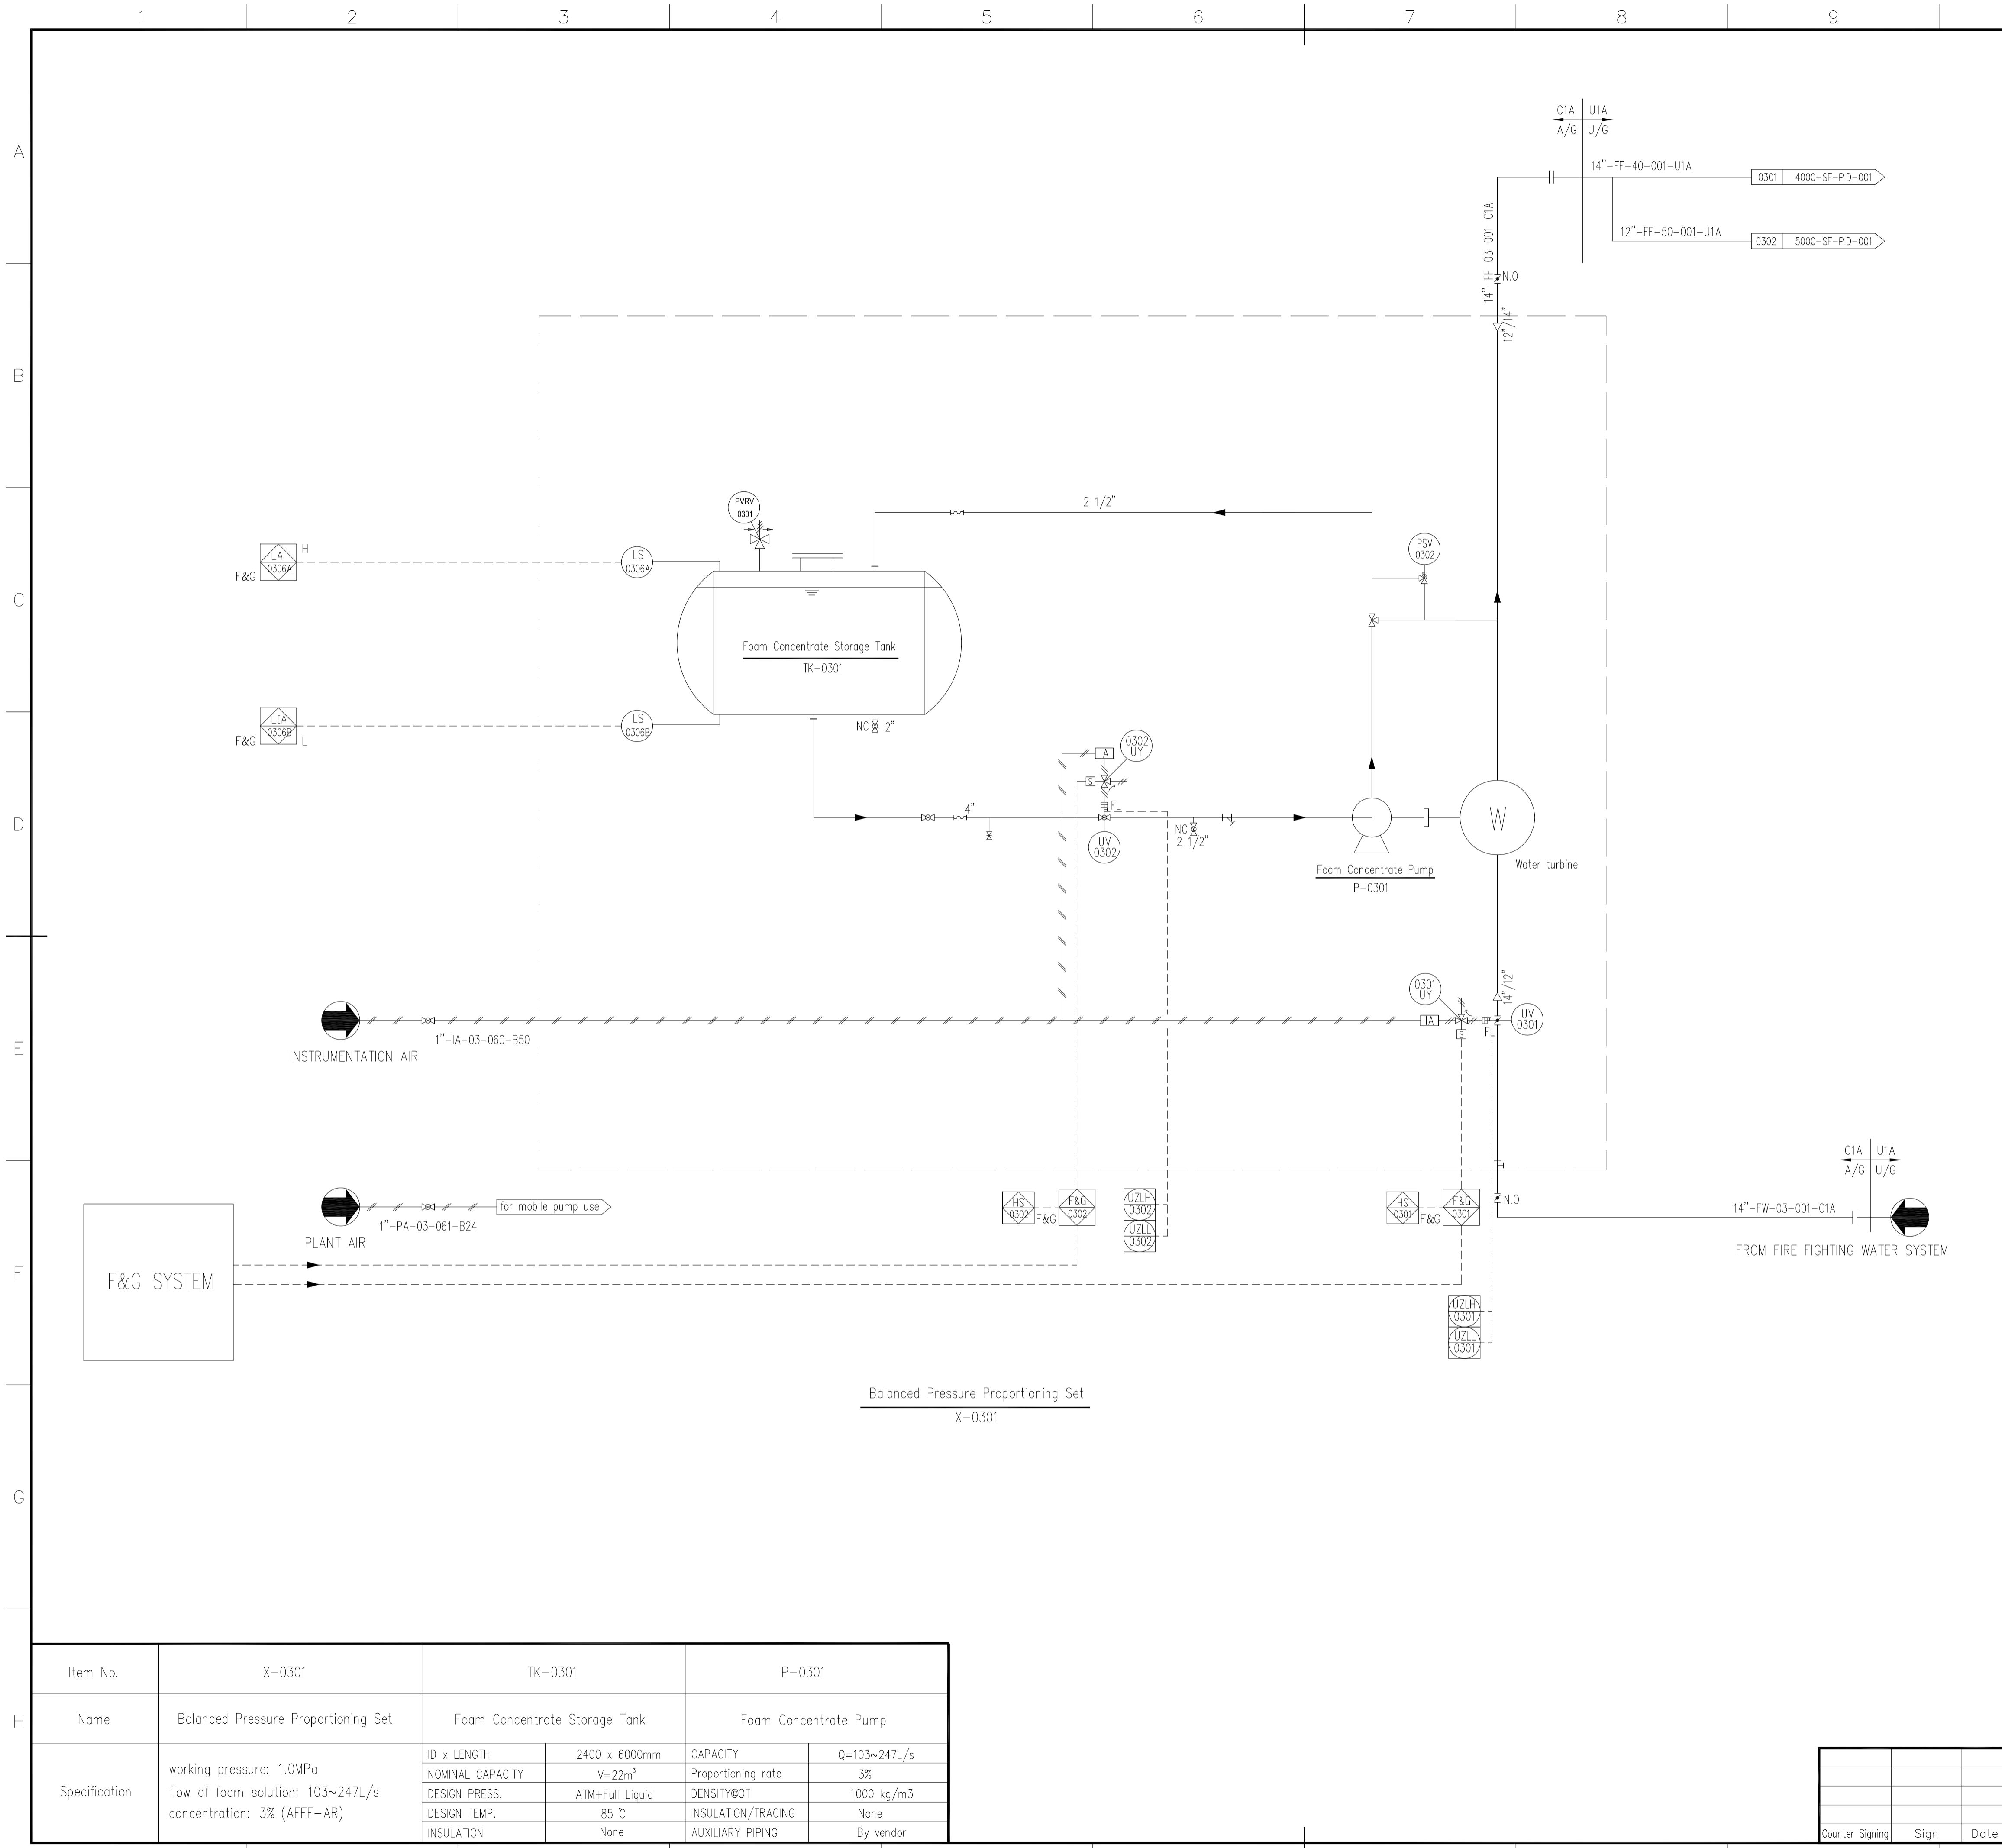

**GENERAL NOTES**

- 1 ALL RELEVANT EQUIPMENT, INSTRUMENTATION, PIPING AND ALL REQUIRED FACILITIES WITHIN THIS DIAGRAM SHALL BE DESIGNED AND FINALIZED BY VENDOR / SUPPLIER;
- 2 SIZE OF RELEVANT PIPING SHALL BE DEFINED BY VENDOR.
- 3 THE SYSTEM SHALL BE CONTROLLED IN F&G SYSTEM, AND CONTROL LOGICAL SHALL BE SUPPLIED BY VENDOR.
- 4 VENDOR SHALL FINALIZE THE SET PRESSURE OF PSV.
- 5 PNEUMATIC VALVE SHALL EQUIPPED WITH HAND WHEEL SWITCH.
- 6 REQUIREMENTS OF NFPA-11 AND NFPA-20 SHALL BE CONSIDERED COMPLETELY.
- 7 TEST & COMMISSIONING SHALL BE IN ACCORDANCE WITH REQUIREMENTS OF NFPA.

**PIPE NUMBER**

14" - FW - 03 - 001 - C1A

Pipe Class Code  
Sequence Number  
Unit Number  
Fluid Code  
Nominal Diameter

**REFERENCE DRAWINGS**

MKP-11-DE-4000-SF-PID-001	MKP-11-DE-5000-SF-PID-001
MKP-11-DE-0300-PI-PPL-001	MKP-11-DE-9700-SF-SPC-001
MKP-11-DE-9700-SF-EQL-001	MKP-11-DE-7000-PR-PID-018

**SYMBOLS AND LEGENDS**

	Pneumatic valve		Trench
IA	Instrumental air	FL	Failure locked
N.O	Normal open	NC	Normal close
F&G	Fire and Gas system	FF	Foam solution
FW	Fire water		

As built	30.04.2020	Liu Jian		Cui Yanjun	Deng Wenhui
Approved for Construction	25.12.2019	Li Yang		Cui Yanjun	Deng Wenhui
Approved for Construction	10.12.2019	Li Yang		Cui Yanjun	Deng Wenhui
Approved for Construction	30.09.2017	Li Yang		Cui Yanjun	Deng Wenhui
Approved for Construction	23.09.2016	Li Yang		Cui Yanjun	Deng Wenhui
Approved for Construction	02.09.2016	Li Yang		Cui Yanjun	Deng Wenhui

THIS DOCUMENT IS THE PROPERTY OF TCC. NO PART OF THIS DOCUMENT SHALL BE REPRODUCED OR DISCLOSED TO OTHERS OR USED FOR ANY PURPOSE WHATSOEVER EXCEPT WITH THE PRIOR WRITTEN PERMISSION OF TCC.

OWNER: Middle East Kimiaye Pars Company


HALDOR TOPSØE A/S	DOCUMENT NAME:	JOB NO.	DOC. GRP.	REV.
		DRAW. NO.	DIAGRAM	

<b>TCC</b> 中国天辰工程有限公司 CHINA TIANCHEN ENGINEERING CORPORATION	CONTRACTOR DRAWING NO. MKP-11-AS-0300-PF03-PID-001
SUB-CONTRACTOR LOGO	SHEET 01 TOTAL 01
	SUB-CONTRACTOR DRAWING NO. -
	SHEET - TOTAL -

P&ID FOR FOAM STATION	PROJECT	MKP Methanol Project			
	UNIT	Foam Station			
	PHASE	As built drawing			
SCALE N/A	SHEET 1	TOT. 1	SIZE A1	OWNER DWG NO.	MKP-11-AS-0300-SF-PID-001

Item No.	X-0301	TK-0301	P-0301
Name	Balanced Pressure Proportioning Set	Foam Concentrate Storage Tank	Foam Concentrate Pump
Specification	working pressure: 1.0MPa flow of foam solution: 103~247L/s concentration: 3% (AFFF-AR)	ID x LENGTH	2400 x 6000mm
		NOMINAL CAPACITY	V=22m³
		DESIGN PRESS.	ATM+Full Liquid
		DESIGN TEMP.	85 °C
		INSULATION	None
		CAPACITY	Q=103~247L/s
		Proportioning rate	3%
		DENSITY@OT	1000 kg/m3
		INSULATION/TRACING	None
		AUXILIARY PIPING	By vendor

Counter Signing	Sign	Date
-----------------	------	------

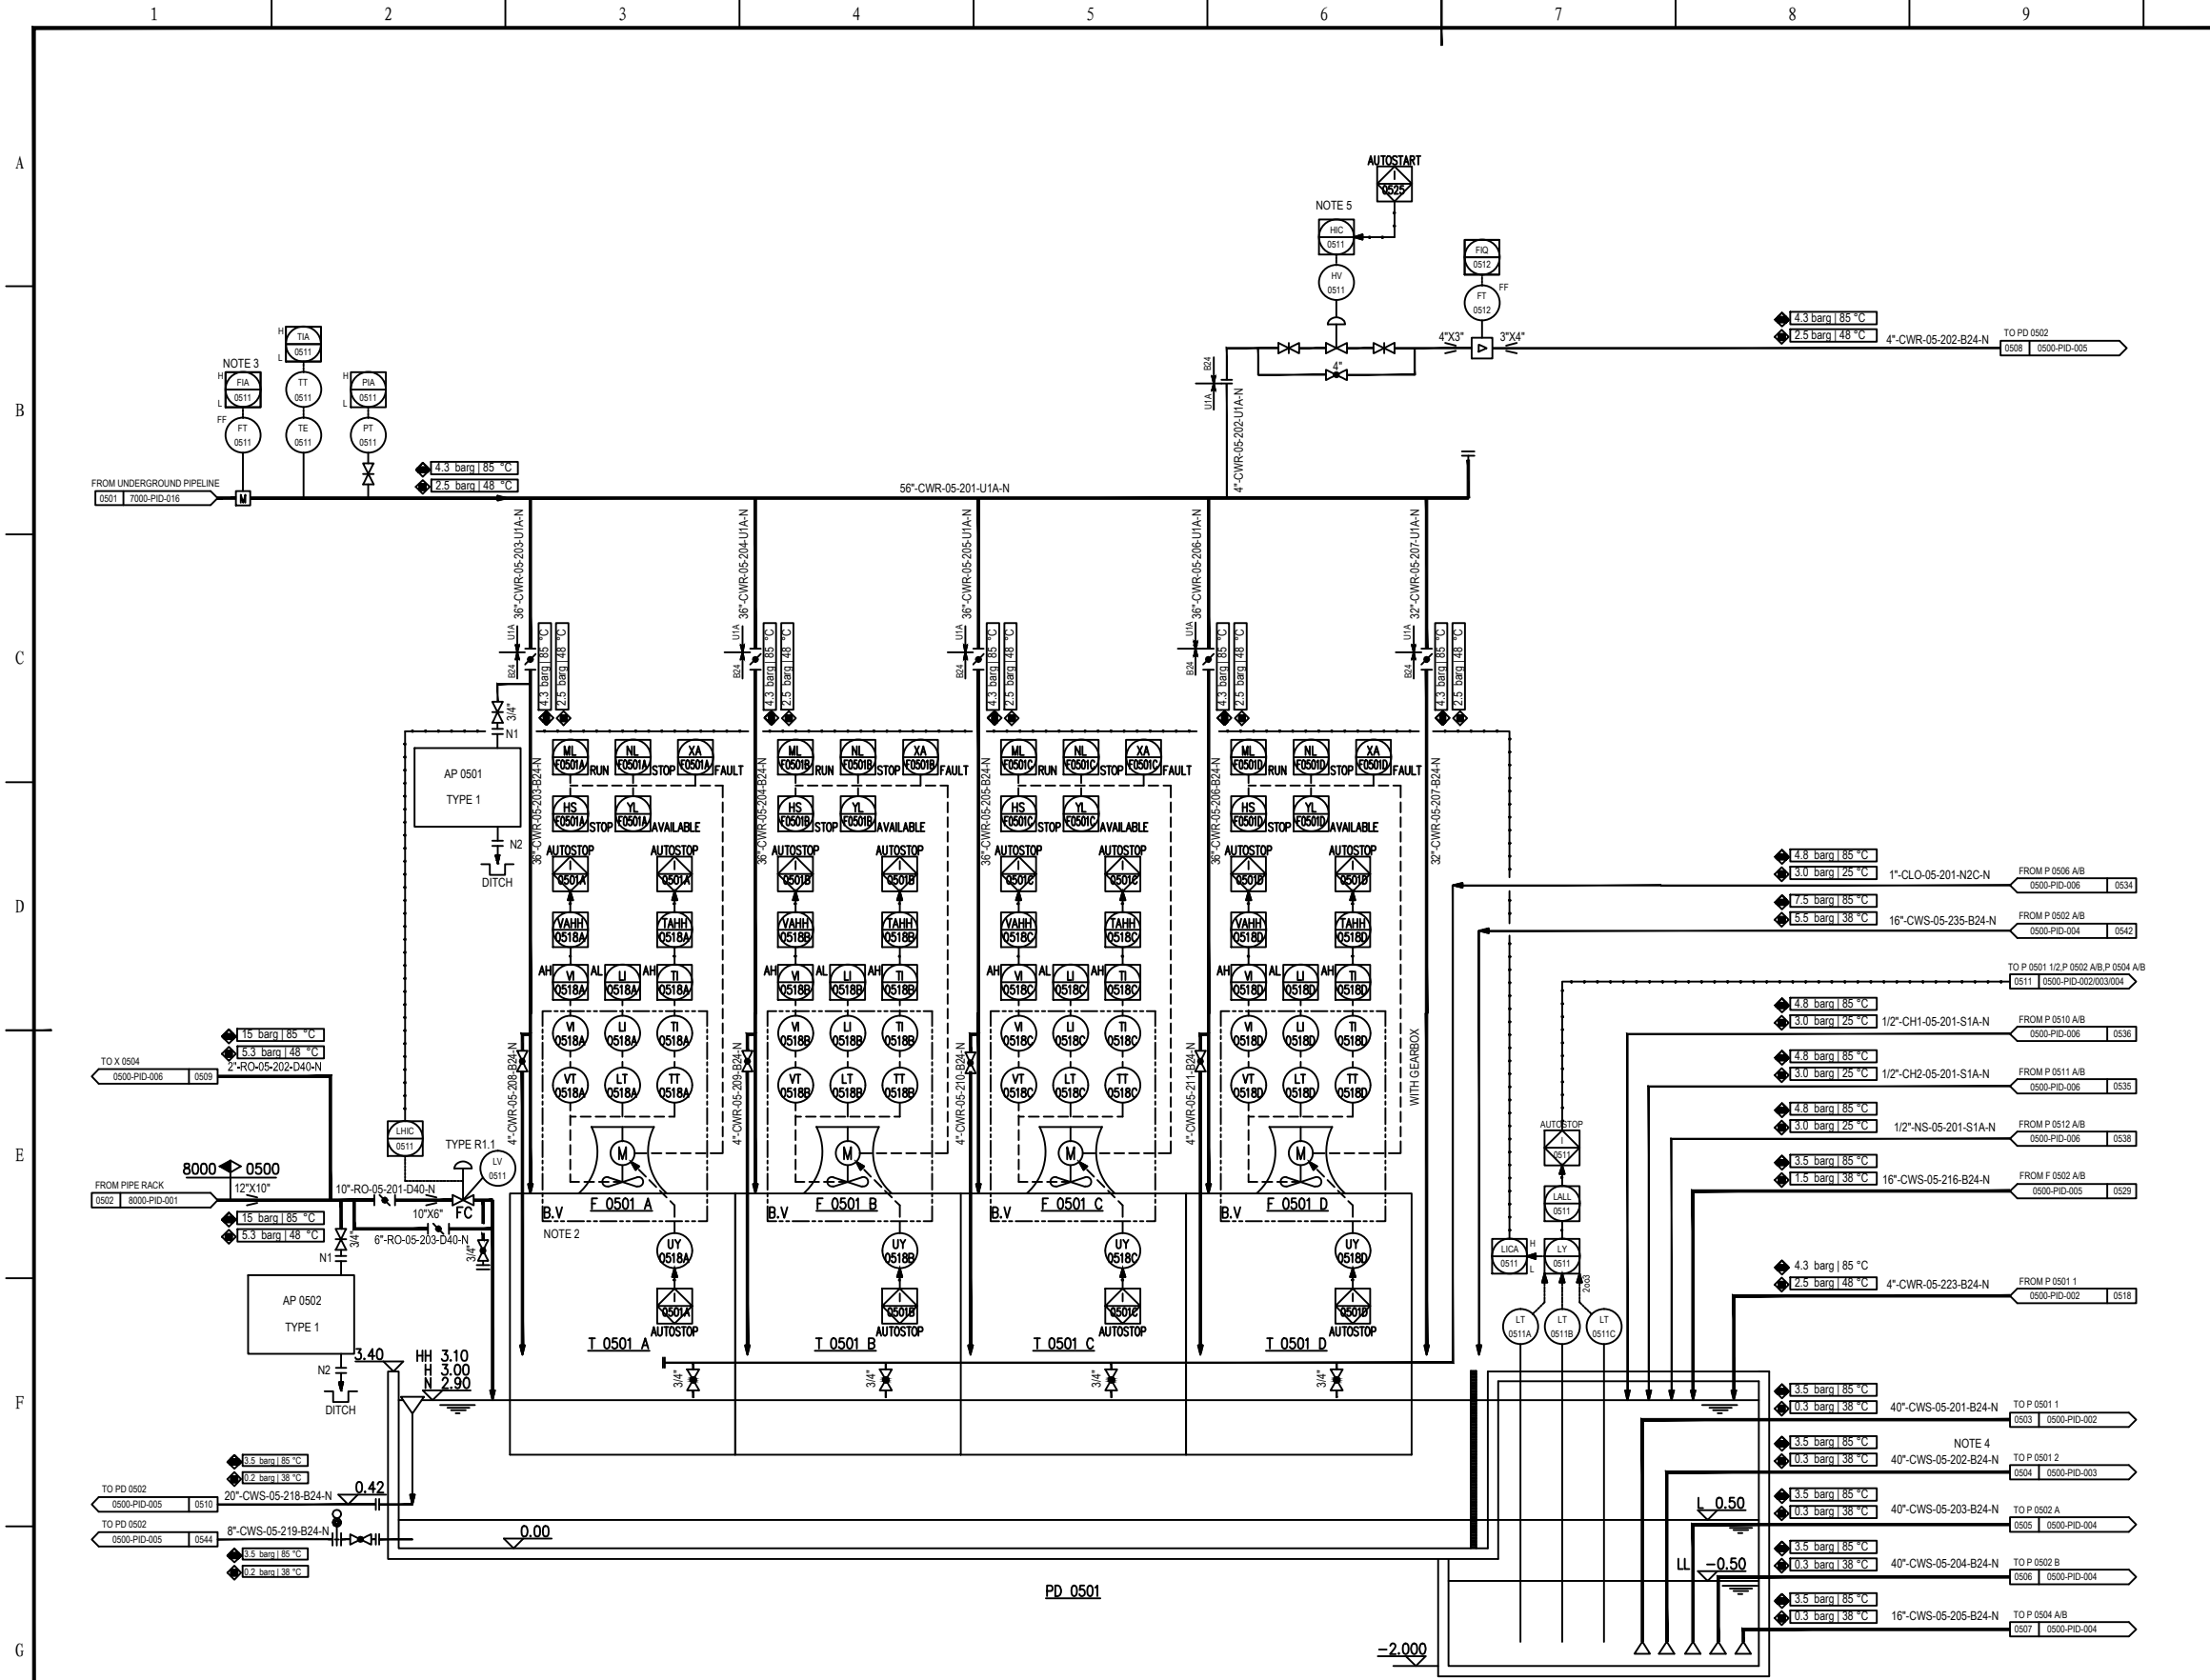

**GENERAL NOTES**

NOTES:

2. VT, LT AND TT ARE LOCATED ON SPEED REDUCER OF FANS.
- V-VIBRATION; L-OIL LEVEL; T-OIL TEMPERATURE.
3. ALARM HIGH TO BE CONSIDERED FOR FI.
4. COOLING WATER PUMPS WILL BE SPACED AT EQUAL DISTANCE SYMMETRICAL TO THE BASIN.
5. THE SIGNAL OF CONTROL VALVE WILL BE SHOWN IN FCS. THE OPERATOR ADJUST THE VALVE IN CONTROL ROOM.

**REFERENCE DRAWINGS**


**SYMBOLS AND LEGENDS**

4.8 barg   85 °C	1"-CLO-05-201-N2C-N	FROM P 0506 A/B	0500-PID-006	0534
3.0 barg   25 °C				
7.5 barg   85 °C	16"-CWS-05-235-B24-N	FROM P 0502 A/B	0500-PID-004	0542
15.5 barg   38 °C				
4.8 barg   85 °C				
3.0 barg   25 °C	1/2"-CH1-05-201-S1A-N	FROM P 0510 A/B	0500-PID-006	0536
4.8 barg   85 °C				
3.0 barg   25 °C	1/2"-CH2-05-201-S1A-N	FROM P 0511 A/B	0500-PID-006	0535
4.8 barg   85 °C				
3.0 barg   25 °C	1/2"-NS-05-201-S1A-N	FROM P 0512 A/B	0500-PID-006	0538
4.8 barg   85 °C				
11.5 barg   38 °C	16"-CWS-05-216-B24-N	FROM F 0502 A/B	0500-PID-005	0529
4.3 barg   85 °C				
12.5 barg   48 °C	4"-CWR-05-223-B24-N	FROM P 0501 1	0500-PID-002	0518

**KEY PLAN**

4.3 barg   85 °C				
12.5 barg   48 °C	4"-CWR-05-202-U1A-N	FROM P 0501 1	0500-PID-002	0518
3.5 barg   85 °C				
10.3 barg   38 °C	40"-CWS-05-201-B24-N	TO P 0501 1	0503   0500-PID-002	
3.5 barg   85 °C				
10.3 barg   38 °C				
10.3 barg   38 °C				
3.5 barg   85 °C				
10.3 barg   38 °C	40"-CWS-05-202-B24-N	NOTE 4	TO P 0501 2	
3.5 barg   85 °C				
10.3 barg   38 °C	40"-CWS-05-203-B24-N	TO P 0502 A	0505   0500-PID-004	
3.5 barg   85 °C				
10.3 barg   38 °C	40"-CWS-05-204-B24-N	TO P 0502 B	0506   0500-PID-004	
3.5 barg   85 °C				
10.3 barg   38 °C	16"-CWS-05-205-B24-N	TO P 0504 A/B	0507   0500-PID-004	

REV.	PURPOSE OF ISSUE	DATE	DESIGN	DRAW	CHECK	REVIEW	APPROVE
▲	As built	30.04.2020	Nie Xiao		Du Guiju	Xie Xuan	
▲	Approved For Construction	30.12.2019	Nie Xiao		Du Guiju	Xie Xuan	
▲	Approved For Construction	22.08.2018	Nie Xiao		Tian Tao	Xie Xuan	
▲	Approved For Construction	17.07.2018	Nie Xiao		Tian Tao	Xie Xuan	
▲	Approved For Construction	29.09.2017	Nie Xiao		Tian Tao	Xie Xuan	
▲	Approved For Construction	22.11.2016	Nie Xiao		Tian Tao	Xie Xuan	
▲	Issued For Approval	11.10.2016	Nie Xiao		Tian Tao	Xie Xuan	
▲	Issued For Review	15.07.2016	Nie Xiao		Tian Tao	Xie Xuan	
▲	Issued For Comments	06.06.2016	Nie Xiao		Tian Tao	Xie Xuan	

THIS DOCUMENT IS THE PROPERTY OF TCC. NO PART OF THIS DOCUMENT SHALL BE REPRODUCED OR DISCLOSED TO OTHERS OR USED FOR ANY PURPOSE WHATSOEVER EXCEPT WITH THE PRIOR WRITTEN PERMISSION OF TCC.

**OWNER:**


Middle East Kimiaye Pars Company

<b>HALDOR TOPSØE A/S</b>	DOCUMENT NAME:	JOB NO.:	DWG. NO.:	REV.:
<b>TCC 中国天辰工程有限公司</b>	CONTRACTOR DRAWING NO.:	MKP-11-AS-0500-EE06-PID-001		
	SHEET 01	TOTAL 01		
	SUB-CONTRACTOR DRAWING NO.:			
	SHEET TOTAL			

T 0501 A/B/C/D	COOLING WATER TOWER	F 0501 A/B/C/D	COOLING TOWER FAN	PD 0501	COOLING WATER POND
LXWXH(m)	16.4X16.4X20.1	CAPACITY(m³/h)	2200000	LXWXH(mm)	67500X20900X3400
DESIGN PRESS.	ATM	ID(mm)	9140	NOMINAL CAPACITY	4465 m³
DESIGN TEMP.	85 °C	DESIGN PRESS.	0.0015 barg	DESIGN PRESS.	ATM
INSULATION	NO	DESIGN TEMP.	85 °C	DESIGN TEMP.	85 °C
CLADDING/LINING	NONE	INSULATION	NO	INSULATION	NONE

P&ID FOR COOLING WATER TOWER		PROJECT	MKP Methanol Project
		UNIT	COOLING WATER UNIT
		PHASE	As built drawing
SCALE	SHEET 1	TOT. 1	SIZE A1
Counter Signing	Sign	Date	OWNER DWG NO. MKP-11-AS-0500-PR-PID-001



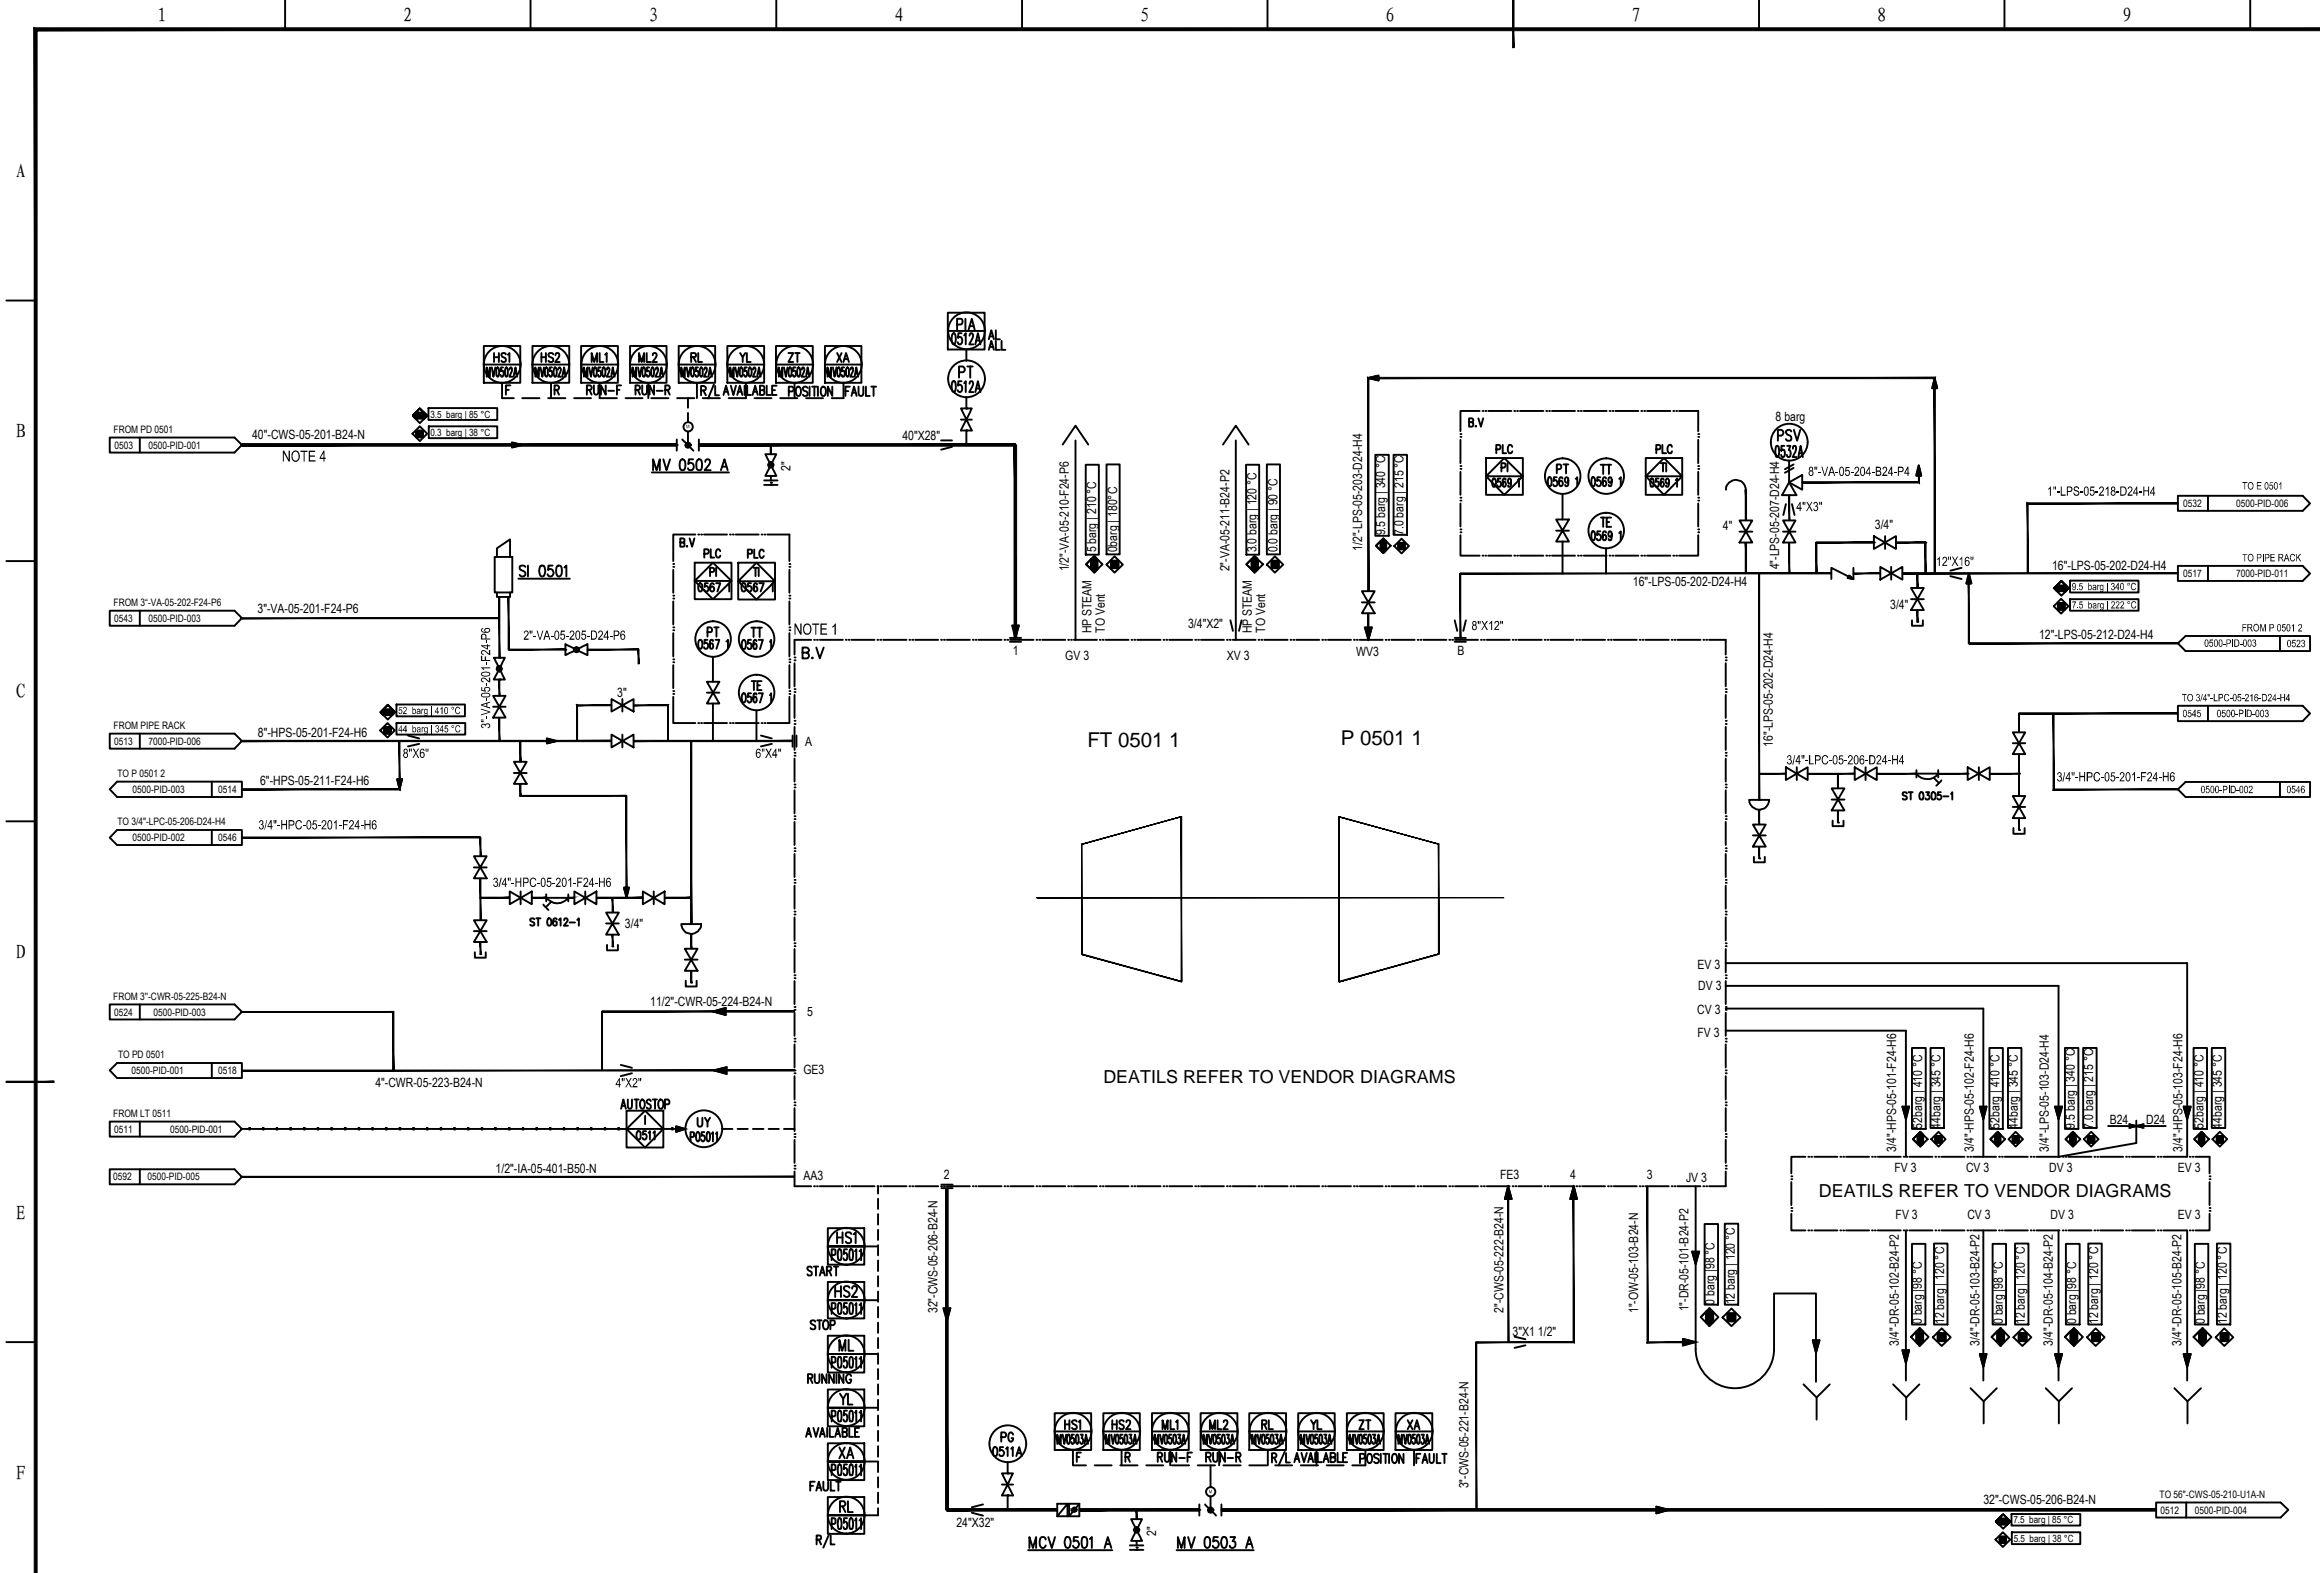

**GENERAL NOTES**

1. THE DRAWING OF TURBINE SHALL BE DESIGNED BY STEAM TURBINE VENDOR.
2. ALL OF THESE SHALL BE SUPPLIED BY STEAM TURBINE VENDOR.
4. THERE IS MESH BASKET IN FRONT OF EACH PIPE SUCTION FOR COOLING WATER PUMP.

**REFERENCE DRAWINGS**


**SYMBOLS AND LEGENDS**


**KEY PLAN**


REV.	PURPOSE OF ISSUE	DATE	DESIGN	DRAW	CHECK	REVIEW	APPROVE
▲	As built	30.04.2020	Nie Xiao	Du Guiju	Xie Xuan		
▲	Approved For Construction	30.12.2019	Nie Xiao	Du Guiju	Xie Xuan		
▲	Approved For Construction	22.08.2018	Nie Xiao	Tian Tao	Xie Xuan		
▲	Approved For Construction	17.07.2018	Nie Xiao	Tian Tao	Xie Xuan		
▲	Approved For Construction	29.09.2017	Nie Xiao	Tian Tao	Xie Xuan		
▲	Approved For Construction	22.11.2016	Nie Xiao	Tian Tao	Xie Xuan		
▲	Issued For Approval	11.10.2016	Nie Xiao	Tian Tao	Xie Xuan		
▲	Issued For Approval	15.07.2016	Nie Xiao	Tian Tao	Xie Xuan		
▲	Issued For Comments	06.06.2016	Nie Xiao	Tian Tao	Xie Xuan		

THIS DOCUMENT IS THE PROPERTY OF TCC. NO PART OF THIS DOCUMENT SHALL BE REPRODUCED OR DISCLOSED TO OTHERS OR USED FOR ANY PURPOSE WHATSOEVER EXCEPT WITH THE PRIOR WRITTEN PERMISSION OF TCC.


OWNER:

**Middle East  
Kimiaye Pars Company**

	DOCUMENT NAME:	JOB NO.:	DWG. NO.:	REV.:
	CONTRACTOR DRAWING NO. MKP-11-AS-0500-EE06-PID-002			
SHEET 01		TOTAL 01		
SUB-CONTRACTOR DRAWING NO.		SHEET TOTAL		

<b>P 0501 1</b>	COOLING WATER PUMP STEAM TURBINE	<b>MV 0502 A</b>	ELECTRIC BUTTERFLY VALVE	<b>MV 0503 A</b>	ELECTRIC BUTTERFLY VALVE	<b>MCV 0501 A</b>	MULTIFUNCTIONAL HYDRAULIC CONTROL VALVE	<b>SI 0501</b>	HP STEAM VENT SILENCER
CAPACITY	4500 m <sup>3</sup> /h	SIZE	40"	SIZE	32"	SIZE	32"	CAPACITY	20,000 kg/hr
HEAD	55 m	POWER	4 kW	POWER	4 kW	DESIGN PRESS.	7.3 barg	DESIGN PRESS.	7 barg
DENSITY@OT	993 kg/m <sup>3</sup>	DESIGN PRESS.	7.3 barg	DESIGN PRESS.	7.3 barg	DESIGN TEMP.	85 °C	DESIGN TEMP.	410 °C
INSULATION/TRACING	NONE	DESIGN TEMP.	85 °C	DESIGN TEMP.	85 °C	MATERIAL	BY VENDOR	MATERIAL SHELL	CS
AUXILIARY PIPING	BY STEAM TURBINE VENDOR	AUXILIARY PIPING	BY VENDOR	AUXILIARY PIPING	BY VENDOR	AUXILIARY PIPING	BY VENDOR		
TYPE	STEAM TURBINE								
MATERIAL	C.S								
ELEV. OF FOUNDATION	EL +100.70 m								

P&ID FOR COOLING WATER TURBINE PUMP 1		PROJECT	MKP Methanol Project
		UNIT	COOLING WATER UNIT
		PHASE	As built drawing
SCALE	SHEET 1	TOT. 1	SIZE A1
Counter Signing	Sign	Date	OWNER DWG NO. MKP-11-AS-0500-PR-PID-002

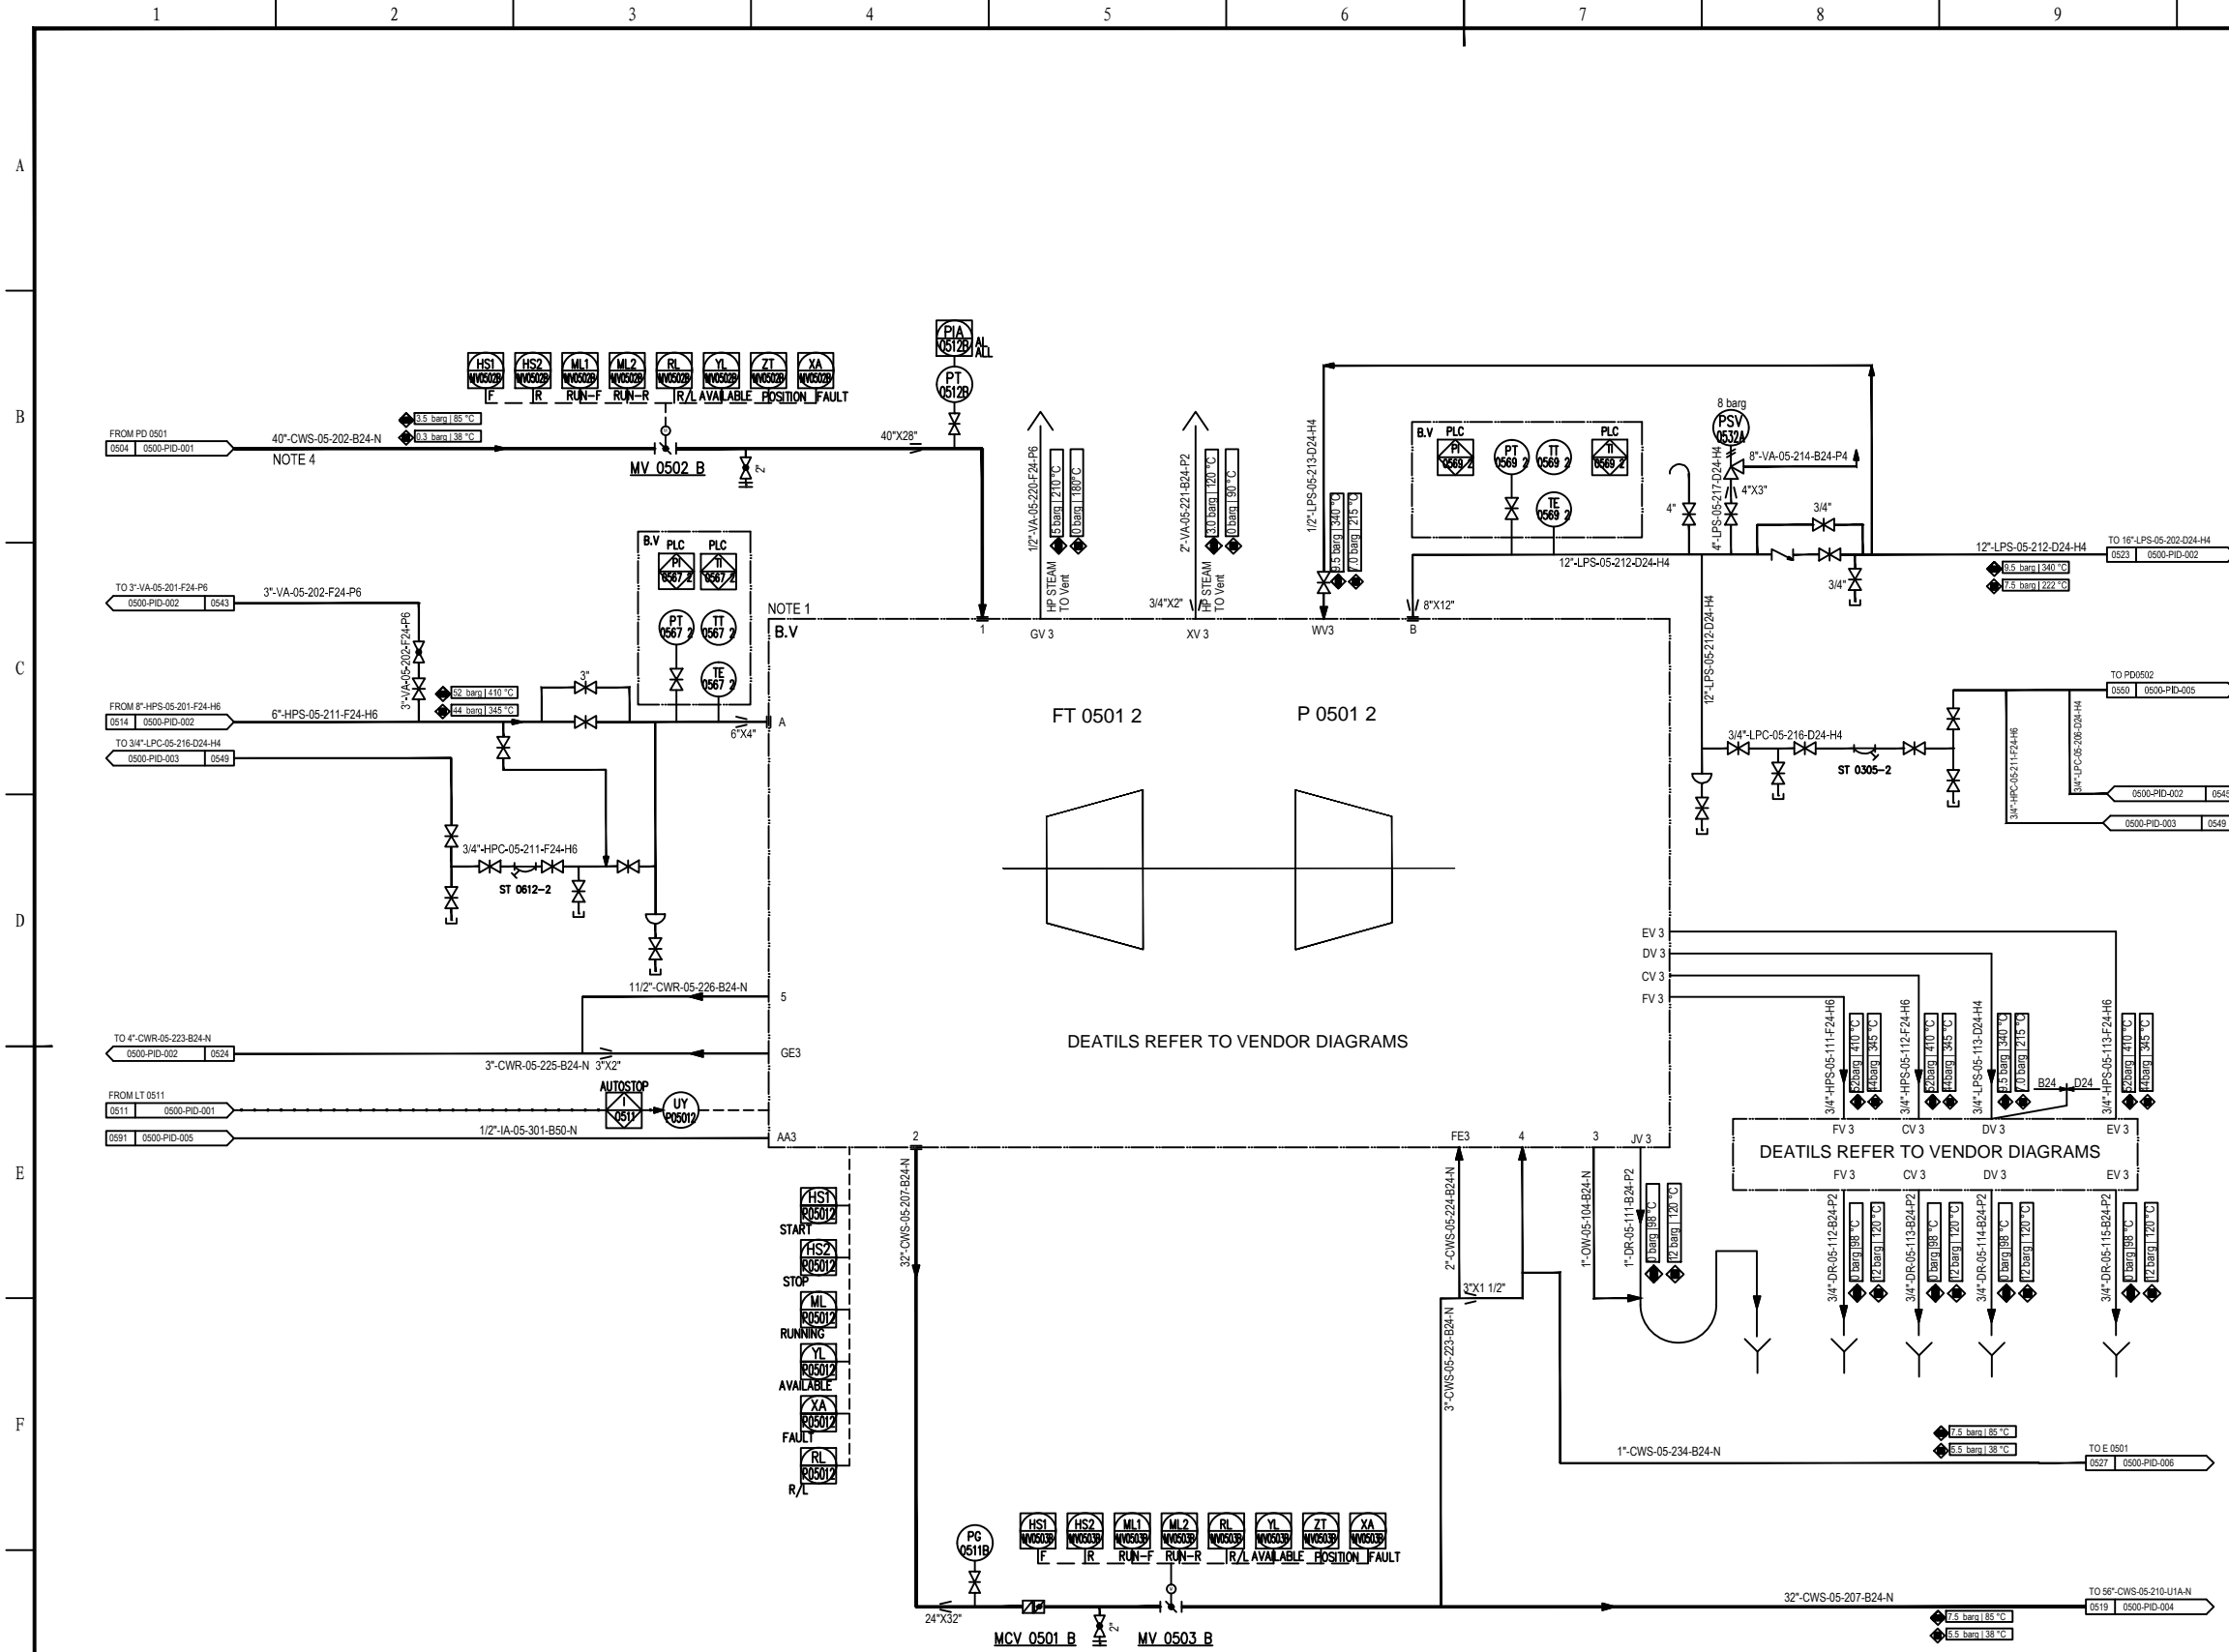

**GENERAL NOTES**

1. THE DRAWING OF TURBINE SHALL BE DESIGNED BY STEAM TURBINE VENDOR.
2. ALL OF THESE SHALL BE SUPPLIED BY STEAM TURBINE VENDOR.
4. THERE IS MESH BASKET IN FRONT OF EACH PIPE SUCTION FOR COOLING WATER PUMP.

**REFERENCE DRAWINGS**


**SYMBOLS AND LEGENDS**

**KEY PLAN**

REV.	PURPOSE OF ISSUE	DATE	DESIGN	DRAW	CHECK	REVIEW	APPROVE
▲	As built	30.04.2020	Nie Xiao		Du Guiju	Xie Xuan	
▲	Approved For Construction	30.12.2019	Nie Xiao		Du Guiju	Xie Xuan	
▲	Approved For Construction	22.8.2018	Nie Xiao		Tian Tao	Xie Xuan	
▲	Approved For Construction	17.7.2018	Nie Xiao		Tian Tao	Xie Xuan	
▲	Approved For Construction	29.09.2017	Nie Xiao		Tian Tao	Xie Xuan	
▲	Approved For Construction	22.11.2016	Nie Xiao		Tian Tao	Xie Xuan	
▲	Issued For Approval	11.10.2016	Nie Xiao		Tian Tao	Xie Xuan	
▲	Issued For Approval	15.07.2016	Nie Xiao		Tian Tao	Xie Xuan	
▲	Issued For Comments	06.06.2016	Nie Xiao		Tian Tao	Xie Xuan	

THIS DOCUMENT IS THE PROPERTY OF TCC. NO PART OF THIS DOCUMENT SHALL BE REPRODUCED OR DISCLOSED TO OTHERS OR USED FOR ANY PURPOSE WHATSOEVER EXCEPT WITH THE PRIOR WRITTEN PERMISSION OF TCC.

**OWNER:**




**Middle East  
Kimiaye Pars Company**

<b>HALDOR TOPSØE A/S</b>	DOCUMENT NAME	JOB NO.	DWG NO.	REV.
<b>TCC 中国天辰工程有限公司</b>	CONTRACTOR DRAWING NO.	MKP-11-AS-0500-EE06-PID-003		
	SHEET	01	TOTAL	01
	SUB-CONTRACTOR DRAWING NO.			
	SHEET		TOTAL	

<b>P 0501 2</b>	COOLING WATER PUMP STEAM TURBINE	<b>MV 0502 B</b>	ELECTRIC BUTTERFLY VALVE	<b>MV 0503 B</b>	ELECTRIC BUTTERFLY VALVE	<b>MCV 0501 B</b>	MULTIFUNCTIONAL HYDRAULIC CONTROL VALVE
CAPACITY	4500 m <sup>3</sup> /h	SIZE	40"	SIZE	32"	SIZE	32"
HEAD	55 m	POWER	4 kW	POWER	4 kW	DESIGN PRESS.	7.3 barg
DENSITY@OT	993 kg/m <sup>3</sup>	DESIGN PRESS.	7.3 barg	DESIGN PRESS.	7.3 barg	DESIGN TEMP.	85 °C
INSULATION/TRACING	NONE	DESIGN TEMP.	85 °C	DESIGN TEMP.	85 °C	MATERIAL	BY VENDOR
AUXILIARY PIPING	BY STEAM TURBINE VENDOR	AUXILIARY PIPING	BY VENDOR	AUXILIARY PIPING	BY VENDOR	AUXILIARY PIPING	BY VENDOR
TYPE	STEAM TURBINE						
MATERIAL	C.S						
ELEV. OF FOUNDATION	EL +100.70 m						

<b>P&amp;ID FOR COOLING WATER TURBINE PUMP 2</b>	PROJECT	MKP Methanol Project
	UNIT	COOLING WATER UNIT
	PHASE	As built drawing
	OWNER DWG NO.	MKP-11-AS-0500-PR-PID-003

SCALE	SHEET 1	TOT. 1	SIZE A1
Counter Signing	Sign	Date	

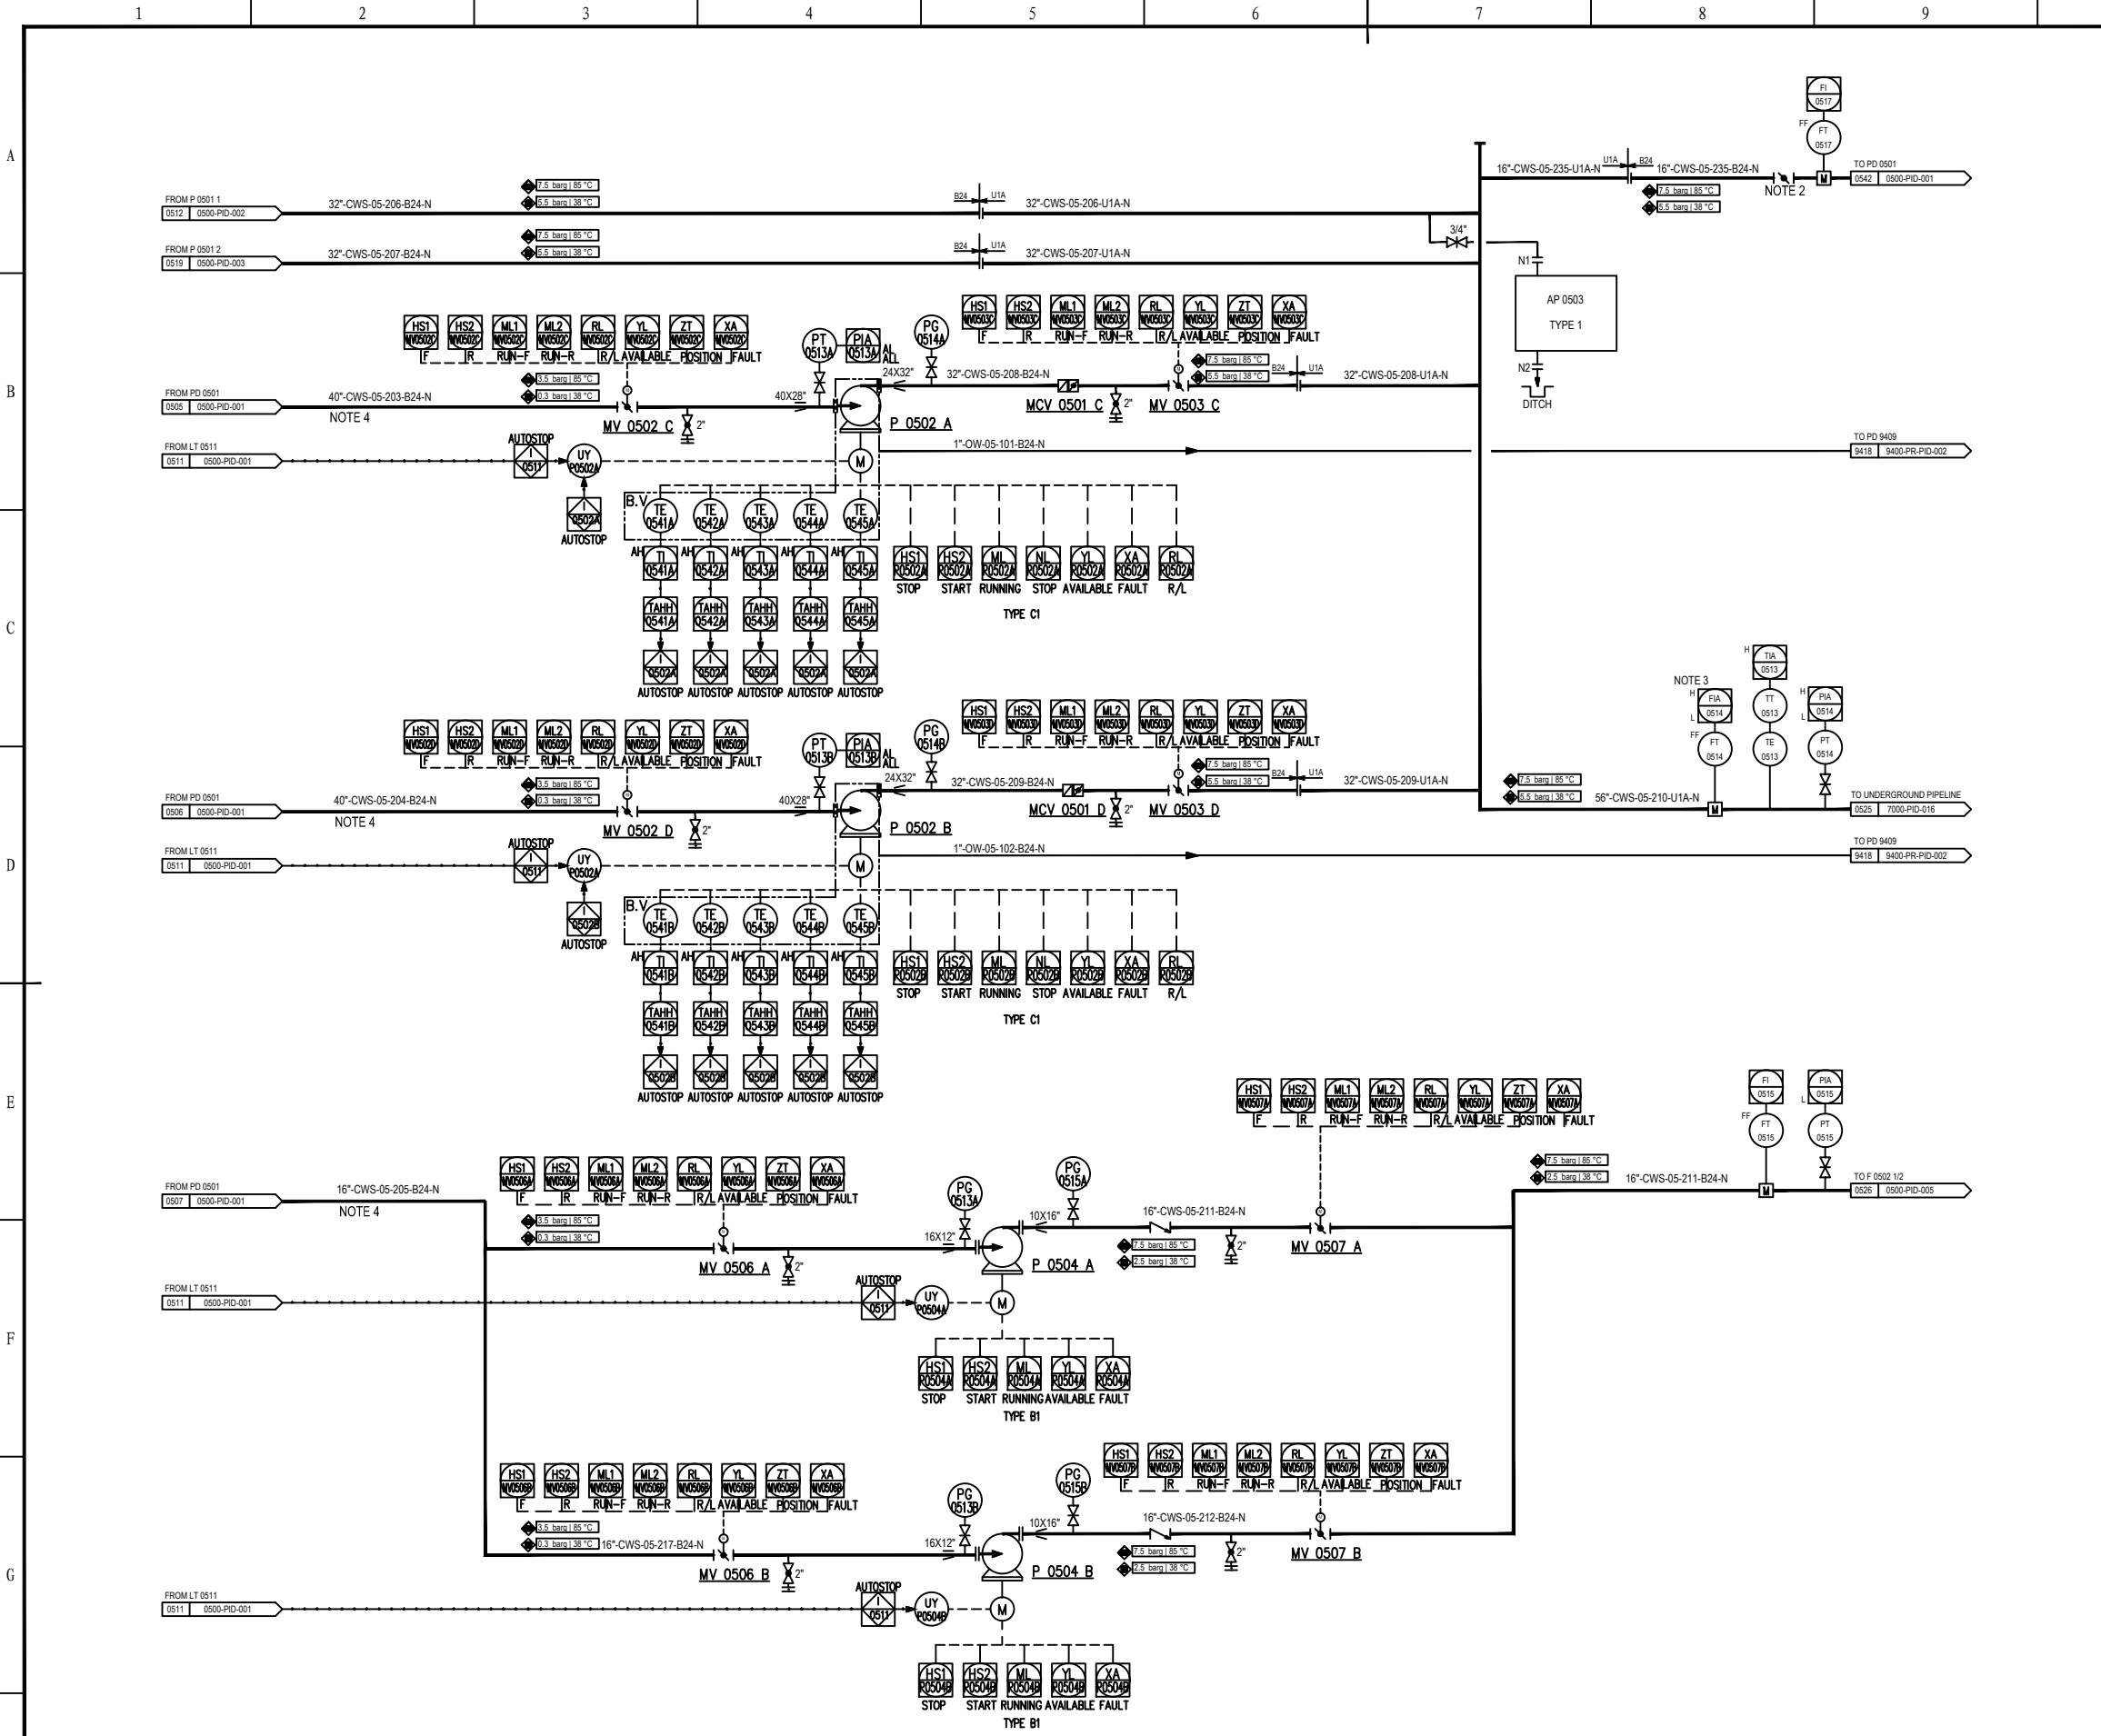

**GENERAL NOTES**

2. A LOW NOISE HIGH PERFORMANCE BUTTERFLY VALVE SHOULD BE APPLIED.
3. ALARM HIGH TO BE CONSIDERED FOR FI.
4. THERE IS MESH BASKET IN FRONT OF EACH PIPE SUCTION FOR COOLING WATER PUMP.

**REFERENCE DRAWINGS**


**SYMBOLS AND LEGENDS**

**KEY PLAN**

REV.	PURPOSE OF ISSUE	DATE	DESIGN	DRAW	CHECK	REVIEW	APPROVE
▲	As built	30.04.2020	Nie Xiao		Du Guiju	Xie Xuan	
▲	Approved For Construction	30.12.2019	Nie Xiao		Du Guiju	Xie Xuan	
▲	Approved For Construction	22.08.2018	Nie Xiao		Tian Too	Xie Xuan	
▲	Approved For Construction	17.07.2018	Nie Xiao		Tian Too	Xie Xuan	
▲	Approved For Construction	29.09.2017	Nie Xiao		Tian Too	Xie Xuan	
▲	Approved For Construction	22.11.2016	Nie Xiao		Tian Too	Xie Xuan	
▲	Issued For Approval	11.10.2016	Nie Xiao		Tian Too	Xie Xuan	
▲	Issued For Approval	15.07.2016	Nie Xiao		Tian Too	Xie Xuan	
▲	Issued For Comments	06.06.2016	Nie Xiao		Tian Too	Xie Xuan	

THIS DOCUMENT IS THE PROPERTY OF TCC. NO PART OF THIS DOCUMENT SHALL BE REPRODUCED OR DISCLOSED TO OTHERS OR USED FOR ANY PURPOSE WHATSOEVER EXCEPT WITH THE PRIOR WRITTEN PERMISSION OF TCC.

**OWNER:**


**Middle East  
Kimiaye Pars Company**

<b>HALDOR TOPSØE A/S</b>	DOCUMENT NAME:	JOB NO.:	DWG. NO.:	REV.:
<b>TCC 中国天辰工程有限公司</b>	CONTRACTOR DRAWING NO. MKP-11-AS-0500-EE06-PID-004		SHEET 01 TOTAL 01	
SUB-CONTRACTOR DRAWING NO.		SHEET TOTAL		

P 0502 A/B	COOLING WATER PUMP	MV 0502 C/D	ELECTRIC BUTTERFLY VALVE	MV 0503 C/D	ELECTRIC BUTTERFLY VALVE	P 0504 A/B	SIDE FILTER PUMP	MV 0506 A/B	ELECTRIC BUTTERFLY VALVE	MV 0507 A/B	ELECTRIC BUTTERFLY VALVE	MCV 0501 C/D	MULTIFUNCTIONAL HYDRAULIC CONTROL VALVE
CAPACITY	4500 m <sup>3</sup> /h	SIZE	40"	SIZE	32"	CAPACITY	640 m <sup>3</sup> /h	SIZE	16"	SIZE	16"	SIZE	32"
HEAD	55 m	POWER	4 kW	POWER	4 kW	HEAD	25 m	POWER	4 kW	POWER	4 kW	DESIGN PRESS.	7.3 barg
DENSITY@OT	993 kg/m <sup>3</sup>	DESIGN PRESS.	7.3 barg	DESIGN PRESS.	7.3 barg	DENSITY@OT	993 kg/m <sup>3</sup>	DESIGN PRESS.	4.3 barg	DESIGN PRESS.	4.3 barg	DESIGN TEMP.	85 °C
INSULATION/TRACING	NONE	DESIGN TEMP.	85 °C	DESIGN TEMP.	85 °C	INSULATION/TRACING	NONE	DESIGN TEMP.	85 °C	DESIGN TEMP.	85 °C	MATERIAL	BY VENDOR
AUXILIARY PIPING	BY PUMP VENDOR	AUXILIARY PIPING	BY VENDOR	AUXILIARY PIPING	BY PUMP VENDOR	AUXILIARY PIPING	BY PUMP VENDOR	AUXILIARY PIPING	BY VENDOR	AUXILIARY PIPING	BY VENDOR	AUXILIARY PIPING	BY VENDOR
TYPE	CENTRIFUGAL					TYPE	CENTRIFUGAL						
MATERIAL	C.S					MATERIAL	C.S						
ELEV. OF FOUNDATION	EL. +100.70 m					ELEV. OF FOUNDATION	EL. +100.70 m						

P&ID FOR COOLING WATER PUMP		PROJECT	MKP Methanol Project
		UNIT	COOLING WATER UNIT
		PHASE	As built drawing
SCALE	SHEET 1	TOT. 1	SIZE A1
Counter Signing	Sign	Date	OWNER DWG NO. MKP-11-AS-0500-PR-PID-004



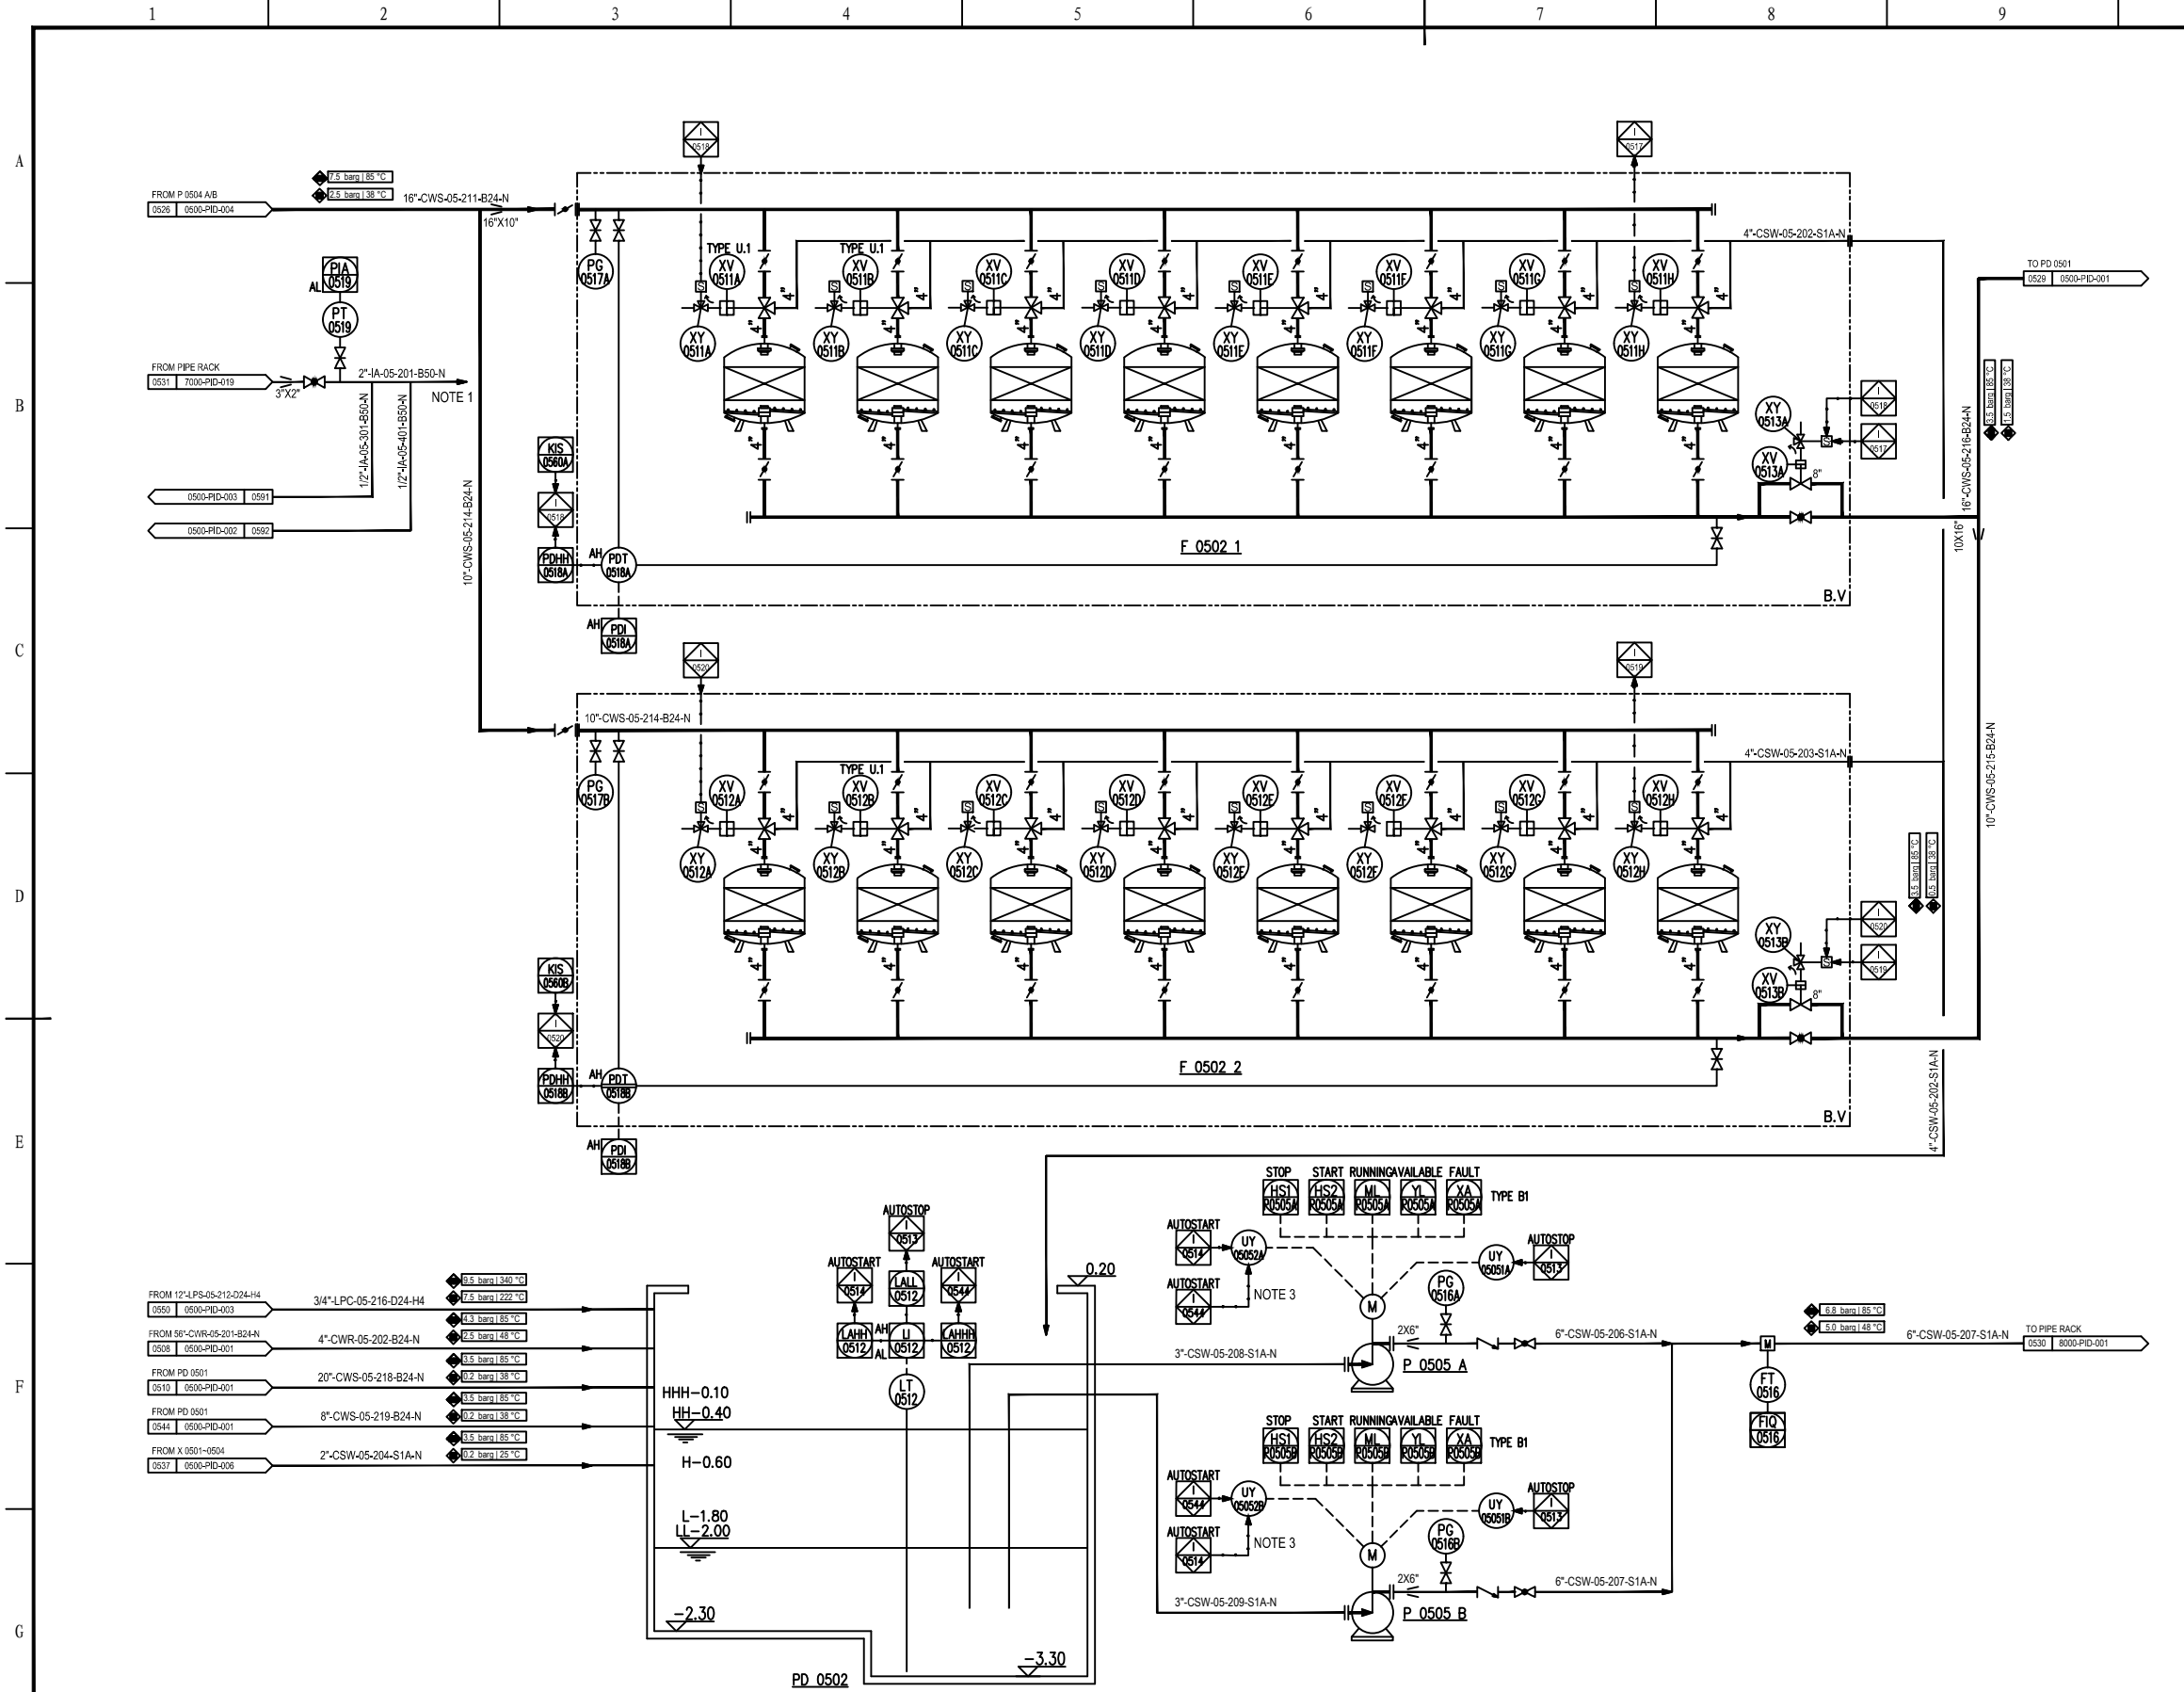

**GENERAL NOTES**

1. INSTRUMENT AIR PIPE HEADER WILL BE CONNECTED TO ALL PNEUMATIC VALVE.
2. ON-OFF VALVES BELONG TO TYPE U.1, THE ONLY DIFFERENCE IS THERE IS NO RESET OF INTERLOCK UNIT.
3. SOFTWARE SWITCH WILL BE SET FOR SELECTION OF AUTOSTART PUMP A OR B.

**REFERENCE DRAWINGS**


**SYMBOLS AND LEGENDS**

**KEY PLAN**

REV.	PURPOSE OF ISSUE	DATE	DESIGN	DRAW	CHECK	REVIEW	APPROVE
▲	As built	30.04.2020	Nie Xiao		Du Guiju	Xie Xuan	
▲	Approved For Construction	05.07.2019	Nie Xiao		Du Guiju	Xie Xuan	
▲	Approved For Construction	22.08.2018	Nie Xiao		Tian Tao	Xie Xuan	
▲	Approved For Construction	17.07.2018	Nie Xiao		Tian Tao	Xie Xuan	
▲	Approved For Construction	29.09.2017	Nie Xiao		Tian Tao	Xie Xuan	
▲	Approved For Construction	11.10.2016	Nie Xiao		Tian Tao	Xie Xuan	
▲	Issued For Approval	15.07.2016	Nie Xiao		Tian Tao	Xie Xuan	
▲	Issued For Comments	06.06.2016	Nie Xiao		Tian Tao	Xie Xuan	

THIS DOCUMENT IS THE PROPERTY OF TCC. NO PART OF THIS DOCUMENT SHALL BE REPRODUCED OR DISCLOSED TO OTHERS OR USED FOR ANY PURPOSE WHATSOEVER EXCEPT WITH THE PRIOR WRITTEN PERMISSION OF TCC.

**OWNER:**




**Middle East  
Kimiaye Pars Company**

<b>HALDOR TOPSØE A/S</b>	DOCUMENT NAME:	JOB NO.:	DWG. NO.:	REV.:
<b>TCC 中国天辰工程有限公司</b>	CONTRACTOR DRAWING NO. MKP-11-AS-0500-EE06-PID-005			
	SHEET 01 TOTAL 01			
	SUB-CONTRACTOR DRAWING NO.			
	SHEET TOTAL			

F 0502 1/2	COOLING WATER FILTER QUARTZ SAND	PD 0502	CLEAN SALTY WATER POND	P 0505 A/B	CLEAN SALTY WATER PUMP
CAPACITY	320 m <sup>3</sup> /h	LX(W)H(mm)	7500X5400X2500	CAPACITY	55 m <sup>3</sup> /h
MATERIAL SHELL	C.S	NOMINAL CAPACITY	80 m <sup>3</sup>	HEAD	50 m
DENSITY	993 kg/m <sup>3</sup>	DESIGN PRESS.	ATM	DENSITY	989 kg/m <sup>3</sup>
INSULATION/TRACING	NONE	DESIGN TEMP.	85 °C	INSULATION/TRACING	NONE
AUXILIARY PIPING	BY VENDOR	INSULATION	NONE	AUXILIARY PIPING	BY VENDOR
MATERIAL CASING	C.S/RUBBER			TYPE	SELF-PRIMING
MATERIAL FILTER ELEMENT	QUARTZ SAND			MATERIAL	C.S
ELEV. OF FOUNDATION	EL +100.70 m			ELEV. OF FOUNDATION	EL +100.70 m

P&ID FOR COOLING WATER FILTER		PROJECT	MKP Methanol Project
		UNIT	COOLING WATER UNIT
		PHASE	As built drawing
SCALE	SHEET 1	TOT. 1	SIZE A1
Counter Signing	Sign	Date	OWNER DWG NO. MKP-11-AS-0500-PR-PID-005

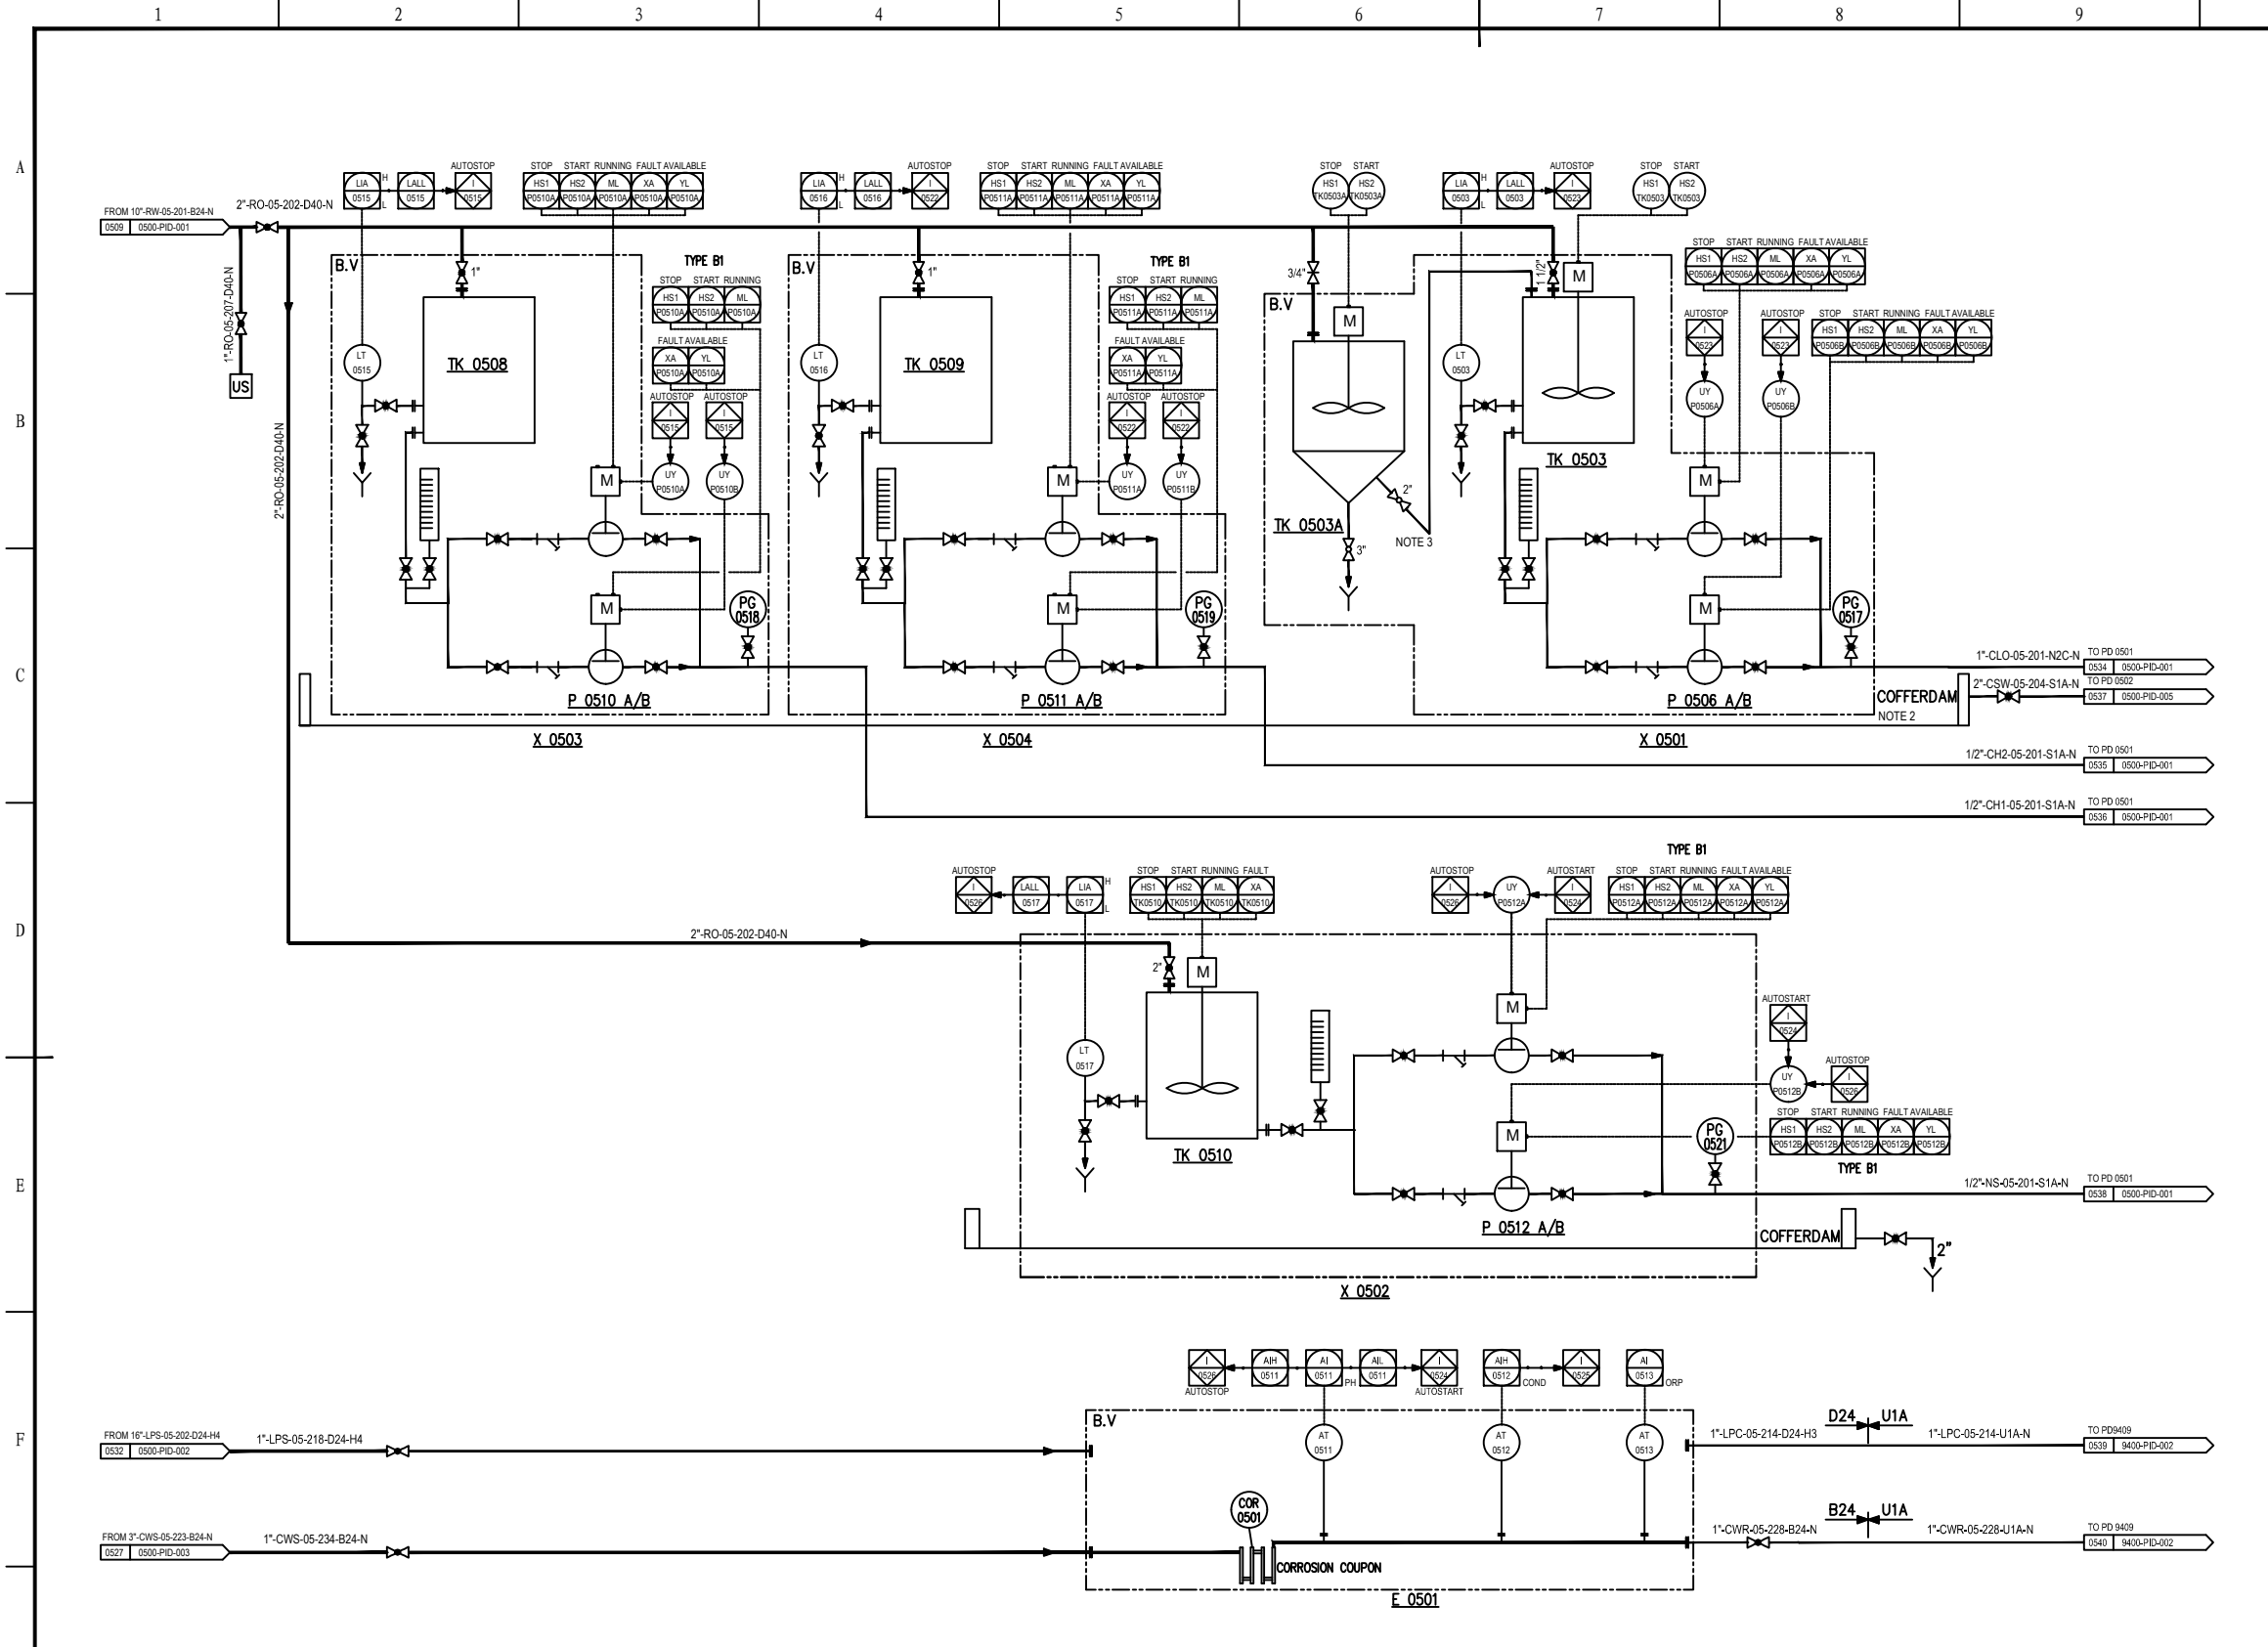

**GENERAL NOTES**

NOTES:

1. AN EMERGENCY SHOWER AND EYE WASH WILL BE PROVIDED LOCAL TO MECHANICAL INJECTION PACKAGES.
2. ANTI-ACID BRICK WILL BE EQUIPPED ON COFFERDAM SURFACE.
3. THE LIQUID IN SOLUTION TANK TK 0503A WILL BE OVERFLOWED INTO TK 0503 DIRECTLY.

**REFERENCE DRAWINGS**

1/2"-CH2-05-201-S1A-N	TO PD 0501
0534   0530-PID-001	
1/2"-CH1-05-201-S1A-N	TO PD 0501
0536   0530-PID-001	

**SYMBOLS AND LEGENDS**

**KEY PLAN**

REV.	PURPOSE OF ISSUE	DATE	DESIGN	DRAW	CHECK	REVIEW	APPROVE
▲	As built	30.04.2020	Nie Xiao		Du Guiju	Xie Xuan	
▲	Approved For Construction	30.12.2019	Nie Xiao		Du Guiju	Xie Xuan	
▲	Approved For Construction	05.07.2019	Nie Xiao		Du Guiju	Xie Xuan	
▲	Approved For Construction	25.04.2019	Nie Xiao		Du Guiju	Xie Xuan	
▲	Approved For Construction	22.08.2018	Nie Xiao		Tian Tao	Xie Xuan	
▲	Approved For Construction	17.07.2018	Nie Xiao		Tian Tao	Xie Xuan	
▲	Approved For Construction	29.09.2017	Nie Xiao		Tian Tao	Xie Xuan	
▲	Approved For Construction	22.11.2016	Nie Xiao		Tian Tao	Xie Xuan	
▲	Issued For Approval	11.10.2016	Nie Xiao		Tian Tao	Xie Xuan	
▲	Issued For Approval	15.07.2016	Nie Xiao		Tian Tao	Xie Xuan	
▲	Issued For Comments	06.06.2016	Nie Xiao		Tian Tao	Xie Xuan	

THIS DOCUMENT IS THE PROPERTY OF TCC. NO PART OF THIS DOCUMENT SHALL BE REPRODUCED OR DISCLOSED TO OTHERS OR USED FOR ANY PURPOSE WHATSOEVER EXCEPT WITH THE PRIOR WRITTEN PERMISSION OF TCC.

**OWNER:**

**Middle East**  
Kimiaye Pars Company

**HALDOR TOPSØE A/S**

**TCC 中国天辰工程有限公司**  
CHINA TIANCHEN ENGINEERING CORPORATION

CONTRACTOR DRAWING NO. MKP-11-AS-0500-EE06-PID-006  
SHEET 01 TOTAL 01  
SUB-CONTRACTOR DRAWING NO.  
SHEET TOTAL

**P&ID FOR CHEMICAL DOSING UNIT**

PROJECT: MKP Methanol Project  
UNIT: COOLING WATER UNIT  
PHASE: As built drawing


SCALE: SHEET 1 TOT. 1 SIZE A1  
OWNER DWG NO. MKP-11-AS-0500-PR-PID-006

P 0506 A/B		TK 0503		TK 0508		P 0510 A/B		TK 0509		TK 0510		P 0512 A/B		E 0501		TK 0503A	
CAPACITY	100 L/h	ID X HEIGHT(mm)	1500X2000	ID X HEIGHT(mm)	1000X1500	CAPACITY	0-50 L/h	ID X HEIGHT(mm)	1000X1500	CAPACITY	0-50 L/h	EXCHANGE AREA	4.8 m <sup>2</sup>	ID X HEIGHT(mm)	1000X610	SOLUTION TANK	
HEAD	30 m	NOMINAL CAPACITY	3 m <sup>3</sup>	NOMINAL CAPACITY	1 m <sup>3</sup>	HEAD	30 m	NOMINAL CAPACITY	1 m <sup>3</sup>	HEAD	30 m	DESIGN PRESS.(TU,SH)	5.5/5.0 barg	NOMINAL CAPACITY	0.85 m <sup>3</sup>		
DENSITY@OT	1000 kg/m <sup>3</sup>	DESIGN PRESS.	ATM	DESIGN PRESS.	ATM	DENSITY@OT	1000 kg/m <sup>3</sup>	DESIGN PRESS.	ATM	DENSITY@OT	1030 kg/m <sup>3</sup>	INSULATION/TRACING	NONE	DESIGN TEMP.	85 °C		
INSULATION/TRACING	NONE	DESIGN TEMP.	85 °C	INSULATION/TRACING	NONE	INSULATION/TRACING	NONE	DESIGN TEMP.	85 °C	INSULATION/TRACING	NONE	AUXILIARY PIPING	BY VENDOR	INSULATION	NONE		
AUXILIARY PIPING	BY VENDOR	INSULATION	NONE	INSULATION	NONE	AUXILIARY PIPING	BY VENDOR	INSULATION	NONE	AUXILIARY PIPING	BY VENDOR	TYPE	MONITORING	INSULATION	NONE		
MATERIAL	PVDF	MATERIAL	FRP	MATERIAL	316L	MATERIAL	316L	MATERIAL	316L	MATERIAL	316L	MATERIAL	SS304	MATERIAL	PE		
ELEV. OF FOUNDATION	EL +100.70 m	ELEV. OF FOUNDATION	EL +100.70 m	ELEV. OF FOUNDATION	EL +100.70 m	ELEV. OF FOUNDATION	EL +100.70 m	ELEV. OF FOUNDATION	EL +100.70 m	ELEV. OF FOUNDATION	EL +100.70 m	ELEV. OF FOUNDATION	EL +100.70 m	ELEV. OF FOUNDATION	EL +100.70 m		

X 1001	GAS STATION
FLOW RATE	66142-198000m <sup>3</sup> /h
INLET GAS PRESS.	54.1-62 barg
OUTLET GAS PRESS.	52 barg
DESIGN TEMP.	85 °C

GENERAL NOTES

- NOTES:
- 1) DETAILS OF X1001 TO BE UPDATED ACCORDING TO TECHNICAL DOCUMENTS PROVIDED BY VENDOR.
  - 2) THE LEVEL GAUGE SHOULD BE VISIBLE TO THE OPERATOR AT POSITION OF DRAIN VALVES.
  - 3) FIC CALCULATED INSIDE DUAL CHANNEL FLOW COMPUTER. ONE SIGNAL SENT TO DMP, AND ANOTHER SENT TO FCS.
  - 4) VENT TO SAFE AREA.
  - 5) REQUIREMENT OF PSV ON DRY GAS FILTER TO BE CONFIRMED BY VENDOR.
  - 6) VENT AND DRAIN TO BE FORESEEN GENERALLY AT HIGH AND LOW POINTS.
  - 7) THE CLOSED DRAIN WILL BE COLLECTED IN A PORTABLE SEALED CONTAINER.
  - 8) TIGHT SHUT OFF TYPE(TSO), SLAM SHUT-OFF VALVE.
  - 9) DOUBLE LOCKED BY DMP AND OWNER.
  - 10) THE HIGH ALARMS FOR FIC-1915/1925/1935 ARE FOR REAL TIME FLOW RATE, NOT FOR ACCUMULATED VALUE.

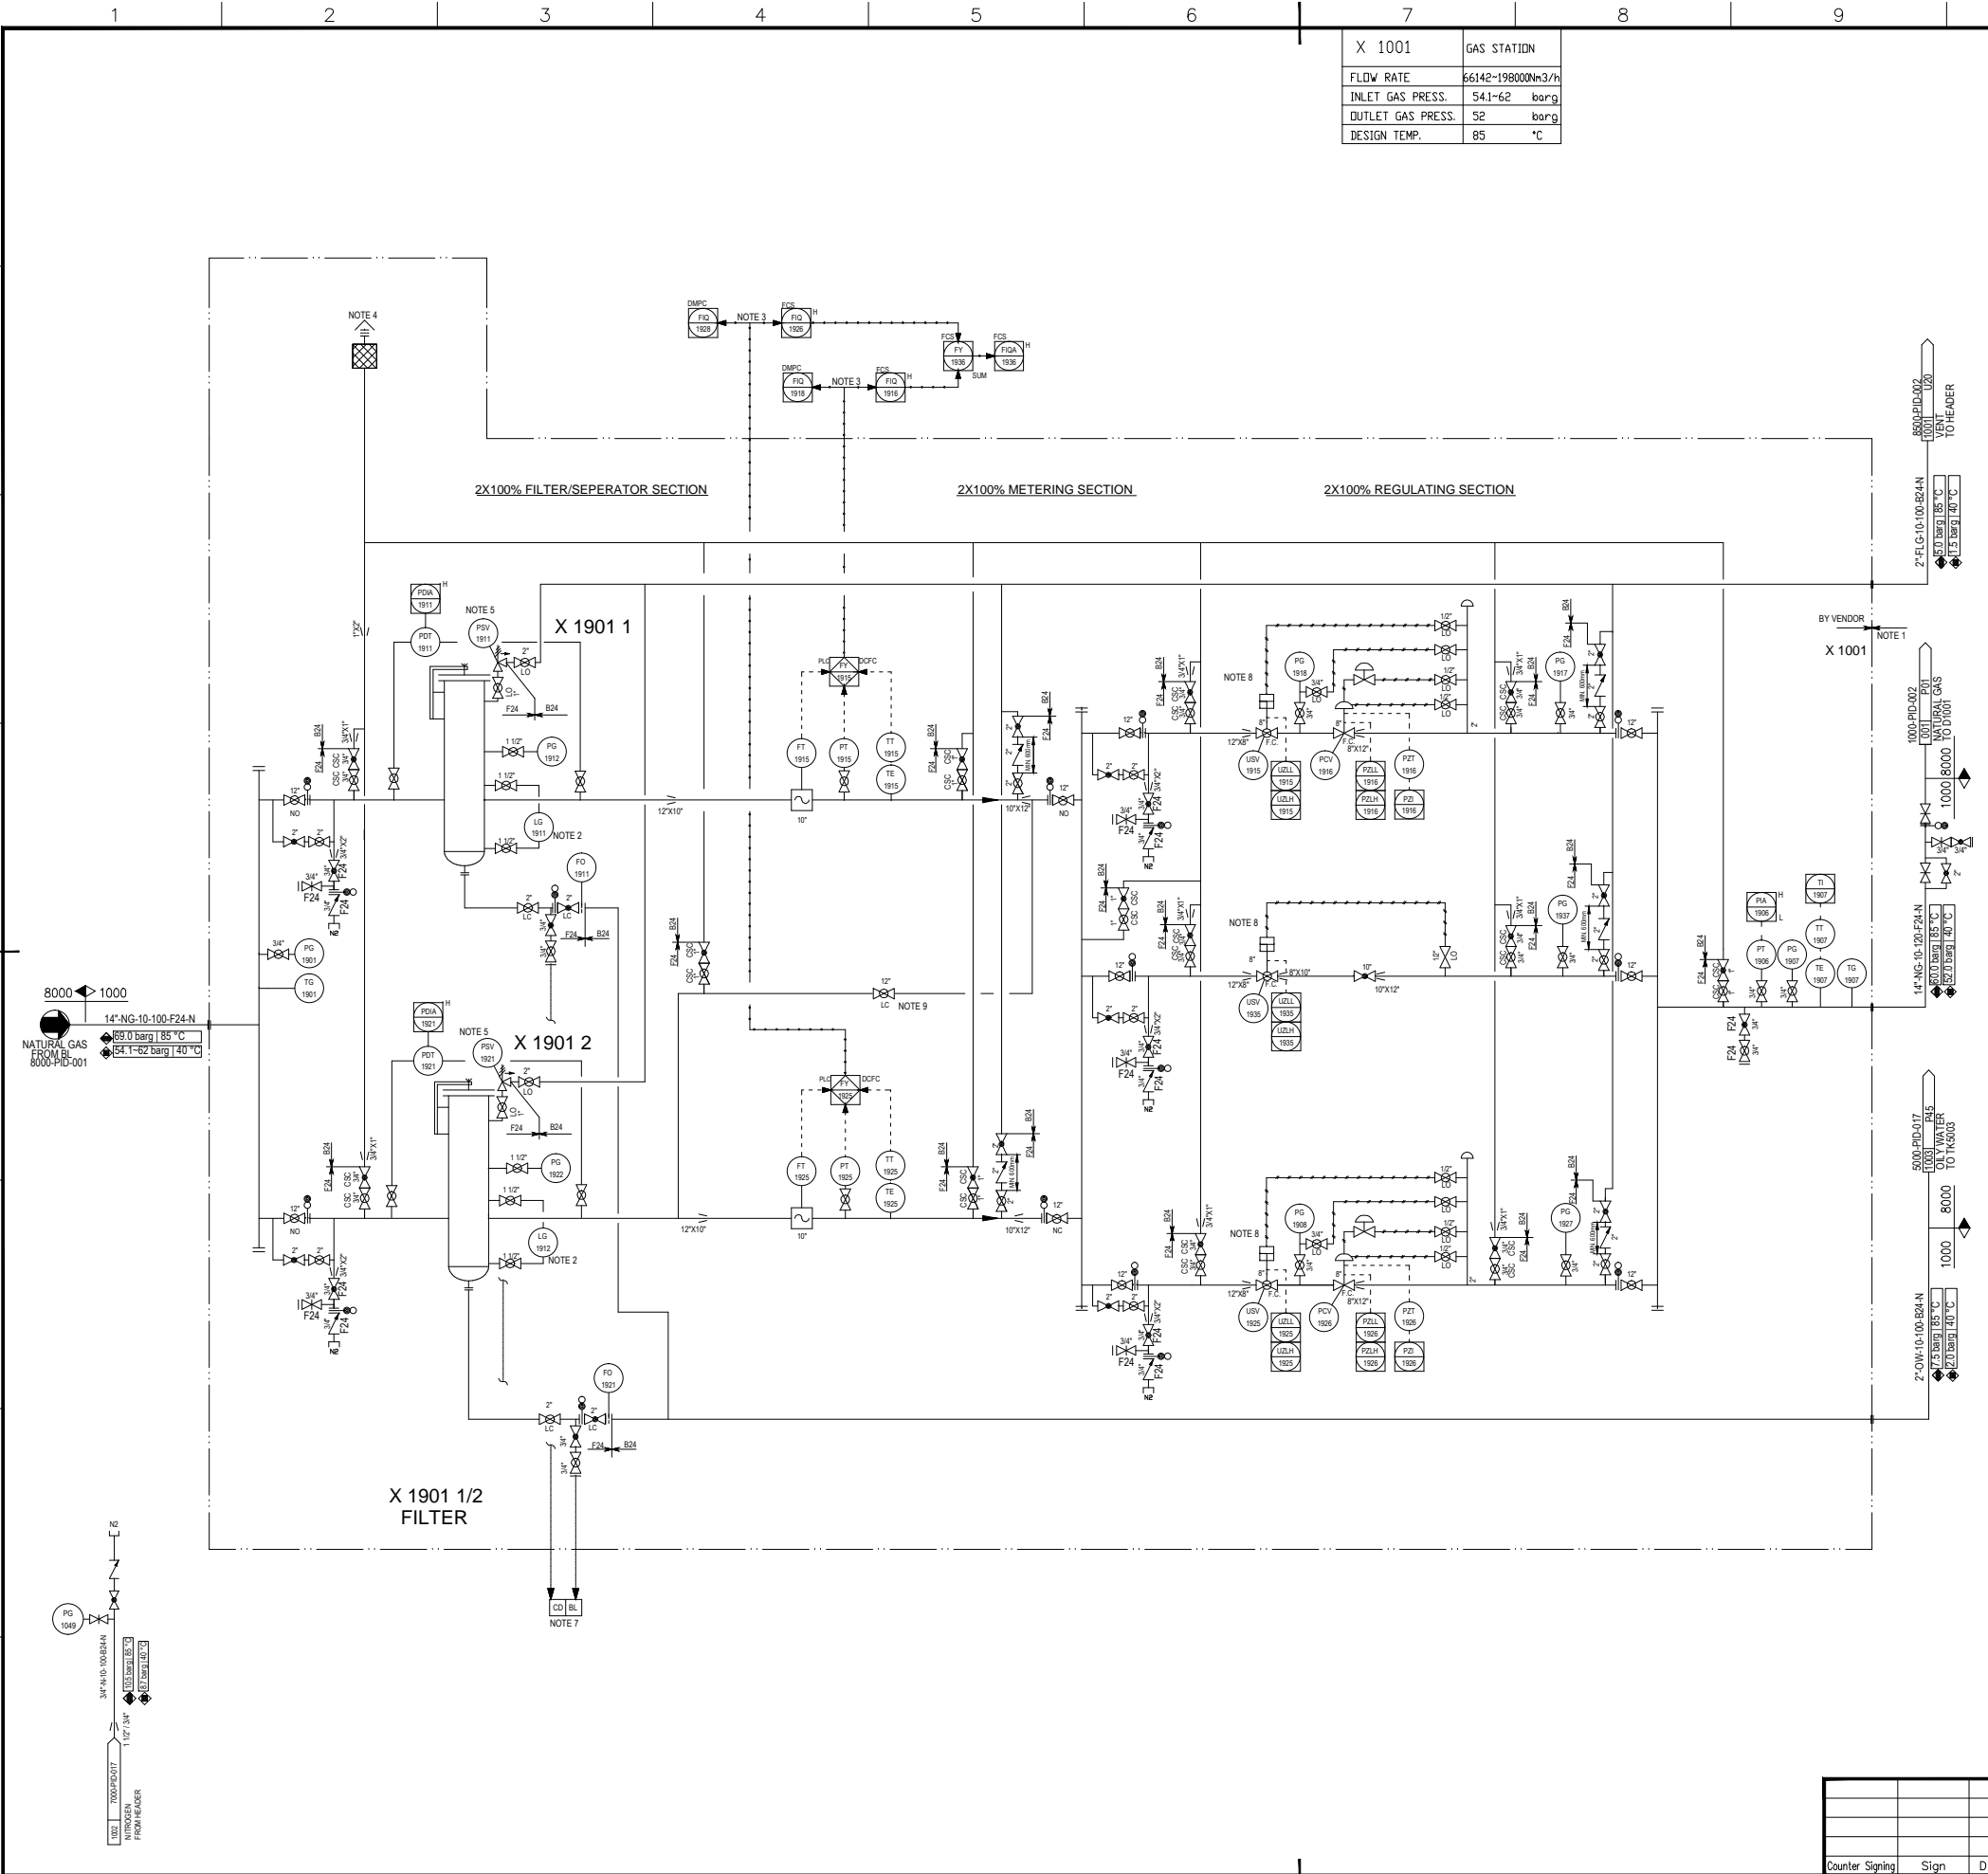

8000 1000  
 14"-NG-10-100-F24-N  
 NATURAL GAS FROM 8000-1000-001  
 89.0 barg 85 °C  
 54.1-62 barg 140 °C

PG 1906  
 3/4"-W-100-0084-N  
 100% NITROGEN FROM HEADER  
 100% NITROGEN FROM HEADER

REFERENCE DRAWINGS

SYMBOLS AND LEGENDS

KEY PLAN

REV.	PURPOSE OF ISSUE	DATE	DESIGN	DRAW	CHECK	REVIEW	APPROVE
▲	As Built	30.04.2020	Xu Yekun	Xu Hong	Liu Shengkol		
▲	Approved For Construction	30.12.2019	Xu Yekun	Xu Hong	Liu Shengkol		
▲	Approved For Construction	02.02.2018	Xu Yekun	Xu Hong	Liu Shengkol		
▲	Approved For Construction	06.11.2017	Xu Yekun	Xu Hong	Liu Shengkol		
▲	Approved For Construction	22.03.2017	Jiang Yu	Xu Hong	Liu Shengkol		
▲	Approved For Construction	16.01.2017	Jiang Yu	Xu Hong	Liu Shengkol		
▲	Approved For Construction	11.11.2016	Jiang Yu	Xu Hong	Liu Shengkol		
▲	Issued for Approval	13.10.2016	Jiang Yu	Xu Hong	Liu Shengkol		
▲	Issued for Approval	24.06.2016	Jiang Yu	Xu Hong	Liu Shengkol		
▲	Issued for Comments	29.4.2016	Jiang Yu	Xu Hong	Liu Shengkol		

THIS DOCUMENT IS THE PROPERTY OF TCC. NO PART OF THIS DOCUMENT SHALL BE REPRODUCED OR DISCLOSED TO OTHERS OR USED FOR ANY PURPOSE WHATSOEVER EXCEPT WITH THE PRIOR WRITTEN PERMISSION OF TCC.

OWNER: Middle East Kimiaye Pars Company

HALDOR TOPSØE A/S DOCUMENT NAME: CONTRACTOR DRAWING NO.

TCC 中国天辰工程有限公司 CONTRACTOR DRAWING NO. MKP-11-AS-1000-PS07-PID-001

SHEET 01 TOTAL 01 SUB-CONTRACTOR DRAWING NO.

SHEET -- TOTAL --

GAS STATION PIPING AND INSTRUMENT DIAGRAM PROJECT: MKP Methanol Project UNIT: Desulphurisation Unit PHASE: As Built Drawing OWNER DWG NO.: MKP-11-AS-1000-PR-PID-001

Counter	Sign	Date

SCALE:-- SHEET:1 TOT.:1 SIZE:A1



D 1001	NATURAL GAS K.O. DRUM
ID x LENGTH(T-D)	1550 x 2550mm
DESIGN PRESS.	60 barg
DESIGN TEMP.	85 °C
INSULATION	NO
CLADDING/LINING	NONE

D 1011 A/B	PORTABLE DRAIN DRUM
LENGTH x HEIGHT	~1000x1000x1000mm
DESIGN PRESS.	ATM barg
DESIGN TEMP.	85 °C
INSULATION	NO
CLADDING/LINING	NONE

GENERAL NOTES

- \*NOTES:
- 1) TO BE VISIBLE FROM LG 1005.
  - 2) THE CLOSED DRAIN WILL BE COLLECTED IN A PORTABLE SEALED CONTAINER.
  - 3) BETWEEN THESE TWO PSV, ALWAYS ONE INLET BLOCK VALVE SHALL BE L.O. AND THE OTHER ONE SHALL BE L.C.
  - 4) THE MIN. DISTANCE OF CHECK VALVE BEFORE D 1001 SHALL BE AT LEAST 10 TIMES OF LINE INNER DIAMETER.
  - 5) WHEN DRAINING, OPEN GATE VALVE FULLY AND THEN SLOWLY OPEN 1" GLOBE VALVE FOR DRAINING THE LIQUID AND DURING CLOSING DO REVERSE AND MAKE SURE THE DRAIN LINE IS FULLY CLOSED AFTER THE DRAIN.
- \*GENERAL NOTE:
- LOW POINT DRAINS AND HIGH POINT VENT MUST BE ADDED DURING DETAILED ENGINEERING.

REFERENCE DRAWINGS

SYMBOLS AND LEGENDS

KEY PLAN

REV.	PURPOSE OF ISSUE	DATE	DESIGN	DRAW	CHECK	REVIEW	APPROVE
▲	As Built	30.04.2020	Xu Yekun		Xu Hong	Liu Shengkol	
▲	Approved For Construction	02.02.2018	Xu Yekun		Xu Hong	Liu Shengkol	
▲	Approved For Construction	22.08.2017	Xu Yekun		Xu Hong	Liu Shengkol	
▲	Approved For Construction	05.05.2017	Jiang Yu		Xu Hong	Liu Shengkol	
▲	Approved For Construction	22.03.2017	Jiang Yu		Xu Hong	Liu Shengkol	
▲	Approved For Construction	22.01.2017	Jiang Yu		Xu Hong	Liu Shengkol	
▲	Approved For Construction	11.11.2016	Jiang Yu		Xu Hong	Liu Shengkol	
▲	Approved For Construction	13.10.2016	Jiang Yu		Xu Hong	Liu Shengkol	
▲	Approved For Construction	31.08.2016	Jiang Yu		Xu Hong	Liu Shengkol	
▲	Approved For Construction	24.06.2016	Jiang Yu		Xu Hong	Liu Shengkol	
▲	Issued for Comments	29.04.2016	Jiang Yu		Xu Hong	Liu Shengkol	

THIS DOCUMENT IS THE PROPERTY OF TCC. NO PART OF THIS DOCUMENT SHALL BE REPRODUCED OR DISCLOSED TO OTHERS OR USED FOR ANY PURPOSE WHATSOEVER EXCEPT WITH THE PRIOR WRITTEN PERMISSION OF TCC.

OWNER:


 Middle East Kimiaye Pars Company

DESIGNER	HALDOR TOPSØE A/S	DOCUMENT NAME	NATURAL GAS DISTRIBUTION PIPING AND INSTRUMENT DIAGRAM	DATE	02.02.2018	REV.	4
CHECKER		SCALE		NO.	42		
APPROVED							

CONTRACTOR	TCC 中国天辰工程有限公司	CONTRACTOR DRAWING NO.	MKP-11-AS-1000-PS07-PID-002
		SHEET 01	TOTAL 01
		SUB-CONTRACTOR DRAWING NO.	
		SHEET --	TOTAL --

PROJECT	MKP Methanol Project
UNIT	Desulphurisation Unit
PHASE	As Built Drawing
OWNER DWG NO.	MKP-11-AS-1000-PR-PID-002

SCALE: --	SHEET: 1	TOT.: 1	SIZE: A1
-----------	----------	---------	----------

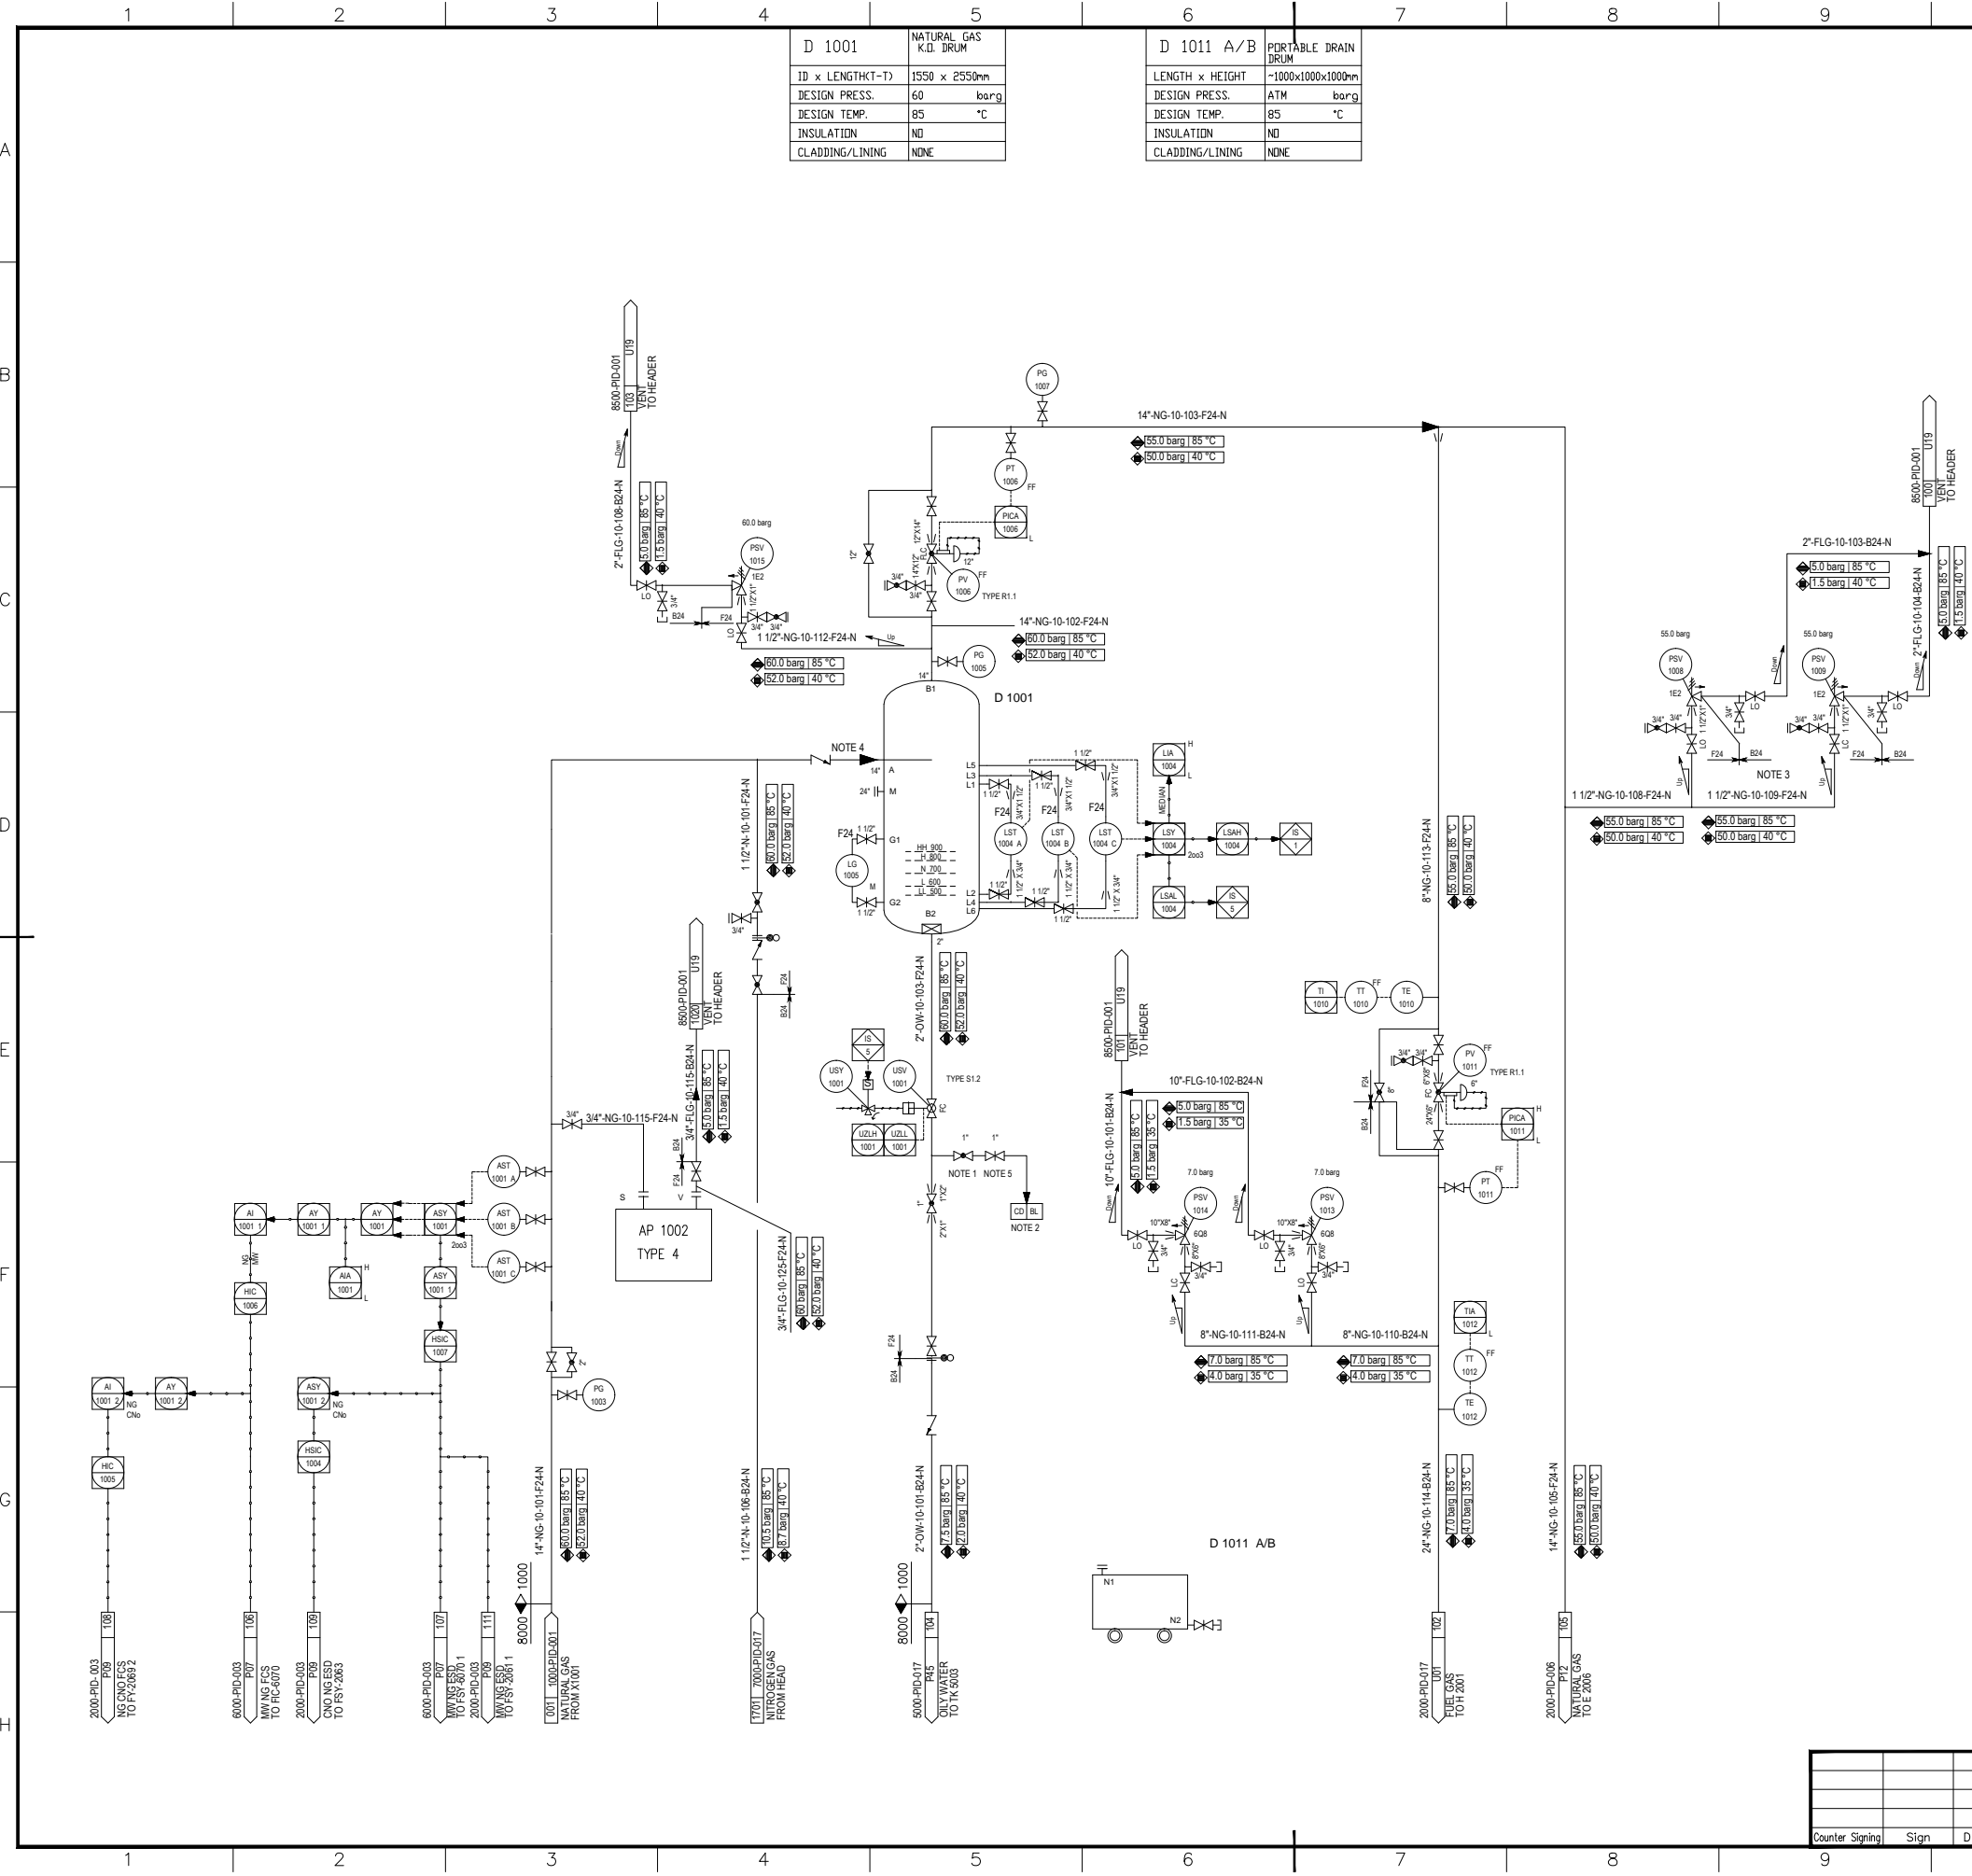

A  
B  
C  
D  
E  
F  
G  
H

A  
B  
C  
D  
E  
F  
G  
H

1 2 3 4 5 6 7 8 9 10 11 12

1 2 3 4 5 6 7 8 9 10 11 12


Counter	Sign	Date
---------	------	------

R 1001	HYDROGENATOR
ID x LENGTH(T-D)	4450x3100 mm
DESIGN PRESS.	55 barg
DESIGN TEMP.	410 °C
INSULATION	YES
CLADDING/LINING	NDNE

R 1002 1/2	SULPHUR ABSORBER
ID x LENGTH(T-D)	4000x1500 mm
DESIGN PRESS.	55 barg
DESIGN TEMP.	410 °C
INSULATION	YES
CLADDING/LINING	NDNE

GENERAL NOTES

- NOTES:
- NOZZLE O OF R 1002 1/2 IS AN INNER EXTENSION TUBE, CONNECTING PIPE OF AP 1039/1044 WITH 1/2" FLANGE, WHICH IS MORE RELIABLE THAN NPT CONNECTION.
  - SOFTWARE LIMITATION FOR CHANGING SET POINT VALUE MUST NOT BE MORE THAN 5%.
  - PV-1045 INCLUDES 4 NOISE REDUCTION DISKS, THE SIZE IS 8"-10"-12"-14", AND THE REDUCER CONSIDERED BY PIPING.
- GENERAL NOTE:
- LOW POINT DRAINS AND HIGH POINT VENT MUST BE ADDED DURING DETAILED ENGINEERING.

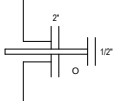

REFERENCE DRAWINGS

SYMBOLS AND LEGENDS

KEY PLAN



REV.	PURPOSE OF ISSUE	DATE	DESIGN	DRAW	CHECK	REVIEW	APPROVE
▲	As Built	30.04.2020	Xu Yekun		Xu Hong	Liu Shengkol	
▲	Approved For Construction	06.11.2017	Xu Yekun		Xu Hong	Liu Shengkol	
▲	Approved For Construction	05.05.2017	Jiang Yu		Xu Hong	Liu Shengkol	
▲	Approved For Construction	22.03.2017	Jiang Yu		Xu Hong	Liu Shengkol	
▲	Approved For Construction	22.01.2017	Jiang Yu		Xu Hong	Liu Shengkol	
▲	Approved For Construction	11.11.2016	Jiang Yu		Xu Hong	Liu Shengkol	
▲	Approved For Construction	13.10.2016	Jiang Yu		Xu Hong	Liu Shengkol	
▲	Approved For Construction	31.08.2016	Jiang Yu		Xu Hong	Liu Shengkol	
▲	Approved For Construction	24.06.2016	Jiang Yu		Xu Hong	Liu Shengkol	
▲	Issued for Comments	29.04.2016	Jiang Yu		Xu Hong	Liu Shengkol	

OWNER:

**Middle East  
Kimiaye Pars Company**


CONTRACTOR	HALDOR TOPSØE A/S	DOCUMENT NAME	DESULPHURISATION PIPING AND INSTRUMENT DIAGRAM	DATE	06.11.2017	NO.	42	REV.	5
CONTRACT NO.	1341714	CONTRACTOR DRAWING NO.	MKP-11-AS-1000-PS07-PID-003	SHEET	01	TOTAL	01		
SUB-CONTRACTOR DRAWING NO.									
SHEET									

PROJECT	MKP Methanol Project
UNIT	Desulphurisation Unit
PHASE	As Built Drawing
OWNER DWG. NO.	MKP-11-AS-1000-PR-PID-003

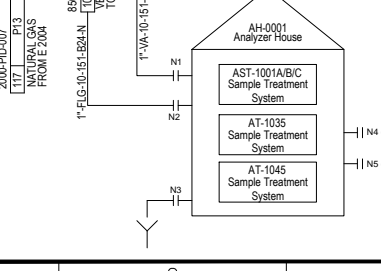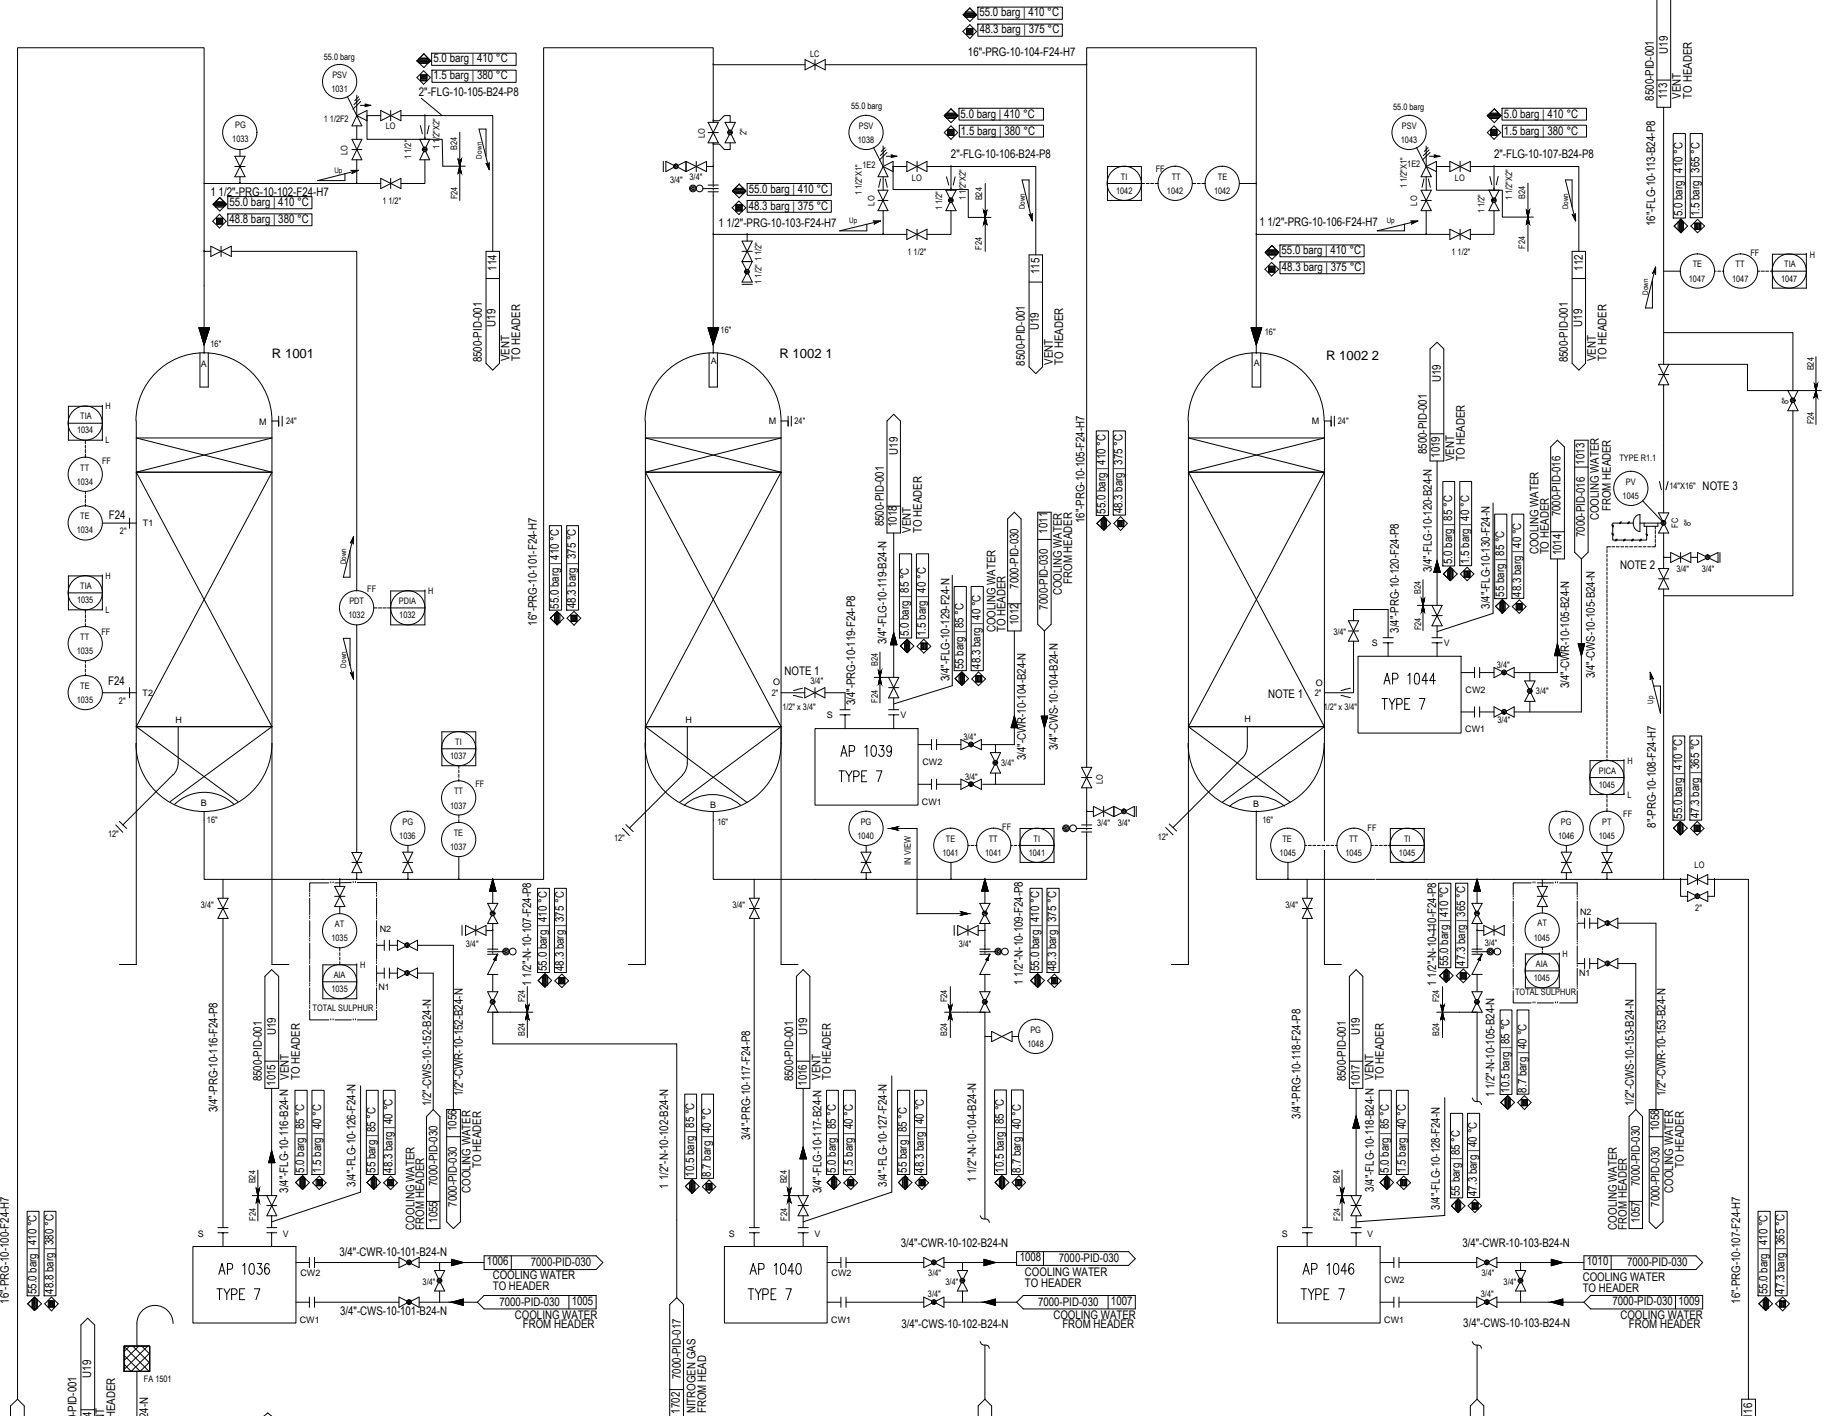

Counter	Sign	Date

SCALE: -	SHEET: 1	TOT: 1	SIZE: A1
----------	----------	--------	----------

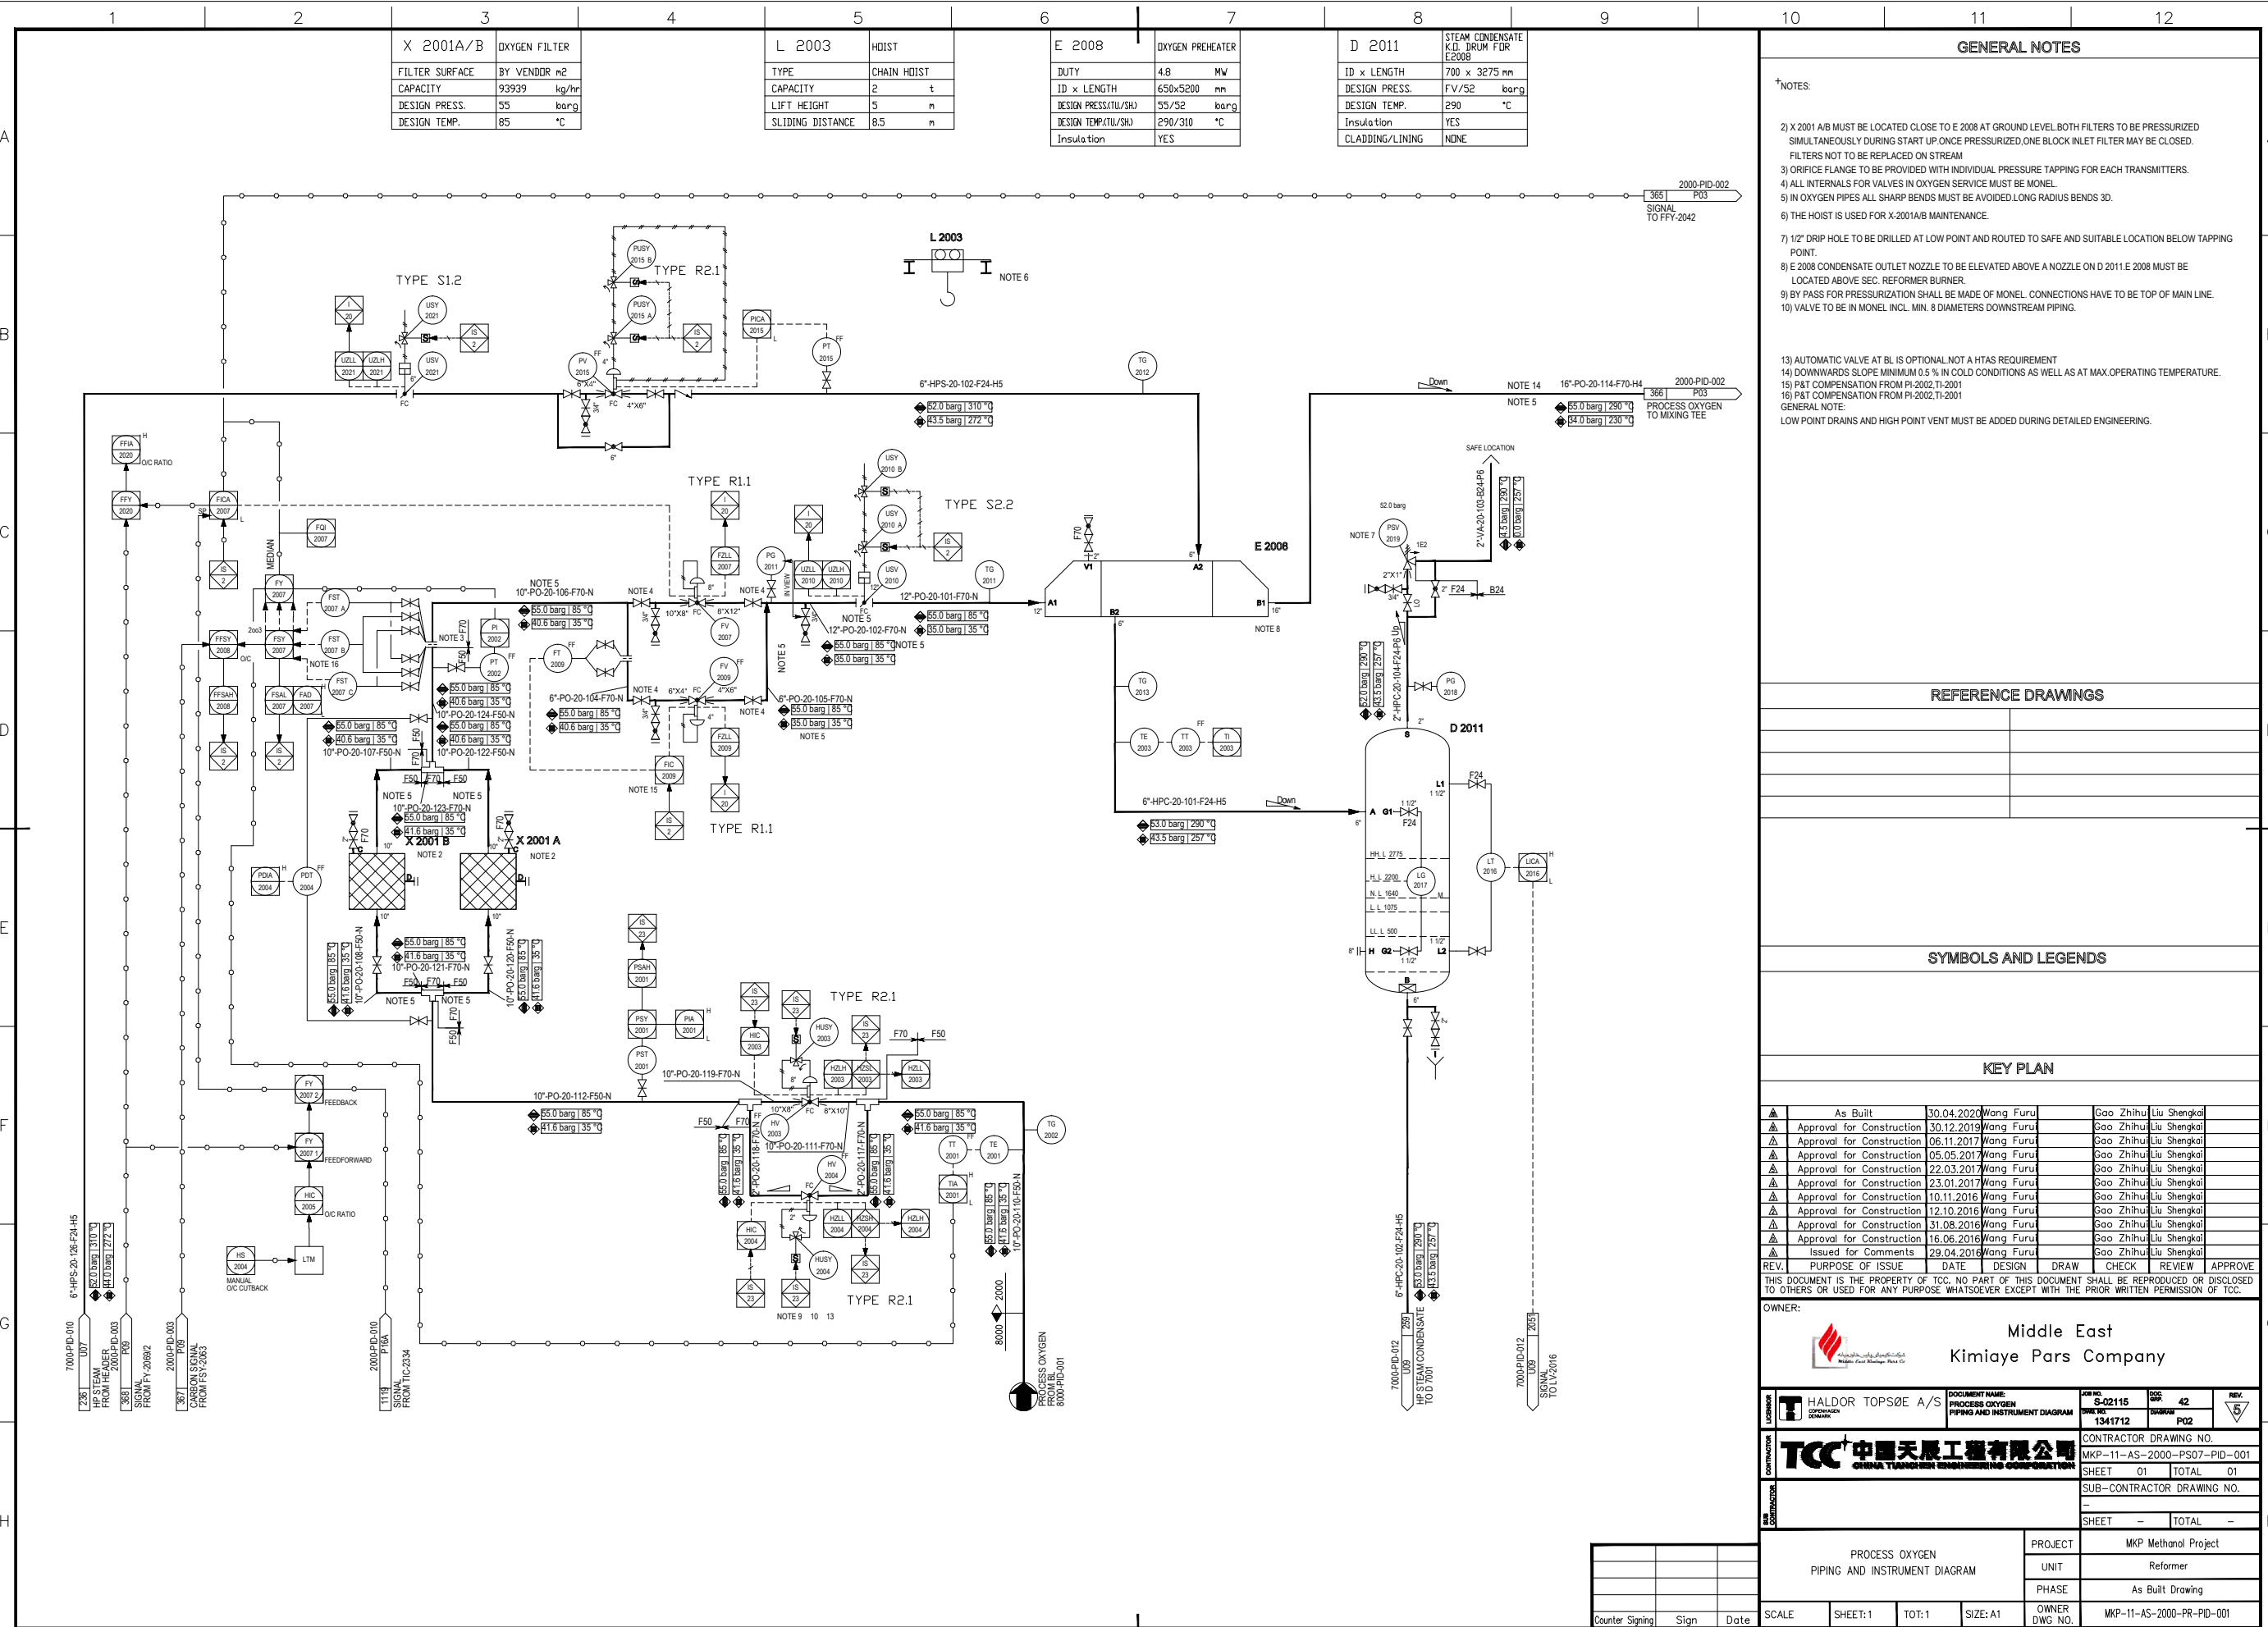

**GENERAL NOTES**

- NOTES:**
- 2) X 2001 A/B MUST BE LOCATED CLOSE TO E 2008 AT GROUND LEVEL. BOTH FILTERS TO BE PRESSURIZED SIMULTANEOUSLY DURING START UP. ONCE PRESSURIZED, ONE BLOCK INLET FILTER MAY BE CLOSED. FILTERS NOT TO BE REPLACED ON STREAM.
  - 3) ORIFICE FLANGE TO BE PROVIDED WITH INDIVIDUAL PRESSURE TAPPING FOR EACH TRANSMITTERS.
  - 4) ALL INTERNALS FOR VALVES IN OXYGEN SERVICE MUST BE MONEL.
  - 5) IN OXYGEN PIPES ALL SHARP BENDS MUST BE AVOIDED. LONG RADIUS BENDS 3D.
  - 6) THE HOIST IS USED FOR X-2001A/B MAINTENANCE.
  - 7) 1/2" DRIP HOLE TO BE DRILLED AT LOW POINT AND ROUTED TO SAFE AND SUITABLE LOCATION BELOW TAPPING POINT.
  - 8) E 2008 CONDENSATE OUTLET NOZZLE TO BE ELEVATED ABOVE A NOZZLE ON D 2011. E 2008 MUST BE LOCATED ABOVE SEC. REFORMER BURNER.
  - 9) BY PASS FOR PRESSURIZATION SHALL BE MADE OF MONEL. CONNECTIONS HAVE TO BE TOP OF MAIN LINE.
  - 10) VALVE TO BE IN MONEL INCL. MIN. 8 DIAMETERS DOWNSTREAM PIPING.
- 13) AUTOMATIC VALVE AT BL IS OPTIONAL NOT A HTAS REQUIREMENT
  - 14) DOWNWARDS SLOPE MINIMUM 0.5 % IN COLD CONDITIONS AS WELL AS AT MAX. OPERATING TEMPERATURE.
  - 15) P&T COMPENSATION FROM FI-2002.TI-2001
  - 16) P&T COMPENSATION FROM FI-2002.TI-2001
- GENERAL NOTE:  
LOW POINT DRAINS AND HIGH POINT VENT MUST BE ADDED DURING DETAILED ENGINEERING.

**REFERENCE DRAWINGS**


**SYMBOLS AND LEGENDS**

**KEY PLAN**

REV.	PURPOSE OF ISSUE	DATE	DESIGN	DRAW	CHECK	REVIEW	APPROVE
▲	As Built	30.04.2020	Wang Furui	Gao Zhihu	Liu Shengkol		
▲	Approval for Construction	30.12.2019	Wang Furui	Gao Zhihu	Liu Shengkol		
▲	Approval for Construction	06.11.2017	Wang Furui	Gao Zhihu	Liu Shengkol		
▲	Approval for Construction	05.05.2017	Wang Furui	Gao Zhihu	Liu Shengkol		
▲	Approval for Construction	22.03.2017	Wang Furui	Gao Zhihu	Liu Shengkol		
▲	Approval for Construction	23.01.2017	Wang Furui	Gao Zhihu	Liu Shengkol		
▲	Approval for Construction	10.11.2016	Wang Furui	Gao Zhihu	Liu Shengkol		
▲	Approval for Construction	12.10.2016	Wang Furui	Gao Zhihu	Liu Shengkol		
▲	Approval for Construction	31.08.2016	Wang Furui	Gao Zhihu	Liu Shengkol		
▲	Approval for Construction	16.06.2016	Wang Furui	Gao Zhihu	Liu Shengkol		
▲	Issued for Comments	29.04.2016	Wang Furui	Gao Zhihu	Liu Shengkol		

THIS DOCUMENT IS THE PROPERTY OF TCC. NO PART OF THIS DOCUMENT SHALL BE REPRODUCED OR DISCLOSED TO OTHERS OR USED FOR ANY PURPOSE WHATSOEVER EXCEPT WITH THE PRIOR WRITTEN PERMISSION OF TCC.


OWNER: **Middle East Kimiaye Pars Company**

	DOCUMENT NAME: <b>PROCESS OXYGEN PIPING AND INSTRUMENT DIAGRAM</b>	JOB NO: <b>S-02115</b>	SHEET NO: <b>42</b>	REV. <b>5</b>
	CONTRACTOR DRAWING NO. <b>1341712</b>	SHEET NO. <b>02</b>		
	CONTRACTOR DRAWING NO. <b>MKP-11-AS-2000-PS07-PID-001</b>			
	SHEET 01 TOTAL 01			
SUB-CONTRACTOR DRAWING NO.				
SHEET -- TOTAL --				

PROJECT: <b>MKP Methanol Project</b>	UNIT: <b>Reformer</b>
PHASE: <b>As Built Drawing</b>	
SCALE: SHEET:1 TOT:1 SIZE: A1	OWNER DWG NO.: <b>MKP-11-AS-2000-PR-PID-001</b>

Counter	Sign	Date



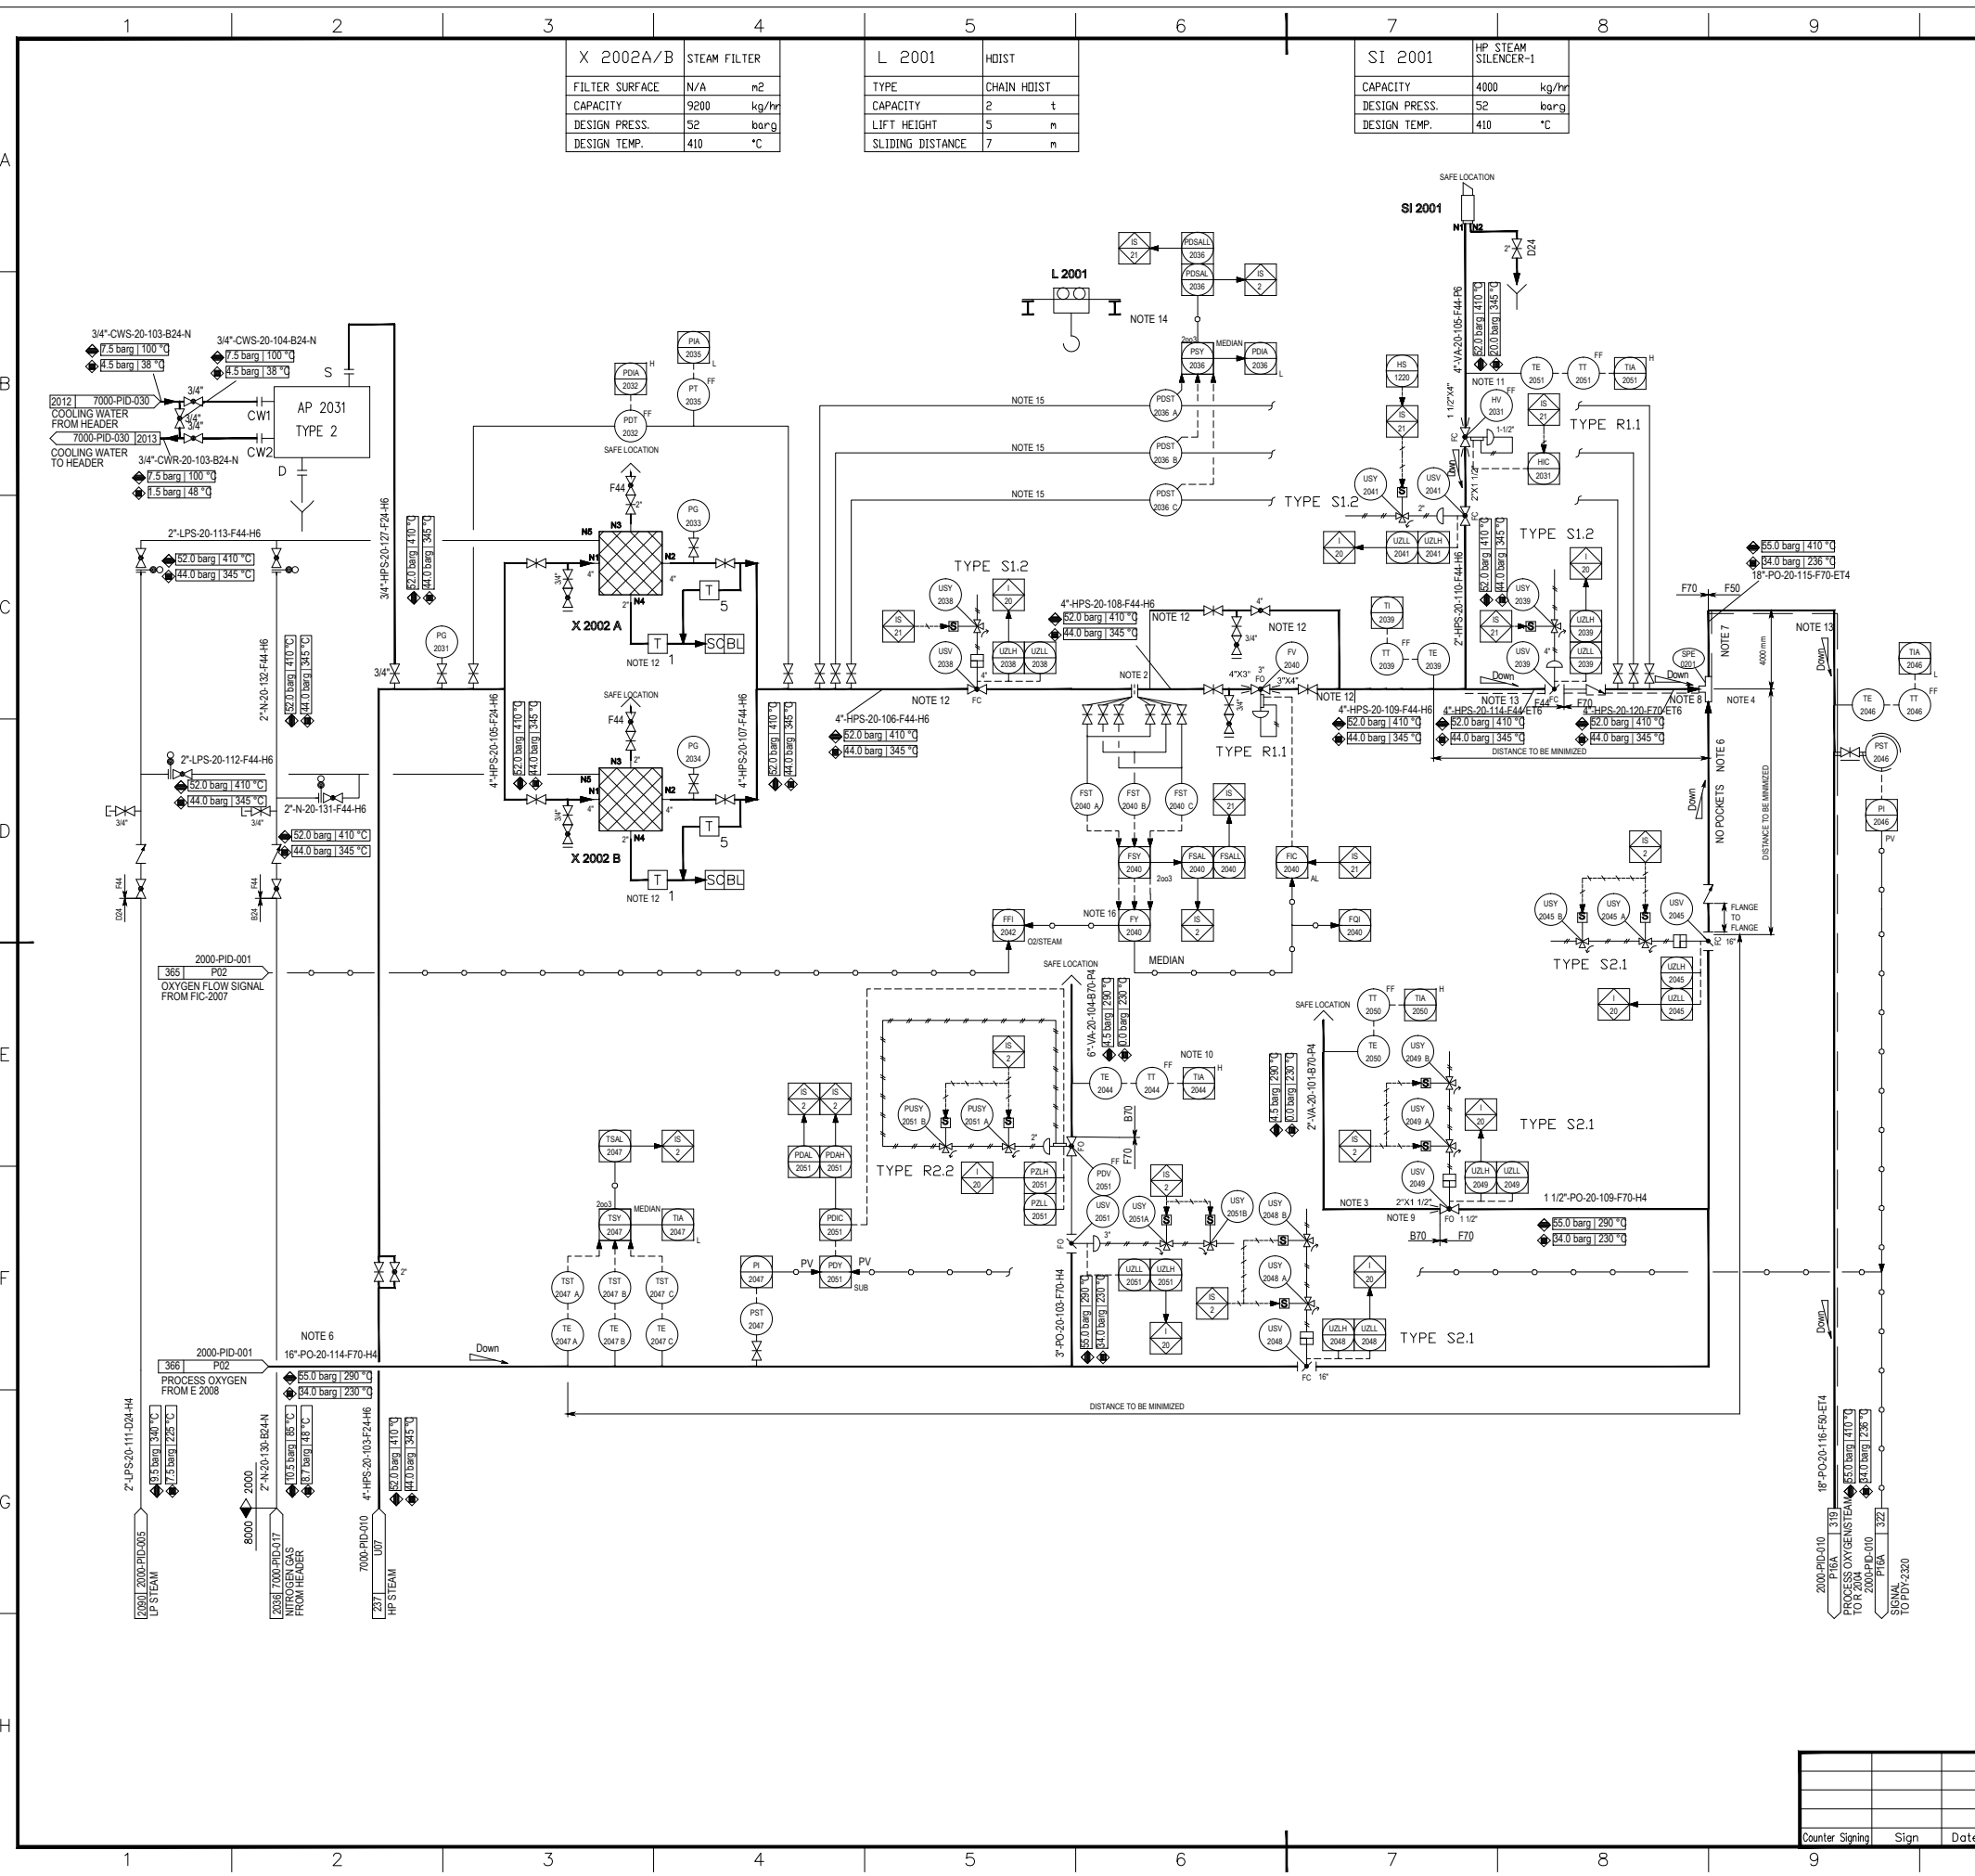

X 2002A/B STEAM FILTER		
FILTER SURFACE	N/A	m <sup>2</sup>
CAPACITY	9200	kg/hr
DESIGN PRESS.	52	barg
DESIGN TEMP.	410	°C

L 2001 HOIST	
TYPE	CHAIN HOIST
CAPACITY	2 t
LIFT HEIGHT	5 m
SLIDING DISTANCE	7 m

SI 2001 HP STEAM SILENCER-1	
CAPACITY	4000 kg/hr
DESIGN PRESS.	52 barg
DESIGN TEMP.	410 °C

**GENERAL NOTES**

- NOTES:
- ORIFICE FLANGE TO BE PROVIDED WITH INDIVIDUAL PRESSURE TAPPING FOR EACH TRANSMITTERS.
  - NO POCKETS ALLOWED.
  - DETAILED DESIGNER MUST CONSIDER THERMAL STRESSES IN THE MIXING POINT. THE TEE MUST BE MOUNTED TO ENSURE A STRAIGHT FLOW OF OXYGEN.
  - ANY ELBOWS BETWEEN O<sub>2</sub> / STEAM MIXING TEE AND R 2004 MUST BE WITH LONG RADIUS (1.5 D)
  - IN OXYGEN PIPES ALL SHARP BENDS MUST BE AVOIDED. LONG RADIUS BENDS 3D.
  - MIN. LENGTH OF MONEL PIPE FROM MIXING POINT: 4m. DISTANCE TO R 2004 MUST BE MINIMIZED.
  - PIPE MUST BE DESIGNED IN MATERIALS AS SPECIFIED IN F70 (MONEL) BUT MUST BE ABLE TO WITHSTAND DESIGN TEMPERATURE AND DESIGN PRESSURE AS SPECIFIED.
  - BLEED TO BE TAKEN FROM BOTTOM OF OXYGEN LINE AND ROUTED TO SAFE LOCATION BELOW TAPPING POINT.
  - START-UP PREHEATING OF OXYGEN LINE IT MUST BE POSSIBLE TO OPERATE THIS BLEED AFTER IS-2 IS RESET BUT BEFORE DOUBLE BLOCK AND BLEED IS RESET
  - 1/2" DRIP HOLE TO BE DRILLED AT LOW POINT AND ROUTED TO SAFE AND SUITABLE LOCATION BELOW TAPPING POINT.
  - STEAM TRAPS AT LOW POINTS/ DEAD ENDS MUST BE PROVIDED.
  - MI CABLE TRACING TO 250 °C.
  - THE HOIST IS USED FOR X-2002AB MAINTENANCE.
  - BYPASS LINE IN MANIFOLD IS NOT ALLOWED.
  - P&T COMPENSATION FROM PIC-7003, TI-7007

GENERAL NOTE:  
 LOW POINT DRAINS AND HIGH POINT VENT MUST BE ADDED DURING DETAILED ENGINEERING.  
 IN OXYGEN PIPES ALL SHARP BENDS MUST BE AVOIDED. LONG RADIUS BENDS 3D.

**REFERENCE DRAWINGS**

**SYMBOLS AND LEGENDS**

**KEY PLAN**

REV.	PURPOSE OF ISSUE	DATE	DESIGN	DRAW	CHECK	REVIEW	APPROVE
▲	As Built	30.04.2020	Wang Furu		Gao Zhihu	Liu Shengkol	
▲	Approval for Construction	30.12.2019	Wang Furu		Gao Zhihu	Liu Shengkol	
▲	Approval for Construction	06.11.2017	Wang Furu		Gao Zhihu	Liu Shengkol	
▲	Approval for Construction	05.05.2017	Wang Furu		Gao Zhihu	Liu Shengkol	
▲	Approval for Construction	22.03.2017	Wang Furu		Gao Zhihu	Liu Shengkol	
▲	Approval for Construction	23.01.2017	Wang Furu		Gao Zhihu	Liu Shengkol	
▲	Approval for Construction	10.11.2016	Wang Furu		Gao Zhihu	Liu Shengkol	
▲	Approval for Construction	12.10.2016	Wang Furu		Gao Zhihu	Liu Shengkol	
▲	Approval for Construction	31.08.2016	Wang Furu		Gao Zhihu	Liu Shengkol	
▲	Approval for Construction	16.06.2016	Wang Furu		Gao Zhihu	Liu Shengkol	
▲	Issued for Comments	29.04.2016	Wang Furu		Gao Zhihu	Liu Shengkol	

THIS DOCUMENT IS THE PROPERTY OF TCC. NO PART OF THIS DOCUMENT SHALL BE REPRODUCED OR DISCLOSED TO OTHERS OR USED FOR ANY PURPOSE WHATSOEVER EXCEPT WITH THE PRIOR WRITTEN PERMISSION OF TCC.


OWNER: **Middle East Kimiaye Pars Company**

DESIGNER	HALDOR TOPSØE A/S	DOCUMENT NAME	OXYGEN PREHEATING PIPING AND INSTRUMENT DIAGRAM	PROJ NO	S-02115	REV	42
DRAWN		DATE		SHEET NO	1341713	TOTAL	03

CONTRACTOR	<b>TCC 中国天辰工程有限公司</b>	CONTRACTOR DRAWING NO.	MKP-11-AS-2000-PS07-PID-002
		SHEET	01 TOTAL 01
		SUB-CONTRACTOR DRAWING NO.	
		SHEET	TOTAL

PROJECT	MKP Methanol Project
UNIT	Reformer
PHASE	As Built Drawing
OWNER DWG NO.	MKP-11-AS-2000-PR-PID-002

Counter	Sign	Date
---------	------	------

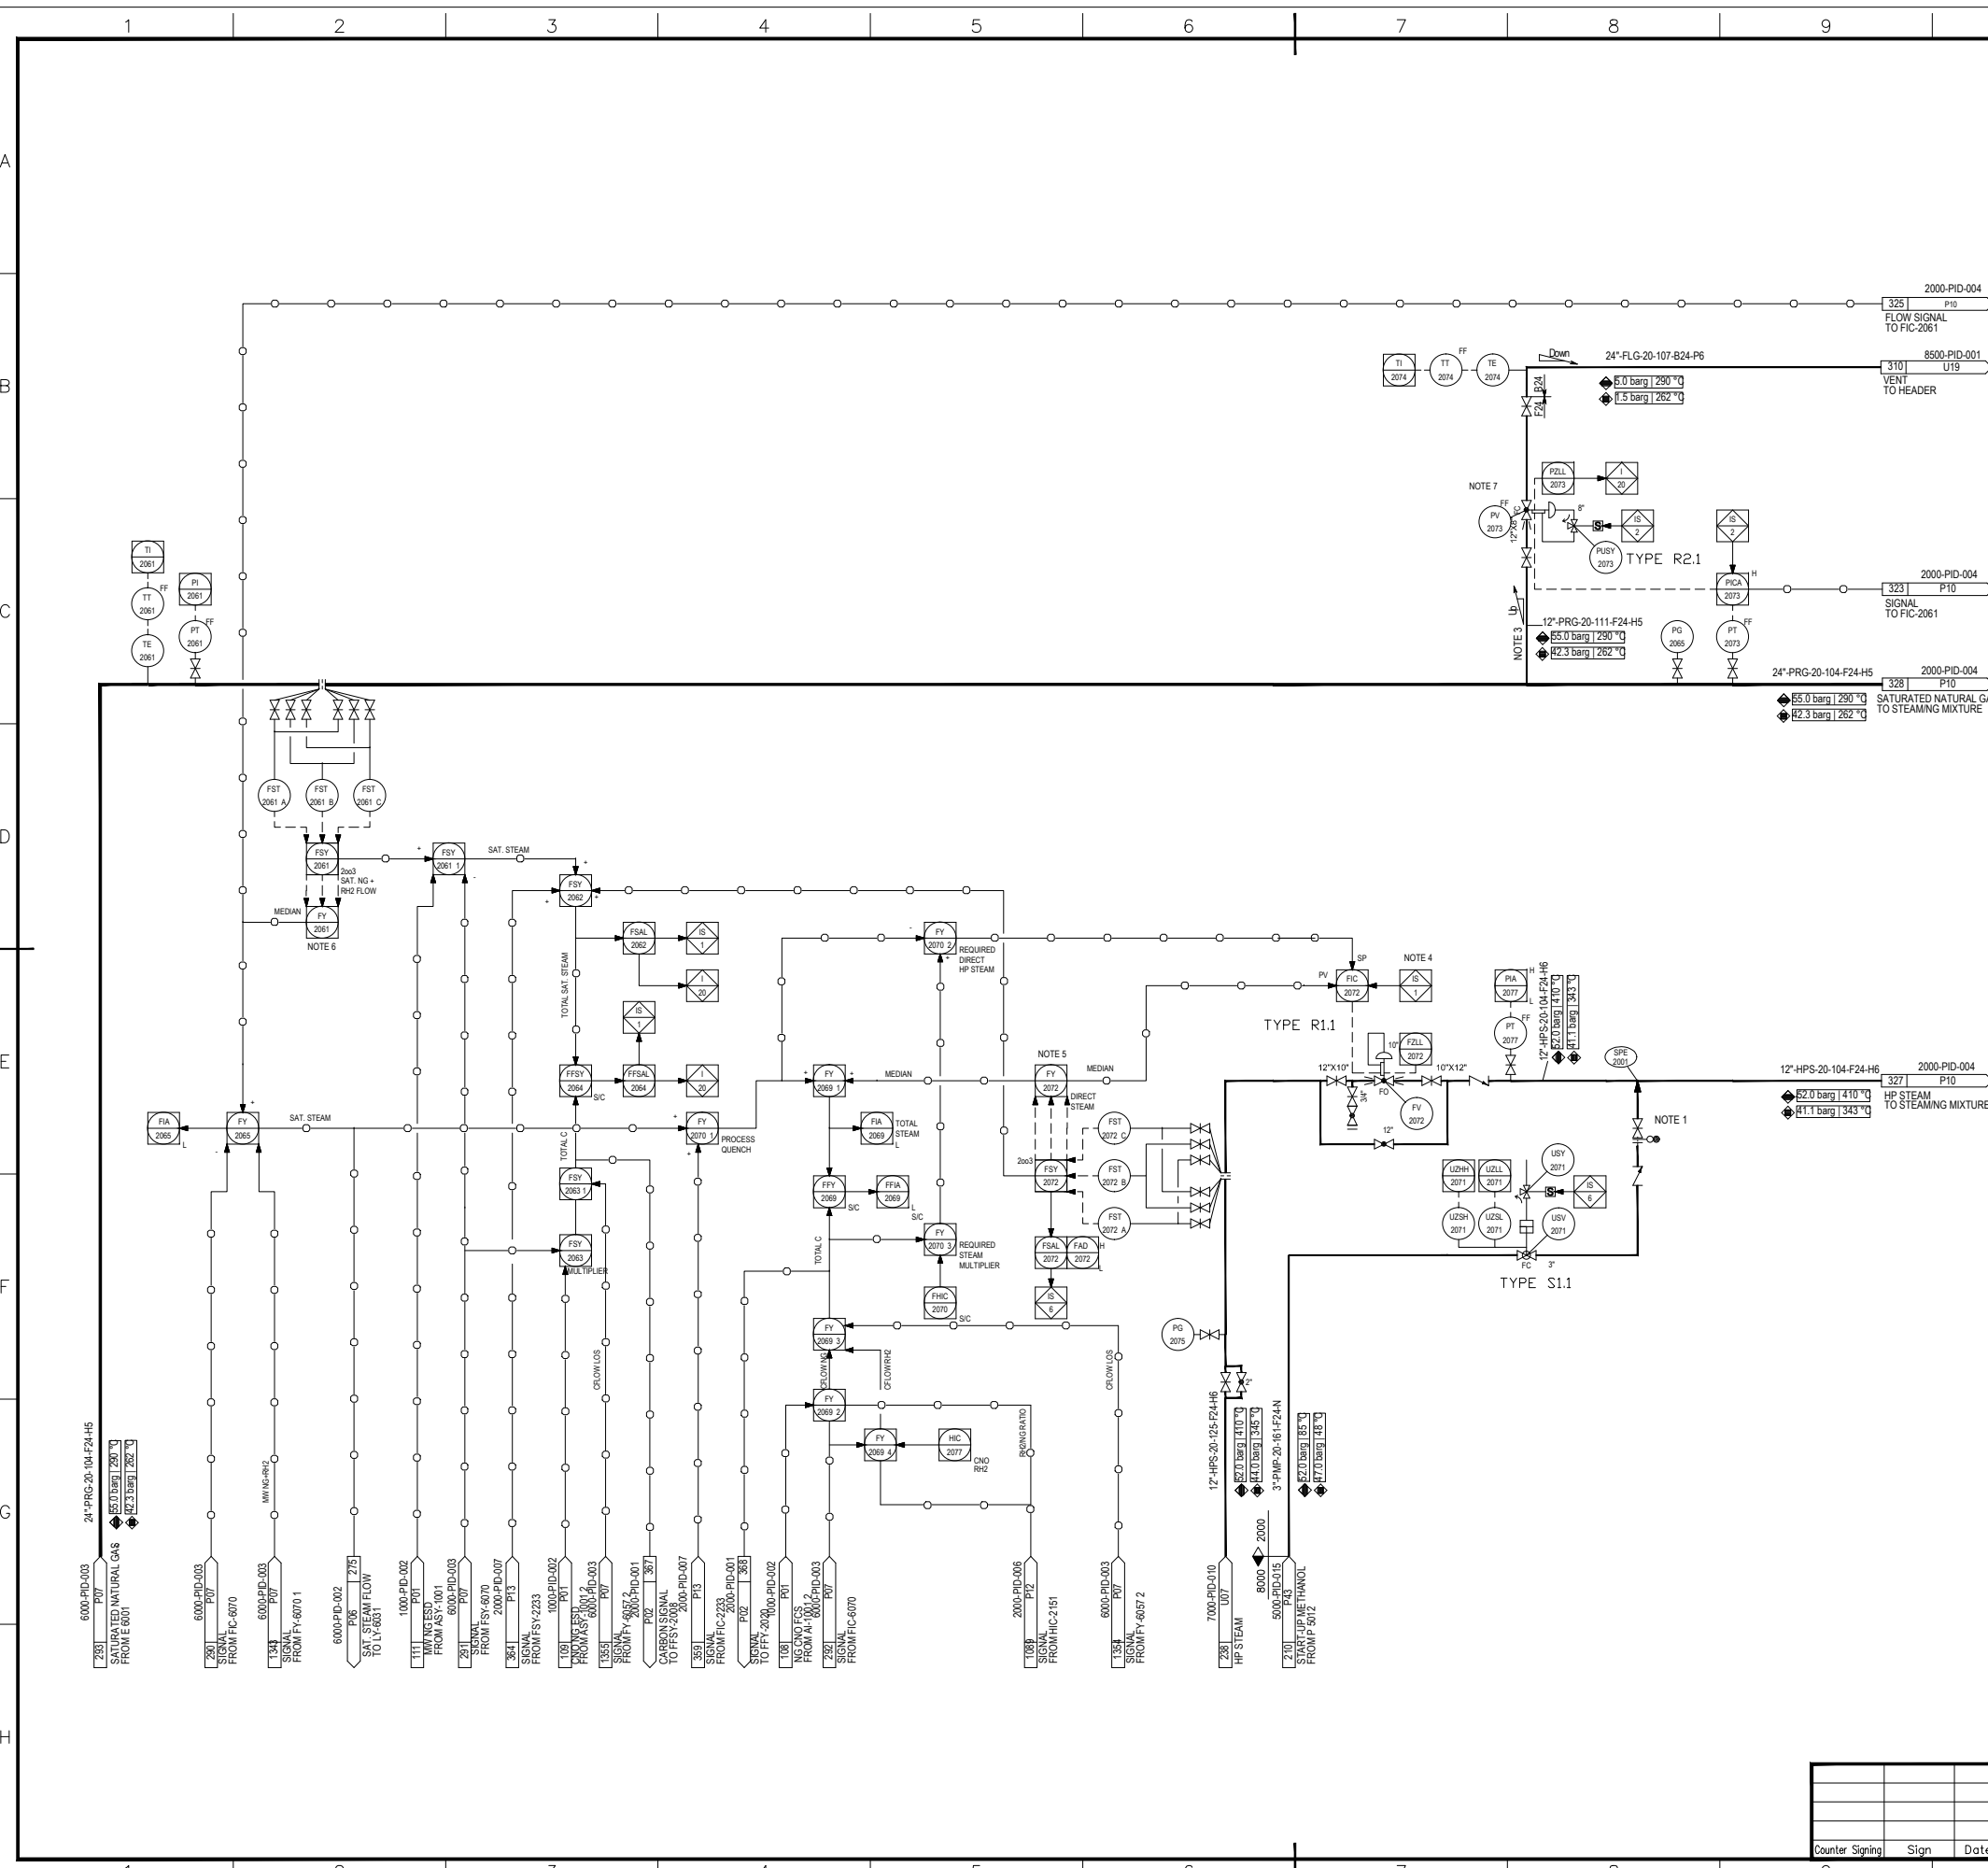

### GENERAL NOTES

†NOTES:

- METHANOL INJECTION CONNECTION.
- DISTANCE MINIMISED BETWEEN PROCESS VENT AND E 2002 B.
- SUBSEQUENT TO IS-1 THIS SET POINT IS RAMPED DOWN.
- P&T COMPENSATION FROM PIC-7003, TI-7007
- P&T COMPENSATION FROM PI-2061, TI-2061
- PV-2073 includes 4 noise reduction disks, the size is 14" 24" and the reducer considered by piping.

†GENERAL NOTE:  
LOW POINT DRAINS AND HIGH POINT VENT MUST BE ADDED DURING DETAILED ENGINEERING.

### REFERENCE DRAWINGS


### SYMBOLS AND LEGENDS

### KEY PLAN

▲	As Built	30.04.2020	Wang Furu	Gao Zhihu	Liu Shengkol
▲	Approval for Construction	30.12.2019	Wang Furu	Gao Zhihu	Liu Shengkol
▲	Approval for Construction	05.05.2017	Wang Furu	Gao Zhihu	Liu Shengkol
▲	Approval for Construction	22.03.2017	Wang Furu	Gao Zhihu	Liu Shengkol
▲	Approval for Construction	10.11.2016	Wang Furu	Gao Zhihu	Liu Shengkol
▲	Approval for Construction	12.10.2016	Wang Furu	Gao Zhihu	Liu Shengkol
▲	Approval for Construction	31.08.2016	Wang Furu	Gao Zhihu	Liu Shengkol
▲	Approval for Construction	16.06.2016	Wang Furu	Gao Zhihu	Liu Shengkol
▲	Issued for Comments	29.04.2016	Wang Furu	Gao Zhihu	Liu Shengkol

REV.	PURPOSE OF ISSUE	DATE	DESIGN	DRAW	CHECK	REVIEW	APPROVE

THIS DOCUMENT IS THE PROPERTY OF TCC. NO PART OF THIS DOCUMENT SHALL BE REPRODUCED OR DISCLOSED TO OTHERS OR USED FOR ANY PURPOSE WHATSOEVER EXCEPT WITH THE PRIOR WRITTEN PERMISSION OF TCC.

OWNER: **Middle East Kimiaye Pars Company**

	DOCUMENT NAME: <b>S/C RATIO CONTROL I PIPING AND INSTRUMENT DIAGRAM</b>	JOB NO: <b>S-02115</b>	SHEET NO: <b>42</b>	REV. <b>4</b>
	CONTRACTOR: 	CONTRACTOR DRAWING NO. <b>MKP-11-AS-2000-PS07-PID-003</b>	SHEET 01 TOTAL 01	SUB-CONTRACTOR DRAWING NO.

S/C RATIO CONTROL I PIPING AND INSTRUMENT DIAGRAM		PROJECT	MKP Methanol Project
		UNIT	Reformer
		PHASE	As Built Drawing
		OWNER DWG NO.	MKP-11-AS-2000-PR-PID-003

Counter	Sign	Date	SCALE	SHEET: 1	TOT: 1	SIZE: A1
---------	------	------	-------	----------	--------	----------

SI 2003	HP STEAM SILENCER-2
CAPACITY	4000 kg/hr
DESIGN PRESS.	52 barg
DESIGN TEMP.	410 °C

**GENERAL NOTES**

- NOTES:
- 1) TOP ENTRY CONNECTION.
  - 3) DISTANCE MINIMIZED BETWEEN PROCESS VENT AND E 2002.
  - 4) 1/2" DRIPHOLE TO BE DRILLED AT LOW POINT TO SAFE AND SUITABLE LOCATION.
  - 5) OPERATED LOCAL.
  - 6) MIN. DISTANCE BETWEEN USV-2092 AND USV-2093.
  - 8) CONSIDER DRAIN LINE AT LOW POINT.
  - 9) P&T COMPENSATION FROM PIC-2073.TI-2061.
  - 10) P&T COMPENSATION FROM PI-2150.TI-2150.

GENERAL NOTE:  
LOW POINT DRAINS AND HIGH POINT VENT MUST BE ADDED DURING DETAILED ENGINEERING.

**REFERENCE DRAWINGS**

**SYMBOLS AND LEGENDS**

**KEY PLAN**


REV.	PURPOSE OF ISSUE	DATE	DESIGN	DRAW	CHECK	REVIEW	APPROVE
▲	As Built	30.04.2020	Wang Furu		Gao Zhihu	Liu Shengkol	
▲	Approval for Construction	30.12.2019	Wang Furu		Gao Zhihu	Liu Shengkol	
▲	Approval for Construction	06.11.2017	Wang Furu		Gao Zhihu	Liu Shengkol	
▲	Approval for Construction	22.03.2017	Wang Furu		Gao Zhihu	Liu Shengkol	
▲	Approval for Construction	23.01.2017	Wang Furu		Gao Zhihu	Liu Shengkol	
▲	Approval for Construction	28.12.2016	Wang Furu		Gao Zhihu	Liu Shengkol	
▲	Approval for Construction	10.11.2016	Wang Furu		Gao Zhihu	Liu Shengkol	
▲	Approval for Construction	12.10.2016	Wang Furu		Gao Zhihu	Liu Shengkol	
▲	Approval for Construction	31.08.2016	Wang Furu		Gao Zhihu	Liu Shengkol	
▲	Approval for Construction	16.06.2016	Wang Furu		Gao Zhihu	Liu Shengkol	
▲	Issued for Comments	29.04.2016	Wang Furu		Gao Zhihu	Liu Shengkol	

THIS DOCUMENT IS THE PROPERTY OF TCC. NO PART OF THIS DOCUMENT SHALL BE REPRODUCED OR DISCLOSED TO OTHERS OR USED FOR ANY PURPOSE WHATSOEVER EXCEPT WITH THE PRIOR WRITTEN PERMISSION OF TCC.

OWNER: **Middle East Kimiaye Pars Company**

DESIGNER	HALDOR TOPSØE A/S	DOCUMENT NAME	S/C RATIO CONTROL II PIPING AND INSTRUMENT DIAGRAM	PRO NO	S-02115	REV.	42
DATE	2020.07.07	SCALE	P10	CONTRACTOR DRAWING NO.	1341720	TOTAL	01
				SUB-CONTRACTOR DRAWING NO.		SHEET	01
				SHEET		TOTAL	

S/C RATIO CONTROL II PIPING AND INSTRUMENT DIAGRAM		PROJECT	MKP Methanol Project
		UNIT	Reformer
		PHASE	As Built Drawing
SCALE	SHEET:1	TOT:1	SIZE: A1
OWNER DWG NO.	MKP-11-AS-2000-PR-PID-004		

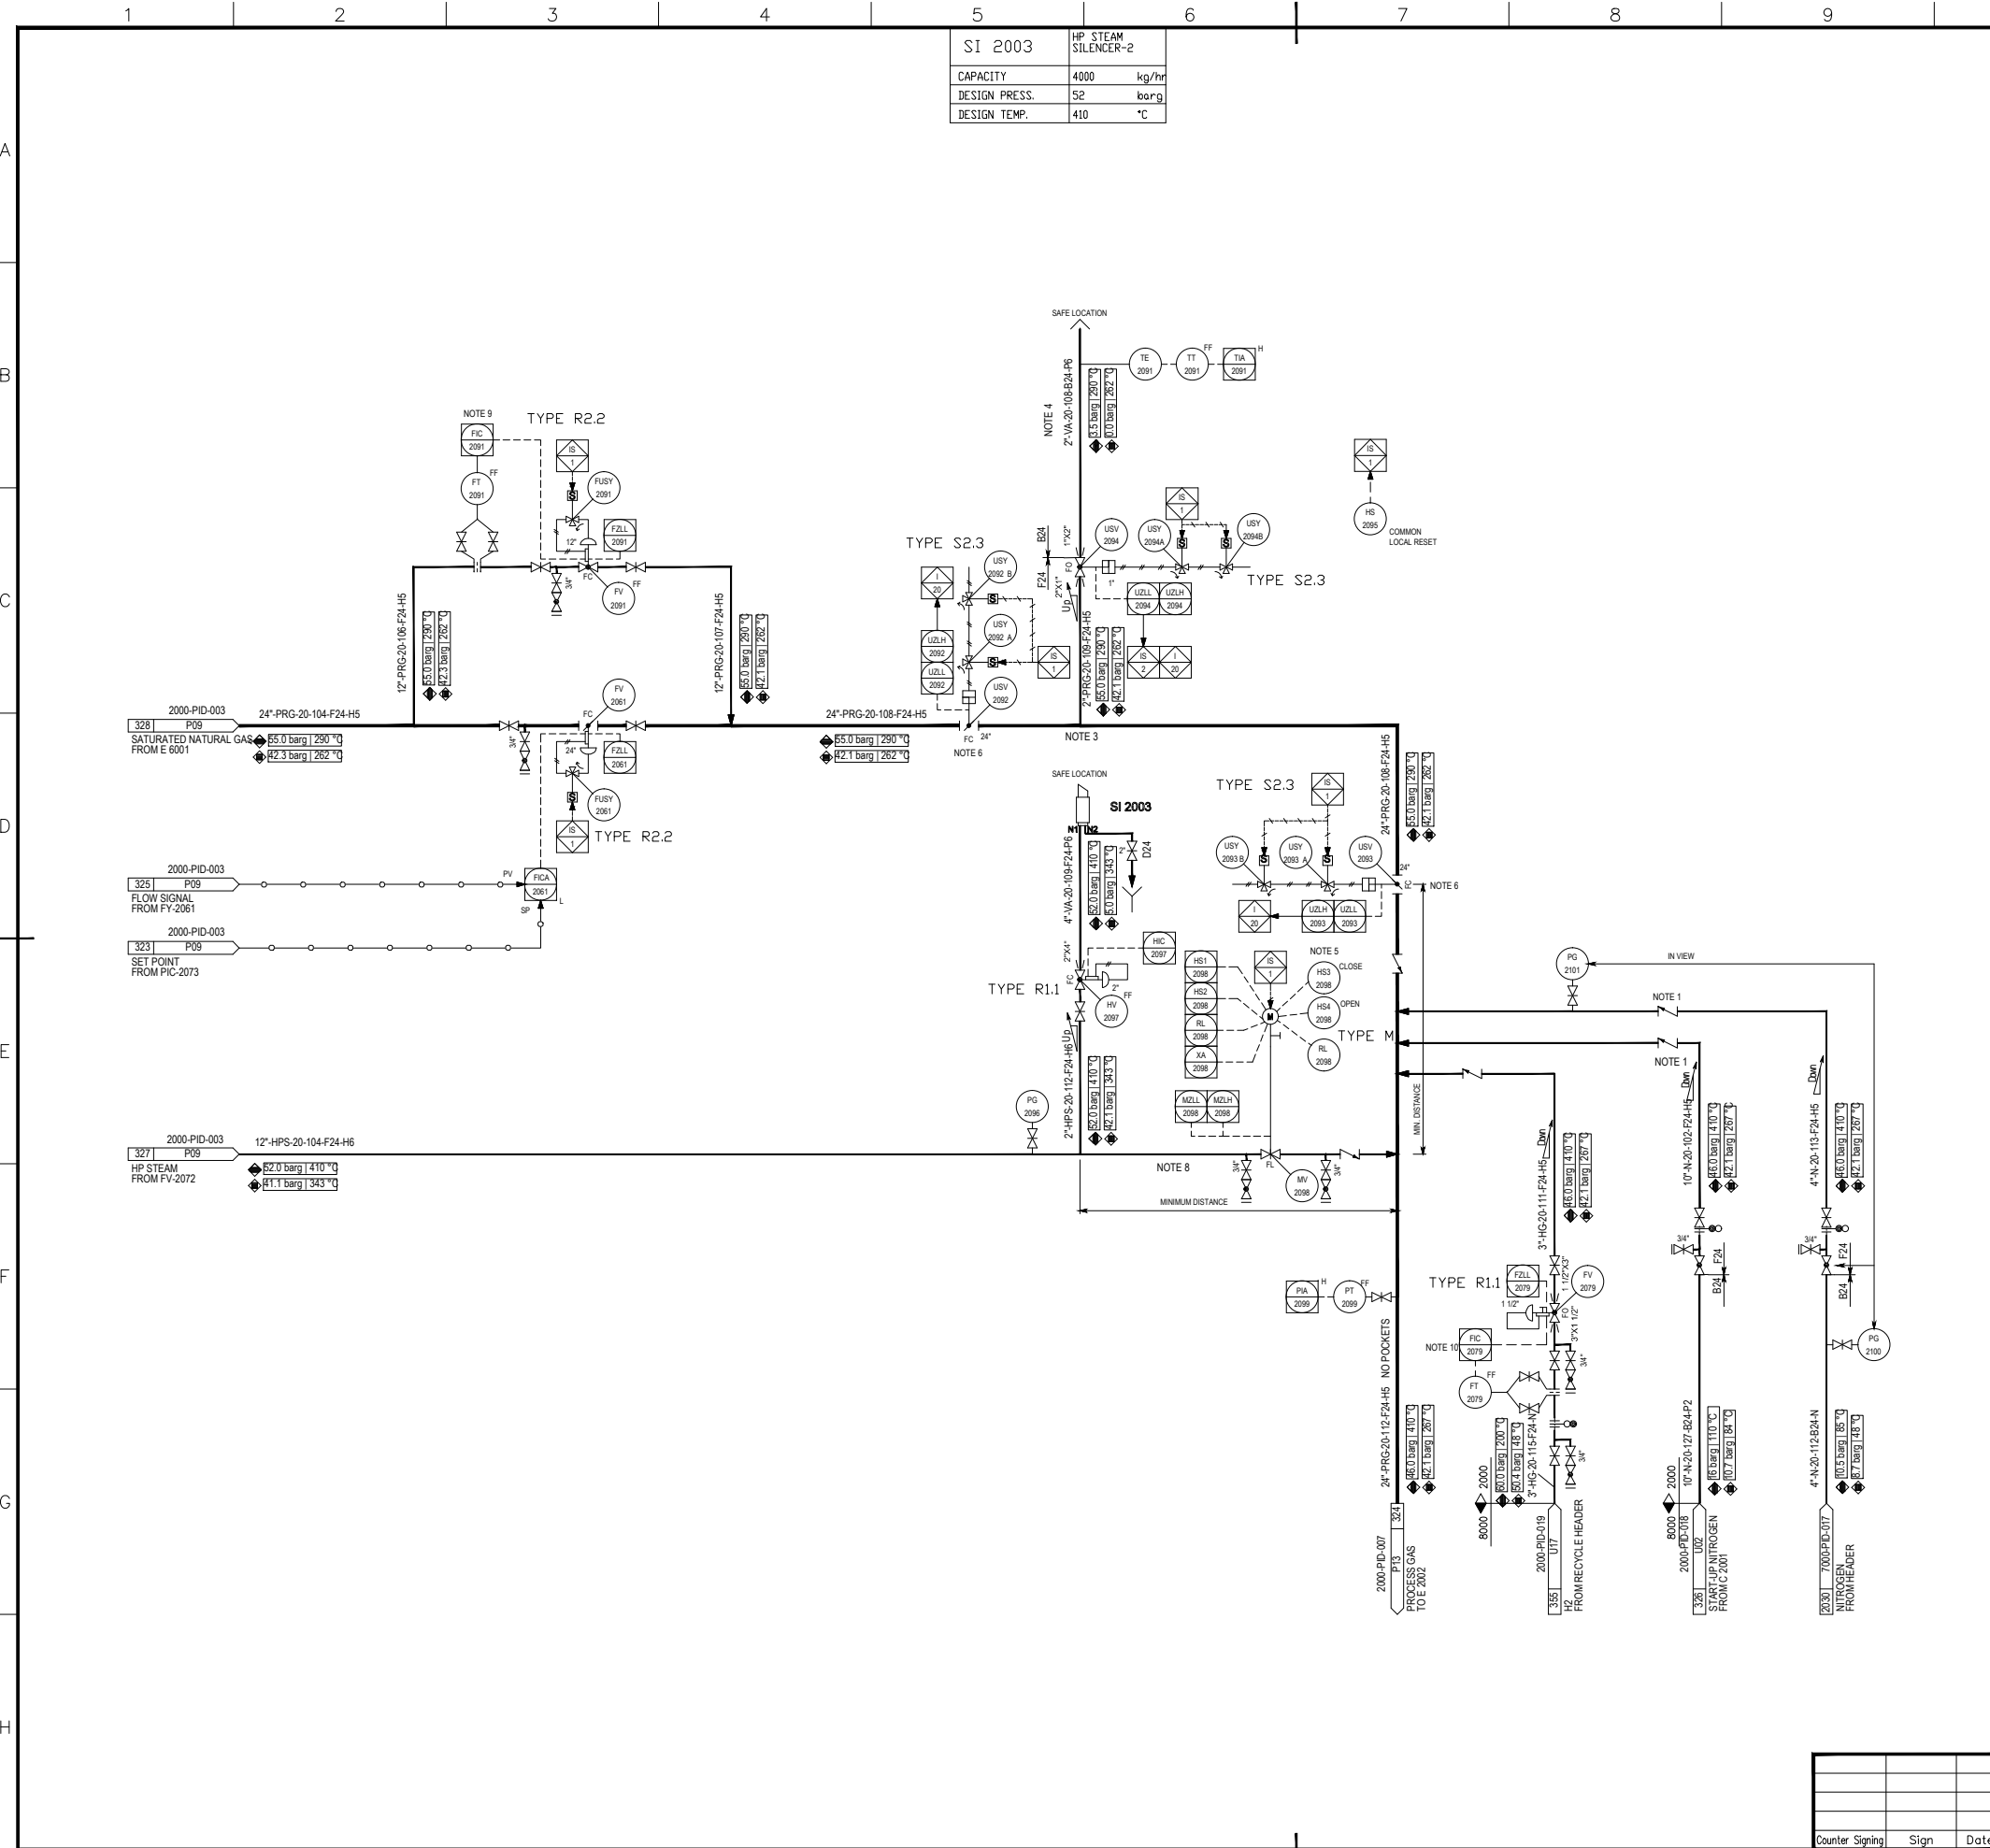

Counter Signing Sign Date

F 2002	COMBUSTION AIR BLOWER
CAPACITY	424237 kg/hr
PRESS. (SUC./DIS.)	-0.012/0.034 barg
TEMP. (SUC./DIS.)	48/ °C
DRIVE POWER	1400 kW
AUXILIARY PIPING	By Vendor

FT 2002	STEAM TURBINE FOR F 2002
TYPE	BACK PRESSURE
DESIGN PRESS.	52 barg
DESIGN TEMP.	410 °C
RATED POWER	1350 kW

SI 2005	HP STEAM SILENCER-3
CAPACITY	6000 kg/hr
DESIGN PRESS.	52 barg
DESIGN TEMP.	410 °C

**GENERAL NOTES**

- NOTES:
- AIR INTAKE WITH DUST FILTER TO BE LOCATED MINIMUM 5 m ABOVE GRADE.
  - PIPE SIZES FOR STEAM AT FT-2002 BY TURBINE VENDOR.
  - VENDOR SCOPE TO BE DETAILED BY VENDOR.
  - 1/2" DRIP HOLE TO BE DRILLED AT LOW POINT TO SAFE AND SUITABLE LOCATION.
  - VALVE SIZE WILL BE CONFIRMED BY VENDOR.
  - AIR DUCTING SIZE WILL BE CONFIRMED BY VENDOR FINALLY.
  - THE SUPPLY SCOPE OF PRIMARY REFORMER VENDOR INSTRUMENTS ARE OUT OF VENDOR SUPPLY SCOPE IF NO SPECIAL INSTRUCTIONS.
  - THE FLOWMETER ELEMENT IS SUPPLIED BY PRIMARY REFORMER VENDOR.
  - P&T COMPENSATION FROM PIC-7003.TI-7107.
  - P&T COMPENSATION FROM PI-2111.TI-2111.
  - THE TEMPERATURE INDICATOR/GAUGE(TT-2851/2852) AND THE PRESSURE INDICATOR/GAUGE (PT-2854/PT-2855/PG-2851) ARE SUPPLIED BY FT2002 VENDOR. PLEASE FIND VENDOR DOCUMENT FOR DETAILS.

GENERAL NOTE:  
LOW POINT DRAINS AND HIGH POINT VENT MUST BE ADDED DURING DETAILED ENGINEERING.

**REFERENCE DRAWINGS**

**SYMBOLS AND LEGENDS**

**KEY PLAN**

As Built	30.04.2020	Wang Furu	Gao Zhihu	Liu Shengkol
Approval for Construction	30.12.2019	Wang Furu	Gao Zhihu	Liu Shengkol
Approval for Construction	06.11.2017	Wang Furu	Gao Zhihu	Liu Shengkol
Approval for Construction	05.05.2017	Wang Furu	Gao Zhihu	Liu Shengkol
Approval for Construction	22.03.2017	Wang Furu	Gao Zhihu	Liu Shengkol
Approval for Construction	23.01.2017	Wang Furu	Gao Zhihu	Liu Shengkol
Approval for Construction	10.11.2016	Wang Furu	Gao Zhihu	Liu Shengkol
Approval for Construction	12.10.2016	Wang Furu	Gao Zhihu	Liu Shengkol
Approval for Construction	31.08.2016	Wang Furu	Gao Zhihu	Liu Shengkol
Approval for Construction	16.06.2016	Wang Furu	Gao Zhihu	Liu Shengkol
Issued for Comments	29.04.2016	Wang Furu	Gao Zhihu	Liu Shengkol


REV. PURPOSE OF ISSUE DATE DESIGN DRAW CHECK REVIEW APPROVE  
THIS DOCUMENT IS THE PROPERTY OF TCC. NO PART OF THIS DOCUMENT SHALL BE REPRODUCED OR DISCLOSED TO OTHERS OR USED FOR ANY PURPOSE WHATSOEVER EXCEPT WITH THE PRIOR WRITTEN PERMISSION OF TCC.

OWNER: **Middle East Kimiaye Pars Company**

DESIGNER	HALDOR TOPSØE A/S	DOCUMENT NAME	FLUE GAS WHS I PIPING AND INSTRUMENT DIAGRAM	PRO NO	S-02115	REV.	4
DRAWN		DATE		NO.	1341721	SCALE	P11
CONTRACTOR	<b>TCC 中国天辰工程技术有限公司</b>	CONTRACTOR DRAWING NO. MKP-11-AS-2000-PS07-PID-005					
NO.		SHEET 01 TOTAL 01					
SUB-CONTRACTOR DRAWING NO.							
SHEET -- TOTAL --							

FLUE GAS WHS I PIPING AND INSTRUMENT DIAGRAM		PROJECT	MKP Methanol Project
		UNIT	Reformer
		PHASE	As Built Drawing
		OWNER DWG NO.	MKP-11-AS-2000-PR-PID-005

Counter	Sign	Date
---------	------	------

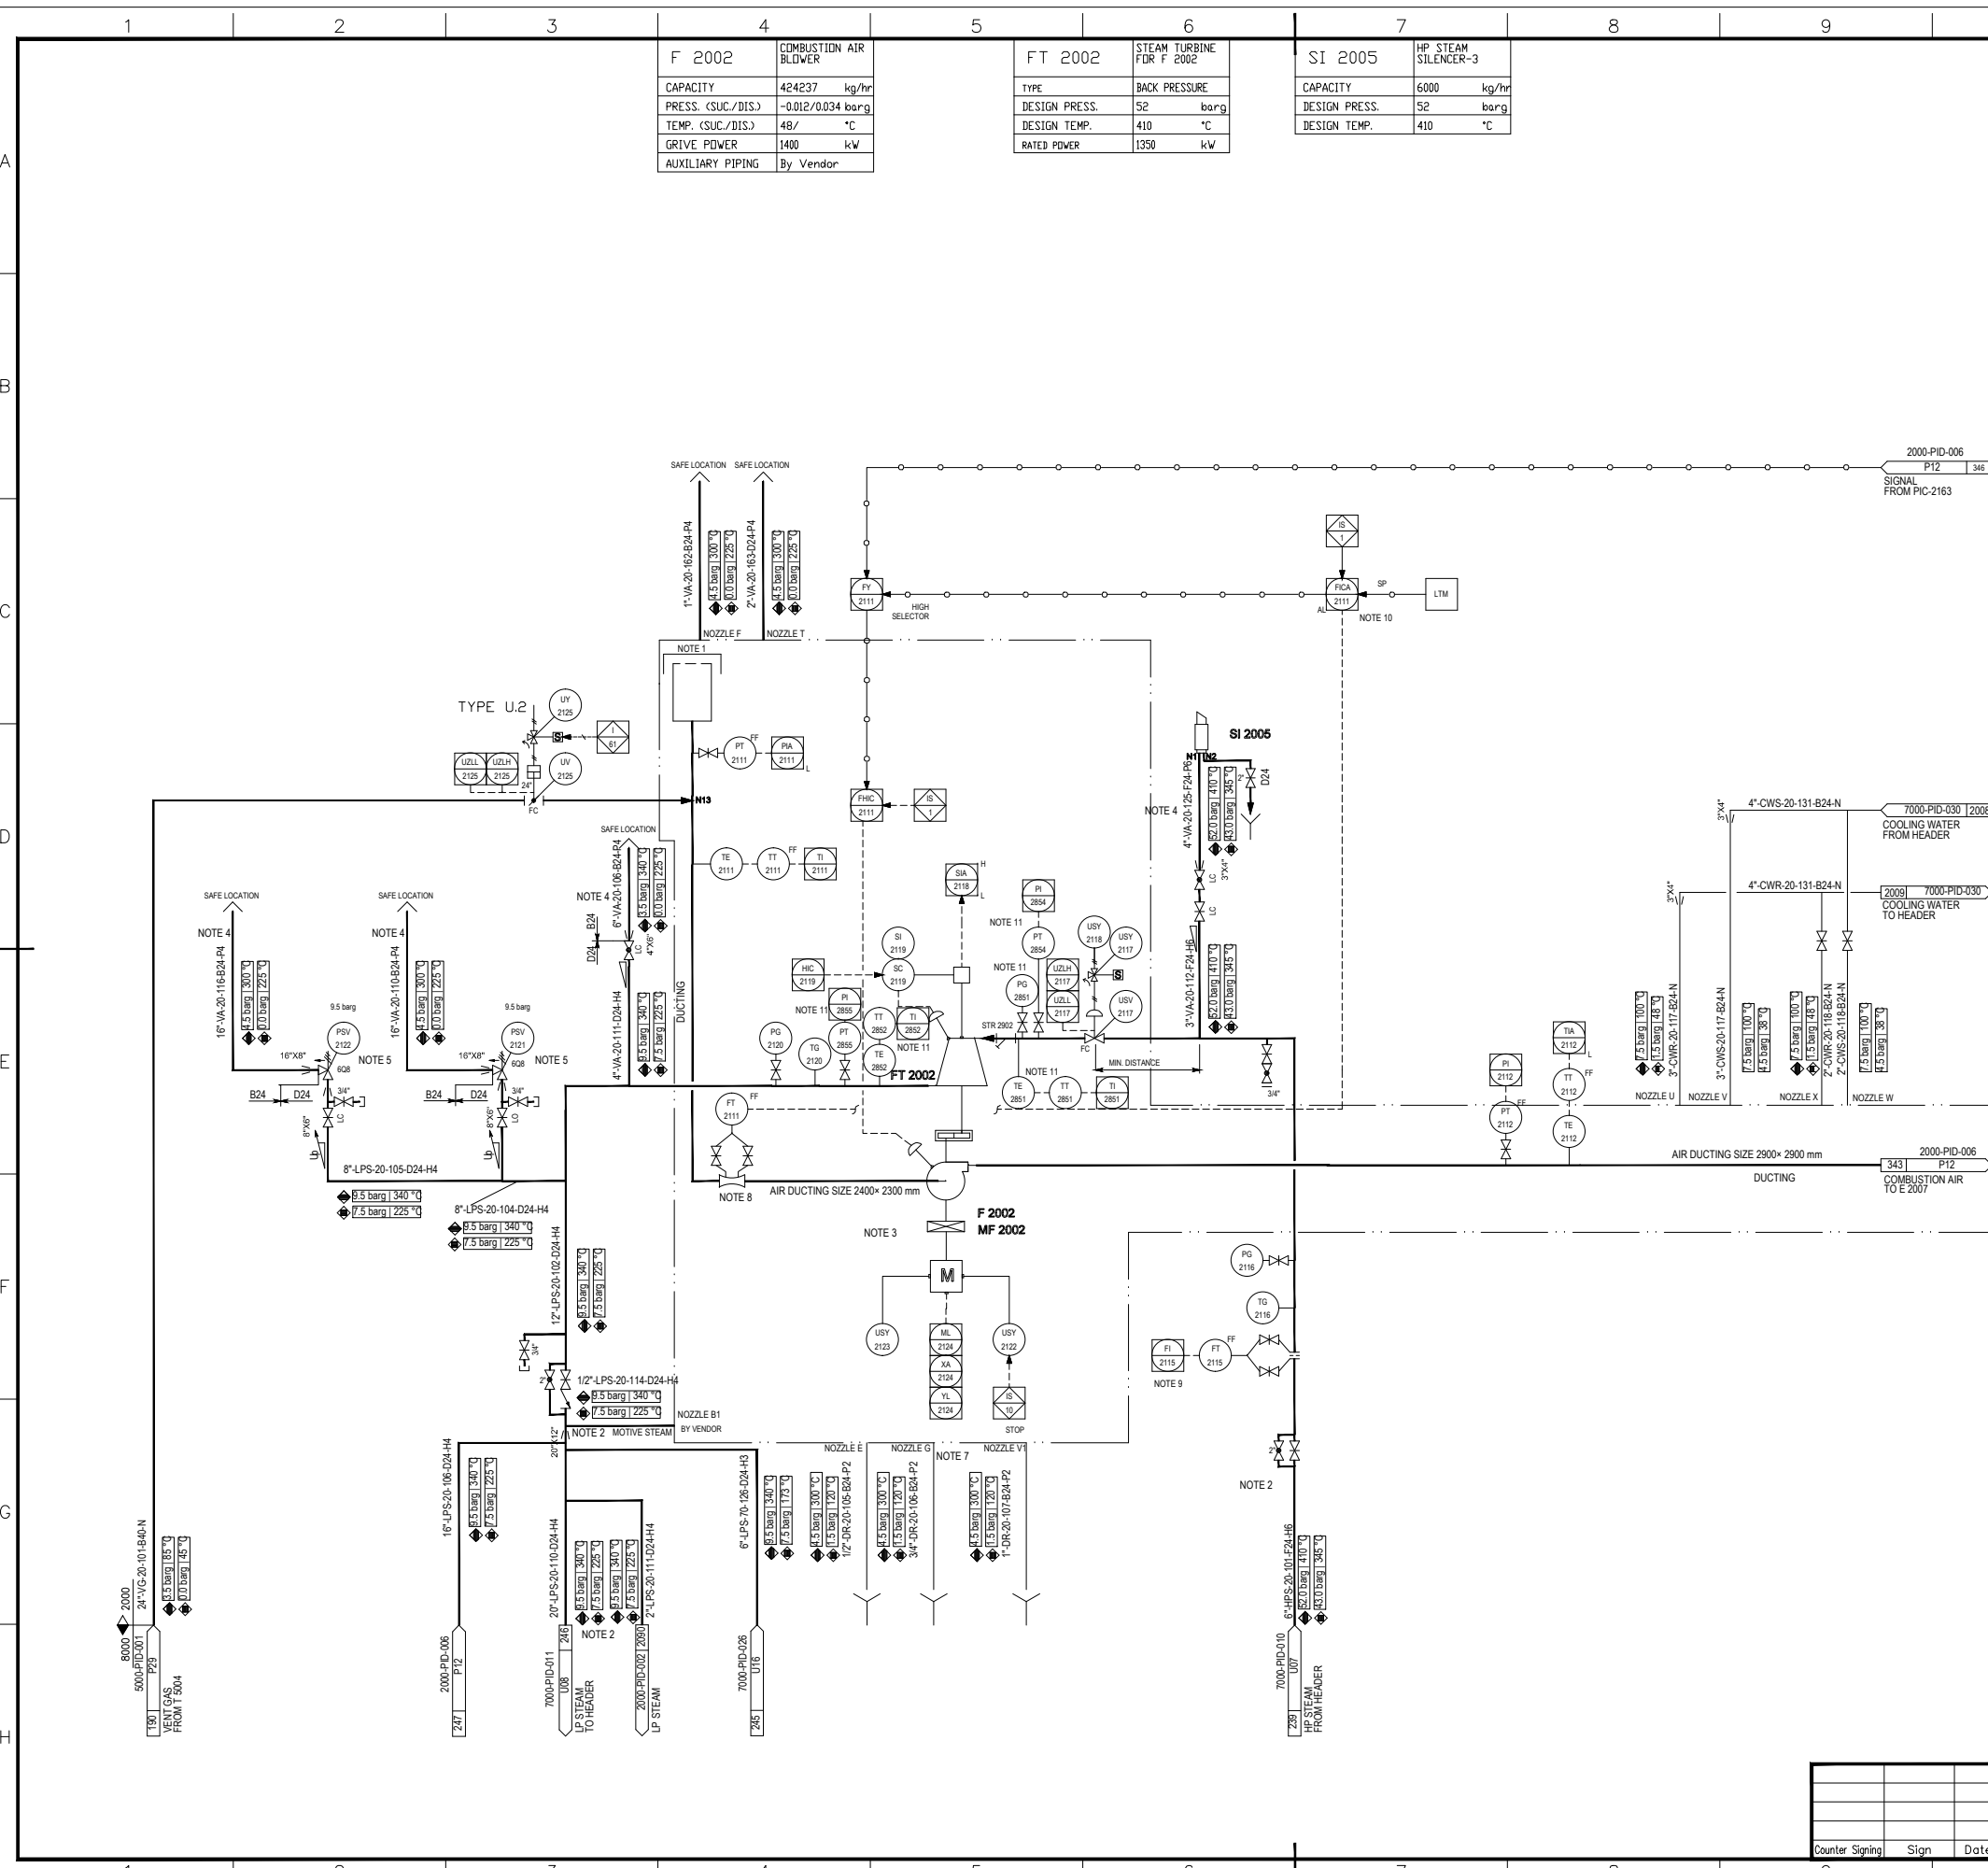



1	2	3	4	5	6	7	8	9	10	11	12
S 2001	FLUE GAS STACK	F 2001	FLUE GAS BLOWER	FT 2001	STEAM TURBINE FOR F 2001	E 2007	COMBUSTION AIR PREHEATER	E 2006	1st NATURAL GAS FEED PREHEAT COIL	SI 2006	HP STEAM SILENCER-4
CAPACITY	4392510 Nm <sup>3</sup> /h	CAPACITY	469314 kg/hr	TYPE	BACK PRESSURE	DUTY	14.3 MW	DUTY (EOR-rich gas)	17.7 MW	CAPACITY	8000 kg/hr
DESIGN PRESS.	Ambient barg	PRESS. (SUC./DIS.)	-0.05/0 barg	DESIGN PRESS.	52 barg	DESIGN PRESS.(COIL)	BY VENDOR barg	DESIGN PRESS.(COIL)	55 barg	DESIGN PRESS.	52 barg
DESIGN TEMP.	250 °C	TEMP. (SUC./DIS.)	150/ °C	DESIGN TEMP.	410 °C	DESIGN TEMP.(COIL)	210 °C	DESIGN TEMP.(COIL)	350 °C	DESIGN TEMP.	410 °C
		DRIVE POWER	2350 kW	RATED POWER	2500 kW						
		AUXILIARY PIPING	By Vendor								

**GENERAL NOTES**

- NOTES:
- 1) PST-2163 A/B/C TO BE LOCATED AS CLOSE AS POSSIBLE TO H 2001.
  - 2) GUIDE VANES
  - 3) PIPE SIZES FOR STEAM AT FT 2001 BY TURBINE VENDOR.
  - 4) 1/2" DRIP HOLE TO BE DRILLED AT LOW POINT TO SAFE AND SUITABLE LOCATION.
  - 5) VALVE SIZE WILL BE CONFIRMED BY VENDOR.
  - 7) SIZE OF AIR DAMPER IS DETERMINED BY VENDOR
  - 8) AIR DUCTING SIZE WILL BE CONFIRMED BY VENDOR FINALLY
  - 9) THE SUPPLY SCOPE OF PRIMARY REFORMER VENDOR.
  - INSTRUMENTS ARE OUT OF VENDOR SUPPLY SCOPE IF NO SPECIAL INSTRUCTIONS
  - 10) THE PIPE AND VALVE FOR AP-2160 IS SUPPLIED BY PRIMARY REFORMER VENDOR
  - 11) P&T COMPENSATION FROM PI-2150, TI-2150
  - 12) P&T COMPENSATION FROM PIC-1006, TI-2151
  - 13) P&T COMPENSATION FROM PIC-7003, TI-7007
  - 14) THE TEMPERATURE INDICATOR/GAUGE(TT-2801/2802) AND THE PRESSURE INDICATOR/GAUGE (PT-2804/PT-2805/PI-2801) ARE SUPPLIED BY FT2001 VENDOR.
  - PLEASE FIND VENDOR DOCUMENT FOR DETAILS.
- GENERAL NOTE:  
LOW POINT DRAINS AND HIGH POINT VENT MUST BE ADDED DURING DETAILED ENGINEERING.

**REFERENCE DRAWINGS**

**SYMBOLS AND LEGENDS**


**KEY PLAN**

REV.	PURPOSE OF ISSUE	DATE	DESIGN	DRAW	CHECK	REVIEW	APPROVE
▲	As Built	30.04.2020	Wang Furui			Gao Zhihui	Liu Shengkol
▲	Approval for Construction	30.12.2019	Wang Furui			Gao Zhihui	Liu Shengkol
▲	Approval for Construction	06.11.2017	Wang Furui			Gao Zhihui	Liu Shengkol
▲	Approval for Construction	05.05.2017	Wang Furui			Gao Zhihui	Liu Shengkol
▲	Approval for Construction	22.03.2017	Wang Furui			Gao Zhihui	Liu Shengkol
▲	Approval for Construction	23.01.2017	Wang Furui			Gao Zhihui	Liu Shengkol
▲	Approval for Construction	28.12.2016	Wang Furui			Gao Zhihui	Liu Shengkol
▲	Approval for Construction	10.11.2016	Wang Furui			Gao Zhihui	Liu Shengkol
▲	Approval for Construction	12.10.2016	Wang Furui			Gao Zhihui	Liu Shengkol
▲	Approval for Construction	31.08.2016	Wang Furui			Gao Zhihui	Liu Shengkol
▲	Approval for Construction	16.06.2016	Wang Furui			Gao Zhihui	Liu Shengkol
▲	Issued for Comments	29.04.2016	Wang Furui			Gao Zhihui	Liu Shengkol


OWNER: Middle East Kimiaye Pars Company

DESIGNER	HALDOR TOPSØE A/S	DOCUMENT NAME	FLUE GAS WHS II PIPING AND INSTRUMENT DIAGRAM	PROJ NO	S-02115	CONV	42	REV.	4
DRAWN		DATE	13/4/22	SCALE	P12				
CONTRACTOR	TCC 中国天辰工程有限公司	CONTRACTOR DRAWING NO.	MKP-11-AS-2000-PS07-PID-006	SHEET	01	TOTAL	01		
CONTRIBUTOR		SUB-CONTRACTOR DRAWING NO.		SHEET		TOTAL			

PROJECT	MKP Methanol Project
UNIT	Reformer
PHASE	As Built Drawing
OWNER DWG NO.	MKP-11-AS-2000-PR-PID-006

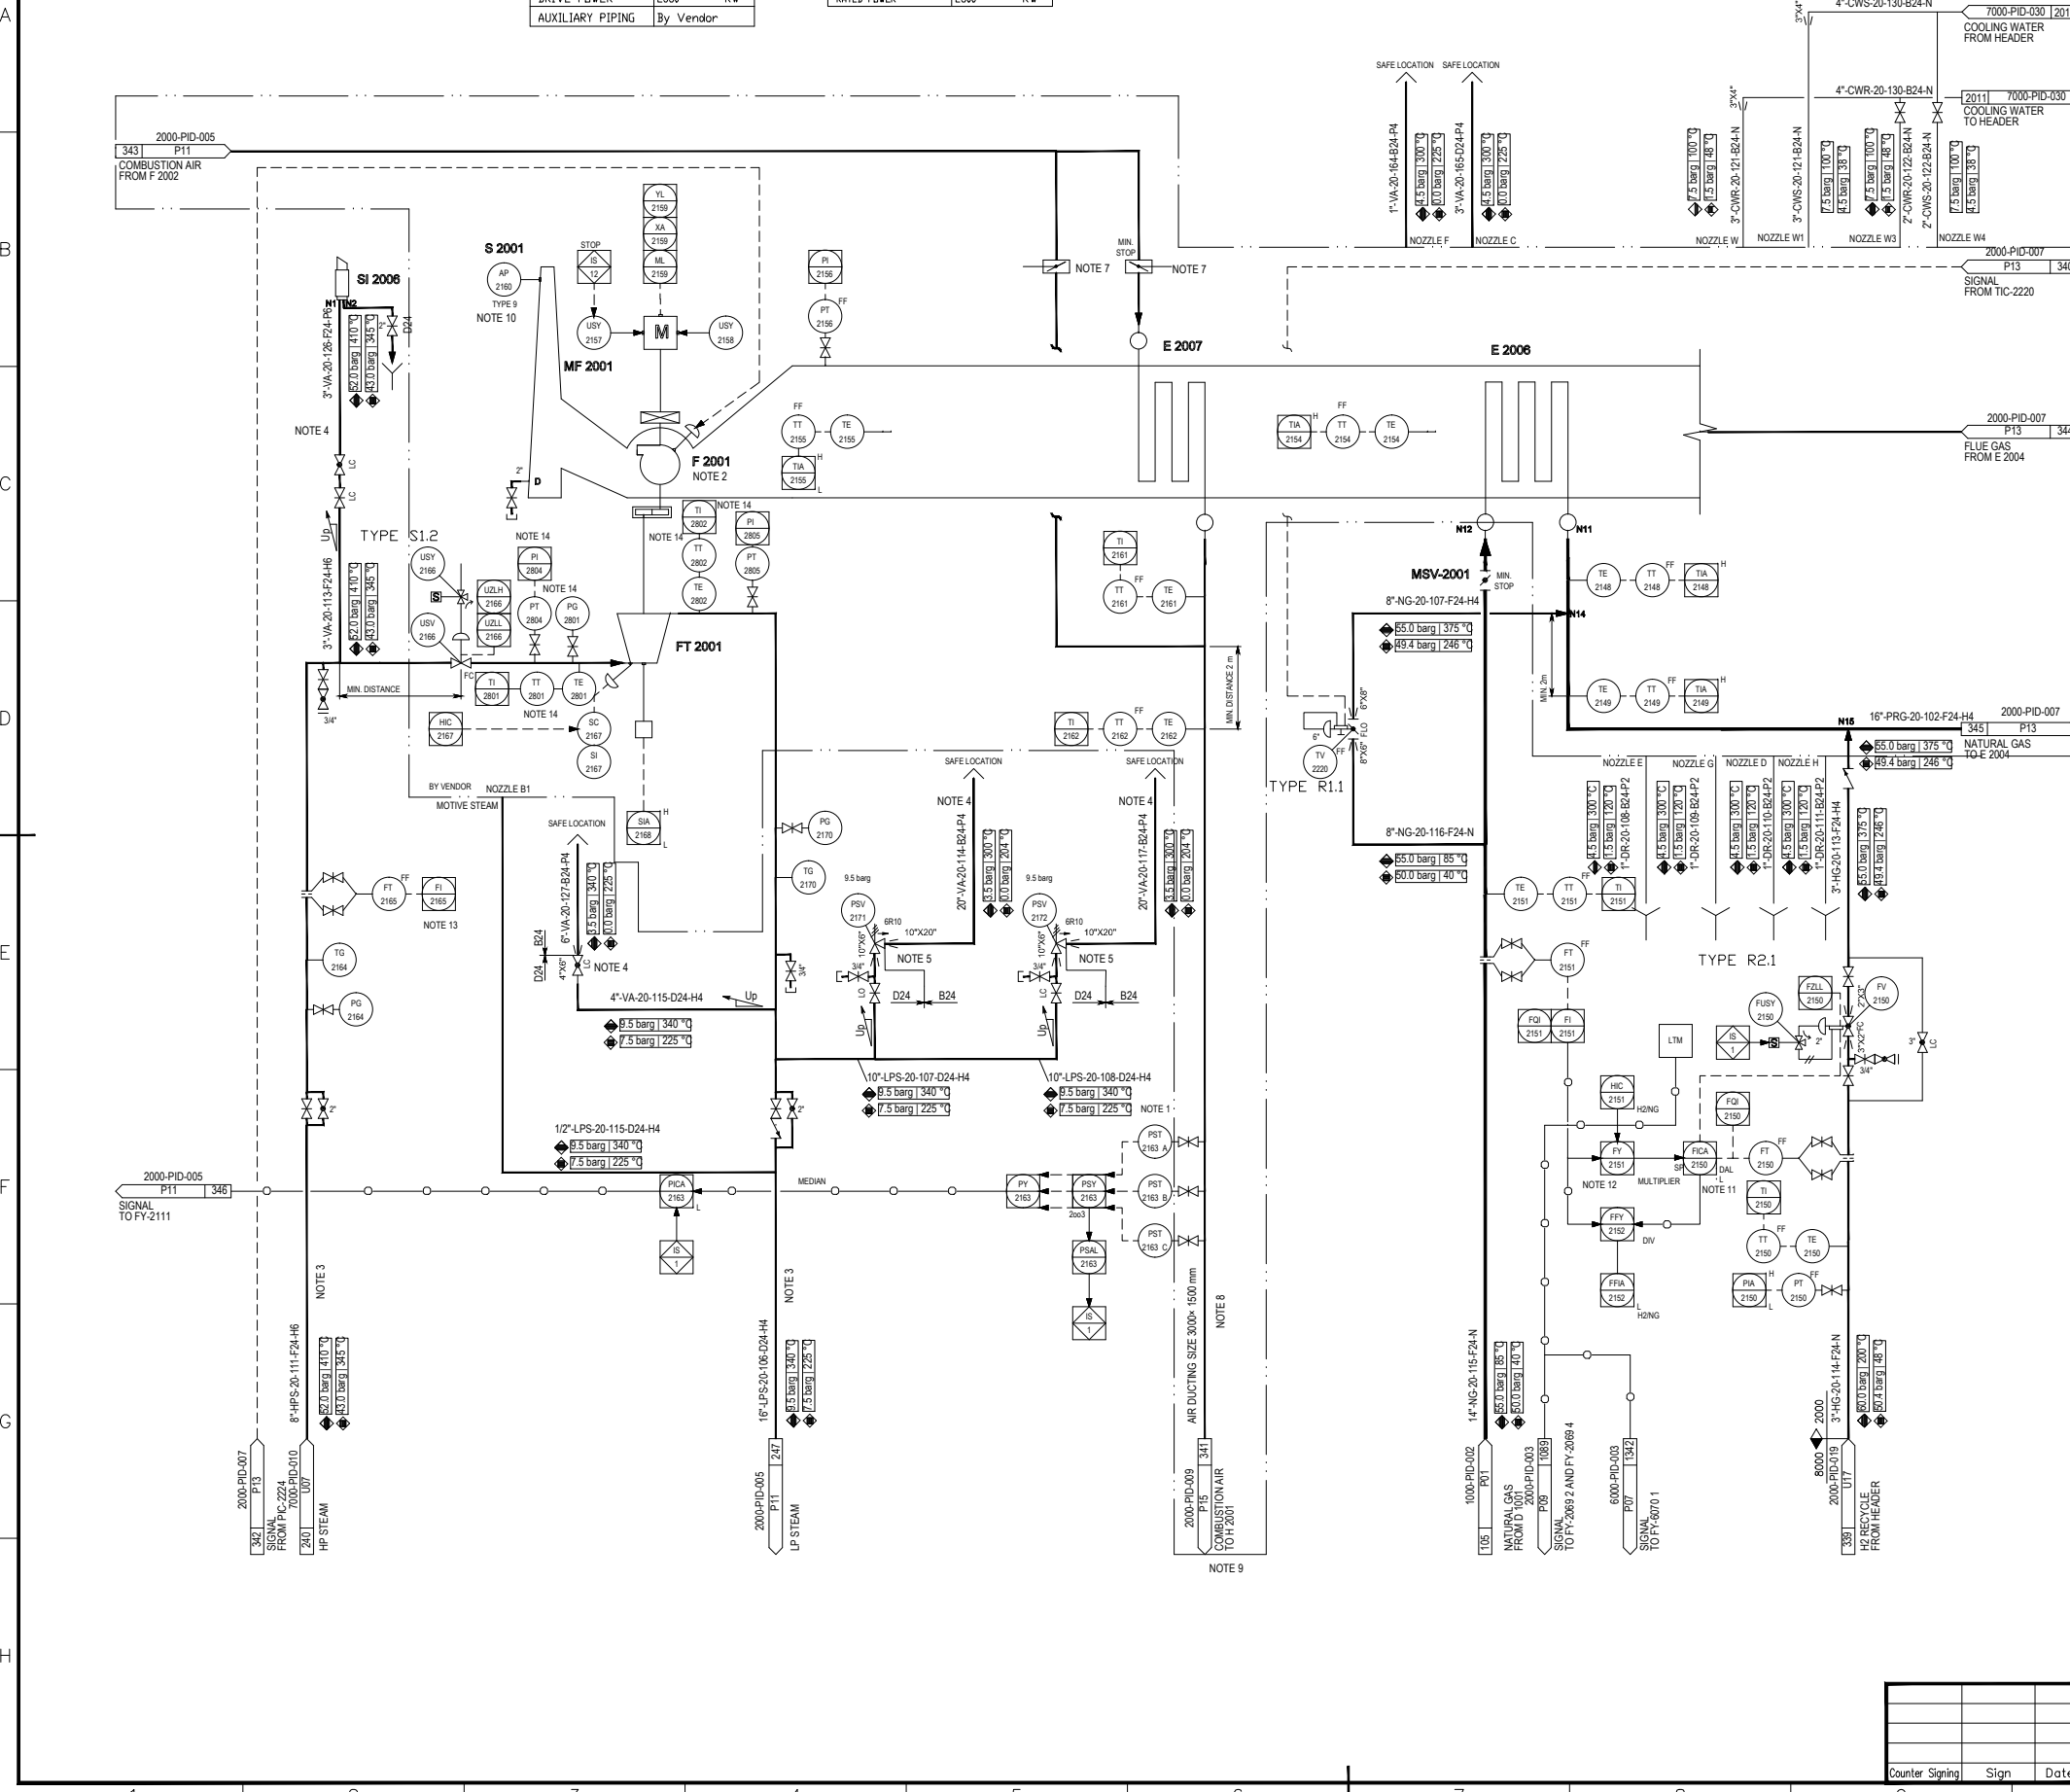

Counter	Sign	Date
---------	------	------

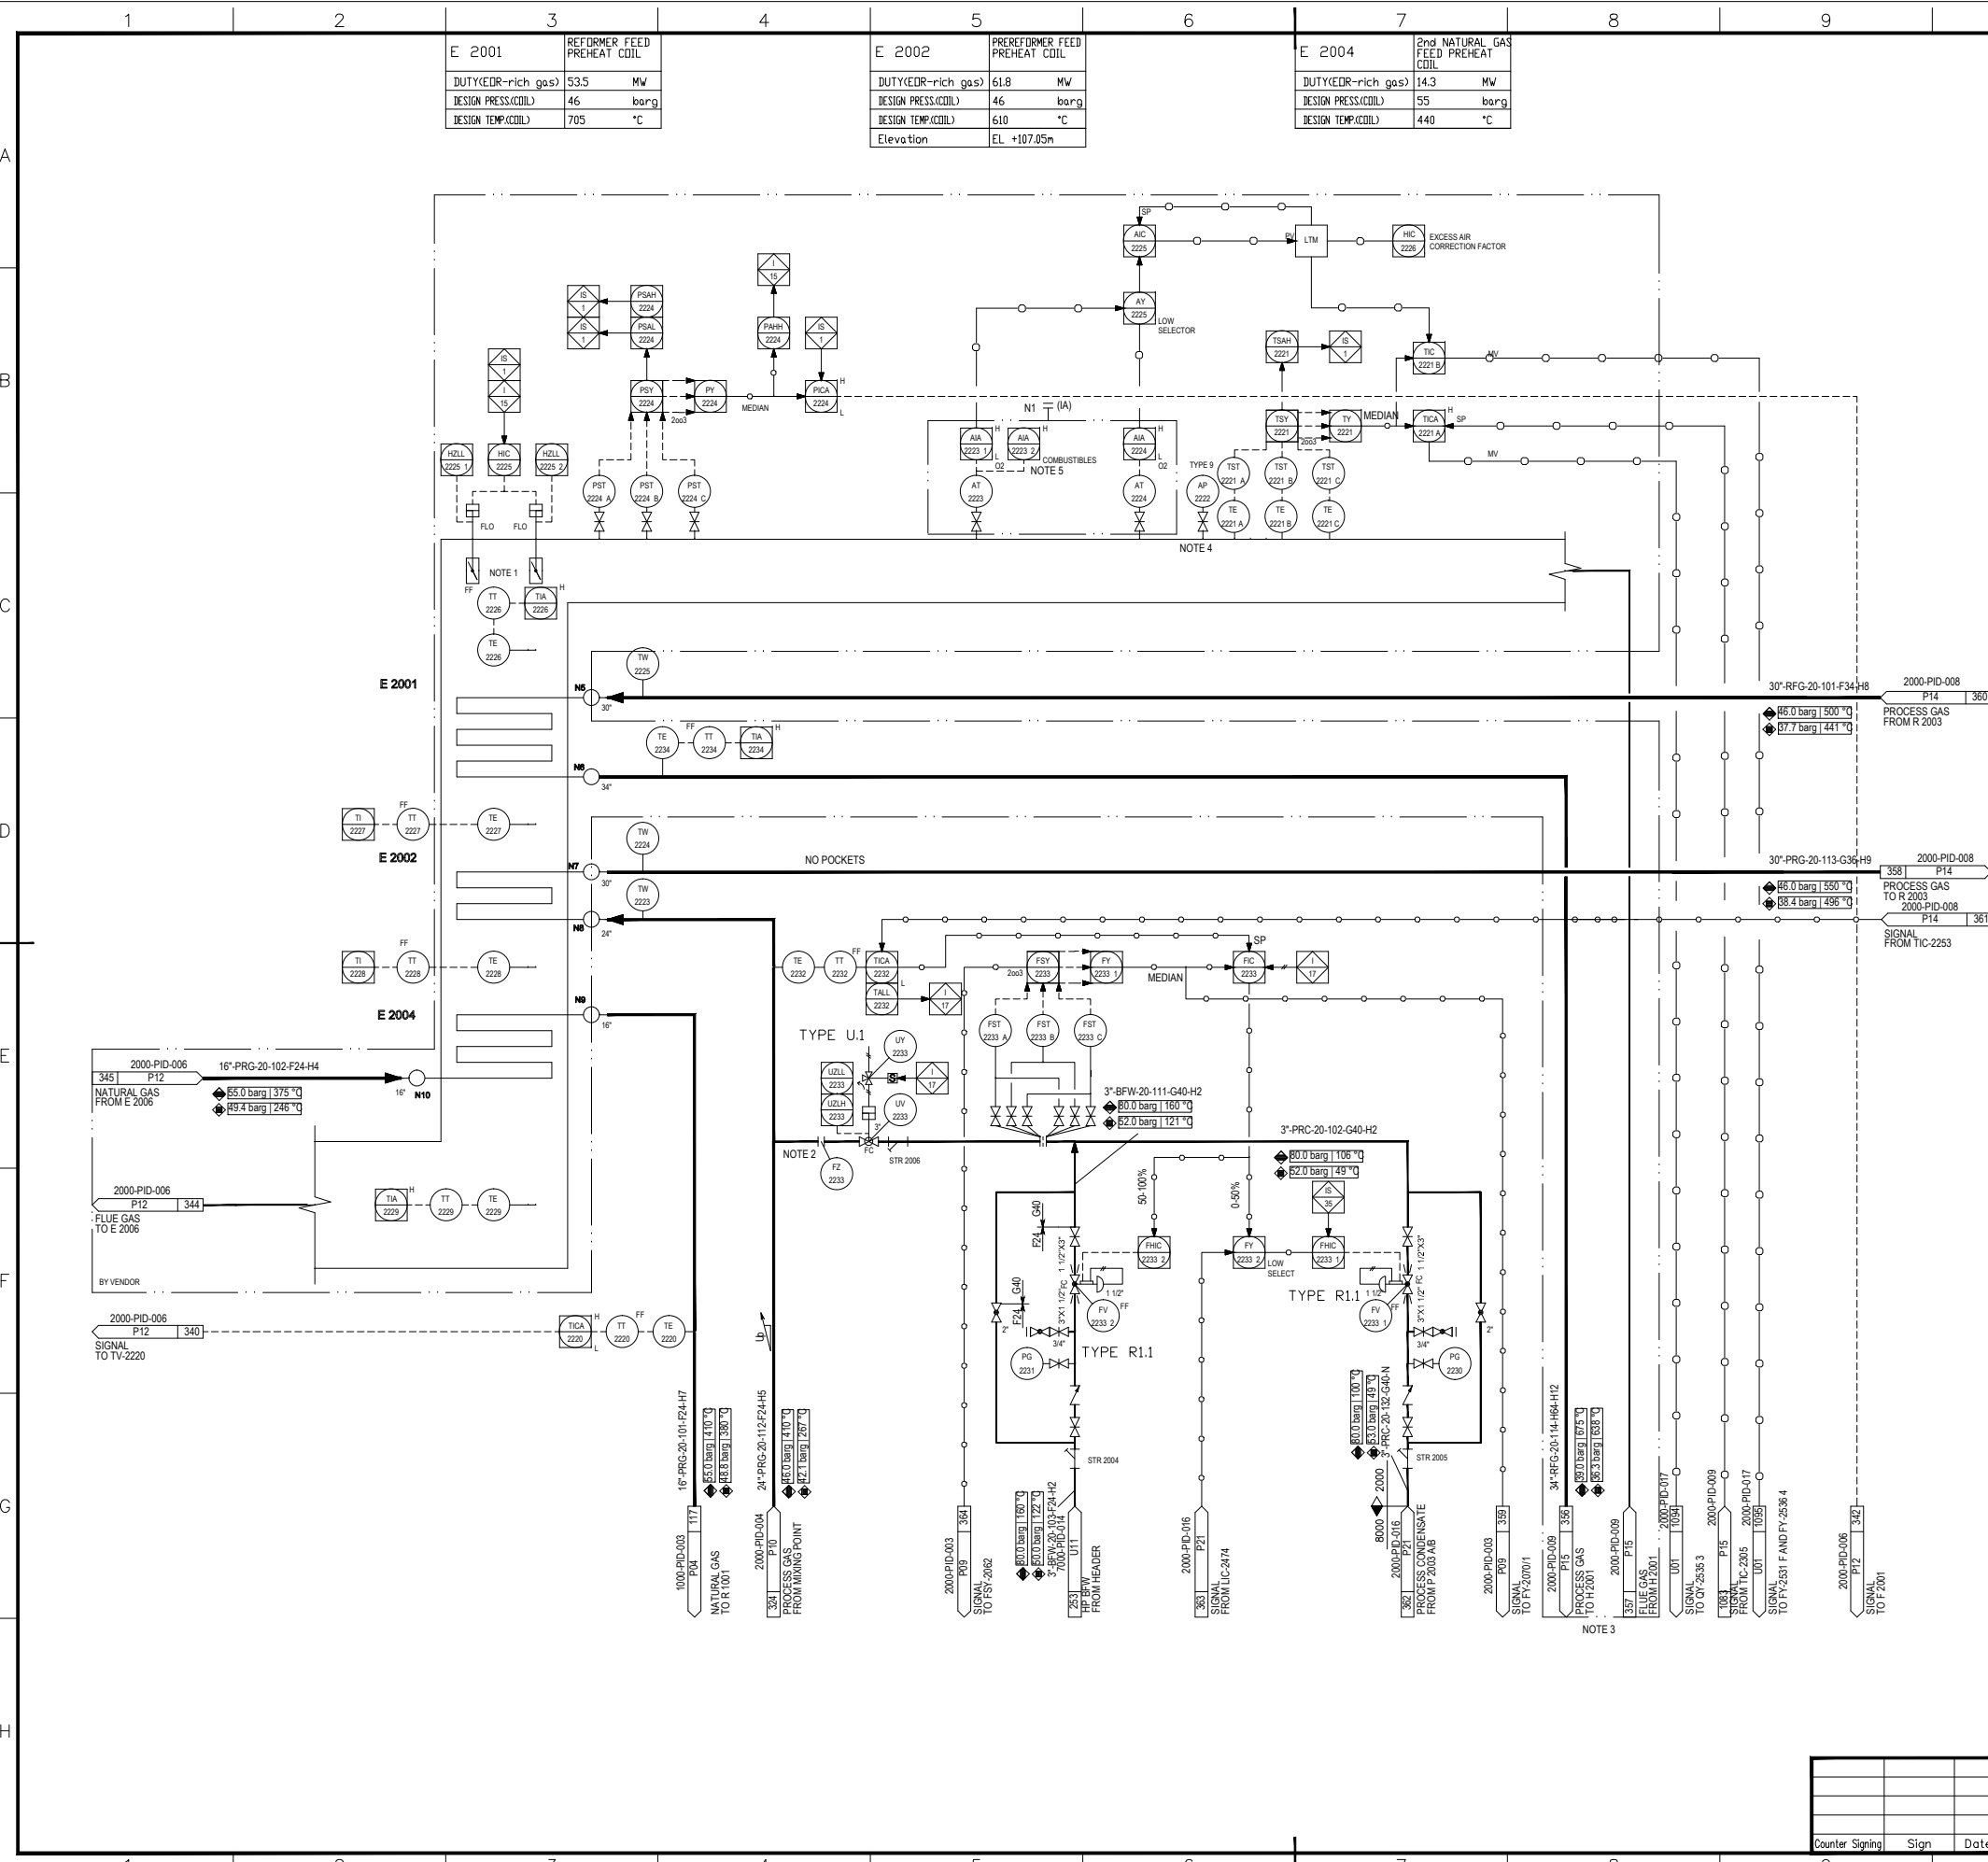

Equipment	Process	Duty	Design Press.	Design Temp.	Elevation
E 2001	REFORMER FEED PREHEAT COIL	DUTY (DR-rich gas) 53.5 MW	46 barg	705 °C	
E 2002	PRE-REFORMER FEED PREHEAT COIL	DUTY (DR-rich gas) 61.8 MW	46 barg	610 °C	EL. +107.05m
E 2004	2nd NATURAL GAS FEED PREHEAT COIL	DUTY (DR-rich gas) 14.3 MW	55 barg	440 °C	

**GENERAL NOTES**

NOTES:

- 1) FALSE AIR DAMPER.
- 2) SPRAY NOZZLES TO BE INSTALLED ACCORDING TO VENDOR INSTRUCTIONS.
- 3) THE SUPPLY SCOPE OF PRIMARY REFORMER VENDOR INSTRUMENTS ARE OUT OF VENDOR SUPPLY SCOPE IF NO SPECIAL INSTRUCTIONS.
- 4) THE PIPE AND VALVE FOR AP-2222 IS SUPPLIED BY PRIMARY REFORMER VENDOR.
- 5) WHEN THERE IS NO INSTRUMENT AIR SUPPLY FOR THE ANALYZER AT-2223, THE LAST EFFECTIVE DATA SHALL BE RECORDED IN FCS.

GENERAL NOTE:  
LOW POINT DRAINS AND HIGH POINT VENTS MUST BE ADDED DURING DETAILED ENGINEERING.

**REFERENCE DRAWINGS**

Ref. No.	Description
2000-PID-008	P14 PROCESS GAS FROM R 2003
2000-PID-008	358 P14 PROCESS GAS TO R 2003
2000-PID-008	361 P14 SIGNAL FROM TIC-2253

**SYMBOLS AND LEGENDS**

**KEY PLAN**

REV.	PURPOSE OF ISSUE	DATE	DESIGN	DRAW	CHECK	REVIEW	APPROVE
▲	As Built	30.04.2020	Wang Furu		Gao Zhihu	Liu Shengkol	
▲	Approval for Construction	30.12.2019	Wang Furu		Gao Zhihu	Liu Shengkol	
▲	Approval for Construction	06.11.2017	Wang Furu		Gao Zhihu	Liu Shengkol	
▲	Approval for Construction	05.05.2017	Wang Furu		Gao Zhihu	Liu Shengkol	
▲	Approval for Construction	22.03.2017	Wang Furu		Gao Zhihu	Liu Shengkol	
▲	Approval for Construction	23.01.2017	Wang Furu		Gao Zhihu	Liu Shengkol	
▲	Approval for Construction	10.11.2016	Wang Furu		Gao Zhihu	Liu Shengkol	
▲	Approval for Construction	12.10.2016	Wang Furu		Gao Zhihu	Liu Shengkol	
▲	Approval for Construction	31.08.2016	Wang Furu		Gao Zhihu	Liu Shengkol	
▲	Approval for Construction	16.06.2016	Wang Furu		Gao Zhihu	Liu Shengkol	
▲	Issued for Comments	29.04.2016	Wang Furu		Gao Zhihu	Liu Shengkol	

OWNER: Middle East Kimiaye Pars Company

DESIGNER	HALDOR TOPSØE A/S	DOCUMENT NAME	FLUE GAS WHS III PIPING AND INSTRUMENT DIAGRAM	PROJ NO	S-02115	CONTRACTOR DRAWING NO.	1341723
DRAWN		DATE		CONTRACTOR		MKP-11-AS-2000-PS07-PID-007	
CHECKED		SCALE		CONTRACTOR		SHEET 01	TOTAL 01
APPROVED		TITLE		CONTRACTOR		SUB-CONTRACTOR DRAWING NO.	
				CONTRACTOR		SHEET --	TOTAL --

PROJECT	MKP Methanol Project
UNIT	Reformer
PHASE	As Built Drawing
OWNER DWG NO.	MKP-11-AS-2000-PR-PID-007

Counter Signing Sign Date

R 2003	PREREFORMER
ID x LENGTH	3900 x 2600mm
DESIGN PRESS.	46 barg
DESIGN TEMP.	550 °C
Insulation	YES
CLADDING/LINING	NONE

**GENERAL NOTES**

\*NOTES:  
1) ISOLATE PREREFORMER DURING OPENING OF DOWNSTREAM SYSTEM TO PREVENT AIR INGRESS TO CATALYST.

\*GENERAL NOTE:  
LOW POINT DRAINS AND HIGH POINT VENT MUST BE ADDED DURING DETAILED ENGINEERING.

**REFERENCE DRAWINGS**

**SYMBOLS AND LEGENDS**

**KEY PLAN**


▲	As Built	30.04.2020	Wang Furu	Gao Zhihu	Liu Shengkol
▲	Approval for Construction	02.02.2018	Wang Furu	Gao Zhihu	Liu Shengkol
▲	Approval for Construction	06.11.2017	Wang Furu	Gao Zhihu	Liu Shengkol
▲	Approval for Construction	05.05.2017	Wang Furu	Gao Zhihu	Liu Shengkol
▲	Approval for Construction	22.03.2017	Wang Furu	Gao Zhihu	Liu Shengkol
▲	Approval for Construction	10.11.2016	Wang Furu	Gao Zhihu	Liu Shengkol
▲	Approval for Construction	12.10.2016	Wang Furu	Gao Zhihu	Liu Shengkol
▲	Approval for Construction	31.08.2016	Wang Furu	Gao Zhihu	Liu Shengkol
▲	Approval for Construction	16.06.2016	Wang Furu	Gao Zhihu	Liu Shengkol
▲	Issued for Comments	29.04.2016	Wang Furu	Gao Zhihu	Liu Shengkol

REVISION: THIS DOCUMENT IS THE PROPERTY OF TCC. NO PART OF THIS DOCUMENT SHALL BE REPRODUCED OR DISCLOSED TO OTHERS OR USED FOR ANY PURPOSE WHATSOEVER EXCEPT WITH THE PRIOR WRITTEN PERMISSION OF TCC.

OWNER:  Middle East Kimiaye Pars Company

DESIGNER	HALDOR TOPSØE A/S	DOCUMENT NAME	PREREFORMING PIPING AND INSTRUMENT DIAGRAM	JOB NO.	S-02115	CONTRACT NO.	42	REV.	3
DRAWN		DATE		1341724		ISSUED	P14		
CONTRACTOR	TCC 中国天辰工程有限公司 CHINA TIANCHEN ENGINEERING CORPORATION								
CONTRACTOR DRAWING NO.	MKP-11-AS-2000-PS07-PID-008								
SHEET	01	TOTAL	01						
SUB-CONTRACTOR DRAWING NO.									
SHEET	-	TOTAL	-						

PROJECT	MKP Methanol Project		
UNIT	Reformer		
PHASE	As Built Drawing		
OWNER DWG NO.	MKP-11-AS-2000-PR-PID-008		

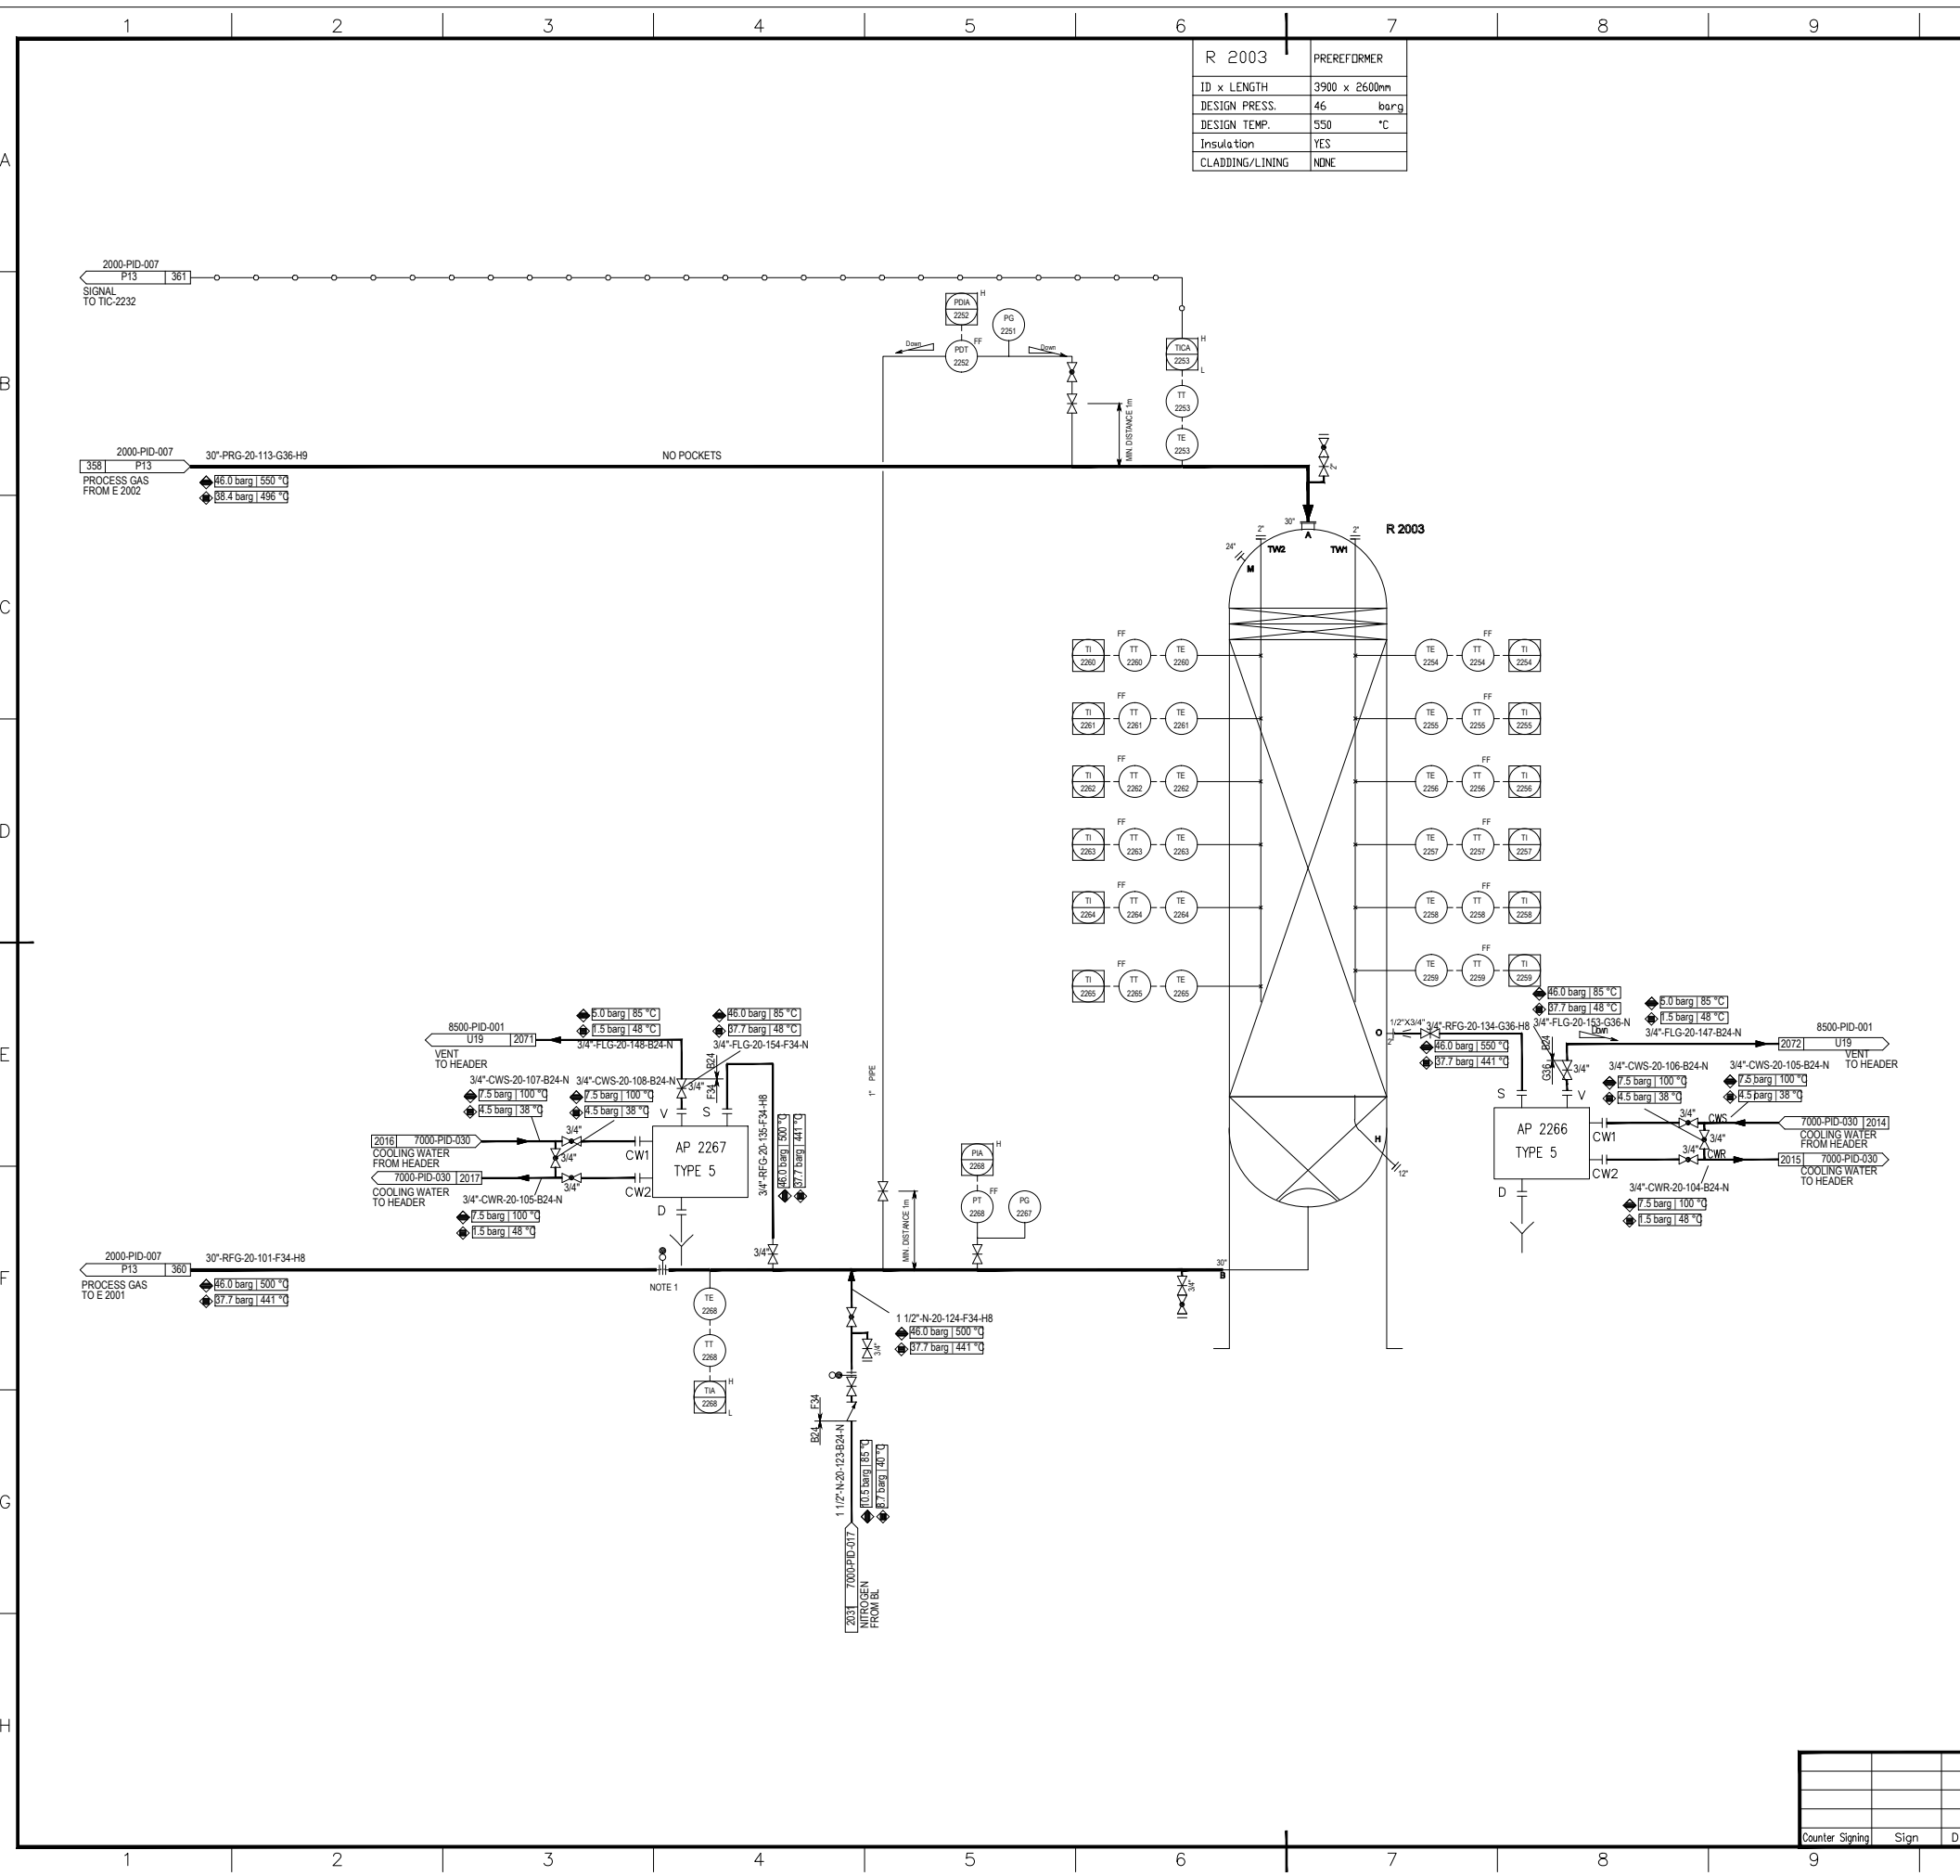

Counter	Sign	Date

H 2001	PRIMARY REFORMER
CAPACITY	154.1 Mw
DESIGN PRESS.(CDIL)	39 barg
DESIGN TEMP.(CDIL)	850 °C

**GENERAL NOTES**

- \*NOTES:
- HIGH PRESSURE IN REFORMER FURNACE BOX ACTIVATES HAZARD FLASHERS, THREE FLASHERS ARE LOCATED AT EACH END OF THE REFORMER AND ON EACH FLOOR.
  - FUEL PIPING TO BE SYMMETRICAL.
  - FUEL PIPING AND AIR DUCTING TO BE SUPPLIED WITH FLANGES AT THE END OF SUBHEATERS. IF WELDED CAPS ARE SUPPLIED THESE MUST BE REMOVED FOR PIPE BLOWING.
  - END CAP FOR DISTRIBUTOR TO BE FIELD WELDED AFTER PIPE BLOWING.
  - MIN 4 m INCOLOY 600 PIPE OF 1".
  - COLD COLLECTOR IS REFRACTORY LINE THE OPERATING-DESIGN PRESSURE IS 32.0/34.7 BARG. THE OPERATING TEMPERATURE FOR PROCESS GAS IS 742. THE OPERATING-DESIGN TEMPERATURE FOR SHELL AFTER LINING IS 150/400.
  - THE LINE IS IN THE SUPPLY SCOPE OF AP-2306 VENDOR.
  - NEW STANDARD IS THREE THERMOWELLS ONE FOR EACH THERMOCOUPLE. (THREE INDIVIDUAL THERMOELEMENTS IN THE SAME THERMOWELL IS ACCEPTABLE IF ALREADY IMPLEMENTED)
  - AIR DUCTING SIZE WILL BE CONFIRMED BY VENDOR FINALLY.
  - THE SUPPLY SCOPE OF PRIMARY REFORMER VENDOR INSTRUMENTS ARE OUT OF VENDOR SUPPLY SCOPE IF NO SPECIAL INSTRUCTIONS.
  - THE PIPE AND VALVE FOR PT-2282/2307/PG-2283/PDT-2283 ARE SUPPLIED BY PRIMARY REFORMER VENDOR.
  - THE PIPE AND VALVE FOR AP-2294/2296 IS SUPPLIED BY PRIMARY REFORMER VENDOR.

\*GENERAL NOTE:  
LOW POINT DRAINS AND HIGH POINT VENT MUST BE ADDED DURING DETAILED ENGINEERING.

**REFERENCE DRAWINGS**

**SYMBOLS AND LEGENDS**

**KEY PLAN**


REV.	PURPOSE OF ISSUE	DATE	DESIGN	DRAW	CHECK	REVIEW	APPROVE
▲	As Built	30.04.2020	Wang Furui		Gao Zhihu	Liu Shengkai	
▲	Approval for Construction	30.12.2019	Wang Furui		Gao Zhihu	Liu Shengkai	
▲	Approval for Construction	02.02.2018	Wang Furui		Gao Zhihu	Liu Shengkai	
▲	Approval for Construction	06.11.2017	Wang Furui		Gao Zhihu	Liu Shengkai	
▲	Approval for Construction	05.05.2017	Wang Furui		Gao Zhihu	Liu Shengkai	
▲	Approval for Construction	22.03.2017	Wang Furui		Gao Zhihu	Liu Shengkai	
▲	Approval for Construction	23.01.2017	Wang Furui		Gao Zhihu	Liu Shengkai	
▲	Approval for Construction	10.11.2016	Wang Furui		Gao Zhihu	Liu Shengkai	
▲	Approval for Construction	12.10.2016	Wang Furui		Gao Zhihu	Liu Shengkai	
▲	Approval for Construction	31.08.2016	Wang Furui		Gao Zhihu	Liu Shengkai	
▲	Approval for Construction	16.06.2016	Wang Furui		Gao Zhihu	Liu Shengkai	
▲	Issued for Comments	29.04.2016	Wang Furui		Gao Zhihu	Liu Shengkai	

THIS DOCUMENT IS THE PROPERTY OF TCC. NO PART OF THIS DOCUMENT SHALL BE REPRODUCED OR DISCLOSED TO OTHERS OR USED FOR ANY PURPOSE WHATSOEVER EXCEPT WITH THE PRIOR WRITTEN PERMISSION OF TCC.

OWNER: **Middle East Kimiaye Pars Company**

DESIGNER	HALDOR TOPSØE A/S	DOCUMENT NAME	TUBULAR REFORMER PIPING AND INSTRUMENT DIAGRAM	PROJ NO	S-02115	CDR	42	REV.	4
DRAWN		DATE	13/4/2025	SCALE	P15				
CONTRACTOR	<b>TCC 中国天辰工程技术有限公司</b>	CONTRACTOR DRAWING NO. MKP-11-AS-2000-PS07-PID-009							
CONTRACT NO.		SHEET 01 TOTAL 01							
CONTRACTOR		SUB-CONTRACTOR DRAWING NO.							
CONTRACTOR		SHEET -- TOTAL --							

TUBULAR REFORMER PIPING AND INSTRUMENT DIAGRAM		PROJECT	MKP Methanol Project
		UNIT	Reformer
		PHASE	As Built Drawing
SCALE	SHEET:1	TOT:1	SIZE: A1
OWNER DWG NO.	MKP-11-AS-2000-PR-PID-009		

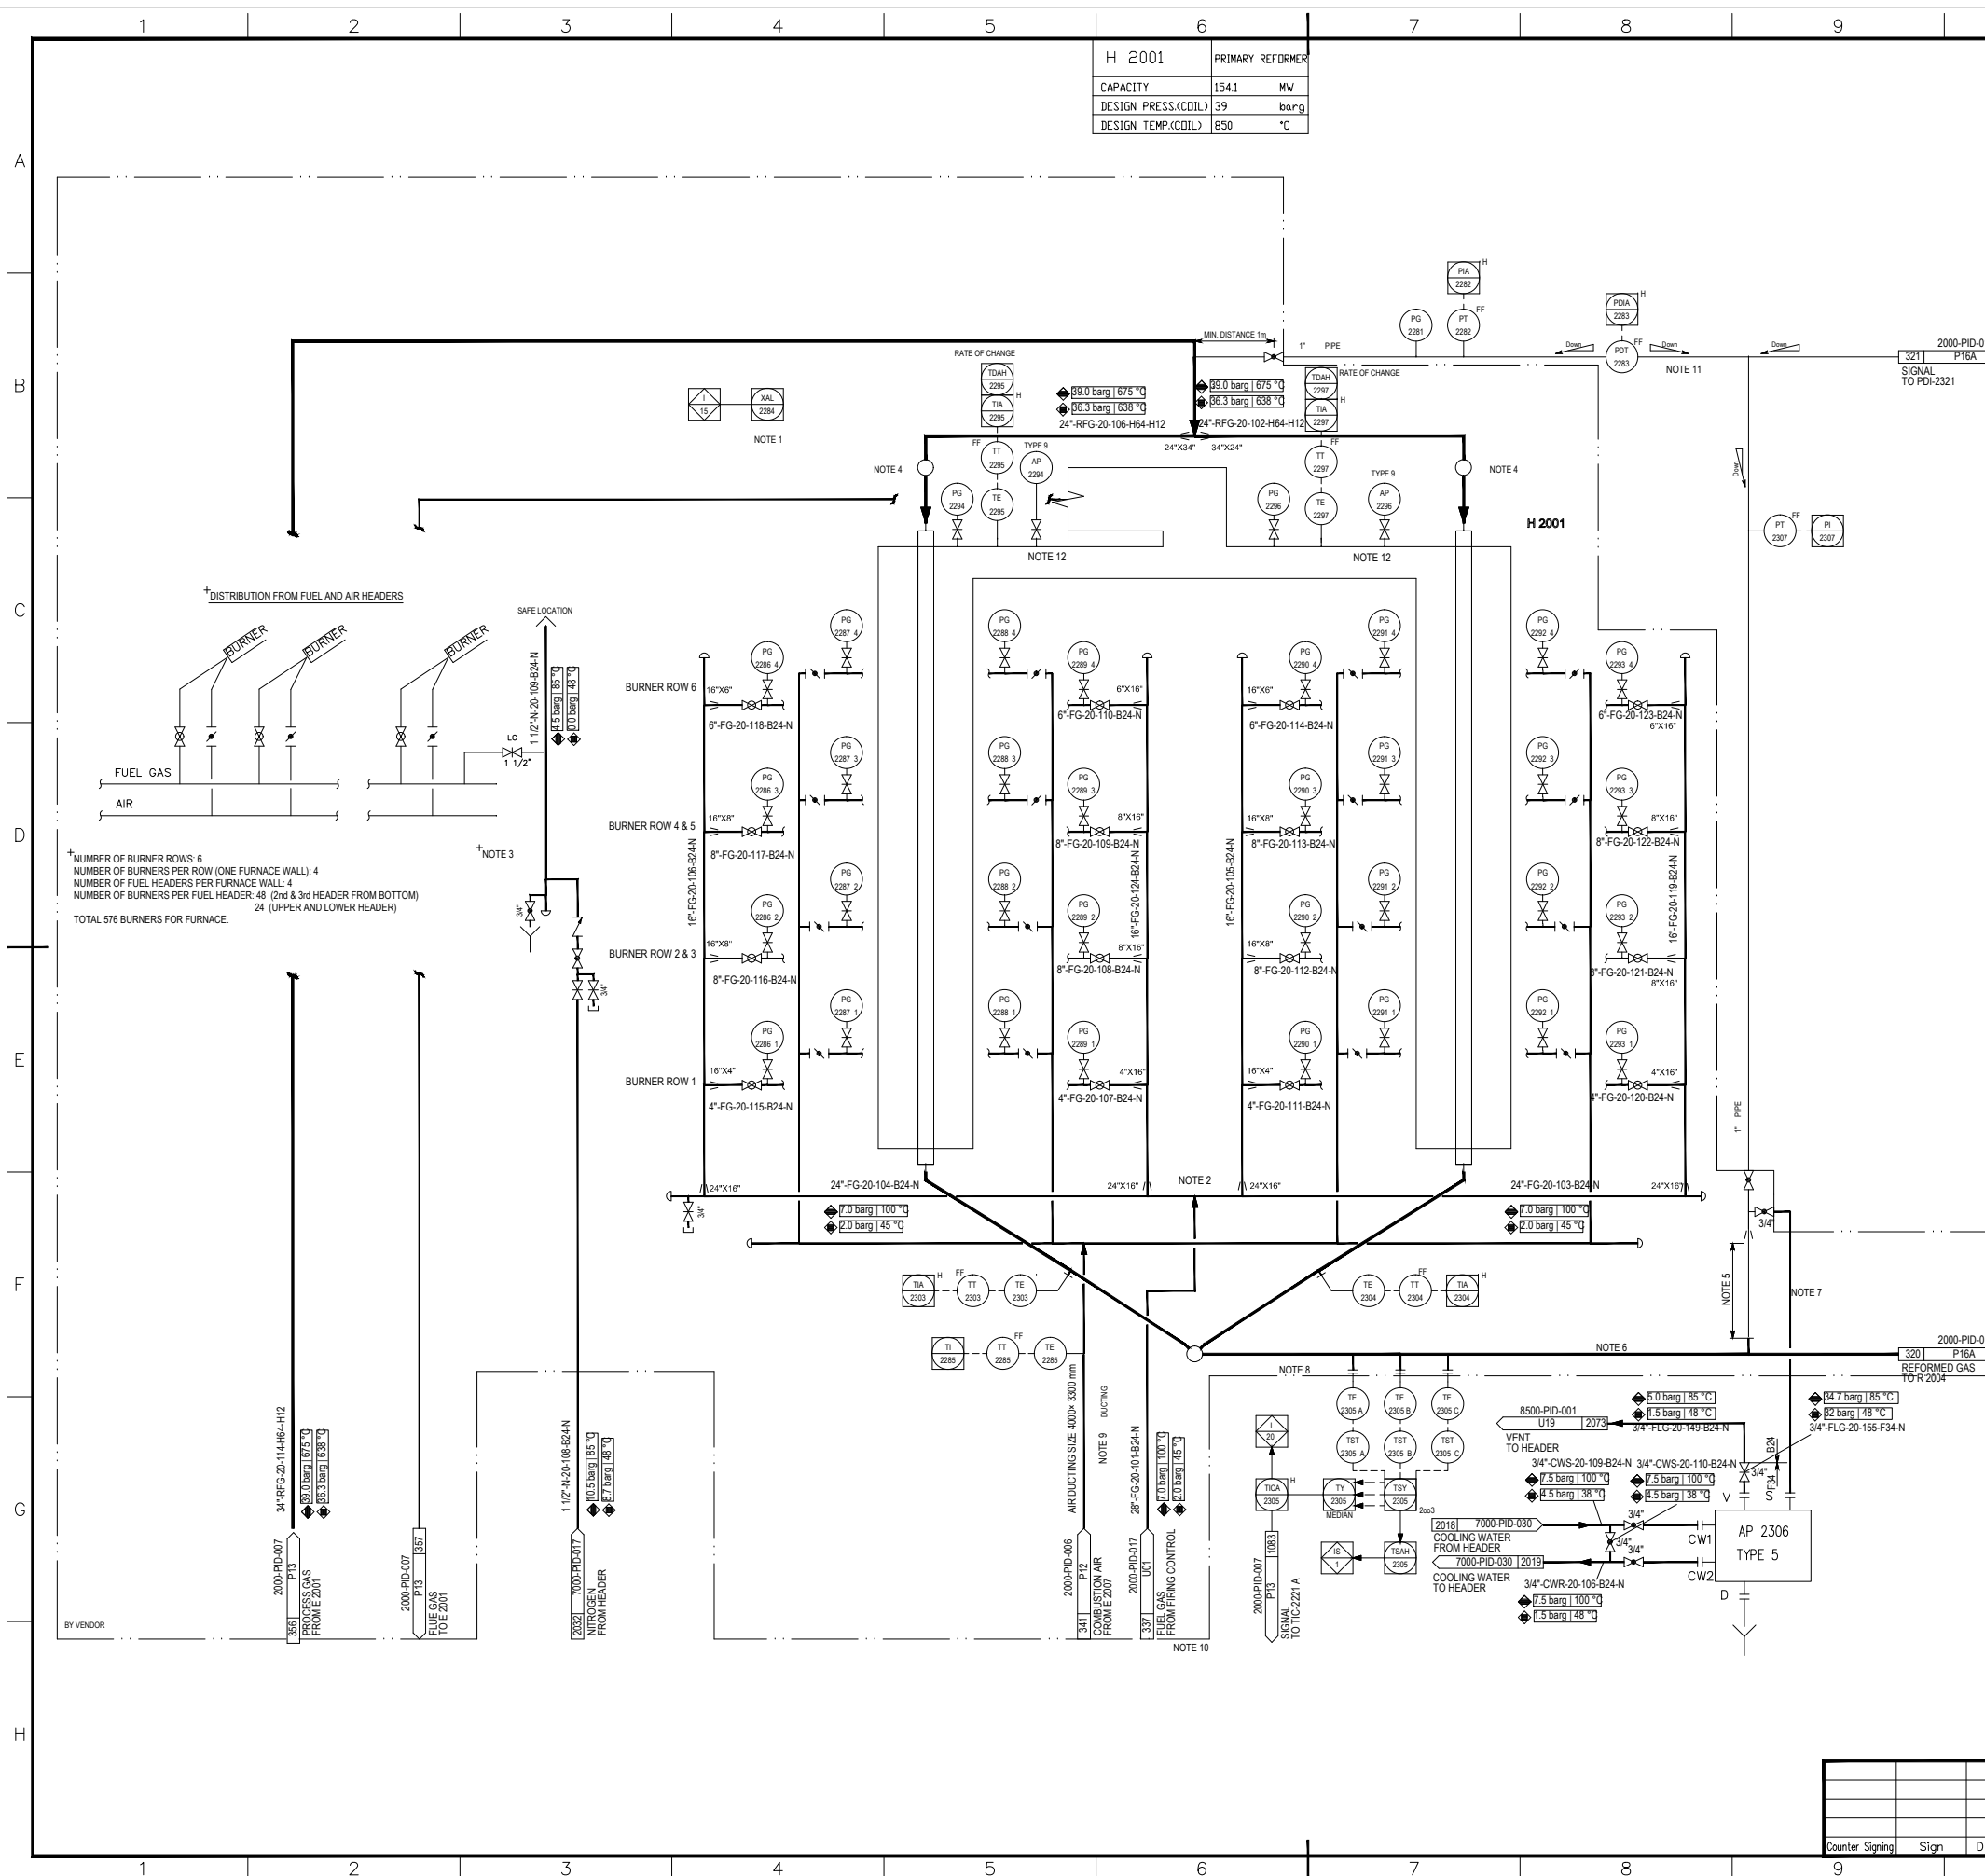

NUMBER OF BURNER ROWS: 6  
NUMBER OF BURNERS PER ROW (ONE FURNACE WALL): 4  
NUMBER OF FUEL HEADERS PER FURNACE WALL: 4  
NUMBER OF BURNERS PER FUEL HEADER: 48 (2nd & 3rd HEADER FROM BOTTOM)  
24 (UPPER AND LOWER HEADER)  
TOTAL 576 BURNERS FOR FURNACE.



R 2004	SECONDARY REFORMER
ID x LENGTH	5400 x 823mm
DESIGN PRESS.	34.7 barg
DESIGN TEMP.	400 °C
Insulation	YES
CLADDING/LINING	LINING

**GENERAL NOTES**

- \*NOTES:
- 1) SHELL TEMPERATURE MONITORING.
  - 2) TRANSMITTERS MUST BE INSTALLED ABOVE R 2004 WITH SLOPE BACK TO THE PROCESS. IMPULSE LINES MUST BE MIN. 1" PIPE.
  - 3) MIN 4 m INCOLOY 600 PIPE OF 1".
  - 4) NITROGEN REQUIRED AT THERMOWELL.
  - 5) WATER SPRAYING FOR SHELL COOLING IN CASE OF HOT SPOT TO OPEN DRAIN.
  - 6) COLD COLLECTOR IS REFRACTORY LINE. THE OPERATING/DESIGN PRESSURE IS 32.0/34.7 BARG. THE OPERATING TEMPERATURE FOR PROCESS GAS IS 742 °C. THE OPERATING/DESIGN TEMPERATURE FOR SHELL AFTER LINING IS 150/400 °C.
  - 7) P1 IS POSITIONED ON MANIFOLD TO E2020 1/2 (P1 IN PROCESS SPECIFICATION)
  - 8) THE SUPPLY SCOPE OF PRIMARY REFORMER VENDOR INSTRUMENTS ARE OUT OF VENDOR SUPPLY SCOPE IF NO SPECIAL INSTRUCTIONS
  - 9) THE PIPE AND VALVE FOR PT-2324/2322/PDT-2323/2321 ARE SUPPLIED BY PRIMARY REFORMER VENDOR
  - 10) MINIMUM DISTANCE TO SPE-0201

\*GENERAL NOTE:  
LOW POINT DRAINS AND HIGH POINT VENT MUST BE ADDED DURING DETAILED ENGINEERING.

**REFERENCE DRAWINGS**

**SYMBOLS AND LEGENDS**

**KEY PLAN**


As Built	30.04.2020	Wang Furu	Gao Zhihu	Liu Shengkai
Approval for Construction	30.12.2019	Wang Furu	Gao Zhihu	Liu Shengkai
Approval for Construction	06.11.2017	Wang Furu	Gao Zhihu	Liu Shengkai
Approval for Construction	22.03.2017	Wang Furu	Gao Zhihu	Liu Shengkai
Approval for Construction	10.11.2016	Wang Furu	Gao Zhihu	Liu Shengkai
Approval for Construction	12.10.2016	Wang Furu	Gao Zhihu	Liu Shengkai
Approval for Construction	31.08.2016	Wang Furu	Gao Zhihu	Liu Shengkai
Approval for Construction	16.06.2016	Wang Furu	Gao Zhihu	Liu Shengkai
Issued for Comments	29.04.2016	Wang Furu	Gao Zhihu	Liu Shengkai

REV. PURPOSE OF ISSUE DATE DESIGN DRAW CHECK REVIEW APPROVE  
THIS DOCUMENT IS THE PROPERTY OF TCC. NO PART OF THIS DOCUMENT SHALL BE REPRODUCED OR DISCLOSED TO OTHERS OR USED FOR ANY PURPOSE WHATSOEVER EXCEPT WITH THE PRIOR WRITTEN PERMISSION OF TCC.

OWNER: Middle East Kimiaye Pars Company

CONTRACTOR	HALDOR TOPSØE A/S	DOCUMENT NAME	SECONDARY REFORMER PIPING AND INSTRUMENT DIAGRAM	DWG NO.	S-02115	REV.	4
CONTRACTOR	TCC 中国天辰工程有限公司	CONTRACTOR DRAWING NO.	MKP-11-AS-2000-PS07-PID-010	SHEET	01	TOTAL	01
CONTRACTOR		SUB-CONTRACTOR DRAWING NO.		SHEET		TOTAL	


PROJECT	MKP Methanol Project
UNIT	Reformer
PHASE	As Built Drawing
OWNER DWG NO.	MKP-11-AS-2000-PR-PID-010

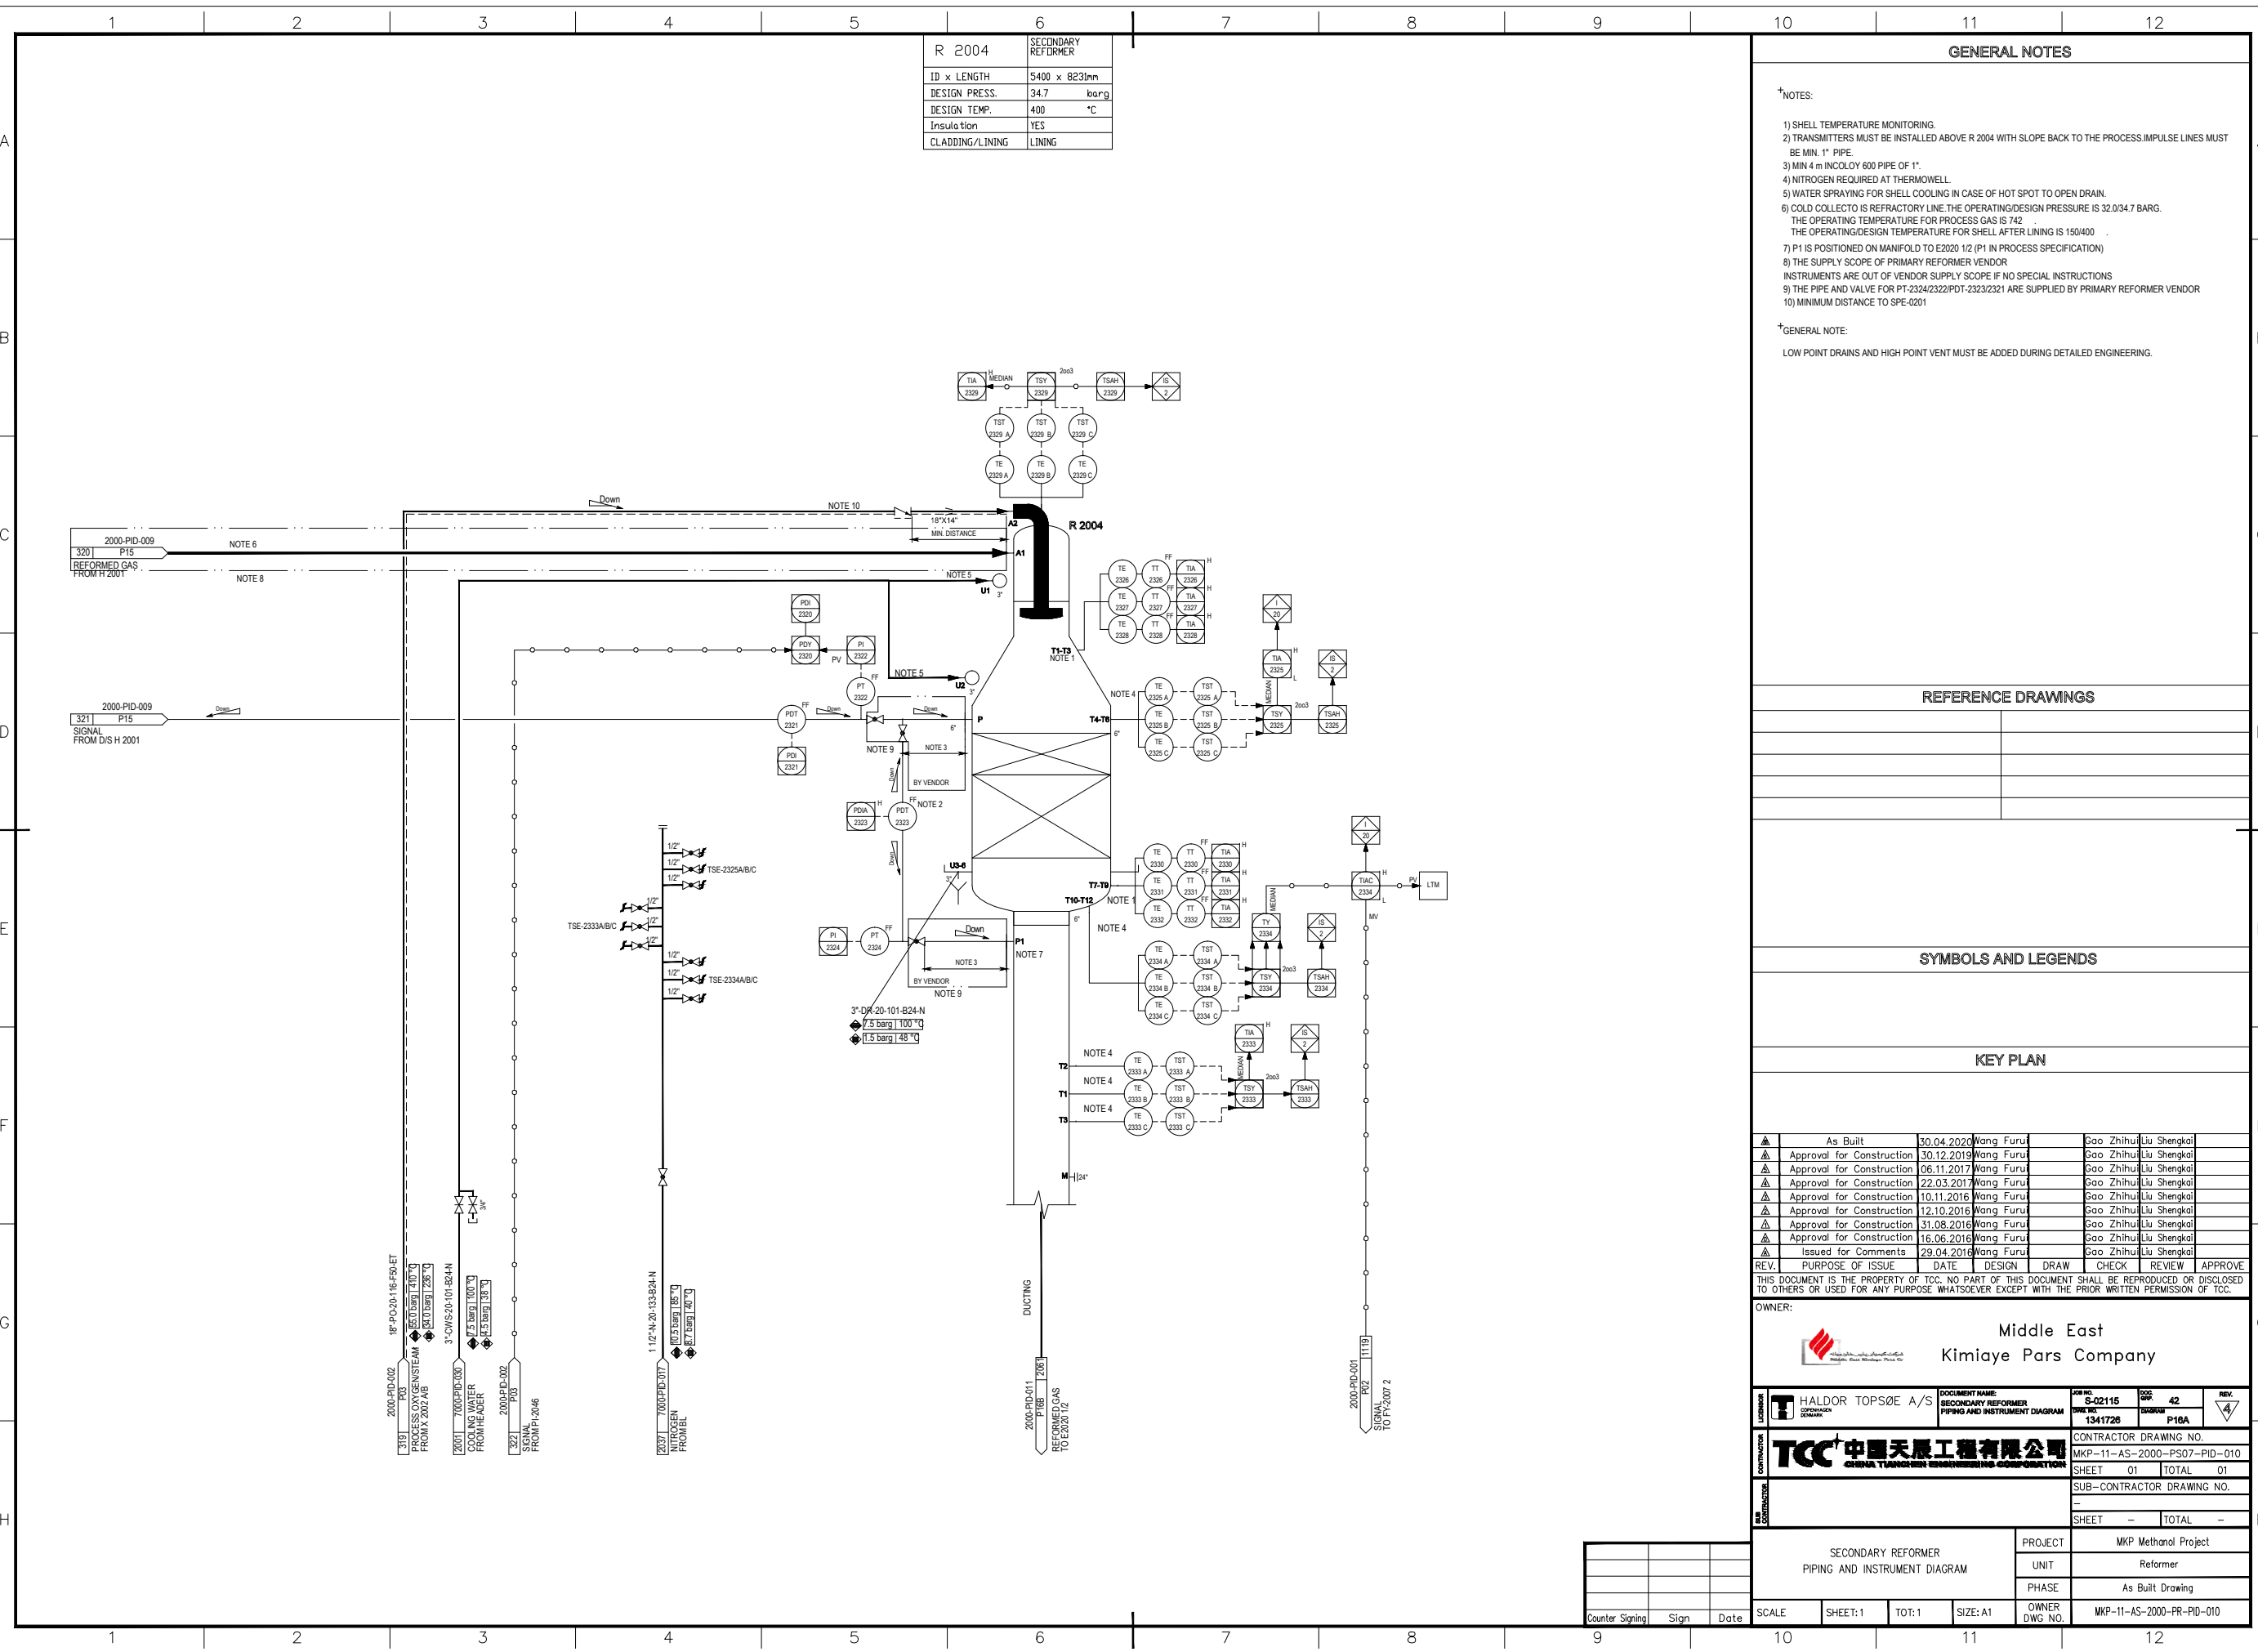

Counter	Sign	Date

SCALE	SHEET: 1	TOT: 1	SIZE: A1
-------	----------	--------	----------

E 2020 1/2	WASTE HEAT BOILER
DUTY	82.5 MW
ID x LENGTH-T	2890x7000 mm
DESIGN PRESS.(TL/SH)	31/113 barg
DESIGN TEMP.(TL/SH)	400/330 °C
Insulation	NA

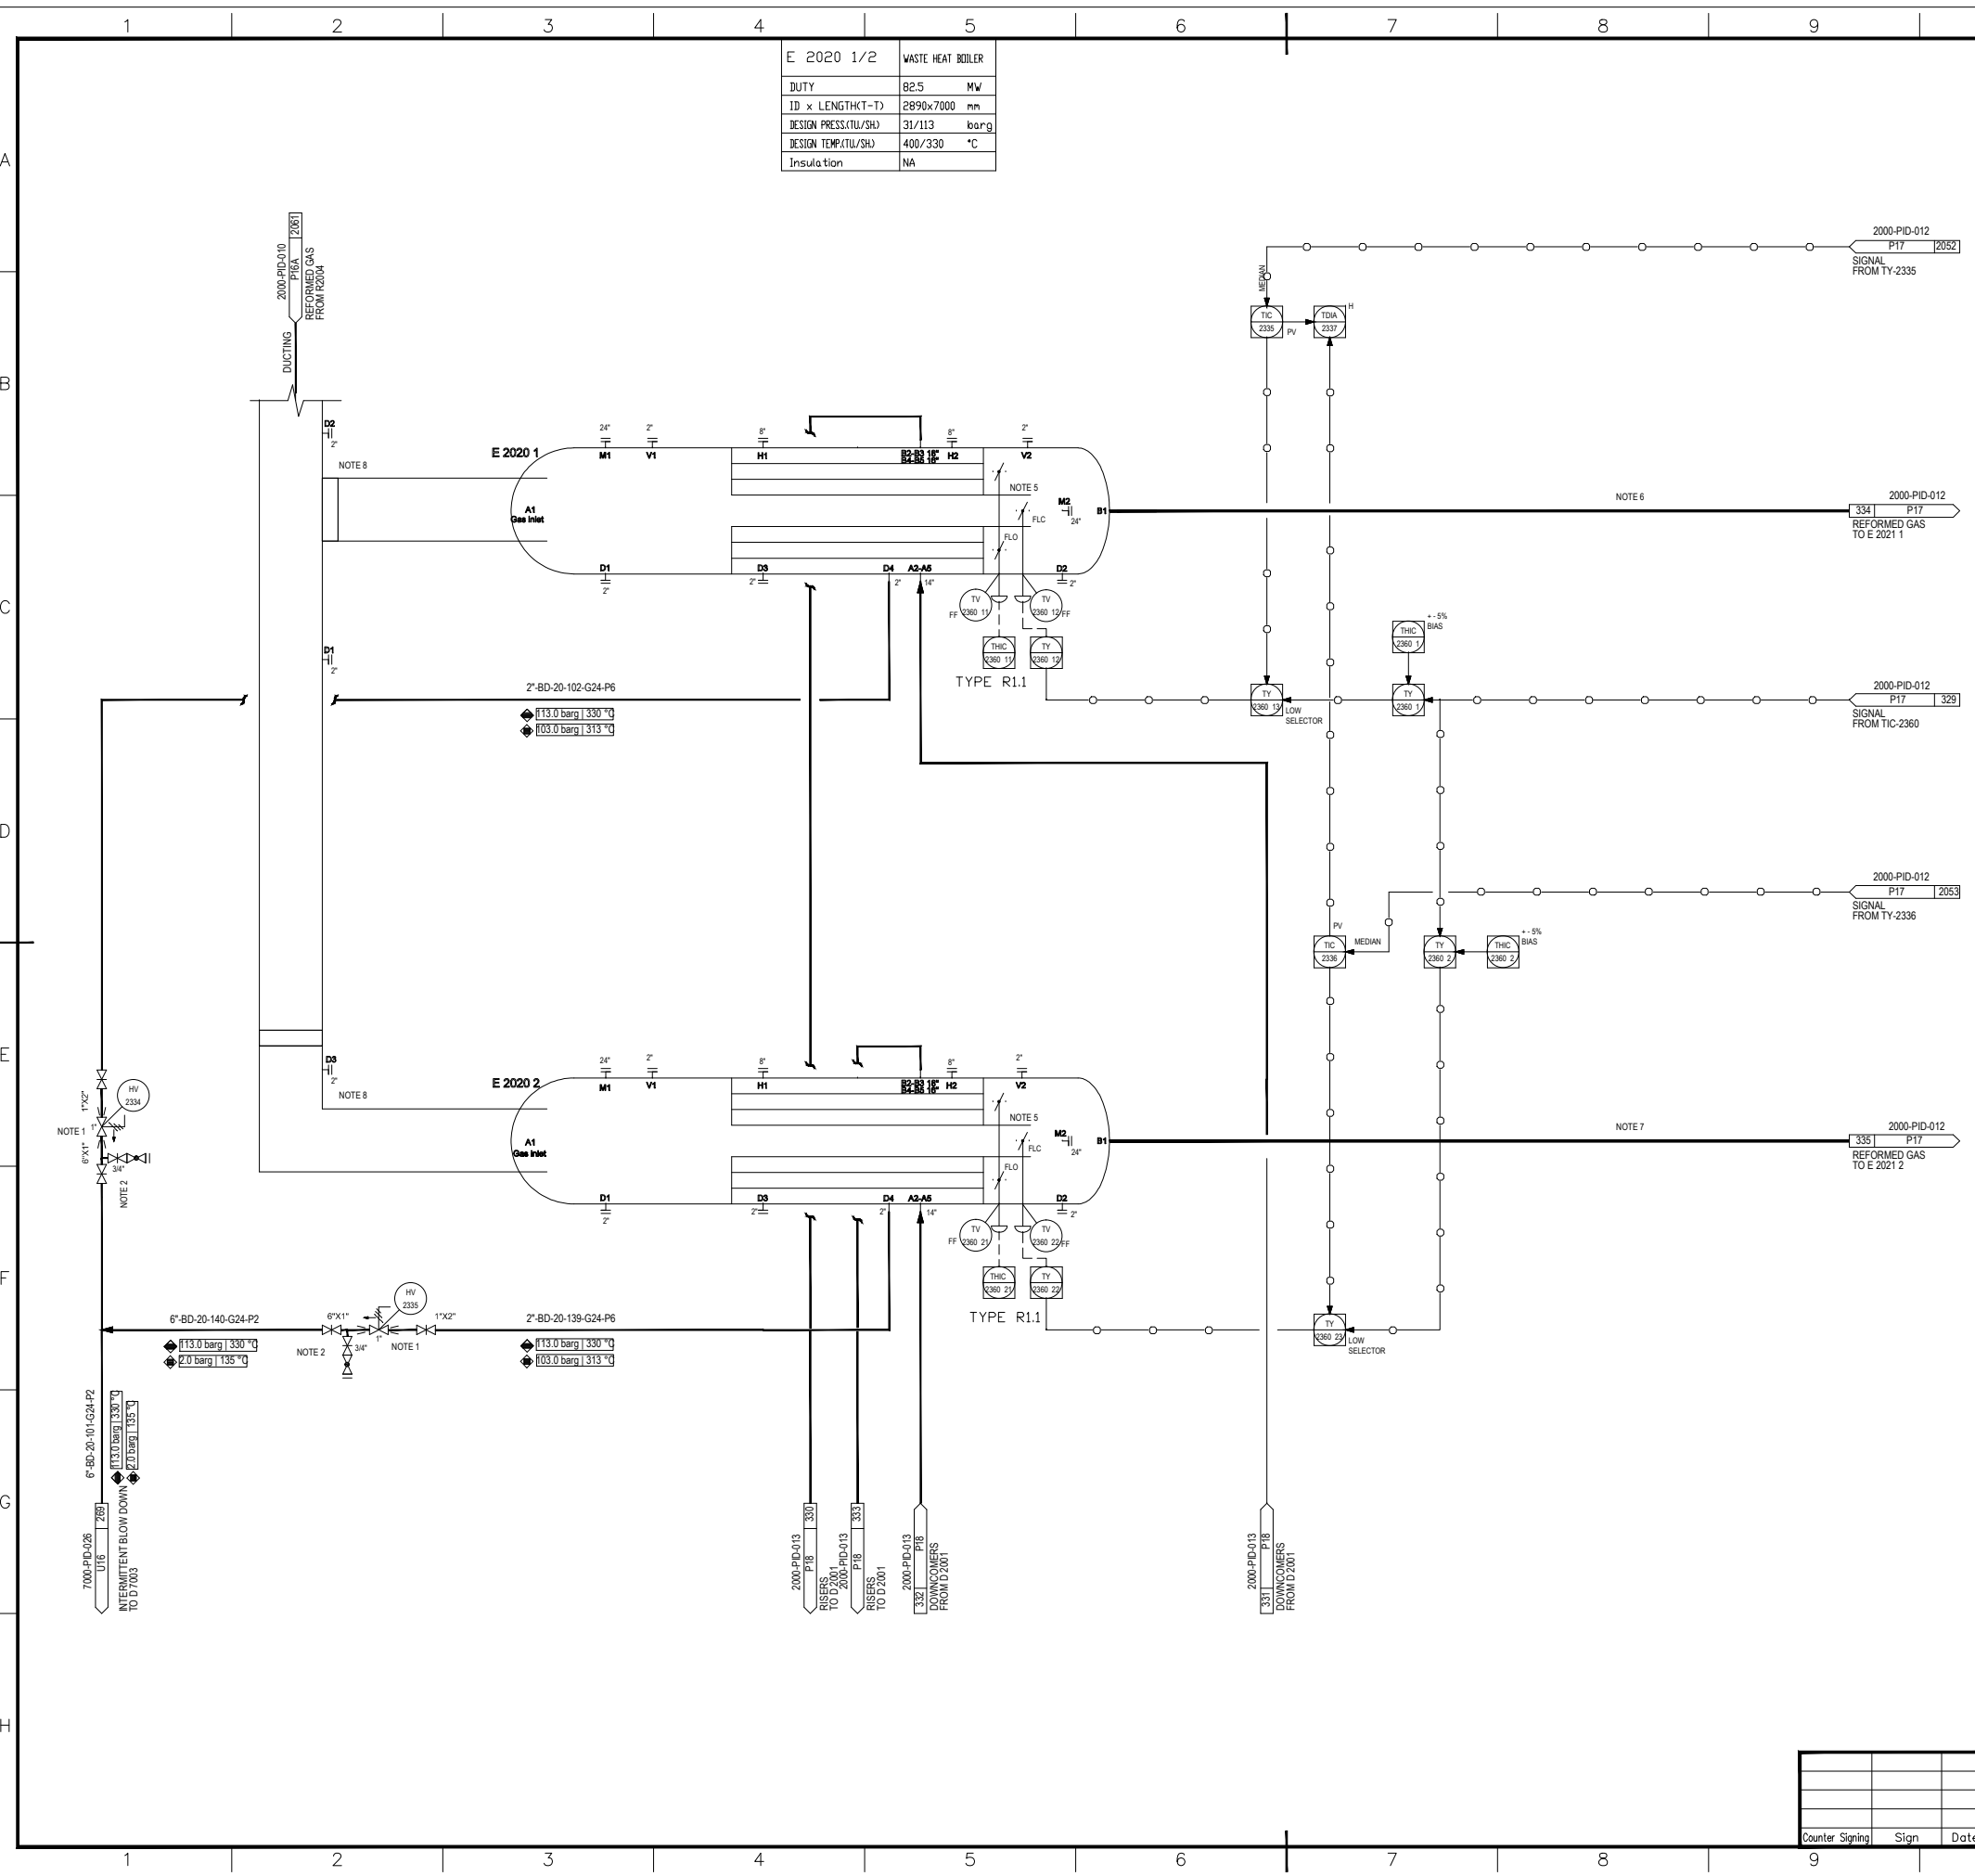

**GENERAL NOTES**

- †NOTES:
- 1) BLOW DOWN VALVE TO BE PLACED AS CLOSE AS POSSIBLE TO D 7003. NO POCKETS ON BOILER BLOW DOWN LINE DOWNSTREAM BLOW DOWN VALVE.
  - 2) TWO PHASE FLOW.
  - 3) TO BE PROVIDED WITH ADJUSTABLE MINIMUM STOP.
  - 4) E 2020 1 AND E 2021 1 ARE DIRECT CONNECTION.
  - 5) E 2020 2 AND E 2021 2 ARE DIRECT CONNECTION.
  - 6) SYMMETRICAL DUCTING.
  - †GENERAL NOTE:  
LOW POINT DRAINS AND HIGH POINT VENT MUST BE ADDED DURING DETAILED ENGINEERING.

**REFERENCE DRAWINGS**

2000-PID-012	P17	2052
2000-PID-012	P17	329
2000-PID-012	P17	2053

**SYMBOLS AND LEGENDS**

**KEY PLAN**

As Built	30.04.2020	Wang Furu	Gao Zhihu	Liu Shengkol
Approval for Construction	30.12.2019	Wang Furu	Gao Zhihu	Liu Shengkol
Approval for Construction	06.11.2017	Wang Furu	Gao Zhihu	Liu Shengkol
Approval for Construction	22.03.2017	Wang Furu	Gao Zhihu	Liu Shengkol
Approval for Construction	10.11.2016	Wang Furu	Gao Zhihu	Liu Shengkol
Approval for Construction	12.10.2016	Wang Furu	Gao Zhihu	Liu Shengkol
Issued for Approval	31.08.2016	Wang Furu	Gao Zhihu	Liu Shengkol
Issued for Approval	16.06.2016	Wang Furu	Gao Zhihu	Liu Shengkol
Issued for Comments	29.04.2016	Wang Furu	Gao Zhihu	Liu Shengkol


REV. PURPOSE OF ISSUE DATE DESIGN DRAW CHECK REVIEW APPROVE  
THIS DOCUMENT IS THE PROPERTY OF TCC. NO PART OF THIS DOCUMENT SHALL BE REPRODUCED OR DISCLOSED TO OTHERS OR USED FOR ANY PURPOSE WHATSOEVER EXCEPT WITH THE PRIOR WRITTEN PERMISSION OF TCC.

OWNER: Middle East Kimiaye Pars Company

DESIGNER	HALDOR TOPSØE A/S	DOCUMENT NAME	SECONDARY REFORMER II PIPING AND INSTRUMENT DIAGRAM	JOB NO.	S-02115	CDR	42	REV.	2
CONTRACTOR	TCC 中国天辰工程有限公司	CONTRACTOR DRAWING NO.	MKP-11-AS-2000-PS07-PID-011	DWG NO.	1341758	ISSUED	P16B		
		SHEET	01	TOTAL	01				
		SUB-CONTRACTOR DRAWING NO.							
		SHEET	--	TOTAL	--				

PROJECT	MKP Methanol Project
UNIT	Reformer
PHASE	As Built Drawing
OWNER DWG NO.	MKP-11-AS-2000-PR-PID-011

Counter	Sign	Date

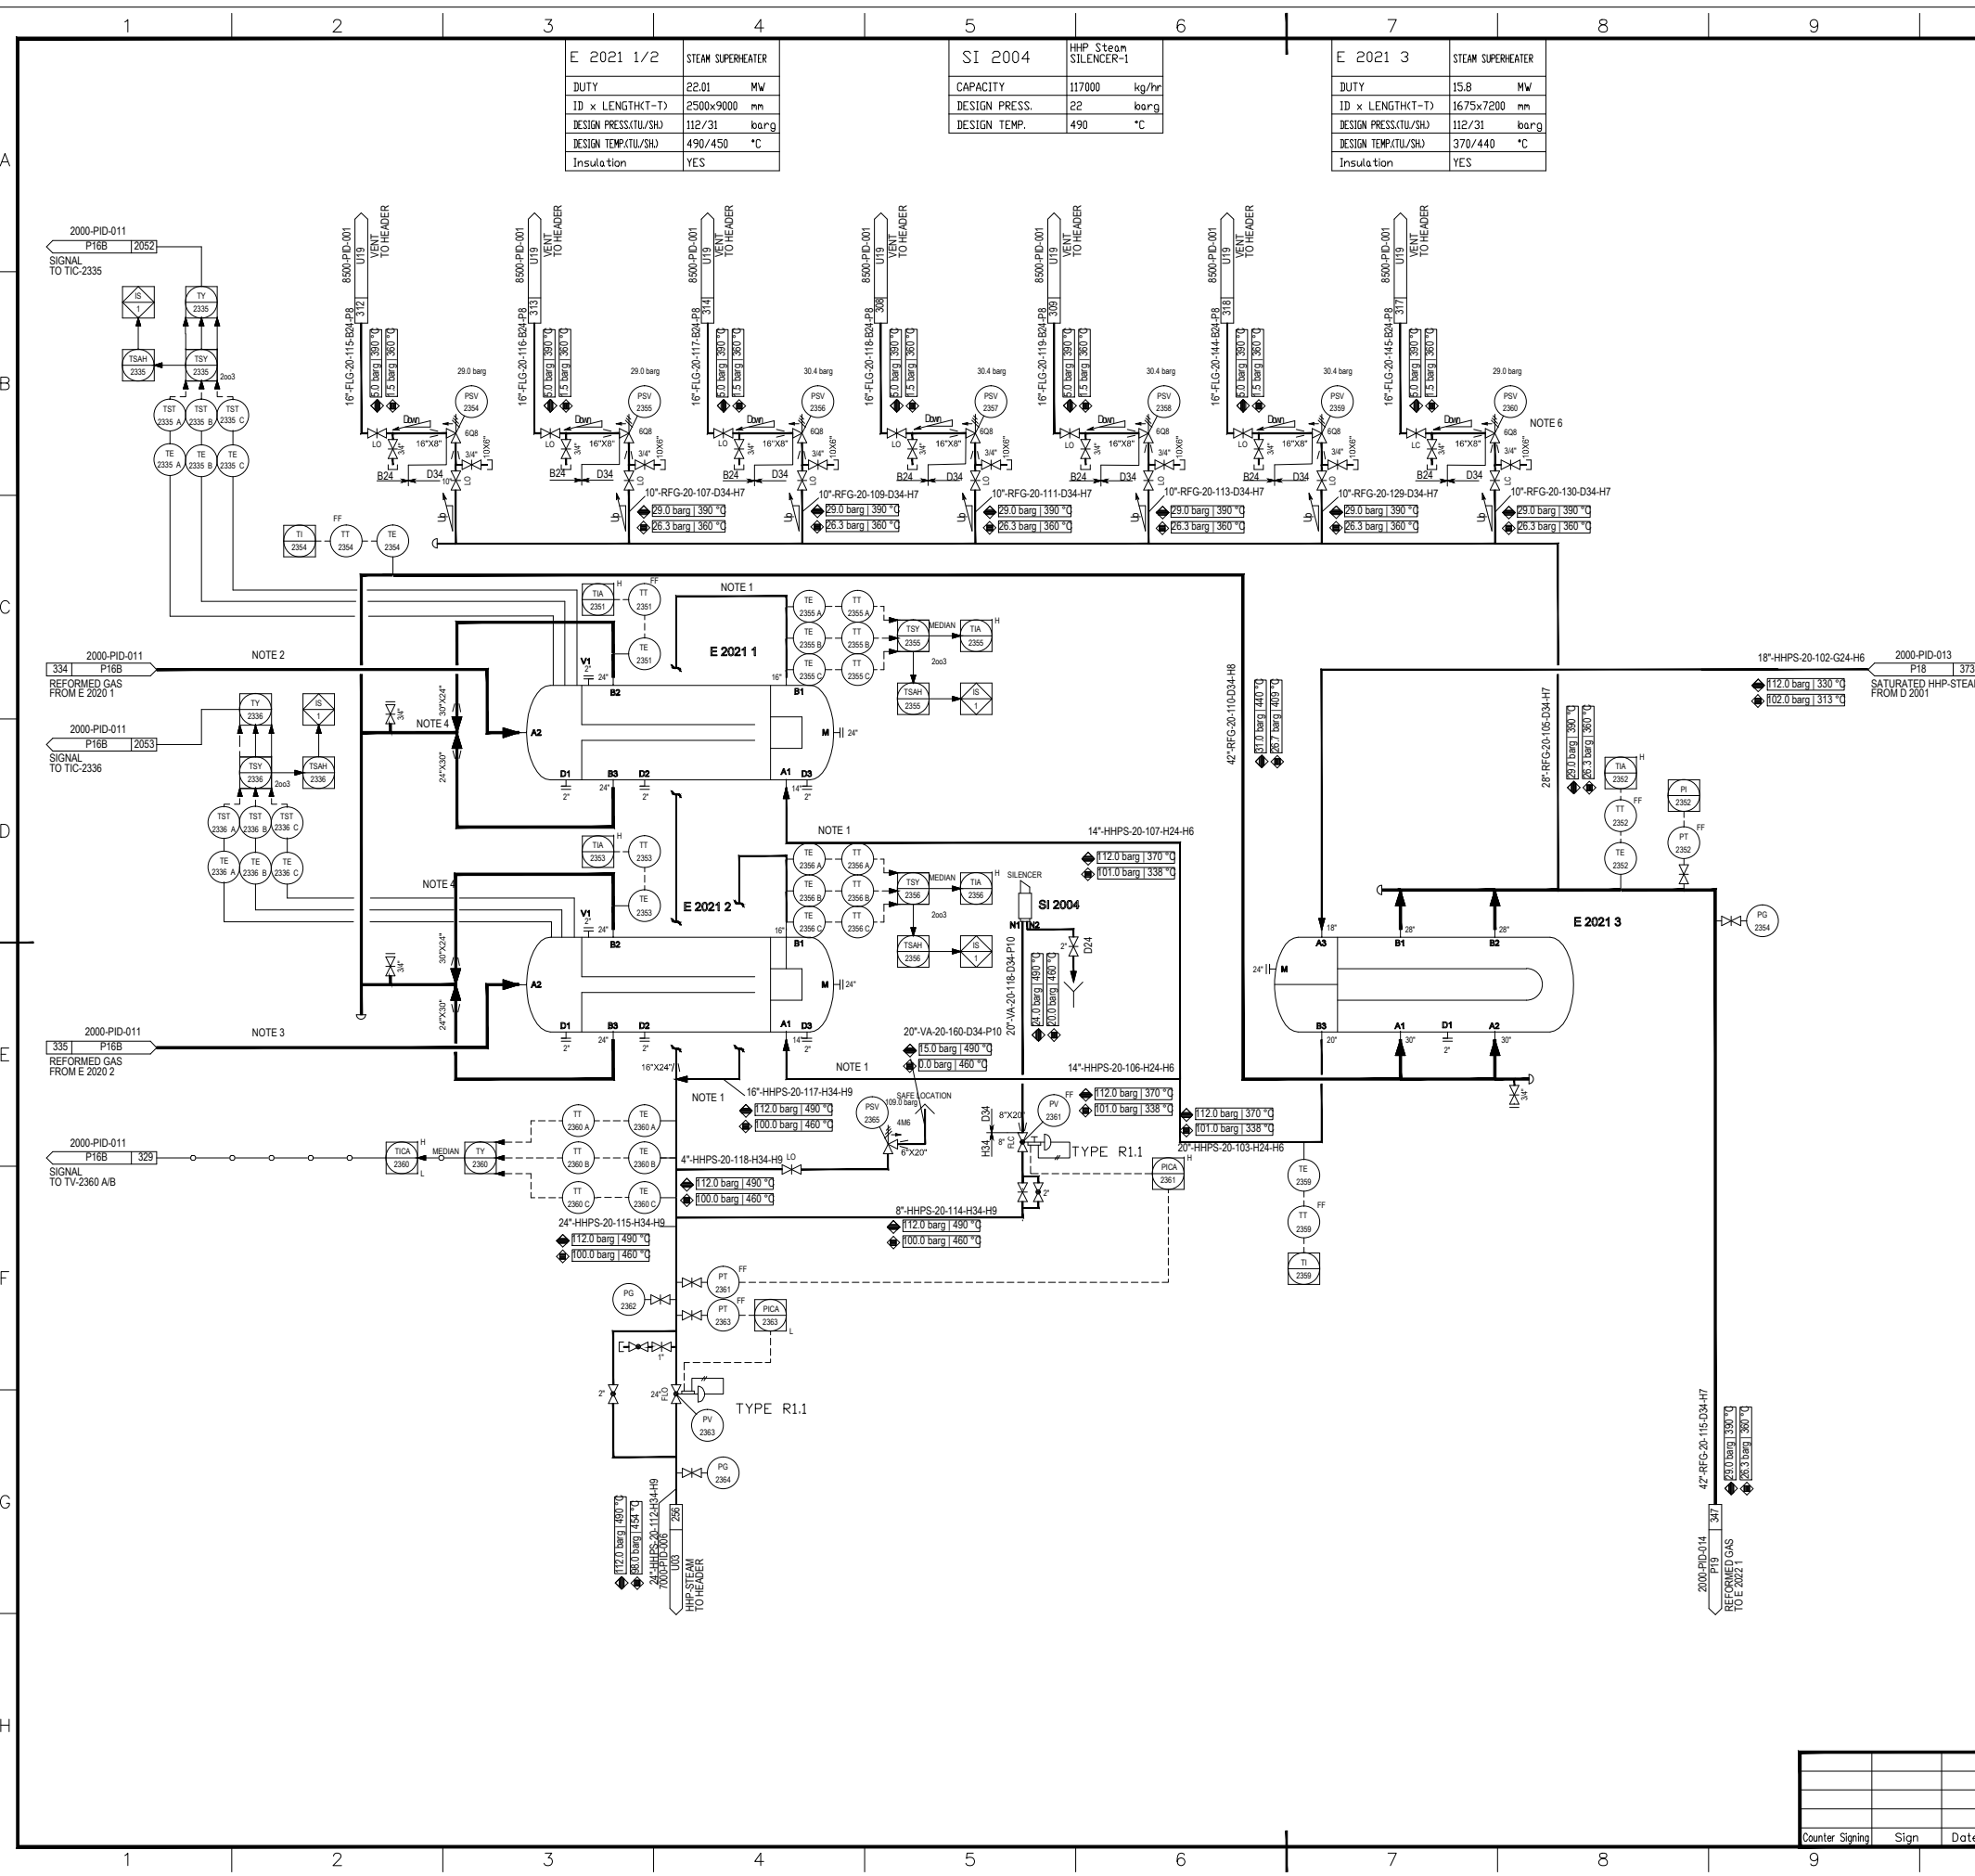

E 2021 1/2	STEAM SUPERHEATER
DUTY	22.01 MW
ID x LENGTH(T)-T)	2500x9000 mm
DESIGN PRESS.(TL/SH)	112/31 barg
DESIGN TEMP.(TL/SH)	490/450 °C
Insulation	YES

SI 2004	HHP Steam SILENCER-1
CAPACITY	117000 kg/hr
DESIGN PRESS.	22 barg
DESIGN TEMP.	490 °C

E 2021 3	STEAM SUPERHEATER
DUTY	15.8 MW
ID x LENGTH(T)-T)	1675x7200 mm
DESIGN PRESS.(TL/SH)	112/31 barg
DESIGN TEMP.(TL/SH)	370/440 °C
Insulation	YES

**GENERAL NOTES**

- \*NOTES:
- 1) SYMMETRICAL STEAM PIPING AROUND E 2021 1/2.
  - 2) E 2020 1 AND E 2021 1 ARE DIRECT CONNECTION.
  - 3) E 2020 2 AND E 2021 2 ARE DIRECT CONNECTION.
  - 4) SYMMETRICAL PIPING.
  - 5) VALVE SIZE WILL BE CONFIRMED BY VENDOR.
  - 6) THE FLANGE CLASS FOR INLET OF SAFETY-RELIEF VALVES PSV-2354-2360 SHOULD BE CL600 DIFFERING FROM PIPE.
- \*GENERAL NOTE:
- LOW POINT DRAINS AND HIGH POINT VENT MUST BE ADDED DURING DETAILED ENGINEERING.

**REFERENCE DRAWINGS**

**SYMBOLS AND LEGENDS**

**KEY PLAN**


REV.	PURPOSE OF ISSUE	DATE	DESIGN	DRAW	CHECK	REVIEW	APPROVE
▲	As Built	30.04.2020	Wang Furu		Gao Zhihu	Liu Shengkol	
▲	Approval for Construction	05.05.2017	Wang Furu		Gao Zhihu	Liu Shengkol	
▲	Approval for Construction	22.03.2017	Wang Furu		Gao Zhihu	Liu Shengkol	
▲	Approval for Construction	23.01.2017	Wang Furu		Gao Zhihu	Liu Shengkol	
▲	Approval for Construction	10.11.2016	Wang Furu		Gao Zhihu	Liu Shengkol	
▲	Approval for Construction	12.10.2016	Wang Furu		Gao Zhihu	Liu Shengkol	
▲	Approval for Construction	31.08.2016	Wang Furu		Gao Zhihu	Liu Shengkol	
▲	Approval for Construction	16.06.2016	Wang Furu		Gao Zhihu	Liu Shengkol	
▲	Issued for Comments	29.04.2016	Wang Furu		Gao Zhihu	Liu Shengkol	

OWNER: Middle East Kimiaye Pars Company

DESIGNER	HALDOR TOPSØE A/S	DOCUMENT NAME	STEAM SUPERHEATER PIPING AND INSTRUMENT DIAGRAM	PRO NO.	S-02115	REV.	4
DATE	05.05.2017	SCALE	P17	CONTRACTOR DRAWING NO.	1341727	TOTAL	01
				SUB-CONTRACTOR DRAWING NO.			
				SHEET	01	TOTAL	01

PROJECT	MKP Methanol Project
UNIT	Reformer
PHASE	As Built Drawing
OWNER DWG NO.	MKP-11-AS-2000-PR-PID-012

SCALE	SHEET:1	TOT:1	SIZE: A1
Counter Signing	Sign	Date	

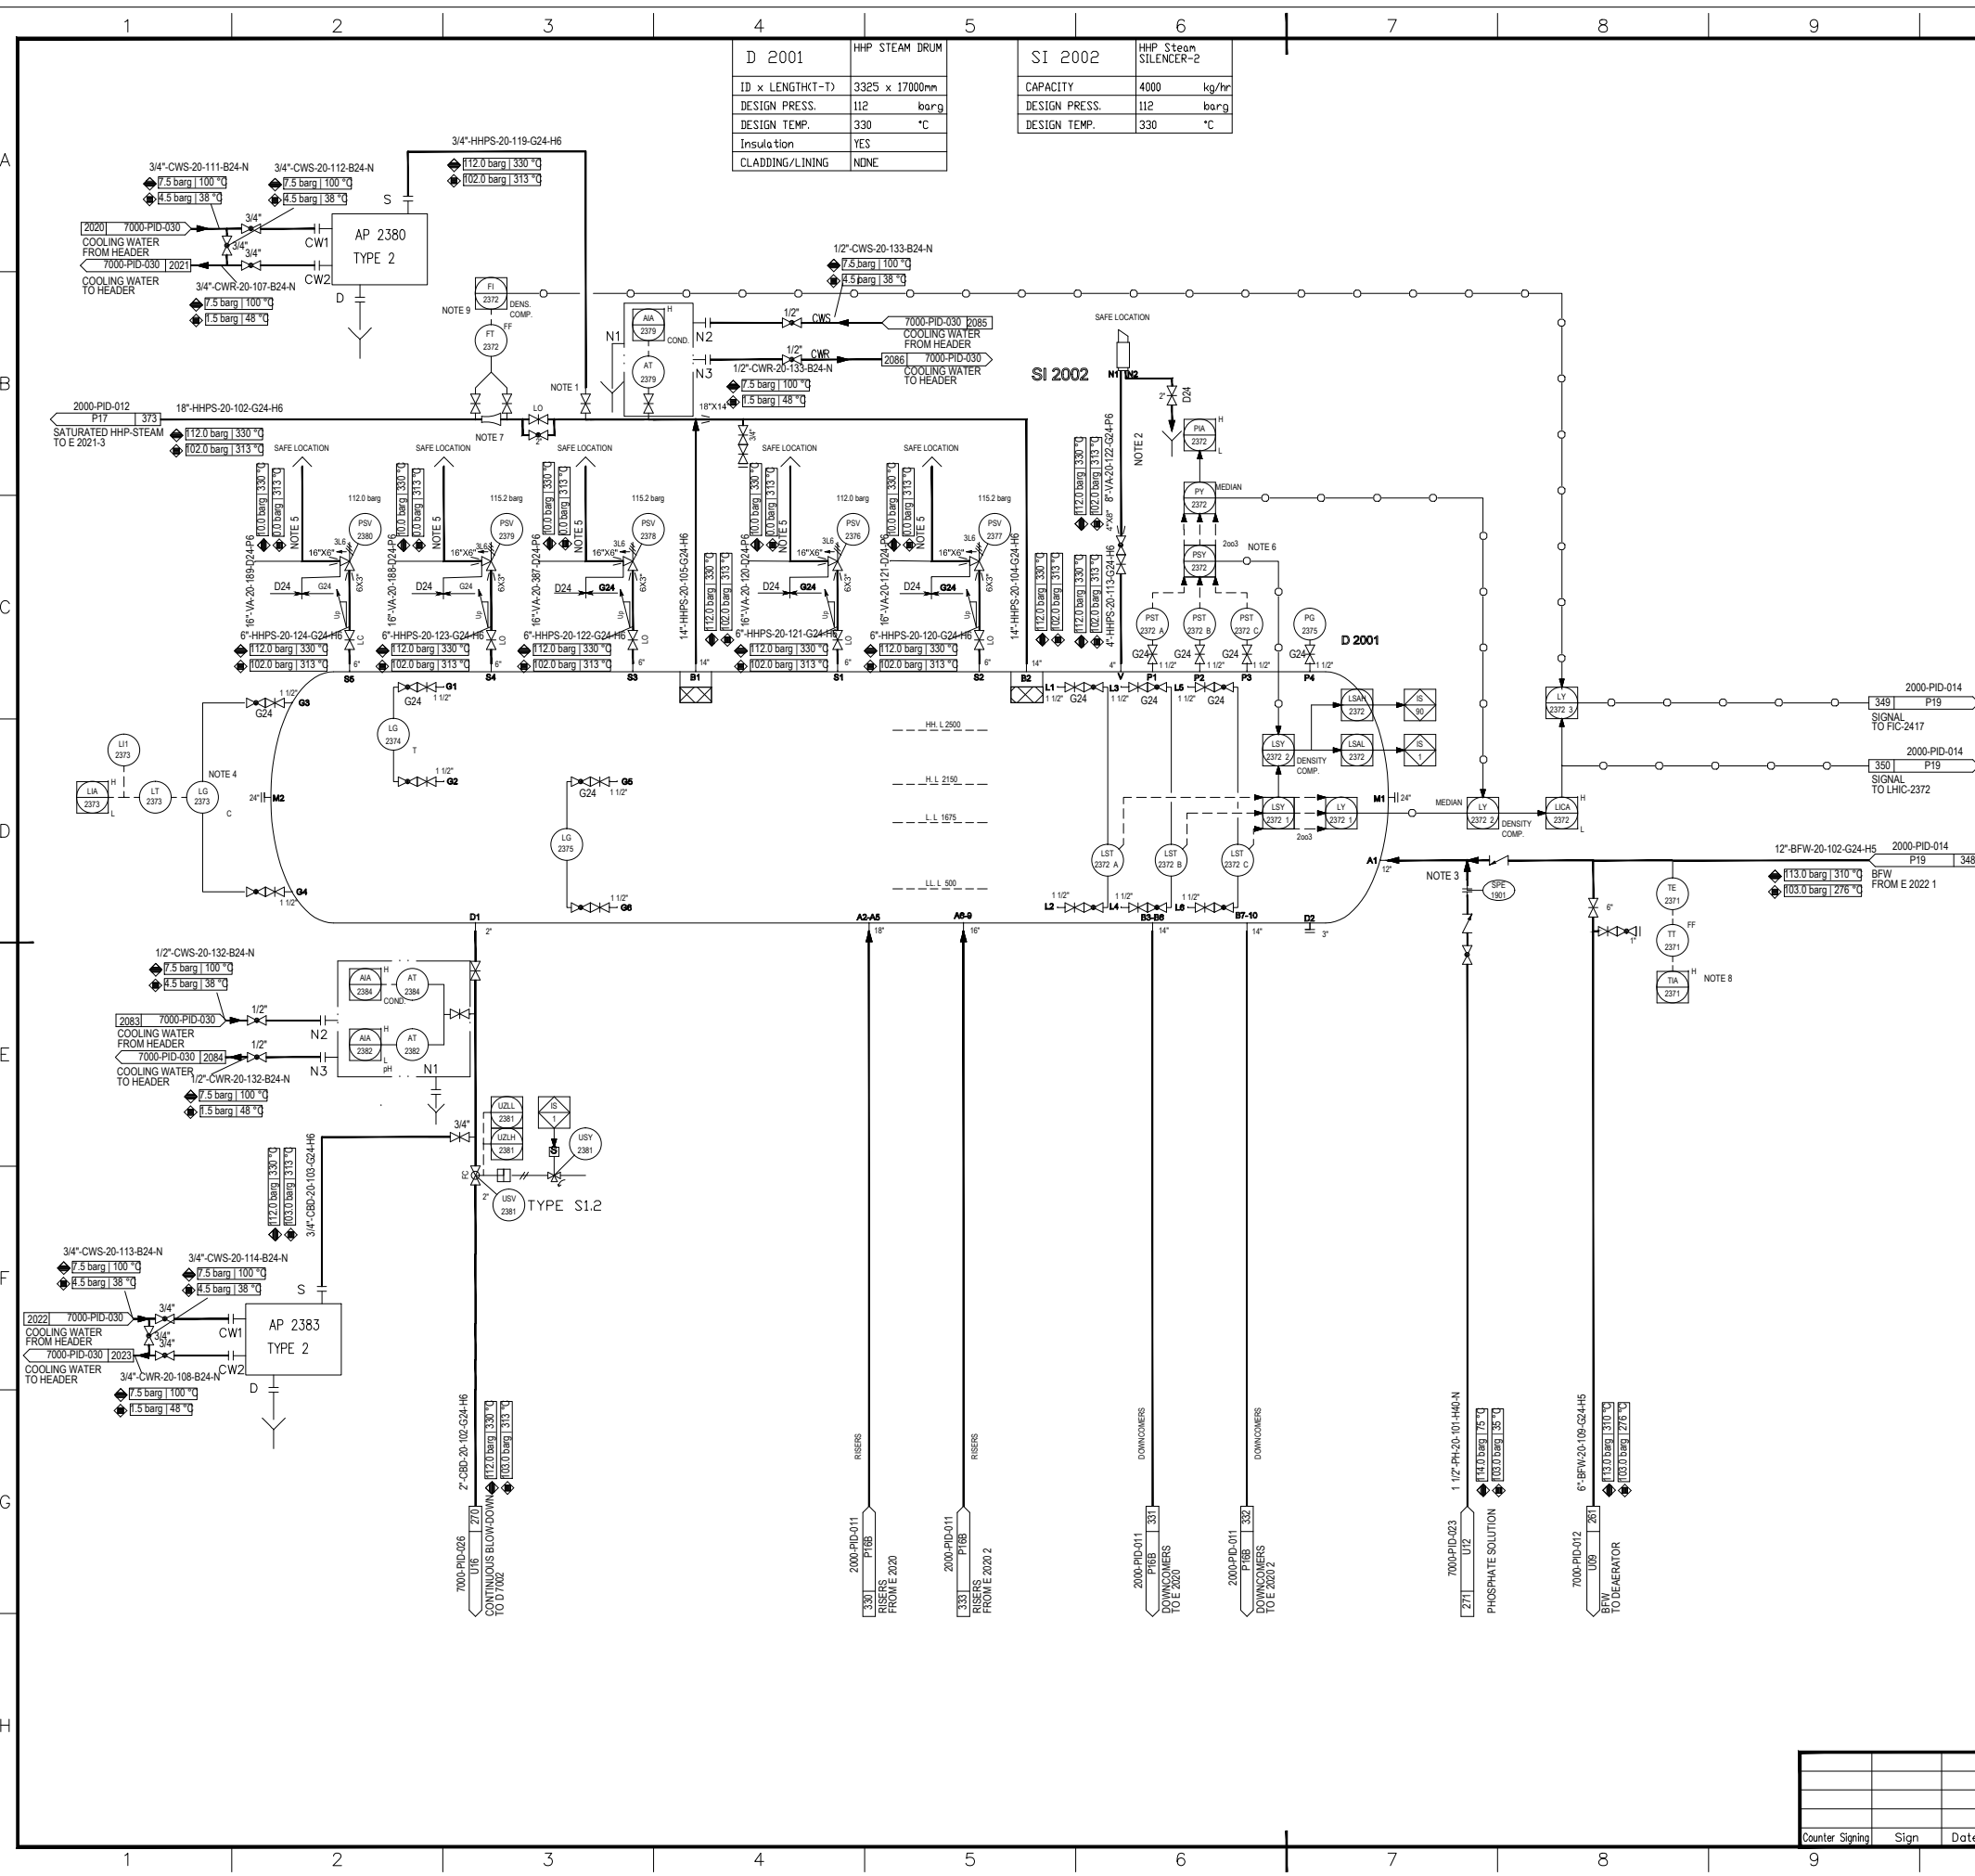

<b>D 2001</b>	HHP STEAM DRUM
ID x LENGTH(T-D)	3325 x 17000mm
DESIGN PRESS.	112 barg
DESIGN TEMP.	330 °C
Insulation	YES
CLADDING/LINING	NONE

<b>SI 2002</b>	HHP Steam SILENCER-2
CAPACITY	4000 kg/hr
DESIGN PRESS.	112 barg
DESIGN TEMP.	330 °C

**GENERAL NOTES**

- NOTES:
- 1) ACCESSIBLE FROM PLATFORM.
  - 2) LINE SIZING BY SILENCER VENDOR.
  - 3) SPE-1901: PHOSPHATE INJECTION CONNECTION.
- 
- 4) HYDRATEST WITH LOCAL INDICATOR AT GROUND LEVEL AND SIGNAL TO DCS.
  - 5) 1/2" DRIP HOLE TO BE DRILLED AT LOW POINT TO SAFE AND SUITABLE LOCATION.
  - 6) PRESSURE COMPENSATION.
  - 7) FLOW NOZZLE TO BE LOCATED ABOVE D 2001.
  - 8) ALARM TO BE PROGRAMMED DEPENDANT ON PI-2372 READING:  $AH = 100 \times (\sqrt{(PI-2372+1)}) - 10$
  - 9) PRESSURE COMPENSATION FROM PI-2372
- GENERAL NOTE:  
LOW POINT DRAINS AND HIGH POINT VENT MUST BE ADDED DURING DETAILED ENGINEERING.

**REFERENCE DRAWINGS**

2000-PID-012	18"-HHPS-20-102-G24-H6	SAFE LOCATION
2000-PID-014	348 P19	SIGNAL TO PIC-2417
2000-PID-014	350 P19	SIGNAL TO LHIC-2372
12"-BFW-20-102-G24-H5	2000-PID-014	P19 348
		BFW FROM E 2022 1

**SYMBOLS AND LEGENDS**

**KEY PLAN**

As Built	30.04.2020	Wang Furu	Gao Zhihu	Liu Shengkol
Approval for Construction	30.12.2019	Wang Furu	Gao Zhihu	Liu Shengkol
Approval for Construction	06.11.2017	Wang Furu	Gao Zhihu	Liu Shengkol
Approval for Construction	05.05.2017	Wang Furu	Gao Zhihu	Liu Shengkol
Approval for Construction	22.03.2017	Wang Furu	Gao Zhihu	Liu Shengkol
Approval for Construction	23.01.2017	Wang Furu	Gao Zhihu	Liu Shengkol
Approval for Construction	07.12.2016	Wang Furu	Gao Zhihu	Liu Shengkol
Approval for Construction	12.10.2016	Wang Furu	Gao Zhihu	Liu Shengkol
Approval for Construction	31.08.2016	Wang Furu	Gao Zhihu	Liu Shengkol
Approval for Construction	16.06.2016	Wang Furu	Gao Zhihu	Liu Shengkol
Issued for Comments	29.04.2016	Wang Furu	Gao Zhihu	Liu Shengkol

THIS DOCUMENT IS THE PROPERTY OF TCC. NO PART OF THIS DOCUMENT SHALL BE REPRODUCED OR DISCLOSED TO OTHERS OR USED FOR ANY PURPOSE WHATSOEVER EXCEPT WITH THE PRIOR WRITTEN PERMISSION OF TCC.

OWNER:

**Middle East  
Kimiaye Pars Company**

OWNER	HALDOR TOPSØE A/S	DOCUMENT NAME	STEAM GENERATION PIPING AND INSTRUMENT DIAGRAM	PRO NO	S-02115	REV	4
CONTRACTOR	TCC 中国天辰工程有限公司	DATE	13/4/2020	REV	P18		
CONTRACTOR DRAWING NO.		MKP-11-AS-2000-PS07-PID-013					
SHEET		01 TOTAL 01					
SUB-CONTRACTOR DRAWING NO.							
SHEET							

PROJECT	MKP Methanol Project
UNIT	Reformer
PHASE	As Built Drawing
OWNER DWG NO.	MKP-11-AS-2000-PR-PID-013

Counter	Sign	Date



E 2022 1	BFV Preheater
DUTY	34.8 MW
ID x LENGTH(T)	1450x10000 mm
DESIGN PRESS.(TLU/SH)	113/29 barg
DESIGN TEMP.(TLU/SH)	310/390 °C
Insulation	YES

E 2022 2/3	BFV Preheater
DUTY	41.6 MW
ID x LENGTH(T)	1450x10000 mm
DESIGN PRESS.(TLU/SH)	113/29 barg
DESIGN TEMP.(TLU/SH)	310/280 °C
Insulation	YES

P 2001 A/B	PROCESS CONDENSATE PUMP ND1
CAPACITY	32.3 m <sup>3</sup> /h
HEAD	274.3 m
DENSITY	903 kg/m <sup>3</sup>
INSULATION/TRACING	YES
AUXILIARY PIPING	By Vendor

D 2002	1st SEPARATOR
ID x LENGTH(T)	3750 x 4850 mm
DESIGN PRESS.	29 barg
DESIGN TEMP.	200 °C
Insulation	YES
CLADDING/LINING	NONE
Elevation of Equipment	EL +103.54m

D 2003	2nd SEPARATOR
ID x LENGTH(T)	3650 x 4750 mm
DESIGN PRESS.	29 barg
DESIGN TEMP.	200 °C
Insulation	YES
CLADDING/LINING	NONE

**GENERAL NOTES**

- NOTES:
- TWO PHASE FLOW.
  - SWITCHING BY FHS-2417 (SYMBOLIC INDICATED) FROM 3-ELEMENT LEVEL CONTROL VIA FIC-2417 TO SINGLE ELEMENT LEVEL CONTROL IS DONE WITH AUTOMATIC CHANGE OF TUNING CONSTANTS IN LIC-2372.
  - NOZZLE B2 ON D2002 MUST BE LOCATED MIN. 1.5 m ABOVE P 2001 AB TO BE CONFORMED BY PUMP VENDOR.
  - VALVE SIZE WILL BE CONFIRMED BY VENDOR.
  - MOUNT ON STANDPIPE OR BRIDLE. ALTERNATIVELY ADD A SET OF NOZZLES (ONE SET FOR EACH LT-).
  - PIA-2416 LOW PRESSURE THEN I-2001 WORK MAKE STAND-BY PUMP AUTOSTART.
  - PV-2406 INCLUDES 3 NOISE REDUCTION DISKS, THE SIZE IS 16"24" AND THE REDUCER CONSIDERED BY PIPING.

GENERAL NOTE:  
LOW POINT DRAINS AND HIGH POINT VENT MUST BE ADDED DURING DETAILED ENGINEERING.

**REFERENCE DRAWINGS**

**SYMBOLS AND LEGENDS**

**KEY PLAN**


REV.	PURPOSE OF ISSUE	DATE	DESIGN	DRAW	CHECK	REVIEW	APPROVE
▲	As Built	30.04.2020	Wang Furu				Gao Zhihu Liu Shengkol
▲	Approval for Construction	30.12.2019	Wang Furu				Gao Zhihu Liu Shengkol
▲	Approval for Construction	06.11.2017	Wang Furu				Gao Zhihu Liu Shengkol
▲	Approval for Construction	05.05.2017	Wang Furu				Gao Zhihu Liu Shengkol
▲	Approval for Construction	22.03.2017	Wang Furu				Gao Zhihu Liu Shengkol
▲	Approval for Construction	23.01.2017	Wang Furu				Gao Zhihu Liu Shengkol
▲	Approval for Construction	10.11.2016	Wang Furu				Gao Zhihu Liu Shengkol
▲	Approval for Construction	12.10.2016	Wang Furu				Gao Zhihu Liu Shengkol
▲	Issued for Approval	31.08.2016	Wang Furu				Gao Zhihu Liu Shengkol
▲	Issued for Approval	16.06.2016	Wang Furu				Gao Zhihu Liu Shengkol
▲	Issued for Comments	29.04.2016	Wang Furu				Gao Zhihu Liu Shengkol

THIS DOCUMENT IS THE PROPERTY OF TCC. NO PART OF THIS DOCUMENT SHALL BE REPRODUCED OR DISCLOSED TO OTHERS OR USED FOR ANY PURPOSE WHATSOEVER EXCEPT WITH THE PRIOR WRITTEN PERMISSION OF TCC.

OWNER: Middle East Kimiaye Pars Company


DESIGNER	HALDOR TOPSØE A/S	DOCUMENT NAME	GAS COOLING AND SEPARATION I PIPING AND INSTRUMENT DIAGRAM	DWG NO.	S-02115	REV.	42
CONTRACTOR	TCC 中国天辰工程有限公司	DATE	13/4/2020	CONTRACTOR DRAWING NO.	MKP-11-AS-2000-PR-PID-014	SHEET	01
SCALE		TOTAL		SUB-CONTRACTOR DRAWING NO.		TOTAL	
CHECKER		SHEET				TOTAL	


GAS COOLING AND SEPARATION I PIPING AND INSTRUMENT DIAGRAM		PROJECT	MKP Methanol Project
		UNIT	Reformer
		PHASE	As Built Drawing
SCALE	SHEET:1	TOT:1	SIZE: A1
COUNTER SIGNING	SIGN	DATE	OWNER DWG NO. MKP-11-AS-2000-PR-PID-014

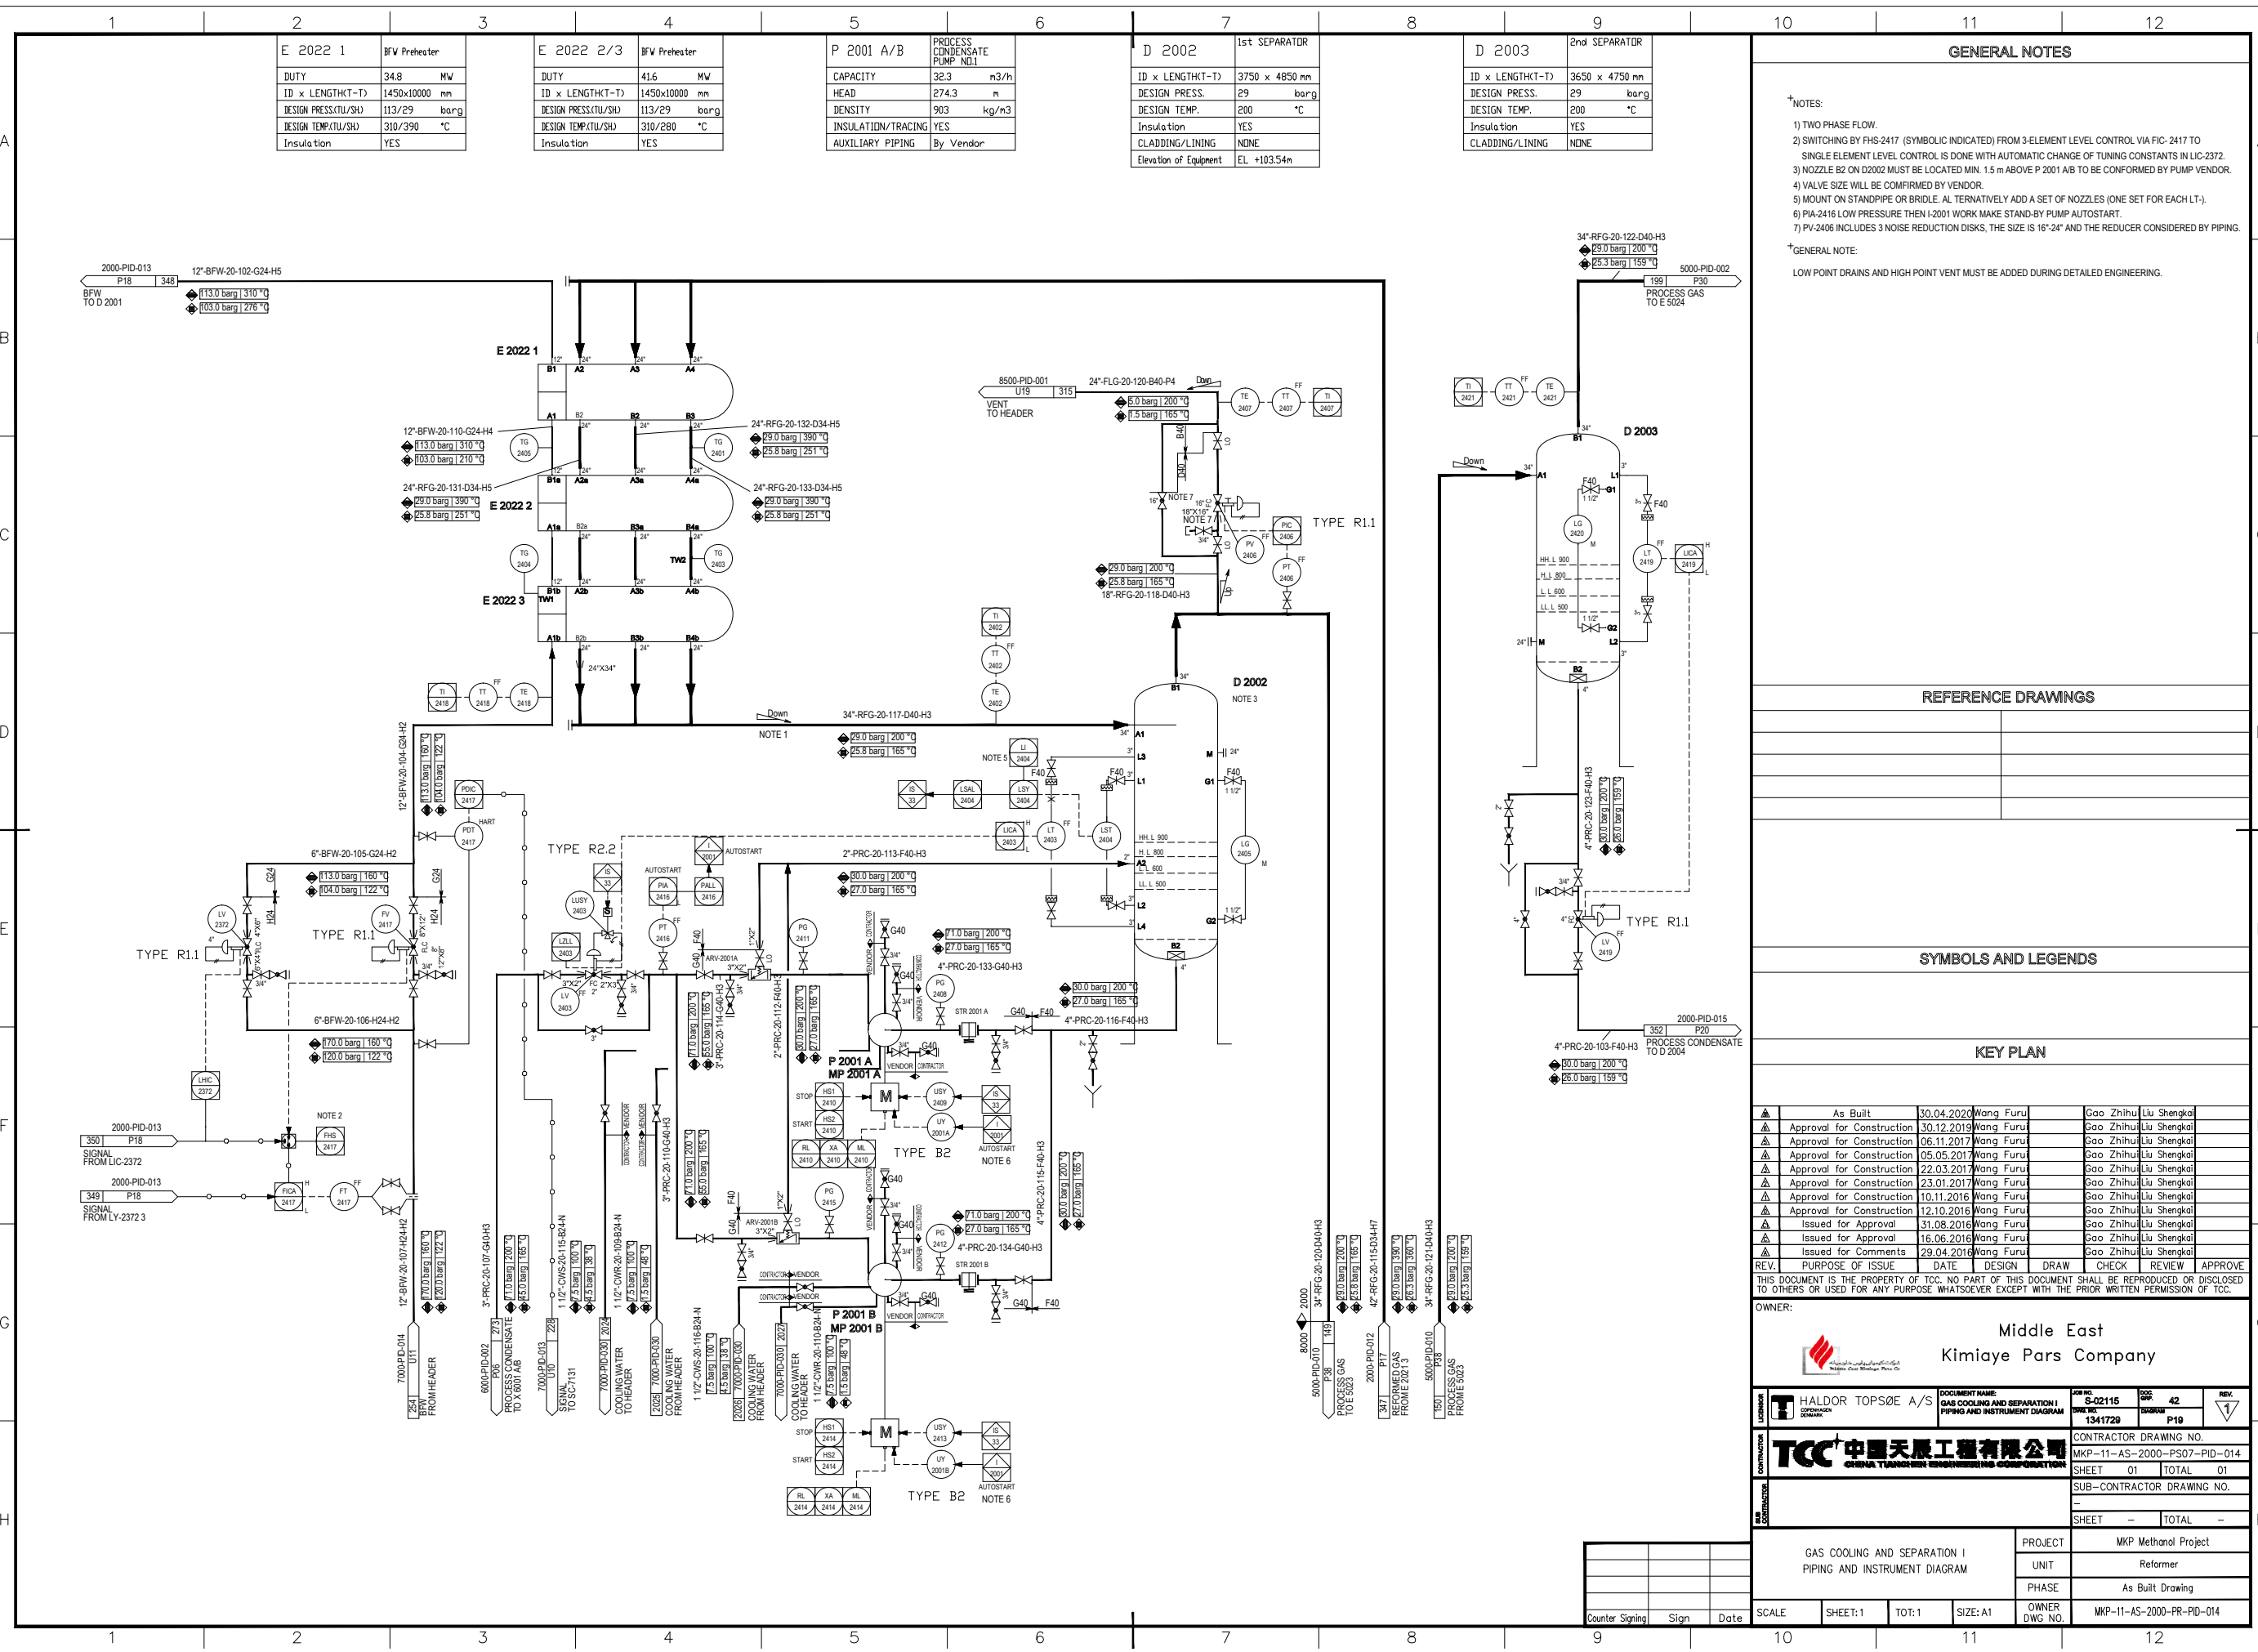

<b>D 2004</b>	3rd SEPARATOR	<b>P 2002 A/B</b>	PROCESS CONDENSATE PUMP NO.2	<b>E 2025</b>	DMW PREHEATER
ID x LENGTH-T)	3350 x 4825 mm	CAPACITY	116.5 m <sup>3</sup> /h	DUTY	9.4 MW
DESIGN PRESS.	29 barg	Head	279.9 m	ID x LENGTH-T)	1000x1800 mm
DESIGN TEMP.	200 °C	DENSITY	928 kg/m <sup>3</sup>	DESIGN PRESS.(TLU/SH)	29/14 barg
Insulation	YES	INSULATION/TRACING	YES	DESIGN TEMP.(TLU/SH)	200/100 °C
CLADDING/LINING	NONE	AUXILIARY PIPING	By Vendor	Insulation	YES
Elevation of Equipment	EL +103.8m				

**GENERAL NOTES**

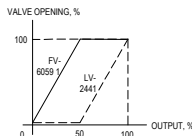- †NOTES:
- NOZZLE B2 ON D 2004 MUST BE LOCATED MIN 1.5m ABOVE P2002 A/B. TO BE CONFIRMED BY PUMP VENDOR.
  - MOUNT ON STANDPIPE OR BRIDLE. ALTERNATIVELY ADD A SET OF NOZZLES (ONE SET FOR EACH LT-).
  - FUNCTION OF LIC-2441
- 
- PIA2453 LOW PRESSURE THEN I-2002 WORK MAKE STAND-BY PUMP AUTOSTART.
- †GENERAL NOTE:  
LOW POINT DRAINS AND HIGH POINT VENT MUST BE ADDED DURING DETAILED ENGINEERING.

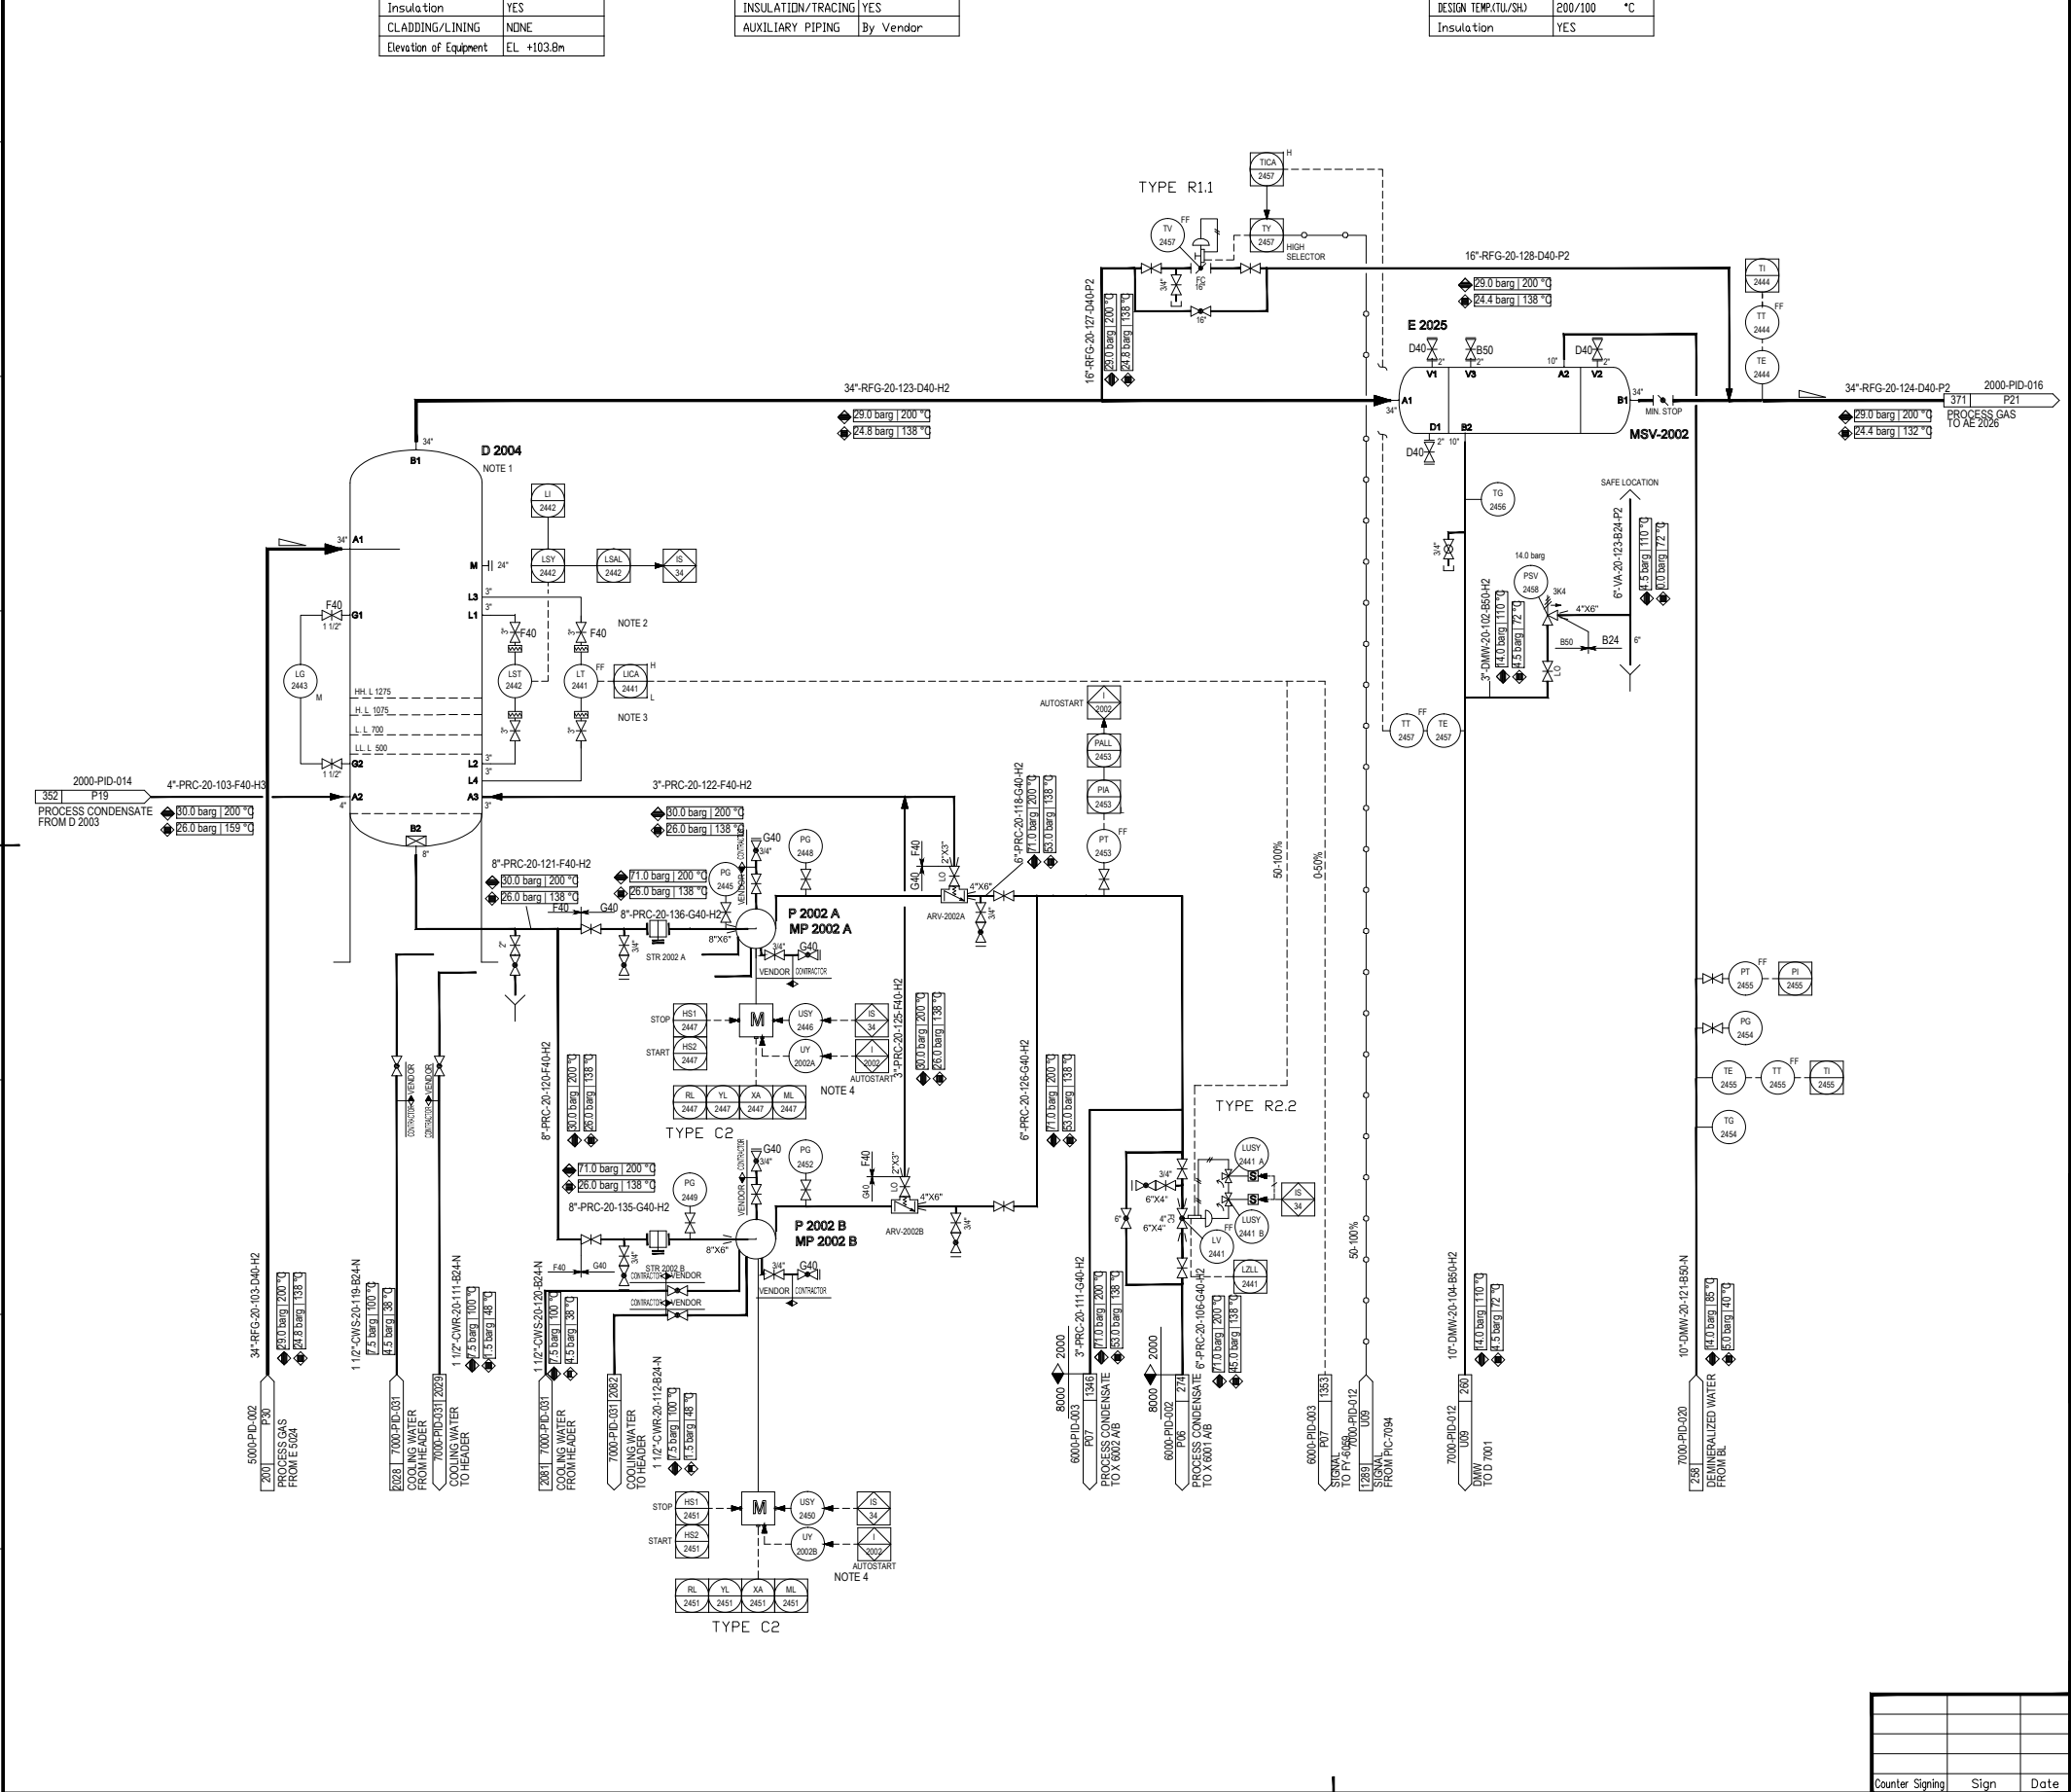

**REFERENCE DRAWINGS**

**SYMBOLS AND LEGENDS**

**KEY PLAN**

REV.	PURPOSE OF ISSUE	DATE	DESIGN	DRAW	CHECK	REVIEW	APPROVE
▲	As Built	30.04.2020	Wang Furu				Gao Zhihu Liu Shengkol
▲	Approval for Construction	30.12.2019	Wang Furu				Gao Zhihu Liu Shengkol
▲	Approval for Construction	06.11.2017	Wang Furu				Gao Zhihu Liu Shengkol
▲	Approval for Construction	05.05.2017	Wang Furu				Gao Zhihu Liu Shengkol
▲	Approval for Construction	22.03.2017	Wang Furu				Gao Zhihu Liu Shengkol
▲	Approval for Construction	23.01.2017	Wang Furu				Gao Zhihu Liu Shengkol
▲	Approval for Construction	10.11.2016	Wang Furu				Gao Zhihu Liu Shengkol
▲	Approval for Construction	12.10.2016	Wang Furu				Gao Zhihu Liu Shengkol
▲	Approval for Construction	31.08.2016	Wang Furu				Gao Zhihu Liu Shengkol
▲	Approval for Construction	16.06.2016	Wang Furu				Gao Zhihu Liu Shengkol
▲	Issued for Comments	29.04.2016	Wang Furu				Gao Zhihu Liu Shengkol

OWNER: **Middle East Kimiaye Pars Company**

DESIGNER	HALDOR TOPSØE A/S	DOCUMENT NAME	GAS COOLING AND SEPARATION II PIPING AND INSTRUMENT DIAGRAM	PRO NO.	S-02115	CONV.	42	REV.	1
CONTRACTOR	TCC 中国天辰工程有限公司	DRAWING NO.	1341730	SCALE	P20				
		CONTRACTOR DRAWING NO.	MKP-11-AS-2000-PS07-PID-015						
		SHEET	01	TOTAL	01				
		SUB-CONTRACTOR DRAWING NO.							
		SHEET	-	TOTAL	-				

GAS COOLING AND SEPARATION II PIPING AND INSTRUMENT DIAGRAM		PROJECT	MKP Methanol Project
		UNIT	Reformer
		PHASE	As Built Drawing
		OWNER DWG NO.	MKP-11-AS-2000-PR-PID-015

Counter Signing Sign Date

<b>AE 2026</b>	<b>AIR COOLER</b>	<b>P 2003 A/B</b>	<b>PROCESS CONDENSATE PUMP NO.3</b>	<b>E 2027</b>	<b>WATER COOLER</b>	<b>D 2005</b>	<b>FINAL SEPARATOR</b>
DUTY	51.3 MW	CAPACITY	83 m <sup>3</sup> /h	DUTY	6.5 MW	ID x LENGTH(T-T)	3500 x 4825 mm
ID x LENGTH(T-T)	BY VENDOR mm	Head	351 m	ID x LENGTH(T-T)	1400x10000 mm	DESIGN PRESS.	29 barg
DESIGN PRESS.(TLU/SH)	29 barg	DENSITY	989 kg/m <sup>3</sup>	DESIGN PRESS.(TLU/SH)	7.5/29 barg	DESIGN TEMP.	100 °C
DESIGN TEMP.(TLU/SH)	200 °C	INSULATION/TRACING	NONE	DESIGN TEMP.(TLU/SH)	100/120 °C	Insulation	NONE
		AUXILIARY PIPING	By Vendor	Insulation	NA	CLADDING/LINING	NONE
				Elevation of Equipment	EL +103.7m		

**GENERAL NOTES**

- †NOTES:
- TOP EXIT CONNECTION.
  - CONTROLLER TO AUTO WHEN SIGNAL FROM IS-1. SETPOINT EQUAL TO PROCESS VALUE BEFORE TRIP. SETPOINT MUST BE RAMPED DOWN TO 3 barg OVER 10 min.
  - PRESSURE TO BE HALVED EVERY 4 MINUTES OF DEPRESSURISATION.
  - IS-3 TO PUT CONTROLLER IN MANUAL OPEN VALVE TO AN OPENING CORRESPONDING TO THE FLOW AT TIME OF TRIP THEN PIC-2481 IS PUT IN AUTO WITH SET POINT EQUAL TO ACTUAL PRESSURE AT TIME OF TRIP.
  - D 2005 TO BE LOCATED CLOSE TO C 3001. NOZZLE B2 ON D 2005 MUST BE LOCATED MIN 1.5m ABOVE P 2003 A/B. TO BE CONFIRMED BY PUMP VENDOR.
  - TW IS TO BE INSTALLED ON EACH OUTLET HEADER FROM AE 2026.
- 9) VALVE SIZE WILL BE CONFIRMED BY VENDOR.
- 10) PIA2493 LOW PRESSURE THEN I-2003 WORK MAKE STAND-BY PUMP AUTOSTART.
- 11) DETAIL DRAWING FOR AE 2026 PLEASE SEE MKP-11-DE-2000-PR-PID-020
- 12) P&T COMPENSATION FROM PI-2481, TI-2476
- 13) PV-2481 INCLUDES 3 NOISE REDUCTION DISKS, THE SIZE IS 16"-28" AND THE REDUCER CONSIDERED BY PIPING.

†GENERAL NOTE:  
LOW POINT DRAINS AND HIGH POINT VENT MUST BE ADDED DURING DETAILED ENGINEERING.

**REFERENCE DRAWINGS**

**SYMBOLS AND LEGENDS**


**KEY PLAN**

REV.	PURPOSE OF ISSUE	DATE	DESIGN	DRAW	CHECK	REVIEW	APPROVE
▲	As Built	30.04.2020	Wang Furu			Gao Zhihu	Liu Shengkol
▲	Approval for Construction	30.12.2019	Wang Furu			Gao Zhihu	Liu Shengkol
▲	Approval for Construction	06.11.2017	Wang Furu			Gao Zhihu	Liu Shengkol
▲	Approval for Construction	05.05.2017	Wang Furu			Gao Zhihu	Liu Shengkol
▲	Approval for Construction	22.03.2017	Wang Furu			Gao Zhihu	Liu Shengkol
▲	Approval for Construction	23.01.2017	Wang Furu			Gao Zhihu	Liu Shengkol
▲	Approval for Construction	28.12.2016	Wang Furu			Gao Zhihu	Liu Shengkol
▲	Approval for Construction	12.10.2016	Wang Furu			Gao Zhihu	Liu Shengkol
▲	Issued for Review	31.08.2016	Wang Furu			Gao Zhihu	Liu Shengkol
▲	Issued for Review	16.06.2016	Wang Furu			Gao Zhihu	Liu Shengkol
▲	Issued for Comments	29.04.2016	Wang Furu			Gao Zhihu	Liu Shengkol

OWNER: Middle East Kimiaye Pars Company


DESIGNER	HALDOR TOPSØE A/S	DOCUMENT NAME	GAS COOLING AND SEPARATION III PIPING AND INSTRUMENT DIAGRAM	NO. OF SHEETS	42	REV.	4
CONTRACTOR	TCC 中国天辰工程有限公司	CONTRACTOR DRAWING NO.	MKP-11-AS-2000-PS07-PID-016	CONTRACTOR	1341731	CONTRACTOR	P21
CONTRACTOR		SHEET	01	TOTAL	01		
CONTRACTOR		SUB-CONTRACTOR DRAWING NO.					
CONTRACTOR		SHEET		TOTAL			

PROJECT	MKP Methanol Project
UNIT	Reformer
PHASE	As Built Drawing
OWNER DWG NO.	MKP-11-AS-2000-PR-PID-016

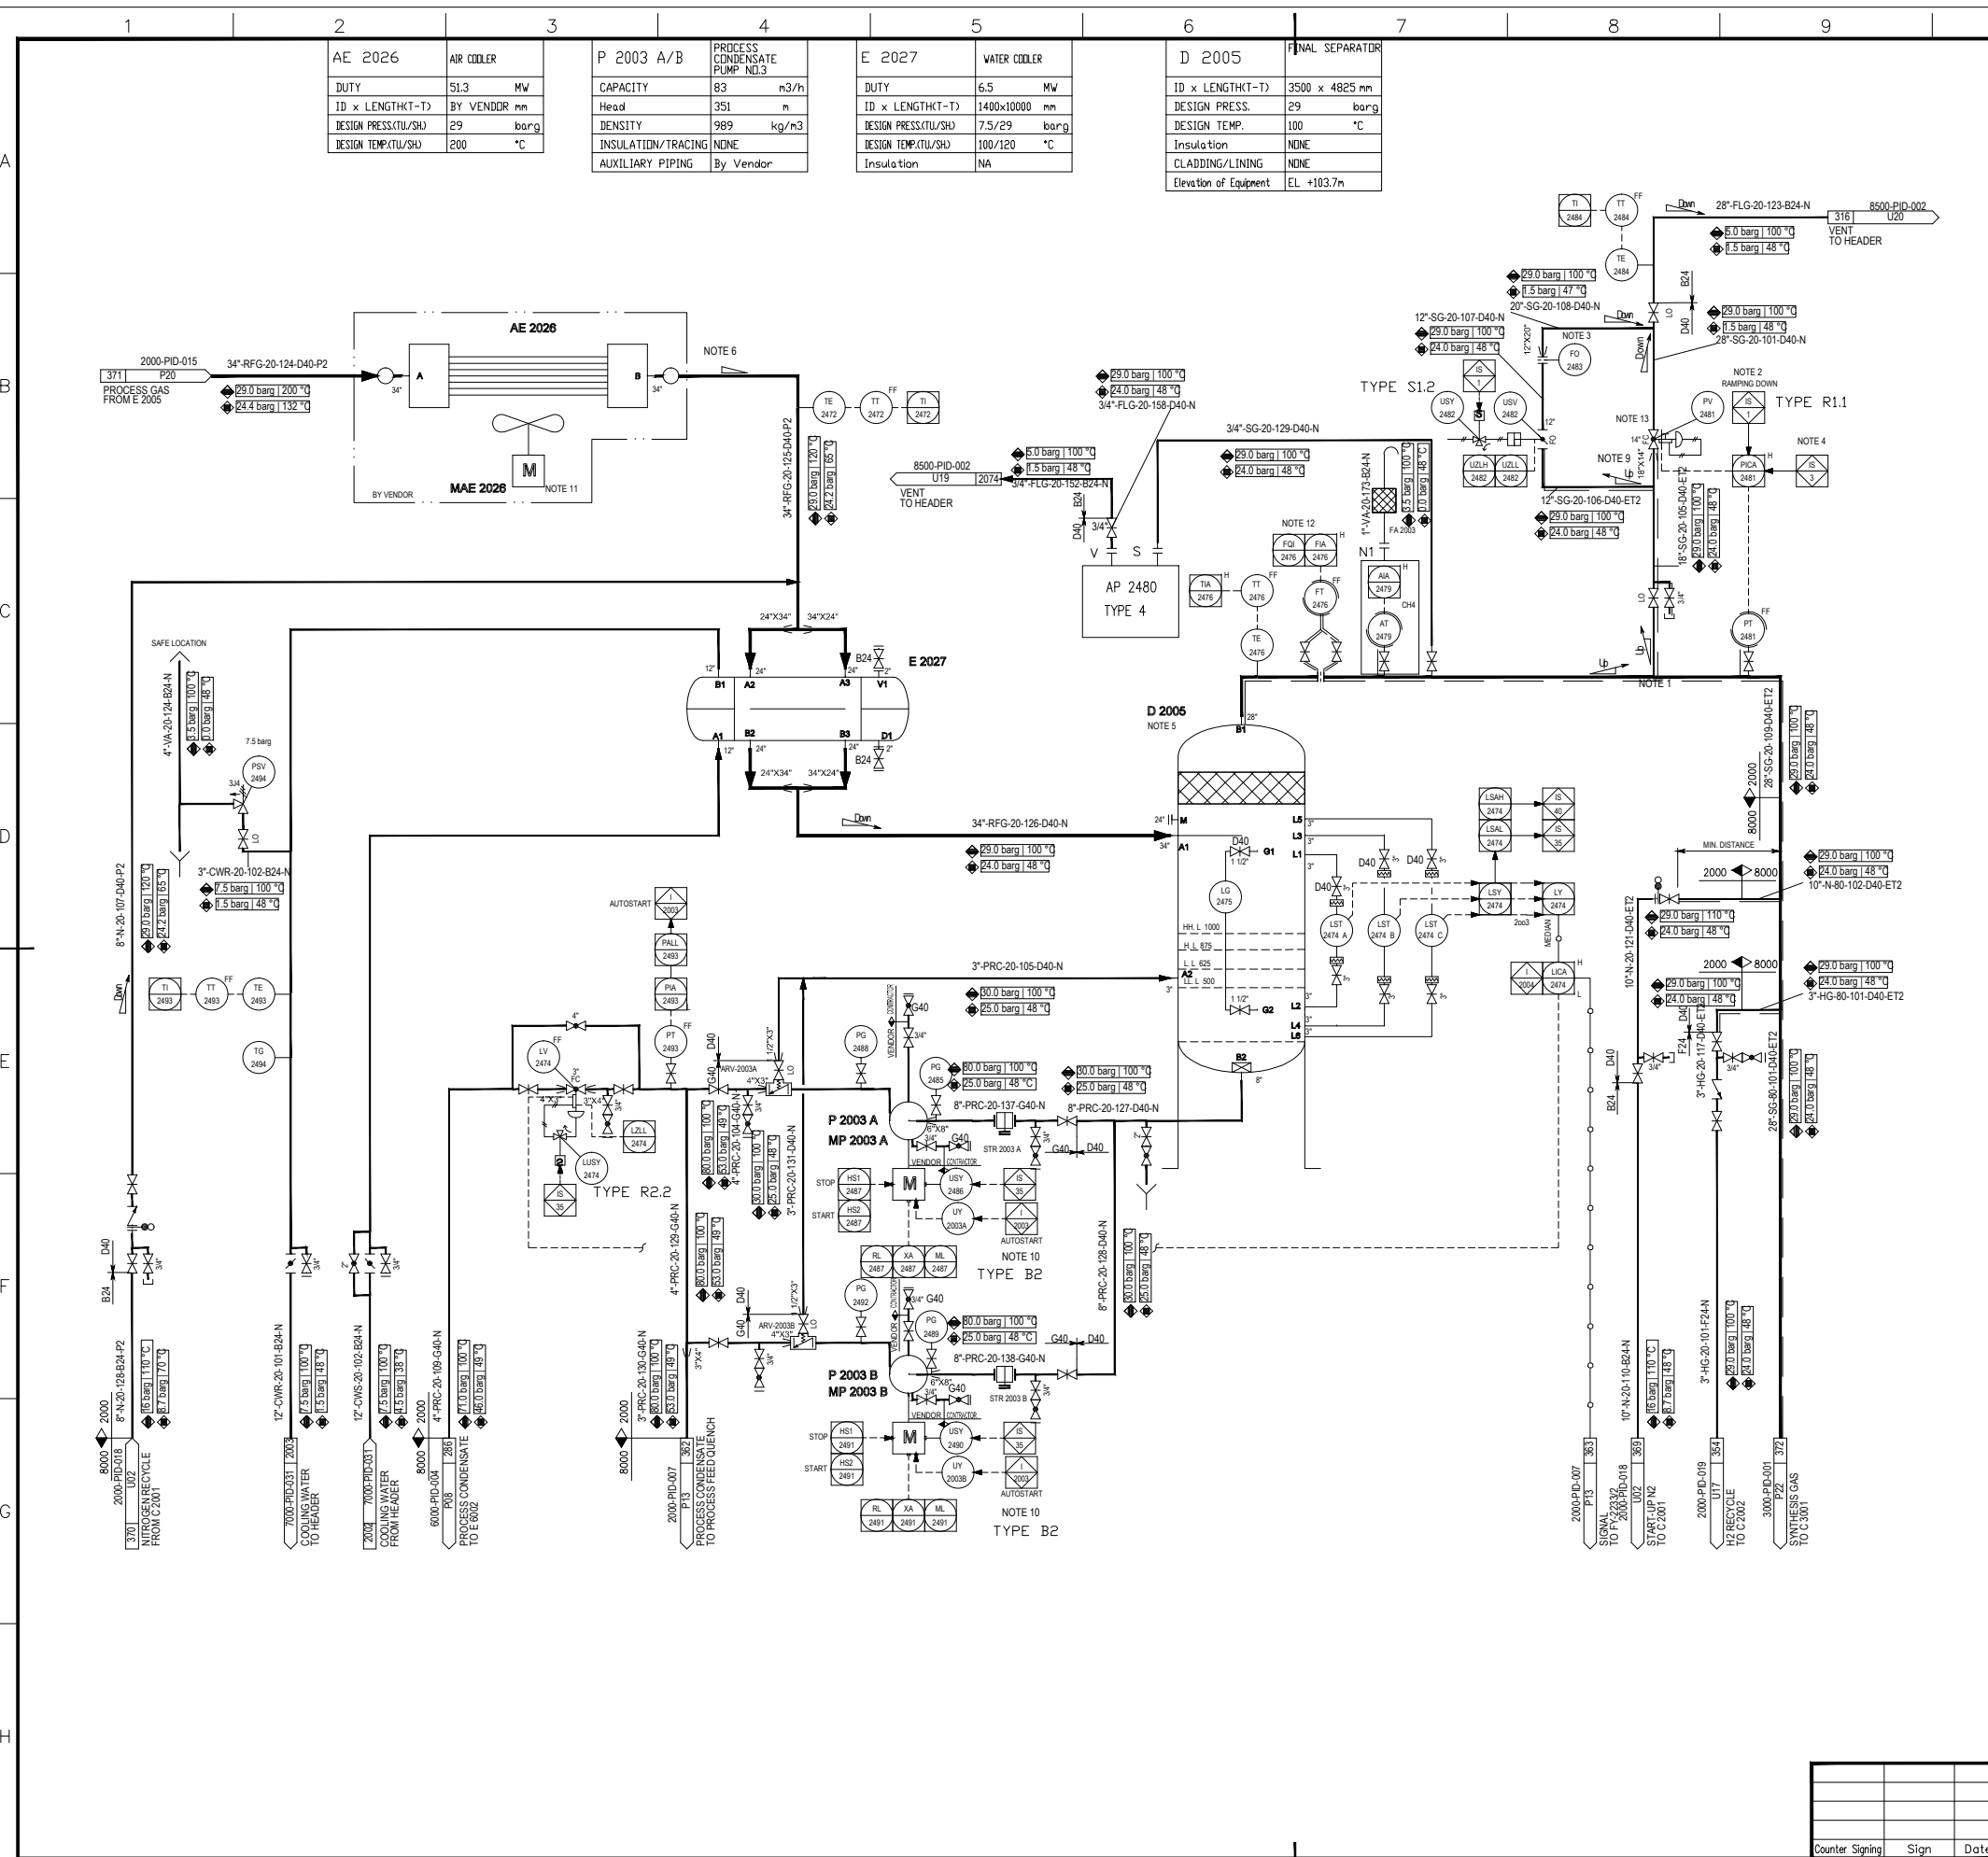

Counter Signing Sign Date

SCALE SHEET:1 TOT:1 SIZE:A1

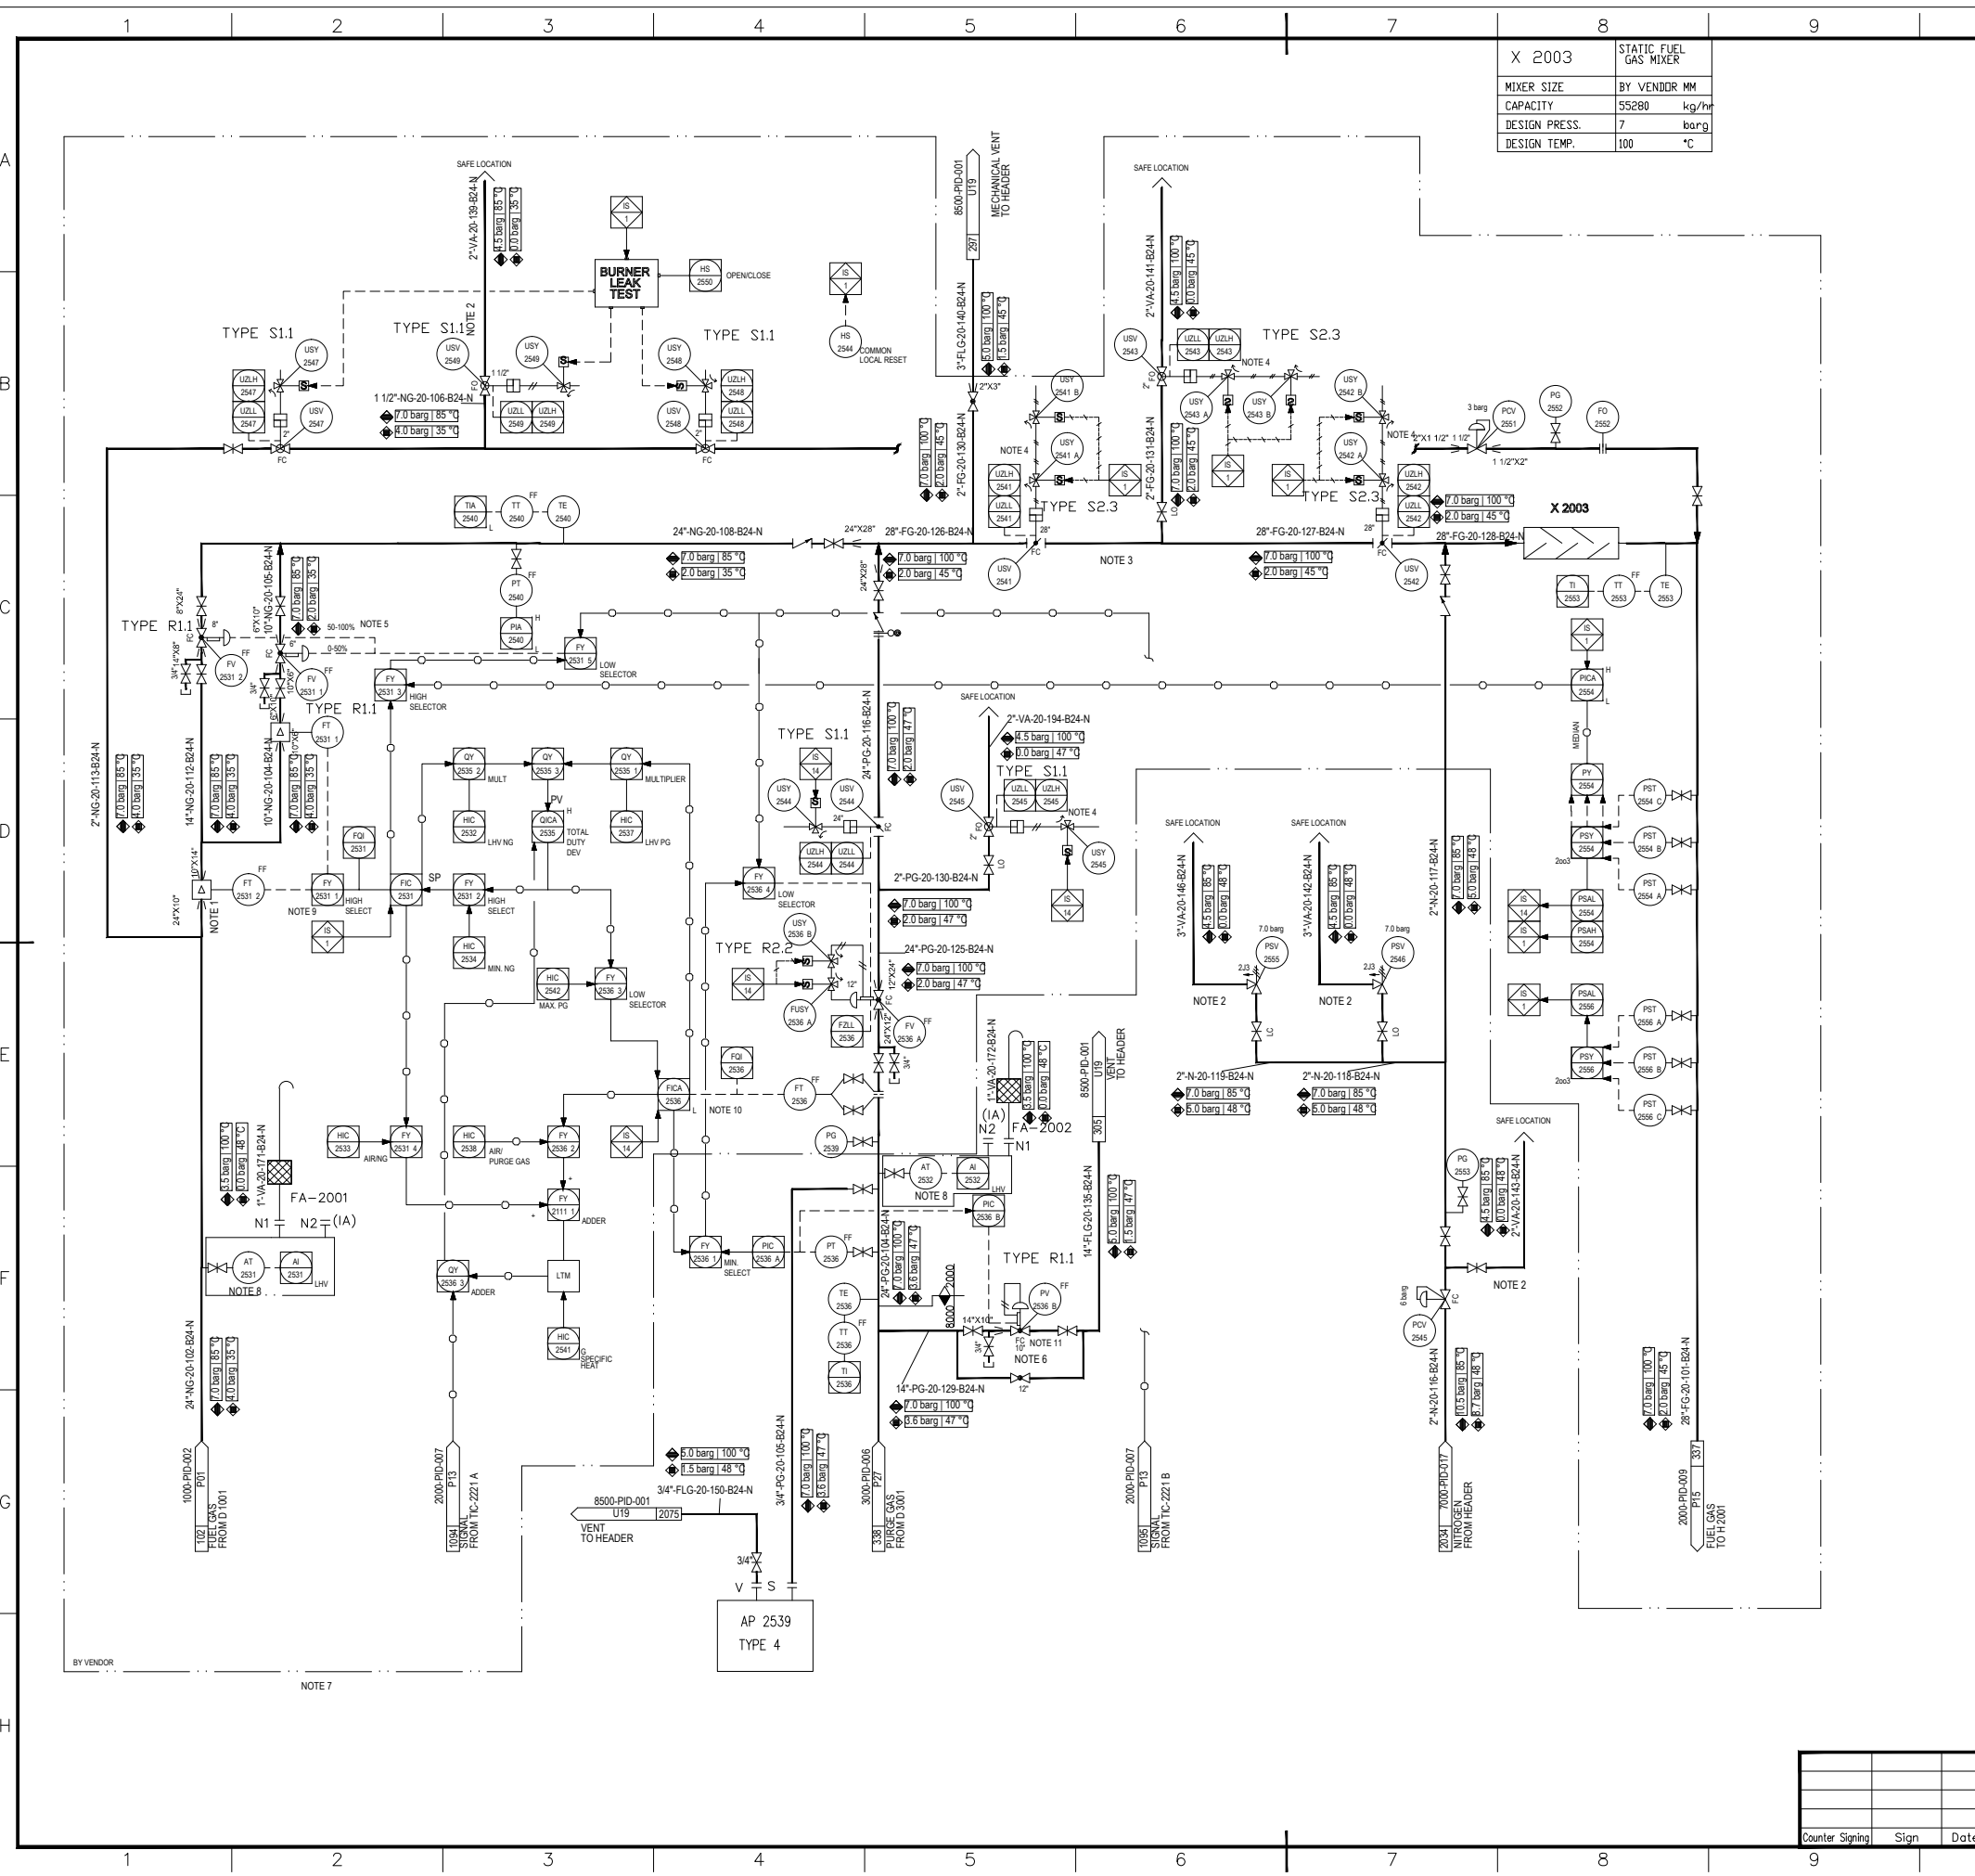

X 2003	STATIC FUEL GAS MIXER
MIXER SIZE	BY VENDOR MM
CAPACITY	55280 kg/hr
DESIGN PRESS.	7 barg
DESIGN TEMP.	100 °C

**GENERAL NOTES**

- †NOTES:
- 1) MIN. DISTANCE BETWEEN FT-2531 AND PV-1011: 10 meter ALTERNATIVE INCREASE PIPE DIAMETER TO ACHIEVE IDENTICAL GAS VOLUME. REQUIREMENTS OF FLOW MEASURING EQUIPMENT MUST ALSO BE CONSIDERED.
  - 2) 1/2" DRIP HOLE TO BE DRILLED AT LOW POINT TO SAFE AND SUITABLE LOCATION.
  - 3) DISTANCE TO FURNACE TO BE MINIMIZED.
  - 4) SOLENOID VALVES TO BE IN 2oo2d CONFIGURATION FOR SAFETY AND AVAILABILITY.
  - 5)
- 
- 6) VALVE SIZE WILL BE CONFIRMED BY VENDOR.
  - 7) THE DESIGN SCOPE OF PRIMARY REFORMER VENDOR
  - 8) WHEN THERE IS NO INSTRUMENT AIR SUPPLY FOR THE ANALYZER AT-2531/AT-2532, THE LAST EFFECTIVE DATA SHALL BE RECORDED IN FCS.
  - 9) P&T COMPENSATION FROM PIC-1011, TI-1012
  - 10) P&T COMPENSATION FROM PIC-2536A, TI-2536
  - 11) PV-2536B includes 1 noise reduction disks, the size is 14" and the reducer considered by piping.
- †GENERAL NOTE:  
LOW POINT DRAINS AND HIGH POINT VENT MUST BE ADDED DURING DETAILED ENGINEERING.

**REFERENCE DRAWINGS**

**SYMBOLS AND LEGENDS**

**KEY PLAN**

As Built	30.04.2020	Wang Furu	Gao Zhihu	Liu Shengkol
Approval for Construction	30.12.2019	Wang Furu	Gao Zhihu	Liu Shengkol
Approval for Construction	06.11.2017	Wang Furu	Gao Zhihu	Liu Shengkol
Approval for Construction	05.05.2017	Wang Furu	Gao Zhihu	Liu Shengkol
Approval for Construction	22.03.2017	Wang Furu	Gao Zhihu	Liu Shengkol
Approval for Construction	23.01.2017	Wang Furu	Gao Zhihu	Liu Shengkol
Approval for Construction	12.10.2016	Wang Furu	Gao Zhihu	Liu Shengkol
Approval for Construction	31.08.2016	Wang Furu	Gao Zhihu	Liu Shengkol
Approval for Construction	16.06.2016	Wang Furu	Gao Zhihu	Liu Shengkol
Issued for Comments	29.04.2016	Wang Furu	Gao Zhihu	Liu Shengkol


THIS DOCUMENT IS THE PROPERTY OF TCC. NO PART OF THIS DOCUMENT SHALL BE REPRODUCED OR DISCLOSED TO OTHERS OR USED FOR ANY PURPOSE WHATSOEVER EXCEPT WITH THE PRIOR WRITTEN PERMISSION OF TCC.

OWNER: Middle East Kimiaye Pars Company

OWNER	Middle East Kimiaye Pars Company
DESIGNER	HALDOR TOPSØE A/S
DOCUMENT NAME	FUEL SYSTEM PIPING AND INSTRUMENT DIAGRAM
PROJ NO	S-02115
CONTRACTOR	TCC 中国天辰工程有限公司
CONTRACTOR DRAWING NO.	MKP-11-AS-2000-PS09-PID-001
SHEET NO	01
TOTAL SHEETS	01
SCALE	SHEET:1 TOT:1 SIZE: A1
PROJECT	MKP Methanol Project
UNIT	Reformer
PHASE	As Built Drawing
OWNER DWG NO.	MKP-11-AS-2000-PR-PID-017

Counter Sign Sign Date



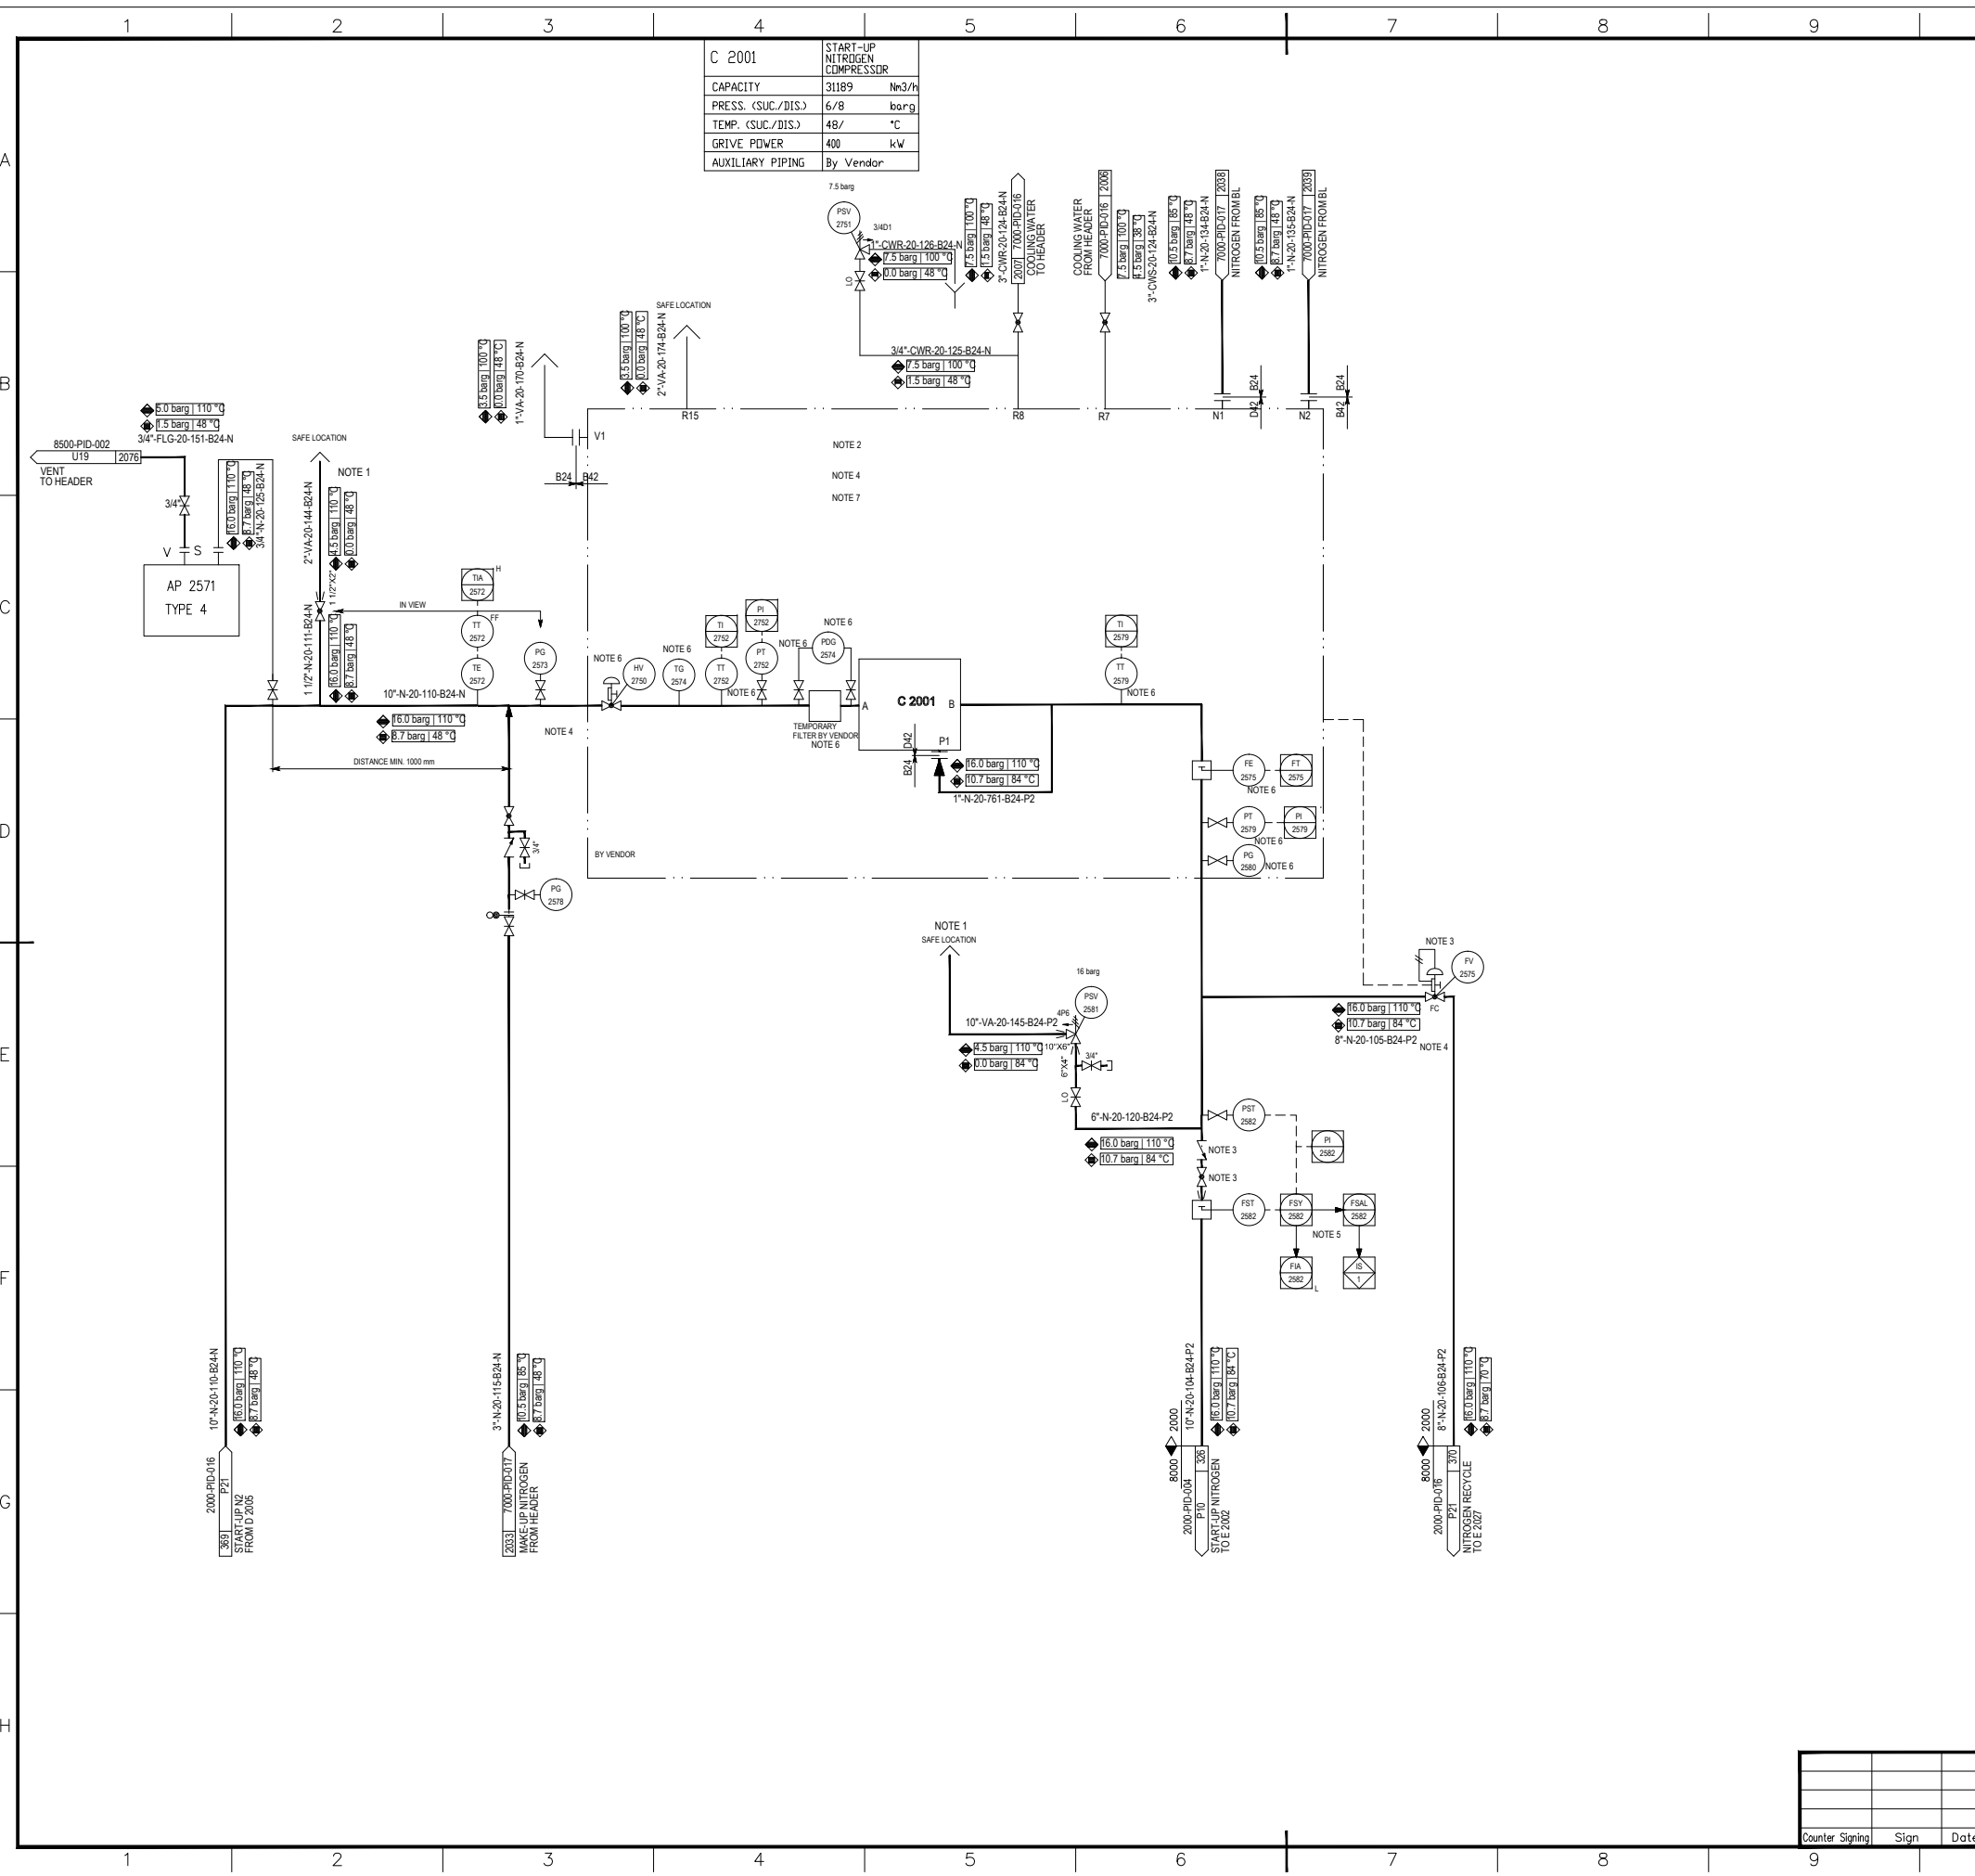

<b>C 2001</b>	START-UP NITROGEN COMPRESSOR
CAPACITY	3189 Nm <sup>3</sup> /h
PRESS. (SUC./DIS.)	6/8 barg
TEMP. (SUC./DIS.)	48/ °C
DRIVE POWER	400 kW
AUXILIARY PIPING	By Vendor

**GENERAL NOTES**

- †NOTES:
- 1) 1/2" DRIP HOLE TO BE DRILLED AT LOW POINT TO SAFE AND SUITABLE LOCATION.
  - 2) DETAILS BY VENDOR.
  - 3) THE FV-2575 BLOCK VALVE AND CHECK VALVE WILL BE SUPPLIED BY C 2001 VENDOR LOOSE.
  - 4) THE PROCESS NITROGEN PIPE CONNECTING WITH INLET AND OUTLET OF C 2001 IS SUPPLIED BY TCC
  - 5) PRESSURE COMPENSATION FROM PT-2582.
  - 6) THE TEMPERATURE INDICATOR/GAUGE (TG-2574/TI-2752/2579), THE PRESSURE INDICATOR/GAUGE (PI-2752/PT-2579/PC-2580), THE FLOWMETER/FT-2575, THE DIFFERENTIAL PRESSURE GAUGE (PDG-2574) AND TEMPORARY FILTER ARE SUPPLIED BY C2001 VENDOR.
  - 7) PLEASE FIND VENDOR DOCUMENT FOR DETAILS.
- †GENERAL NOTE:
- LOW POINT DRAINS AND HIGH POINT VENT MUST BE ADDED DURING DETAILED ENGINEERING.

**REFERENCE DRAWINGS**

**SYMBOLS AND LEGENDS**

**KEY PLAN**

▲	As Built	30.04.2020	Wang Furu	Gao Zhihui	Liu Shengkol
▲	Approval for Construction	30.12.2019	Wang Furu	Gao Zhihui	Liu Shengkol
▲	Approval for Construction	02.02.2018	Wang Furu	Gao Zhihui	Liu Shengkol
▲	Approval for Construction	06.11.2017	Wang Furu	Gao Zhihui	Liu Shengkol
▲	Approval for Construction	05.05.2017	Wang Furu	Gao Zhihui	Liu Shengkol
▲	Approval for Construction	22.03.2017	Wang Furu	Gao Zhihui	Liu Shengkol
▲	Approval for Construction	12.10.2016	Wang Furu	Gao Zhihui	Liu Shengkol
▲	Approval for Construction	31.08.2016	Wang Furu	Gao Zhihui	Liu Shengkol
▲	Approval for Construction	16.06.2016	Wang Furu	Gao Zhihui	Liu Shengkol
▲	Issued for Comments	29.04.2016	Wang Furu	Gao Zhihui	Liu Shengkol

THIS DOCUMENT IS THE PROPERTY OF TCC. NO PART OF THIS DOCUMENT SHALL BE REPRODUCED OR DISCLOSED TO OTHERS OR USED FOR ANY PURPOSE WHATSOEVER EXCEPT WITH THE PRIOR WRITTEN PERMISSION OF TCC.

OWNER:

Middle East Kimiaye Pars Company

DESIGNER	HALDOR TOPSØE A/S	DOCUMENT NAME	START-UP BLOWER PIPING AND INSTRUMENT DIAGRAM	JOB NO.	S-02115	CDR	42	REV.	3	
CONTRACTOR	中国天辰工程有限公司	CONTRACTOR DRAWING NO.	MKP-11-AS-2000-PS09-PIB-002	DWG NO.	1341758	SCALE	U02			
		SUB-CONTRACTOR DRAWING NO.				SHEET		01	TOTAL	01
		SHEET				SHEET		-	TOTAL	-

PROJECT	MKP Methanol Project
UNIT	Reformer
PHASE	As Built Drawing
OWNER DWG NO.	MKP-11-AS-2000-PR-PIB-018


Counter	Sign	Date

SCALE	SHEET:1	TOT:1	SIZE: A1
-------	---------	-------	----------

1 2 3 4 5 6 7 8 9 10 11 12

A  
B  
C  
D  
E  
F  
G  
H

C 2002	HYDROGEN RECYCLE COMPRESSOR
CAPACITY	5078 Nm <sup>3</sup> /h
PRESS. (SUC./DIS.)	24/50.4 barg
TEMP. (SUC./DIS.)	48/ °C
DRIVE POWER	200 kW
AUXILIARY PIPING	By Vendor

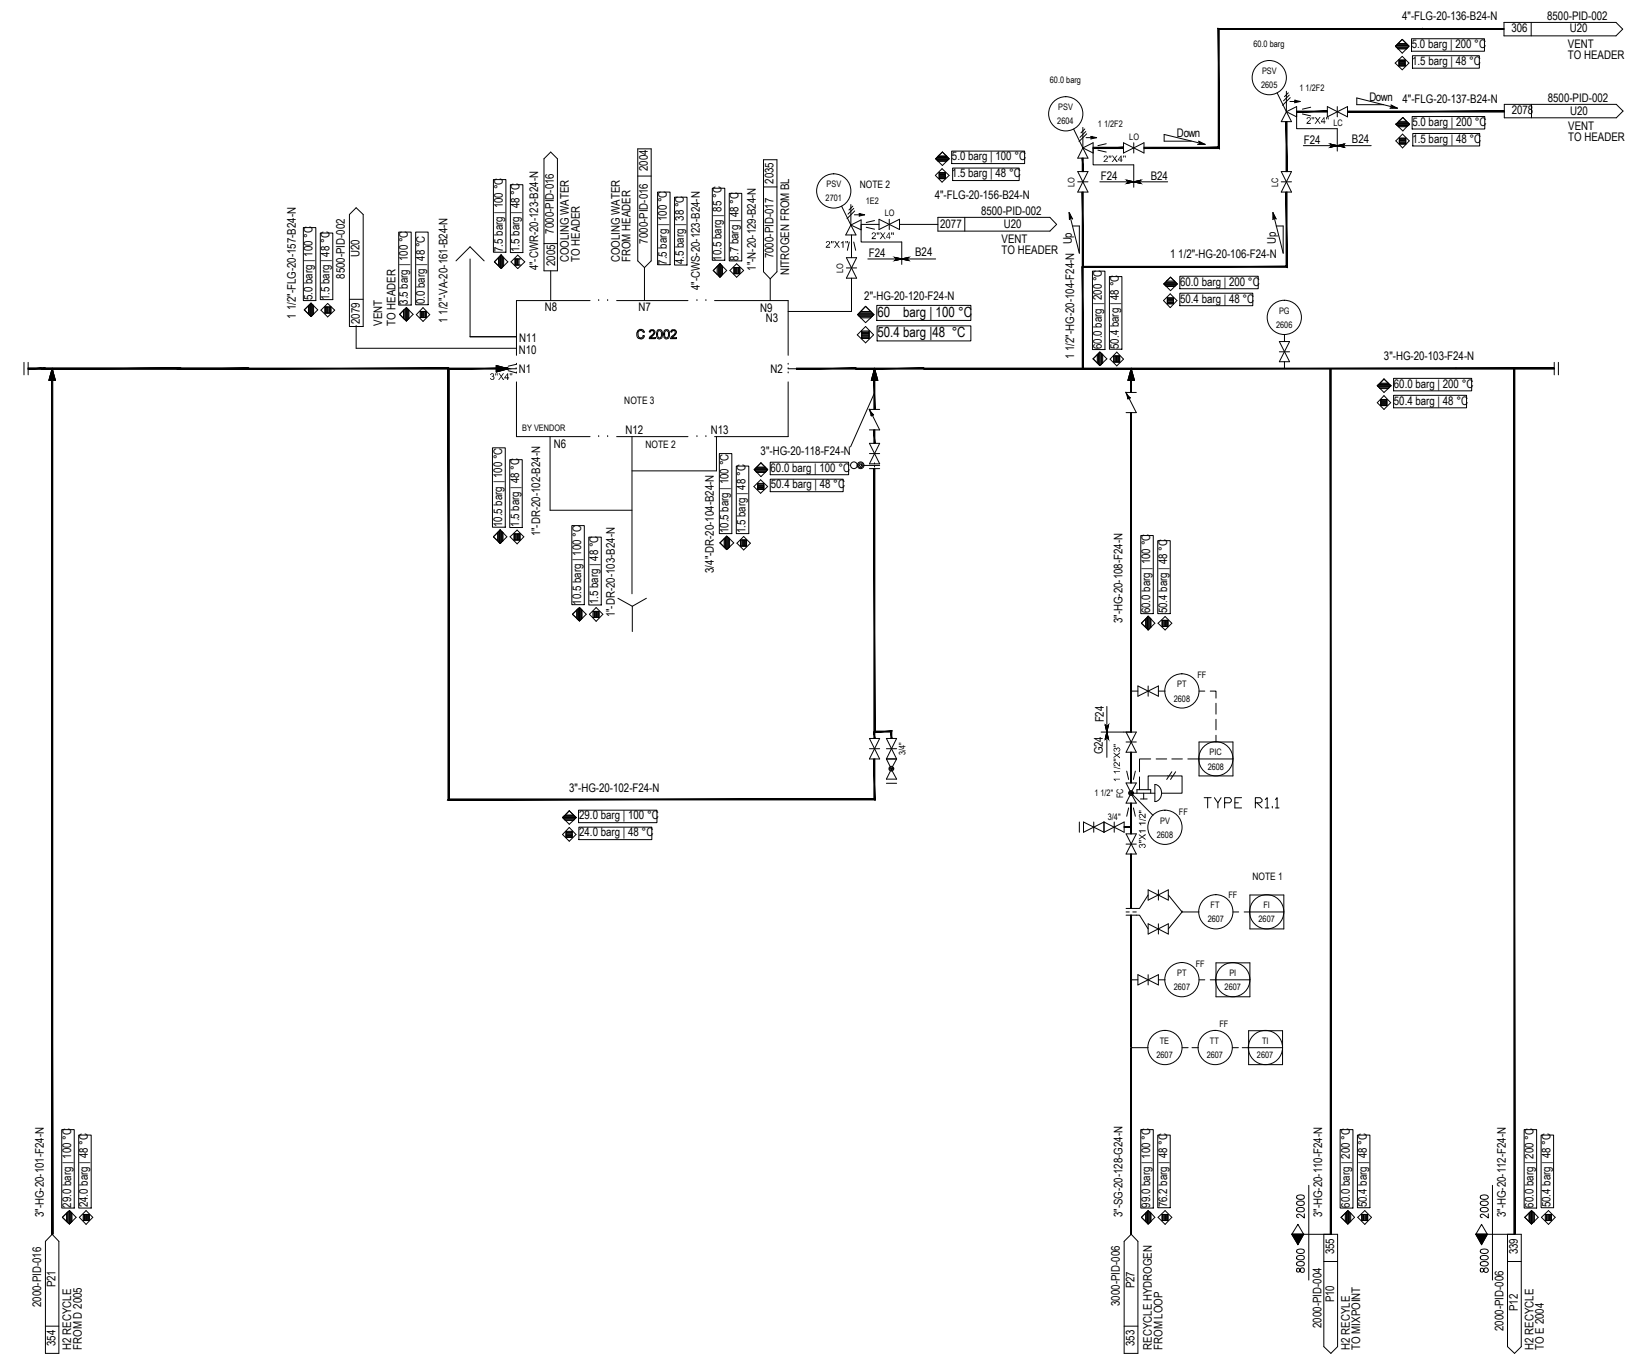

GENERAL NOTES

- \*NOTES:
- 1) P&T COMPENSATION FROM PI-2607, TI-2607
  - 2) PSV-2701 IS SUPPLIED BY C2002 VENDOR
  - 3) PLEASE FIND VENDOR DOCUMENT FOR DETAILS.
- +GENERAL NOTE:
- LOW POINT DRAINS AND HIGH POINT VENT MUST BE ADDED DURING DETAILED ENGINEERING.

REFERENCE DRAWINGS

SYMBOLS AND LEGENDS

KEY PLAN

REV.	PURPOSE OF ISSUE	DATE	DESIGN	DRAW	CHECK	REVIEW	APPROVE
▲	As Built	30.04.2020	Wang Furu		Gao Zhihu	Liu Shengke	
▲	Approval for Construction	30.12.2019	Wang Furu		Gao Zhihu	Liu Shengke	
▲	Approval for Construction	02.02.2018	Wang Furu		Gao Zhihu	Liu Shengke	
▲	Approval for Construction	06.11.2017	Wang Furu		Gao Zhihu	Liu Shengke	
▲	Approval for Construction	05.05.2017	Wang Furu		Gao Zhihu	Liu Shengke	
▲	Approval for Construction	22.03.2017	Wang Furu		Gao Zhihu	Liu Shengke	
▲	Approval for Construction	23.01.2017	Wang Furu		Gao Zhihu	Liu Shengke	
▲	Approval for Construction	10.11.2016	Wang Furu		Gao Zhihu	Liu Shengke	
▲	Approval for Construction	12.10.2016	Wang Furu		Gao Zhihu	Liu Shengke	
▲	Approval for Construction	31.08.2016	Wang Furu		Gao Zhihu	Liu Shengke	
▲	Approval for Construction	16.06.2016	Wang Furu		Gao Zhihu	Liu Shengke	
▲	Issued for Comments	29.04.2016	Wang Furu		Gao Zhihu	Liu Shengke	

THIS DOCUMENT IS THE PROPERTY OF TCC. NO PART OF THIS DOCUMENT SHALL BE REPRODUCED OR DISCLOSED TO OTHERS OR USED FOR ANY PURPOSE WHATSOEVER EXCEPT WITH THE PRIOR WRITTEN PERMISSION OF TCC.

OWNER:

**Middle East  
Kimiaye Pars Company**

	DOCUMENT NAME <b>H2 RECYCLE SYSTEM PIPING AND INSTRUMENT DIAGRAM</b>	JOB NO. <b>S-02115</b>	SHEET NO. <b>42</b>	REV. <b>2</b>
	CONTRACTOR 	DRAWING NO. <b>1341773</b>	DATE <b>03/08/20</b>	U17
CONTRACTOR DRAWING NO. <b>MKP-11-AS-2000-PS09-PID-003</b>		SHEET 01 TOTAL 01		
SUB-CONTRACTOR DRAWING NO.		SHEET -- TOTAL --		


H2 RECYCLE SYSTEM PIPING AND INSTRUMENT DIAGRAM		PROJECT MKP Methanol Project
SCALE SHEET:1 TOT:1 SIZE: A1		UNIT Reformer
OWNER DWG NO. MKP-11-AS-2000-PR-PID-019		PHASE As Built Drawing

Counter	Sign	Date

1 2 3 4 5 6 7 8 9 10 11 12


L 2004	CANTILEVER CRANE
TYPE	COLUMN CANTILEVER
CAPACITY	1 t
LIFT HEIGHT	20 m
SLIDING DISTANCE	1.8 m

AE 2026	AIR COOLER
DUTY	5L3 MW
ID x LENGTH(T)	BY VENDOR mm
DESIGN PRESS.(TLU/SH)	29 barg
DESIGN TEMP.(TLU/SH)	200 °C

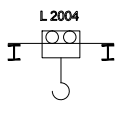

**GENERAL NOTES**

- \*NOTES:
- 1) THERMOWELL LABEL IS SHOWN BELOW (ONE TW FOR EACH TUBE BOX OUTLET):
- |                                     |
|-------------------------------------|
| MAE2026A MAE2026B MAE2026G MAE2026H |
| B1 TW2473A B13 TW2473G              |
| B3 TW2473B B15 TW2473H              |
| MAE2026C MAE2026D MAE2026E MAE2026J |
| B5 TW2473C B17 TW2473I              |
| B7 TW2473D B19 TW2473J              |
| MAE2026K MAE2026F MAE2026L MAE2026M |
| B9 TW2473E B21 TW2473K              |
| B11 TW2473F B23 TW2473L             |
- 2) CANTILEVER CRANE IS USED FOR AE-2026 MAINTENANCE.

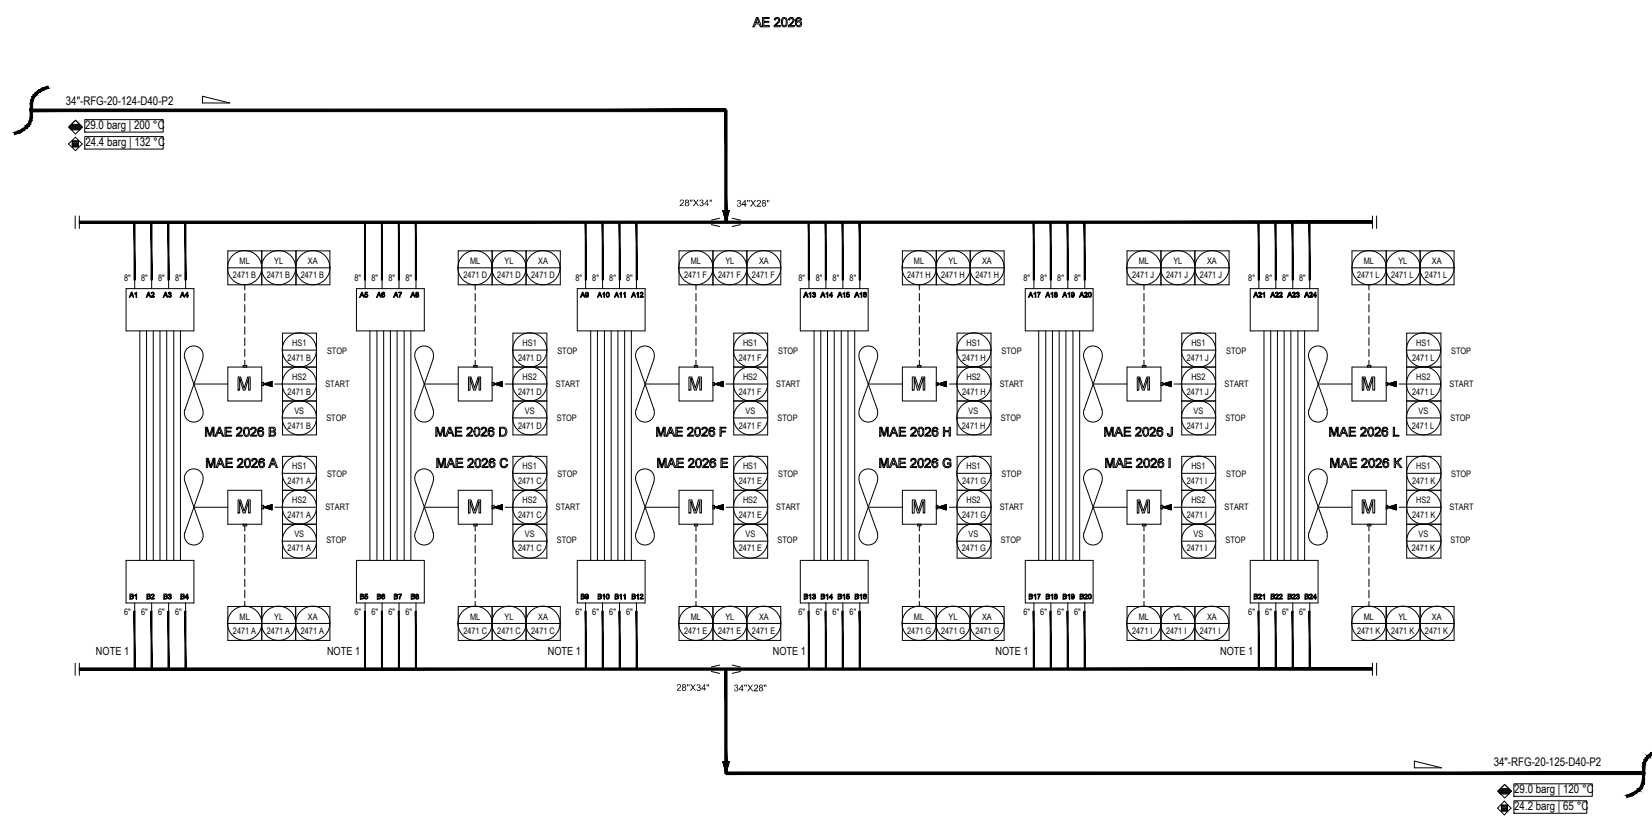

**REFERENCE DRAWINGS**

**SYMBOLS AND LEGENDS**

**KEY PLAN**

REV.	PURPOSE OF ISSUE	DATE	DESIGN	DRAW	CHECK	REVIEW	APPROVE
▲	As Built	30.04.2020	Wang Furu		Gao Zhihu	Liu Shengkol	
▲	Approval for Construction	05.05.2017	Wang Furu		Gao Zhihu	Liu Shengkol	
▲	Approval for Construction	22.03.2017	Wang Furu		Gao Zhihu	Liu Shengkol	
▲	Approval for Construction	23.01.2017	Wang Furu		Gao Zhihu	Liu Shengkol	
▲	Issued for Review	28.12.2016	Wang Furu		Gao Zhihu	Liu Shengkol	
▲	Issued for Review	12.10.2016	Wang Furu		Gao Zhihu	Liu Shengkol	
▲	Issued for Comments	31.08.2016	Wang Furu		Gao Zhihu	Liu Shengkol	


THIS DOCUMENT IS THE PROPERTY OF TCC. NO PART OF THIS DOCUMENT SHALL BE REPRODUCED OR DISCLOSED TO OTHERS OR USED FOR ANY PURPOSE WHATSOEVER EXCEPT WITH THE PRIOR WRITTEN PERMISSION OF TCC.

OWNER: Middle East Kimiaye Pars Company

OWNER	DOCUMENT NAME	JOB NO.	SCALE	REV.
CONTRACTOR	TCC 中国天辰工程有限公司	CONTRACTOR DRAWING NO.		
CONTRACTOR	CHINA TIANCHEN ENGINEERING CORPORATION	MKP-11-AS-2000-PS07-PID-017		
		SHEET 01 TOTAL 01		
		SUB-CONTRACTOR DRAWING NO.		
		SHEET -- TOTAL --		

PROJECT	MKP Methanol Project
UNIT	Reformer
PHASE	As Built Drawing
OWNER DWG NO.	MKP-11-AS-2000-PR-PID-020

Counter	Sign	Date

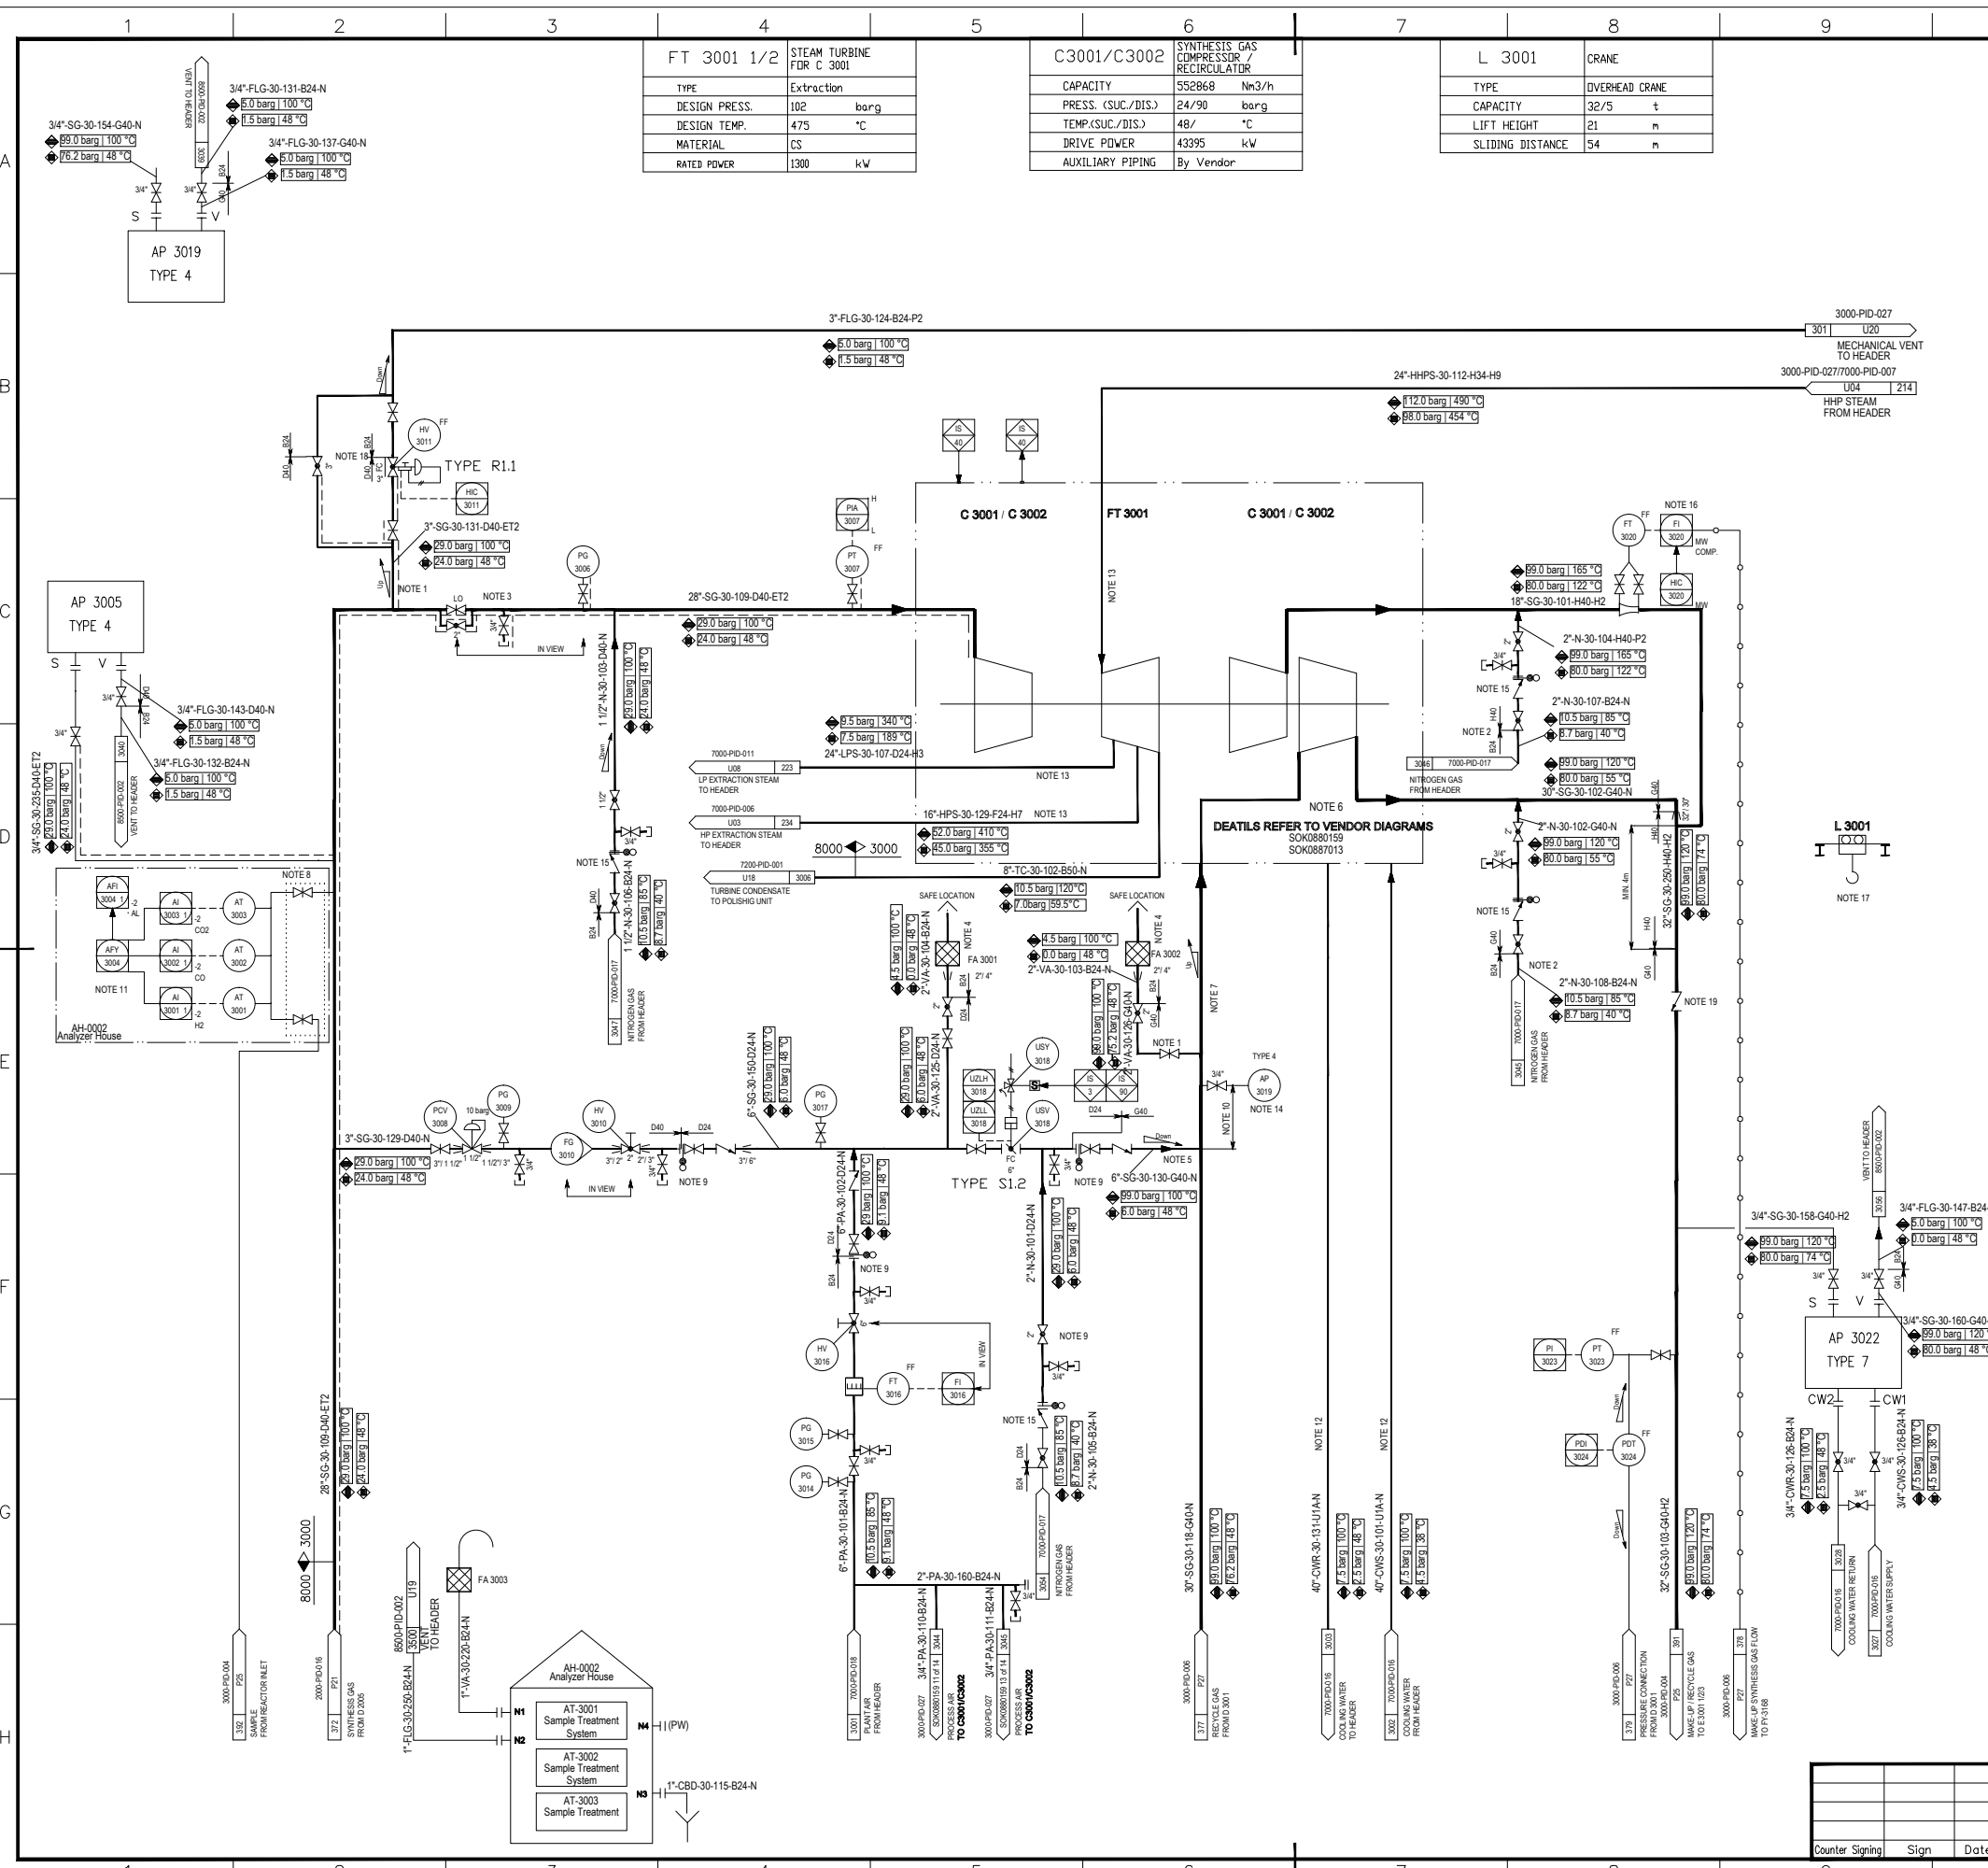

FT 3001 1/2	STEAM TURBINE FOR C 3001
TYPE	Extraction
DESIGN PRESS.	102 barg
DESIGN TEMP.	475 °C
MATERIAL	CS
RATED POWER	1300 kW

C3001/C3002	SYNTHESIS GAS COMPRESSOR / RECIRCULATOR
CAPACITY	552868 Nm <sup>3</sup> /h
PRESS. (SUC./DIS.)	24/90 barg
TEMP.(SUC./DIS.)	48/ °C
DRIVE POWER	43395 kW
AUXILIARY PIPING	By Vendor

L 3001	CRANE
TYPE	DVERHEAD CRANE
CAPACITY	32/5 t
LIFT HEIGHT	21 m
SLIDING DISTANCE	54 m

**GENERAL NOTES**

- NOTES:
- PURGE POINT TO BE LOCATED AS CLOSE AS POSSIBLE TO COMPRESSOR BLOCK VALVE.
  - FOR PRESSURIZING LOOP AT START-UP AND FOR PURGING TO BE LOCATED AS CLOSE AS POSSIBLE TO COMPRESSOR BLOCK VALVE.
  - BLOCK VALVES TO BE LOCATED AS CLOSE AS POSSIBLE TO COMPRESSOR SHUT-OFF VALVE. PIPING CLASS DOWNSTREAM BLOCK VALVES TO BE CONFIRMED BY COMPRESSOR VENDOR.
  - 1/2" DRIP HOLE TO BE DRILLED AT LOW POINT TO SAFE AND SUITABLE LOCATION.
  - TOP ENTRY CONNECTION.
  - SAFETY VALVE ON COOLING WATER TO BE INCLUDED IN VENDOR SCOPE.
  - SLOPE REQUIREMENT MUST BE FULFILLED. IF THIS IS NOT POSSIBLE, EL TRACED.
  - AUTOMATIC MANIFOLD.
  - FIGURE-8 TYPE BLIND TO BE TURNED TO NORMALLY CLOSED POSITION BEFORE STARTING LOOP PRESURISATION.
  - AP-3019 MUST BE LOCATED AT A DISTANCE OF MINIMUM 20 X PIPE DIAMETER FROM SG-30-130.
  - AFY-3004: MODULE =  $\frac{H_2-CO_2}{CO-CO_2}$
  - TO BE CONFIRMED BY COMPRESSOR VENDOR.
  - PIPE SIZE MUST BE CONFIRMED BY TURBINE VENDOR.
  - THE SAMPLING POINT IS SHOWN IN THE TOP LEFT CORNER OF THIS PAGE.
  - THE DISTANCE BETWEEN CHECK VALVE AND THE CONNECTED MAIN PIPE SHOULD BE MINIMIZED.
  - P&T COMPENSATION FROM PI-3023, T FROM TT 3719 (COMPRESSOR PACKAGE), MW COMPENSATION FROM FIC-020.
  - CRANE IS USED FOR COMPRESSOR AND TURBINE MAINTENANCE.
  - HV-3011 INCLUDES 1 NOISE REDUCTION DISKS, THE SIZE IS 3" AND THE REDUCER CONSIDERED BY PIPING.
  - INTERNAL INSPECTION AND MAINTENANCE ARE NEEDED FOR THE CHECK VALVE ACCORDING TO THE REQUIREMENT OF API 521.
- GENERAL NOTE:  
 LOW POINT DRAINS AND HIGH POINT VENT MUST BE ADDED DURING DETAILED ENGINEERING.  
 ALL WELDING CONNECTION WITH SIZE GREATER THAN 2 INCHES SHALL BE BUTT WELDED TYPE UNLESS OTHERWISE SPECIFIED.  
 ALL VALVES GREATER THAN 2 INCHES SHALL BE FLANGED TYPE UNLESS OTHERWISE SPECIFIED.

**REFERENCE DRAWINGS**

**SYMBOLS AND LEGENDS**

**KEY PLAN**

REV.	PURPOSE OF ISSUE	DATE	DESIGN	DRAW	CHECK	REVIEW	APPROVE
▲	As Built	30.04.2020	Xu Jun		Mu Yujun	Hu Qiyi	
▲	Approved for Construction	30.12.2019	Xu Jun		Mu Yujun	Hu Qiyi	
▲	Approved for Construction	11.11.2018	Xu Jun		Mu Yujun	Hu Qiyi	
▲	Approved for Construction	02.02.2018	Xu Jun		Mu Yujun	Hu Qiyi	
▲	Approved for Construction	06.11.2017	Xu Jun		Mu Yujun	Hu Qiyi	
▲	Approved for Construction	18.05.2017	Li Zhijuan		Mu Yujun	Hu Qiyi	
▲	Approved for Construction	22.03.2017	Li Zhijuan		Mu Yujun	Hu Qiyi	
▲	Approved for Construction	22.01.2017	Li Zhijuan		Mu Yujun	Hu Qiyi	
▲	Approved for Construction	13.10.2016	Li Zhijuan		Mu Yujun	Hu Qiyi	
▲	Approved for Construction	31.08.2016	Li Zhijuan		Mu Yujun	Hu Qiyi	
▲	Issued for Review	25.06.2016	Li Zhijuan		Mu Yujun	Hu Qiyi	
▲	Issued for Comments	29.04.2016	Li Zhijuan		Mu Yujun	Hu Qiyi	


THIS DOCUMENT IS THE PROPERTY OF TCC. NO PART OF THIS DOCUMENT SHALL BE REPRODUCED OR DISCLOSED TO OTHERS OR USED FOR ANY PURPOSE WHATSOEVER EXCEPT WITH THE PRIOR WRITTEN PERMISSION OF TCC.

OWNER: **Middle East Kimiaye Pars Company**

DESIGNER	HALDOR TOPSØE A/S	DOCUMENT NAME	SYNTHESIS GAS COMPRESSOR PIPING AND INSTRUMENT DIAGRAM	PROJ NO	S-02115	REV	4
DRAWN BY		DATE	13/11/2016	ISSUED BY	P22		
CONTRACTOR	<b>TCC 中国天辰工程有限公司</b>	CONTRACTOR DRAWING NO.	MKP-11-AS-3000-PS07-PID-001	SHEET	01	TOTAL	01
SCALE		SUB-CONTRACTOR DRAWING NO.		SHEET		TOTAL	

PROJECT	MKP Methanol Project
UNIT	METHANOL SYNTHESIS
PHASE	As Built Drawing
OWNER DWG NO.	MKP-11-AS-3000-PR-PID-001



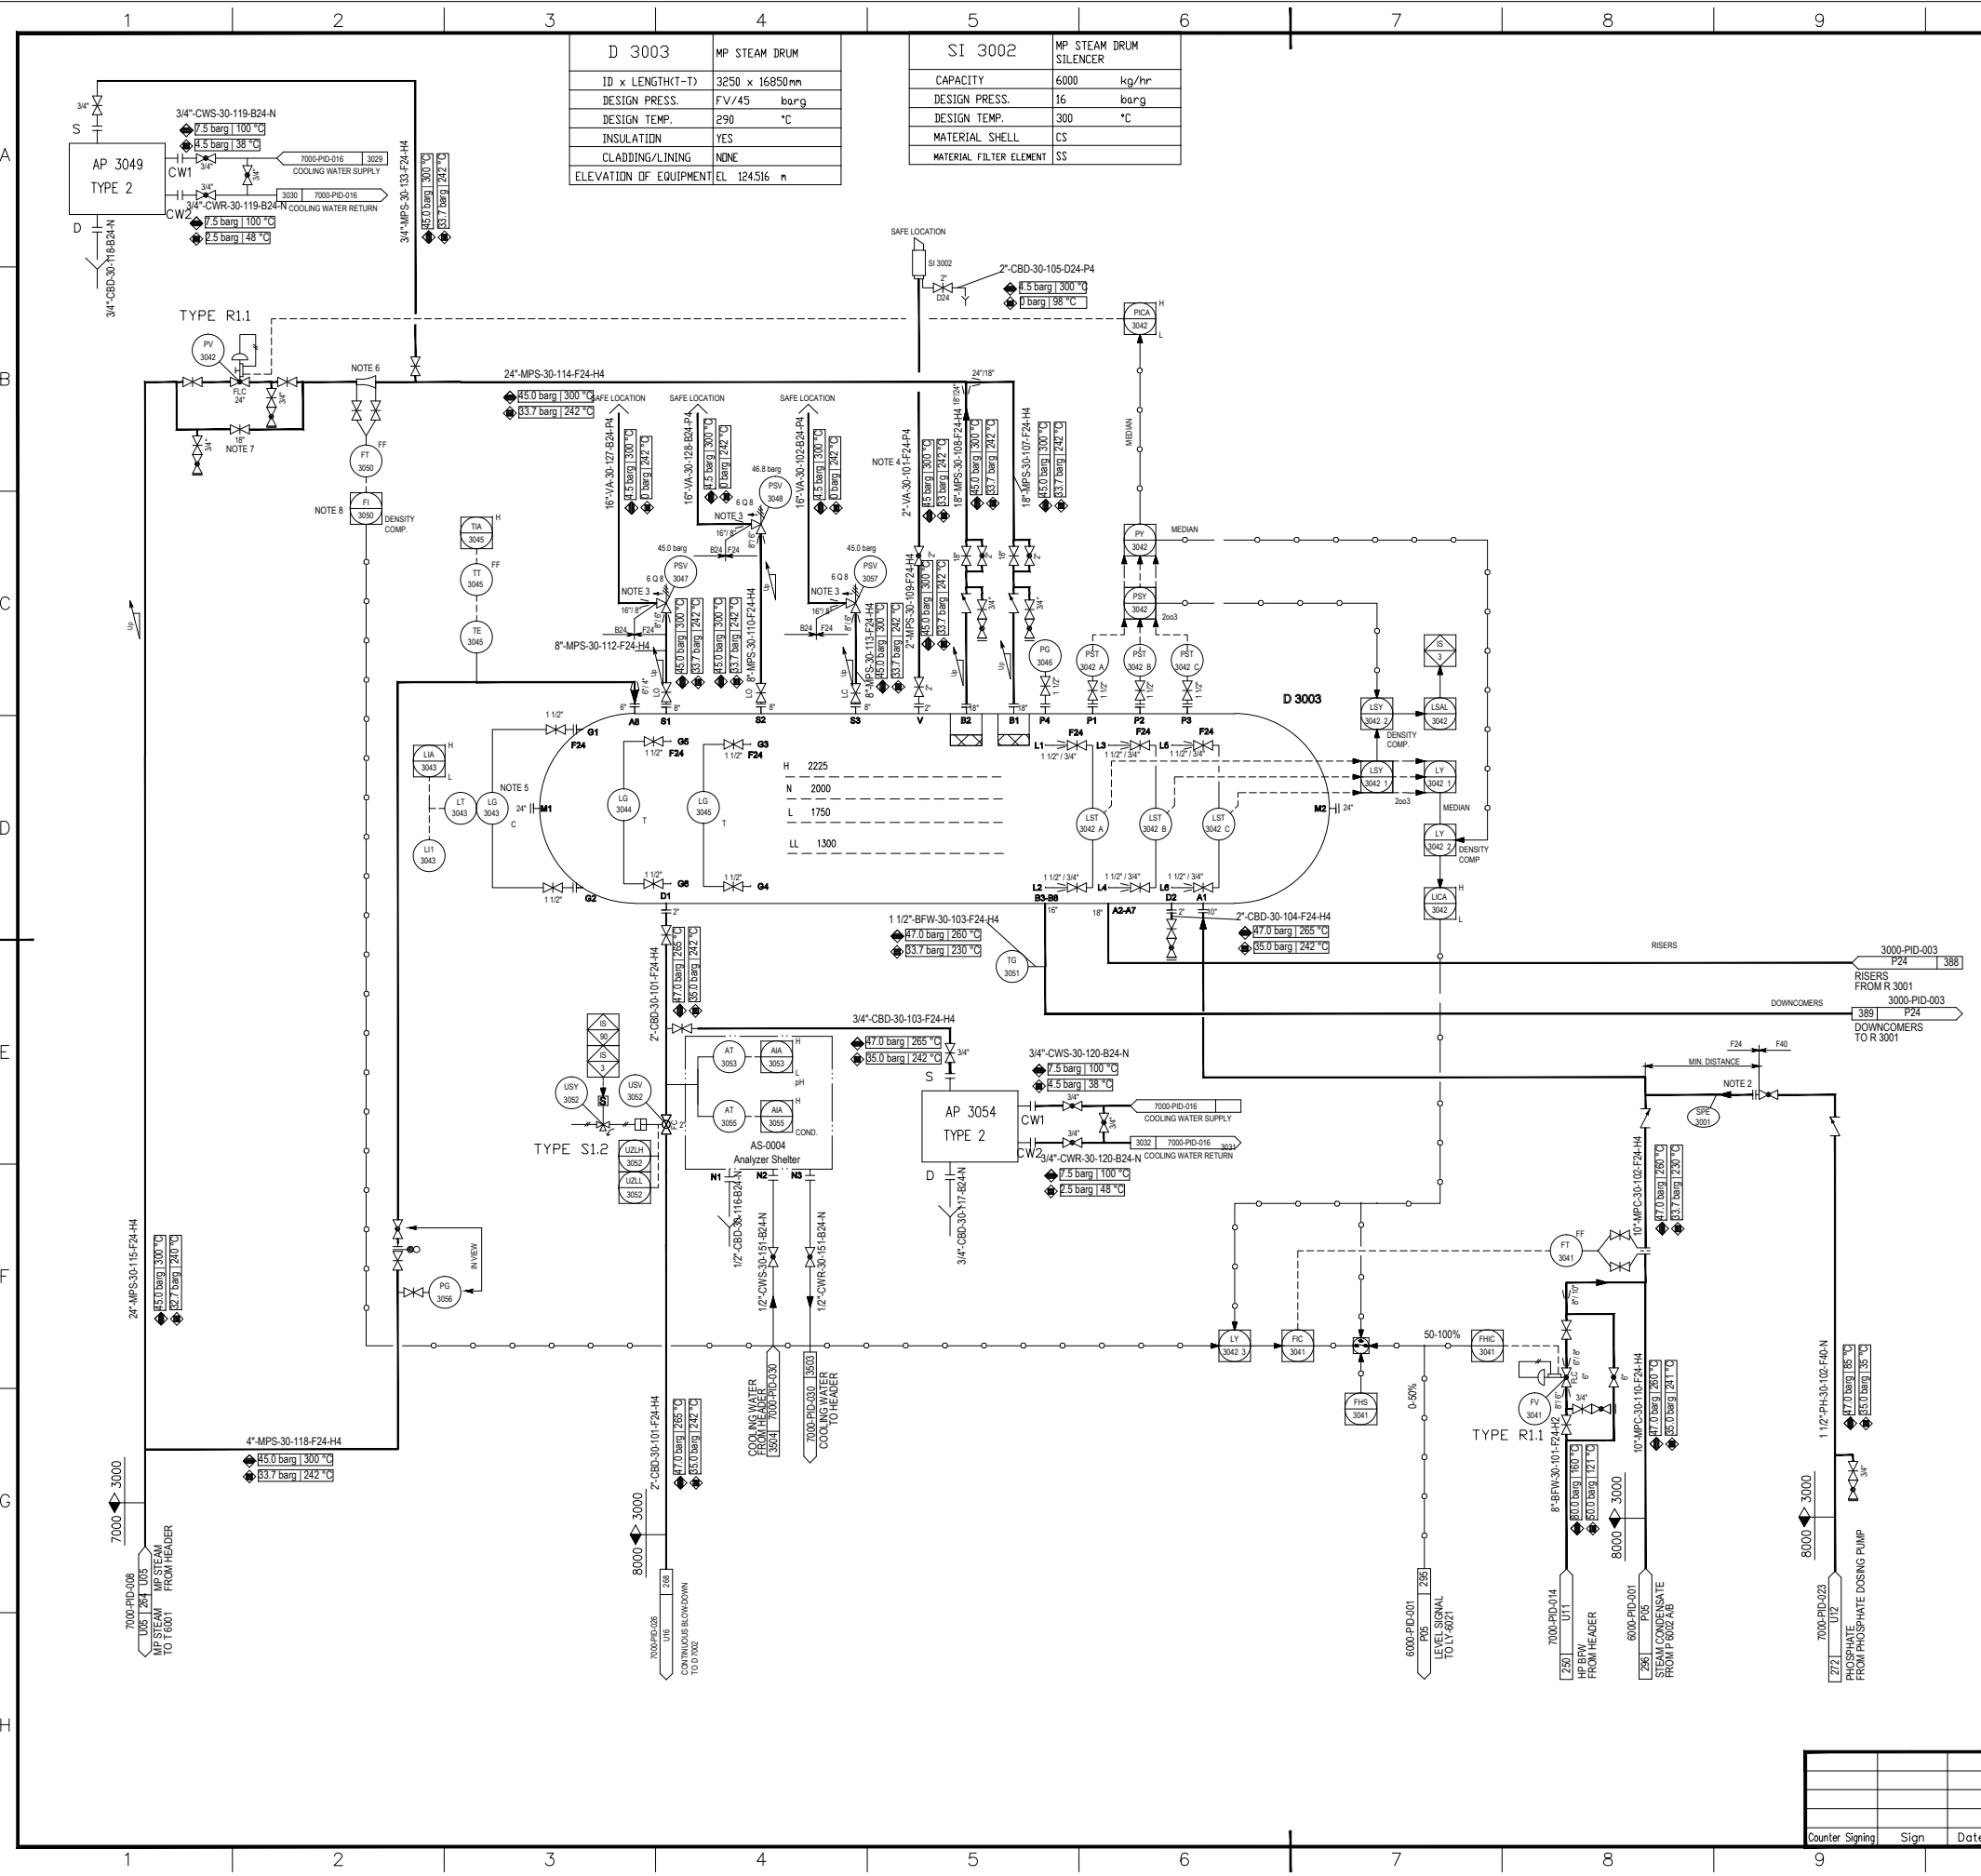

D 3003		MP STEAM DRUM	
ID x LENGTH(T)	3250 x 16850 mm	CAPACITY	6000 kg/hr
DESIGN PRESS.	FV/45 barg	DESIGN PRESS.	16 barg
DESIGN TEMP.	290 °C	DESIGN TEMP.	300 °C
INSULATION	YES	MATERIAL SHELL	CS
CLADDING/LINING	NONE	MATERIAL FILTER ELEMENT	SS
ELEVATION OF EQUIPMENT	EL 124516 m		

SI 3002		MP STEAM DRUM SILENCER	
CAPACITY	6000 kg/hr		
DESIGN PRESS.	16 barg		
DESIGN TEMP.	300 °C		
MATERIAL SHELL	CS		
MATERIAL FILTER ELEMENT	SS		

**GENERAL NOTES**

- †NOTES:
- 1) SWITCHING FHS-3041 (SYMBOLIC INDICATED) FROM 3-ELEMENT LEVEL CONTROL VIA FIC-3041 TO SINGLE ELEMENT LEVEL CONTROL IS DONE WITH AUTOMATIC CHANGE OF TUNING CONSTANTS IN LIC-3042.
  - 2) PHOSPHATE INJECTION CONNECTION.
- 
- 3) 1/2" DRIP HOLE TO BE DRILLED AT LOW POINT TO SAFE AND SUITABLE LOCATION.
  - 4) LINE SIZING BY SILENCER VENDOR.
  - 5) HYDRATEST WITH LOCAL INDICATOR AT GROUND LEVEL AND SIGNAL TO DCS.
  - 6) FLOW NOZZLE TO BE LOCATED ABOVE D 3003.
  - 7) EQUIPPED WITH GEAR BOX.
  - 8) P&T COMPENSATION FROM PIC-3042.
- †GENERAL NOTE:  
LOW POINT DRAINS AND HIGH POINT VENT MUST BE ADDED DURING DETAILED ENGINEERING.

**REFERENCE DRAWINGS**

**SYMBOLS AND LEGENDS**

**KEY PLAN**

REV.	PURPOSE OF ISSUE	DATE	DESIGN	DRAW	CHECK	REVIEW	APPROVE
▲	As Built	30.04.2020	Xu Jun		Mu Yujun	Hu Qiyi	
▲	Approved for Construction	30.12.2019	Xu Jun		Mu Yujun	Hu Qiyi	
▲	Approved for Construction	11.11.2018	Xu Jun		Mu Yujun	Hu Qiyi	
▲	Approved for Construction	06.11.2017	Xu Jun		Mu Yujun	Hu Qiyi	
▲	Approved for Construction	18.05.2017	Li Zhijuan		Mu Yujun	Hu Qiyi	
▲	Approved for Construction	22.03.2017	Li Zhijuan		Mu Yujun	Hu Qiyi	
▲	Approved for Construction	22.01.2017	Li Zhijuan		Mu Yujun	Hu Qiyi	
▲	Approved for Construction	13.10.2016	Li Zhijuan		Mu Yujun	Hu Qiyi	
▲	Approved for Construction	31.08.2016	Li Zhijuan		Mu Yujun	Hu Qiyi	
▲	Issued for Approval	25.06.2016	Li Zhijuan		Mu Yujun	Hu Qiyi	
▲	Issued for Comments	29.04.2016	Li Zhijuan		Mu Yujun	Hu Qiyi	

OWNER: Middle East Kimiaye Pars Company

DESIGNER	HALDOR TOPSØE A/S	DOCUMENT NAME	SYNTHESIS, PART I PIPING AND INSTRUMENT DIAGRAM	PRO NO.	S-02115	REV.	42
DATE	13/11/2017	CONTRACTOR DRAWING NO.	MKP-11-AS-3000-PS07-PID-002	CONTRACTOR	TCC 中国天辰工程技术有限公司	SHEET	01
		SUB-CONTRACTOR DRAWING NO.				TOTAL	01
		SHEET				TOTAL	

PROJECT	MKP Methanol Project
UNIT	METHANOL SYNTHESIS
PHASE	As Built Drawing
OWNER DWG NO.	MKP-11-AS-3000-PR-PID-002


Counter Signing Sign Date

SCALE:-- SHEET: 1 TOT.: 1 SIZE: A1

J 3002 1/2/3 START-UP EJECTOR		R 3001 1/2/3 METHANOL REACTOR	
CAPACITY Suction/Motive	525/30 t/h	ID x LENGTH	4700 x 9000mm
DESIGN PRESS.	46.5/52 barg	VDLUME	m <sup>3</sup>
DESIGN TEMP.	260/470 °C	DESIGN PRESS.	99/46.5 barg
MATERIAL	CS, Motive nozzle SS	DESIGN TEMP.(TU/SH)	300/260 °C
		MATERIAL SHELL	CS) HEAD 1.25Cr0.5Mo
		Elev. of EQUIPMENT	EL 110.200 m

**GENERAL NOTES**

- †NOTES:
- 1) MIN. DISTANCE BETWEEN J 3003 1/2/3 AND R 3001 1/2/3.
  - 2) TO BE LOCATED AS CLOSE AS POSSIBLE TO R 3001 1/2/3.
  - 3) DRIPHOLE IS NEEDED.
  - 4) A10 AND B10 HAVE TO BE LOCATED 180 DEG APART.
  - 5) THE SAMPLING POINT IS SHOWN IN THE BOTTOM OF THIS PAGE.
- †GENERAL NOTE:
- LOW POINT DRAINS AND HIGH POINT VENT MUST BE ADDED DURING DETAILED ENGINEERING.

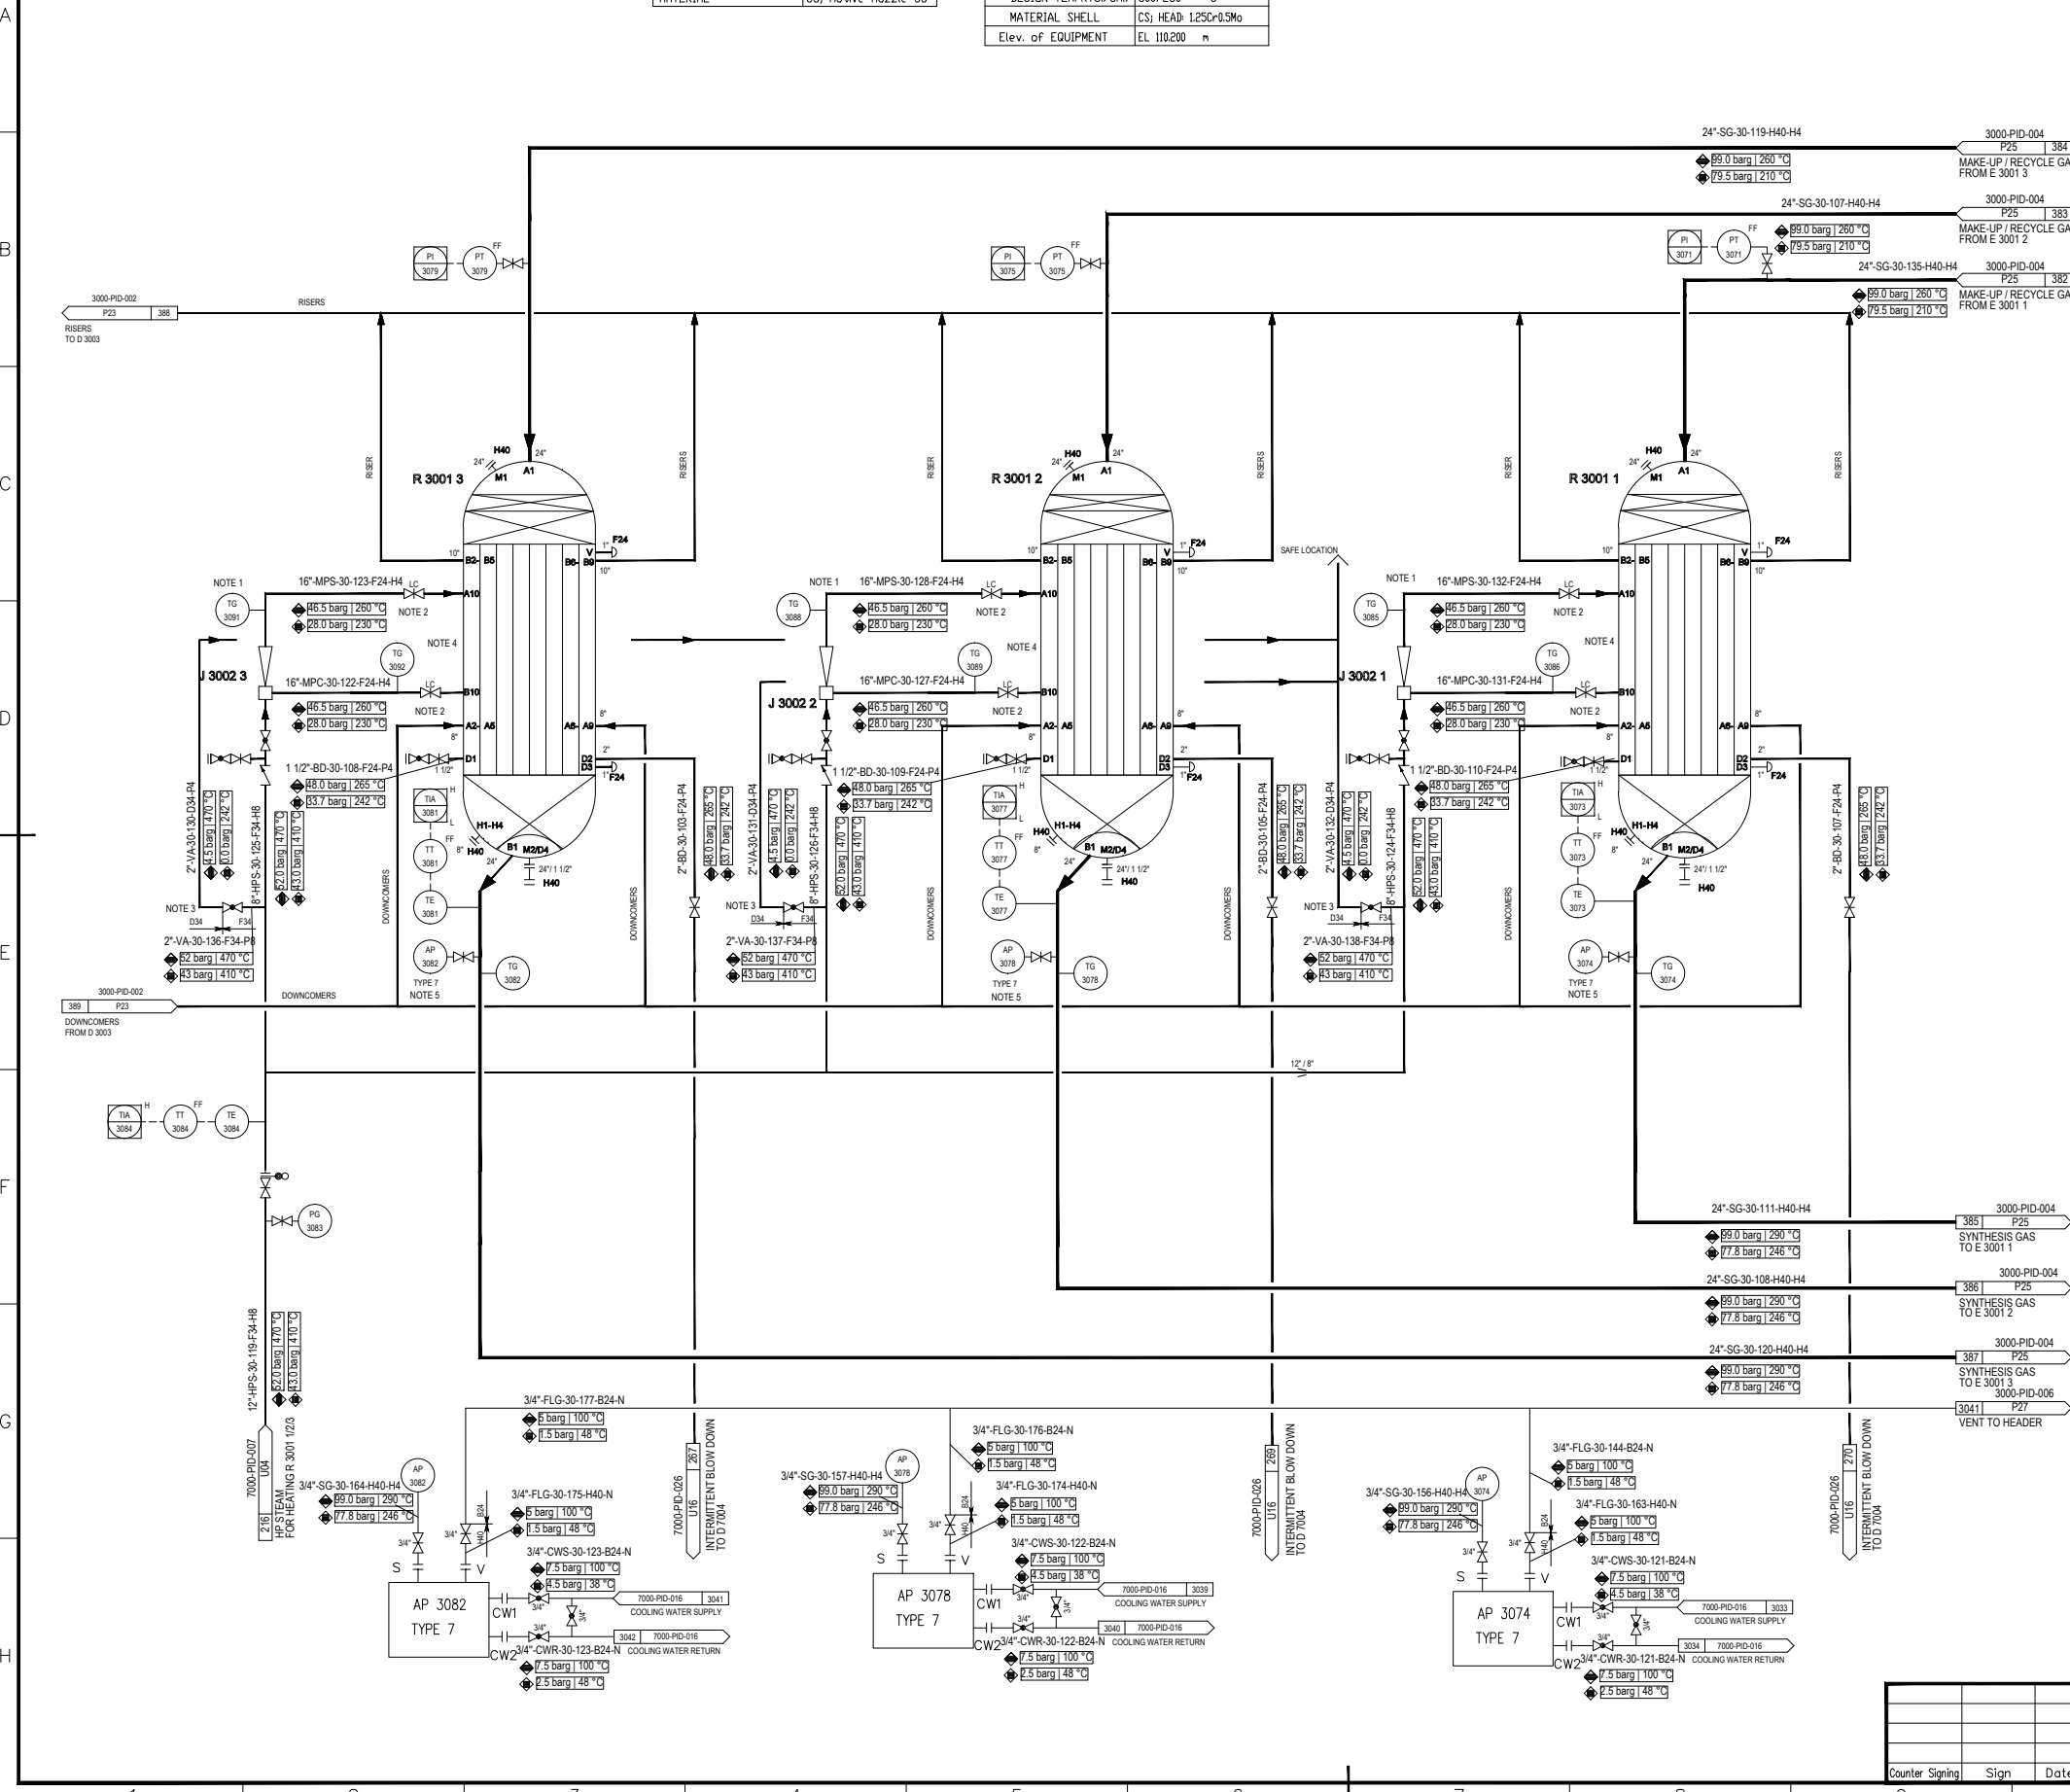

**REFERENCE DRAWINGS**

**SYMBOLS AND LEGENDS**

**KEY PLAN**

REV.	PURPOSE OF ISSUE	DATE	DESIGN	DRAW	CHECK	REVIEW	APPROVE
▲	As Built	30.04.2020	Xu Jun		Mu Yujun	Hu Qiyi	
▲	Approved for Construction	30.12.2019	Xu Jun		Mu Yujun	Hu Qiyi	
▲	Approved for Construction	06.11.2017	Xu Jun		Mu Yujun	Hu Qiyi	
▲	Approved for Construction	18.05.2017	Li Zhijuan		Mu Yujun	Hu Qiyi	
▲	Approved for Construction	22.03.2017	Li Zhijuan		Mu Yujun	Hu Qiyi	
▲	Approved for Construction	22.01.2017	Li Zhijuan		Mu Yujun	Hu Qiyi	
▲	Approved for Construction	13.10.2016	Li Zhijuan		Mu Yujun	Hu Qiyi	
▲	Issued for Approval	31.08.2016	Li Zhijuan		Mu Yujun	Hu Qiyi	
▲	Issued for Approval	25.06.2016	Li Zhijuan		Mu Yujun	Hu Qiyi	
▲	Issued for Comments	29.04.2016	Li Zhijuan		Mu Yujun	Hu Qiyi	

OWNER: Middle East Kimiaye Pars Company

HALDOR TOPSØE A/S

TCC 中国天辰工程技术有限公司


PROJECT	MKP Methanol Project
UNIT	METHANOL SYNTHESIS
PHASE	As Built Drawing
OWNER DWG NO.	MKP-11-AS-3000-PR-PID-003

SCALE: -- SHEET: 1 TOT.: 1 SIZE: A1

E 3001 1/2/3	FEED/EFFLUENT EXCHANGER
DUTY	133.1 MW
ID x LENGTH	1710x18600 mm
DESIGN PRESS.(TLU./SH.)	99/99 barg
DESIGN TEMP.(TLU./SH.)	290/260 °C
MATERIAL SHELL SIDE	SS304L
MATERIAL TUBE SIDE	SS304L
No. of Tubes	2360
Insulation	YES
Elev. of EQUIPMENT	EL 104.300 m

**GENERAL NOTES**

- NOTES:
- 1) SYMMETRICAL PIPING.
  - 2) TWO PHASE FLOW- NO POCKETS ALLOWED.
  - 3) EL-TRACED.
  - 4) I- TO PUT TIC- IN AUTO WITH SETPOINT EQUAL TO ACTUAL PV AT TIME OF TRIP, MINUS 10°C.
- 5) SG-30-142 MUST BE AT HORIZONTAL AND THE SAME ELEVATION AS AE 3002 1/2/3.
- GENERAL NOTE:
- LOW POINT DRAINS AND HIGH POINT VENT MUST BE ADDED DURING DETAILED ENGINEERING.

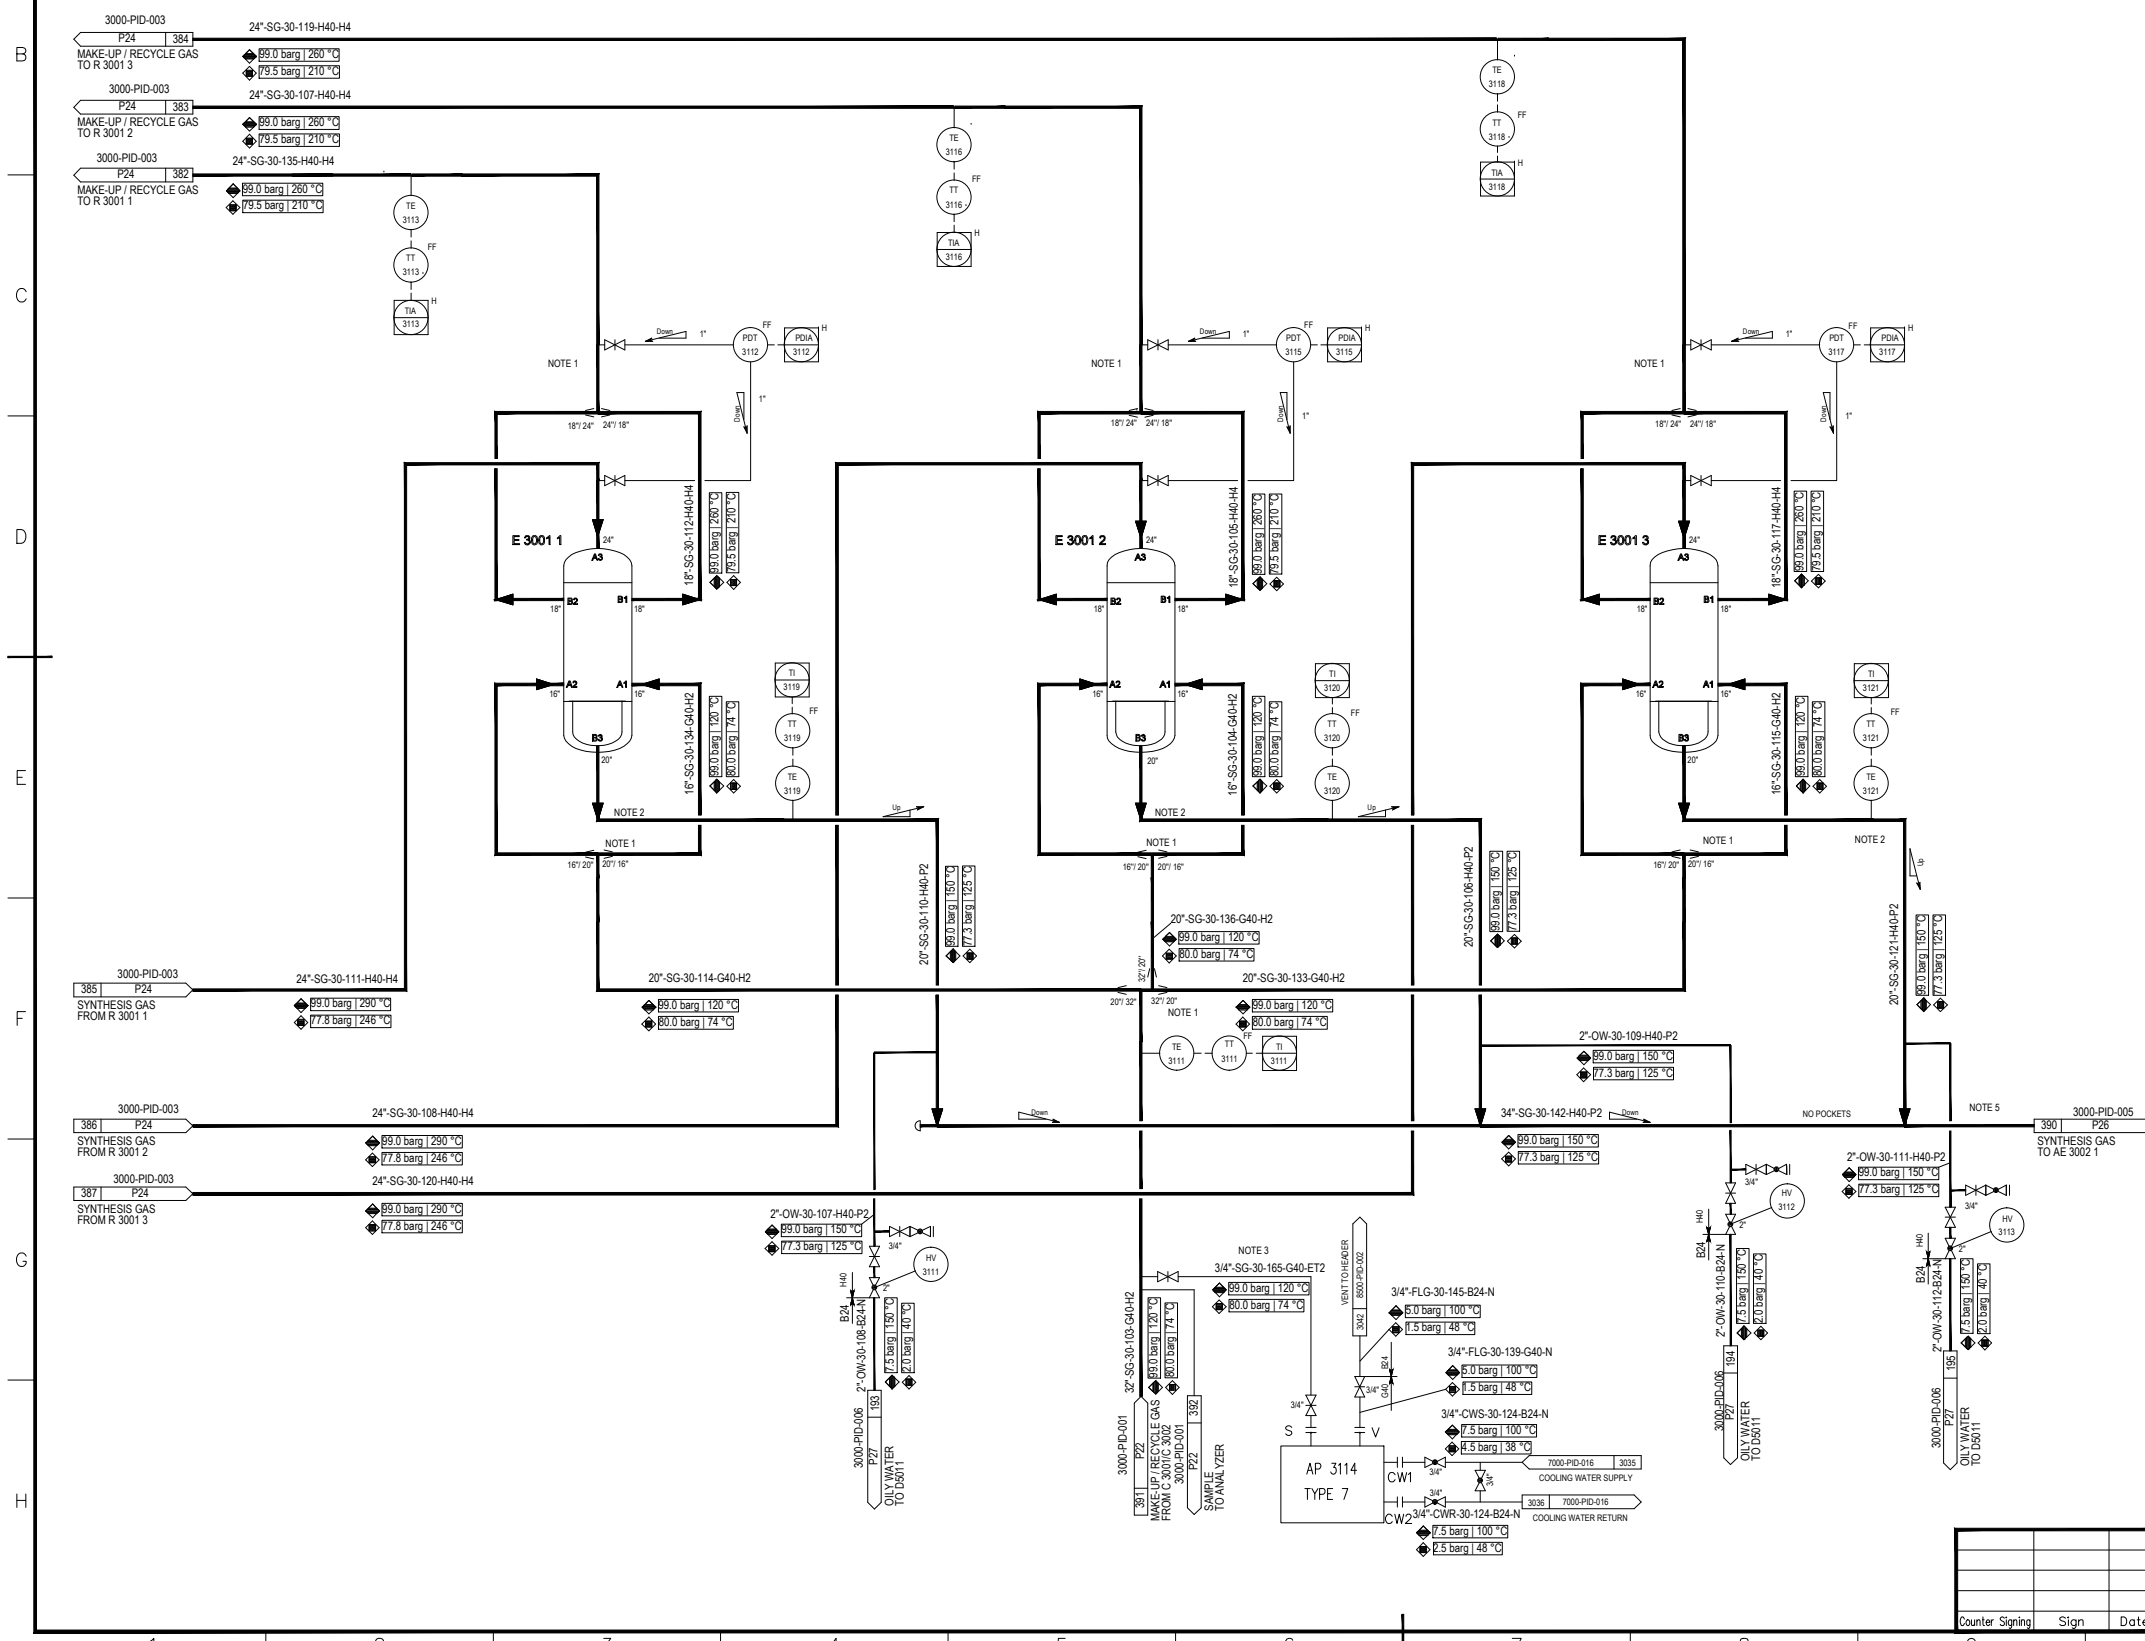

**REFERENCE DRAWINGS**

**SYMBOLS AND LEGENDS**

**KEY PLAN**

REV.	PURPOSE OF ISSUE	DATE	DESIGN	DRAW	CHECK	REVIEW	APPROVE
▲	As Built	30.04.2020	Xu Jun		Mu YuJun	Hu Ouyi	
▲	Approved for Construction	30.12.2019	Xu Jun		Mu YuJun	Hu Ouyi	
▲	Approved for Construction	06.11.2017	Xu Jun		Mu YuJun	Hu Ouyi	
▲	Approved for Construction	22.03.2017	Li ZhiJun		Mu YuJun	Hu Ouyi	
▲	Approved for Construction	13.10.2016	Li ZhiJun		Mu YuJun	Hu Ouyi	
▲	Approved for Construction	31.08.2016	Li ZhiJun		Mu YuJun	Hu Ouyi	
▲	Issued for Approval	25.06.2016	Li ZhiJun		Mu YuJun	Hu Ouyi	
▲	Issued for Comments	29.04.2016	Li ZhiJun		Mu YuJun	Hu Ouyi	

OWNER: Middle East Kimiaye Pars Company

DESIGNER	HALDOR TOPSØE A/S	DOCUMENT NAME	METHANOL F/E EXCHANGER PIPING AND INSTRUMENT DIAGRAM	PRO NO	S-02115	REV.	4
DATE	13/11/2016	SCALE	P25	CONTRACTOR DRAWING NO.	MKP-11-AS-3000-PS07-PID-004	SHEET	01
				SUB-CONTRACTOR DRAWING NO.			
				SHEET -- TOTAL --			

METHANOL F/E EXCHANGER PIPING AND INSTRUMENT DIAGRAM		PROJECT	MKP Methanol Project
		UNIT	METHANOL SYNTHESIS
		PHASE	As Built Drawing
		OWNER DWG NO.	MKP-11-AS-3000-PR-PID-004

Counter	Sign	Date
---------	------	------

SCALE: --	SHEET: 1	TOT: 1	SIZE: A1
-----------	----------	--------	----------


AE 3002 1/2/3		LOOP AIR COOLER	
DUTY	95	MW	
ID x LENGTH(T-T)	BY VENDOR mm		
DESIGN PRESS.(TUBE)	99/	barg	
DESIGN TEMP.(TUBE)	150/	°C	

E 3003 1/2/3		LOOP WATER COOLER	
DUTY	20	MW	
DESIGN PRESS.(TU/SH)	7.5/99	barg	
DESIGN TEMP.(TU/SH)	100/120	°C	
INSULATION	YES		
Elev. of EQUIPMENT	EL 113487 m		

**GENERAL NOTES**

- ↑NOTES:
- TWO PHASE FLOW NO POCKETS ALLOWED.
  - THE DRAIN NOZZLE IS ALSO USED AS THE SAMPLING POINT. THE SAMPLING POINT IS USED FOR DETECTING THE POSSIBLE EQUIPMENT LEAKAGE REGULARLY.
  - THE DETAIL DRAWING OF AE 3002 1/2/3 CAN BE SEEN ON MKP-11-DE-3000-PR-PID-008.
  - THE DISTANCE BETWEEN CHECK VALVE AND THE CONNECTED MAIN PIPE SHOULD BE MINIMIZED.
- ↑GENERAL NOTE:  
LOW POINT DRAINS AND HIGH POINT VENT MUST BE ADDED DURING DETAILED ENGINEERING.

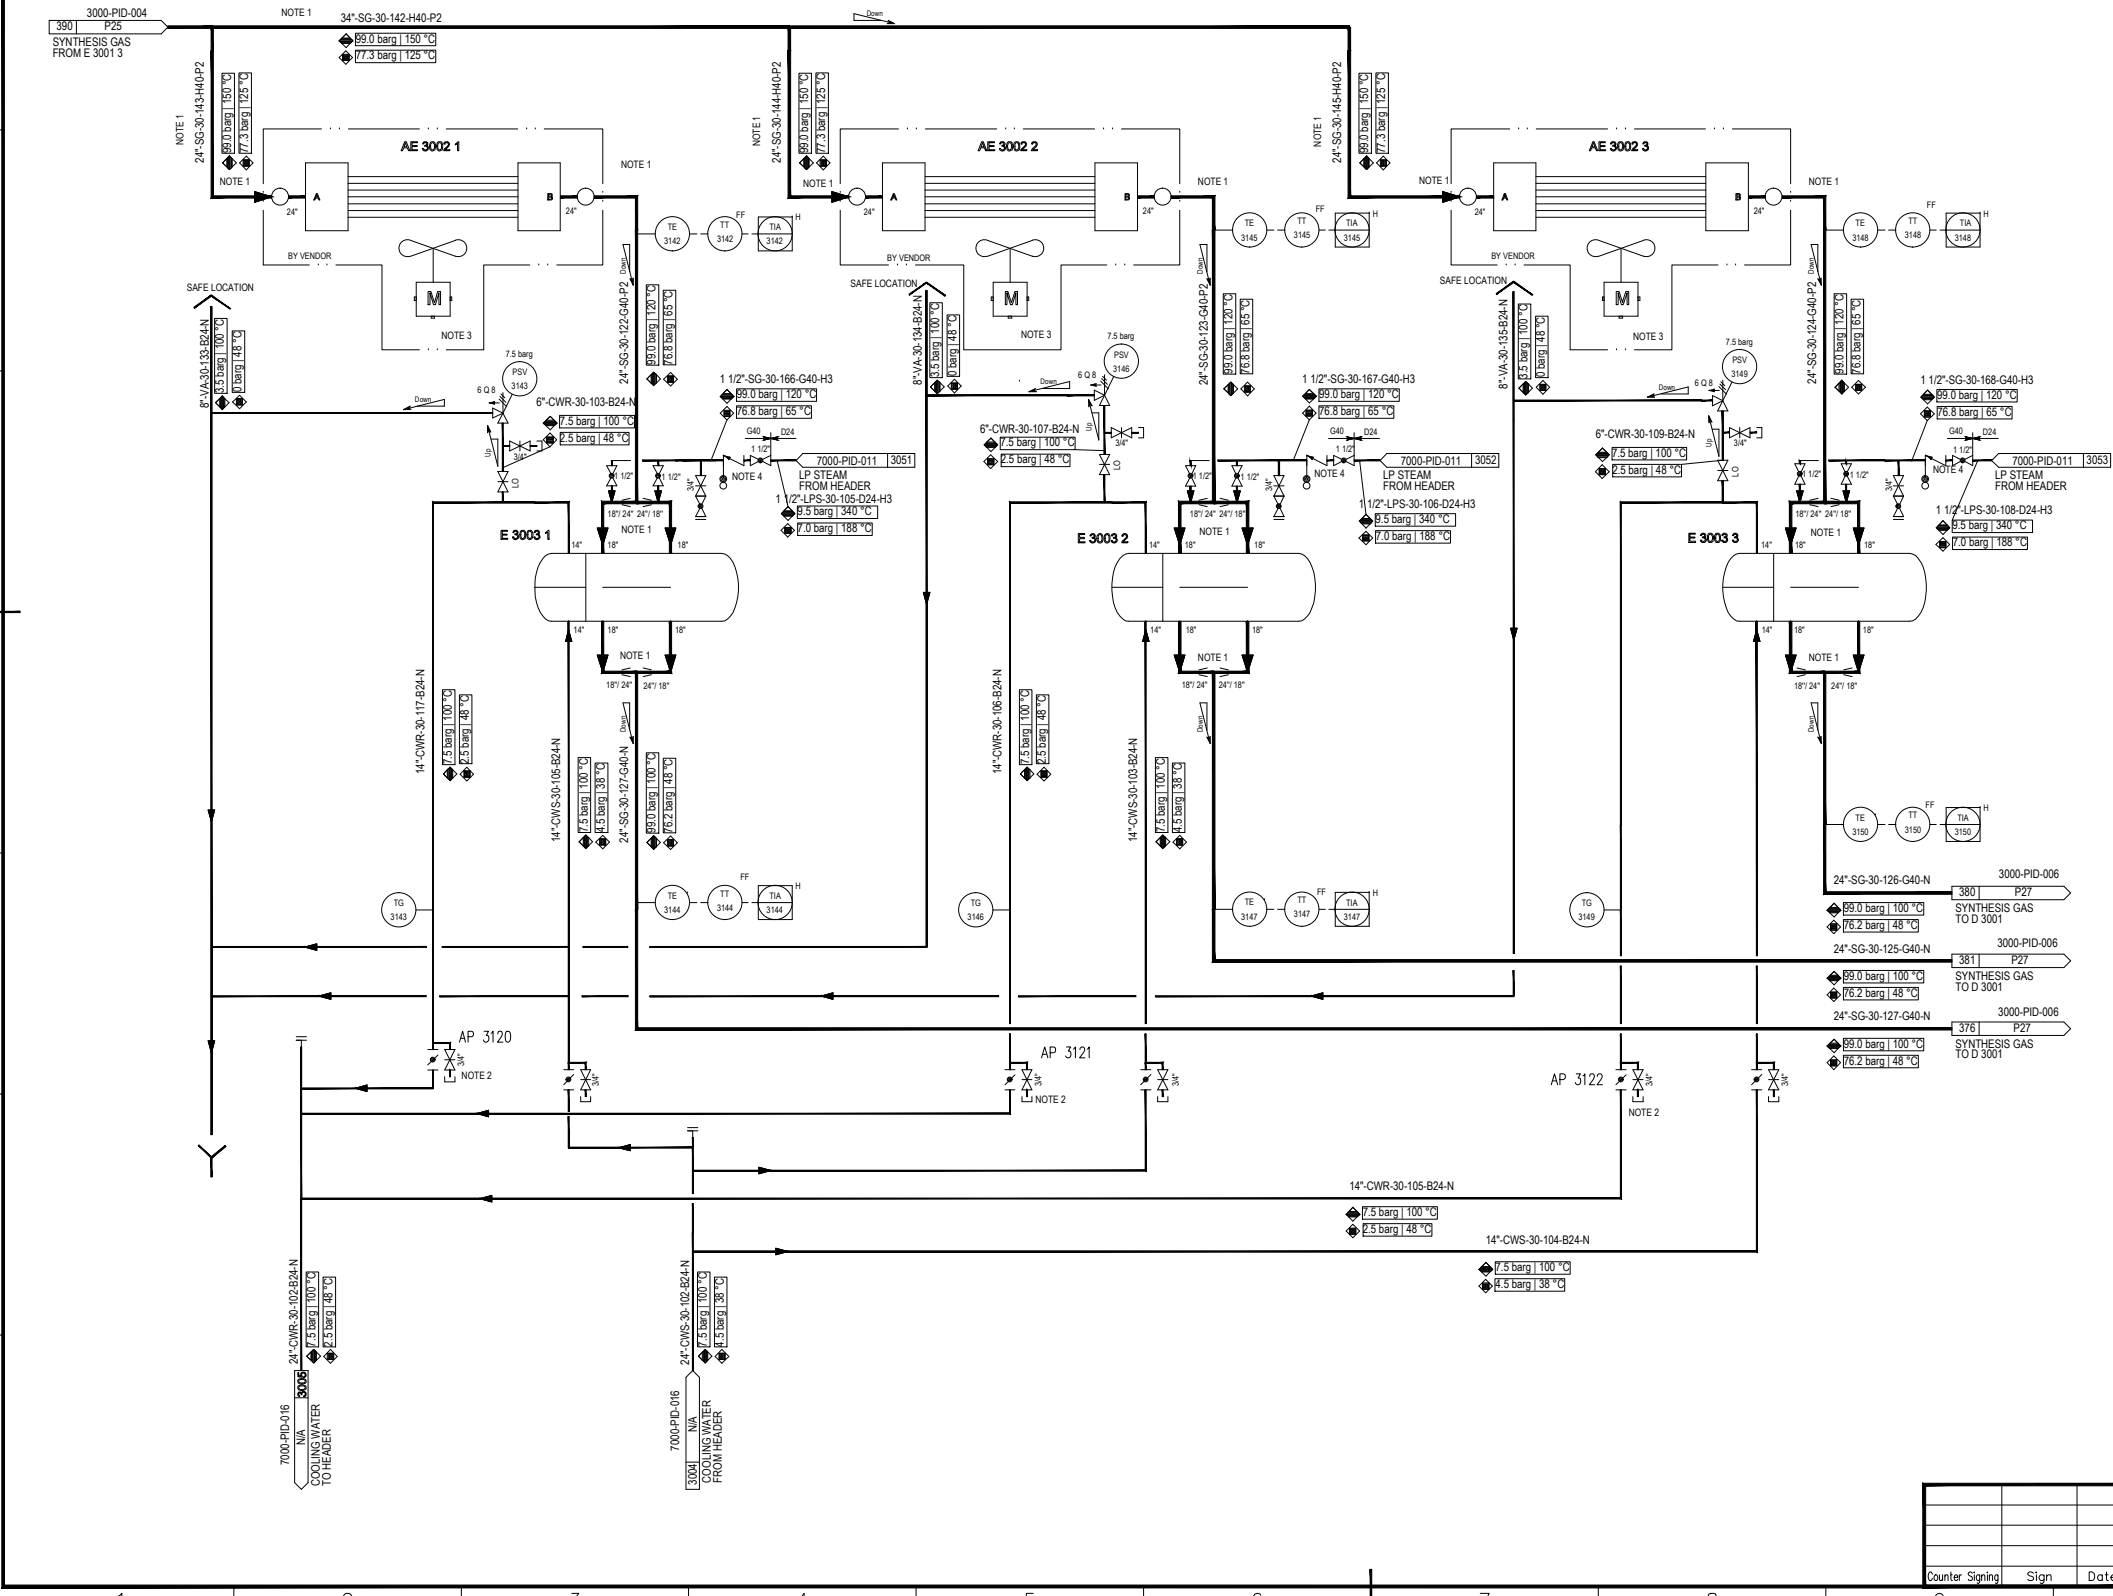

**REFERENCE DRAWINGS**

**SYMBOLS AND LEGENDS**

**KEY PLAN**

REV.	PURPOSE OF ISSUE	DATE	DESIGN	DRAW	CHECK	REVIEW	APPROVE
▲	As Built	30.04.2020	Xu Jun		Mu Yujun	Hu Qiyi	
▲	Approved for Construction	13.08.2018	Xu Jun		Mu Yujun	Hu Qiyi	
▲	Approved for Construction	18.05.2017	Li Zhijuan		Mu Yujun	Hu Qiyi	
▲	Approved for Construction	22.03.2017	Li Zhijuan		Mu Yujun	Hu Qiyi	
▲	Approved for Construction	22.01.2017	Li Zhijuan		Mu Yujun	Hu Qiyi	
▲	Approved for Construction	13.10.2016	Li Zhijuan		Mu Yujun	Hu Qiyi	
▲	Issued for Approval	31.08.2016	Li Zhijuan		Mu Yujun	Hu Qiyi	
▲	Issued for Approval	25.06.2016	Li Zhijuan		Mu Yujun	Hu Qiyi	
▲	Issued for Comments	29.04.2016	Li Zhijuan		Mu Yujun	Hu Qiyi	

THIS DOCUMENT IS THE PROPERTY OF TCC. NO PART OF THIS DOCUMENT SHALL BE REPRODUCED OR DISCLOSED TO OTHERS OR USED FOR ANY PURPOSE WHATSOEVER EXCEPT WITH THE PRIOR WRITTEN PERMISSION OF TCC.

OWNER: Middle East Kimiaye Pars Company

DESIGNER	HALDOR TOPSØE A/S	DOCUMENT NAME	SYNTHESIS GAS COOLING PIPING AND INSTRUMENT DIAGRAM	PRO NO.	S-02115	REV.	4
DATE		DATE		CONTRACTOR	TCC 中国天辰工程有限公司	CONTRACTOR DRAWING NO.	MKP-11-AS-3000-PS07-PID-005
						SHEET	01
						TOTAL	01
						SUB-CONTRACTOR DRAWING NO.	
						SHEET	
						TOTAL	

PROJECT	MKP Methanol Project
UNIT	METHANOL SYNTHESIS
PHASE	As Built Drawing
OWNER DWG NO.	MKP-11-AS-3000-PR-PID-005

Counter	Sign	Date

SCALE	SHEET: 1	TOT: 1	SIZE: A1
-------	----------	--------	----------



D 3001	HP SEPARATOR
ID x LENGTH-T	4900 x 4800 mm
DESIGN PRESS.	99.0 barg
DESIGN TEMP.	100 °C
INSULATION	NO
CLADDING/LINING	CS Cladded With S3304L
Elev. of EQUIPMENT	EL. 104.100 m

J 3001	EJECTOR
CAPACITY Suction/Motive	577/62275 Nm <sup>3</sup> /h
DESIGN PRESS.	FV/3.5 /99.0 barg
DESIGN TEMP.	75/100 °C
MATERIAL	CS, Motive nozzle SS

**GENERAL NOTES**

- NOTES:
- 1) VALVE TO BE PLACED OUTSIDE SYNTHESIS AREA - ACCESSIBLE IN CASE OF FIRE.
  - 2) EMERGENCY DEPRESSURISATION TO BE ACTUATED MANUALLY IN CASE OF FIRE. PIC-3166 B IS RAMPING DOWN TO 50% OF DESIGN PRESSURE IN 15 MINUTES.
  - 3) D 3001 MUST BE LOCATED AS CLOSE AS POSSIBLE TO C 3002.
  - 4) CONNECTION FOR STEAM OUT/DEWAXING.
  - 5) SWITCH FIC-3169 TO AUTO WITH A SETPOINT EQUAL TO ACTUAL OPERATING POINT AND RAMPING THIS SETPOINT DOWN TO ZERO IN TWO MINUTES. HEREAFTER FIC-3169 IS SET IN MANUAL WITH ZERO OUTPUT.
  - 6) SLOPE REQUIREMENT MUST BE FULFILLED. IF THIS IS NOT POSSIBLE, EL TRACED.
  - 7) STEAM OUT OF DEMISTER.
  - 9) BOTH VALVES DESIGNED FOR FULL FLOW.
  - 11) REQUIRED PIPING RUN UPSTREAM (10D) AND DOWN STREAM (5D) OF ALL FLOW METERS SHOULD BE CONSIDERED.
  - 12) DIRECTLY CONNECT THE BYPASS WITH THE MAIN PIPE.
  - 13) P&T COMPENSATION FROM PIC-3166A, TI-3164, MW COMPENSATION FROM HIC-3167.
  - 14) P&T COMPENSATION FROM PIC-3166A, TI-3164.
  - 15) P&T COMPENSATION FROM PIC-3166A, TI-3164.
  - 16) PV-3166 INCLUDES 4 NOISE REDUCTION DISKS, THE SIZE IS 4"-12" AND THE REDUCER CONSIDERED BY PIPING.
  - 17) FV-3169 INCLUDES 2 NOISE REDUCTION DISKS, THE SIZE IS 4"-24" AND THE REDUCER CONSIDERED BY PIPING.
  - 18) 10" WAS FIRST CHANGED TO 16" AND THEN CHANGED TO 24" BY TWO REDUCERS.
- GENERAL NOTE:  
LOW POINT DRAINS AND HIGH POINT VENT MUST BE ADDED DURING DETAILED ENGINEERING.

**REFERENCE DRAWINGS**

**SYMBOLS AND LEGENDS**


**KEY PLAN**

REV.	PURPOSE OF ISSUE	DATE	DESIGN	DRAW	CHECK	REVIEW	APPROVE
▲	As Built	30.04.2020	Xu Jun		Mu Yujun	Hu Qiyi	
▲	Approved for Construction	30.12.2019	Xu Jun		Mu Yujun	Hu Qiyi	
▲	Approved for Construction	06.11.2017	Xu Jun		Mu Yujun	Hu Qiyi	
▲	Approved for Construction	18.05.2017	Li Zhijuan		Mu Yujun	Hu Qiyi	
▲	Approved for Construction	22.03.2017	Li Zhijuan		Mu Yujun	Hu Qiyi	
▲	Approved for Construction	22.01.2017	Li Zhijuan		Mu Yujun	Hu Qiyi	
▲	Approved for Construction	13.10.2016	Li Zhijuan		Mu Yujun	Hu Qiyi	
▲	Approved for Construction	31.08.2016	Li Zhijuan		Mu Yujun	Hu Qiyi	
▲	Issued for Approval	25.06.2016	Li Zhijuan		Mu Yujun	Hu Qiyi	
▲	Issued for Comments	29.04.2016	Li Zhijuan		Mu Yujun	Hu Qiyi	

OWNER: Middle East Kimiaye Pars Company

DESIGNED BY	HALDOR TOPSØE A/S	DOCUMENT NAME	SYNTHESIS PART II PIPING AND INSTRUMENT DIAGRAM	PROJ NO	S-02115	REV.	42
DRAWN BY		DATE	13/4/2017	CONTRACTOR DRAWING NO.	MKP-11-AS-3000-PS07-PID-006	SHEET	01
CHECKED BY		DATE		SUB-CONTRACTOR DRAWING NO.		TOTAL	01
APPROVED BY		DATE		SHEET		TOTAL	

PROJECT	MKP Methanol Project
UNIT	METHANOL SYNTHESIS
PHASE	As Built Drawing
OWNER DWG NO.	MKP-11-AS-3000-PR-PID-006

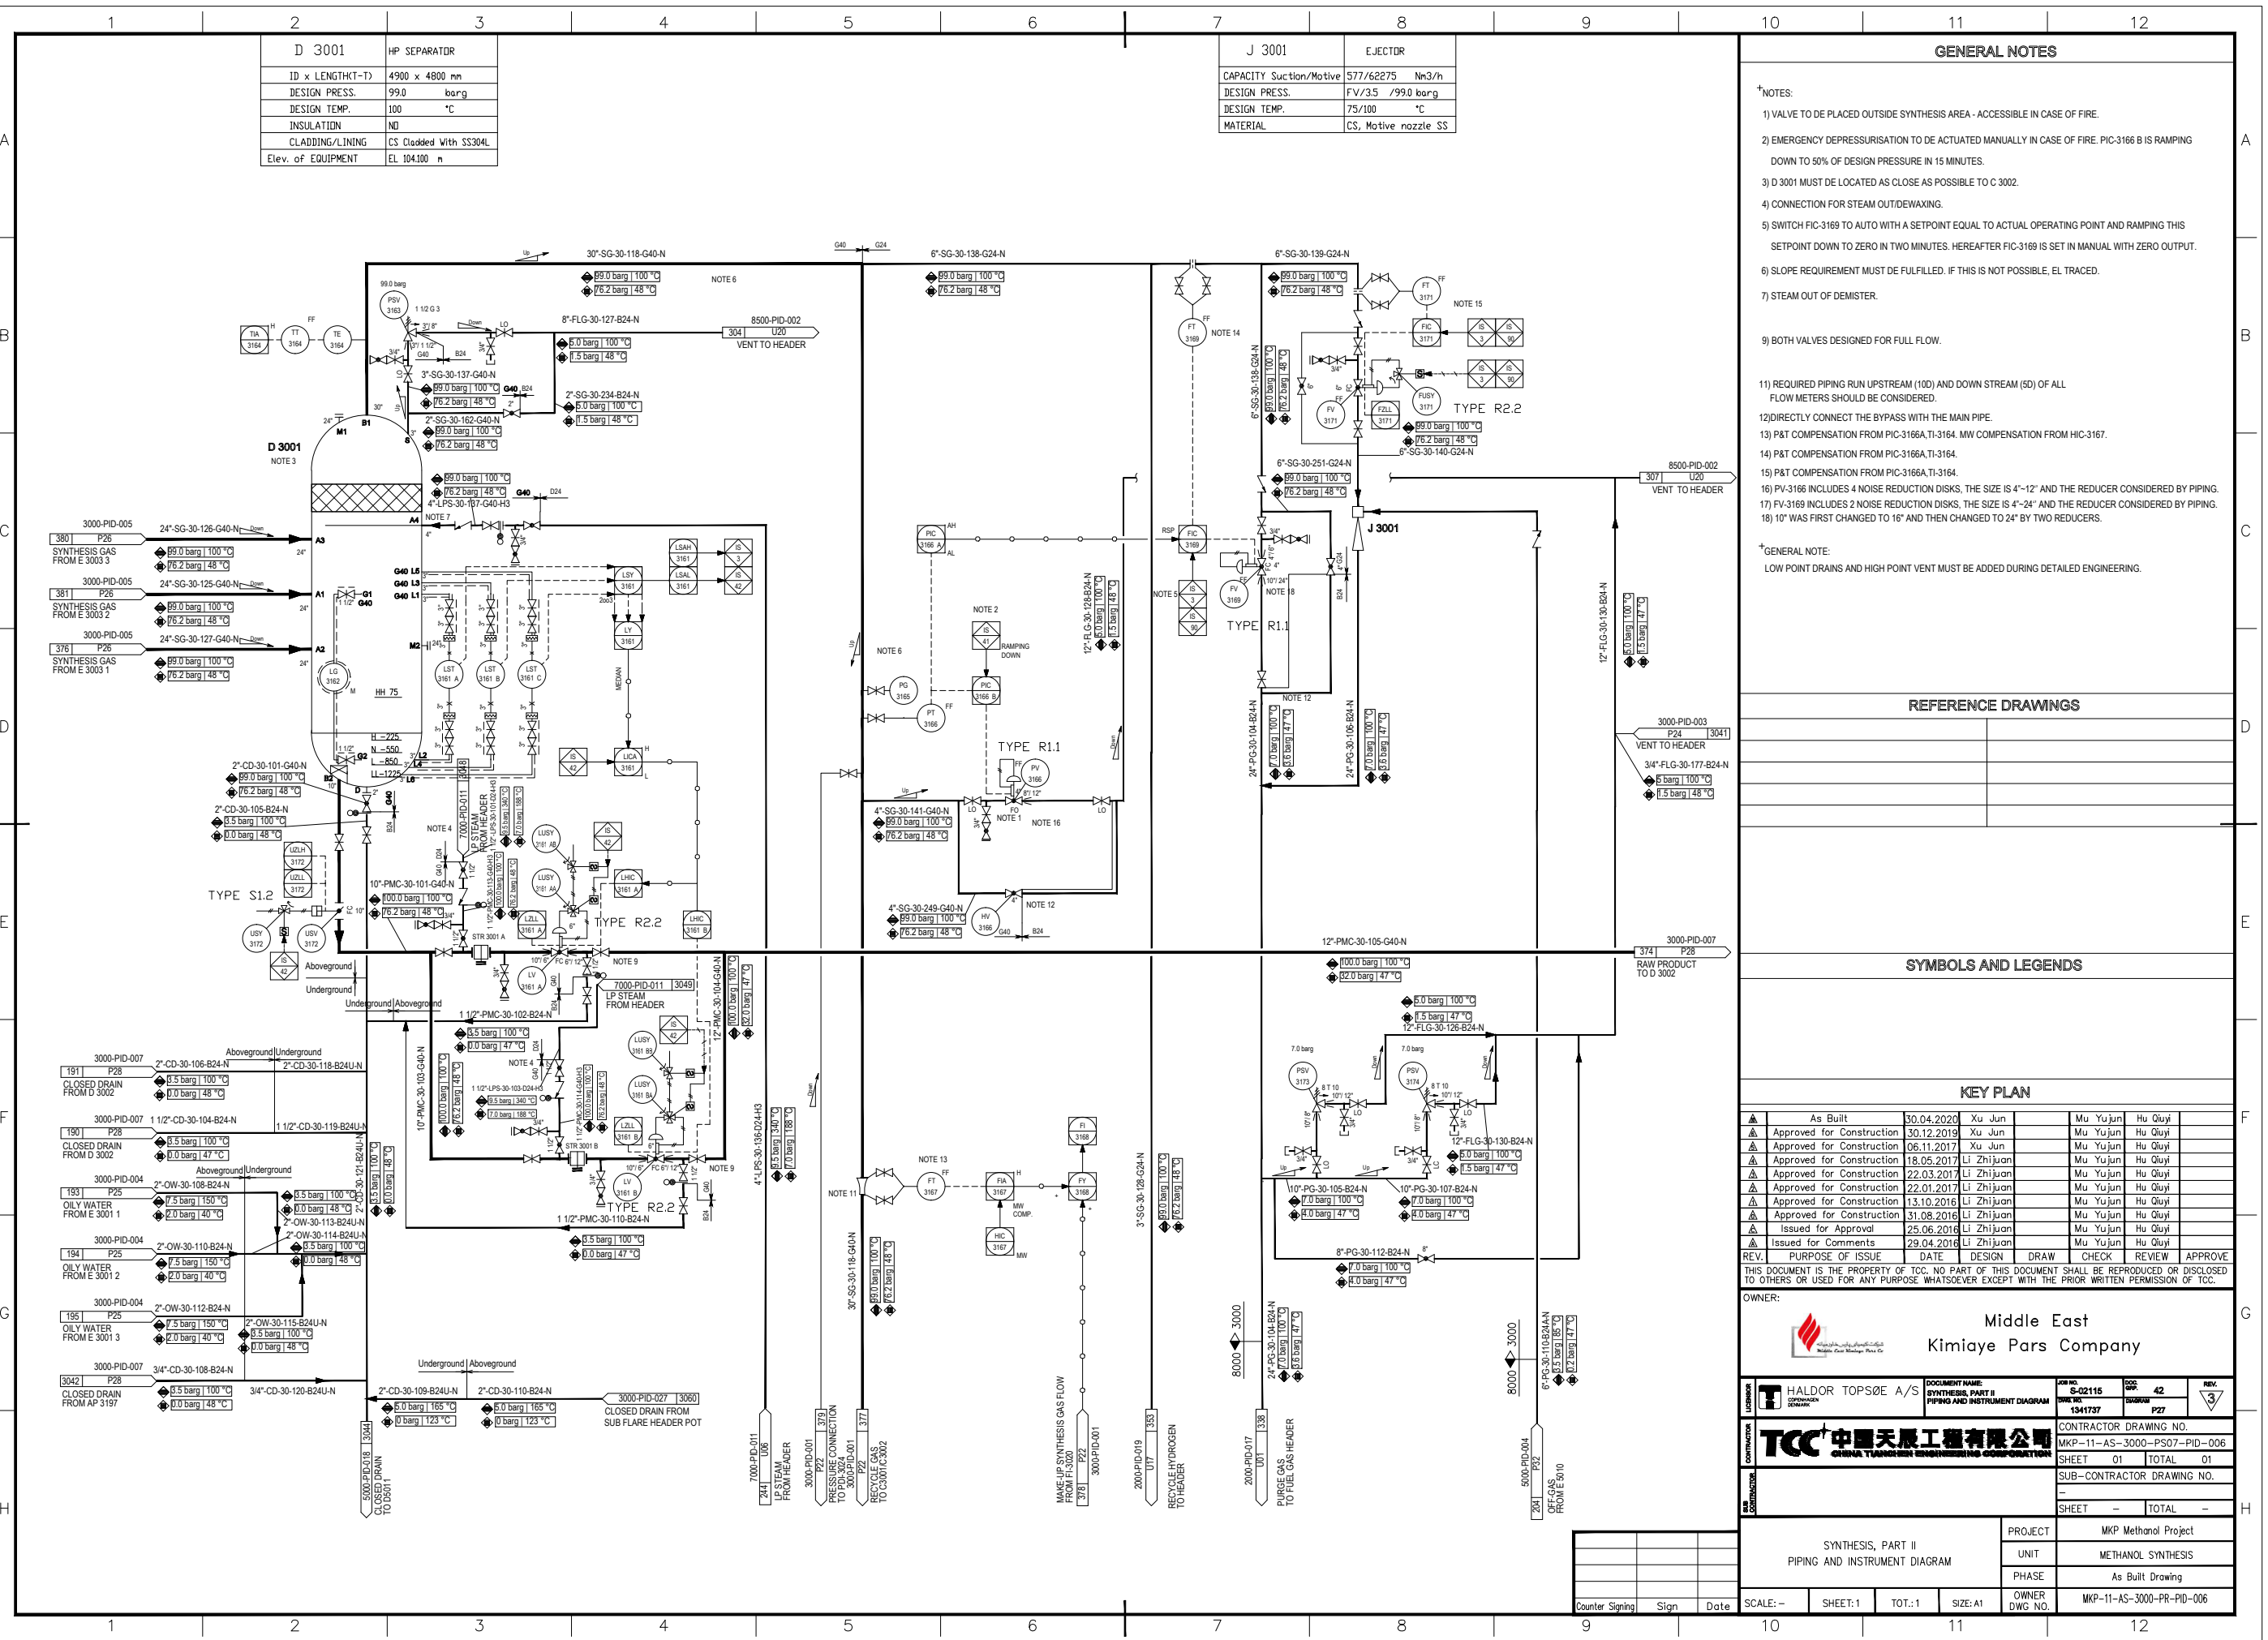

Counter	Sign	Date

SCALE: --	SHEET: 1	TOT.: 1	SIZE: A1
-----------	----------	---------	----------

D 3002	LP SEPARATOR
ID x LENGTH-T	2200 x 6450 mm
DESIGN PRESS.	7.0 barg
DESIGN TEMP.	100 °C
INSULATION	NO
CLADDING/LINING	NONE
Elev. of EQUIPMENT	EL. 101.948 m

**GENERAL NOTES**

- NOTES:**
- 1) CONNECTION FOR STEAM OUT/DEWAXING.
  - 2) DISTANCE TO D 3002 TO BE MINIMIZED.
  - 4) TO BE READABLE FROM LG-3193.
  - 5) THIS PIPE HAS BEEN MIXED WITH 24" PG-30-104-B24-N ON PIPE RACK.
  - 6) P&T COMPENSATION FROM PIC-3194, TI-3194.

**GENERAL NOTE:**  
LOW POINT DRAINS AND HIGH POINT VENT MUST BE ADDED DURING DETAILED ENGINEERING.

**REFERENCE DRAWINGS**

**SYMBOLS AND LEGENDS**


**KEY PLAN**

REV.	PURPOSE OF ISSUE	DATE	DESIGN	DRAW	CHECK	REVIEW	APPROVE
▲	As Built	30.04.2020	Xu Jun		Mu Yujun	Hu Qiyi	
▲	Approved for Construction	30.12.2019	Xu Jun		Mu Yujun	Hu Qiyi	
▲	Approved for Construction	06.11.2017	Xu Jun		Mu Yujun	Hu Qiyi	
▲	Approved for Construction	18.05.2017	Li Zhijuan		Mu Yujun	Hu Qiyi	
▲	Approved for Construction	22.03.2017	Li Zhijuan		Mu Yujun	Hu Qiyi	
▲	Approved for Construction	22.01.2017	Li Zhijuan		Mu Yujun	Hu Qiyi	
▲	Approved for Construction	13.10.2016	Li Zhijuan		Mu Yujun	Hu Qiyi	
▲	Approved for Construction	31.08.2016	Li Zhijuan		Mu Yujun	Hu Qiyi	
▲	Issued for Approval	25.06.2016	Li Zhijuan		Mu Yujun	Hu Qiyi	
▲	Issued for Comments	29.04.2016	Li Zhijuan		Mu Yujun	Hu Qiyi	

OWNER: **Middle East Kimiaye Pars Company**

DESIGNER	HALDOR TOPSØE A/S	DOCUMENT NAME	RAW PRODUCT FLASH PIPING AND INSTRUMENT DIAGRAM	JOB NO.	S-02115	CDR	42	REV.	4
CONTRACTOR	TCC 中国天辰工程有限公司	CONTRACTOR DRAWING NO.	MKP-11-AS-3000-PS07-PID-007	DATE	13/11/20	CDR	P28		
		SHEET	01	TOTAL	01				
		SUB-CONTRACTOR DRAWING NO.							
		SHEET		TOTAL					

PROJECT	MKP Methanol Project
UNIT	METHANOL SYNTHESIS
PHASE	As Built Drawing
OWNER DWG NO.	MKP-11-AS-3000-PR-PID-007

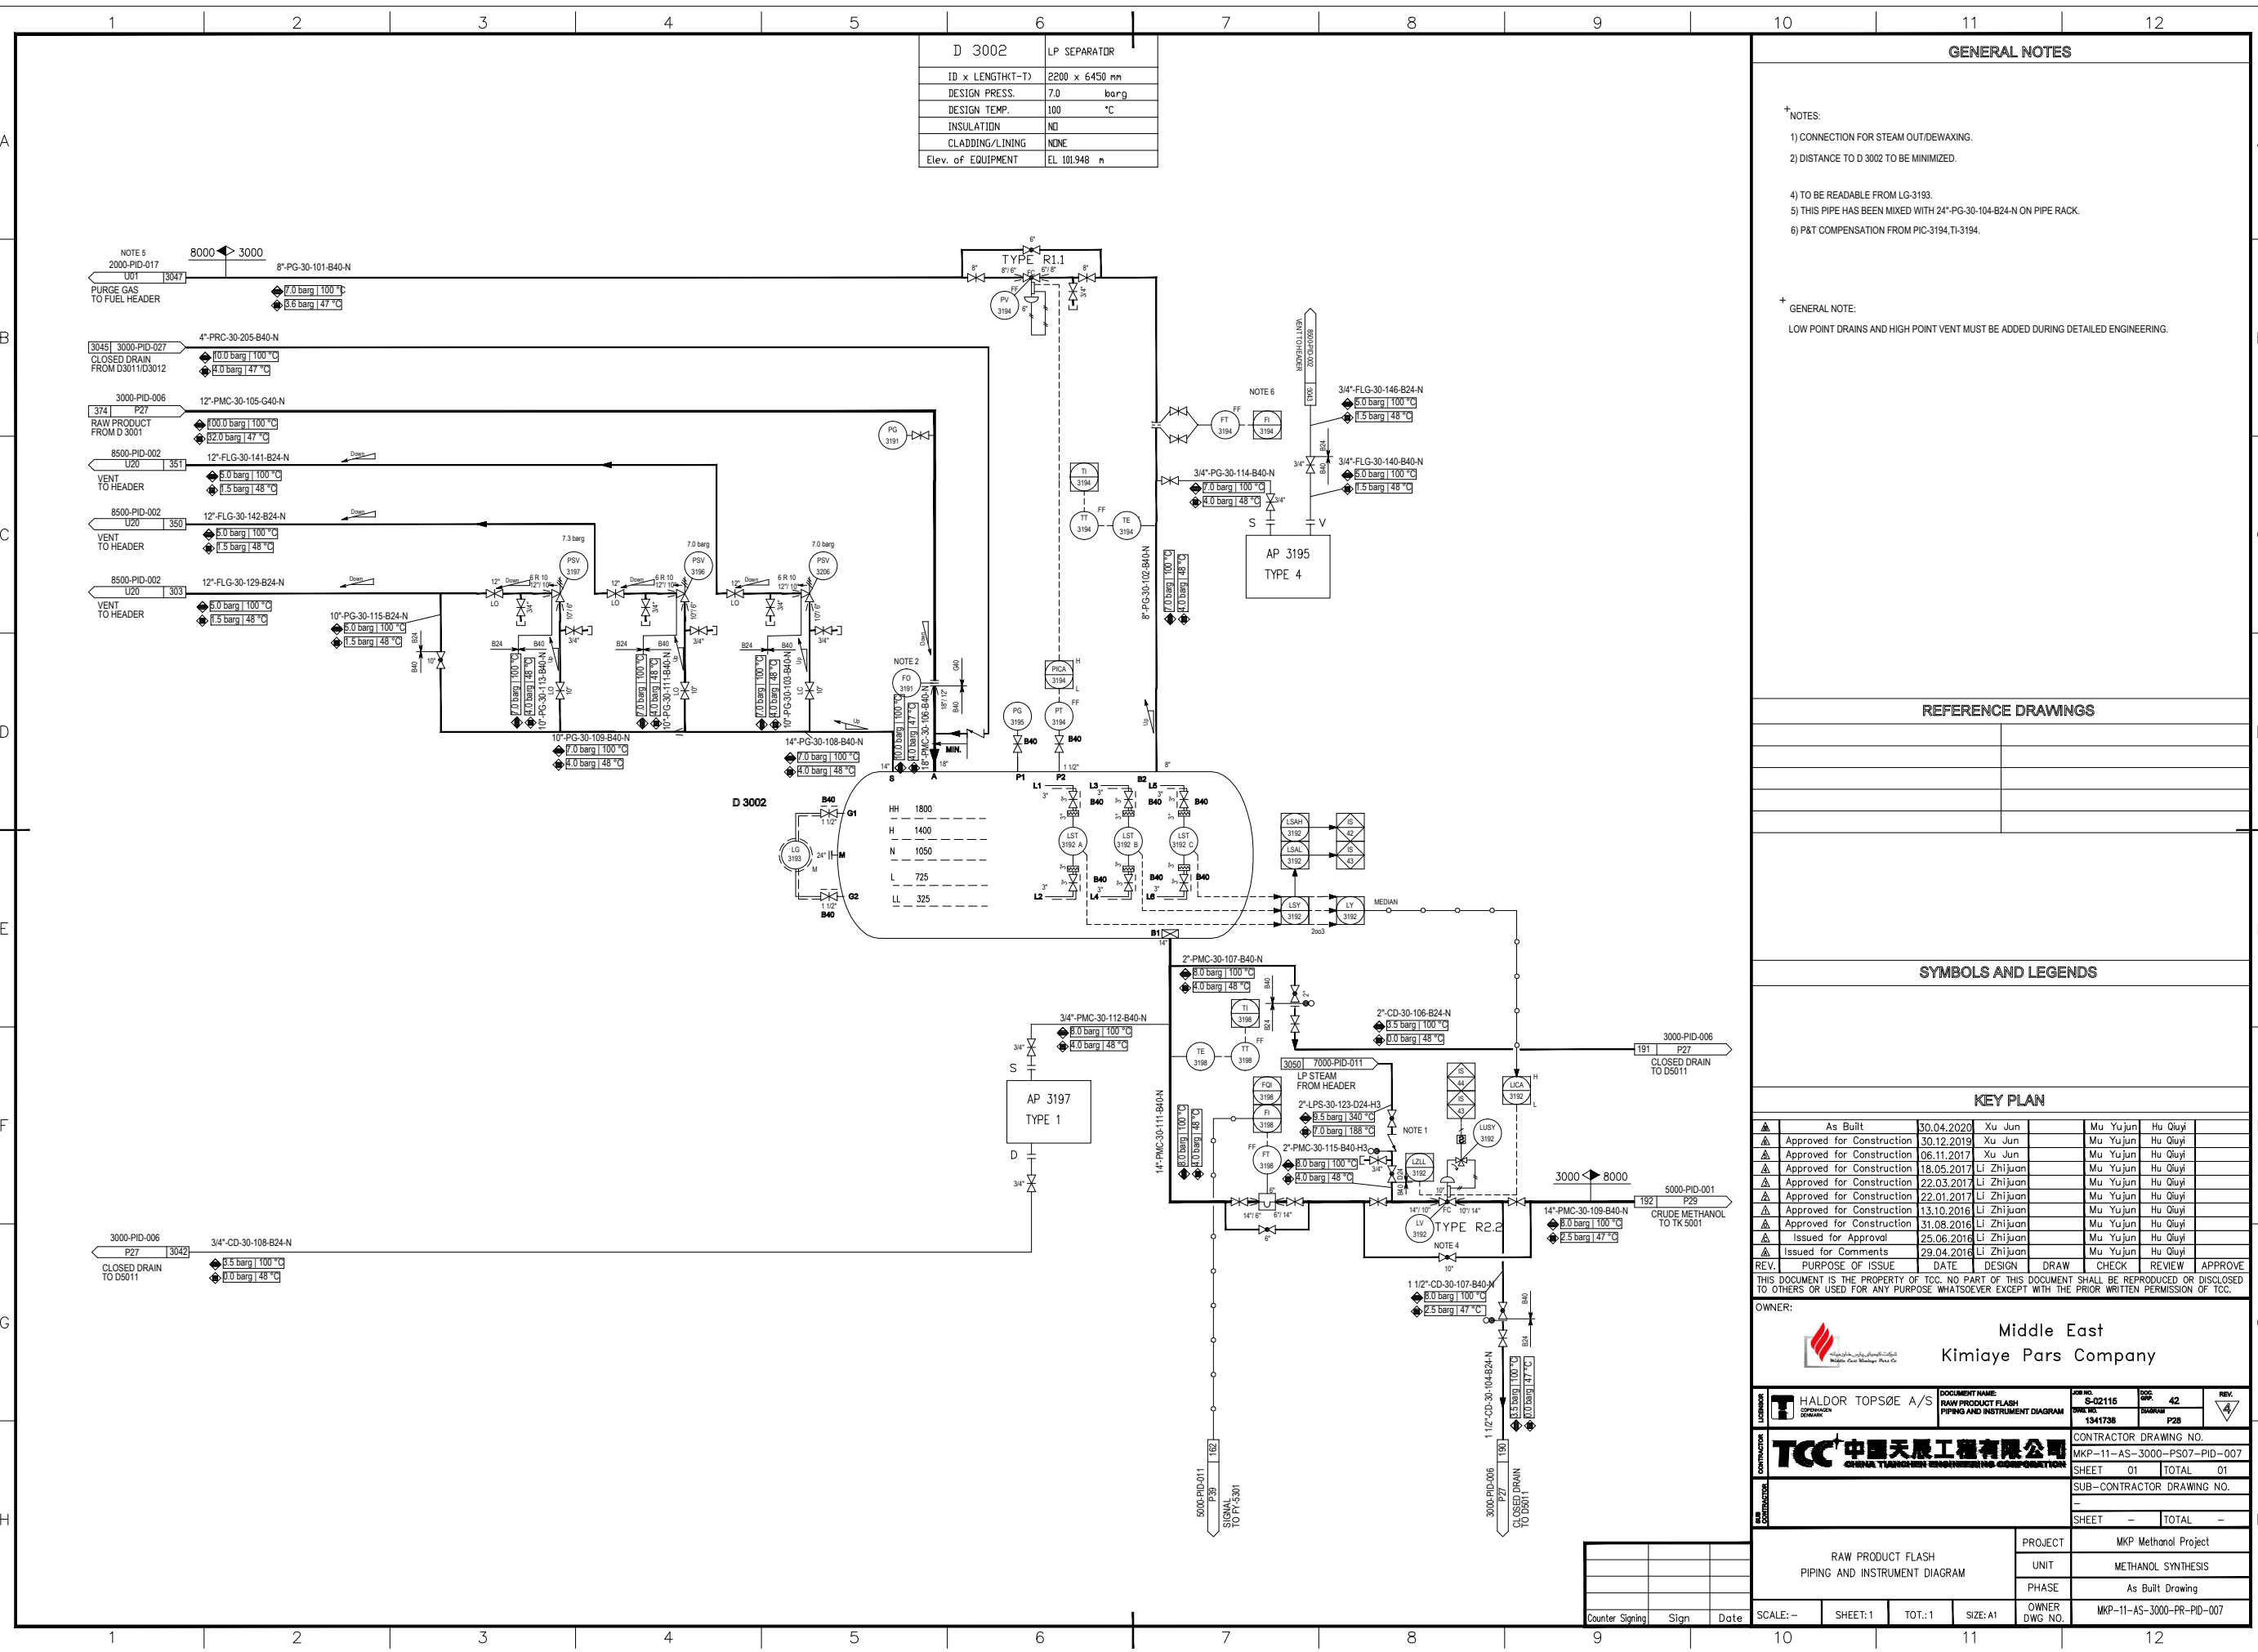

Counter Signing Sign Date

SCALE:-- SHEET: 1 TOT.: 1 SIZE: A1

AE 3002 1/2/3	LOOP AIR COOLER
DUTY	95 MW
ID x LENGTH-T	BY VENDOR mm
DESIGN PRESS.(TUBE)	99/ barg
DESIGN TEMP.(TUBE)	150/ °C

L 3002	CRANE 3002
TYPE	COLUMN CANTILEVER CRANE
CAPACITY	1 t
LIFT HEIGHT	22 m
SLIDING DISTANCE	1.8 m

**GENERAL NOTES**

- NOTES:
- THERMOWELL LABEL IS SHOWN BELOW:  

MAE3002 1A, MAE3002 1B	MAE3002 2A, MAE3002 2B	MAE3002 3A, MAE3002 3B
B1 ITW3001	B1 ITW3009	B1 ITW3017
B3 ITW3002	B3 ITW3010	B3 ITW3018


MAE3002 1C, MAE3002 1D	MAE3002 2C, MAE3002 2D	MAE3002 3C, MAE3002 3D
B5 ITW3003	B5 ITW3011	B5 ITW3019
B7 ITW3004	B7 ITW3012	B7 ITW3020

MAE3002 1E, MAE3002 1F	MAE3002 2E, MAE3002 2F	MAE3002 3E, MAE3002 3F
B9 ITW3005	B9 ITW3013	B9 ITW3021
B11 ITW3006	B11 ITW3014	B11 ITW3022

MAE3002 1G, MAE3002 1H	MAE3002 2G, MAE3002 2H	MAE3002 3G, MAE3002 3H
B13 ITW3007	B13 ITW3015	B13 ITW3023
B15 ITW3008	B15 ITW3016	B15 ITW3024
  - CRANE IS USED FOR AE 3002 1/2/3 MAINTENANCE.



**REFERENCE DRAWINGS**

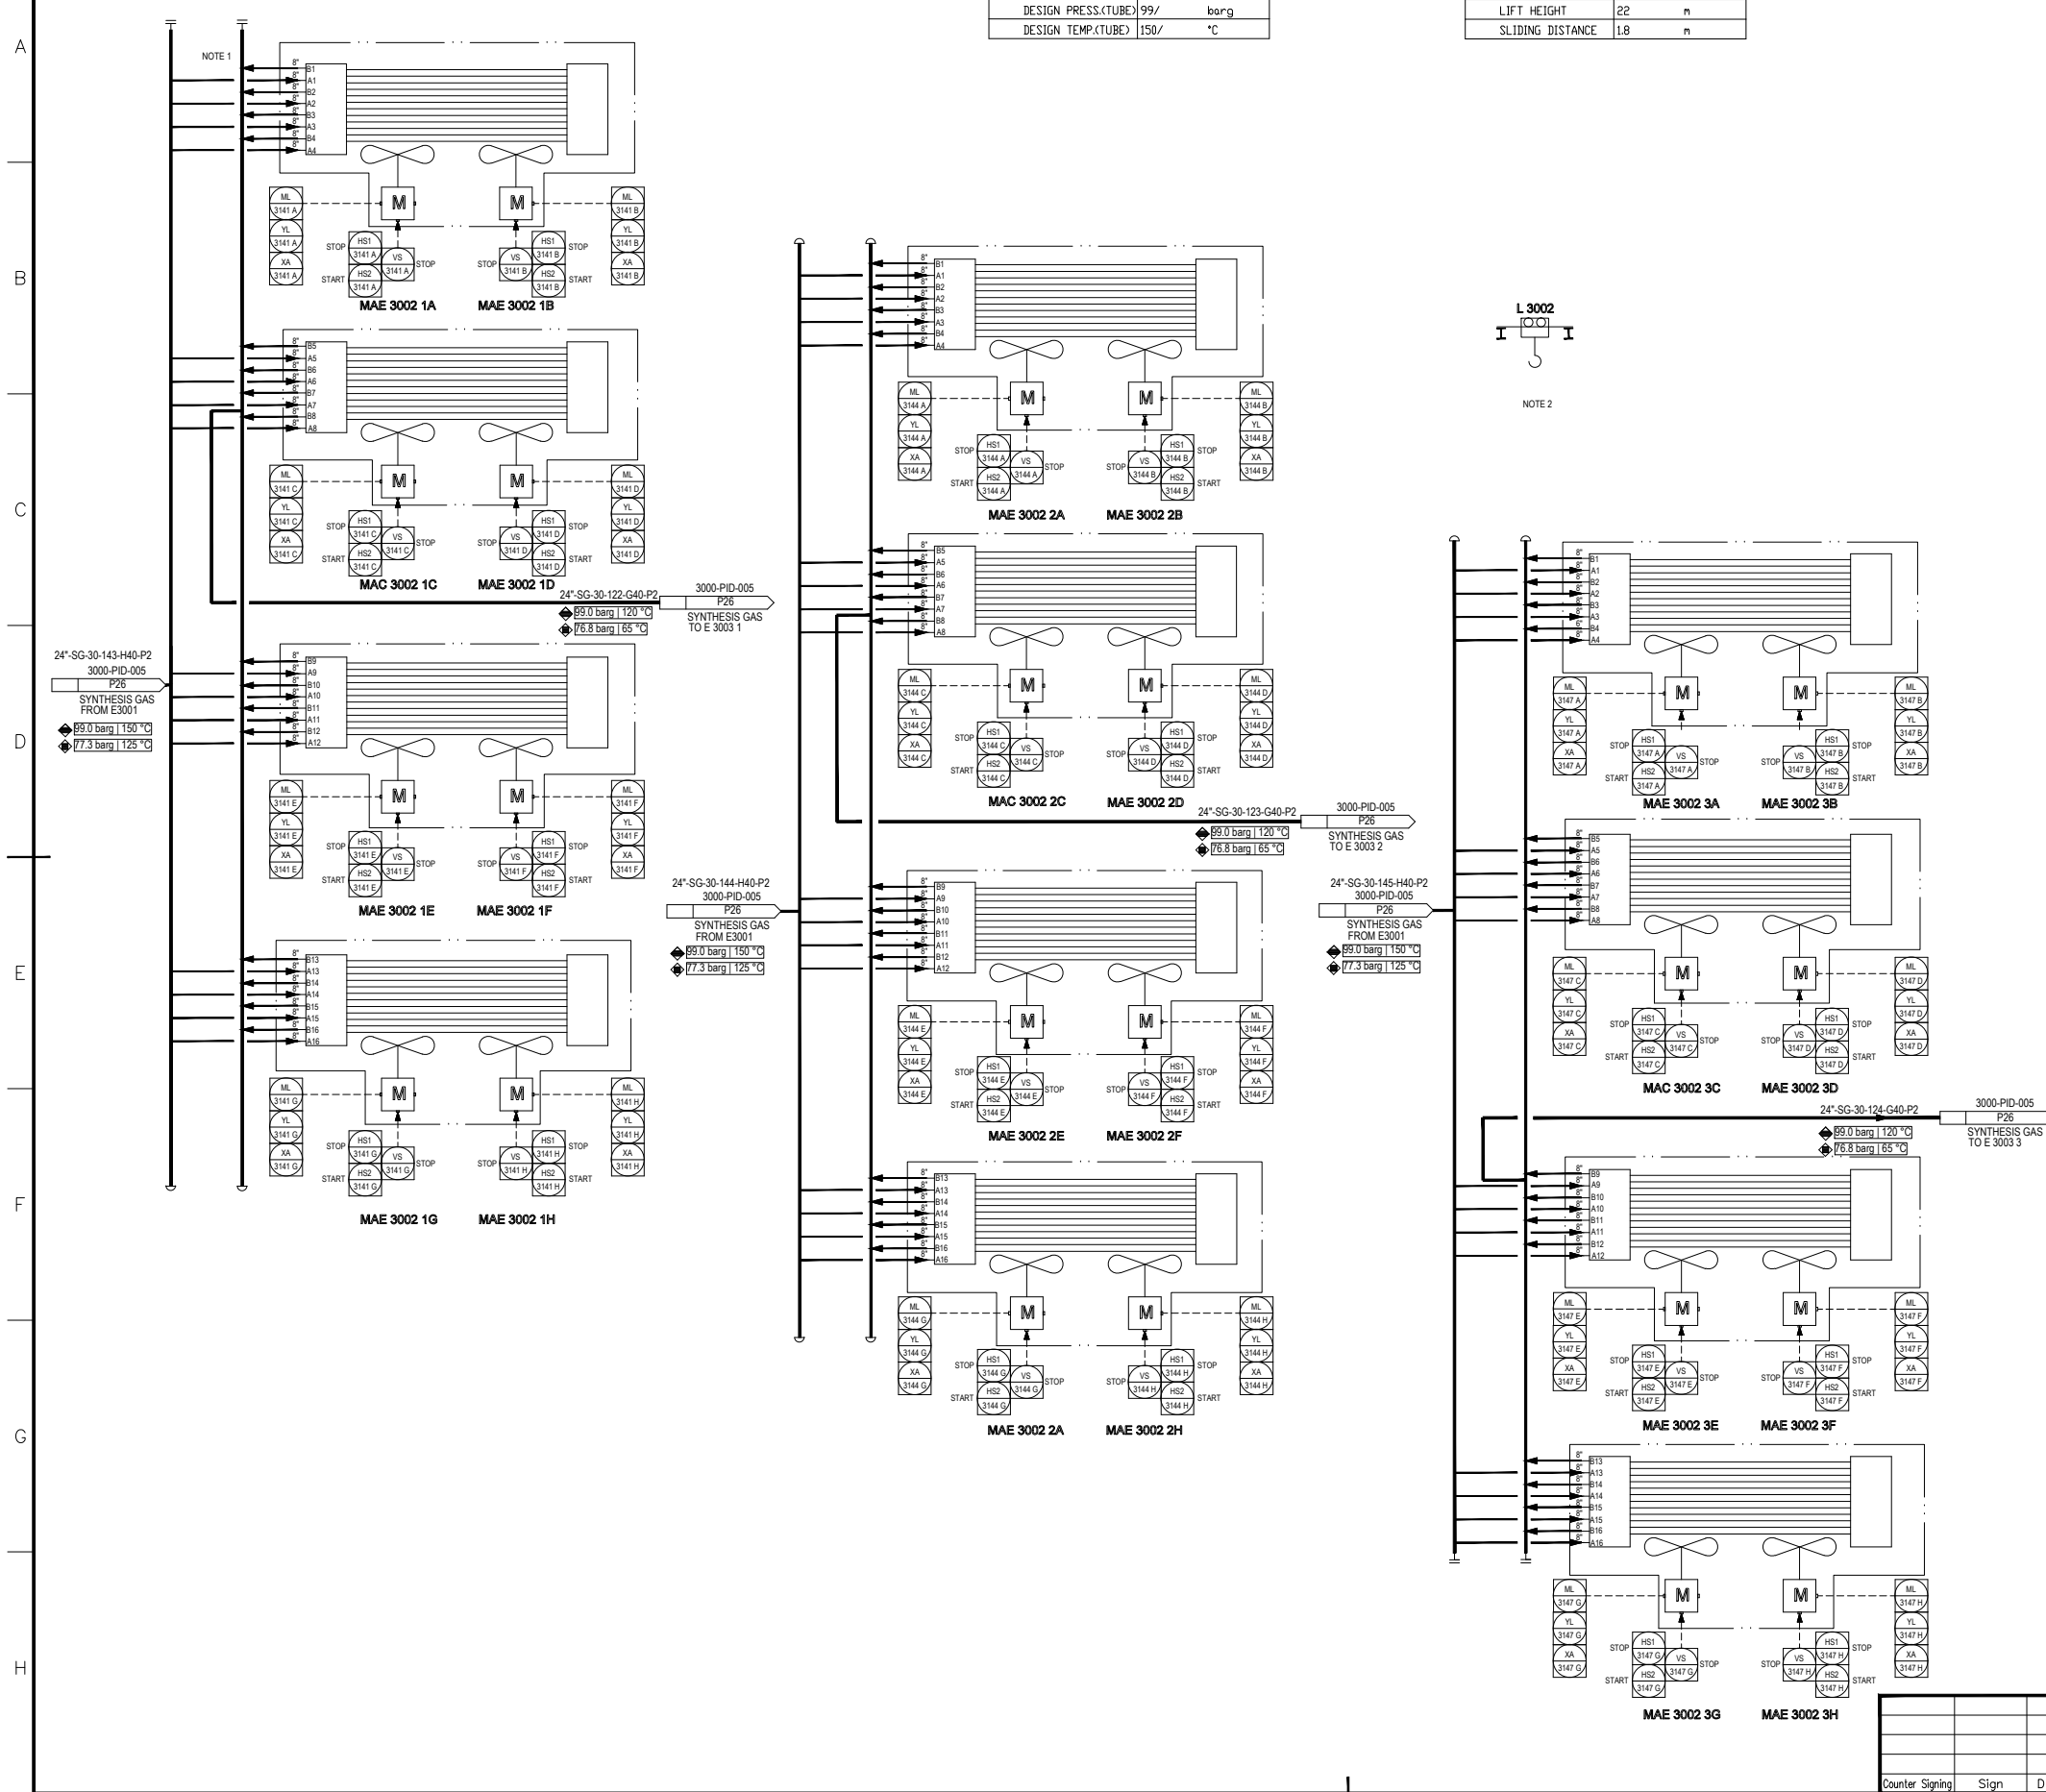**SYMBOLS AND LEGENDS**

**KEY PLAN**

As Built	30.04.2020	Li Zhijuan	Mu Yujun	Hu Qinyi			
Approved for Construction	30.12.2019	Li Zhijuan	Mu Yujun	Hu Qinyi			
Approved for Construction	22.03.2017	Li Zhijuan	Mu Yujun	Hu Qinyi			
Approved for Construction	22.01.2017	Li Zhijuan	Mu Yujun	Hu Qinyi			
Approved for Construction	13.10.2016	Li Zhijuan	Mu Yujun	Hu Qinyi			
Issued for Comments	31.08.2016	Li Zhijuan	Mu Yujun	Hu Qinyi			
REV.	PURPOSE OF ISSUE	DATE	DESIGN	DRAW	CHECK	REVIEW	APPROVE

THIS DOCUMENT IS THE PROPERTY OF TCC. NO PART OF THIS DOCUMENT SHALL BE REPRODUCED OR DISCLOSED TO OTHERS OR USED FOR ANY PURPOSE WHATSOEVER EXCEPT WITH THE PRIOR WRITTEN PERMISSION OF TCC.

OWNER: Middle East Kimiaye Pars Company

DOCUMENT NAME	JOB NO.	CONTRACT NO.	REV.
CONTRACTOR DRAWING NO.	MKP-11-AS-3000-PS09-PID-008	SHEET 01	TOTAL 01
SUB-CONTRACTOR DRAWING NO.		SHEET --	TOTAL --

AIR COOLER AE 3002 1/2/3 DETAIL PIPING AND INSTRUMENT DIAGRAM	PROJECT	MKP Methanol Project
	UNIT	METHANOL SYNTHESIS
	PHASE	As Built Drawing
OWNER DWG NO.		MKP-11-AS-3000-PR-PID-008



Counter Signing Sign Date

SCALE SHEET:1 TOT:1 SIZE:A1

SI 3001	HHP STEAM SILENCER
CAPACITY	85000 kg/hr
DESIGN PRESS.	112 barg
DESIGN TEMP.	490 °C
MATERIAL SHELL	CS
MATERIAL FILTER ELEMENT	SS

**GENERAL NOTES**

GENERAL NOTE:  
 LOW POINT DRAINS AND HIGH POINT VENT MUST BE ADDED DURING DETAILED ENGINEERING.  
 ALL WELDING CONNECTION WITH SIZE GREATER THAN 2 INCHES SHALL BE BUTT WELDED TYPE UNLESS OTHERWISE SPECIFIED.  
 ALL VALVES GREATER THAN 2 INCHES SHALL BE FLANGED TYPE UNLESS OTHERWISE SPECIFIED.  
 NOTE 1: THE HAND VALVES SHOULD BE OPENED SLOWLY.  
 NOTE 2: IS 90 IS THE TRIP OF SYNGAS COMPRESSOR AND RECIRCULATOR; IS 91 IS THE DEPRESSURIZATION OF SYNTHESIS GAS COMPRESSOR.

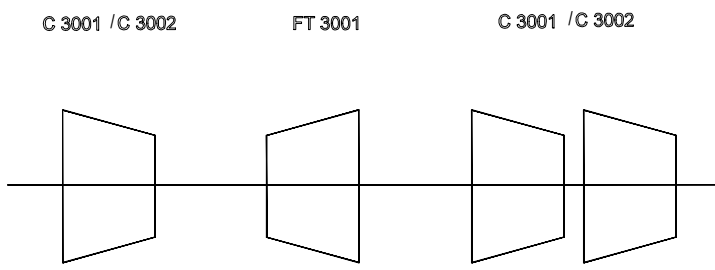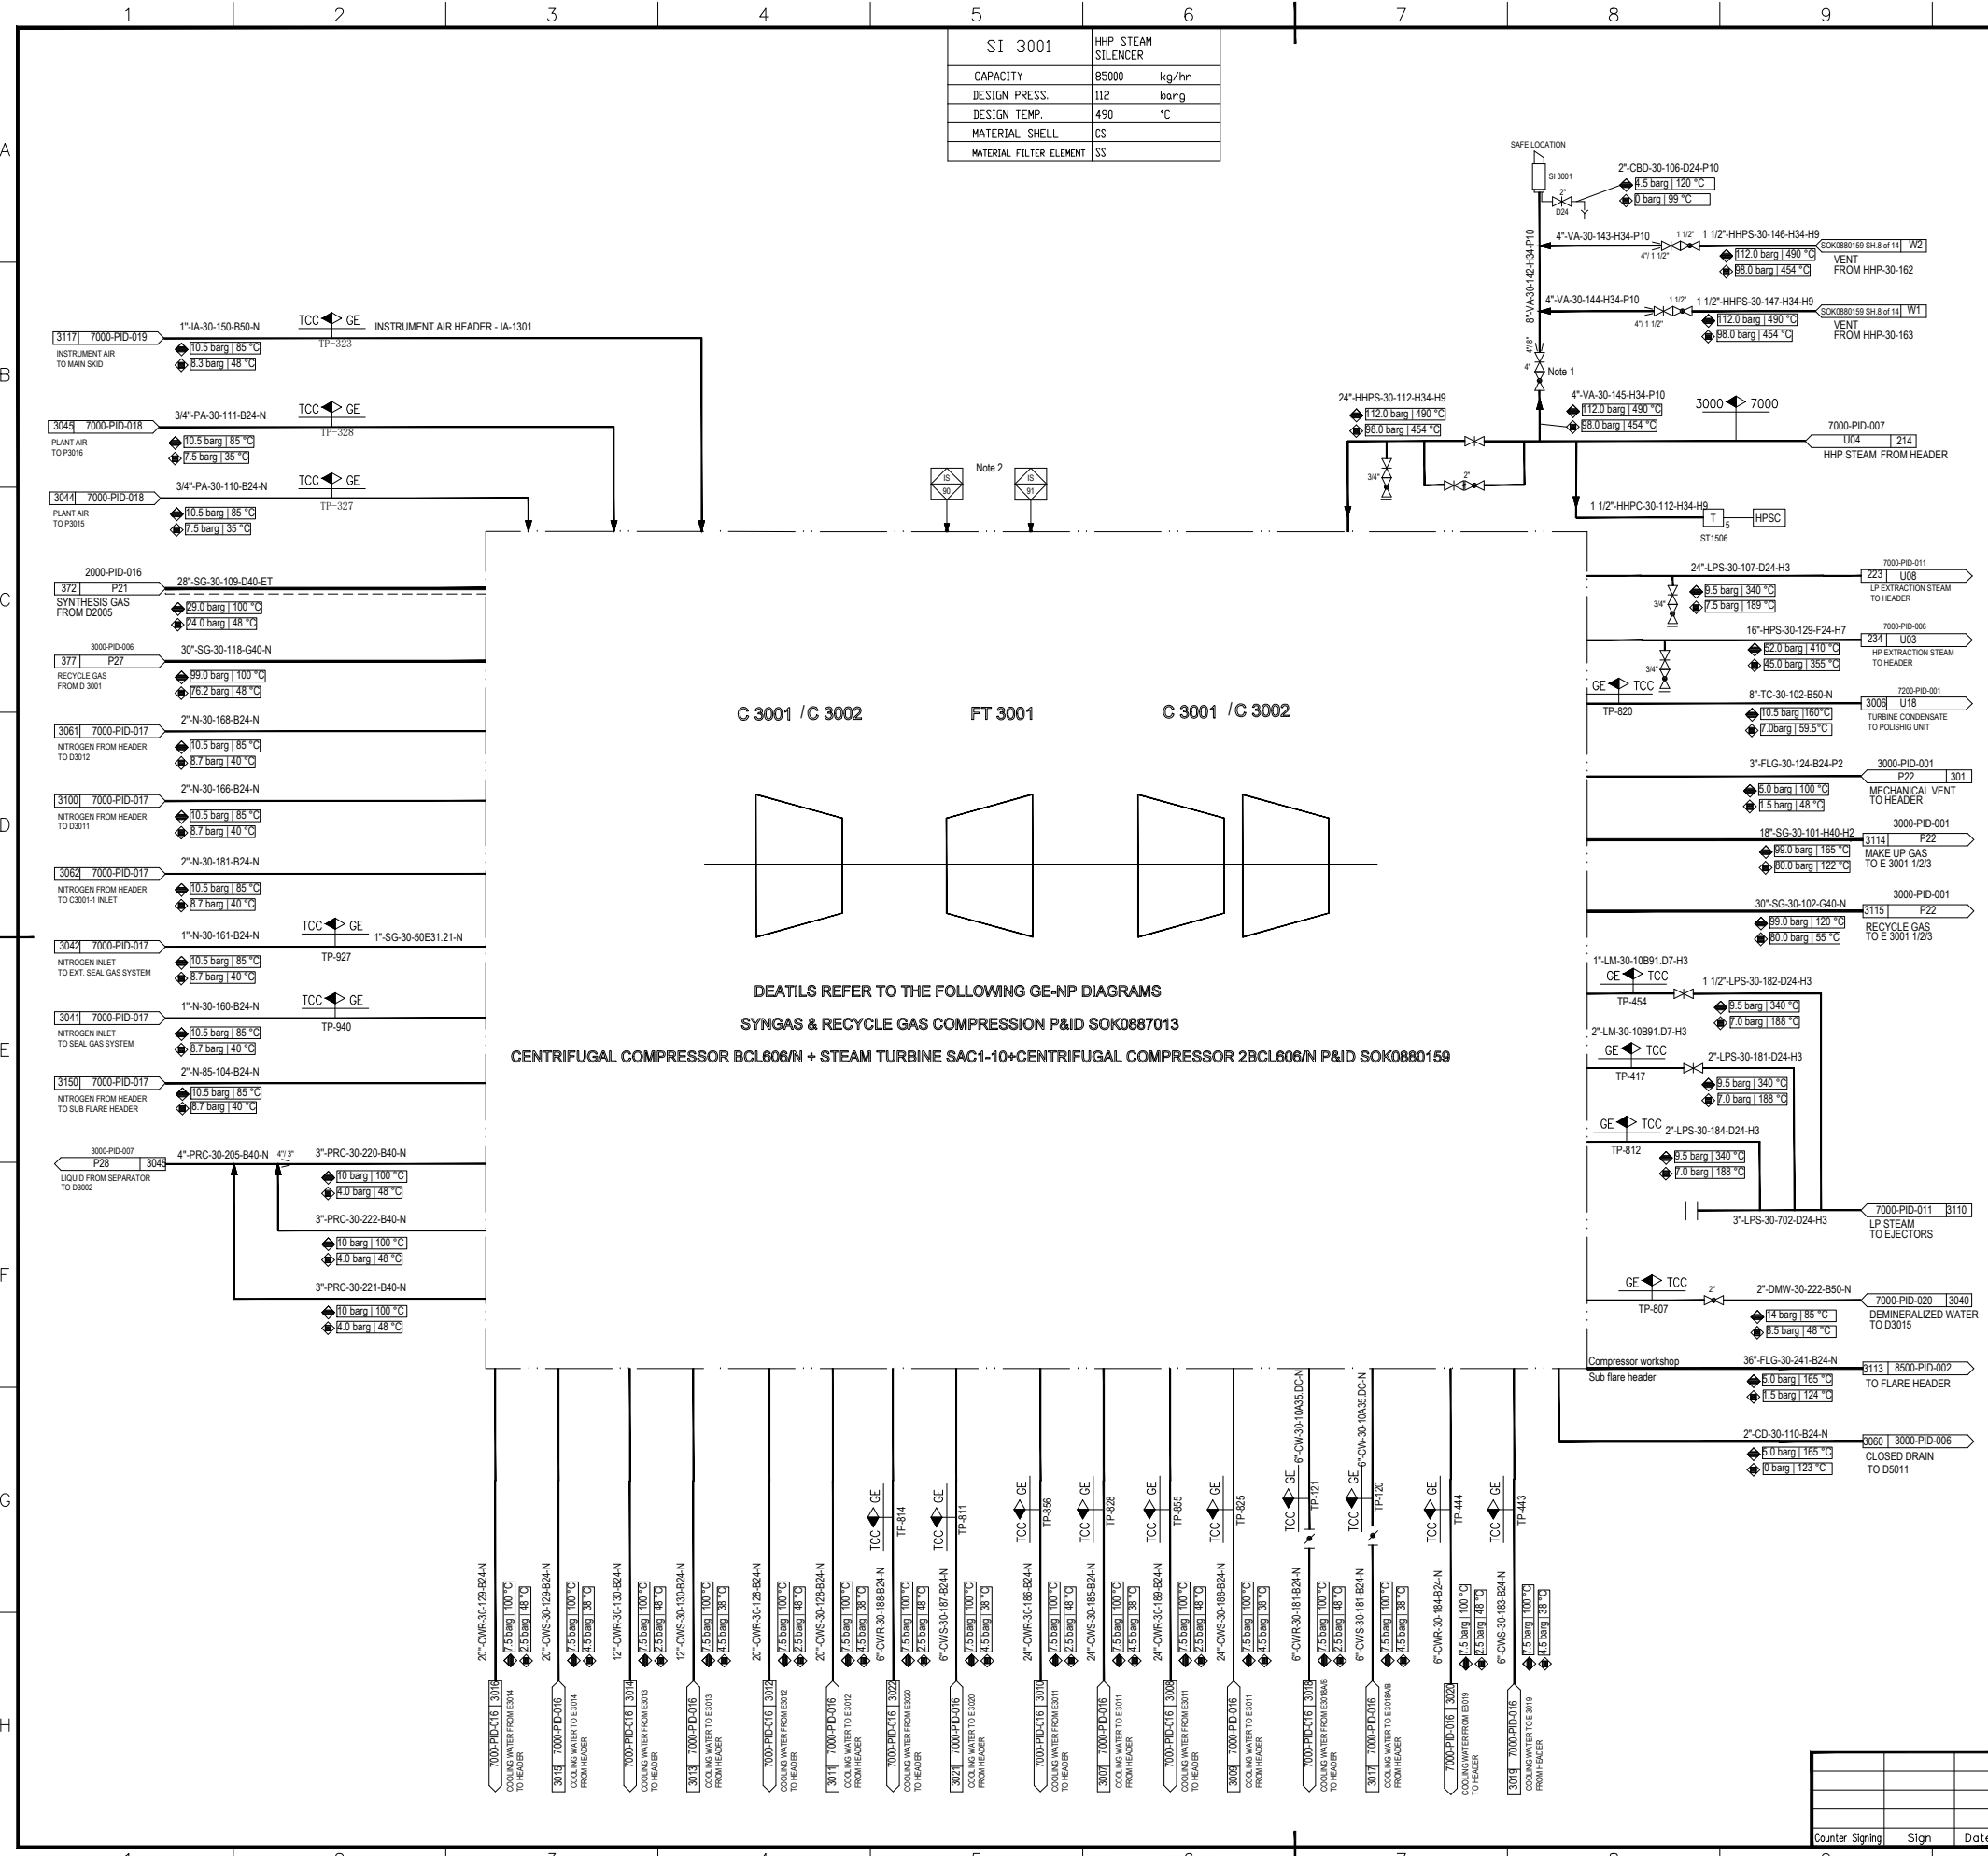

DEATLS REFER TO THE FOLLOWING GE-NP DIAGRAMS  
 SYNGAS & RECYCLE GAS COMPRESSION P&ID SOK0887013  
 CENTRIFUGAL COMPRESSOR BCL606/N + STEAM TURBINE SAC1-10+CENTRIFUGAL COMPRESSOR 2BCL606/N P&ID SOK0880159

**REFERENCE DRAWINGS**

**SYMBOLS AND LEGENDS**

**KEY PLAN**

REV.	PURPOSE OF ISSUE	DATE	DESIGN	DRAW	CHECK	REVIEW	APPROVE
▲	As Built	30.04.2020	Xu Jun		Mu Yujun	Hu Ouyi	
▲	Issued for Information	30.12.2019	Xu Jun		Mu Yujun	Hu Ouyi	
▲	Issued for Information	11.11.2018	Xu Jun		Mu Yujun	Hu Ouyi	
▲	Issued for Information	02.02.2018	Xu Jun		Mu Yujun	Hu Ouyi	
▲	Issued for Information	06.11.2017	Xu Jun		Mu Yujun	Hu Ouyi	
▲	Issued for Information	07.07.2017	Xu Jun		Mu Yujun	Hu Ouyi	

OWNER: Middle East Kimiaye Pars Company


CONTRACTOR	TCC 中国天辰工程有限公司 CHINA TIANCHEN ENGINEERING CORPORATION	CONTRACTOR DRAWING NO. MKP-11-AS-3000-PS07-PID-027
SUB-CONTRACTOR		SHEET 01 TOTAL 01
		SUB-CONTRACTOR DRAWING NO.
		SHEET -- TOTAL --

PROJECT	MKP Methanol Project
UNIT	METHANOL SYNTHESIS
PHASE	As Built Drawing
OWNER DWG NO.	MKP-11-AS-3000-PR-PID-027

Counter Signing Sign Date

SCALE:-- SHEET:1 TOT.:1 SIZE:A1



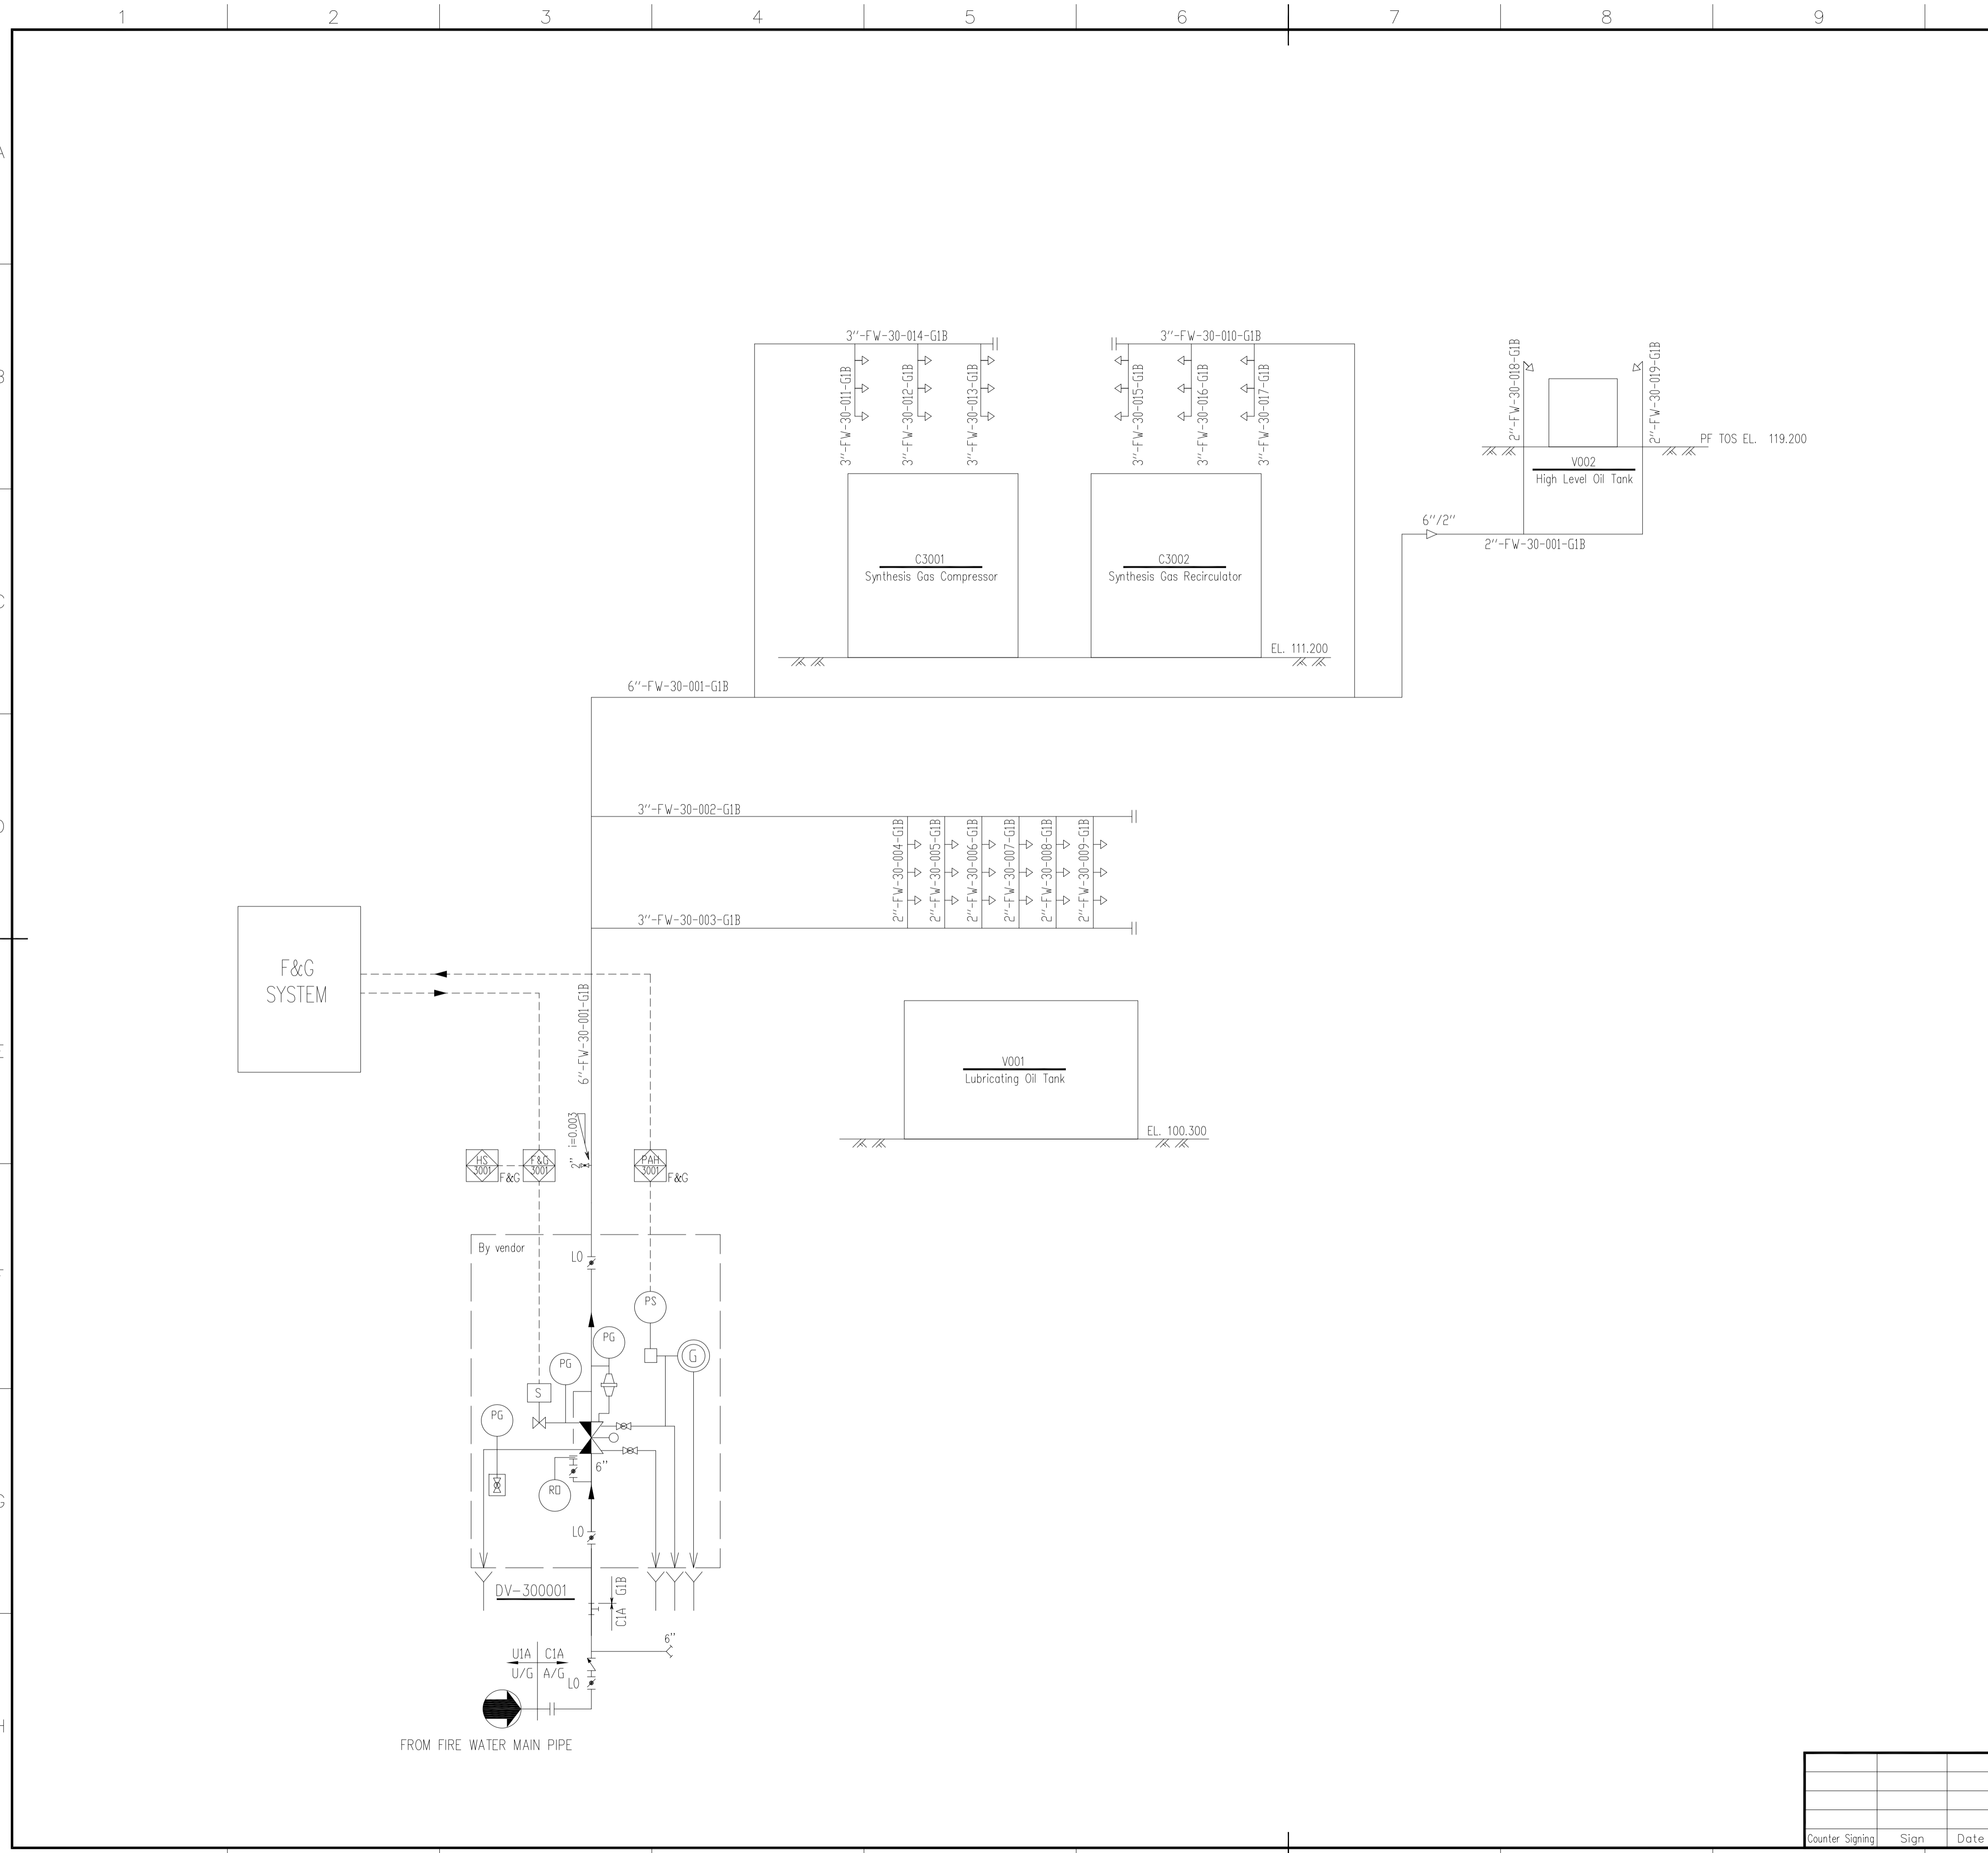


1. THE PIPE SHALL BE SLOPED TO THE DRAIN POINT . THE PIPE SHALL BE DRAINED BY DRAIN VALVE AFTER BEING USED .

**DESIGN PRAMETER FOR SPRAY SYSTEM**

DELUGE VALVE	DV-300001				
EQP.NO.	V001	V002	C3001	C3002	
AREA (m <sup>2</sup> )	48.5	2.6	26.0	26.0	
INTENSITY (L/min.m <sup>2</sup> )	20.40	20.40	20.40	20.40	
SUPPLY POWER (L/s)	35.06				
PRAMETER FOR NOZZLE	TYPE	MEDIUM-SPEED SPRAY SPRINKLER (CONE NOZZLE)			
	QUANTITY	18	2	9	9
	K-FACTOR	42	42	42	42
	MIN WORKING PRESSUR (MPa)	0.2	0.2	0.2	0.2
	SPRAY ANGLE	90°	90°	90°	90°
	DISTANCE TO EQUIPMENT BODY	2150mm	750mm	1500mm	1500mm

**PIPE NUMBER**

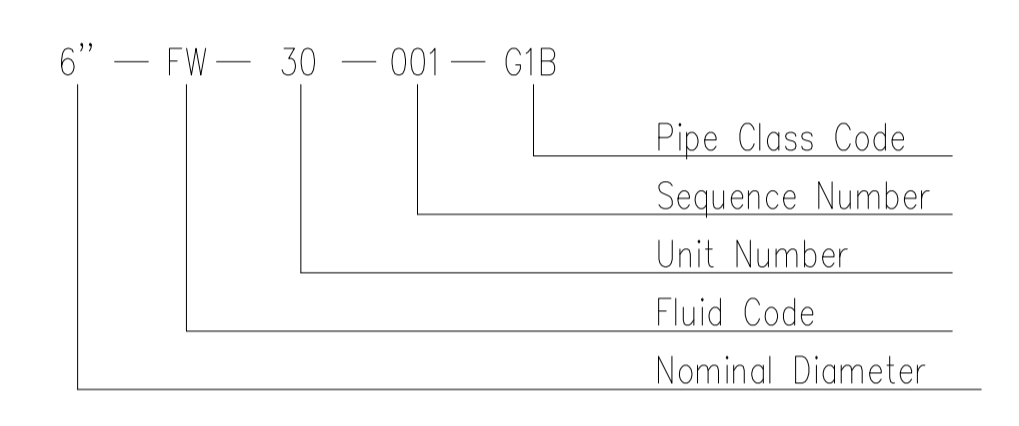

MKP-11-DE-9700-SF-SPC-001	MKP-11-DE-3000-PI-PPL-011
MKP-11-DE-9000-IN-CED-001	

**SYMBOLS AND LEGENDS**

+	spray nozzle	⊗	deluge valve
FW	fire fighting water	T	T type strainer
≡	pressure reducing orifice	⊘	butterfly valve
⊘	globe valve	⊘	ball valve
G	water motor gong	⊘	check valve
⊘	pressure operated relief valve(P.O.R.V.)	⊘	emergency release

REV.	DESCRIPTION	DATE	DESIGN	DRAW	CHECK	REVIEW	APPROVE
△	As built	30.04.2020	Liu Jian		Cui Yanjun	Deng Wenhui	
△	Approved for Construction	10.12.2019	Liu Jian		Cui Yanjun	Deng Wenhui	
△	Approved for Construction	16.03.2017	Liu Jian		Cui Yanjun	Deng Wenhui	
△	Approved for Construction	12.12.2016	Liu Jian		Cui Yanjun	Deng Wenhui	
△	Approved for Construction	19.12.2016	Liu Jian		Cui Yanjun	Deng Wenhui	
△	Approved for Construction	31.10.2016	Liu Jian		Cui Yanjun	Deng Wenhui	

THIS DOCUMENT IS THE PROPERTY OF TCC. NO PART OF THIS DOCUMENT SHALL BE REPRODUCED OR DISCLOSED TO OTHERS OR USED FOR ANY PURPOSE WHATSOEVER EXCEPT WITH THE PRIOR WRITTEN PERMISSION OF TCC.

OWNER: **Middle East Kimiaye Pars Company**

LICENSOR <b>HALDOR TOPSØE A/S</b>	DOCUMENT NAME:	JOB NO.	DOC. GRP.	REV.
CONTRACTOR <b>TCC 中国天辰工程有限公司</b> CHINA TIANCHEN ENGINEERING CORPORATION		DWG. NO.	CONTRACT	
SUB-CONTRACTOR		CONTRACTOR DRAWING NO. MKP-11-AS-3000-PF03-PID-001		
		SHEET 01 TOTAL 01		
		SUB-CONTRACTOR DRAWING NO.		
		SHEET - TOTAL -		

P&ID FOR SPRINKLER SYSTEM IN UNIT 3000	PROJECT	MKP Methanol Project			
	UNIT	Methanol synthesis			
	PHASE	As built drawing			
SCALE N/A	SHEET 1	TOT. 1	SIZE A1	OWNER DWG NO.	MKP-11-AS-3000-SF-PID-001

Counter Signing	Sign	Date
-----------------	------	------




TK4001 2	METHANOL TANK
ID x LENGTH	34000 x 27000 mm
NET WORKING CAPACITY	18848 m <sup>3</sup>
DESIGN PRESS.	-0.003/0.02 barg
DESIGN TEMP.	85 °C
MATERIAL SHELL	CS
Elev. of EQUIPMENT	EL 101.050 m

P4001 A/B	METHANOL TRANSFER PUMP
CAPACITY	487 m <sup>3</sup> /h
Head	102 m
POWER	160 kW
MATERIAL	CS
DRIVER TYPE	MOTOR
Elev. of Equipment	101.13 m

**GENERAL NOTES**

- † NOTES:
- 1) NO POCKET ALLOWED.
  - 2) ALL METHANOL PIPES TO BE CONNECTED TO GROUND FOR ELECTROSTATIC PROTECTION.
  - 5) SELF REGULATING PRESSURE CONTROL VALVE. INSTALLED ON THE TOP OF THE TANK.
  - 7) L1 IS USED FOR THE INDUCED TUBE.
  - 8) LT 4008, LT 4010 SHOULD HAVE A LOCAL INDICATOR EASILY TO BE SEEN AT THE TANK SIDE.

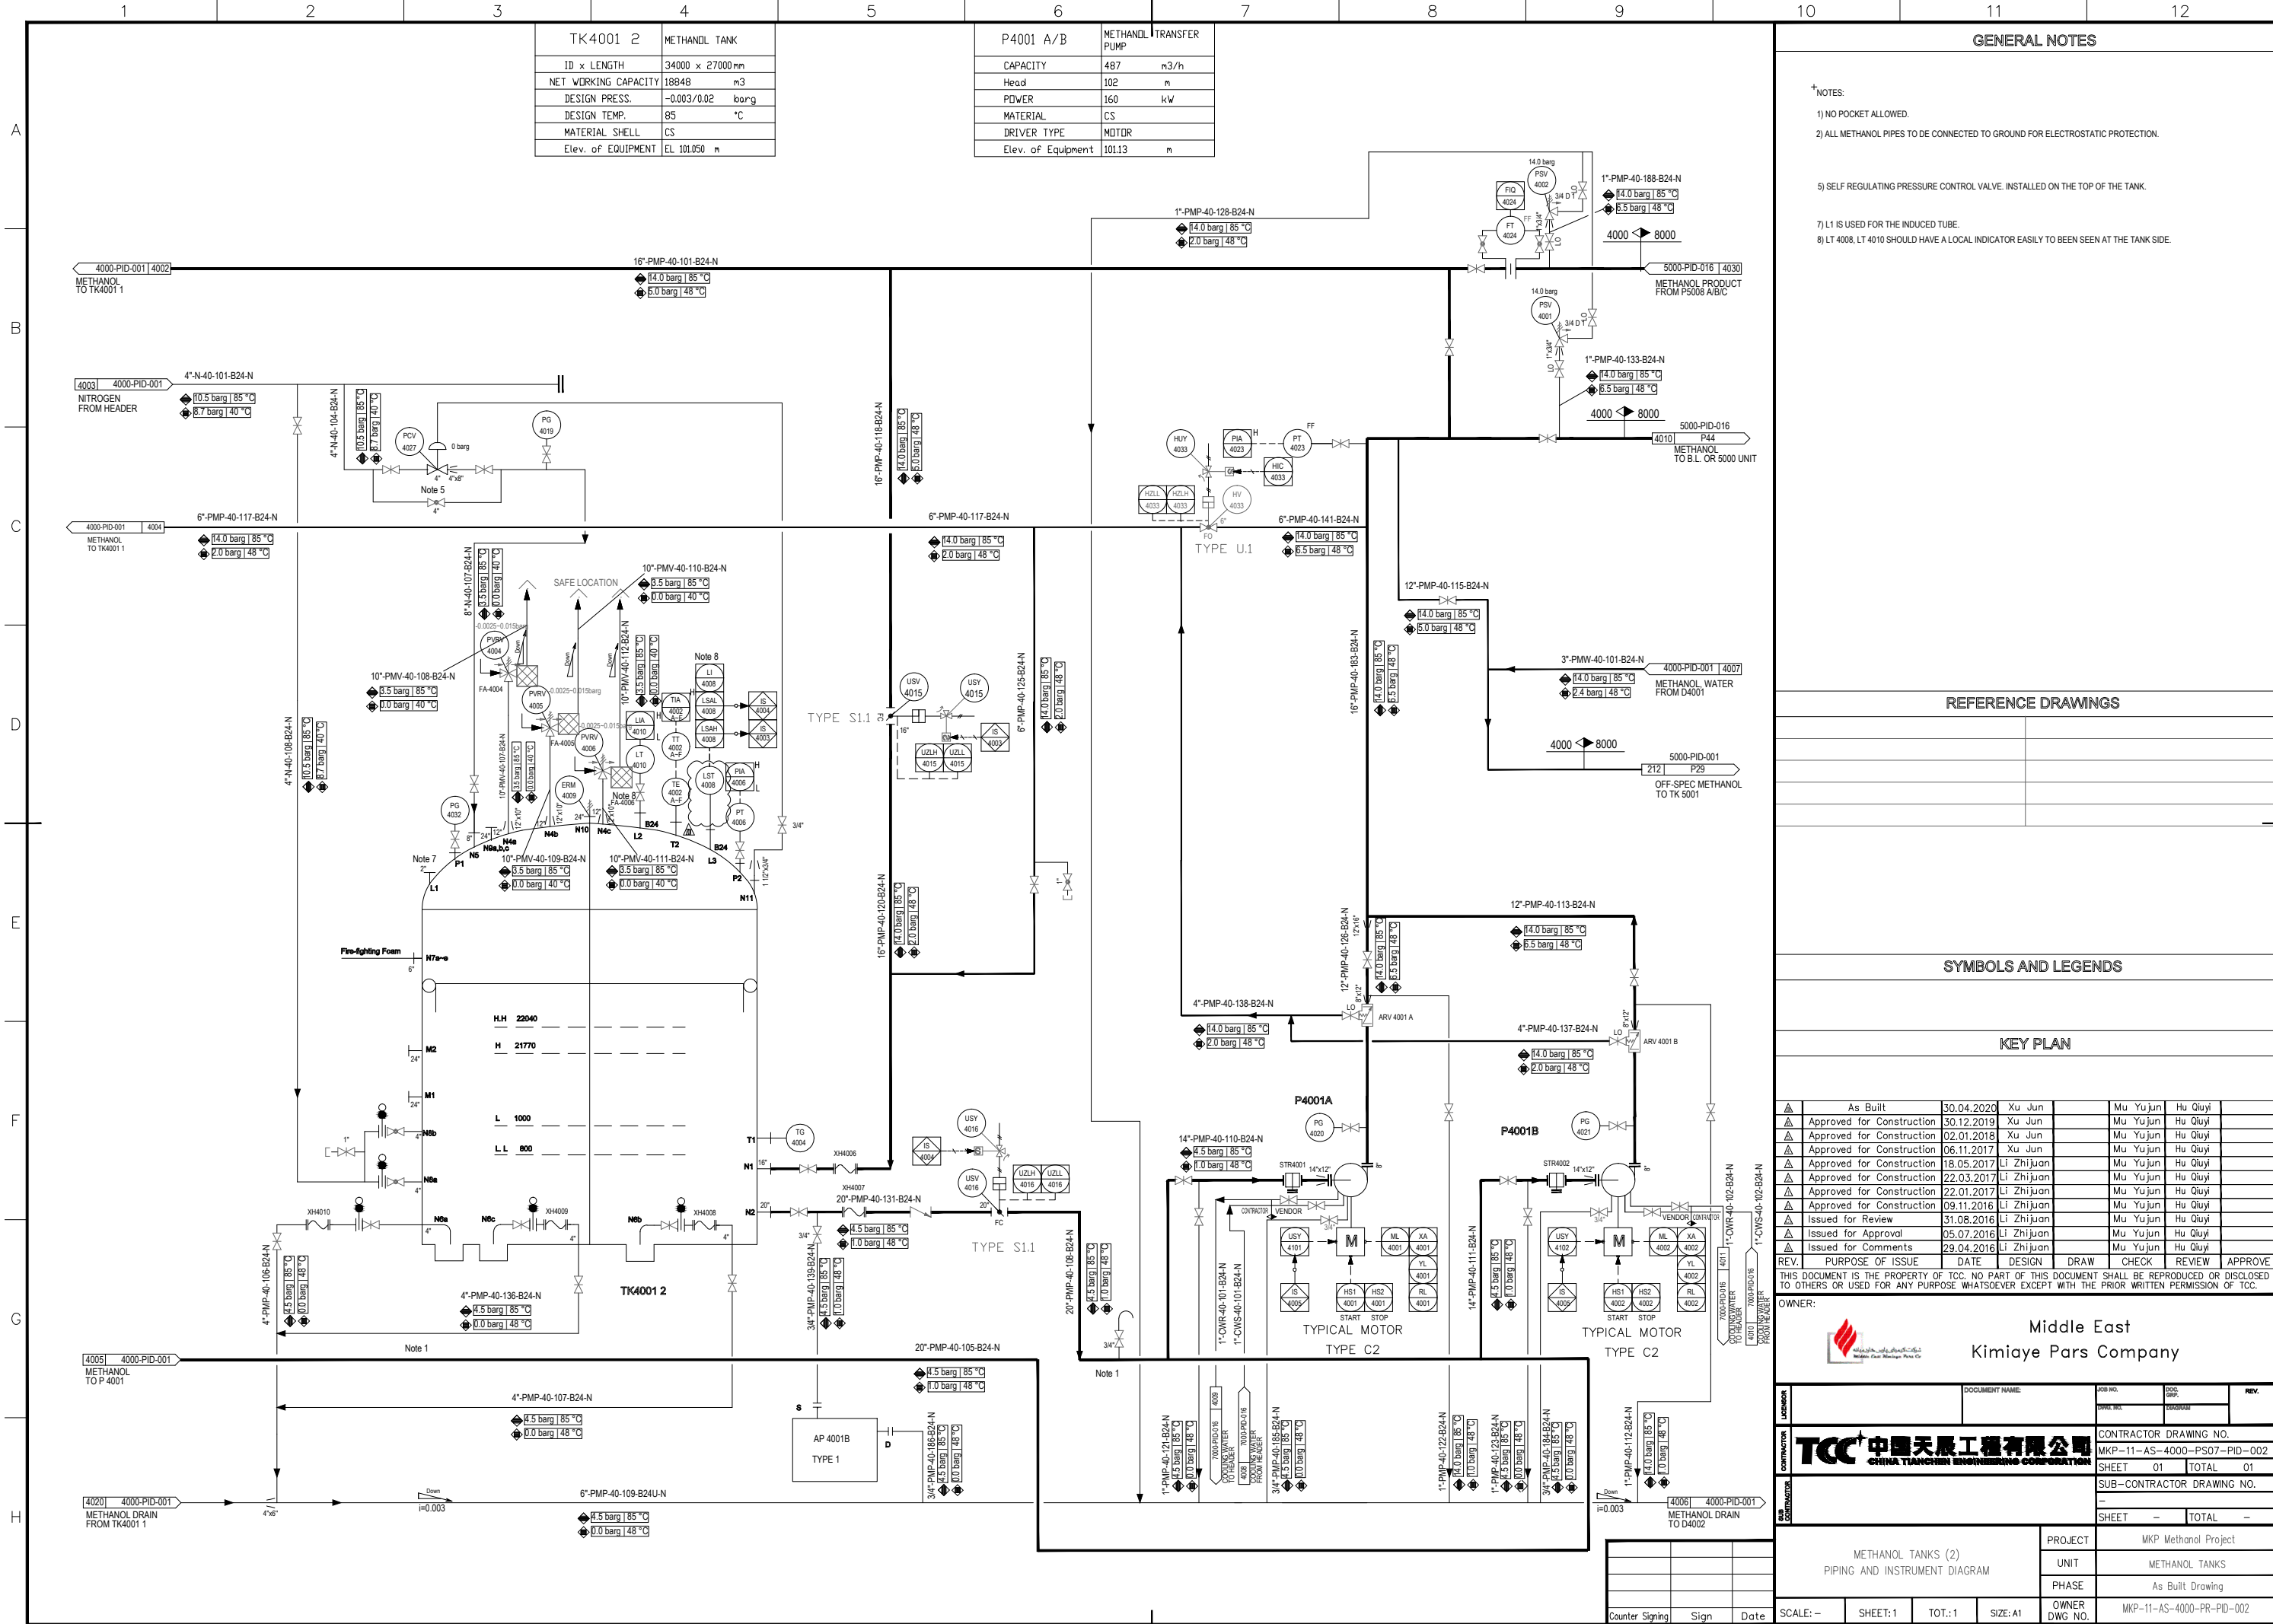

**REFERENCE DRAWINGS**

**SYMBOLS AND LEGENDS**

**KEY PLAN**


REV.	PURPOSE OF ISSUE	DATE	DESIGN	DRAW	CHECK	REVIEW	APPROVE
▲	As Built	30.04.2020	Xu Jun		Mu Yu jun	Hu Qiuyi	
▲	Approved for Construction	30.12.2019	Xu Jun		Mu Yu jun	Hu Qiuyi	
▲	Approved for Construction	02.01.2018	Xu Jun		Mu Yu jun	Hu Qiuyi	
▲	Approved for Construction	06.11.2017	Xu Jun		Mu Yu jun	Hu Qiuyi	
▲	Approved for Construction	18.05.2017	Li Zhijuan		Mu Yu jun	Hu Qiuyi	
▲	Approved for Construction	22.03.2017	Li Zhijuan		Mu Yu jun	Hu Qiuyi	
▲	Approved for Construction	22.01.2017	Li Zhijuan		Mu Yu jun	Hu Qiuyi	
▲	Approved for Construction	09.11.2016	Li Zhijuan		Mu Yu jun	Hu Qiuyi	
▲	Issued for Review	31.08.2016	Li Zhijuan		Mu Yu jun	Hu Qiuyi	
▲	Issued for Approval	05.07.2016	Li Zhijuan		Mu Yu jun	Hu Qiuyi	
▲	Issued for Comments	29.04.2016	Li Zhijuan		Mu Yu jun	Hu Qiuyi	

THIS DOCUMENT IS THE PROPERTY OF TCC. NO PART OF THIS DOCUMENT SHALL BE REPRODUCED OR DISCLOSED TO OTHERS OR USED FOR ANY PURPOSE WHATSOEVER EXCEPT WITH THE PRIOR WRITTEN PERMISSION OF TCC.

OWNER: Middle East Kimiaye Pars Company

DOCUMENT NAME:	ASB NO.:	REV.:
CONTRACTOR: <b>TCC 中国天辰工程技术有限公司</b>	CONTRACTOR DRAWING NO.:	
	MKP-11-AS-4000-PR-002	
	SHEET 01 TOTAL 01	
	SUB-CONTRACTOR DRAWING NO.:	
	SHEET - TOTAL -	
PROJECT: MKP Methanol Project		
UNIT: METHANOL TANKS		
PHASE: As Built Drawing		
OWNER DWG NO.:		MKP-11-AS-4000-PR-002


1 2 3 4 5 6 7 8 9 10 11 12

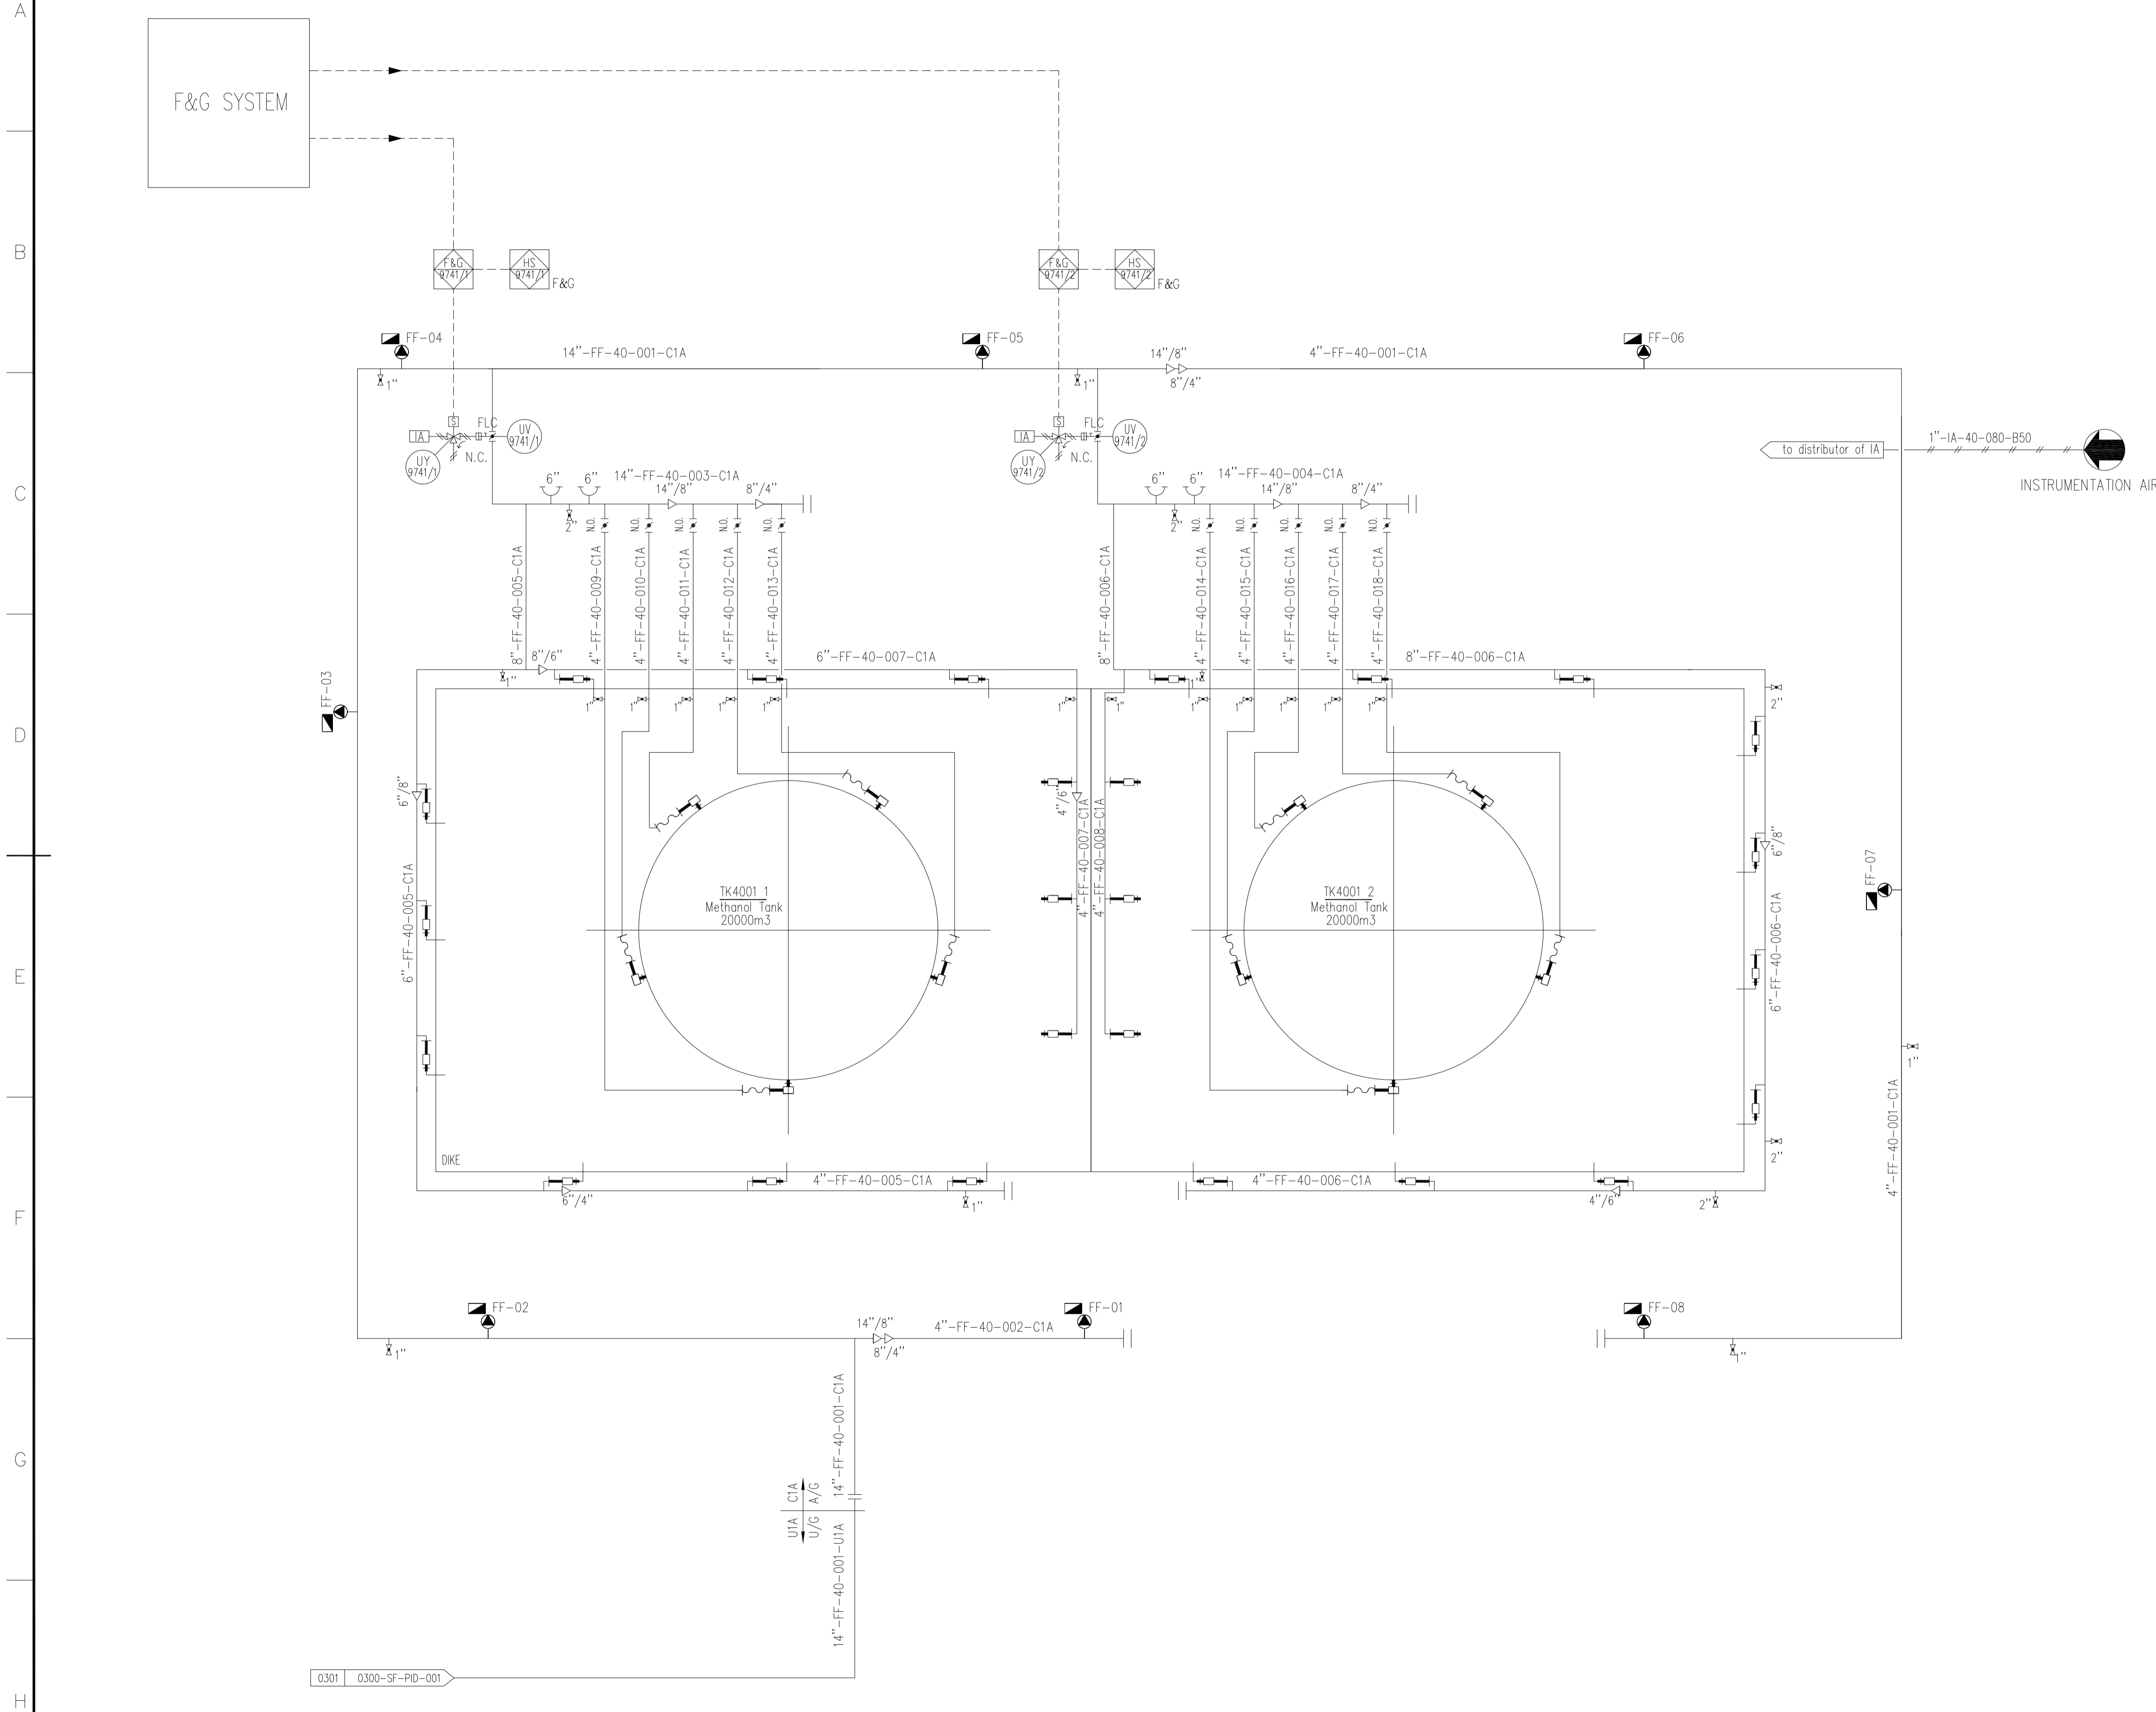

**GENERAL NOTES**

Emptying foam solution should be collected to oily water collection system.

**PIPE NUMBER**

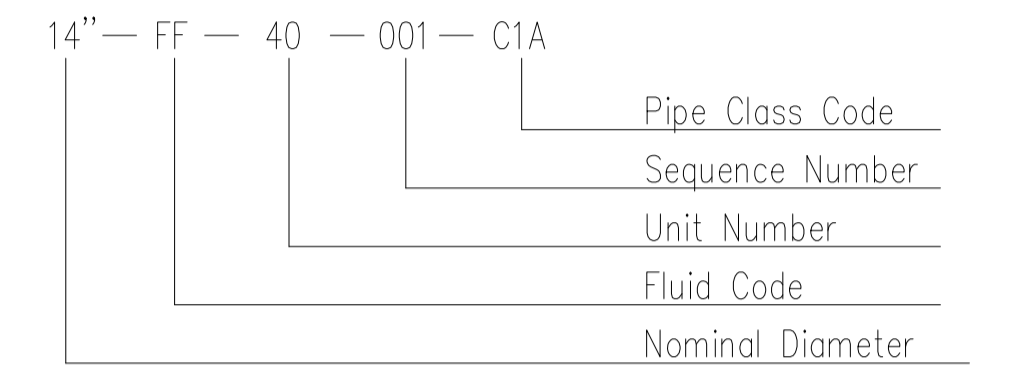

**REFERENCE DRAWINGS**

MKP-11-DE-0300-SF-PID-001	MKP-11-DE-4000-PI-PPL-014
MKP-11-DE-9700-SF-SPC-001	

**SYMBOLS AND LEGENDS**

	Foam chamber (Vertical)		Foam chamber (Horizontal)
	Metalic hose	FF	Foam solution
	Foam hydrant	N.C.	Normal close
	Foam hydrant cabinet	N.O.	Normal open
	Reducer		Fire connection

REV.	DESCRIPTION	DATE	DESIGN	DRAW	CHECK	REVIEW	APPROVE
△	As built	30.04.2020	Liu Jian		Cui Yanjun	Deng Wenhui	
△	Approved for Construction	31.12.2019	Liu Jian		Cui Yanjun	Deng Wenhui	
△	Approved for Construction	28.11.2019	Liu Jian		Cui Yanjun	Deng Wenhui	
△	Approved for Construction	30.09.2017	Li Yang		Cui Yanjun	Deng Wenhui	
△	Approved for Construction	19.10.2016	Li Yang		Cui Yanjun	Deng Wenhui	
△	Approved for Construction	23.09.2016	Li Yang		Cui Yanjun	Deng Wenhui	
△	Approved for Construction	02.09.2016	Li Yang		Cui Yanjun	Deng Wenhui	

THIS DOCUMENT IS THE PROPERTY OF TCC. NO PART OF THIS DOCUMENT SHALL BE REPRODUCED OR DISCLOSED TO OTHERS OR USED FOR ANY PURPOSE WHATSOEVER EXCEPT WITH THE PRIOR WRITTEN PERMISSION OF TCC.

OWNER: Middle East Kimiaye Pars Company


LICENSOR	HALDOR TOPSØE A/S	DOCUMENT NAME:	JOB NO.	DWG. NO.	DOC. GRP.	REV.
CONTRACTOR	<b>TCC</b> 中国天辰工程有限公司 CHINA TIANCHEN ENGINEERING CORPORATION	CONTRACTOR DRAWING NO.	MKP-11-AS-4000-PF03-PID-001			
DESIGNER		SHEET	01	TOTAL	01	
SUB-CONTRACTOR	SUB-CONTRACTOR LOGO	SUB-CONTRACTOR DRAWING NO.	-			
		SHEET	-	TOTAL	-	

P&ID FOR FOAM SYSTEM IN UNIT 4000		PROJECT	MKP Methanol Project	
		UNIT	Methanol Tanks	
		PHASE	As built drawing	
SCALE	N/A	SHEET	1	TOT. 1
SIZE	A1	OWNER DWG NO.	MKP-11-AS-4000-SF-PID-001	

Counter Signing	Sign	Date
-----------------	------	------


1 2 3 4 5 6 7 8 9 10 11 12



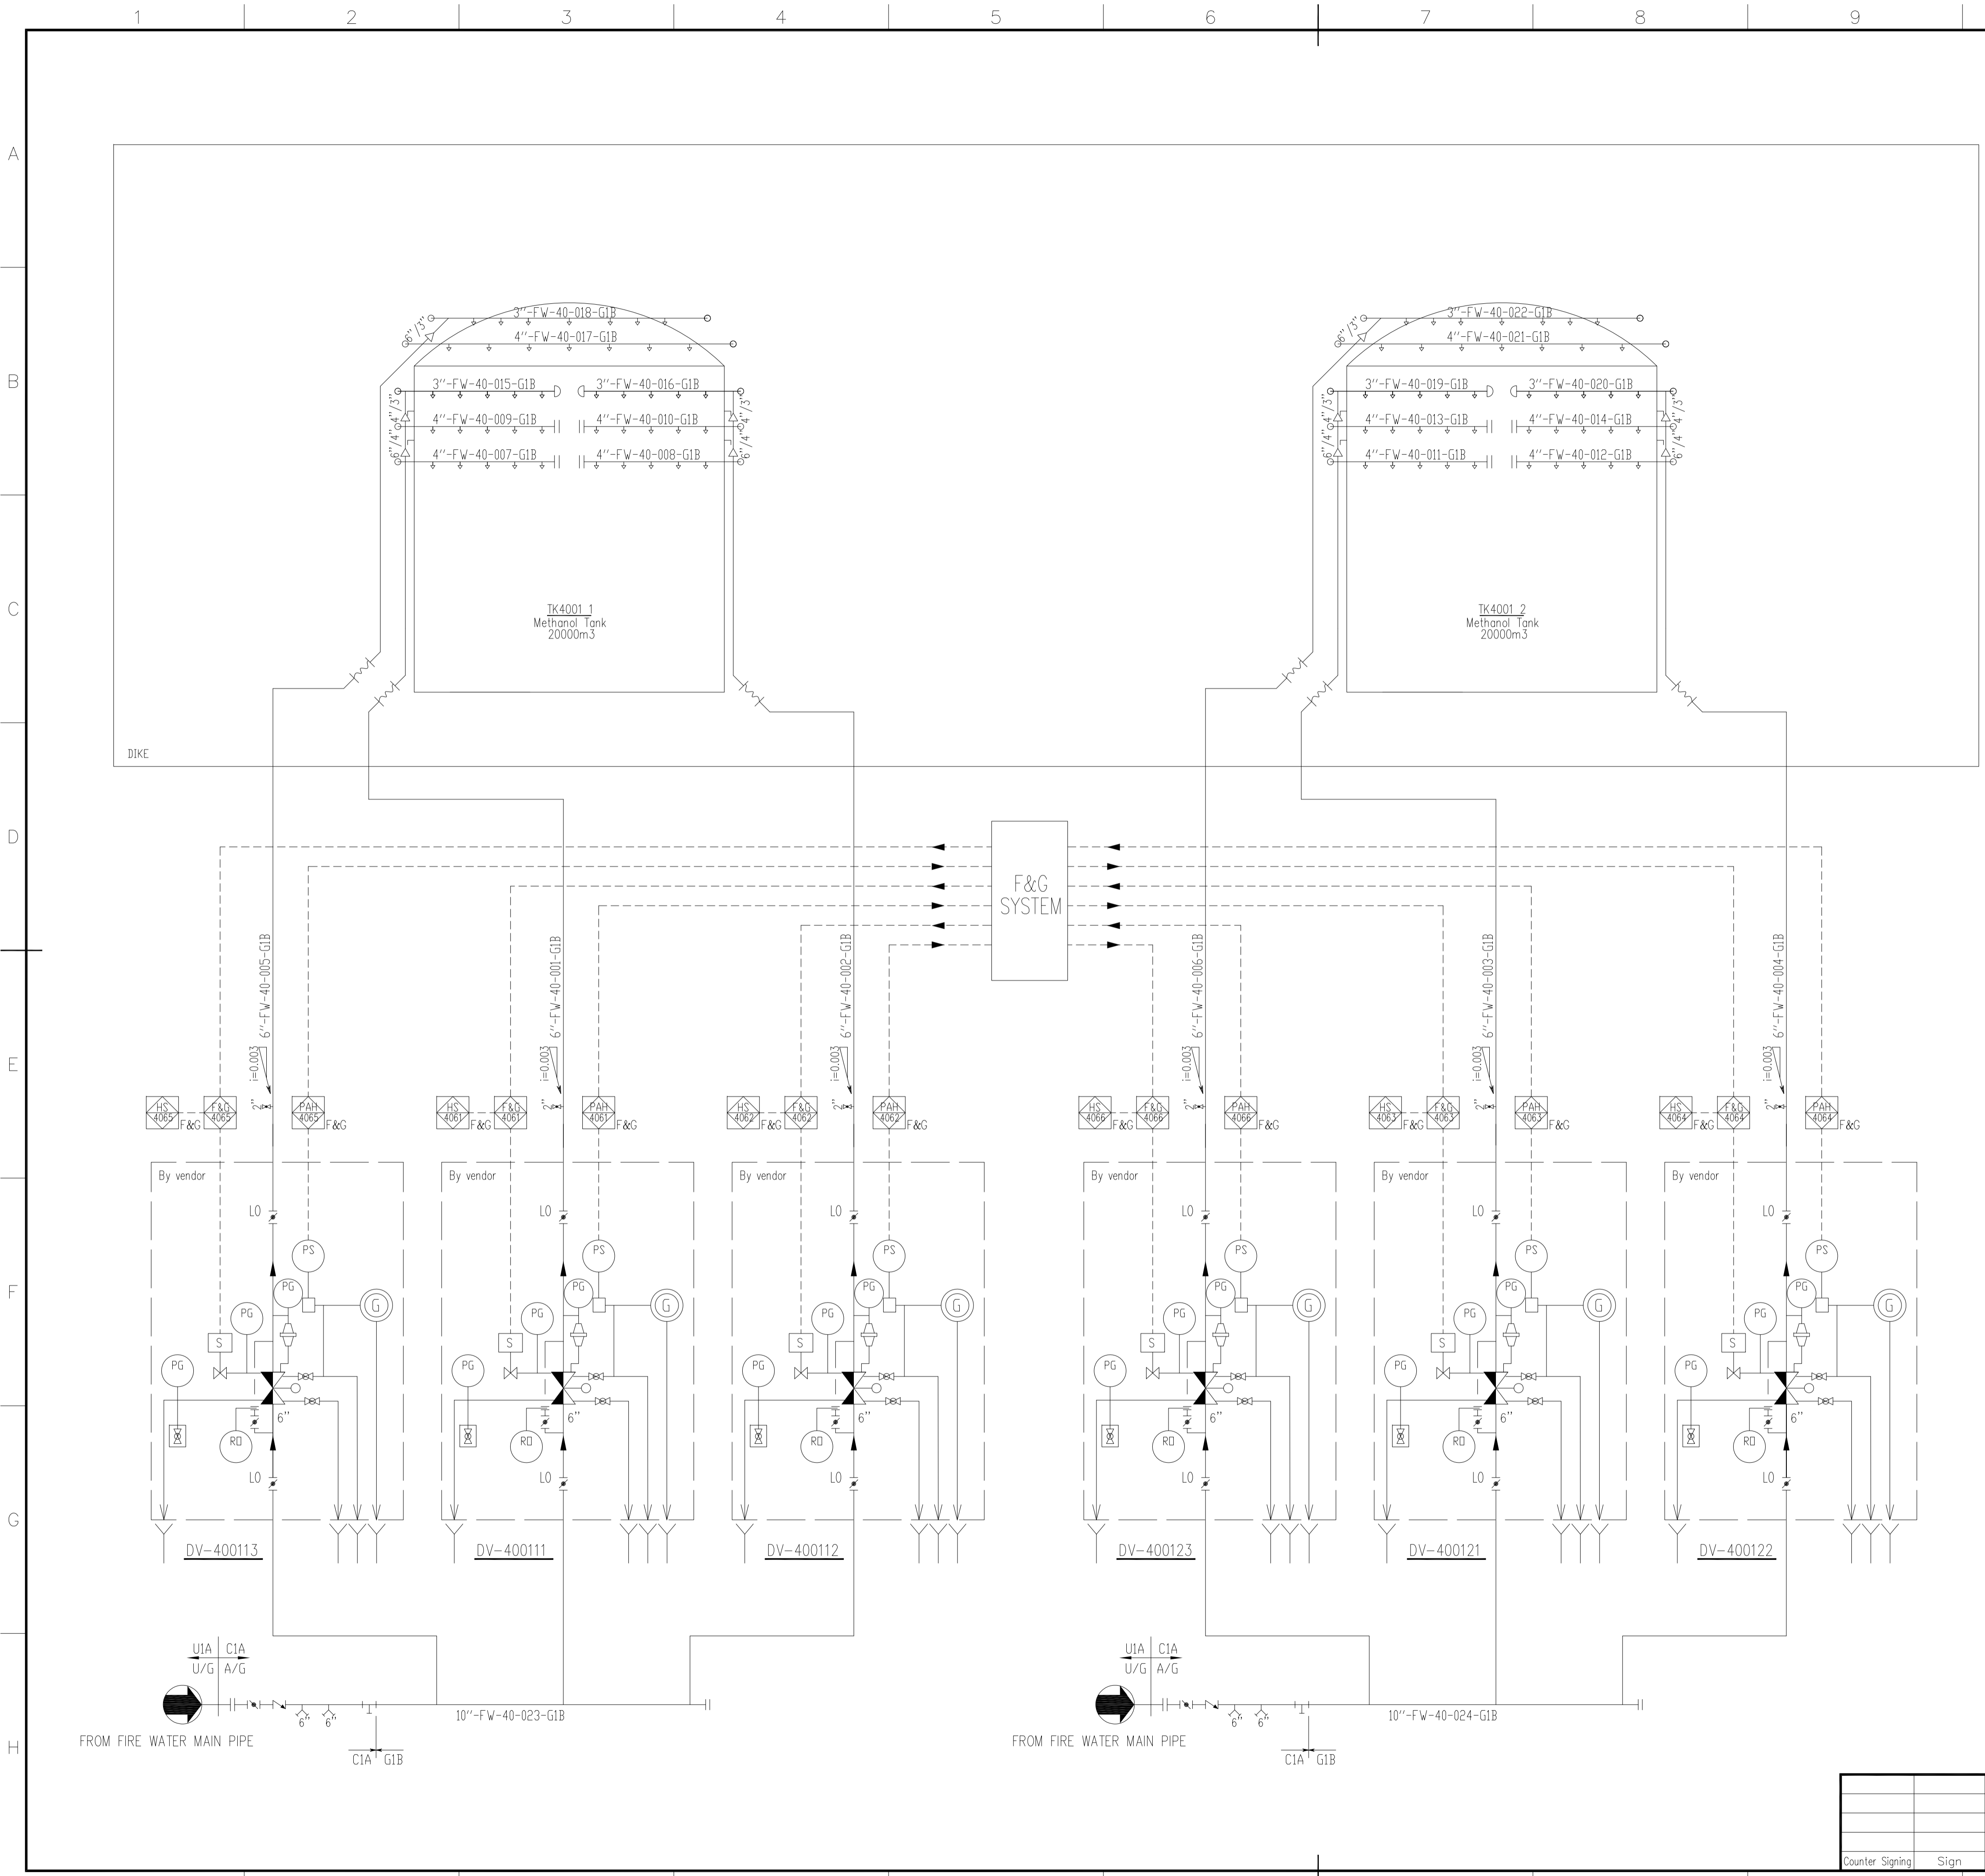

GENERAL NOTES

PIPE NUMBER

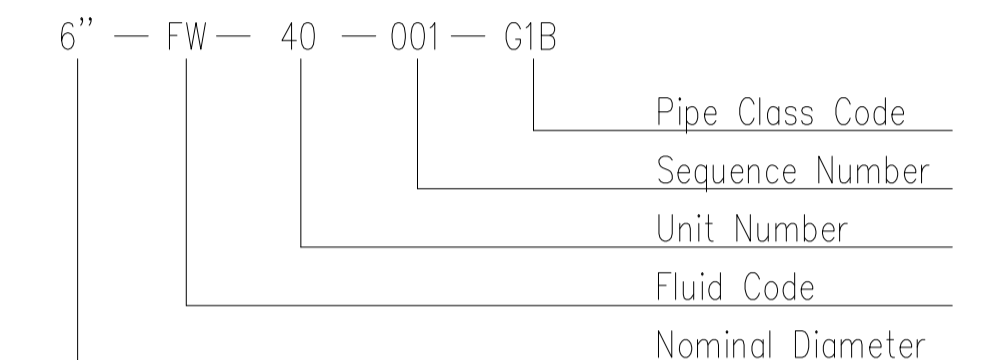

REFERENCE DRAWINGS

MKP-11-DE-9700-SF-SPC-001	MKP-11-DE-4000-PI-PPL-014
MKP-11-DE-9000-IN-CED-001	

SYMBOLS AND LEGENDS

	spray nozzle		deluge valve
	fire fighting water		T type strainer
	metal hose		butterfly valve
	globe valve		ball valve
	water motor gong		check valve
	vacuum stiff. ring		blind flange
	pipe gap		emergency release
	pressure operated relief valve(P.O.R.V.)		

As built	30.04.2020	Liu Jian		Cui Yanjun	Deng Wenhui
Approved for Construction	15.03.2016	Li Yang		Cui Yanjun	Deng Wenhui
Approved for Construction	16.12.2016	Li Yang		Cui Yanjun	Deng Wenhui
Approved for Construction	23.09.2016	Li Yang		Cui Yanjun	Deng Wenhui

THIS DOCUMENT IS THE PROPERTY OF TCC. NO PART OF THIS DOCUMENT SHALL BE REPRODUCED OR DISCLOSED TO OTHERS OR USED FOR ANY PURPOSE WHATSOEVER EXCEPT WITH THE PRIOR WRITTEN PERMISSION OF TCC.

OWNER: Middle East Kimiaye Pars Company

LICENSOR	HALDOR TOPSØE A/S	DOCUMENT NAME:	JOB NO.	DOC. GRP.	REV.

CONTRACTOR		CONTRACTOR DRAWING NO.	
		MKP-11-AS-4000-PF03-PID-002	

SUB-CONTRACTOR	SUB-CONTRACTOR LOGO	SUB-CONTRACTOR DRAWING NO.	

SCALE	N/A	SHEET	1	TOT.	1	SIZE	A1	PROJECT	MKP Methanol Project
								UNIT	Methanol Tanks
								PHASE	As built drawing
OWNER	DWG NO.	MKP-11-AS-4000-SF-PID-002							

Counter Signing	Sign	Date


**GENERAL NOTES**

1. THE PIPE SHALL BE SLOPED TO THE DRAIN POINT , THE PIPE SHALL BE DRAINED BY DRAIN VALVE AFTER BEING USED .
2. DELUGE VALVE SHALL BE LOCATED AT A MINIMUM DISTANCE OF 15m AWAY FROM PROTECTED EQUIPMENT.
3. DOWN STREAM OF DELUGE VALVE SHALL BE CONSIDERED AS DRY SECTION AND FACILITIES SHALL BE PROVIDED TO DRAIN THE DRY PIPING AFTER OPERATION.

**DESIGN PRAMETER FOR SPRAY SYSTEM**

DELUGE VALVE		DV-400101	
EQP.NO.	P4001A	P4001B	
AREA (m <sup>2</sup> )	5.55	5.55	
INTENSITY (L/min.m <sup>2</sup> )	20.40	20.40	
SUPPLY POWER (L/s)	4.8		
PRAMETER FOR NOZZLE	TYPE	MEDIUM-SPEED SPRAY SPRINKLER (CONE NOZZLE)	
	QUANTITY	2	2
	K-FACTOR	67	67
	MIN WORKING PRESSUR (MPa)	0.2	0.2
	SPRAY ANGLE	90°	90°
	DISTANCE ABOVE GROUND	2140mm	2140mm

**PIPE NUMBER**

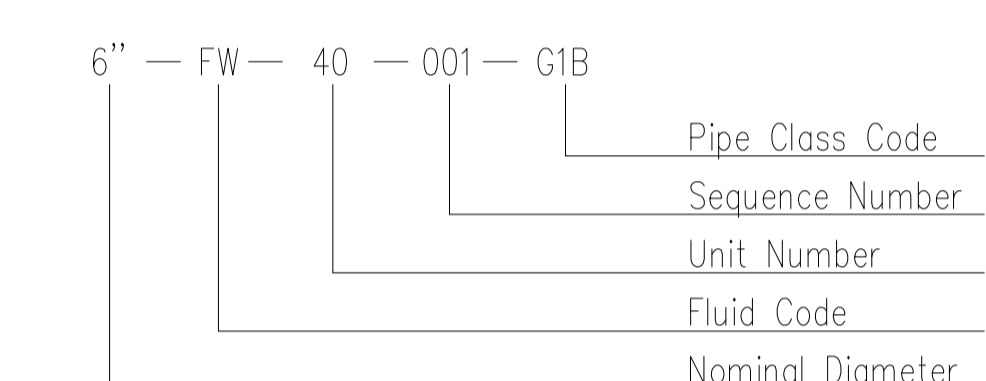

**REFERENCE DRAWINGS**

MKP-11-DE-9700-SF-SPC-001	MKP-11-DE-4000-PI-PPL-014
MKP-11-DE-9000-IN-CED-001	

**SYMBOLS AND LEGENDS**

⊕	spray nozzle	⊗	deluge valve
FW	fire fighting water	T	T type strainer
≡	pressure reducing orifice	⊣	butterfly valve
⊘	globe valve	⊚	ball valve
G	water motor gong	⊗	check valve
⊕	pressure operated relief valve(P.O.R.V.)	⊗	emergency release

As built	30.04.2020	Liu Jian		Cui Yanjun	Deng Wenhui
Approved For Construction	02.06.2017	Li Yang		Cui Yanjun	Deng Wenhui
Approved For Construction	15.03.2017	Li Yang		Cui Yanjun	Deng Wenhui
Approved For Construction	16.12.2016	Li Yang		Cui Yanjun	Deng Wenhui
Approved For Construction	31.10.2016	Li Yang		Cui Yanjun	Deng Wenhui

THIS DOCUMENT IS THE PROPERTY OF TCC. NO PART OF THIS DOCUMENT SHALL BE REPRODUCED OR DISCLOSED TO OTHERS OR USED FOR ANY PURPOSE WHATSOEVER EXCEPT WITH THE PRIOR WRITTEN PERMISSION OF TCC.


OWNER: Middle East Kimiaye Pars Company

LICENSOR	HALDOR TOPSØE A/S	DOCUMENT NAME:	JOB NO.	DOC. GRP.	REV.

CONTRACTOR	TCC 中国天辰工程有限公司 CHINA TIANCHEN ENGINEERING CORPORATION	CONTRACTOR DRAWING NO.	
		MKP-11-AS-4000-PF03-PID-003	

SUB-CONTRACTOR	SUB-CONTRACTOR LOGO	SUB-CONTRACTOR DRAWING NO.	

PROJECT	P&ID FOR SPRINKLER SYSTEM FOR PUMPS IN UNIT 4000	
	PROJECT	MKP Methanol Project
	UNIT	Methanol Tanks
PHASE	As built drawing	
	OWNER DWG NO.	MKP-11-AS-4000-SF-PID-003

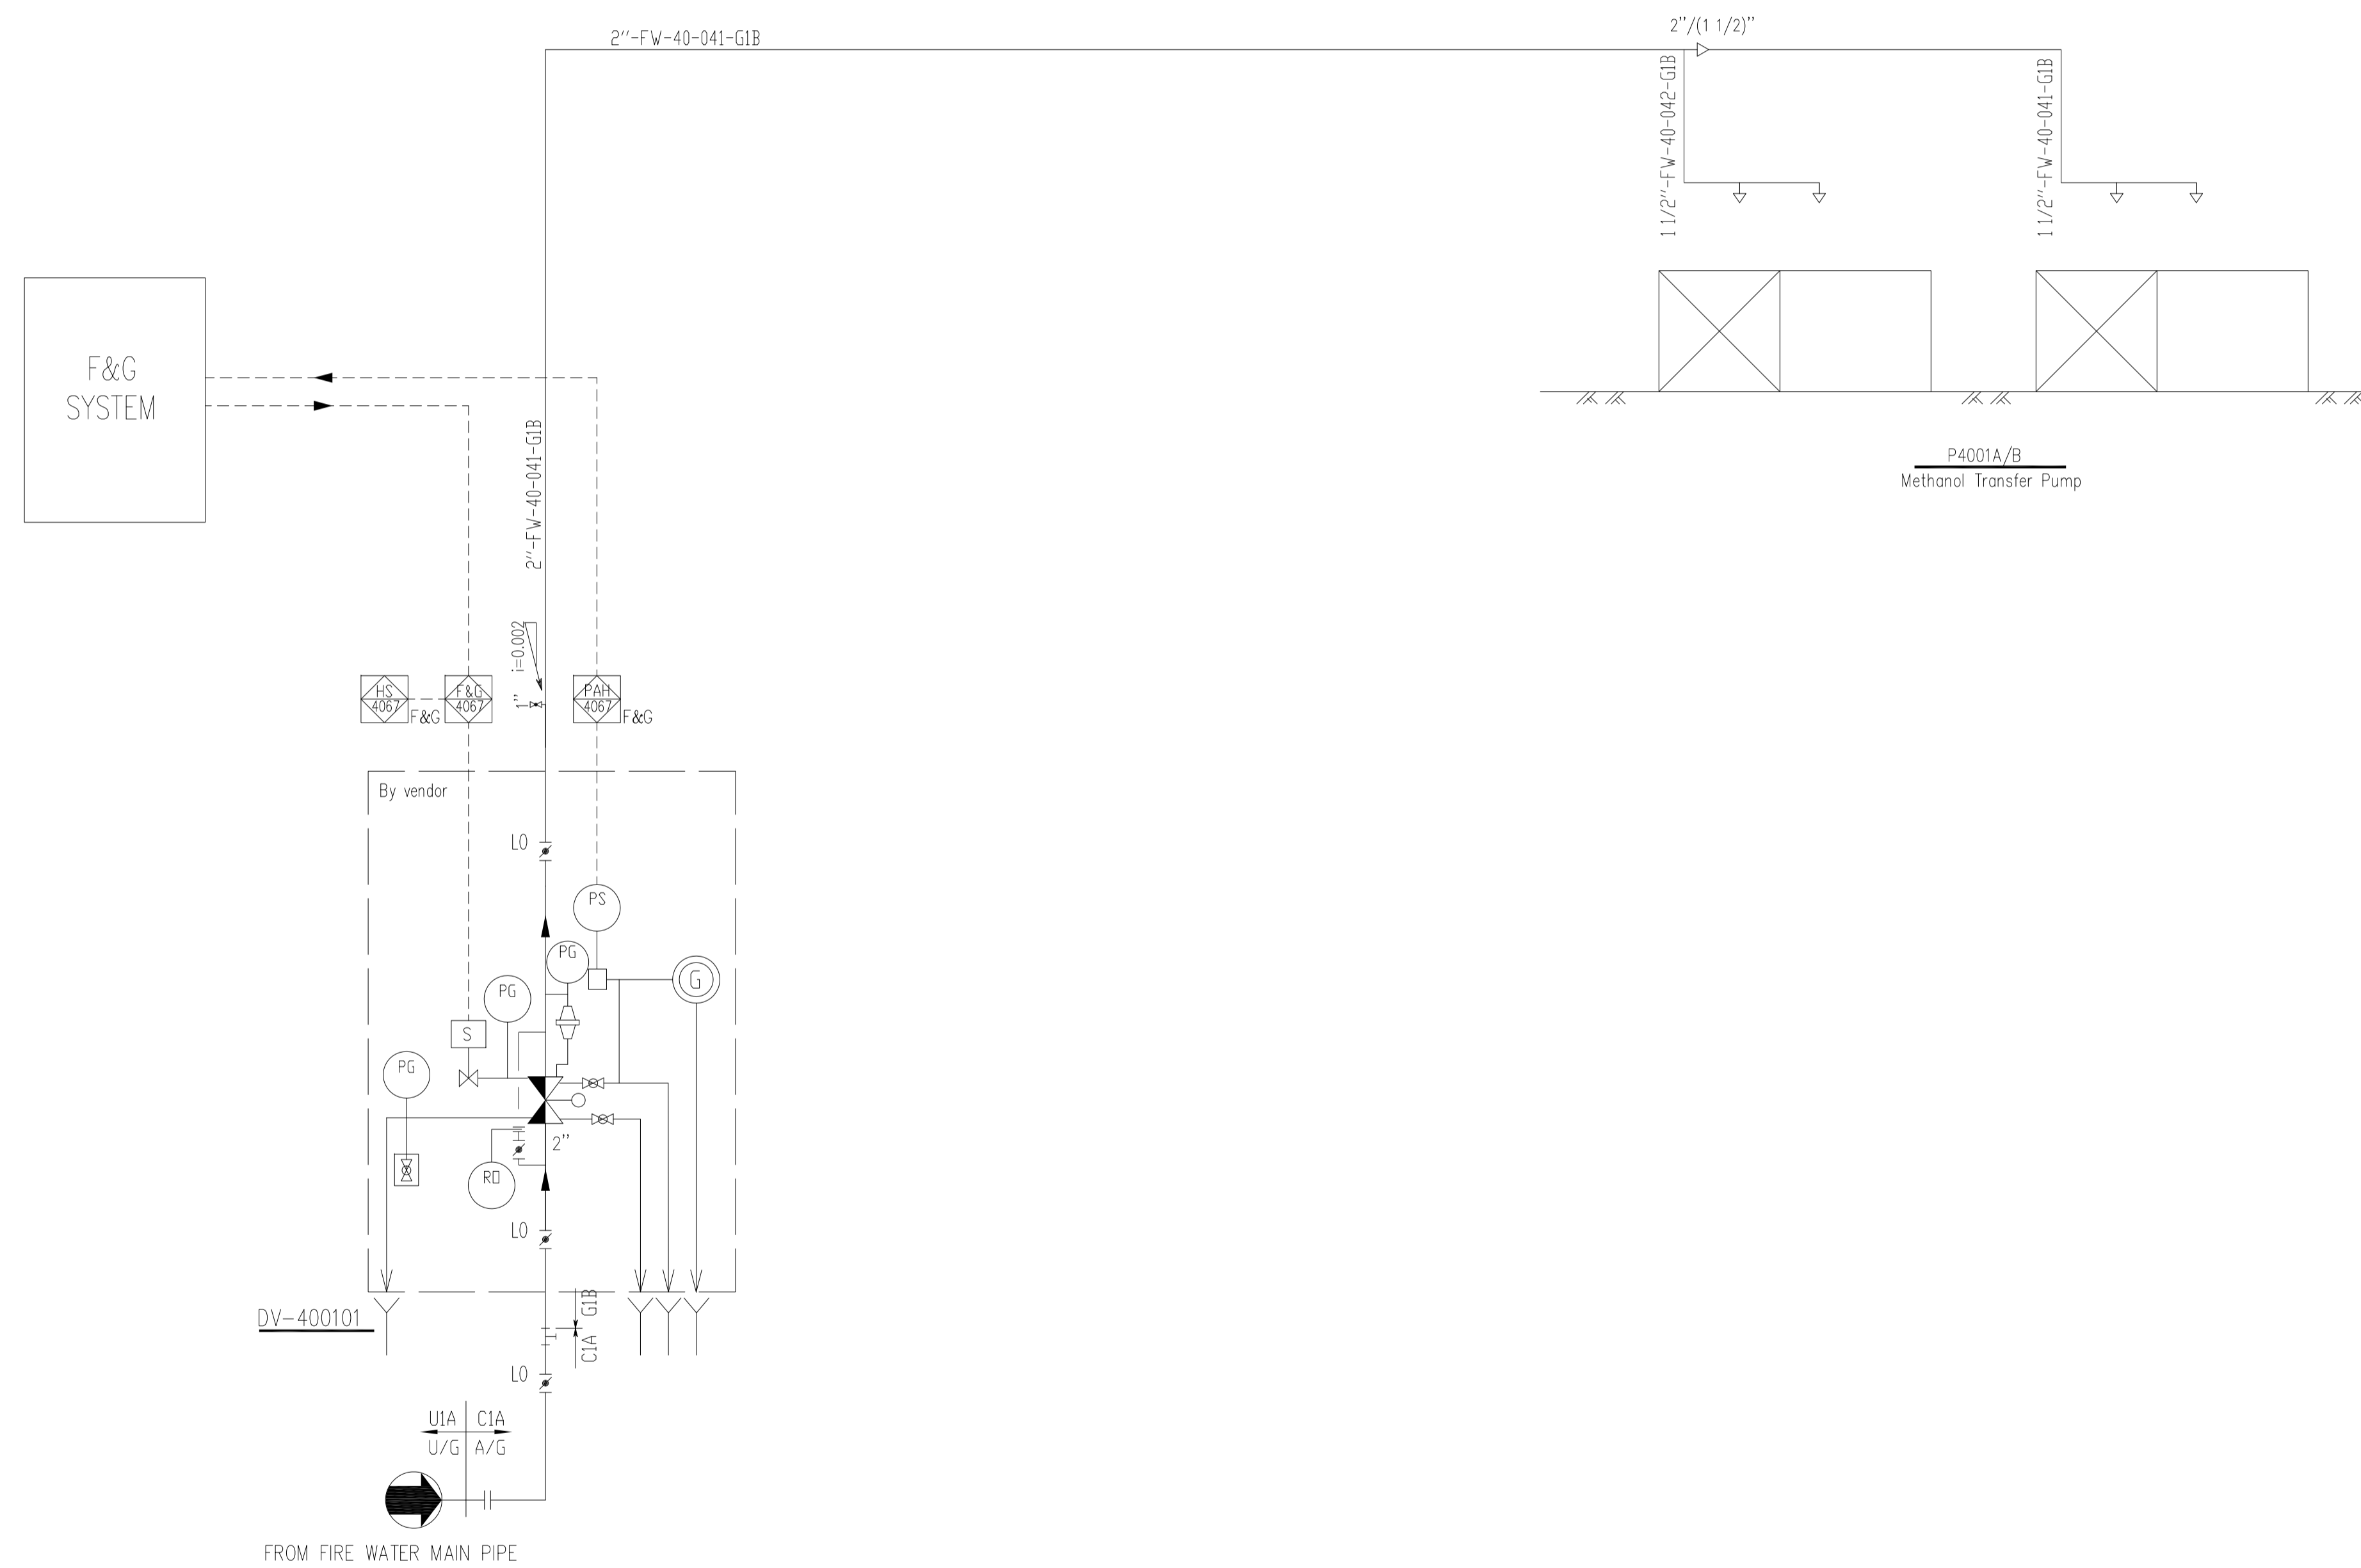


Counter Signing	Sign	Date	SCALE N/A	SHEET 1	TOT. 1	SIZE A1
-----------------	------	------	-----------	---------	--------	---------

TK 5001	RAW METHANOL BUFFER TANK
ID x LENGTH(T)	2500 x 2200mm
NET WORKING CAPACITY	7440 m <sup>3</sup>
DESIGN PRESS.	-0.006~0.020 barg
DESIGN TEMP.	85 °C
INSULATION	NONE
LEVEL OF EQUIPMENT	101.300 m

T 5004	VENT WASH COLUMN
ID x LENGTH(T)	1500 x 7000 mm
DESIGN PRESS.	FV/3.5 barg
DESIGN TEMP.	85 °C
INSULATION	NONE
LEVEL OF EQUIPMENT	125.750 m

L 5001	HOIST 5001
TYPE	CHAN NO SPARK HOIST
CAPACITY	5 t
LIFT HEIGHT	5.5 m
SLIDING DISTANCE	20 m

P 5001 A/B/C	RAW METHANOL PUMP
CAPACITY	186.6 m <sup>3</sup> /h
HEAD	69 m
DENSITY@OT	792 kg/m <sup>3</sup>
INSULATION/TRACING	NONE
AUXILIARY PIPING	BY VENDOR
LEVEL OF EQUIPMENT	101.200 m

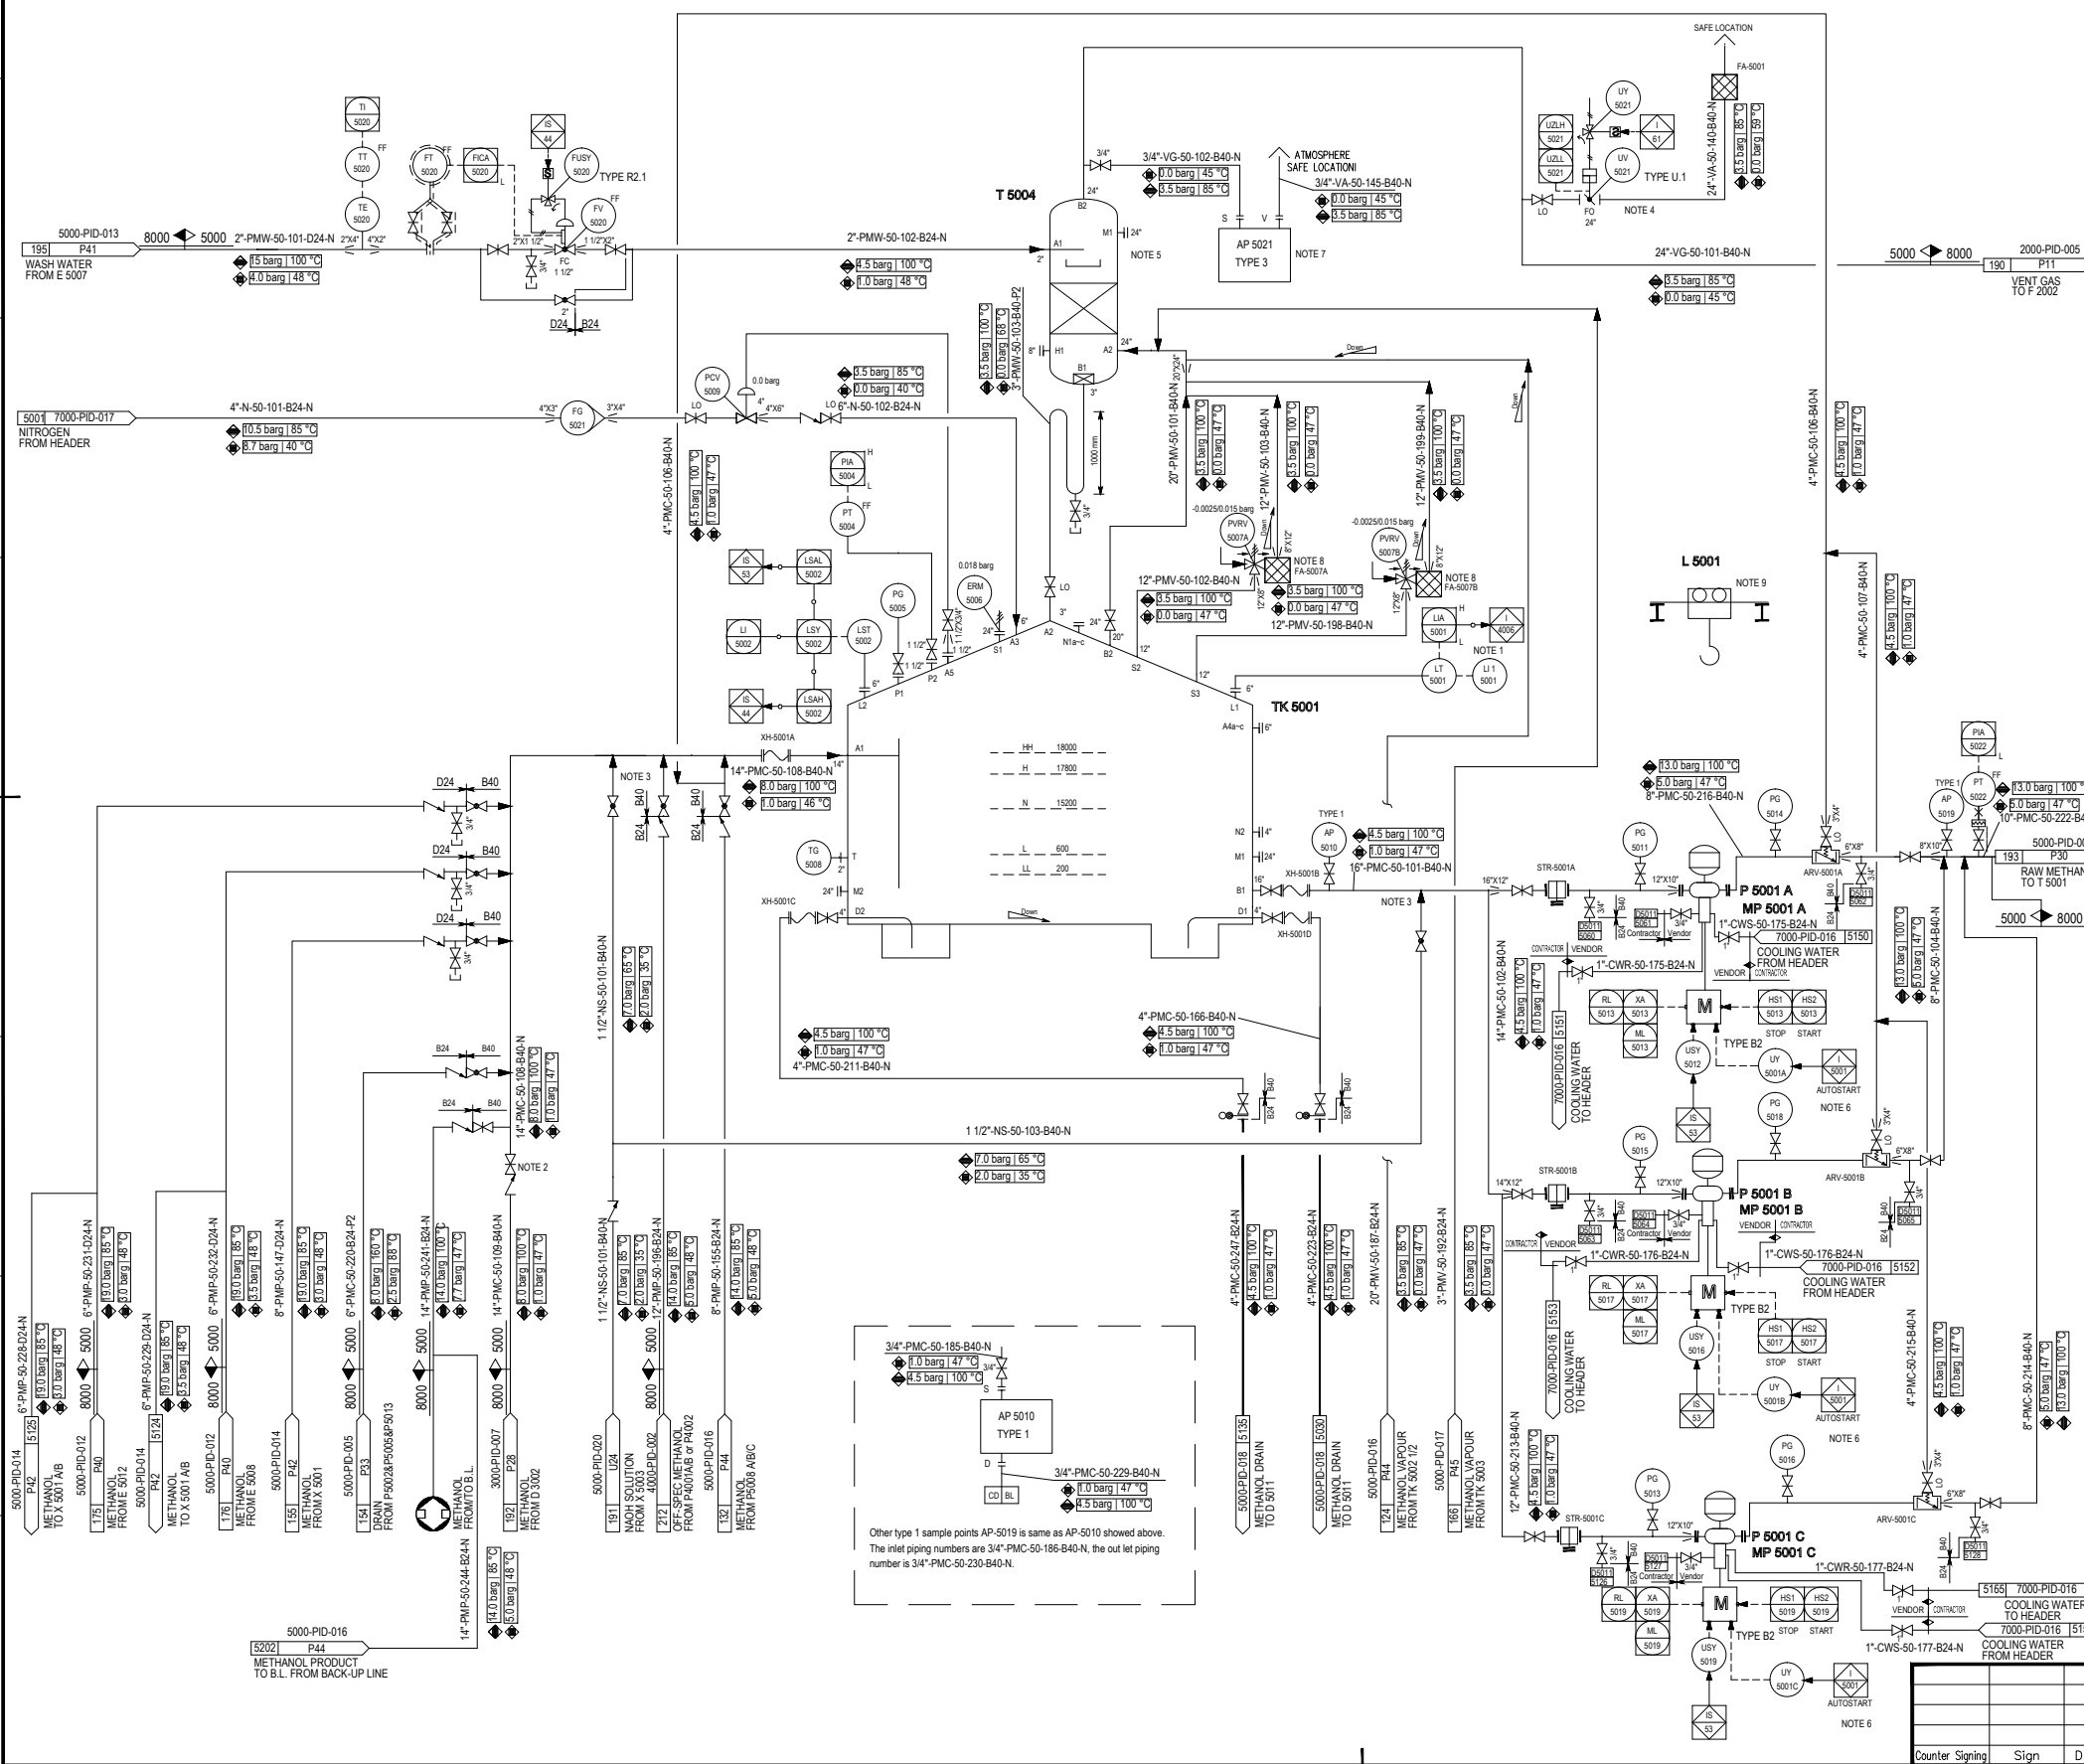

### GENERAL NOTES

NOTES:

- LI 1-5001 AT GRADE.
- MIN. DISTANCE TO TK 5001.
- NAOH SOLUTION INJECTION CONNECTION.

METHANOL  
NAOH SOLUTION

- 1/2" DRIP HOLE TO BE DRILLED AT LOW POINT TO SAFE AND SUITABLE LOCATION.
- T 5004 MUST BE LOCATED ON TOP OF TK 5001.
- THE SPARE PUMP WOULD AUTOSTART WHEN THE OUTLET FLOWRATE DECREASED.
- AP-5021 SHALL BE PLACED NEAR T5004 NOZZLE B2.
- THIS FLAME ARRESTER WILL BE PROVIDED WITH PVRV TOGETHER BY PVRV VENDOR.
- CRANE IS USED FOR P5001 A/B/C MAINTENANCE.

GENERAL NOTE:  
LOW POINT DRAINS AND HIGH POINT VENT MUST BE ADDED DURING DETAILED ENGINEERING.

### REFERENCE DRAWINGS

### SYMBOLS AND LEGENDS

### KEY PLAN

REV.	DESCRIPTION	DATE	DESIGN	DRAW	CHECK	REVIEW	APPROVE
▲	As Built	30.04.2020	Wang Yishu	Mu Yujun	Hu Qiyi		
▲	Approved for Construction	30.12.2019	Wang Yishu	Mu Yujun	Hu Qiyi		
▲	Approved for Construction	02.01.2018	Wang Yishu	Mu Yujun	Hu Qiyi		
▲	Approved for Construction	06.11.2017	Wang Yishu	Mu Yujun	Hu Qiyi		
▲	Approved for Construction	10.07.2017	Li Zhijuan	Mu Yujun	Hu Qiyi		
▲	Issued for Approval	22.06.2017	Li Zhijuan	Mu Yujun	Hu Qiyi		
▲	Issued for Approval	08.05.2017	Li Zhijuan	Mu Yujun	Hu Qiyi		
▲	Issued for Approval	22.03.2017	Li Zhijuan	Mu Yujun	Hu Qiyi		
▲	Issued for Approval	22.01.2017	Li Zhijuan	Mu Yujun	Hu Qiyi		
▲	Issued for Approval	28.11.2016	Li Zhijuan	Mu Yujun	Hu Qiyi		
▲	Issued for Approval	14.10.2016	Li Zhijuan	Mu Yujun	Hu Qiyi		
▲	Issued for Approval	31.08.2016	Li Zhijuan	Mu Yujun	Hu Qiyi		
▲	Issued for Approval	05.07.2016	Li Zhijuan	Mu Yujun	Hu Qiyi		
▲	Issued for Comments	29.04.2016	Li Zhijuan	Mu Yujun	Hu Qiyi		

THIS DOCUMENT IS THE PROPERTY OF TCC. NO PART OF THIS DOCUMENT SHALL BE REPRODUCED OR DISCLOSED TO OTHERS OR USED FOR ANY PURPOSE WHATSOEVER EXCEPT WITH THE PRIOR WRITTEN PERMISSION OF TCC.

OWNER: **Middle East Kimiaye Pars Company**

DESIGNER	HALDOR TOPSØE A/S	DOCUMENT NAME	CRUDE METHANOL TANK PIPING AND INSTRUMENT DIAGRAM	JOB NO.	S-02115	REV.	42
DATE	13/11/20	SCALE	P20	CONTRACTOR DRAWING NO.	MKP-11-AS-5000-PS07-PID-001	SHEET	01
				SUB-CONTRACTOR DRAWING NO.			
				SHEET -- TOTAL --			

PROJECT	MKP Methanol Project
UNIT	Distillation Unit
PHASE	As Built Drawing
OWNER DWG NO.	MKP-11-AS-5000-PR-PID-001

SCALE: -- SHEET: 1 TOT: 1 SIZE: A1



T 5001	STABILIZER COLUMN
ID x LENGTH-T	4300 x 28700 mm
DESIGN PRESS.	FV/3.5 barg
DESIGN TEMP.	150 °C
INSULATION	YES
LEVEL OF EQUIPMENT	109.900 m


E 5024 1/2	STABILIZER COLUMN REBOILER
DUTY	42.7 MW
DESIGN PRESS.(TL/SH)	29/(FV/5.0) barg
DESIGN TEMP.(TL/SH)	200/160 °C
INSULATION	YES

GENERAL NOTES

- NOTES:
- 1) SYMMETRICAL PIPING.
  - 2) NO POCKETS
  - 3) UPPER EDGE OF OVERFLOW WEIRS IN E 5024 2 TO BE 1800 mm ABOVE MAX. LEVEL IN T 5001.
  - 4) GRAVITATIONAL LIQUID FLOW FROM T 5001 TO E 5024 1/2 E 5001 AND BACK TO T 5001. PIPING MUST BE SELF-DRAINING WHEN BYPASS IS OPEN.
  - 5) TOP OF TUBE BUNDLE IN E 5024 1/2 AND E 5001 MUST BE IN SAME ELEVATION.
  - 6) SWITCHING OF FHS-5041 (SYMBOLIC INDICATED) FROM 3-ELEMENT LEVEL CONTROL VIA FIC-5041 TO SINGLE ELEMENT LEVEL CONTROL IS DONE WITH AUTOMATIC CHANGE OF TUNING CONSTANTS IN LIC-5041.
  - 7) NOZZLE B3 ON T 5001 MUST BE LOCATED MIN. 4.3 m ABOVE P 5002 A/B. TO BE CONFIRMED BY PUMP VENDOR.
- GENERAL NOTE:
- LOW POINT DRAINS AND HIGH POINT VENT MUST BE ADDED DURING DETAILED ENGINEERING.

Other type 2 sample points included AP-5053, AP-5055, AP-5056, AP-5057 are same as AP-5052 showed above. Their related pipe numbers are showed below in table 1.

AP POINT	AP-5053	OPC	AP-5055	OPC
CW SUPPLY PIPE	3/4" CWS-50-143-B24-N	5904	3/4" CWS-50-144-B24-N	5906
CW RETURN PIPE	3/4" CWR-50-143-B24-N	5905	3/4" CWR-50-144-B24-N	5907
PROCESS IN PIPE	3/4" PMC-50-173-B24A-P2		3/4" PMC-50-174-B24A-P2	
DRAIN PIPE	3/4" PMC-50-233-B24A-N		3/4" PMC-50-234-B24A-N	
AP POINT	AP-5056	AP-5057		
CW SUPPLY PIPE	3/4" CWS-50-145-B24-N	5908	3/4" CWS-50-146-B24-N	5910
CW RETURN PIPE	3/4" CWR-50-145-B24-N	5909	3/4" CWR-50-146-B24-N	5911
PROCESS IN PIPE	3/4" PMC-50-175-B24A-P2		3/4" PMC-50-176-B24A-P2	
DRAIN PIPE	3/4" PMC-50-235-B24A-N		3/4" PMC-50-236-B24A-N	

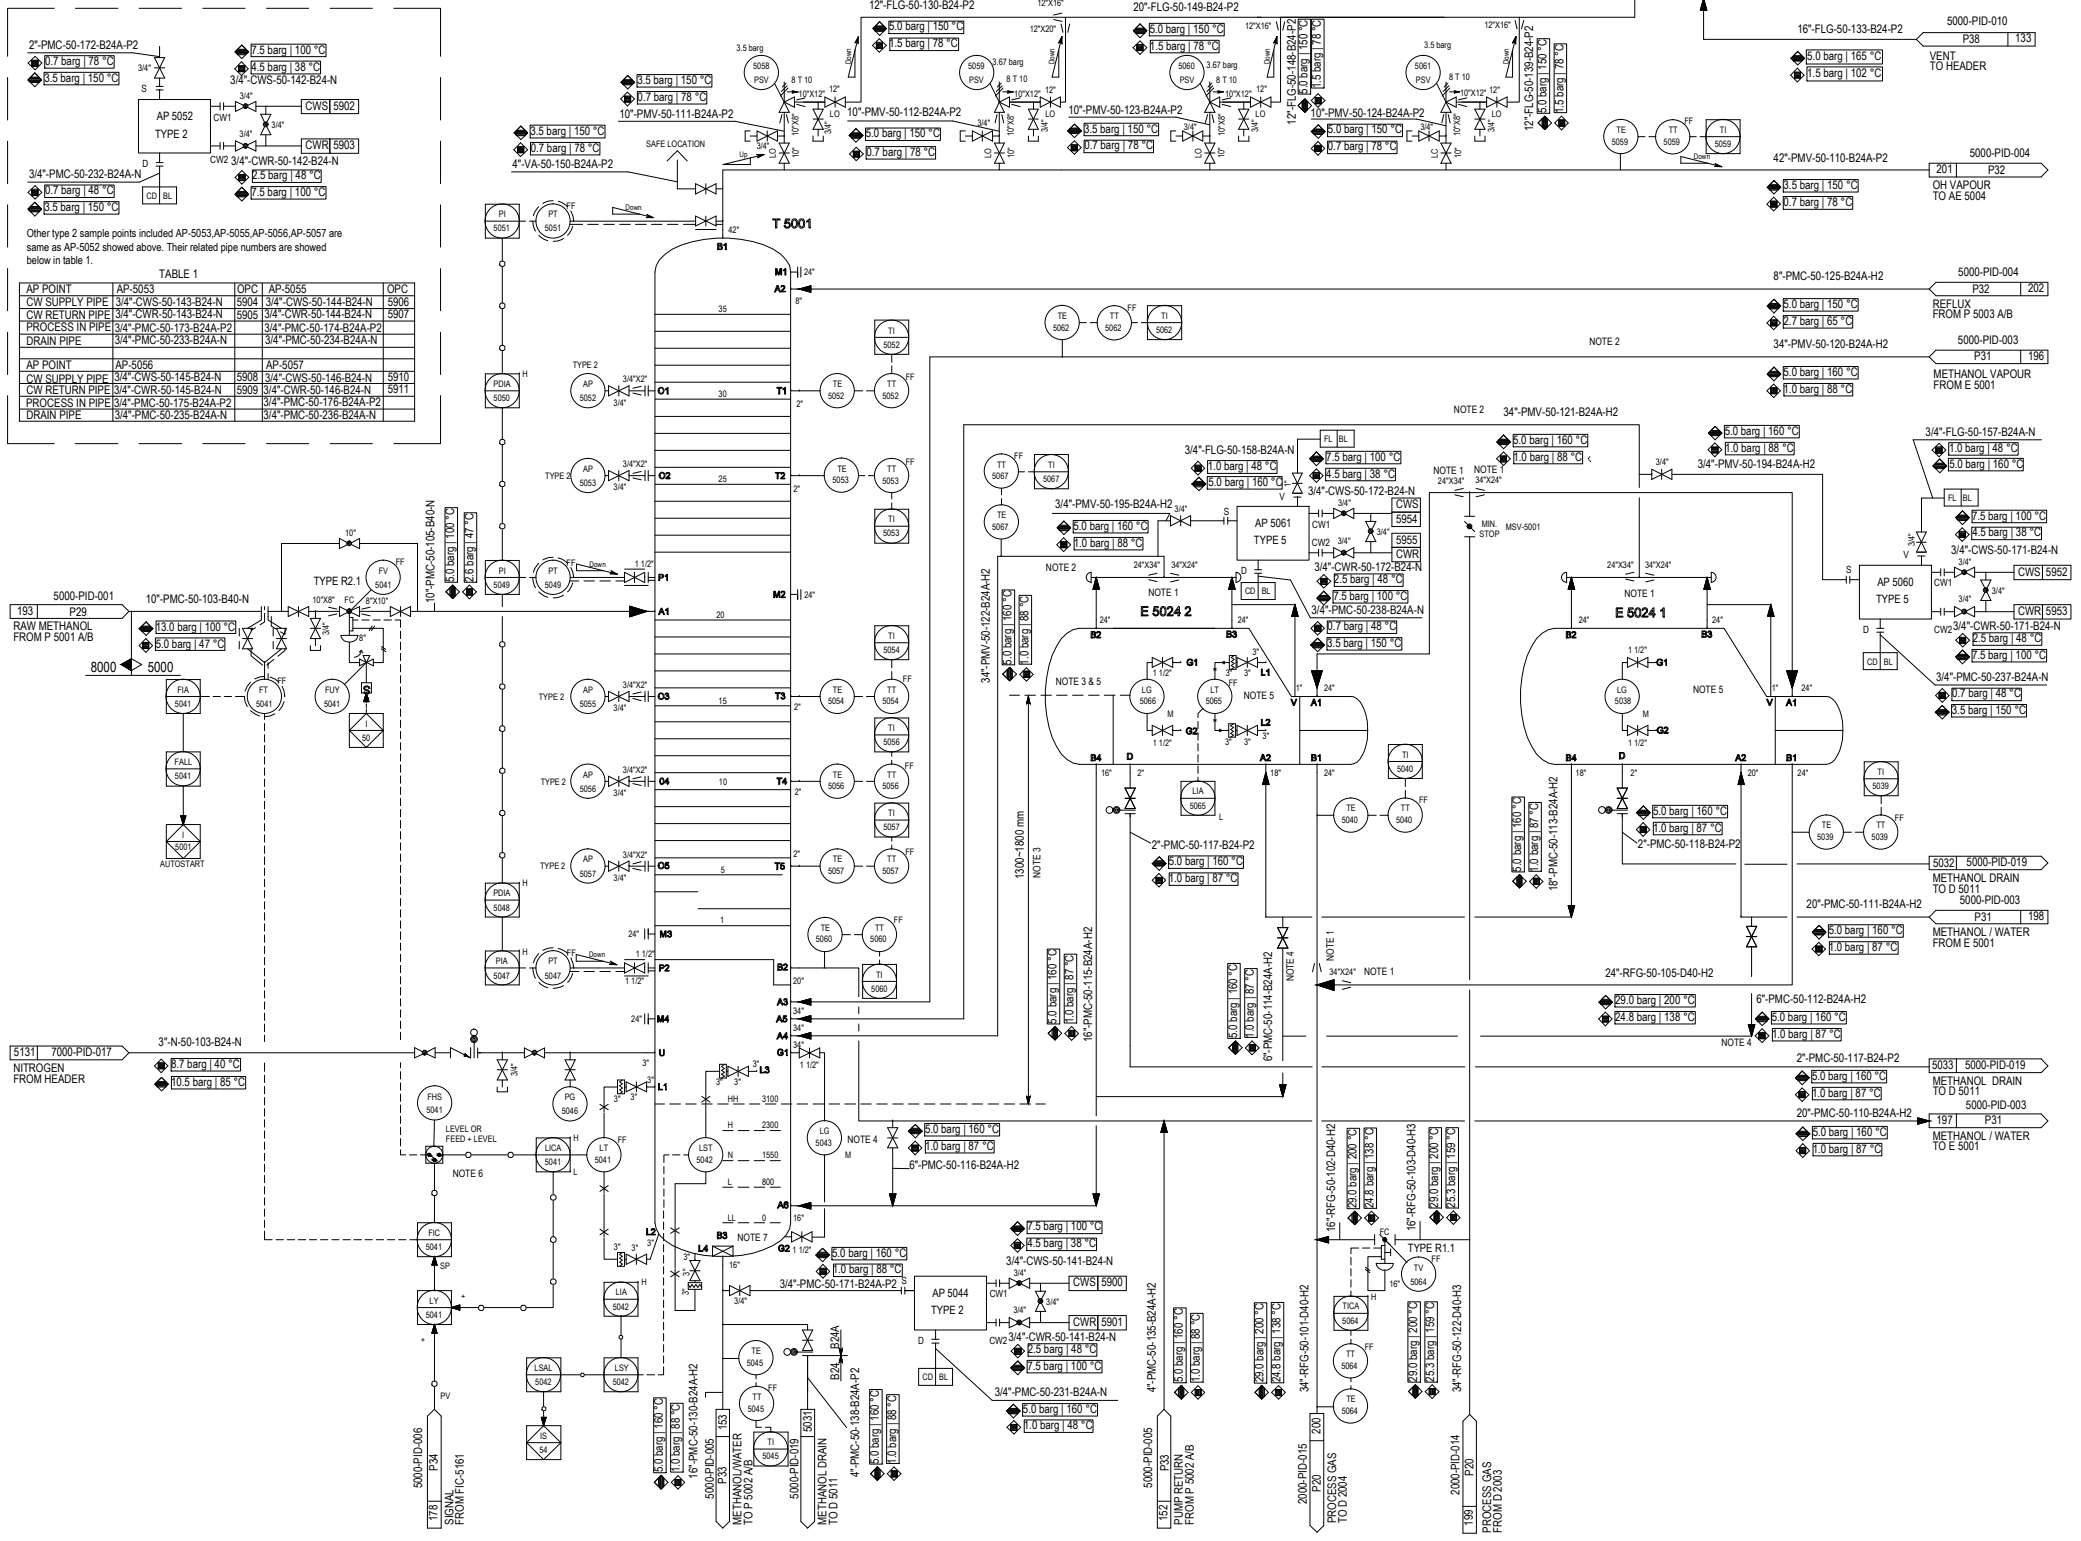

REFERENCE DRAWINGS

SYMBOLS AND LEGENDS

KEY PLAN

REV.	DESCRIPTION	DATE	DESIGN	DRAW	CHECK	REVIEW	APPROVE
▲	As Built	30.04.2020	Wang Yishu	Mu Yujun	Hu Qiyi		
▲	Approved for Construction	30.12.2019	Wang Yishu	Mu Yujun	Hu Qiyi		
▲	Approved for Construction	06.11.2017	Wang Yishu	Mu Yujun	Hu Qiyi		
▲	Approved for Construction	08.05.2017	Li Zhijuan	Mu Yujun	Hu Qiyi		
▲	Approved for Construction	22.03.2017	Li Zhijuan	Mu Yujun	Hu Qiyi		
▲	Approved for Construction	28.11.2016	Li Zhijuan	Mu Yujun	Hu Qiyi		
▲	Approved for Construction	14.10.2016	Li Zhijuan	Mu Yujun	Hu Qiyi		
▲	Issued for Approval	31.08.2016	Li Zhijuan	Mu Yujun	Hu Qiyi		
▲	Issued for Approval	05.07.2016	Li Zhijuan	Mu Yujun	Hu Qiyi		
▲	Issued for Comments	29.04.2016	Li Zhijuan	Mu Yujun	Hu Qiyi		

OWNER:

**Middle East  
Kimiaye Pars Company**

HALDOR TOPSØE A/S

DOCUMENT NAME: STABILIZER COLUMN PIPING AND INSTRUMENT DIAGRAM

JOB NO: S-02115

DRAWING NO: 1341740

CONTRACTOR DRAWING NO. MKP-11-AS-5000-PS07-PID-002

SHEET 01 TOTAL 01

SUB-CONTRACTOR DRAWING NO.

SHEET -- TOTAL --

PROJECT	MKP Methanol Project
UNIT	Distillation Unit
PHASE	As Built Drawing
OWNER DWG NO.	MKP-11-AS-5000-PR-PID-002

Counter Signing Sign Date

SCALE:-- SHEET: 1 TOT: 1 SIZE: A1



E 5001	STABILIZER COLUMN STEAM REBOILER
DUTY	21.4 MW
DESIGN PRESS.(TLU/SH)	(FV/95)/(FV/5.0) barg
DESIGN TEMP.(TLU/SH)	340/160 °C
INSULATION	YES


D 5009	STEAM CONDENSATE K.D. DRUM FOR E 5001
ID x LENGTH(T-T)	1150 x 3400 mm
DESIGN PRESS.	FV/10.5 barg
DESIGN TEMP.	190 °C
INSULATION	YES
CLADDING/LINING	NDNE
LEVEL OF EQUIPMENT	105.600 m

P 5011 A/B	STEAM CONDENSATE PUMP
CAPACITY	53.8 m <sup>3</sup> /h
HEAD	61 m
DENSITY@DT	951 kg/m <sup>3</sup>
INSULATION/TRACING	NDNE
AUXILIARY PIPING	BY VENDOR
LEVEL OF EQUIPMENT	101.200 m

E 7003 1	EXCESS STEAM CONDENSATE COOLER
DUTY	3.51 MW
DESIGN PRESS.(TLU/SH)	7.5/1.9 barg
DESIGN TEMP.(TLU/SH)	100/190 °C
INSULATION	YES

**GENERAL NOTES**

- \*NOTES:
- 1) SYMMETRICAL PIPING.
  - 2) TOP OF TUBE BUNDLE IN E 2024 1/2 AND E 5001 MUST BE IN SAME ELEVATION.
  - 3) 1/2" DRIP HOLE TO BE DRILLED AT LOW POINT TO SAFE AND SUITABLE LOCATION.
  - 4) STEAM CONDENSATE OUTLET NOZZLE ON E 5001 TO BE ELEVATED ABOVE INLET NOZZLE A1 ON D 5009
  - 5) NOZZLE B ON D 5009 MUST BE LOCATED MIN. 4m ABOVE P 5011 A/B. (TO BE CONFIRMED BY PUMP VENDOR).
  - 6) THE SPARE PUMP WOULD AUTOSTART WHEN THE OUTLET PRESSURE DECREASED.
  - 7) P&T COMPENSATION FROM PIC-7056.TI-7056.
  - 8) PV-5069 INCLUDE 1 NOISE REDUCTION DISKS, THE SIZE IS 14" AND THE REDUCER CONSIDERED BY PIPING.
- +GENERAL NOTE:  
LOW POINT DRAINS AND HIGH POINT VENT MUST BE ADDED DURING DETAILED ENGINEERING.

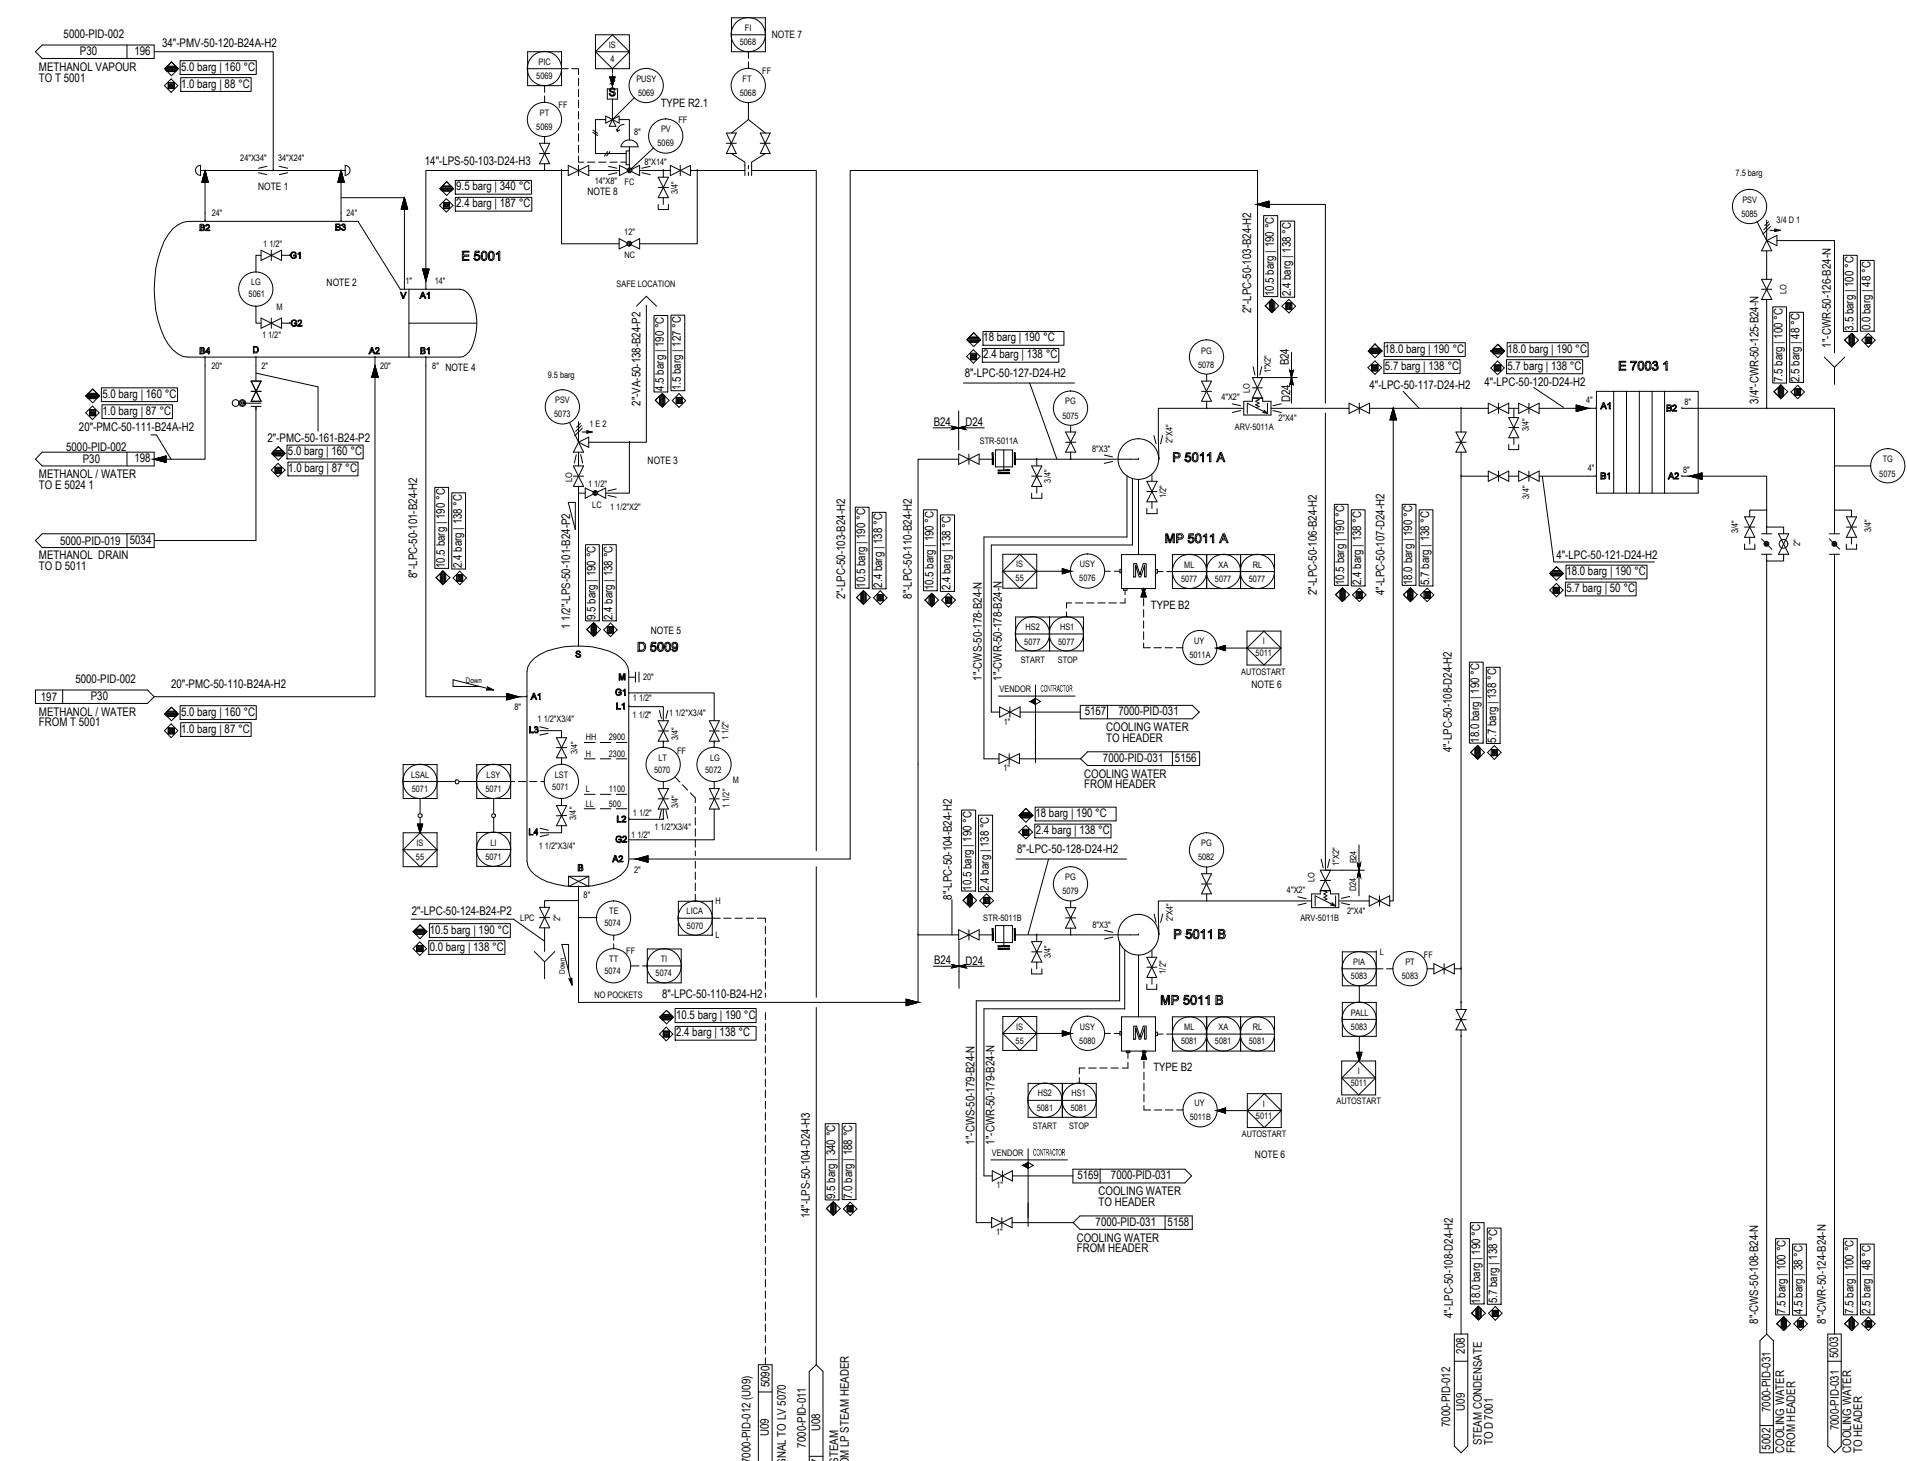

**REFERENCE DRAWINGS**

**SYMBOLS AND LEGENDS**

**KEY PLAN**

REV.	DESCRIPTION	DATE	DESIGN	DRAW	CHECK	REVIEW	APPROVE
▲	As Built	30.04.2020	Wang Yishu	Mu Yujun	Hu Qiyi		
▲	Approved for Construction	30.12.2019	Wang Yishu	Mu Yujun	Hu Qiyi		
▲	Approved for Construction	28.03.2019	Wang Yishu	Mu Yujun	Hu Qiyi		
▲	Approved for Construction	06.11.2017	Wang Yishu	Mu Yujun	Hu Qiyi		
▲	Approved for Construction	08.05.2017	Li Zhijuan	Mu Yujun	Hu Qiyi		
▲	Approved for Construction	22.03.2017	Li Zhijuan	Mu Yujun	Hu Qiyi		
▲	Approved for Construction	22.01.2017	Li Zhijuan	Mu Yujun	Hu Qiyi		
▲	Approved for Construction	28.11.2016	Li Zhijuan	Mu Yujun	Hu Qiyi		
▲	Approved for Construction	14.10.2016	Li Zhijuan	Mu Yujun	Hu Qiyi		
▲	Approved for Construction	31.08.2016	Li Zhijuan	Mu Yujun	Hu Qiyi		
▲	Issued for Approval	05.07.2016	Li Zhijuan	Mu Yujun	Hu Qiyi		
▲	Issued for Comments	29.04.2016	Li Zhijuan	Mu Yujun	Hu Qiyi		

OWNER: Middle East Kimiaye Pars Company

CONTRACTOR: HALDOR TOPSØE A/S

CONTRACTOR: TCC 中国天辰工程有限公司

DOCUMENT NAME	STABILIZER COLUMN REBOILER PIPING AND INSTRUMENT DIAGRAM
JOB NO.	S-02115
REV.	42
DWG NO.	1341741
SCALE	P31

CONTRACTOR DRAWING NO. MKP-11-AS-5000-PS07-PID-003

SHEET 01 TOTAL 01

SUB-CONTRACTOR DRAWING NO. -

SHEET - TOTAL -

PROJECT	MKP Methanol Project
UNIT	Distillation Unit
PHASE	As Built Drawing
OWNER DWG NO.	MKP-11-AS-5000-PR-PID-003

Counter Signing Sign Date

SCALE:-- SHEET:1 TOT.:1 SIZE:A1

<b>AE 5004</b>	STABILIZER COLUMN OH CONDENSER	<b>D 5001</b>	STEAM COLUMN OH ACCUMULATOR
DUTY	33.5 MW	ID x LENGTH-T	2100 x 6500 mm
ID x LENGTH-T	BY VENDOR mm	DESIGN PRESS.	FV/3.5 barg
DESIGN PRESS.(TL/SH)	(FV/3.5)/NA barg	DENSITY@T	150 °C
DESIGN TEMP.(TL/SH)	150/NA °C	INSULATION/TRACING	NONE
		CLADDING/LINING	NONE
		LEVEL OF EQUIPMENT	113.200 m

<b>P 5003 A/B</b>	STABILIZER COLUMN REFLUX PUMP	<b>E 5010</b>	OH GAS CONDENSER
CAPACITY	192.6 m <sup>3</sup> /h	DUTY	0.30 MW
HEAD	57 m	DESIGN PRESS.(TL/SH)	7.5/(FV/3.5) barg
DENSITY@T	752 kg/m <sup>3</sup>	DESIGN TEMP.(TL/SH)	100/150 °C
INSULATION/TRACING	NONE	INSULATION	NONE
AUXILIARY PIPING	BY VENDOR		
LEVEL OF EQUIPMENT	101.160 m		

**GENERAL NOTES**

- † NOTES:
- E 5010 TO BE MOUNTED FOR SELF-DRAINING TO D 5001.
  - FUNCTION OF PIC-5091:  
VALVE OPENING, %  
  
OUTPUT, %
  - NOZZLE B1 ON D 5001 MUST BE PLACED MIN. 4 m ABOVE P 5003 A/B (TO BE CONFIRMED BY PUMP VENDOR).
  - NO POCKETS.
  - TWS TO BE INSTALLED ON EACH OUTLET HEADER FROM AE 5004.
  - DETAIL AIR COOLER DRAWING IN 5000-PR-PID-024.
  - VENT TO SAFE LOCATION.
  - THE SPARE PUMP WOULD AUTOSTART WHEN THE OUTLET PRESSURE DECREASED.
  - P&T COMPENSATION FROM PI-5111, TI-5111.
- † GENERAL NOTE:  
LOW POINT DRAINS AND HIGH POINT VENT MUST BE ADDED DURING DETAILED ENGINEERING.

**REFERENCE DRAWINGS**

**SYMBOLS AND LEGENDS**


**KEY PLAN**

REV.	DESCRIPTION	DATE	DESIGN	DRAW	CHECK	REVIEW	APPROVE
▲	As Built	30.04.2020	Wang Yishu	Mu Yujun	Hu Qiyi		
▲	Approved for Construction	30.12.2019	Wang Yishu	Mu Yujun	Hu Qiyi		
▲	Approved for Construction	26.03.2018	Wang Yishu	Mu Yujun	Hu Qiyi		
▲	Approved for Construction	06.11.2017	Wang Yishu	Mu Yujun	Hu Qiyi		
▲	Approved for Construction	08.05.2017	Li Zhijuan	Mu Yujun	Hu Qiyi		
▲	Approved for Construction	22.03.2017	Li Zhijuan	Mu Yujun	Hu Qiyi		
▲	Approved for Construction	22.01.2017	Li Zhijuan	Mu Yujun	Hu Qiyi		
▲	Approved for Construction	28.11.2016	Li Zhijuan	Mu Yujun	Hu Qiyi		
▲	Approved for Construction	14.10.2016	Li Zhijuan	Mu Yujun	Hu Qiyi		
▲	Issued for Approval	31.08.2016	Li Zhijuan	Mu Yujun	Hu Qiyi		
▲	Issued for Approval	05.07.2016	Li Zhijuan	Mu Yujun	Hu Qiyi		
▲	Issued for Comments	29.04.2016	Li Zhijuan	Mu Yujun	Hu Qiyi		

OWNER: Middle East Kimiaye Pars Company

<b>HALDOR TOPSØE A/S</b>	DOCUMENT NAME: STABILIZER COLUMN OH SYSTEM PIPING AND INSTRUMENT DIAGRAM	JOB NO: S-02115	REV: 42
<b>TCC 中国天辰工程有限公司</b>	CONTRACTOR DRAWING NO. MKP-11-AS-5000-PS07-PID-004	DWG NO: 1341742	SHEET: 01 TOTAL: 01
	SUB-CONTRACTOR DRAWING NO.		
	SHEET: -- TOTAL: --		

STABILIZER COLUMN OH SYSTEM PIPING AND INSTRUMENT DIAGRAM	PROJECT: MKP Methanol Project
	UNIT: Distillation Unit
	PHASE: As Built Drawing
OWNER DWG NO.	MKP-11-AS-5000-PR-PID-004

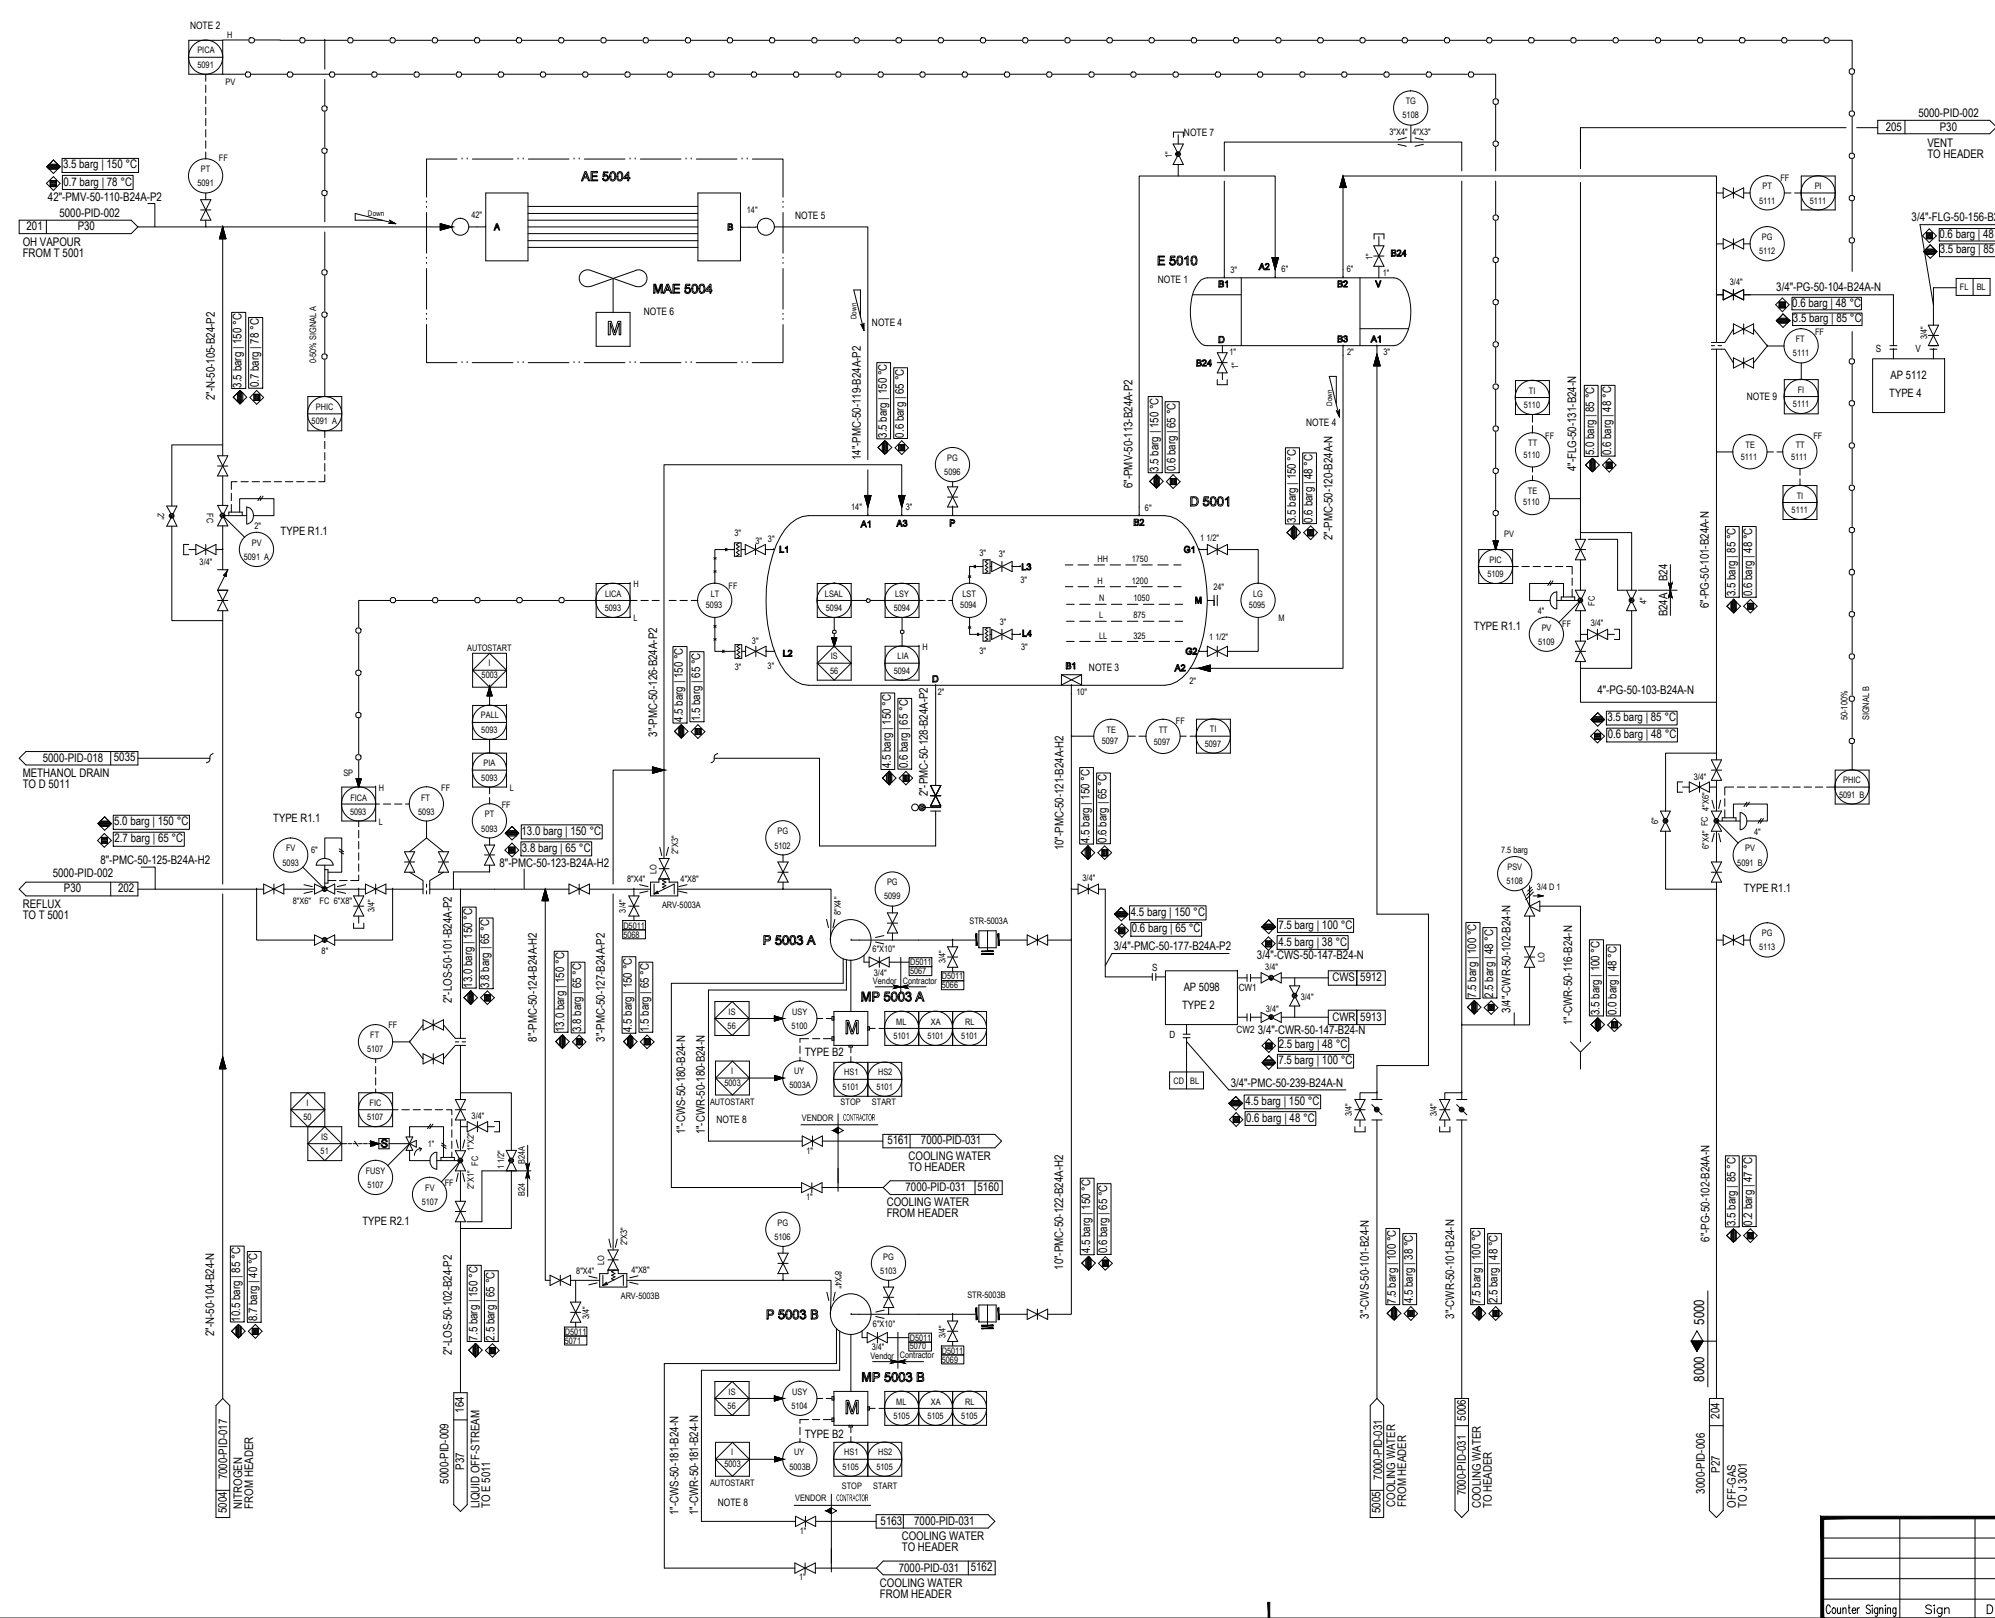

P 5002 A/B	STABILIZER METHANOL PUMP
CAPACITY	390.6 m <sup>3</sup> /h
HEAD	35 m
DENSITY@DT	753 kg/m <sup>3</sup>
INSULATION/TRACING	NONE
AUXILIARY PIPING	BY VENDOR
LEVEL OF EQUIPMENT	101.280 m

GENERAL NOTES

- 1) THE SPARE PUMP WOULD AUTOSTART WHEN THE OUTLET PRESSURE DECREASED.
- GENERAL NOTE:  
LOW POINT DRAINS AND HIGH POINT VENT MUST BE ADDED DURING DETAILED ENGINEERING.

REFERENCE DRAWINGS

SYMBOLS AND LEGENDS

KEY PLAN


As Built	30.04.2020	Li Zhijuan	Mu Yujun	Hu Qiuyi
Approved for Construction	08.05.2017	Li Zhijuan	Mu Yujun	Hu Qiuyi
Approved for Construction	22.03.2017	Li Zhijuan	Mu Yujun	Hu Qiuyi
Approved for Construction	22.01.2017	Li Zhijuan	Mu Yujun	Hu Qiuyi
Approved for Construction	28.11.2016	Li Zhijuan	Mu Yujun	Hu Qiuyi
Approved for Construction	14.10.2016	Li Zhijuan	Mu Yujun	Hu Qiuyi
Approved for Construction	31.08.2016	Li Zhijuan	Mu Yujun	Hu Qiuyi
Issued for Approval	05.07.2016	Li Zhijuan	Mu Yujun	Hu Qiuyi
Issued for Comments	29.04.2016	Li Zhijuan	Mu Yujun	Hu Qiuyi

REV. DESCRIPTION DATE DESIGN DRAW CHECK REVIEW APPROVE  
THIS DOCUMENT IS THE PROPERTY OF TCC. NO PART OF THIS DOCUMENT SHALL BE REPRODUCED OR DISCLOSED TO OTHERS OR USED FOR ANY PURPOSE WHATSOEVER EXCEPT WITH THE PRIOR WRITTEN PERMISSION OF TCC.

OWNER:  Middle East Kimiaye Pars Company

DESIGNER	HALDOR TOPSØE A/S	DOCUMENT NAME	STABILIZER COLUMN PUMPS PIPING AND INSTRUMENT DIAGRAM	JOB NO.	S-02115	CONTRACT NO.	42	REV.	3
DATE	13/11/15	DRAWING NO.	1341743	SHEET	01	TOTAL	01		
CONTRACTOR	TCC 中国天辰工程有限公司 CHINA TIANCHEN ENGINEERING CORPORATION		CONTRACTOR DRAWING NO.		MKP-11-AS-5000-PS07-PID-005				
CONTRACT			SUB-CONTRACTOR DRAWING NO.						
			SHEET		-				

PROJECT	MKP Methanol Project
UNIT	Distillation Unit
PHASE	As Built Drawing
OWNER DWG NO.	MKP-11-AS-5000-PR-PID-005

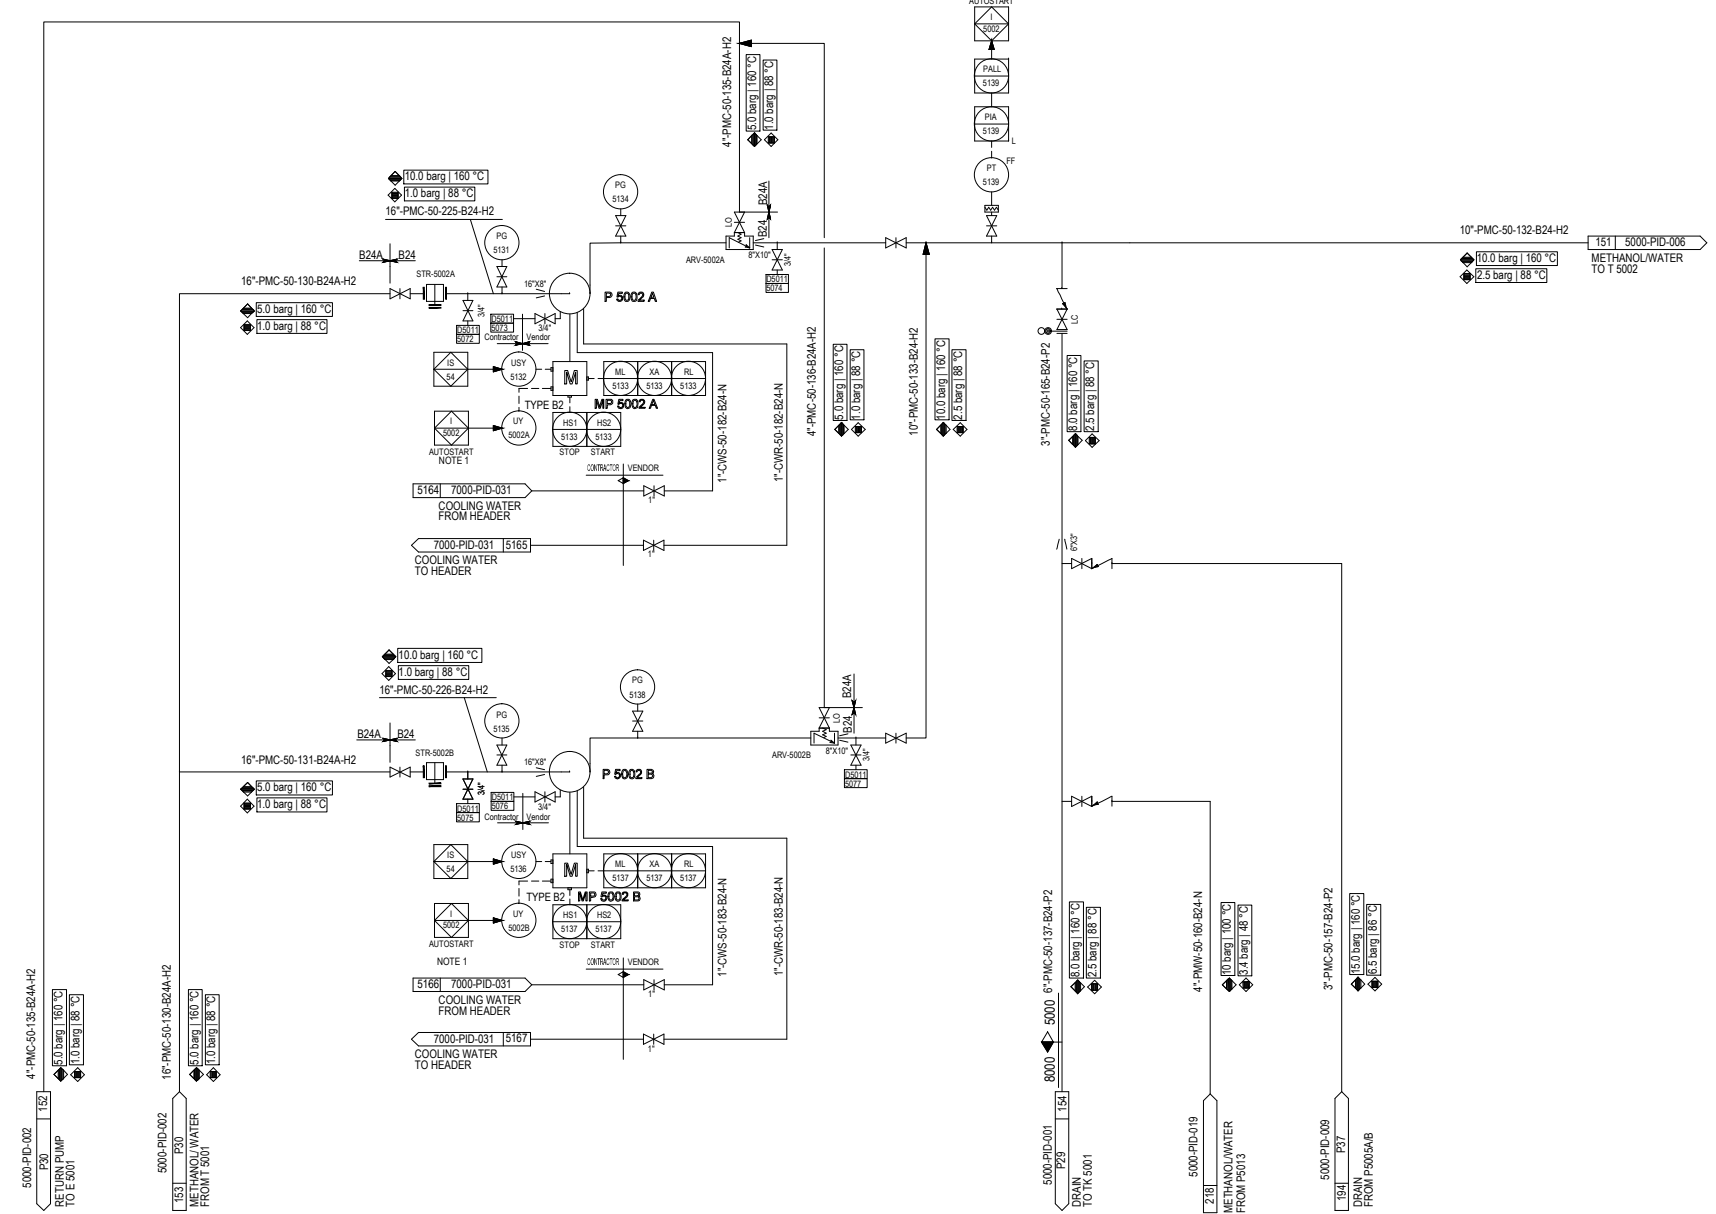

Counter	Sign	Date

SCALE:-- SHEET: 1 TOT.: 1 SIZE: A1

T 5002	LP METHANOL COLUMN
ID x LENGTH-T	7700 x 43400 mm
DESIGN PRESS.	FV/3.5 barg
DESIGN TEMP.	150 °C
INSULATION	YES
LEVEL OF EQUIPMENT	111.900 m

E 5002 4	LP COLUMN REBOILER
DUTY	31.3 MW
DESIGN PRESS.(TL/SH)	(FV/6.0)/(FV/5.0) barg
DESIGN TEMP.(TL/SH)	165/160 °C
INSULATION	YES

**GENERAL NOTES**

- NOTES:
- NO POCKETS.
  - GRAVITATIONAL LIQUID FLOW FROM T 5002 TO E 5002 1/2/3/4 AND BACK TO T 5002. PIPING MUST BE SELF-DRAINING WHEN BYPASS IS OPEN.
  - UPPER EDGE OF OVERFLOW WEIR IN E 5002 4 TO BE LOCATED 3100 mm ABOVE MAX. LEVEL IN E 5002.
  - SWITCHING OF FHS-5161 (SYMBOLIC INDICATED) FROM 3-ELEMENT LEVEL CONTROL VIA FIC-5161 TO SINGLE ELEMENT LEVEL CONTROL IS DONE WITH AUTOMATIC CHANGE OF TUNING CONSTANTS IN LIC-5161.
  - TOP OF TUBE BUNDLE IN E 5002 1/2/3/4 MUST BE IN SAME ELEVATION.
  - MINIMUM 500mm UPWARDS LINE.
  - NOZZLE B3 ON T 5002 MUST BE LOCATED MIN. 3.5m ABOVE P 5005 A/B. (TO BE CONFIRMED BY PUMP VENDOR.)
- GENERAL NOTE:  
LOW POINT DRAINS AND HIGH POINT VENT MUST BE ADDED DURING DETAILED ENGINEERING.

**REFERENCE DRAWINGS**

**SYMBOLS AND LEGENDS**


**KEY PLAN**

REV.	DESCRIPTION	DATE	DESIGN	DRAW	CHECK	REVIEW	APPROVE
▲	As Built	30.04.2020	Wang Yishu	Mu Yujun	Hu Qiyi		
▲	Approved for Construction	30.12.2019	Wang Yishu	Mu Yujun	Hu Qiyi		
▲	Approved for Construction	11.11.2018	Wang Yishu	Mu Yujun	Hu Qiyi		
▲	Approved for Construction	06.11.2017	Wang Yishu	Mu Yujun	Hu Qiyi		
▲	Approved for Construction	22.03.2017	Li Zhijuan	Mu Yujun	Hu Qiyi		
▲	Approved for Construction	22.01.2017	Li Zhijuan	Mu Yujun	Hu Qiyi		
▲	Approved for Construction	28.11.2016	Li Zhijuan	Mu Yujun	Hu Qiyi		
▲	Approved for Construction	14.10.2016	Li Zhijuan	Mu Yujun	Hu Qiyi		
▲	Approved for Construction	31.08.2016	Li Zhijuan	Mu Yujun	Hu Qiyi		
▲	Issued for Approval	05.07.2016	Li Zhijuan	Mu Yujun	Hu Qiyi		
▲	Issued for Comments	29.04.2016	Li Zhijuan	Mu Yujun	Hu Qiyi		

OWNER: Middle East Kimiaye Pars Company

DESIGNER	HALDOR TOPSØE A/S	DOCUMENT NAME	LP METHANOL COLUMN PIPING AND INSTRUMENT DIAGRAM	JOB NO.	S-02115	REV.	4
DATE	13/4/17	SCALE	P34	CONTRACTOR DRAWING NO.	MKP-11-AS-5000-PS07-PID-006	SHEET	01
				SUB-CONTRACTOR DRAWING NO.			
				SHEET -- TOTAL --			

PROJECT	MKP Methanol Project
UNIT	Distillation Unit
PHASE	As Built Drawing
OWNER DWG. NO.	MKP-11-AS-5000-PR-PID-006

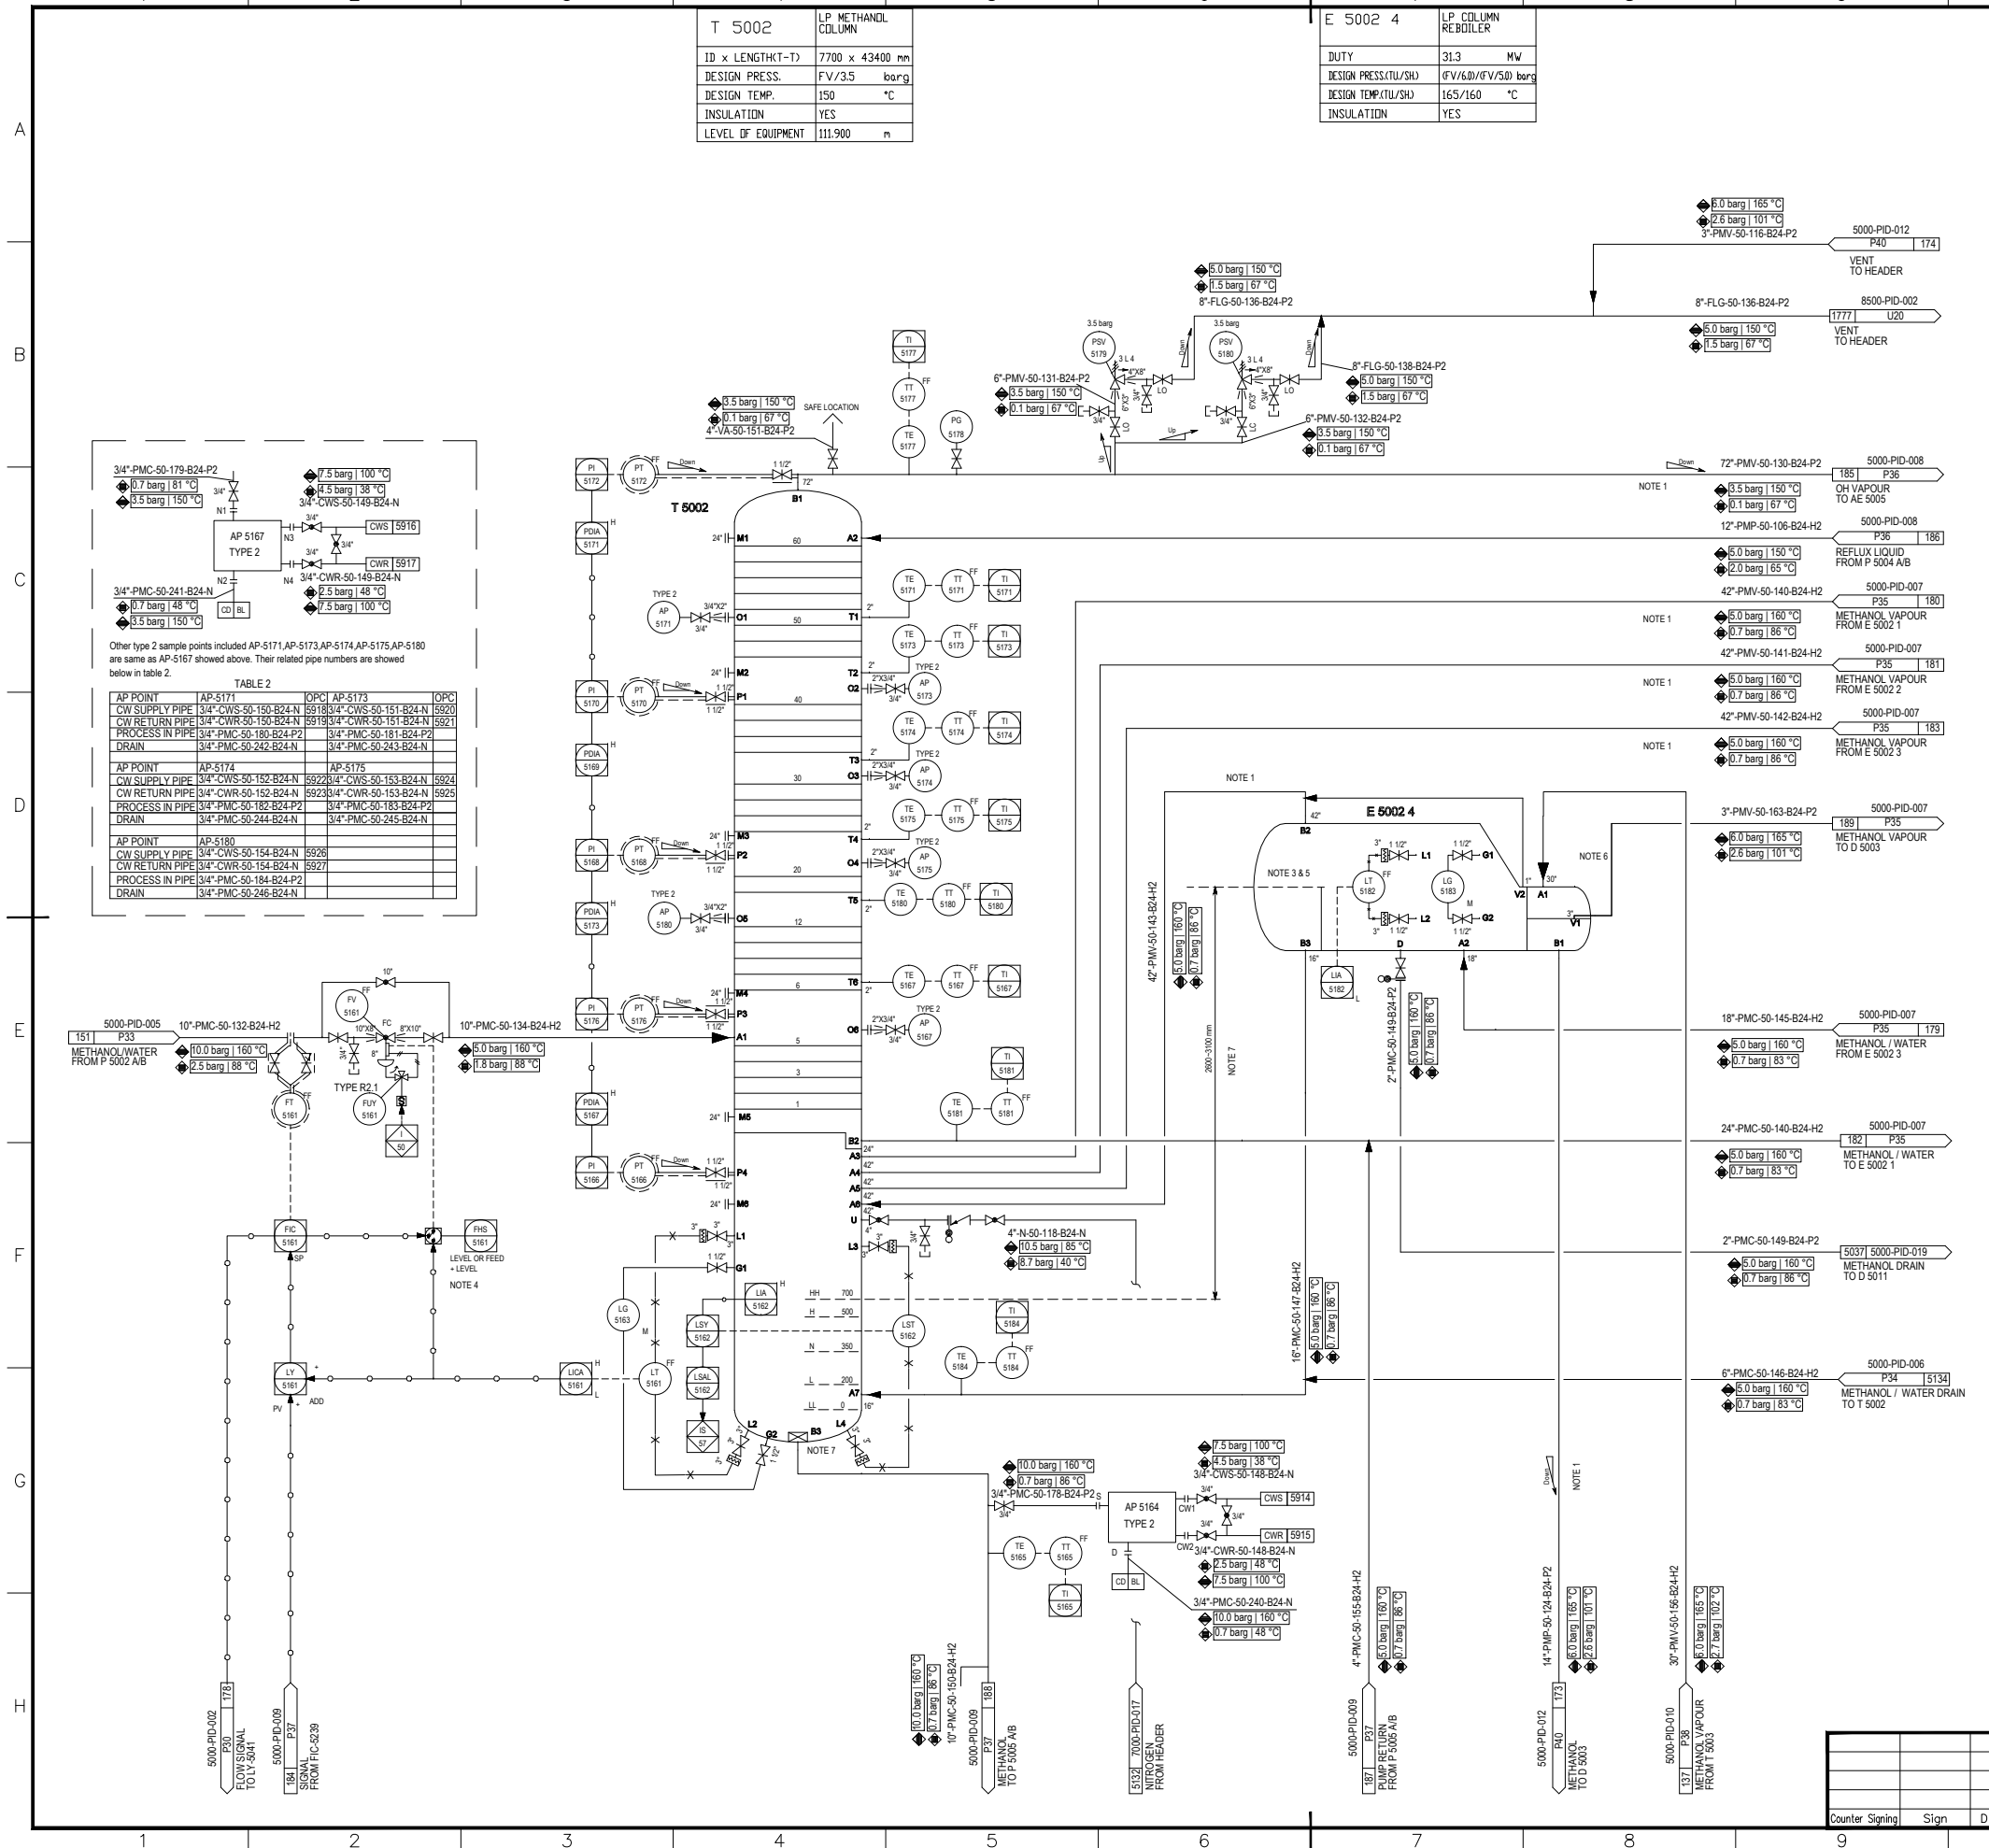

Other type 2 sample points included AP-5171, AP-5173, AP-5174, AP-5175, AP-5180 are same as AP-5167 showed above. Their related pipe numbers are showed below in table 2.

AP POINT	AP-5171	OPC	AP-5173	OPC
CW SUPPLY PIPE	3/4"-CWS-50-150-B24-N	S918	3/4"-CWS-50-151-B24-N	S920
CW RETURN PIPE	3/4"-CWR-50-150-B24-N	S919	3/4"-CWR-50-151-B24-N	S921
PROCESS IN PIPE	3/4"-PMC-50-180-B24-P2		3/4"-PMC-50-181-B24-P2	
DRAIN	3/4"-PMC-50-242-B24-N		3/4"-PMC-50-243-B24-N	
AP POINT	AP-5174	AP-5175		
CW SUPPLY PIPE	3/4"-CWS-50-152-B24-N	S922	3/4"-CWS-50-153-B24-N	S924
CW RETURN PIPE	3/4"-CWR-50-152-B24-N	S923	3/4"-CWR-50-153-B24-N	S925
PROCESS IN PIPE	3/4"-PMC-50-182-B24-P2		3/4"-PMC-50-183-B24-P2	
DRAIN	3/4"-PMC-50-244-B24-N		3/4"-PMC-50-245-B24-N	
AP POINT	AP-5180			
CW SUPPLY PIPE	3/4"-CWS-50-154-B24-N	S926		
CW RETURN PIPE	3/4"-CWR-50-154-B24-N	S927		
PROCESS IN PIPE	3/4"-PMC-50-184-B24-P2			
DRAIN	3/4"-PMC-50-246-B24-N			



E 5002 3	LP COLUMN REBOILER
DUTY	31.3 MW
DESIGN PRESS.(TLU/SH)	(FV/6.0)/(FV/5.0) barg
DESIGN TEMP.(TLU/SH)	165/160 °C
INSULATION	YES


E 5002 2	LP COLUMN REBOILER
DUTY	31.3 MW
DESIGN PRESS.(TLU/SH)	(FV/6.0)/(FV/5.0) barg
DESIGN TEMP.(TLU/SH)	165/160 °C
INSULATION	YES

E 5002 1	LP COLUMN REBOILER
DUTY	31.3 MW
DESIGN PRESS.(TLU/SH)	(FV/6.0)/(FV/5.0) barg
DESIGN TEMP.(TLU/SH)	165/160 °C
INSULATION	YES

GENERAL NOTES

- NOTES:
- NO POCKETS.
  - TOP OF TUBE BUNDLE IN E 5002 1/2/3/4 MUST BE IN SAME ELEVATION.
  - UPPER EDGE OF OVERFLOW WEIR, GRAVITATIONAL LIQUID FLOW FROM T 5002 TO E 5002 1/2/3/4 AND BACK TO T 5002. PIPING MUST BE SELF-DRAINING WHEN BYPASS IS OPEN.
  - VENT TO SAFE LOCATION.

GENERAL NOTE:  
LOW POINT DRAINS AND HIGH POINT VENT MUST BE ADDED DURING DETAILED ENGINEERING.

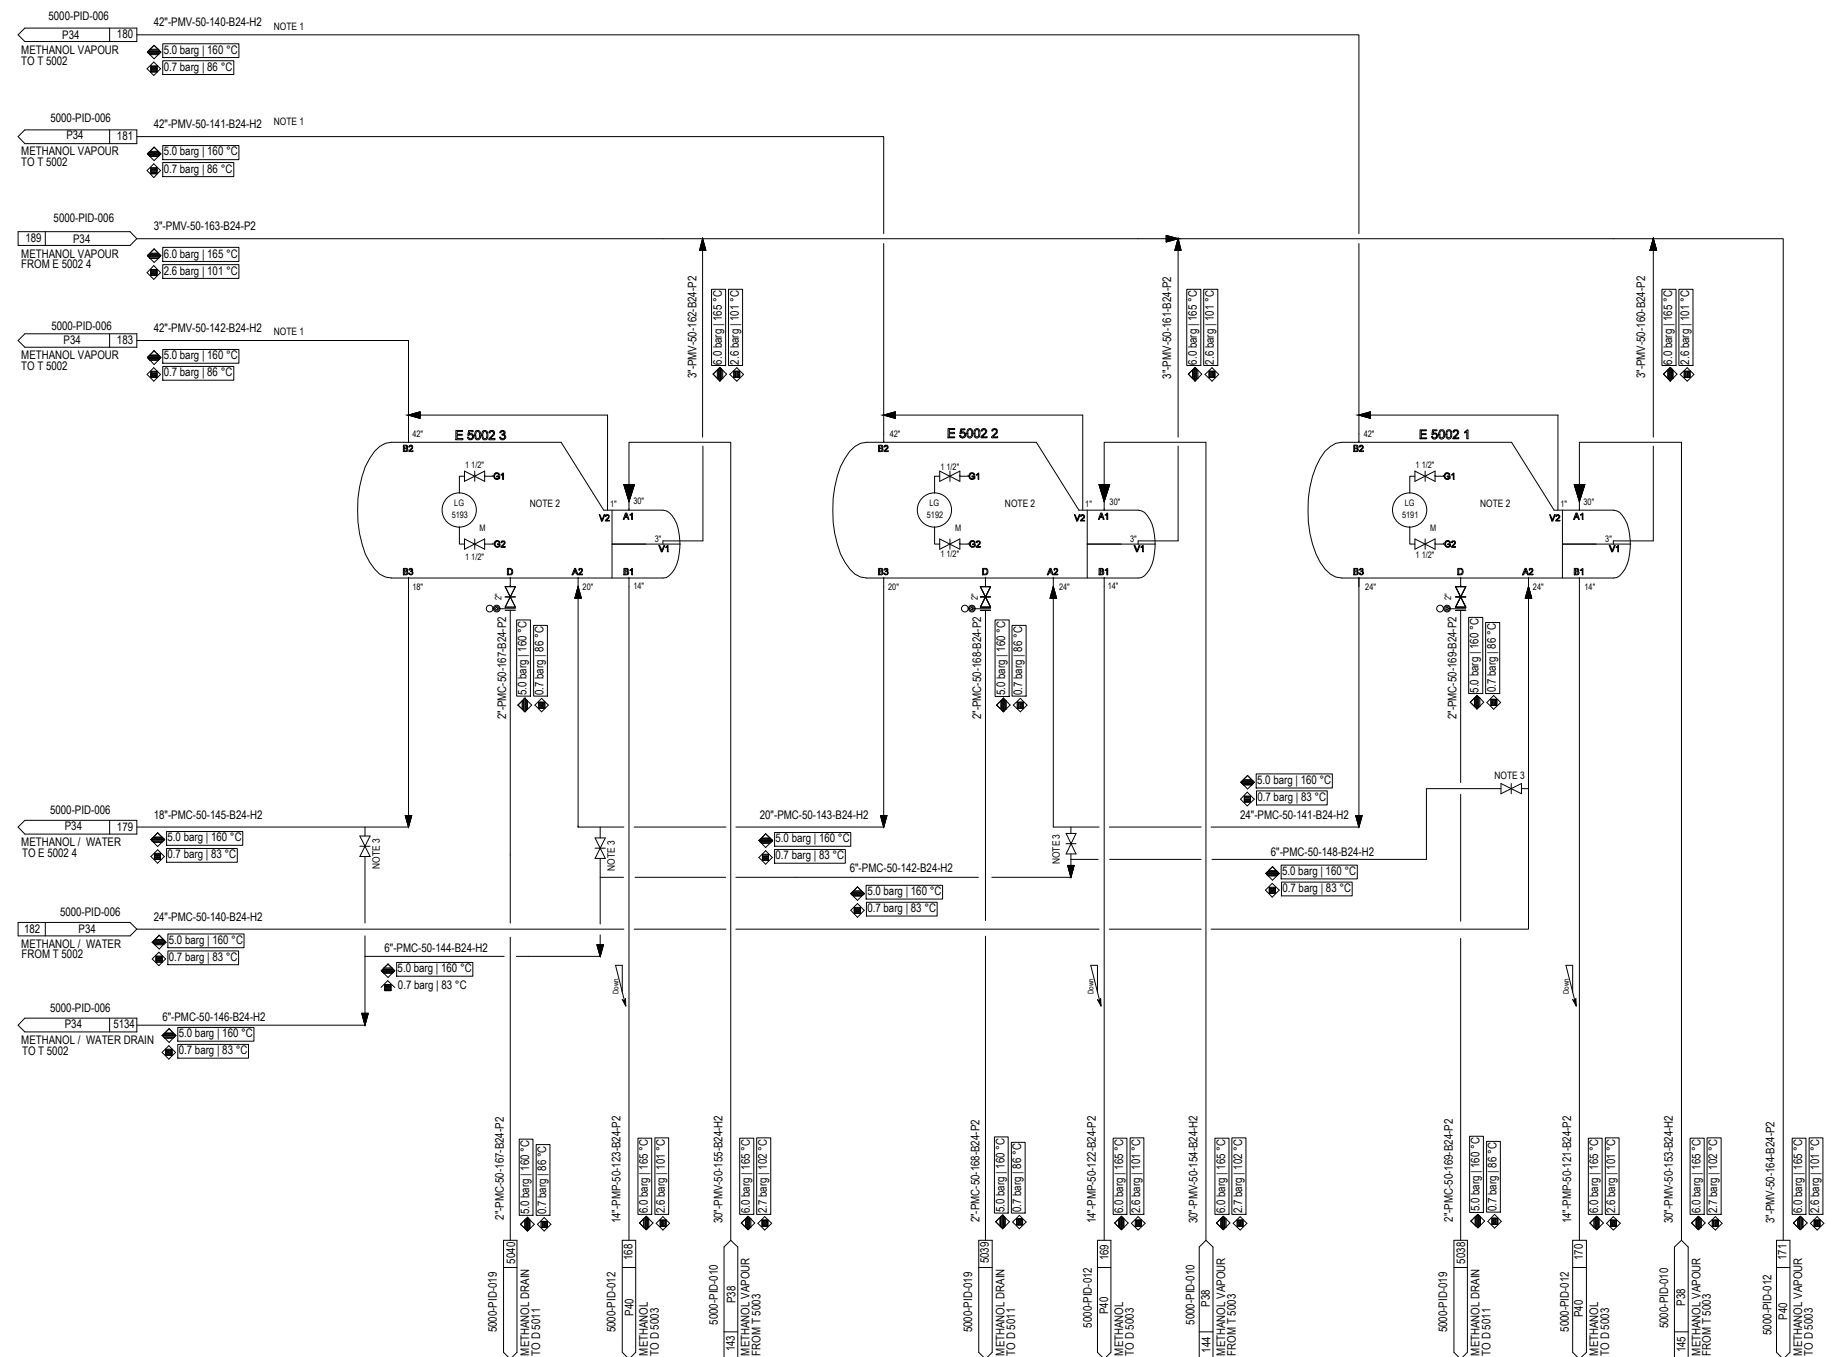

REFERENCE DRAWINGS

SYMBOLS AND LEGENDS

KEY PLAN

REV.	DESCRIPTION	DATE	DESIGN	DRAW	CHECK	REVIEW	APPROVE
▲	As Built	30.04.2020	Li Zhijuan		Mu Yujun	Hu Qiyi	
▲	Approved for Construction	22.01.2017	Li Zhijuan		Mu Yujun	Hu Qiyi	
▲	Approved for Construction	14.10.2016	Li Zhijuan		Mu Yujun	Hu Qiyi	
▲	Approved for Construction	31.08.2016	Li Zhijuan		Mu Yujun	Hu Qiyi	
▲	Issued for Approval	05.07.2016	Li Zhijuan		Mu Yujun	Hu Qiyi	
▲	Issued for Comments	29.04.2016	Li Zhijuan		Mu Yujun	Hu Qiyi	

THIS DOCUMENT IS THE PROPERTY OF TCC. NO PART OF THIS DOCUMENT SHALL BE REPRODUCED OR DISCLOSED TO OTHERS OR USED FOR ANY PURPOSE WHATSOEVER EXCEPT WITH THE PRIOR WRITTEN PERMISSION OF TCC.

OWNER: Middle East Kimiaye Pars Company

DESIGNER	HALDOR TOPSØE A/S	DOCUMENT NAME	LP METHANOL COLUMN REBOILER PIPING AND INSTRUMENT DIAGRAM	JOB NO.	S-02115	CDR	42	REV.	3
DRAWN		DWG NO.	1341745	SCALE		SHEET	P35		
CONTRACTOR	TCC 中国天辰工程有限公司 CHINA TIANCHEN ENGINEERING CORPORATION								
CONTRACT NO.	CONTRACTOR DRAWING NO. MKP-11-AS-5000-PS07-PID-007								
	SHEET 01 TOTAL 01								
	SUB-CONTRACTOR DRAWING NO.								
	SHEET -- TOTAL --								

PROJECT	MKP Methanol Project
UNIT	Distillation Unit
PHASE	As Built Drawing
OWNER DWG NO.	MKP-11-AS-5000-PR-PID-007

Counter	Sign	Date

SCALE: -- SHEET: 1 TOT.: 1 SIZE: A1


E 5008	METHANOL PRODUCT COOLER NO.1
DUTY	1.6 MW
DESIGN PRESS.(TL/SH)	7.5/13 barg
DESIGN TEMP.(TL/SH)	100/150 °C
INSULATION	YES

AE 5005	LP COLUMN OH CONDENSER
DUTY	127.7 MW
ID x LENGTH(T-T)	BY VENDOR mm
DESIGN PRESS.(TL/SH)	(FV/3.5)/NA barg
DESIGN TEMP.(TL/SH)	150/NA °C

P 5004 A/B	LP COLUMN REFUX PUMP
CAPACITY	725.3 m3/h
HEAD	92 m
DENSITY@DT	750 kg/m3
INSULATION/TRACING	NONE
AUXILIARY PIPING	BY VENDOR
LEVEL OF EQUIPMENT	101.440 m

D 5002	LP COLUMN OH ACCUMULATOR
ID x LENGTH(T-T)	3300 x 9850 mm
DESIGN PRESS.	FV/3.5 barg
DESIGN TEMP.	150 °C
INSULATION	YES
CLADDING/LINING	NONE
LEVEL OF EQUIPMENT	105.200 m

**GENERAL NOTES**

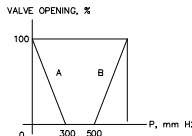- NOTES:
- NOZZLE B ON D 5002 MUST BE LOCATED MIN. 4 m ABOVE P 5004 A/B (TO BE CONFIRMED BY PUMP VENDOR).
  - VENT TO BE AT HIGHER ELEVATION THAN AE 5005 AND AT SAFE LOCATION.
  - FUNCTION OF PIC-5207:
- 
- 1/2" DRIP HOLE TO BE DRILLED AT LOW POINT TO SAFE AND SUITABLE LOCATION.
  - TWS TO BE INSTALLED ON EACH OUTLET HEADER FROM AE 5005.
  - DETAIL AIR COOLER DRAWING IN 5000-PR-PID-023(1) TO 5000-PR-PID-023(4).
  - ONE SET IN WARE HOUSE (E 5008).
  - THE SPARE PUMP WOULD AUTOSTART WHEN THE OUTLET PRESSURE DECREASED.

GENERAL NOTE:  
LOW POINT DRAINS AND HIGH POINT VENT MUST BE ADDED DURING DETAILED ENGINEERING.


**REFERENCE DRAWINGS**

**SYMBOLS AND LEGENDS**

**KEY PLAN**

As Built	30.04.2020	Wang Yishu	Mu Yujun	Hu Qiyi
Approved for Construction	30.12.2019	Wang Yishu	Mu Yujun	Hu Qiyi
Approved for Construction	11.11.2018	Wang Yishu	Mu Yujun	Hu Qiyi
Approved for Construction	06.11.2017	Wang Yishu	Mu Yujun	Hu Qiyi
Approved for Construction	08.05.2017	Li Zhijuan	Mu Yujun	Hu Qiyi
Approved for Construction	22.03.2017	Li Zhijuan	Mu Yujun	Hu Qiyi
Approved for Construction	22.01.2017	Li Zhijuan	Mu Yujun	Hu Qiyi
Approved for Construction	28.11.2016	Li Zhijuan	Mu Yujun	Hu Qiyi
Approved for Construction	14.10.2016	Li Zhijuan	Mu Yujun	Hu Qiyi
Issued for Approval	31.08.2016	Li Zhijuan	Mu Yujun	Hu Qiyi
Issued for Approval	05.07.2016	Li Zhijuan	Mu Yujun	Hu Qiyi
Issued for Comments	29.04.2016	Li Zhijuan	Mu Yujun	Hu Qiyi


THIS DOCUMENT IS THE PROPERTY OF TCC. NO PART OF THIS DOCUMENT SHALL BE REPRODUCED OR DISCLOSED TO OTHERS OR USED FOR ANY PURPOSE WHATSOEVER EXCEPT WITH THE PRIOR WRITTEN PERMISSION OF TCC.

OWNER:  Middle East Kimiaye Pars Company

DESIGNER	HALDOR TOPSØE A/S	DOCUMENT NAME	LP METHANOL COLUMN OH SYSTEM PIPING AND INSTRUMENT DIAGRAM	JOB NO.	S-02115	SCALE	42	REV.	3
DRAWN		DRAWING NO.	1341746	DATE	20200430	BY	PSB	CHKD	
CONTRACTOR	TCC 中国天辰工程有限公司	CONTRACTOR DRAWING NO.	MKP-11-AS-5000-PS07-PID-008	SHEET	01	TOTAL	01		
APPROVED		SUB-CONTRACTOR DRAWING NO.		SHEET		TOTAL			

PROJECT	MKP Methanol Project
UNIT	Distillation Unit
PHASE	As Built Drawing
OWNER DWG. NO.	MKP-11-AS-5000-PR-PID-008

SCALE	---	SHEET	1	TOT	1	SIZE	A1
-------	-----	-------	---	-----	---	------	----

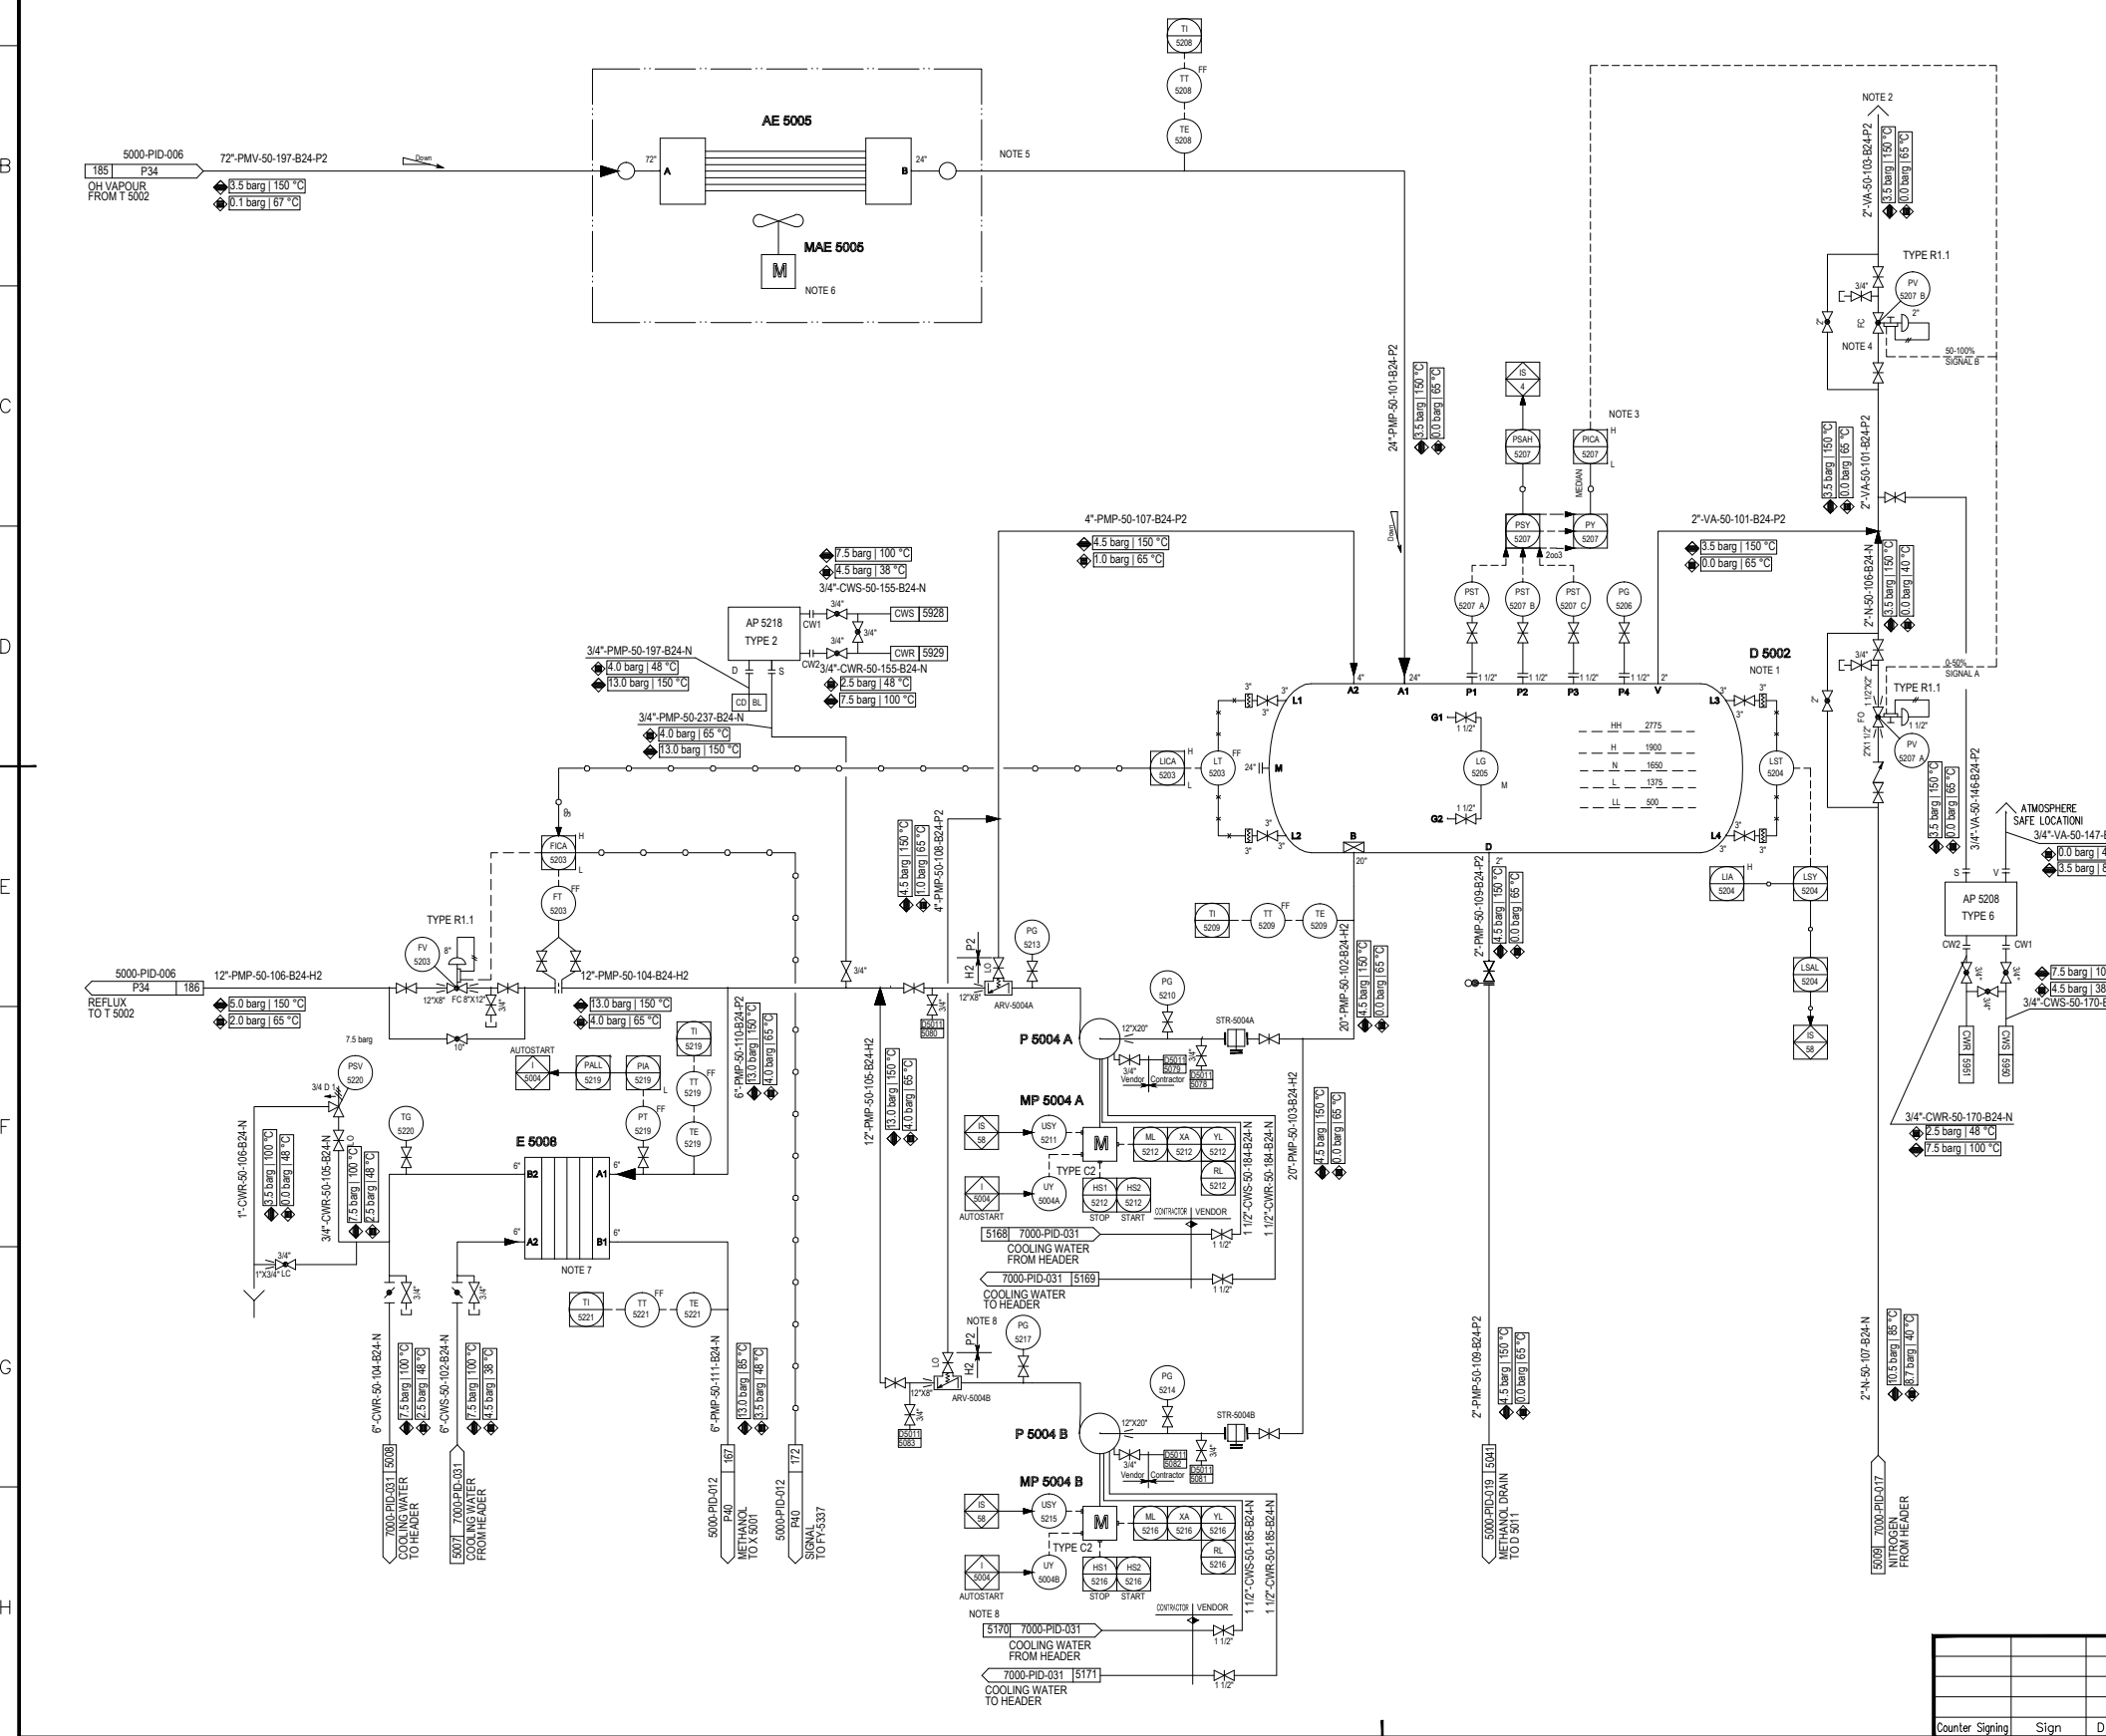

1 2 3 4 5 6 7 8 9 10 11 12

A B C D E F G H

Counter Signing Sign Date

P 5005 A/B	MP COLUMN FEED PUMP
CAPACITY	1821 m <sup>3</sup> /h
HEAD	94 m
DENSITY@DT	786 kg/m <sup>3</sup>
INSULATION/TRACING	NONE
AUXILIARY PIPING	BY VENDOR
LEVEL OF EQUIPMENT	101.230 m

E 5011	LIQUID OFF-STREAM COOLER
DUTY	0.16 MW
DESIGN PRESS.(TIU/SH)	7.5/7.5 barg
DESIGN TEMP.(TIU/SH)	100/175 °C
INSULATION	YES

**GENERAL NOTES**

- 1) THE SPARE PUMP WOULD AUTOSTART WHEN THE OUTLET PRESSURE DECREASED.
- 2) FV-5441 MUST BE LOCATED AS CLOSE AS POSSIBLE TO E 5011.
- 3) FOR T5002 BOTTOM DRAIN TO D5011.

† GENERAL NOTE:

LOW POINT DRAINS AND HIGH POINT VENT MUST BE ADDED DURING DETAILED ENGINEERING.

**REFERENCE DRAWINGS**

**SYMBOLS AND LEGENDS**

**KEY PLAN**



REV.	DESCRIPTION	DATE	DESIGN	DRAW	CHECK	REVIEW	APPROVE
▲	As Built	30.04.2020	Wang Yishu		Mu Yujun	Hu Qiuyi	
▲	Approved for Construction	30.12.2019	Wang Yishu		Mu Yujun	Hu Qiuyi	
▲	Approved for Construction	26.03.2018	Wang Yishu		Mu Yujun	Hu Qiuyi	
▲	Approved for Construction	08.05.2017	Li Zhijuan		Mu Yujun	Hu Qiuyi	
▲	Approved for Construction	22.03.2017	Li Zhijuan		Mu Yujun	Hu Qiuyi	
▲	Approved for Construction	22.01.2017	Li Zhijuan		Mu Yujun	Hu Qiuyi	
▲	Approved for Construction	28.11.2016	Li Zhijuan		Mu Yujun	Hu Qiuyi	
▲	Approved for Construction	14.10.2016	Li Zhijuan		Mu Yujun	Hu Qiuyi	
▲	Approved for Construction	31.08.2016	Li Zhijuan		Mu Yujun	Hu Qiuyi	
▲	Issued for Approval	05.07.2016	Li Zhijuan		Mu Yujun	Hu Qiuyi	
▲	Issued for Comments	29.04.2016	Li Zhijuan		Mu Yujun	Hu Qiuyi	

THIS DOCUMENT IS THE PROPERTY OF TCC. NO PART OF THIS DOCUMENT SHALL BE REPRODUCED OR DISCLOSED TO OTHERS OR USED FOR ANY PURPOSE WHATSOEVER EXCEPT WITH THE PRIOR WRITTEN PERMISSION OF TCC.

OWNER:




**Middle East  
Kimiaye Pars Company**

 <b>HALDOR TOPSOE A/S</b> COMPANY ENGINEER	DOCUMENT NAME	MP METHANOL COLUMN FEED PUMP PIPING AND INSTRUMENT DIAGRAM	JOB NO.	S-02115	REV.	4
	DATE	13/11/17	DWG NO.	1341747	SCALE	P37
 <b>TCC 中国天辰工程有限公司</b> CHINA TIANCHEN ENGINEERING CORPORATION	CONTRACTOR DRAWING NO.					
	MKP-11-AS-5000-PS07-PID-009					
SHEET 01 TOTAL 01						
SUB-CONTRACTOR DRAWING NO.						
SHEET -- TOTAL --						

MP METHANOL COLUMN FEED PUMP PIPING AND INSTRUMENT DIAGRAM	PROJECT	MKP Methanol Project
	UNIT	Distillation Unit
	PHASE	As Built Drawing
OWNER DWG NO.		MKP-11-AS-5000-PR-PID-009

Counter	Sign	Date
---------	------	------

SCALE: --	SHEET: 1	TOT: 1	SIZE: A1
-----------	----------	--------	----------

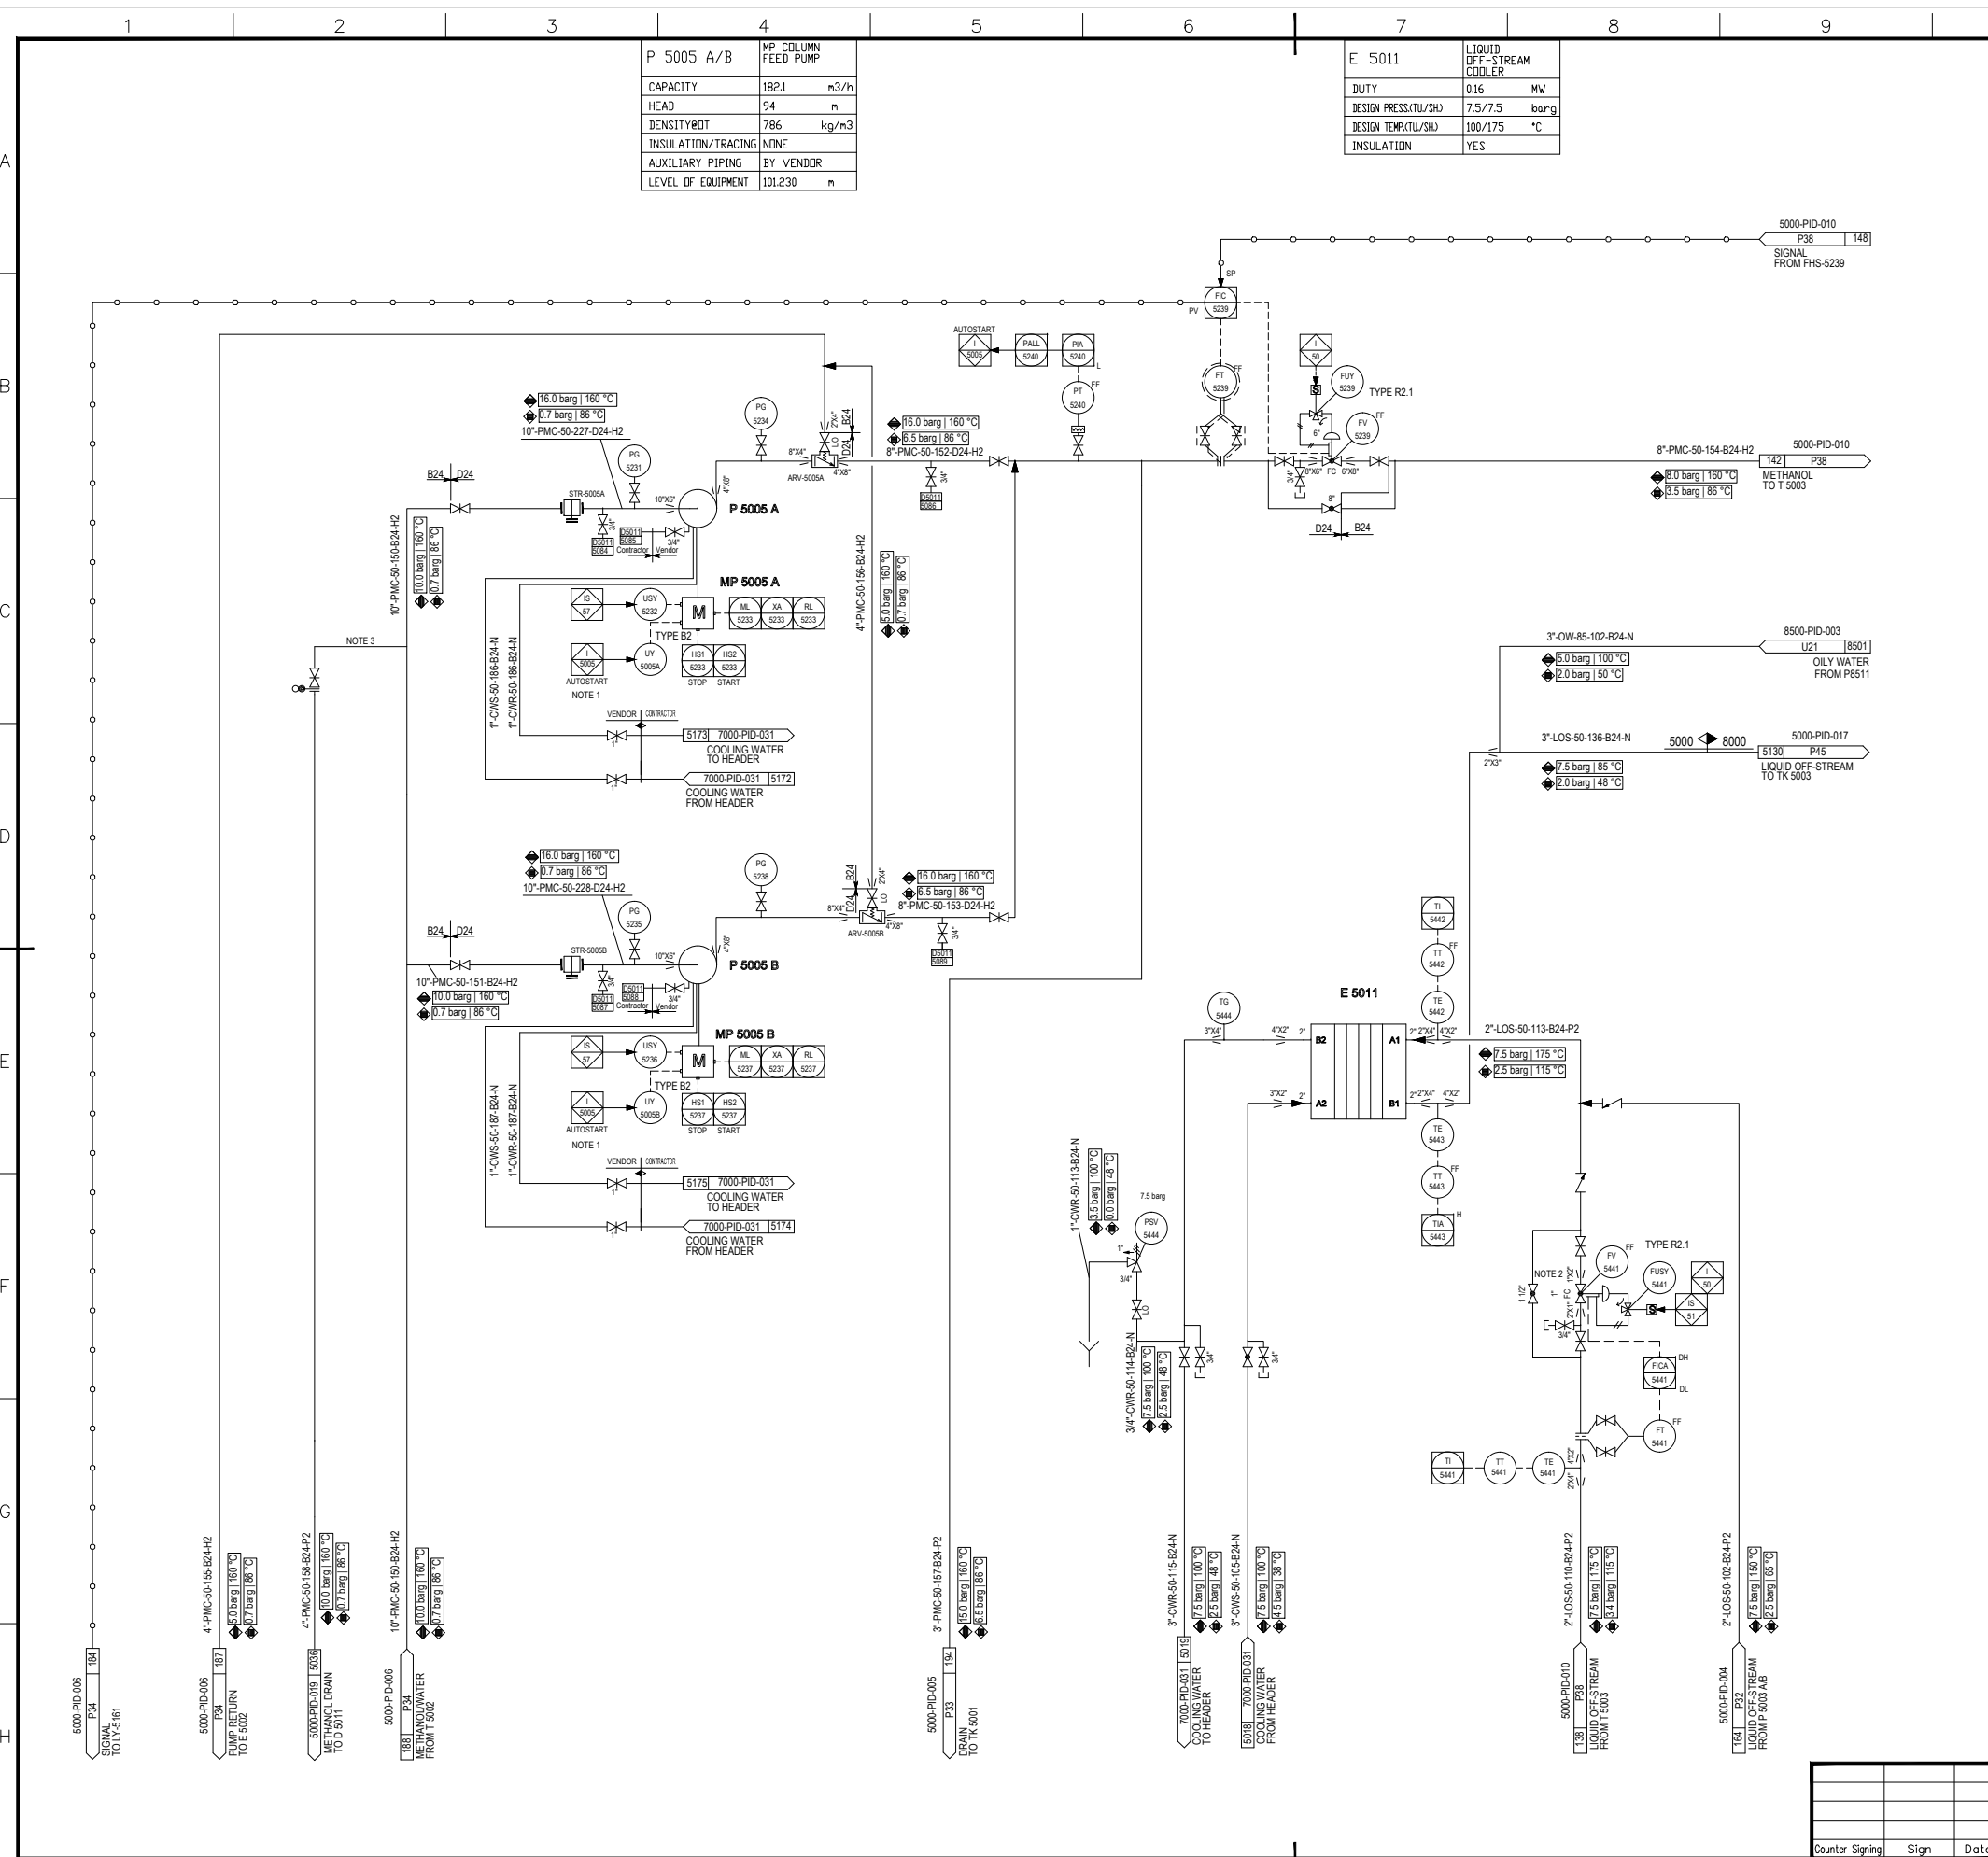

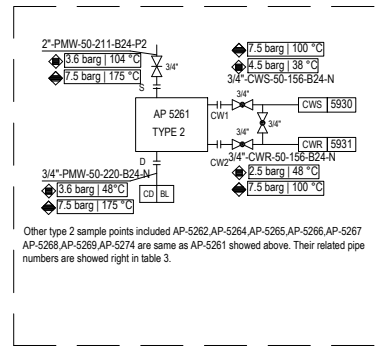


TABLE 3			
AP POINT	AP-5262	OPC1 AP-5264	OPC2
CW SUPPLY PIPE	3/4" CWS-50-157-B24-N	E932 3/4" CWS-50-158-B24-N	E934
CW RETURN PIPE	3/4" CWR-50-157-B24-N	E933 3/4" CWR-50-158-B24-N	E935
PROCESS IN PIPE	3/4" PMW-50-212-B24-P2	3/4" PMW-50-213-B24-P2	
DRAIN	3/4" PMW-50-221-B24-N	3/4" PMW-50-222-B24-N	
AP-5265			
CW SUPPLY PIPE	3/4" CWS-50-159-B24-N	E936 3/4" CWS-50-160-B24-N	E938
CW RETURN PIPE	3/4" CWR-50-159-B24-N	E937 3/4" CWR-50-160-B24-N	E939
PROCESS IN PIPE	3/4" PMW-50-214-B24-P2	3/4" PMW-50-215-B24-P2	
DRAIN	3/4" PMW-50-223-B24-N	3/4" PMW-50-224-B24-N	
AP-5267			
CW SUPPLY PIPE	3/4" CWS-50-161-B24-N	E940 3/4" CWS-50-162-B24-N	E942
CW RETURN PIPE	3/4" CWR-50-161-B24-N	E941 3/4" CWR-50-162-B24-N	E943
PROCESS IN PIPE	3/4" PMW-50-216-B24-P2	3/4" PMW-50-217-B24-P2	
DRAIN	3/4" PMW-50-225-B24-N	3/4" PMW-50-226-B24-N	
AP-5269			
CW SUPPLY PIPE	3/4" CWS-50-163-B24-N	E944 3/4" CWS-50-164-B24-N	E946
CW RETURN PIPE	3/4" CWR-50-163-B24-N	E945 3/4" CWR-50-164-B24-N	E947
PROCESS IN PIPE	3/4" PMW-50-218-B24-P2	3/4" PMW-50-219-B24-P2	
DRAIN	3/4" PMW-50-227-B24-N	3/4" PMW-50-228-B24-N	


T 5003	
ID x LENGTH(T)	6350 x 56400 mm
DESIGN PRESS.	FV/6 barg
DESIGN TEMP.	165 °C
INSULATION	YES
LEVEL OF EQUIPMENT	110.700 m

E 5023	
MP COLUMN REBUILER NO. 2	
DUTY	17.2 MW
DESIGN PRESS.(TU/SH)	29/(FV/7.5) barg
DESIGN TEMP.(TU/SH)	200/175 °C
INSULATION	YES

**GENERAL NOTES**

- + NOTES:
- 1) UPPER EDGE OF OVERFLOW WEIR IN E 5003 2 TO BE 4100 mm ABOVE MAX. LEVEL IN T 5003.
- 2) GRAVITATIONAL LIQUID FLOW FROM T 5003 TO E 5023/E 5003 12 AND BACK TO T 5003. PIPING TO BE SELF-DRAINING WHEN BYPASS IS OPEN.
- 3) NO POCKETS.
- 4) TOP OF THE TUBE BUNDLE IN E 5023 AND E 5003 12 MUST BE AT THE SAME ELEVATION.
- 5) SYMMETRICAL PIPING.
- 6) NOZZLE B3 ON T 5003 MUST BE LOCATED MIN. 3.5 m ABOVE P 5010 AB. TO BE CONFIRMED BY PUMP VENDOR.
- 7) DELETED.
- 8) TO BE READABLE AT GRADE.

+ GENERAL NOTE:  
LOW POINT DRAINS AND HIGH POINT VENT MUST BE ADDED DURING DETAILED ENGINEERING.

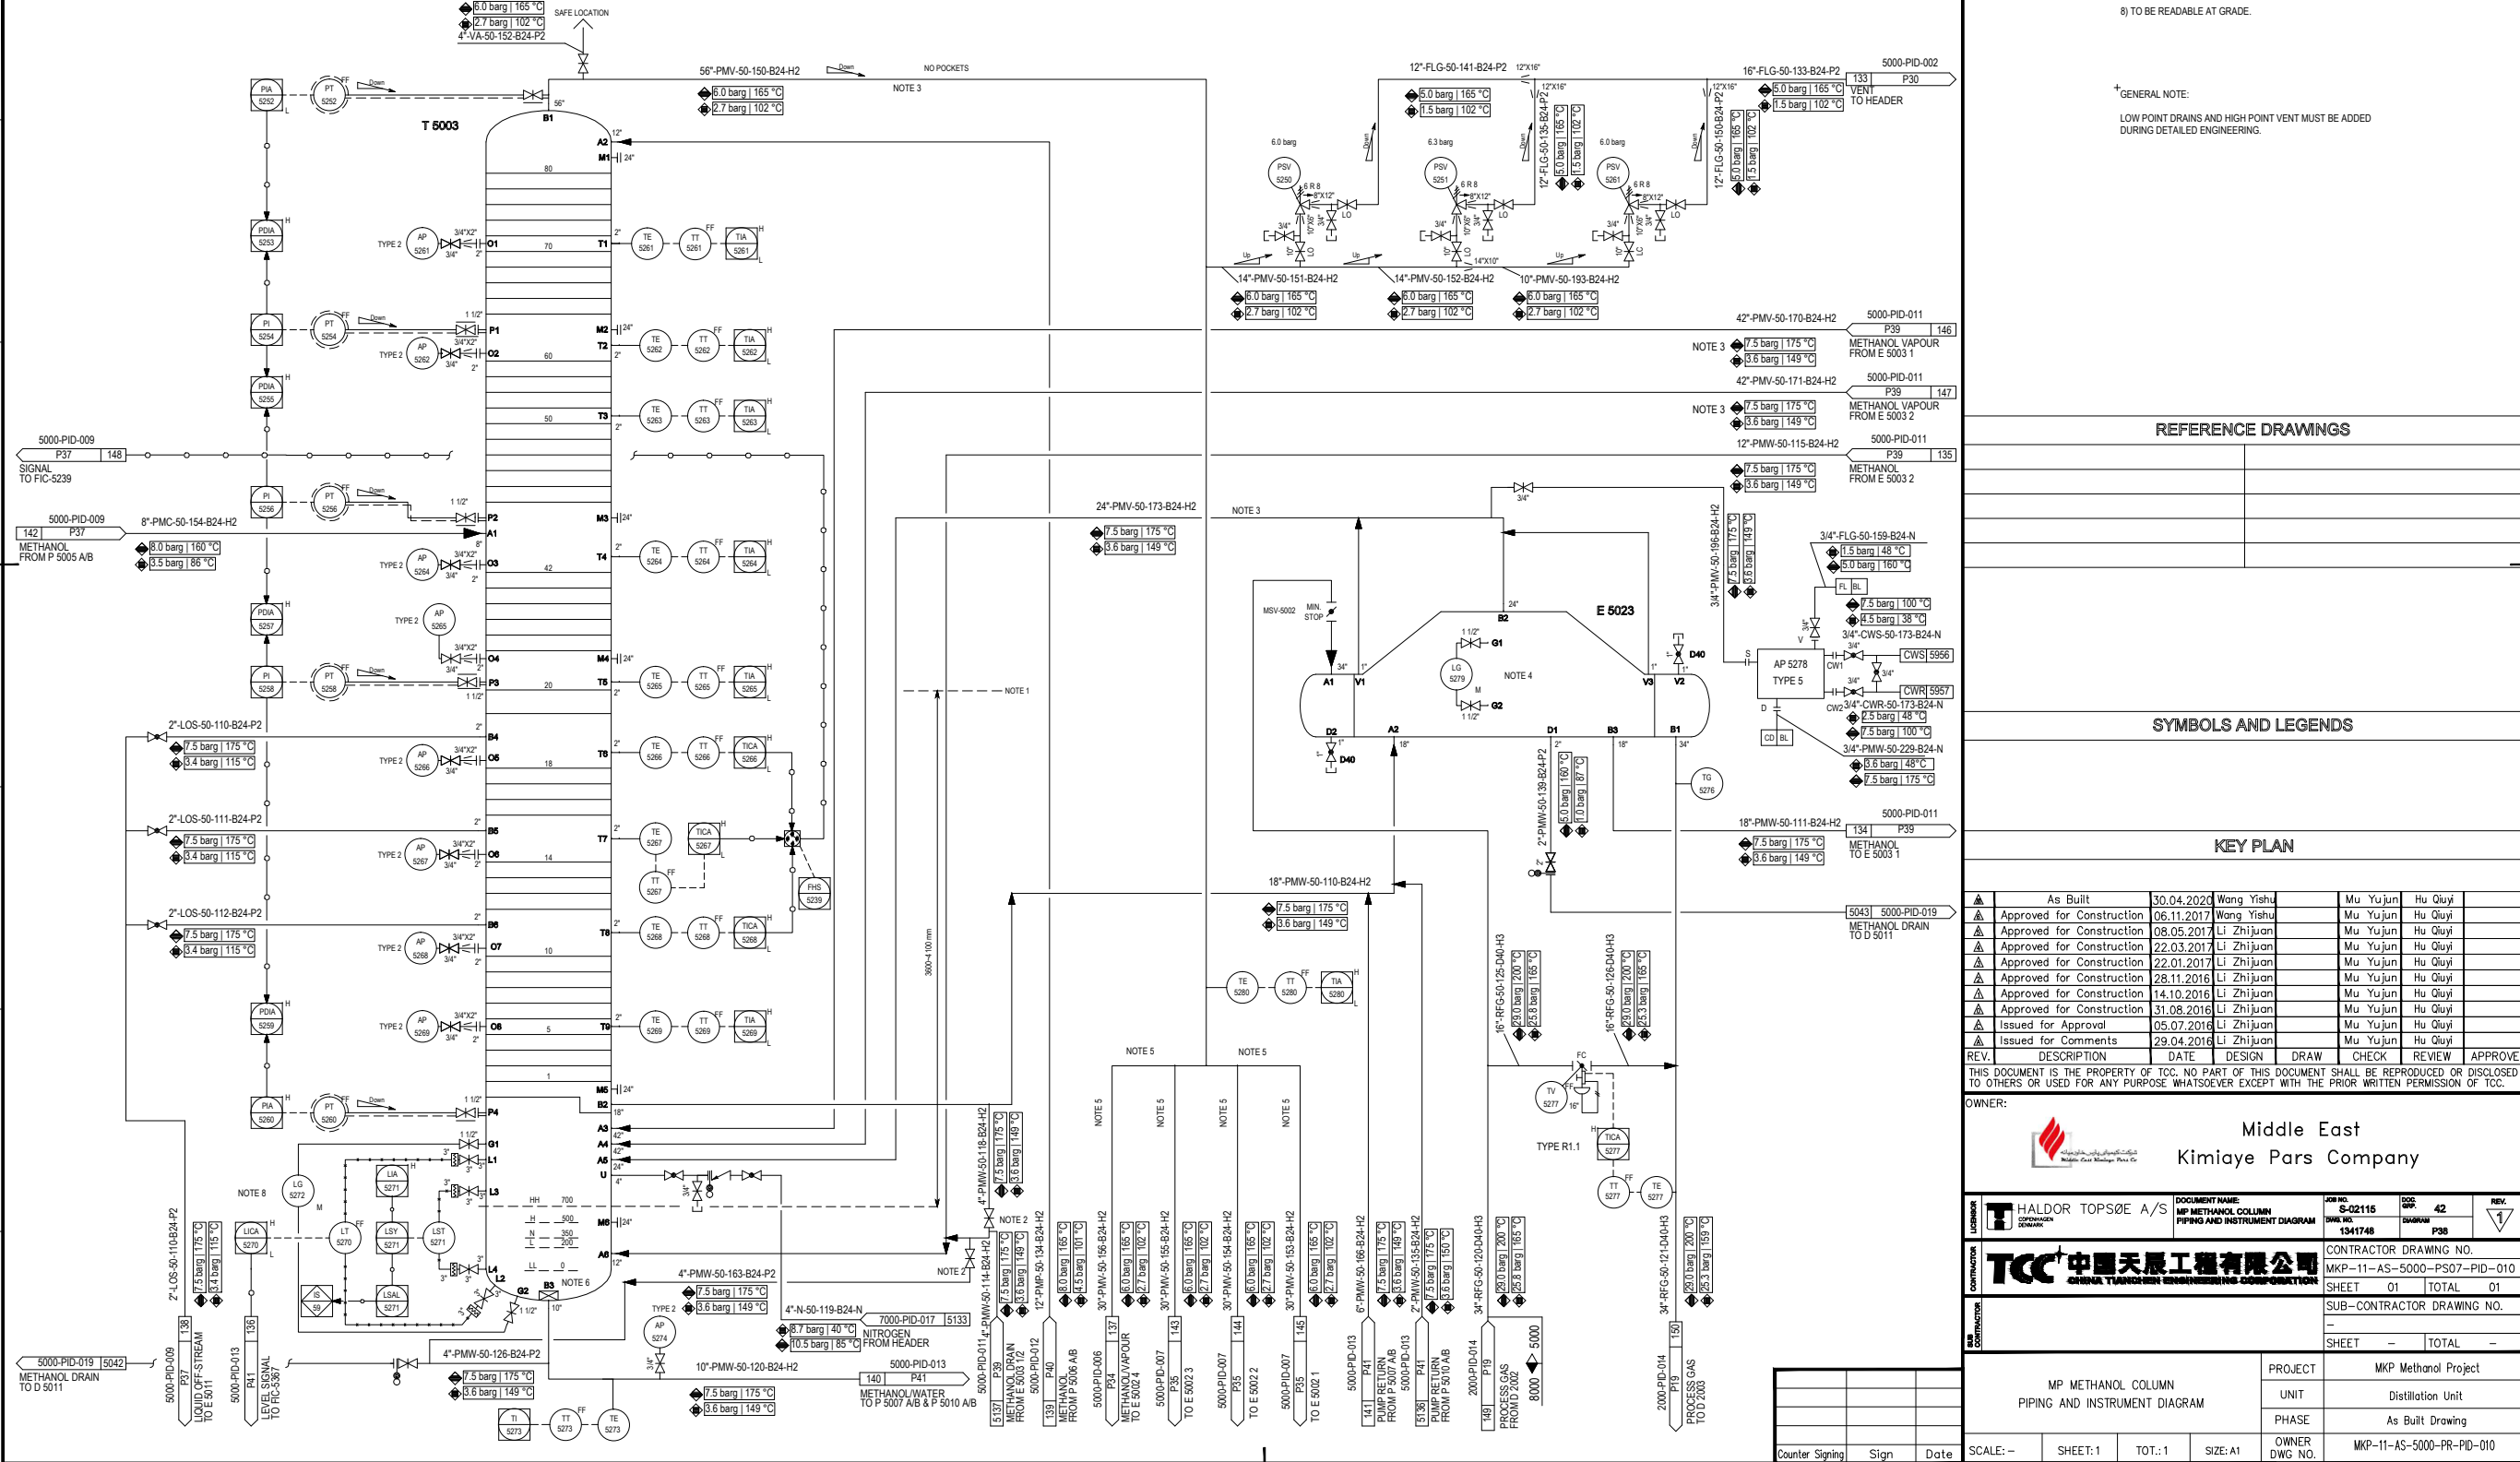

**REFERENCE DRAWINGS**

**SYMBOLS AND LEGENDS**

**KEY PLAN**

REV.	DESCRIPTION	DATE	DESIGN	DRAW	CHECK	REVIEW	APPROVE
▲	As Built	30.04.2020	Wang Yishu	Mu Yujun	Hu Qiyi		
▲	Approved for Construction	06.11.2017	Wang Yishu	Mu Yujun	Hu Qiyi		
▲	Approved for Construction	08.05.2017	Li Zhijuan	Mu Yujun	Hu Qiyi		
▲	Approved for Construction	22.03.2017	Li Zhijuan	Mu Yujun	Hu Qiyi		
▲	Approved for Construction	22.01.2017	Li Zhijuan	Mu Yujun	Hu Qiyi		
▲	Approved for Construction	28.11.2016	Li Zhijuan	Mu Yujun	Hu Qiyi		
▲	Approved for Construction	14.10.2016	Li Zhijuan	Mu Yujun	Hu Qiyi		
▲	Approved for Construction	31.08.2016	Li Zhijuan	Mu Yujun	Hu Qiyi		
▲	Issued for Approval	05.07.2016	Li Zhijuan	Mu Yujun	Hu Qiyi		
▲	Issued for Comments	29.04.2016	Li Zhijuan	Mu Yujun	Hu Qiyi		

THIS DOCUMENT IS THE PROPERTY OF TCC. NO PART OF THIS DOCUMENT SHALL BE REPRODUCED OR DISCLOSED TO OTHERS OR USED FOR ANY PURPOSE WHATSOEVER EXCEPT WITH THE PRIOR WRITTEN PERMISSION OF TCC.

OWNER: Middle East Kimiaye Pars Company

REVISION	DATE	BY	CHKD	APPD
1	30.04.2020	Wang Yishu	Mu Yujun	Hu Qiyi

PROJECT	MKP Methanol Project
UNIT	Distillation Unit
PHASE	As Built Drawing
OWNER DWG NO.	MKP-11-AS-5000-PR-PID-010



E 7003 2	EXCESS STEAM CONDENSATE COOLER
DUTY	15.3 MW
WIDE x LENGTH BY VENDOR	mm
DESIGN PRESS.(TLU/SH)	7.5/10.5 barg
DESIGN TEMP.(TLU/SH)	100/190 °C

E 5003 1/2	MP COLUMN REBOILER NO. 1
DUTY	113.3 MW
DESIGN PRESS.(TLU/SH)	(FV/9.5)/(FV/7.5)barg
DESIGN TEMP.(TLU/SH)	340/175 °C
INSULATION	YES

**GENERAL NOTES**

- NOTES:
- 1) SYMMETRICAL PIPING.
  - 2) TOP OF TUBE BUNDLE IN E 5023 AND E 5003 1/2 MUST BE AT SAME ELEVATION.
  - 3) MIN 1000 mm PIPE.
  - 4) NO POCKETS.
  - 5) GRAVITATIONAL LIQUID FLOW FROM T 5003 TO E 5003 1/2 AND BACK TO T 5003 FOR DRAINING.
  - 6) UPPER EDGE OF OVERFLOW WEIR IN E 5003 2 TO BE 4100 mm ABOVE MAX. LEVEL IN T 5003 FOR DRAINING.
  - 7) P&T COMPENSATION FROM PIC-7056, TI-7056.

GENERAL NOTE:  
LOW POINT DRAINS AND HIGH POINT VENT MUST BE ADDED DURING DETAILED ENGINEERING.


**REFERENCE DRAWINGS**

**SYMBOLS AND LEGENDS**

**KEY PLAN**


REV.	DESCRIPTION	DATE	DESIGN	DRAW	CHECK	REVIEW	APPROVE
▲	As Built	30.04.2020	Wang Yishu	Mu Yujun	Hu Qiyi		
▲	Approved for Construction	30.12.2019	Wang Yishu	Mu Yujun	Hu Qiyi		
▲	Approved for Construction	02.01.2018	Wang Yishu	Mu Yujun	Hu Qiyi		
▲	Approved for Construction	06.11.2017	Wang Yishu	Mu Yujun	Hu Qiyi		
▲	Approved for Construction	08.05.2017	Li Zhijuan	Mu Yujun	Hu Qiyi		
▲	Approved for Construction	22.03.2017	Li Zhijuan	Mu Yujun	Hu Qiyi		
▲	Approved for Construction	22.01.2017	Li Zhijuan	Mu Yujun	Hu Qiyi		
▲	Approved for Construction	14.10.2016	Li Zhijuan	Mu Yujun	Hu Qiyi		
▲	Issued for Approval	31.08.2016	Li Zhijuan	Mu Yujun	Hu Qiyi		
▲	Issued for Approval	05.07.2016	Li Zhijuan	Mu Yujun	Hu Qiyi		
▲	Issued for Comments	29.04.2016	Li Zhijuan	Mu Yujun	Hu Qiyi		

THIS DOCUMENT IS THE PROPERTY OF TCC. NO PART OF THIS DOCUMENT SHALL BE REPRODUCED OR DISCLOSED TO OTHERS OR USED FOR ANY PURPOSE WHATSOEVER EXCEPT WITH THE PRIOR WRITTEN PERMISSION OF TCC.

OWNER:  Middle East Kimiaye Pars Company

DESIGNER	HALDOR TOPSØE A/S	DOCUMENT NAME	MP COLUMN REBOILERS PIPING AND INSTRUMENT DIAGRAM	JOB NO.	S-02115	REV.	42
DATE	13/11/16	DWG NO.	1341749	SCALE	P30		
CONTRACTOR	 TCC 中国天辰工程技术有限公司	CONTRACTOR DRAWING NO.	MKP-11-AS-5000-PS07-PID-011	SHEET	01	TOTAL	01
CONTRACT		SUB-CONTRACTOR DRAWING NO.		SHEET		TOTAL	

PROJECT	MKP Methanol Project
UNIT	Distillation Unit
PHASE	As Built Drawing
OWNER DWG NO.	MKP-11-AS-5000-PR-PID-011

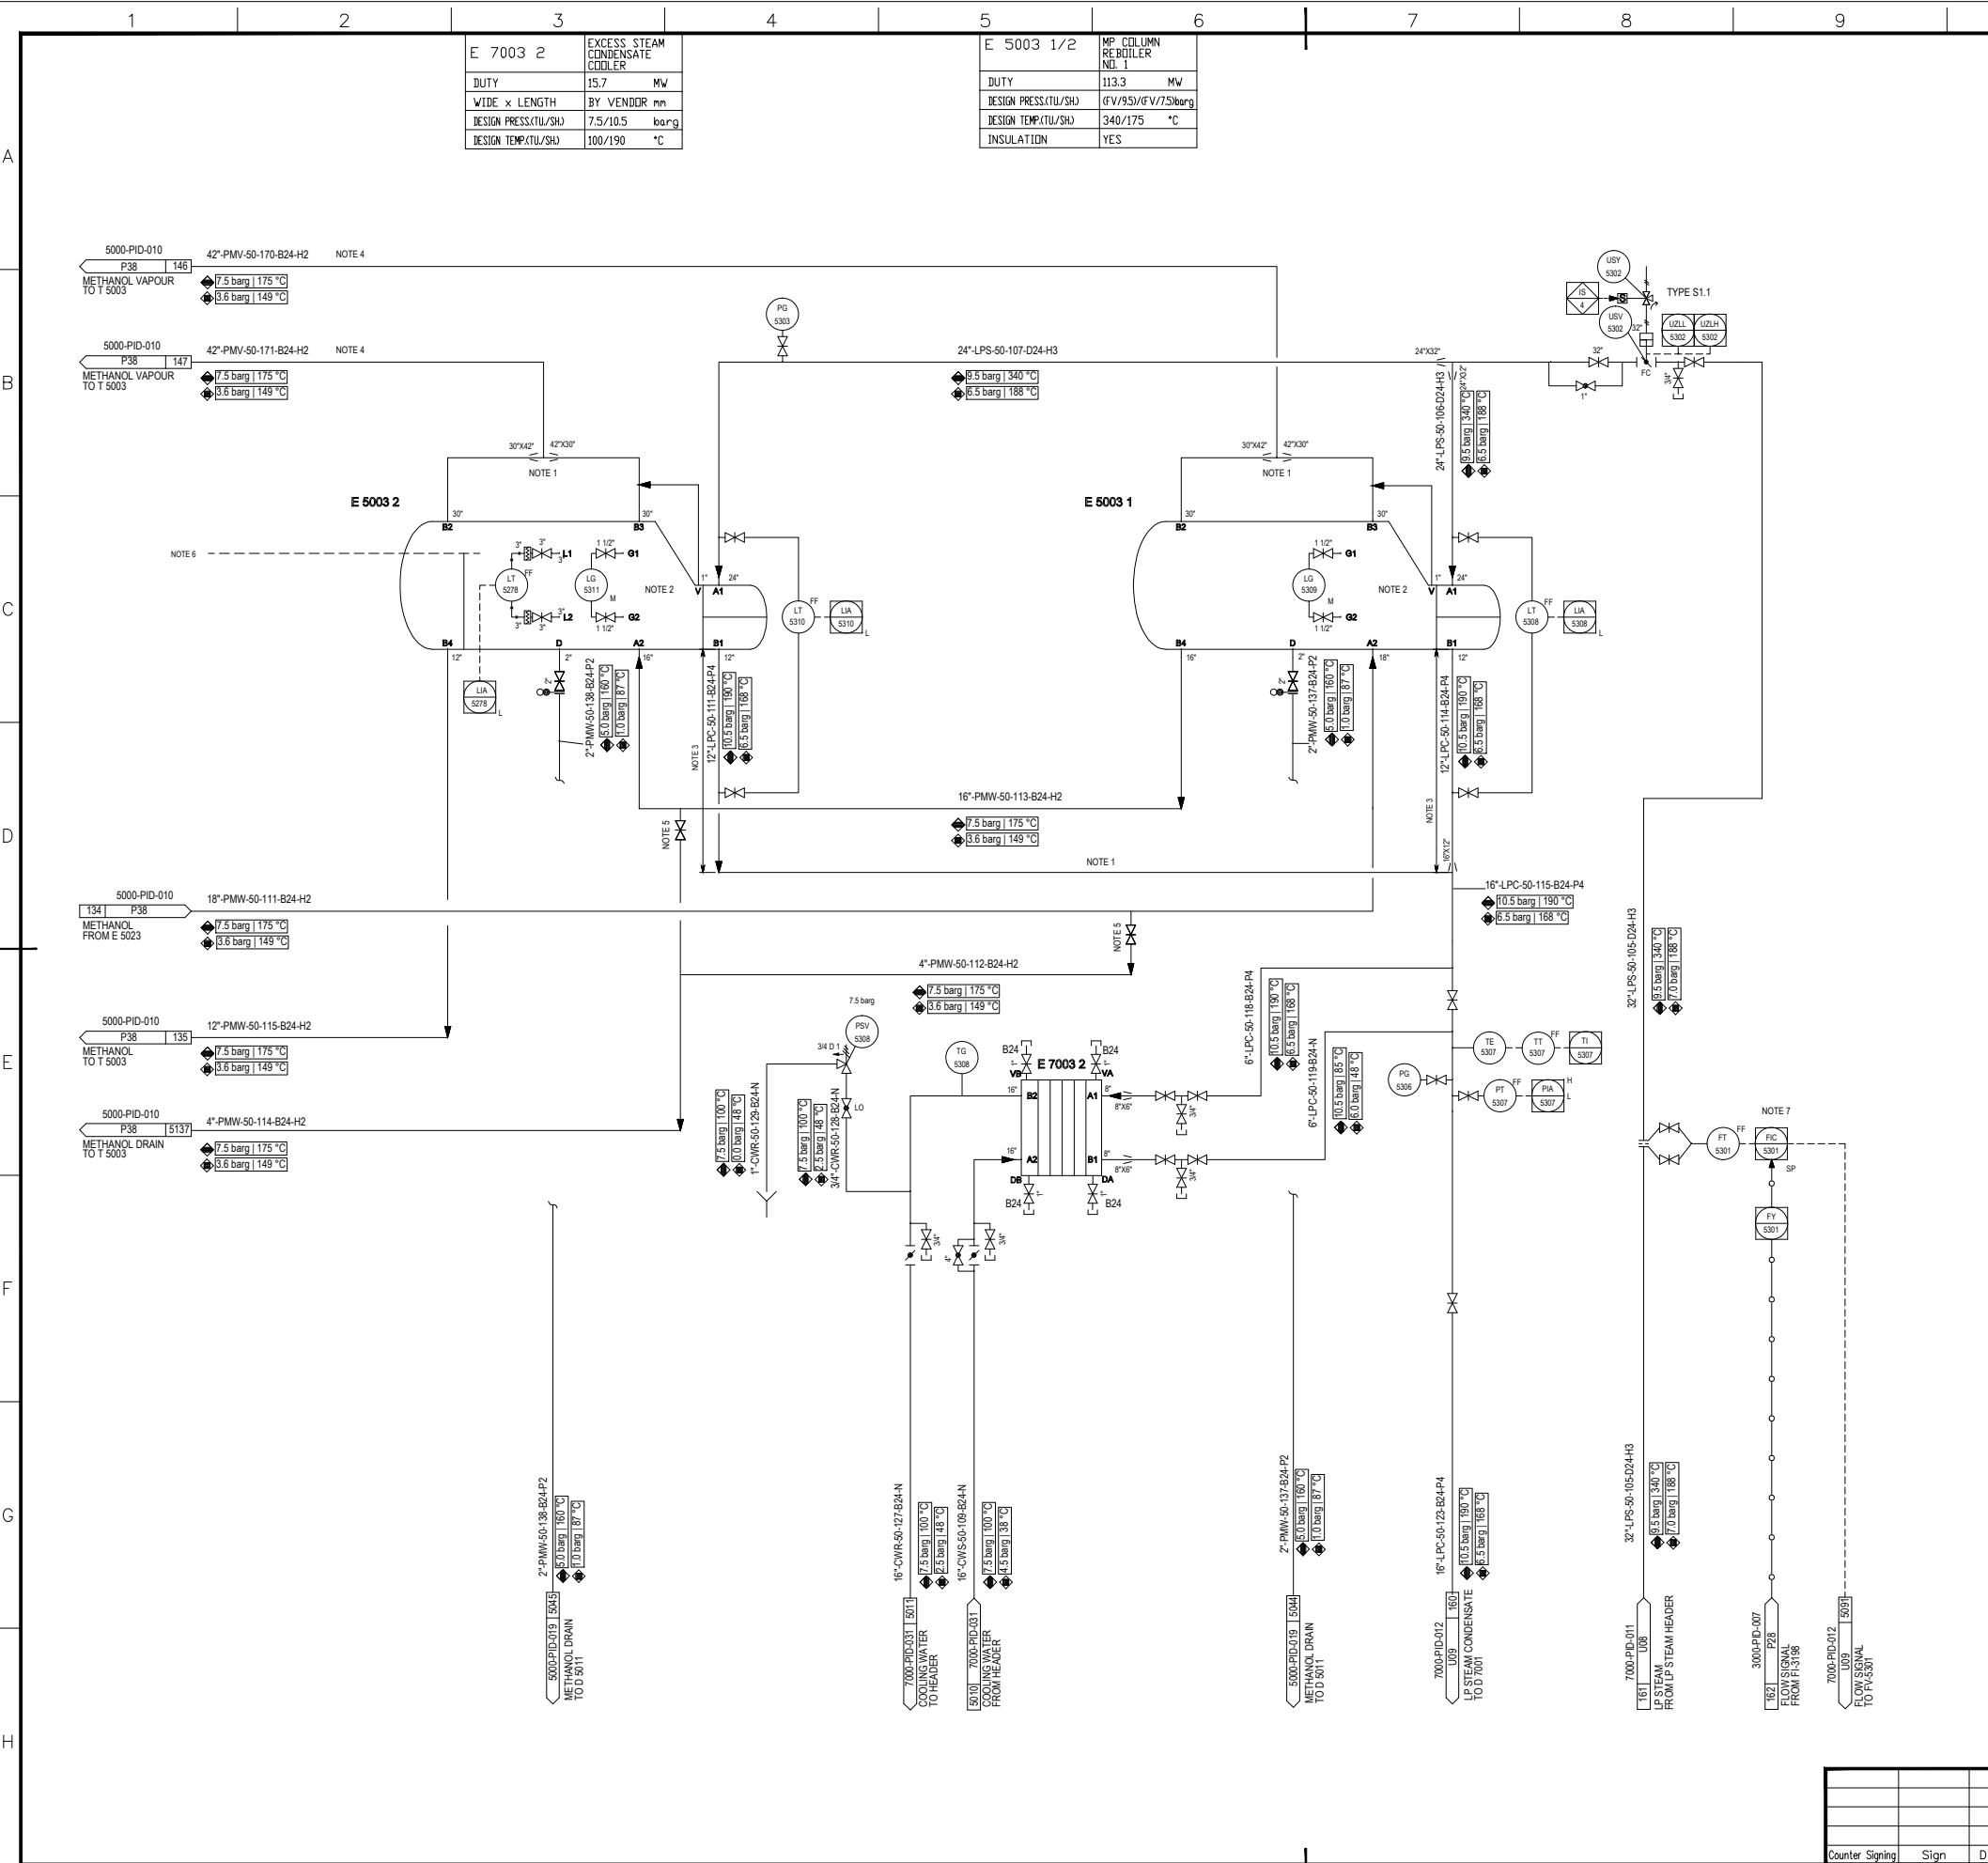

Counter Signing Sign Date

SCALE:-- SHEET:1 TOT:1 SIZE:A1

E 5012	METHANOL PRODUCT COOLER NO. 2
DUTY	3.6 MW
DESIGN PRESS.(TLU/SH)	7.5/19 barg
DESIGN TEMP.(TLU/SH)	100/165 °C
INSULATION	YES

P 5006 A/B	MP COLUMN REF LUX PUMP
CAPACITY	743.9 m <sup>3</sup> /h
HEAD	100 m
DENSITY@DOT	711 kg/m <sup>3</sup>
INSULATION/TRACING	NONE
AUXILIARY PIPING	BY VENDOR
LEVEL OF EQUIPMENT	101.440 m

D 5003	MP COLUMN OH ACCUMULATOR
ID x LENGTH(T-D)	3400 x 10250 mm
DESIGN PRESS.	FV/6.0 barg
DESIGN TEMP.	165 °C
INSULATION	YES
CLADDING/LINING	NONE
LEVEL OF EQUIPMENT	105.200 m

GENERAL NOTES

- NOTES:
- NOZZLE B ON D 5003 MUST BE LOCATED MIN. 4 m ABOVE P 5006 A/B. (TO BE CONFIRMED BY PUMP VENDOR).
  - NO POCKETS.
  - FUNCTION OF FIC-5336:  
OUTPUT FROM FY-5336 3  
  
PV FROM FIC-5321
  - ONE SET IN WARE HOUSE (E 5012).
  - THE SPARE PUMP WOULD AUTOSTART WHEN THE OUTLET PRESSURE DECREASED.

GENERAL NOTE:  
LOW POINT DRAINS AND HIGH POINT VENT MUST BE ADDED DURING DETAILED ENGINEERING.

REFERENCE DRAWINGS

SYMBOLS AND LEGENDS

KEY PLAN

REV.	DESCRIPTION	DATE	DESIGN	DRAW	CHECK	REVIEW	APPROVE
▲	As Built	30.04.2020	Wang Yishu		Mu Yujun	Hu Qiyi	
▲	Approved for Construction	30.12.2019	Wang Yishu		Mu Yujun	Hu Qiyi	
▲	Approved for Construction	06.11.2017	Wang Yishu		Mu Yujun	Hu Qiyi	
▲	Approved for Construction	08.05.2017	Li Zhijuan		Mu Yujun	Hu Qiyi	
▲	Approved for Construction	22.03.2017	Li Zhijuan		Mu Yujun	Hu Qiyi	
▲	Approved for Construction	22.01.2017	Li Zhijuan		Mu Yujun	Hu Qiyi	
▲	Approved for Construction	28.11.2016	Li Zhijuan		Mu Yujun	Hu Qiyi	
▲	Approved for Construction	14.10.2016	Li Zhijuan		Mu Yujun	Hu Qiyi	
▲	Issued for Approval	31.08.2016	Li Zhijuan		Mu Yujun	Hu Qiyi	
▲	Issued for Approval	05.07.2016	Li Zhijuan		Mu Yujun	Hu Qiyi	
▲	Issued for Comments	29.04.2016	Li Zhijuan		Mu Yujun	Hu Qiyi	

THIS DOCUMENT IS THE PROPERTY OF TCC. NO PART OF THIS DOCUMENT SHALL BE REPRODUCED OR DISCLOSED TO OTHERS OR USED FOR ANY PURPOSE WHATSOEVER EXCEPT WITH THE PRIOR WRITTEN PERMISSION OF TCC.


OWNER: Middle East Kimiaye Pars Company

DESIGNER	HALDOR TOPSØE A/S	DOCUMENT NAME	MP METHANOL COLUMN OH SYSTEM PIPING AND INSTRUMENT DIAGRAM	JOB NO.	S-02115	REV.	3
DRAWN		DATE	13/11/20	SCALE	42		
CHECKED		DATE					
APPROVED		DATE					
CONTRACTOR DRAWING NO.				MKP-11-AS-5000-PS07-PID-012			
SHEET				01 TOTAL 01			
SUB-CONTRACTOR DRAWING NO.							
SHEET				TOTAL			

PROJECT	MKP Methanol Project
UNIT	Distillation Unit
PHASE	As Built Drawing
OWNER DWG. NO.	MKP-11-AS-5000-PR-PID-012

Counter Signing Sign Date

SCALE:-- SHEET: 1 TOT: 1 SIZE: A1

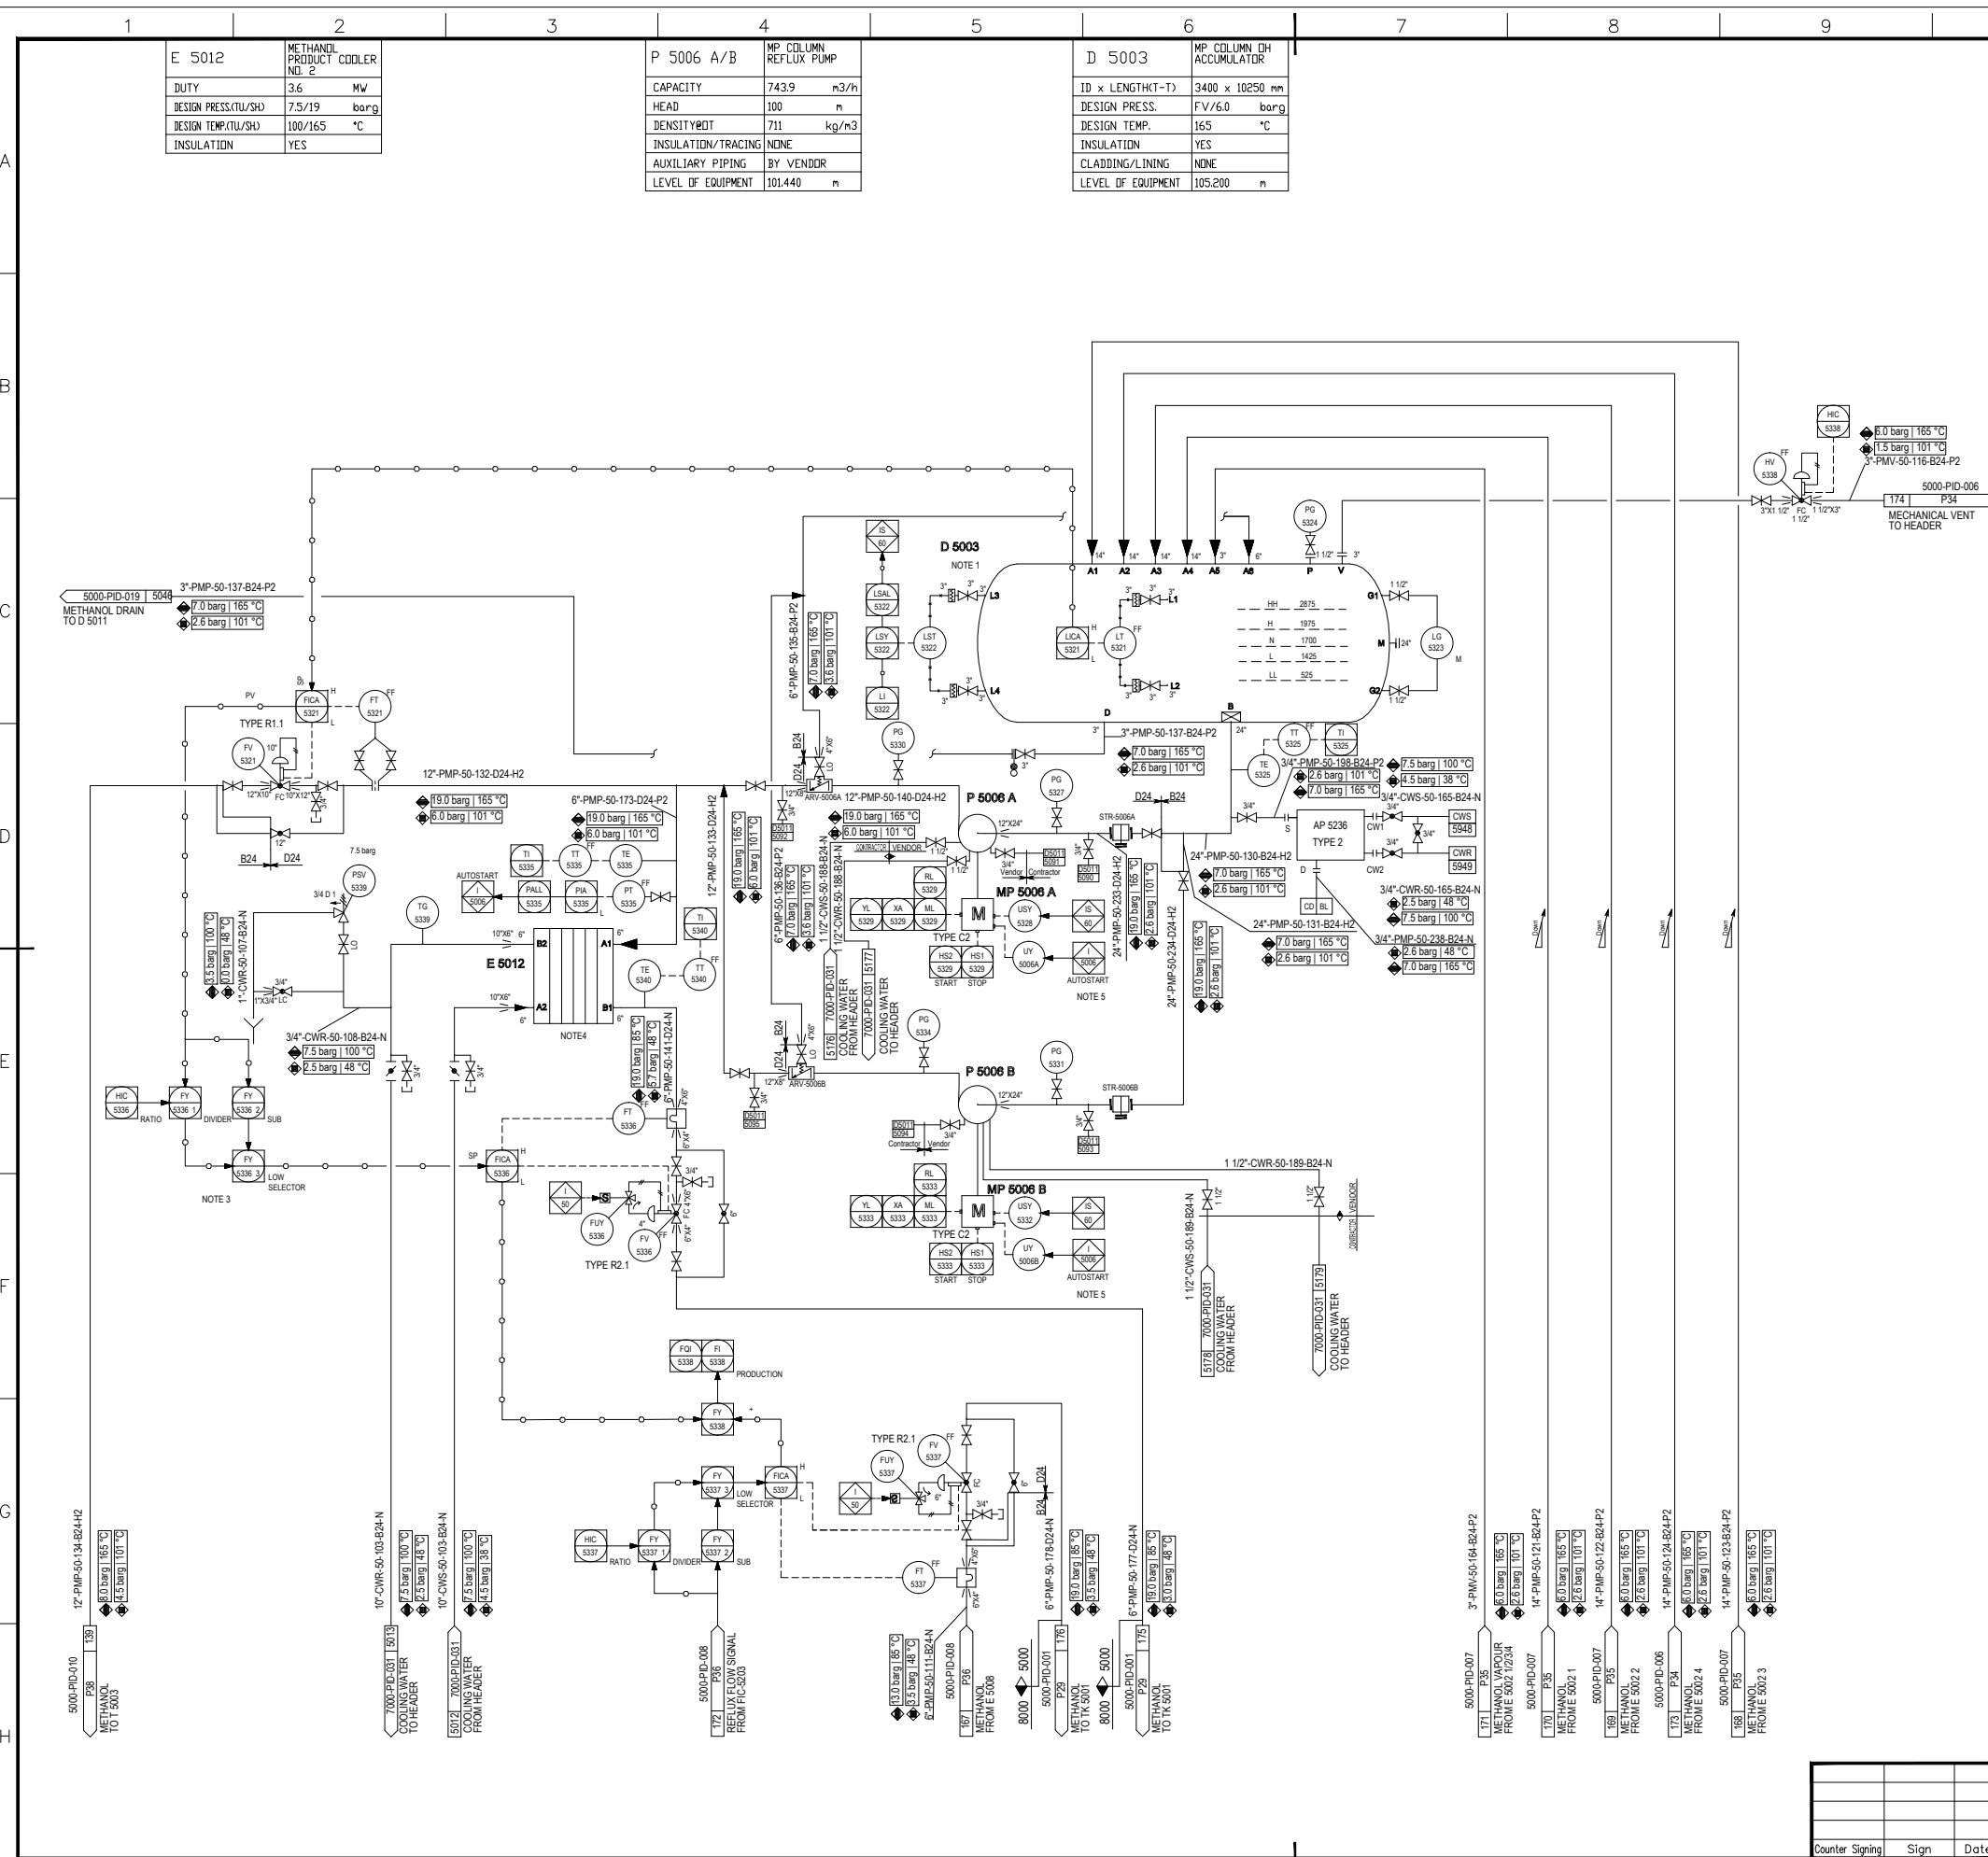

P 5007 A/B	MP COLUMN RECYCLE PUMP
CAPACITY	127 m <sup>3</sup> /h
HEAD	50 m
DENSITY@DT	918 kg/m <sup>3</sup>
INSULATION/TRACING	NONE
AUXILIARY PIPING	BY VENDOR
LEVEL OF EQUIPMENT	101.140 m

P 5010 A/B	EXCESS WATER PUMP
CAPACITY	36.3 m <sup>3</sup> /h
HEAD	570 m
DENSITY@DT	918 kg/m <sup>3</sup>
INSULATION/TRACING	NONE
AUXILIARY PIPING	BY VENDOR
LEVEL OF EQUIPMENT	101.620 m


AE 5006	WASH WATER AIR COOLER
DUTY	0.8 MW
ID x LENGTH(I-T)	BY VENDOR mm
DESIGN PRESS.(TL/SH)	15/NA barg
DESIGN TEMP.(TL/SH)	175/NA °C

E 5007	WASH WATER COOLER
DUTY	0.16 MW
DESIGN PRESS.(TL/SH)	15/7.5 barg
DESIGN TEMP.(TL/SH)	100/120 °C
INSULATION	YES

**GENERAL NOTES**

- NOTES:
- 1) TWS TO BE INSTALLED ON EACH OUTLET HEADER FROM AE 5006.
  - 2) DETAIL AIR COOLER DRAWING IN 5000-PR-026.
  - 3) THE SPARE PUMP WOULD AUTOSTART WHEN THE OUTLET PRESSURE DECREASED.

GENERAL NOTE:  
LOW POINT DRAINS AND HIGH POINT VENT MUST BE ADDED DURING DETAILED ENGINEERING.

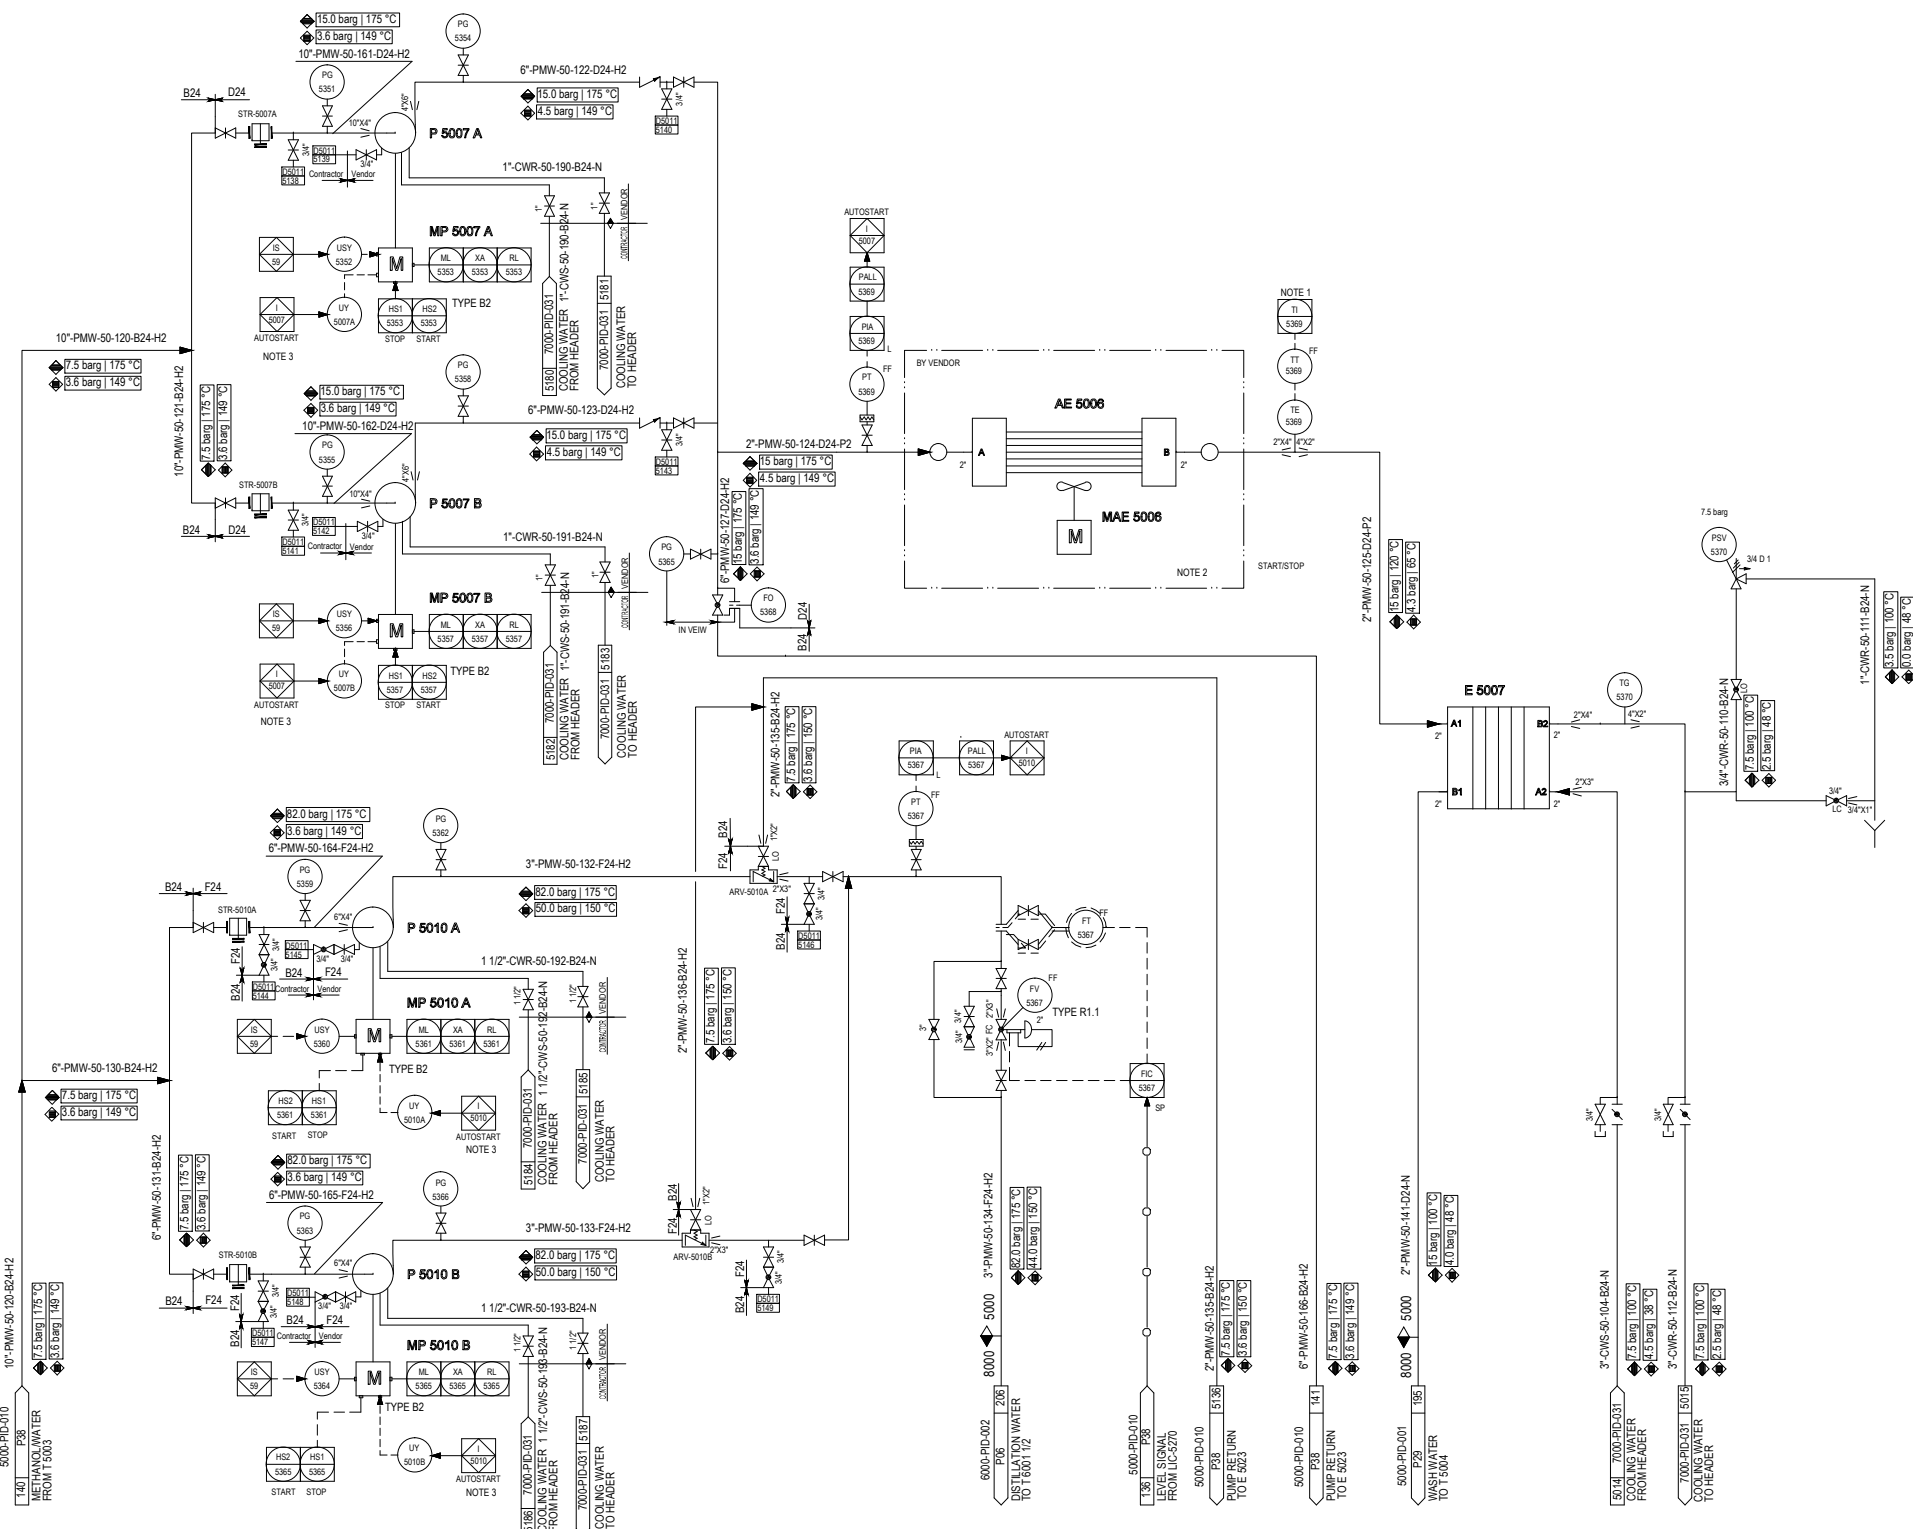

**REFERENCE DRAWINGS**

**SYMBOLS AND LEGENDS**

**KEY PLAN**

REV.	DESCRIPTION	DATE	DESIGN	DRAW	CHECK	REVIEW	APPROVE
▲	As Built	30.04.2020	WangYishu		Mu Yujun	Hu Qiuyi	
▲	Approved for Construction	30.12.2019	WangYishu		Mu Yujun	Hu Qiuyi	
▲	Approved for Construction	08.05.2017	Li Zhijuan		Mu Yujun	Hu Qiuyi	
▲	Approved for Construction	22.03.2017	Li Zhijuan		Mu Yujun	Hu Qiuyi	
▲	Approved for Construction	22.01.2017	Li Zhijuan		Mu Yujun	Hu Qiuyi	
▲	Approved for Construction	28.11.2016	Li Zhijuan		Mu Yujun	Hu Qiuyi	
▲	Issued for Approval	14.10.2016	Li Zhijuan		Mu Yujun	Hu Qiuyi	
▲	Issued for Approval	31.08.2016	Li Zhijuan		Mu Yujun	Hu Qiuyi	
▲	Issued for Approval	05.07.2016	Li Zhijuan		Mu Yujun	Hu Qiuyi	
▲	Issued for Comments	29.04.2016	Li Zhijuan		Mu Yujun	Hu Qiuyi	

THIS DOCUMENT IS THE PROPERTY OF TCC. NO PART OF THIS DOCUMENT SHALL BE REPRODUCED OR DISCLOSED TO OTHERS OR USED FOR ANY PURPOSE WHATSOEVER EXCEPT WITH THE PRIOR WRITTEN PERMISSION OF TCC.

OWNER: **Middle East Kimiaye Pars Company**

DESIGNER	HALDOR TOPSØE A/S	DOCUMENT NAME	MP METHANOL COLUMN BY PRODUCT PIPING AND INSTRUMENT DIAGRAM	JOB NO.	S-02115	CONTRACT NO.	42	REV.	4
DRAWN		DATE	13/4/2015	CHECKED		APPROVED			

CONTRACTOR	<b>TCC 中国天辰工程有限公司</b> CHINA TIANCHEN ENGINEERING CORPORATION	CONTRACTOR DRAWING NO.	MKP-11-AS-5000-PS07-PID-013
		SHEET	01 TOTAL 01
		SUB-CONTRACTOR DRAWING NO.	
		SHEET	TOTAL

PROJECT	MKP Methanol Project
UNIT	Distillation Unit
PHASE	As Built Drawing
OWNER DWG NO.	MKP-11-AS-5000-PR-PID-013

Counter Signing	Sign	Date

X 5001 A/B	PRODUCT POLISHER UNIT
ID x LENGTH-T	3900 x 6400 mm
DESIGN PRESS.	19 barg
DESIGN TEMP.	85 °C
INSULATION	NONE
CATALYST TYPE	AMBERLYST 15 WET

**GENERAL NOTES**

† GENERAL NOTE:  
LOW POINT DRAINS AND HIGH POINT VENT MUST BE ADDED DURING DETAILED ENGINEERING.

**REFERENCE DRAWINGS**


**SYMBOLS AND LEGENDS**

**KEY PLAN**

REV.	DESCRIPTION	DATE	DESIGN	DRAW	CHECK	REVIEW	APPROVE
▲	As Built	30.04.2020	Wang Yishu	Mu Yujun	Hu Qiyi		
▲	Approved for Construction	30.12.2019	Wang Yishu	Mu Yujun	Hu Qiyi		
▲	Approved for Construction	06.11.2017	Wang Yishu	Mu Yujun	Hu Qiyi		
▲	Approved for Construction	08.05.2017	Li Zhijuan	Mu Yujun	Hu Qiyi		
▲	Approved for Construction	22.03.2017	Li Zhijuan	Mu Yujun	Hu Qiyi		
▲	Approved for Construction	28.11.2016	Li Zhijuan	Mu Yujun	Hu Qiyi		
▲	Approved for Construction	14.10.2016	Li Zhijuan	Mu Yujun	Hu Qiyi		
▲	Approved for Construction	31.08.2016	Li Zhijuan	Mu Yujun	Hu Qiyi		
▲	Issued for Review	05.07.2016	Li Zhijuan	Mu Yujun	Hu Qiyi		
▲	Issued for Comments	29.04.2016	Li Zhijuan	Mu Yujun	Hu Qiyi		

THIS DOCUMENT IS THE PROPERTY OF TCC. NO PART OF THIS DOCUMENT SHALL BE REPRODUCED OR DISCLOSED TO OTHERS OR USED FOR ANY PURPOSE WHATSOEVER EXCEPT WITH THE PRIOR WRITTEN PERMISSION OF TCC.


OWNER:



Middle East  
Kimiaye Pars Company


 HALDOR TOPSØE A/S CORPORATE IDENTITY	DOCUMENT NAME:	JOB NO.	CONTRACT NO.	REV.
	METHANOL PRODUCT PIPING AND INSTRUMENT DIAGRAM	S-02115	42	4
 TCC 中国天辰工程有限公司 CHINA TIANCHEN ENGINEERING CORPORATION	CONTRACTOR DRAWING NO.	CONTRACTOR SHEET NO.	TOTAL SHEETS	
	MKP-11-AS-5000-PS07-PID-014	01	01	
	SUB-CONTRACTOR DRAWING NO.			
	SHEET	TOTAL		

METHANOL PRODUCT PIPING AND INSTRUMENT DIAGRAM	PROJECT	MKP Methanol Project
	UNIT	Distillation Unit
	PHASE	As Built Drawing
SCALE:--	OWNER DWG NO.	MKP-11-AS-5000-PR-PID-014

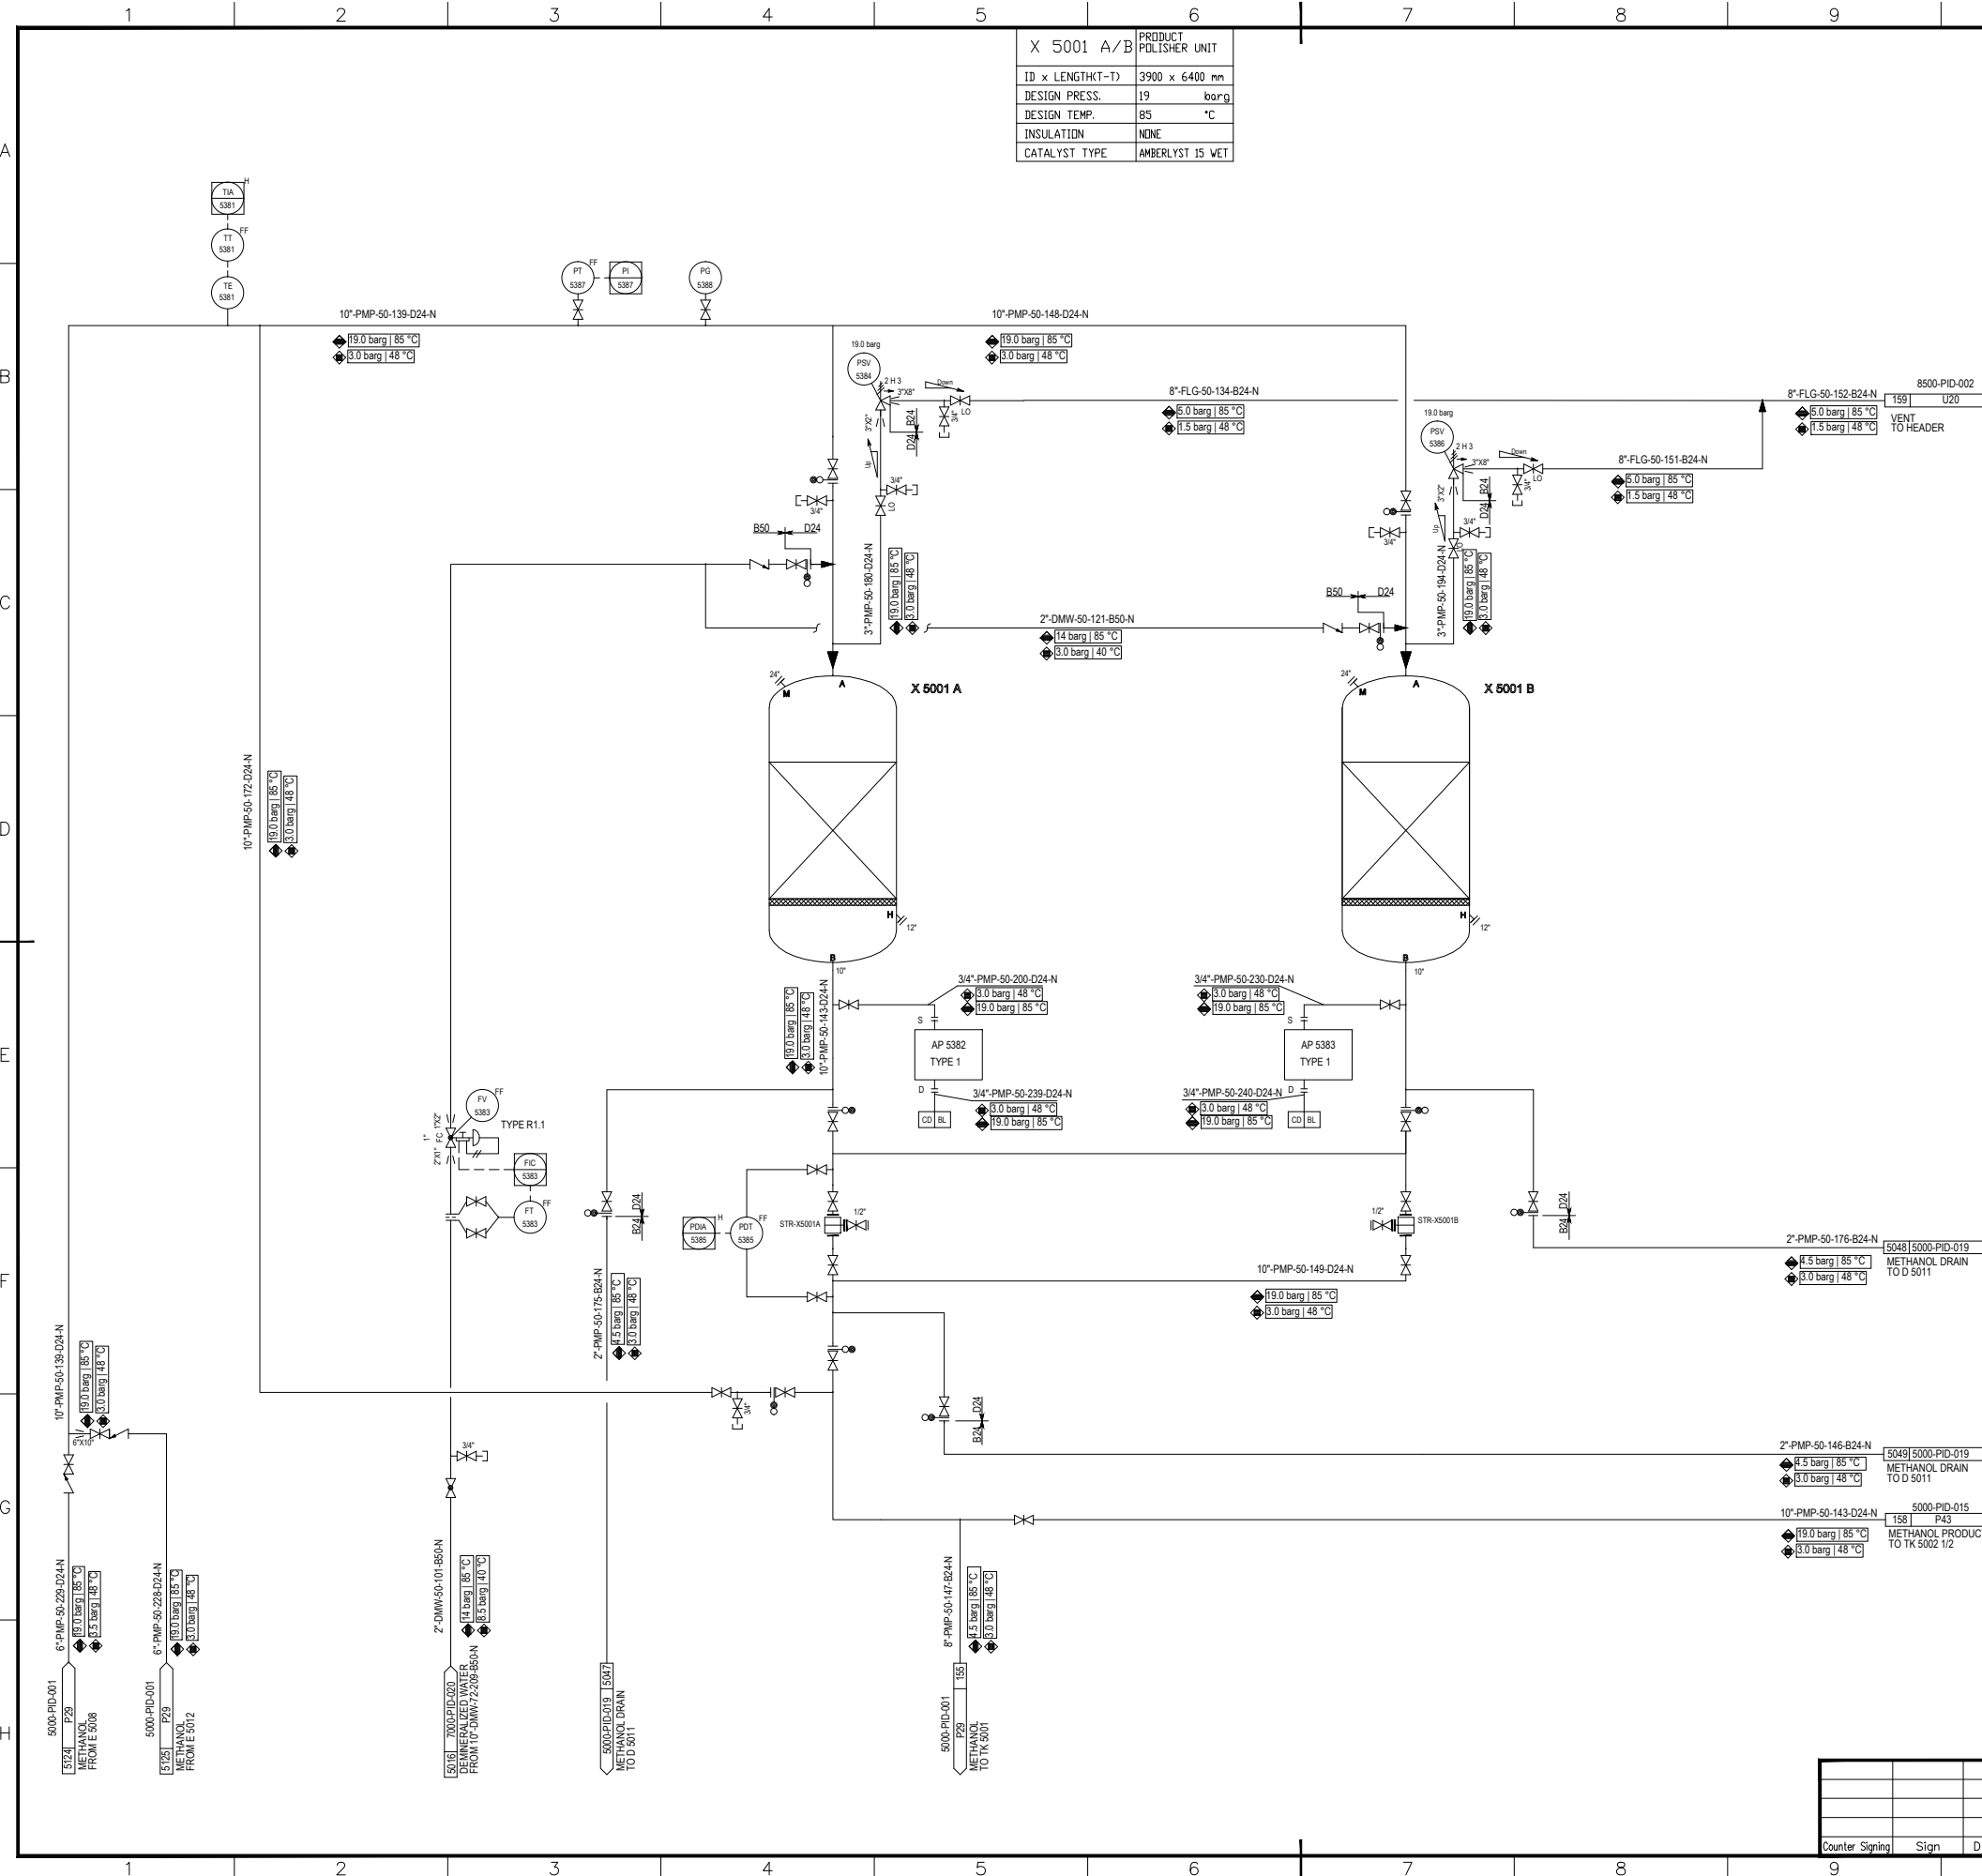

Counter	Sign	Date



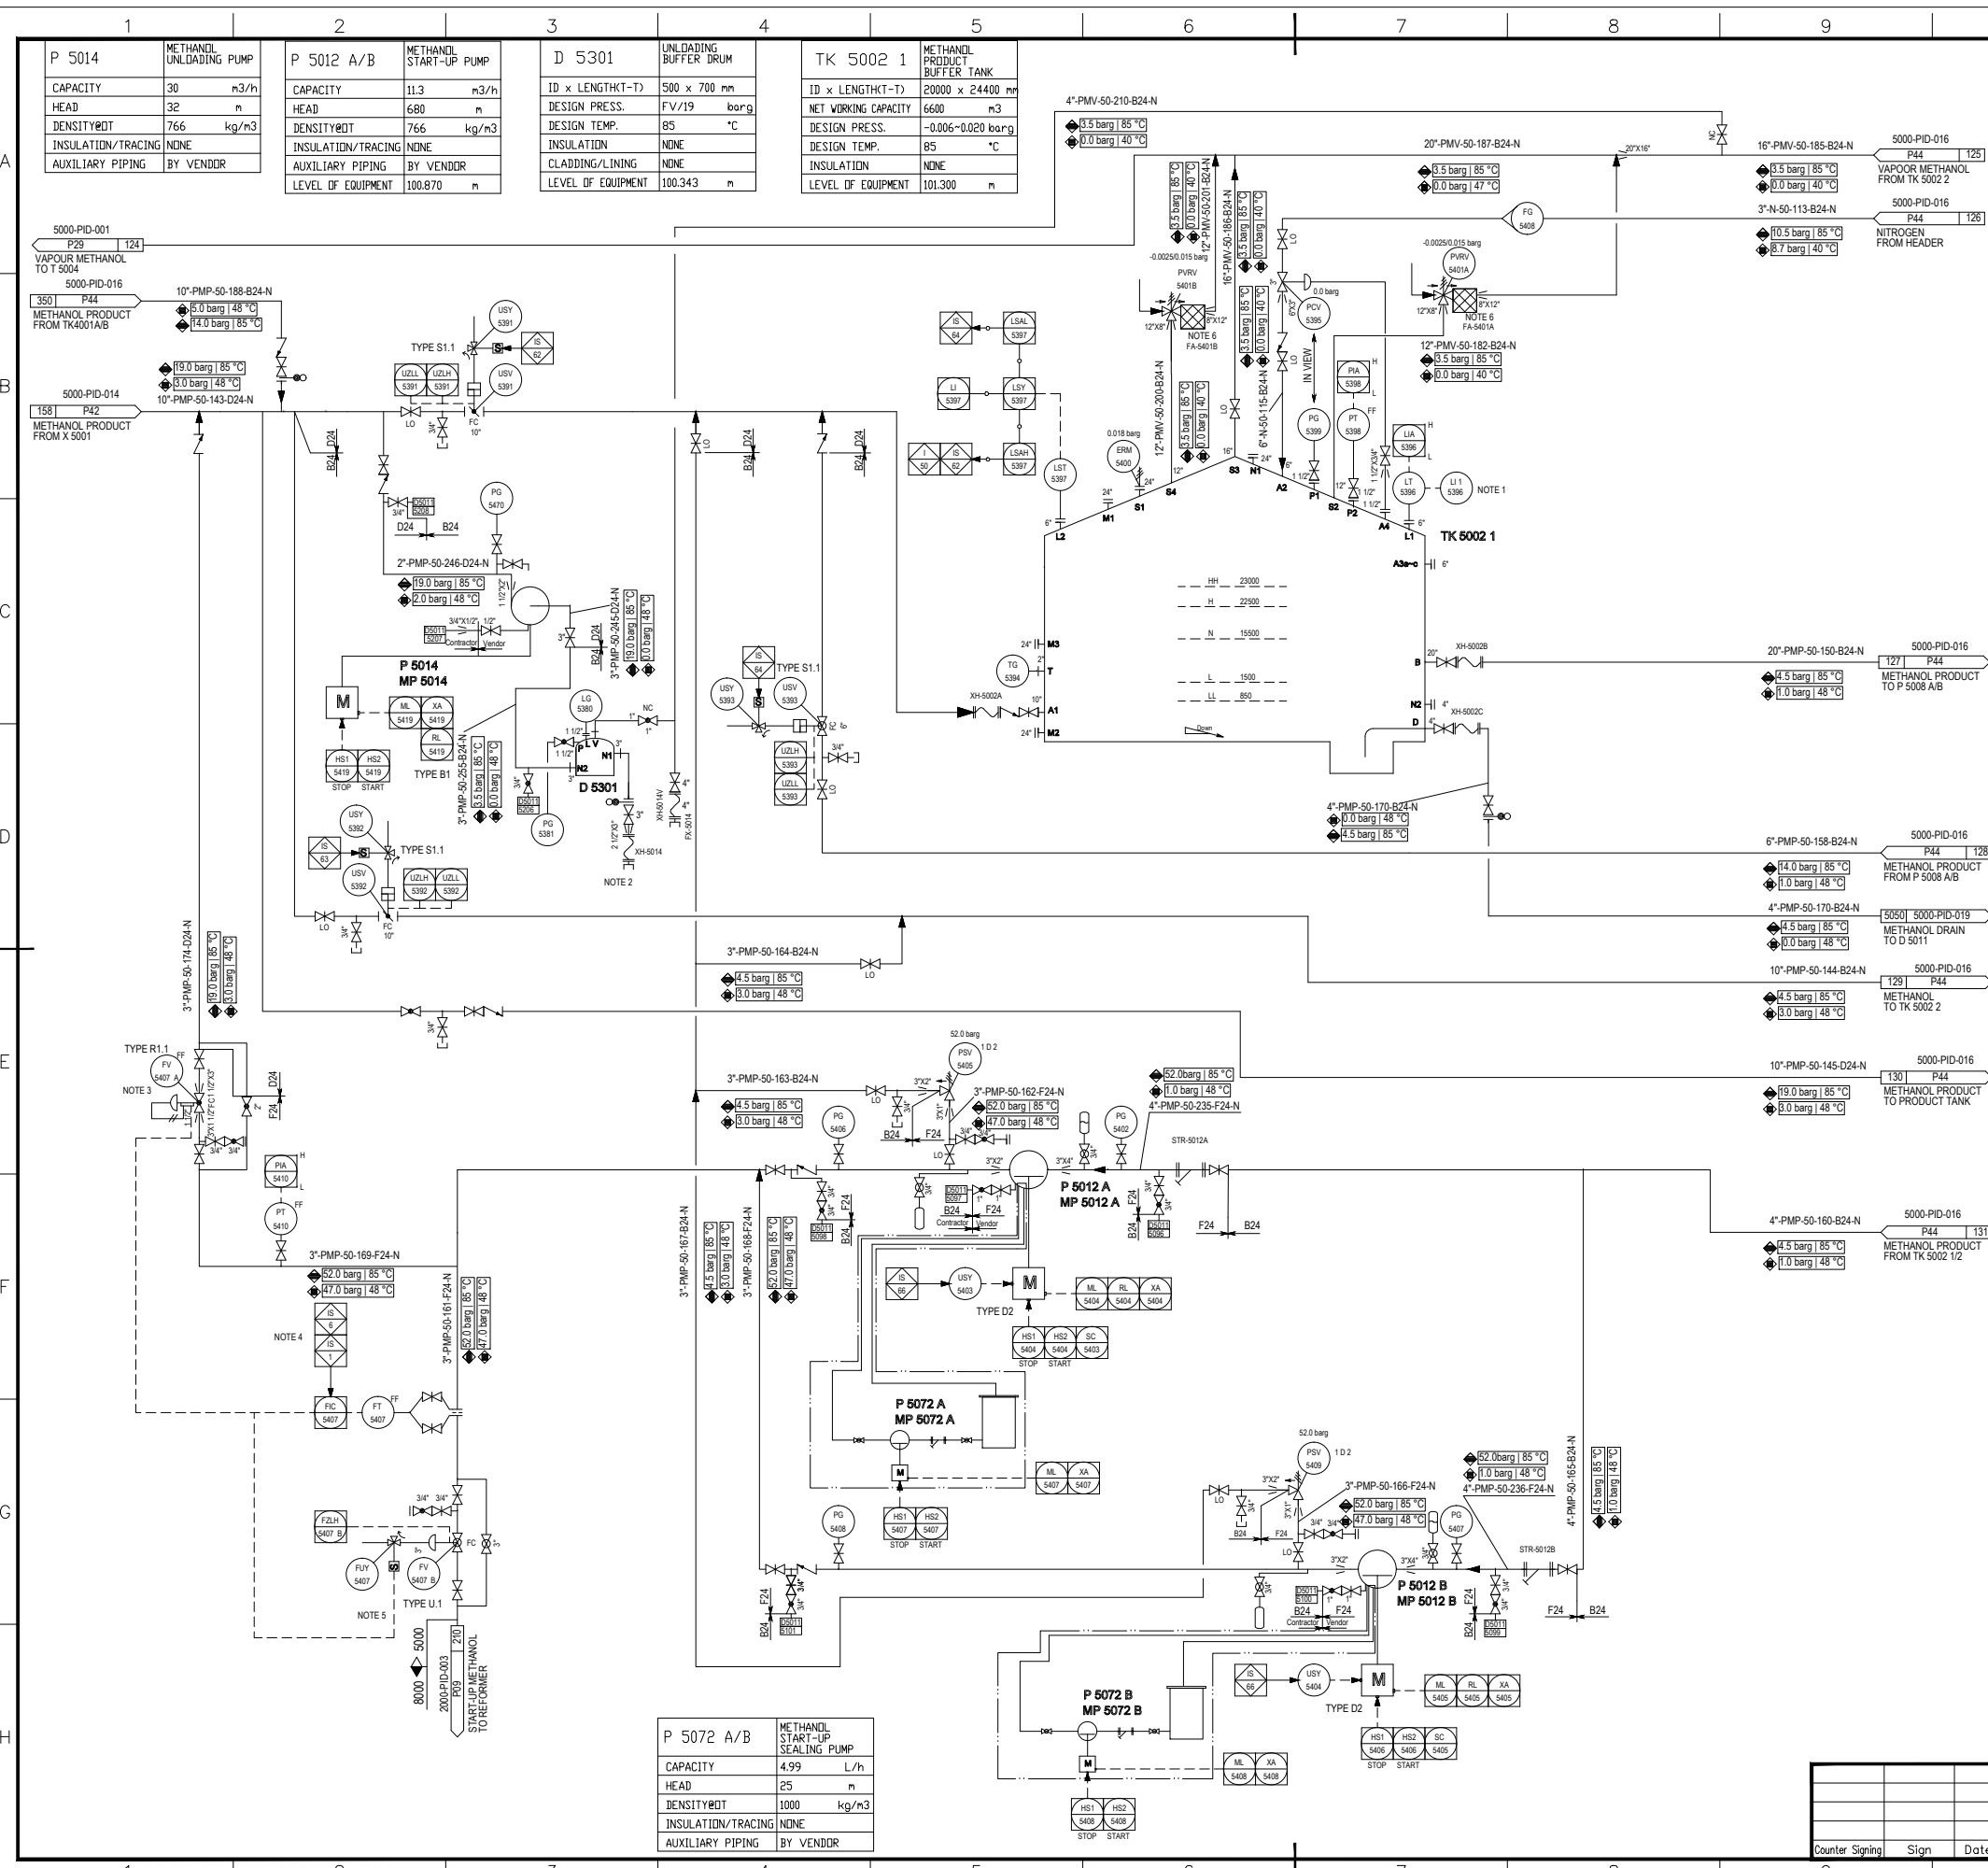

Equipment	Capacity	Head	Density @ 20°C	Insulation/Tracing	Auxiliary Piping
P 5014 METHANOL UNLOADING PUMP	30 m <sup>3</sup> /h	32 m	766 kg/m <sup>3</sup>	NONE	BY VENDOR
P 5012 A/B METHANOL START-UP PUMP	11.3 m <sup>3</sup> /h	680 m	766 kg/m <sup>3</sup>	NONE	BY VENDOR
D 5301 UNLOADING BUFFER DRUM	500 x 700 mm	FV/19 barg	85 °C	NONE	NONE
TK 5002 1 METHANOL PRODUCT BUFFER TANK	20000 x 24400 mm	NET WORKING CAPACITY 6600 m <sup>3</sup>	-0.006-0.020 barg	85 °C	NONE

**GENERAL NOTES**

NOTES:

- 1) AT GRADE.
- 2) FOR FILLING IN METHANOL PRIOR TO INITIAL START-UP.
- 3) OUTPUT OF FIC-5407 IS 100%, WHEN IN MANUAL.
- 4) SUBSEQUENT TO IS-1 THIS SET POINT IS RAMPED DOWN.
- 5) IF OUTPUT FROM FIC-5407 IS BELOW 100%, FV-5407 B IS FULLY OPEN.
- 6) THIS FLAME ARRESTER WILL BE PROVIDED WITH PVRV TOGETHER BY PVRV VENDOR.

GENERAL NOTE:

LOW POINT DRAINS AND HIGH POINT VENT MUST BE ADDED DURING DETAILED ENGINEERING.



Reference Drawing	Description
5000-PID-016	METHANOL PRODUCT TO T 5004
5000-PID-016	VAPOUR METHANOL FROM TK 5002 2
5000-PID-016	NITROGEN FROM HEADER
5000-PID-016	METHANOL PRODUCT TO P 5008 A/B
5000-PID-016	METHANOL PRODUCT FROM P 5008 A/B
5000-PID-016	METHANOL DRAIN TO D 5011
5000-PID-016	METHANOL TO TK 5002 2
5000-PID-016	METHANOL PRODUCT TO PRODUCT TANK
5000-PID-016	METHANOL PRODUCT FROM TK 5002 1/2

Symbol	Legend
(Symbol)	(Description)

REV.	DESCRIPTION	DATE	DESIGN	DRAW	CHECK	REVIEW	APPROVE
▲	As Built	30.04.2020	Wang Yishu	Mu Yujun	Hu Qiyi		
▲	Approved for Construction	30.12.2019	Wang Yishu	Mu Yujun	Hu Qiyi		
▲	Approved for Construction	11.11.2018	Wang Yishu	Mu Yujun	Hu Qiyi		
▲	Approved for Construction	02.02.2018	Wang Yishu	Mu Yujun	Hu Qiyi		
▲	Approved for Construction	06.11.2017	Wang Yishu	Mu Yujun	Hu Qiyi		
▲	Approved for Construction	08.05.2017	Li Zhijuan	Mu Yujun	Hu Qiyi		
▲	Approved for Construction	22.03.2017	Li Zhijuan	Mu Yujun	Hu Qiyi		
▲	Approved for Construction	22.01.2017	Li Zhijuan	Mu Yujun	Hu Qiyi		
▲	Approved for Construction	28.11.2016	Li Zhijuan	Mu Yujun	Hu Qiyi		
▲	Approved for Construction	14.10.2016	Li Zhijuan	Mu Yujun	Hu Qiyi		
▲	Approved for Construction	31.08.2016	Li Zhijuan	Mu Yujun	Hu Qiyi		
▲	Issued for Approval	05.07.2016	Li Zhijuan	Mu Yujun	Hu Qiyi		
▲	Issued for Comments	29.04.2016	Li Zhijuan	Mu Yujun	Hu Qiyi		


OWNER: Middle East Kimiaye Pars Company

DESIGNED BY: HALDOR TOPSØE A/S	DOCUMENT NAME: METHANOL PRODUCT BUFFER TANK I PIPING AND INSTRUMENT DIAGRAM	JOB NO: S-02115	REV: 42
DRAWN BY: 1341753	DATE: P43	CONTRACTOR DRAWING NO. MKP-11-AS-5000-PS07-PID-015	SHEET 01 TOTAL 01
SUB-CONTRACTOR DRAWING NO.		SHEET -- TOTAL --	

METHANOL PRODUCT BUFFER TANK I PIPING AND INSTRUMENT DIAGRAM	PROJECT: MKP Methanol Project
	UNIT: Distillation Unit
	PHASE: As Built Drawing
OWNER DWG NO.:	MKP-11-AS-5000-PR-PID-015

SCALE: -- SHEET: 1 TOT: 1 SIZE: A1

Counter Signing Sign Date

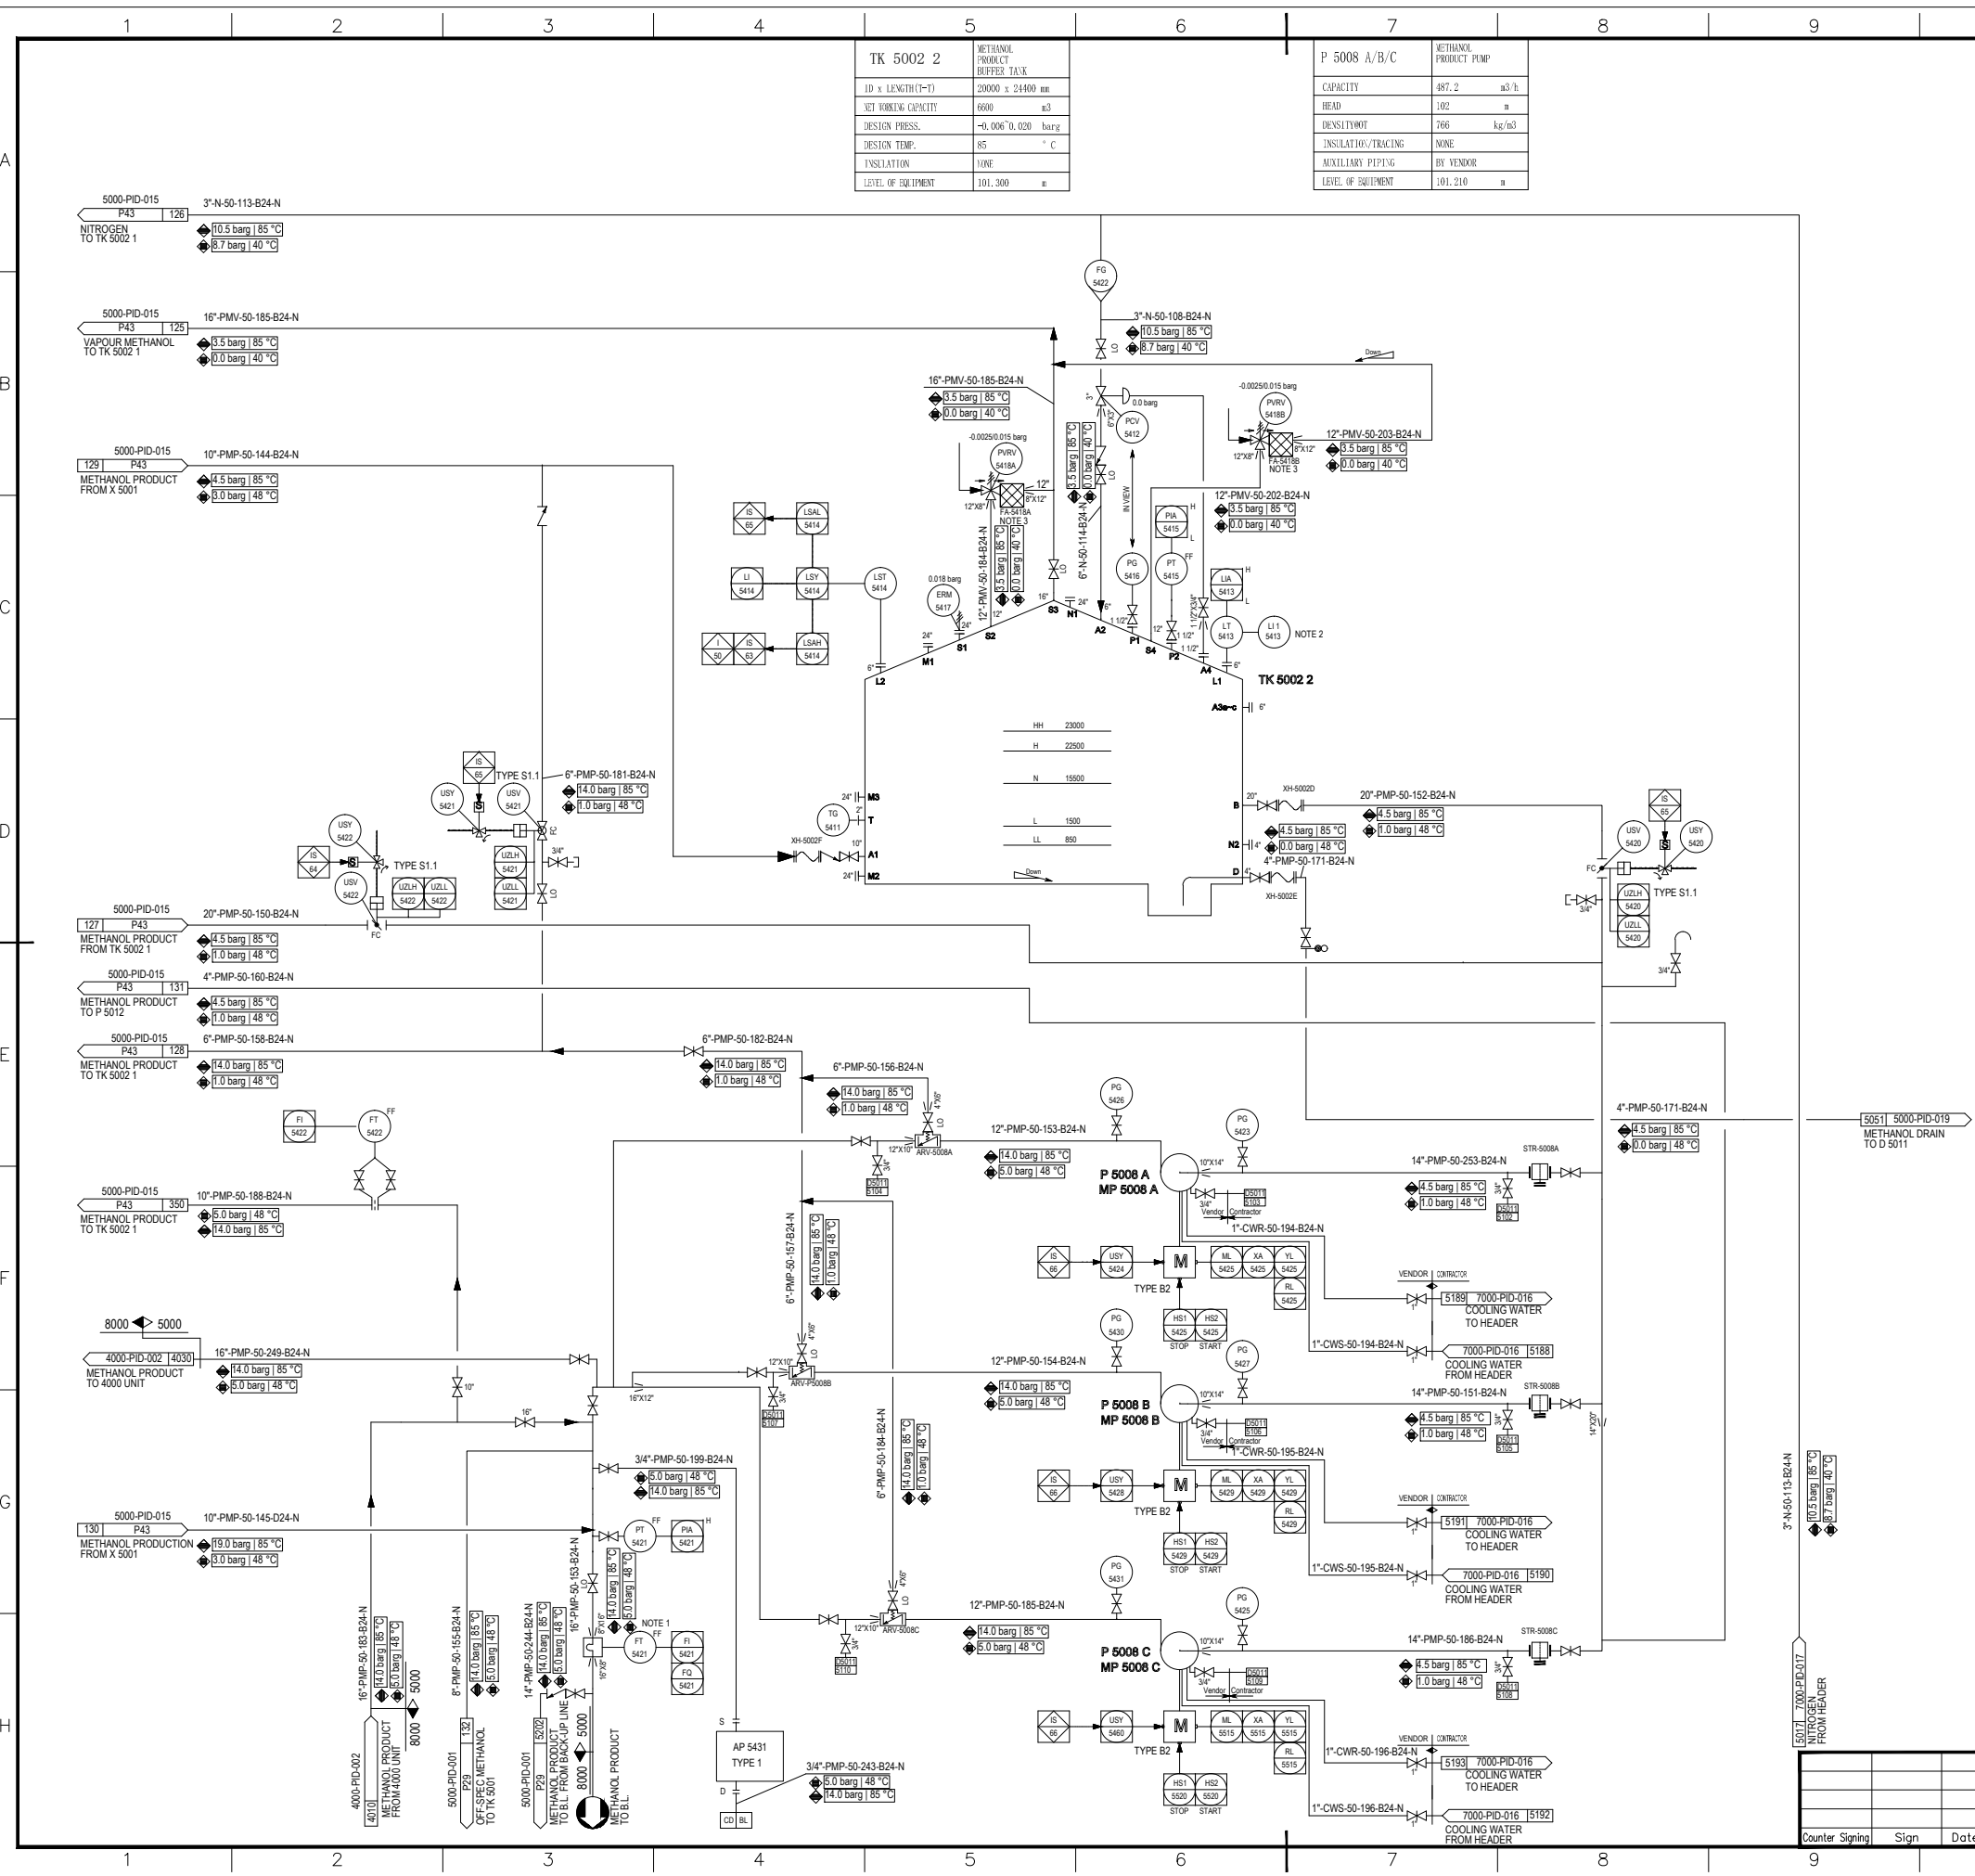

TK 5002 2	METHANOL PRODUCT BUFFER TANK II
ID x LENGTH (mm)	20000 x 24400 mm
SET WORKING CAPACITY	6600 m <sup>3</sup>
DESIGN PRESS.	-0.006 to 0.020 barg
DESIGN TEMP.	85 °C
INSULATION	100E
LEVEL OF EQUIPMENT	101.300 m

P 5008 A/B/C	METHANOL PRODUCT PUMP
CAPACITY	887.2 m <sup>3</sup> /h
HEAD	102 m
DENSITY/WT	766 kg/m <sup>3</sup>
INSULATION/TRACING	NONE
AUXILIARY PIPING	BY VENDOR
LEVEL OF EQUIPMENT	101.210 m

**GENERAL NOTES**

- † NOTES:
- 1) THERMAL PSV ON RUNDOWN LINE MAY BE REQUIRED DEPENDING ON FINAL PIPING LAYOUT.
  - 2) AT GRADE.
  - 3) THIS FLAME ARRESTER WILL BE PROVIDED WITH PVRV TOGETHER BY PVRV VENDOR.
- † GENERAL NOTE:
- LOW POINT DRAINS AND HIGH POINT VENT MUST BE ADDED DURING DETAILED ENGINEERING.

**REFERENCE DRAWINGS**

**SYMBOLS AND LEGENDS**

**KEY PLAN**

REV.	DESCRIPTION	DATE	DESIGN	DRAW	CHECK	REVIEW	APPROVE
▲	As Built	30.04.2020	Wang Yishu		Mu Yujun	Hu Qiyu	
▲	Approved for Construction	30.12.2019	Wang Yishu		Mu Yujun	Hu Qiyu	
▲	Approved for Construction	02.02.2018	Wang Yishu		Mu Yujun	Hu Qiyu	
▲	Approved for Construction	06.11.2018	Wang Yishu		Mu Yujun	Hu Qiyu	
▲	Approved for Construction	22.06.2017	Li Zhijuan		Mu Yujun	Hu Qiyu	
▲	Issued for Approval	08.05.2017	Li Zhijuan		Mu Yujun	Hu Qiyu	
▲	Issued for Approval	22.03.2017	Li Zhijuan		Mu Yujun	Hu Qiyu	
▲	Issued for Approval	22.01.2017	Li Zhijuan		Mu Yujun	Hu Qiyu	
▲	Issued for Approval	28.11.2016	Li Zhijuan		Mu Yujun	Hu Qiyu	
▲	Issued for Approval	14.10.2016	Li Zhijuan		Mu Yujun	Hu Qiyu	
▲	Issued for Approval	31.08.2016	Li Zhijuan		Mu Yujun	Hu Qiyu	
▲	Issued for Approval	05.07.2016	Li Zhijuan		Mu Yujun	Hu Qiyu	
▲	Issued for Comments	29.04.2016	Li Zhijuan		Mu Yujun	Hu Qiyu	

OWNER: **Middle East Kimiaye Pars Company**

CONTRACTOR: **HALDOR TOPSØE A/S**

ENGINEER: **TCC 中国天辰工程技术有限公司**

PROJECT: MKP Methanol Project

UNIT: Distillation Unit

PHASE: As Built Drawing

OWNER DWG NO.: MKP-11-AS-5000-PR-PID-016

SCALE: --	SHEET: 1	TOT.: 1	SIZE: A1
Counter Signing	Sign	Date	

TK 5003	LIQUID OFF-STREAM TANK
ID x LENGTH-T	5000 x 6500 mm
NET WORKING CAPACITY	75 m <sup>3</sup>
DESIGN PRESS.	-0.006-0.020 barg
DESIGN TEMP.	85 °C
INSULATION	NONE
LEVEL OF EQUIPMENT	100.900 m

P 5009 A/B	LIQUID OFF-STREAM PUMP
CAPACITY	4.6 m <sup>3</sup> /h
HEAD	598 m
DENSITY@OT	814 kg/m <sup>3</sup>
INSULATION/TRACING	NONE
AUXILIARY PIPING	BY VENDOR
LEVEL OF EQUIPMENT	100.870 m


P 5071 A/B	LIQUID OFF-STREAM SEALING PUMP
CAPACITY	4.99 L/h
HEAD	25 m
DENSITY@OT	1000 kg/m <sup>3</sup>
INSULATION/TRACING	NONE
AUXILIARY PIPING	BY VENDOR

**GENERAL NOTES**

- †NOTES:
- 1) AT GRADE
  - 2) NOW A BLIND FLANGE IS USED DUE TO DOWNSTREAM ACCEPTANCE PLANT SITUATION IS NOT KNOWN.
  - 3) THIS FLAME ARRESTER WILL BE PROVIDED WITH PVRV TOGETHER BY PVRV VENDOR.
  - 4) THIS VALVE ONLY COULD BE CLOSED WHEN XH-5003B NEEDS TO BE REMOVED.

†GENERAL NOTE:  
LOW POINT DRAINS AND HIGH POINT VENT MUST BE ADDED DURING DETAILED ENGINEERING.

A  
B  
C  
D  
E  
F  
G  
H

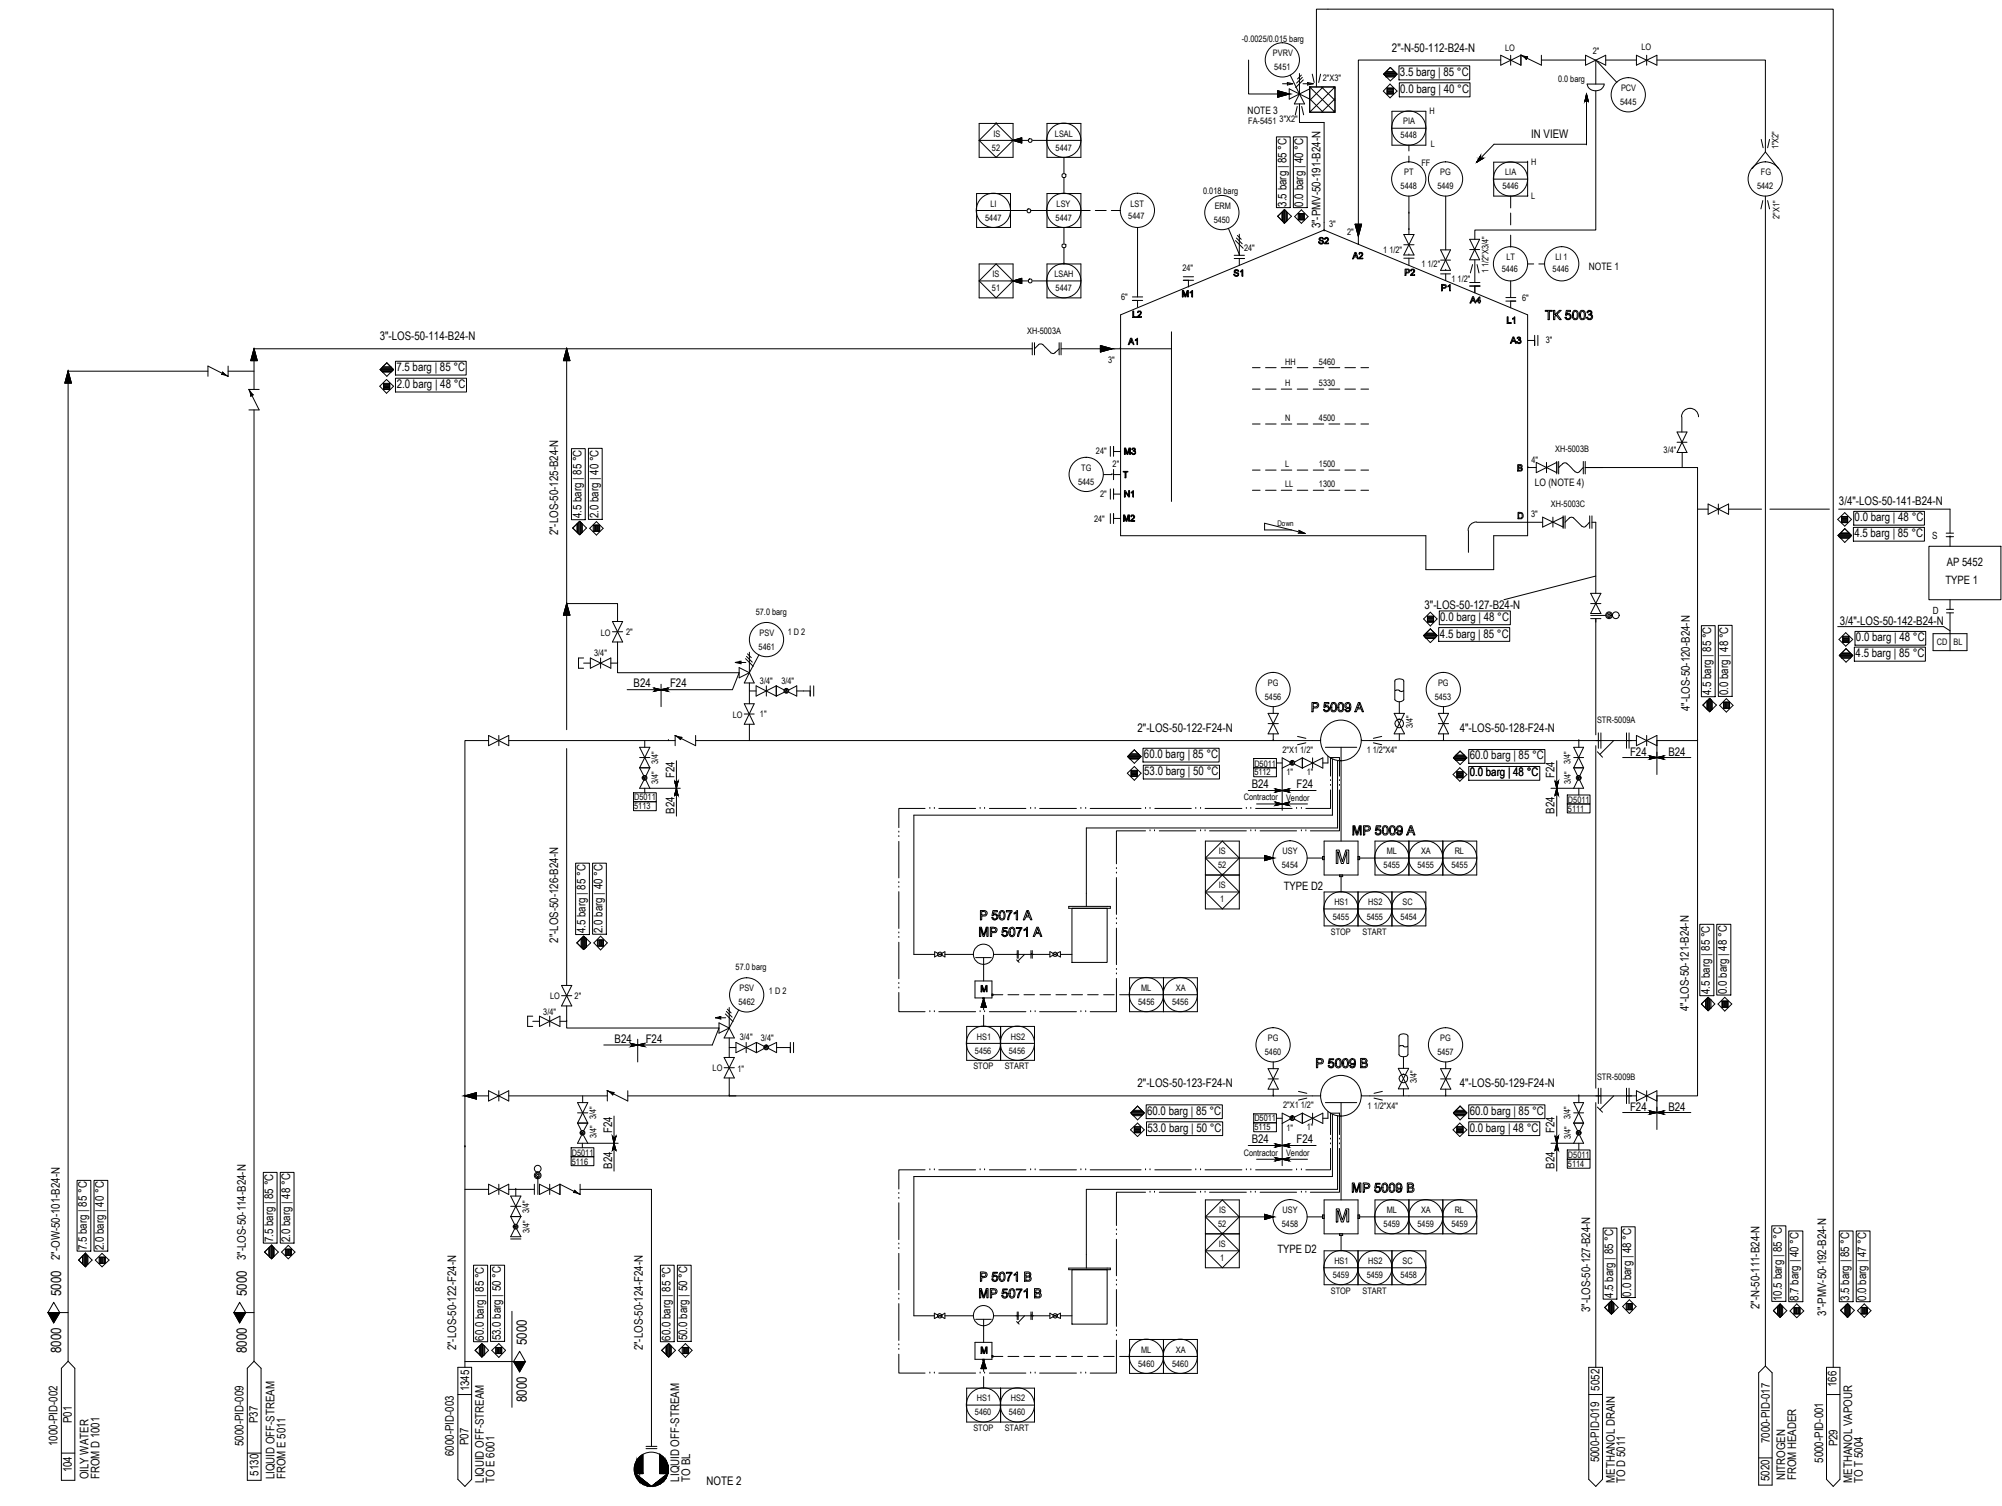

**REFERENCE DRAWINGS**

**SYMBOLS AND LEGENDS**

**KEY PLAN**

REV.	DESCRIPTION	DATE	DESIGN	DRAW	CHECK	REVIEW	APPROVE
▲	As Built	30.04.2020	Wang Yishu		Mu Yujun	Hu Qiuyi	
▲	Approved for Construction	30.12.2019	Wang Yishu		Mu Yujun	Hu Qiuyi	
▲	Approved for Construction	11.11.2018	Wang Yishu		Mu Yujun	Hu Qiuyi	
▲	Approved for Construction	06.11.2017	Wang Yishu		Mu Yujun	Hu Qiuyi	
▲	Approved for Construction	08.05.2017	Li Zhijuan		Mu Yujun	Hu Qiuyi	
▲	Approved for Construction	22.03.2017	Li Zhijuan		Mu Yujun	Hu Qiuyi	
▲	Approved for Construction	22.01.2017	Li Zhijuan		Mu Yujun	Hu Qiuyi	
▲	Approved for Construction	28.11.2016	Li Zhijuan		Mu Yujun	Hu Qiuyi	
▲	Approved for Construction	14.10.2016	Li Zhijuan		Mu Yujun	Hu Qiuyi	
▲	Approved for Construction	31.08.2016	Li Zhijuan		Mu Yujun	Hu Qiuyi	
▲	Issued for Approval	05.07.2016	Li Zhijuan		Mu Yujun	Hu Qiuyi	
▲	Issued for Comments	29.04.2016	Li Zhijuan		Mu Yujun	Hu Qiuyi	

OWNER: **Middle East Kimiaye Pars Company**

CONTRACTOR: **TCC 中国天辰工程有限公司**

CONTRACTOR DRAWING NO. MKP-11-AS-5000-PS07-PID-017


SHEET 01 TOTAL 01

SUB-CONTRACTOR DRAWING NO. SHEET - TOTAL -

PROJECT	MKP Methanol Project
UNIT	Distillation Unit
PHASE	As Built Drawing
OWNER DWG NO.	MKP-11-AS-5000-PR-PID-017

Counter	Sign	Date
---------	------	------

SCALE: --	SHEET: 1	TOT: 1	SIZE: A1
-----------	----------	--------	----------

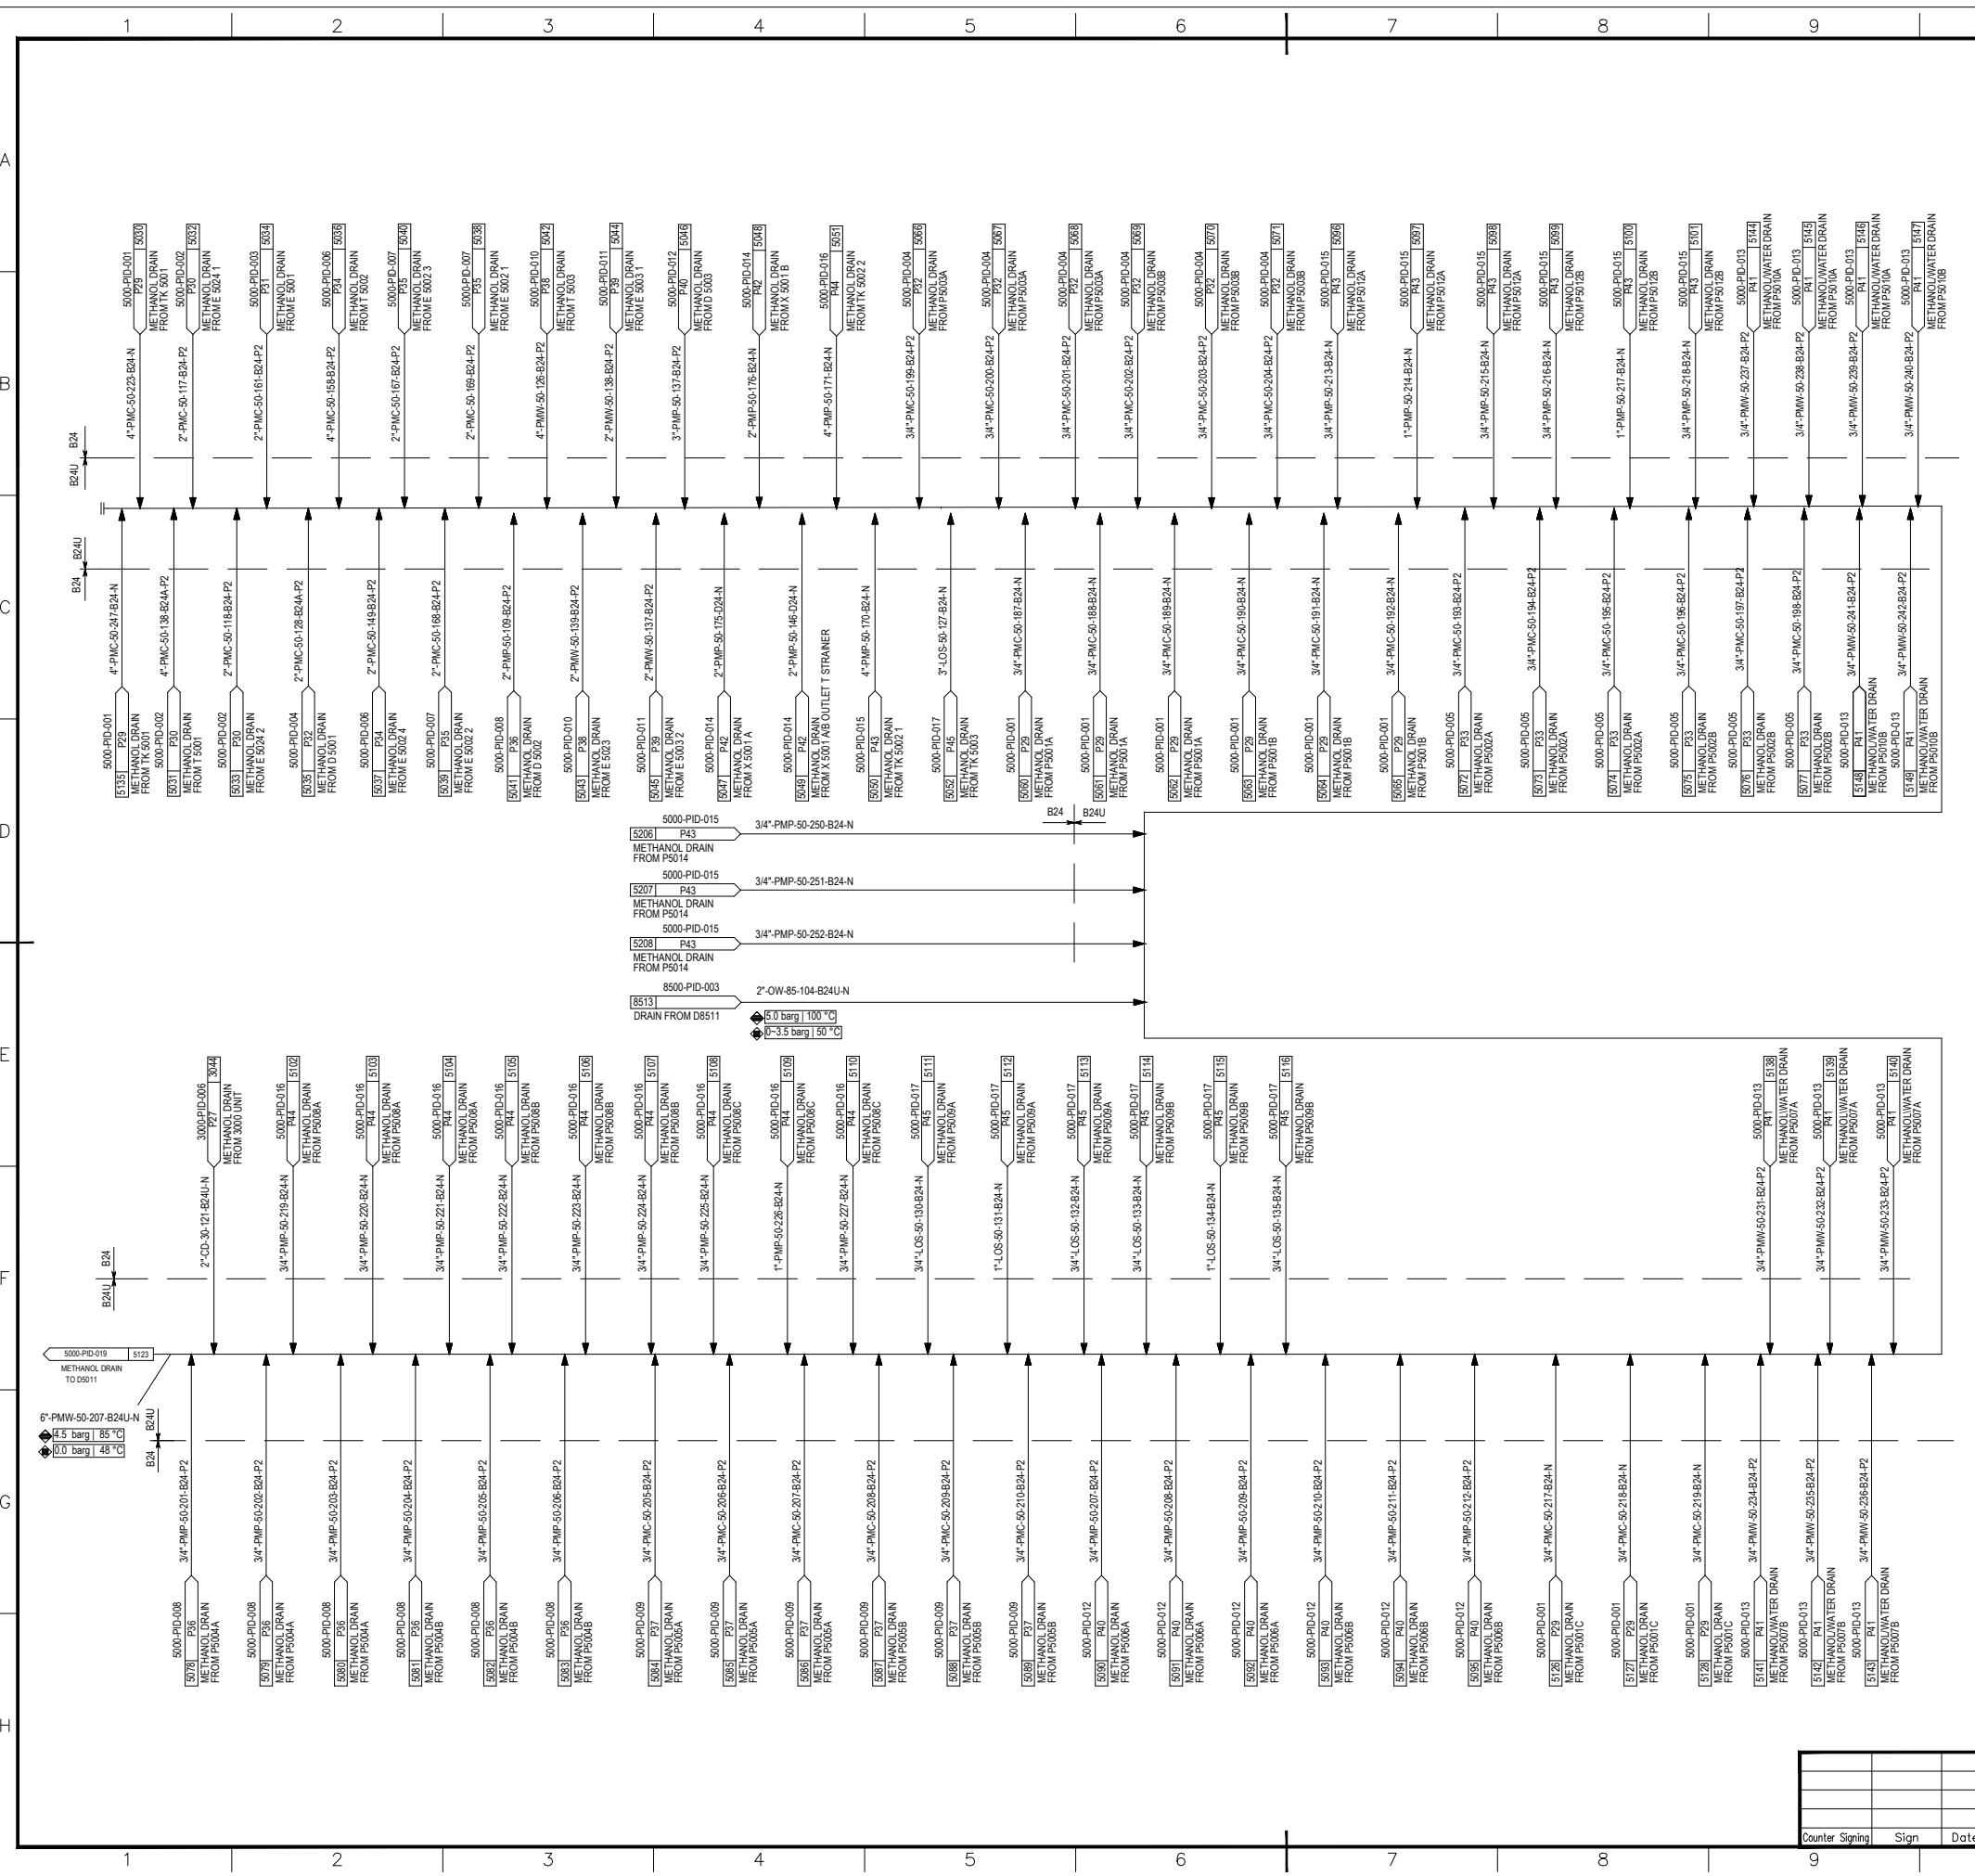

**GENERAL NOTES**

NOTES:  
 1) ALL LOW POINT DRAINS WHICH CONTAIN METHANOL MUST BE CONNECTED TO THE MAIN DRAIN PIPE 6\"/>

**REFERENCE DRAWINGS**

**SYMBOLS AND LEGENDS**

**KEY PLAN**

REV.	DESCRIPTION	DATE	DESIGN	DRAW	CHECK	REVIEW	APPROVE
▲	As Built	30.04.2020	Wang Yishu		Mu Yujun	Hu Qiyi	
▲	Approved for Construction	30.12.2019	Wang Yishu		Mu Yujun	Hu Qiyi	
▲	Approved for Construction	06.11.2017	Li Zhijuan		Mu Yujun	Hu Qiyi	
▲	Approved for Construction	22.03.2017	Li Zhijuan		Mu Yujun	Hu Qiyi	
▲	Approved for Construction	22.01.2017	Li Zhijuan		Mu Yujun	Hu Qiyi	
▲	Approved for Construction	22.01.2017	Li Zhijuan		Mu Yujun	Hu Qiyi	
▲	Approved for Construction	28.11.2016	Li Zhijuan		Mu Yujun	Hu Qiyi	
▲	Approved for Construction	14.10.2016	Li Zhijuan		Mu Yujun	Hu Qiyi	
▲	Approved for Construction	31.08.2016	Li Zhijuan		Mu Yujun	Hu Qiyi	
▲	Issued for Comments	05.07.2016	Li Zhijuan		Mu Yujun	Hu Qiyi	

THIS DOCUMENT IS THE PROPERTY OF TCC. NO PART OF THIS DOCUMENT SHALL BE REPRODUCED OR DISCLOSED TO OTHERS OR USED FOR ANY PURPOSE WHATSOEVER EXCEPT WITH THE PRIOR WRITTEN PERMISSION OF TCC.

OWNER: Middle East Kimiaye Pars Company

<b>TCC</b> 中国天辰工程有限公司 CHINA TIANCHEN ENGINEERING CORPORATION	CONTRACTOR: HALDOR TOPSØE A/S DOCUMENT NAME:	JOB NO.: DRAW NO.:	DATE:	REV.
	CONTRACTOR DRAWING NO. MKP-11-AS-5000-PS07-PID-018		SHEET 01 TOTAL 01	
SUB-CONTRACTOR DRAWING NO.		SHEET -- TOTAL --		

PROJECT: MKP Methanol Project UNIT: Distillation Unit PHASE: As Built Drawing OWNER DWG NO.: MKP-11-AS-5000-PR-PID-018	SCALE: -- SHEET: 1 TOT.: 1 SIZE: A1
---	--

Counter Signing Sign Date



D 5011	CLOSED DRAIN DRUM
ID x LENGTH(T)	1800 x 4000 mm
DESIGN PRESS.	-0.003-3.5 barg
DESIGN TEMP.	150 °C
INSULATION	NONE
CLADDING/LINING	NONE
LEVEL OF EQUIPMENT	96.300 m

P 5013	CLOSED DRAIN DRUM PUMP
CAPACITY	12 m <sup>3</sup> /h
HEAD	33 m
DENSITY@QT	750-1000 kg/m <sup>3</sup>
INSULATION/TRACING	NONE
AUXILIARY PIPING	BY VENDOR

**GENERAL NOTES**

- NOTES:
- 1) ALL LOW POINT DRAINS WHICH CONTAIN METHANOL MUST BE CONNECTED TO THE MAIN DRAIN PIPE 6" PMW-150-201-B24-N AND COLLECTED IN THE CLOSED DRAIN DRUM D 5011.
  - 2) THE DISTANCE BETWEEN PCV-S701 AND THE TOP SURFACE OF GROUND OF INSTALLATION POSITION OF D 5011 SHALL BE LESS THAN 1.5 M.
  - 3) THIS FLAME ARRESTER WILL BE PROVIDED WITH PVRV TOGETHER BY PVRV VENDOR.

**REFERENCE DRAWINGS**

**SYMBOLS AND LEGENDS**

**KEY PLAN**

REV.	DESCRIPTION	DATE	DESIGN	DRAW	CHECK	REVIEW	APPROVE
▲	As Built	30.04.2020	Wang Yishu		Mu Yujun	Hu Qiyi	
▲	Approved for Construction	30.12.2019	Wang Yishu		Mu Yujun	Hu Qiyi	
▲	Approved for Construction	02.01.2018	Wang Yishu		Mu Yujun	Hu Qiyi	
▲	Approved for Construction	06.11.2017	Wang Yishu		Mu Yujun	Hu Qiyi	
▲	Approved for Construction	08.05.2017	Li Zhijuan		Mu Yujun	Hu Qiyi	
▲	Approved for Construction	22.03.2017	Li Zhijuan		Mu Yujun	Hu Qiyi	
▲	Approved for Construction	22.01.2017	Li Zhijuan		Mu Yujun	Hu Qiyi	
▲	Issued for Approval	28.11.2016	Li Zhijuan		Mu Yujun	Hu Qiyi	
▲	Issued for Approval	14.10.2016	Li Zhijuan		Mu Yujun	Hu Qiyi	
▲	Issued for Approval	31.08.2016	Li Zhijuan		Mu Yujun	Hu Qiyi	
▲	Issued for Review	05.07.2016	Li Zhijuan		Mu Yujun	Hu Qiyi	
▲	Issued for Comments	29.04.2016	Li Zhijuan		Mu Yujun	Hu Qiyi	

THIS DOCUMENT IS THE PROPERTY OF TCC. NO PART OF THIS DOCUMENT SHALL BE REPRODUCED OR DISCLOSED TO OTHERS OR USED FOR ANY PURPOSE WHATSOEVER EXCEPT WITH THE PRIOR WRITTEN PERMISSION OF TCC.


OWNER:



Middle East  
Kimiaye Pars Company

DESIGNER	HALDOR TOPSØE A/S	DOCUMENT NAME		JOB NO.		DATE		REV.	
CONTRACTOR	<b>TCC</b> 中国天辰工程有限公司 CHINA TIANCHEN ENGINEERING CORPORATION	CONTRACTOR DRAWING NO.	MKP-11-AS-5000-PS07-PID-019	SHEET	01	TOTAL	01		
SUB-CONTRACTOR		SUB-CONTRACTOR DRAWING NO.		SHEET		TOTAL			

PROJECT	MKP Methanol Project
UNIT	Distillation Unit
PHASE	As Built Drawing
OWNER DWG NO.	MKP-11-AS-5000-PR-PID-019

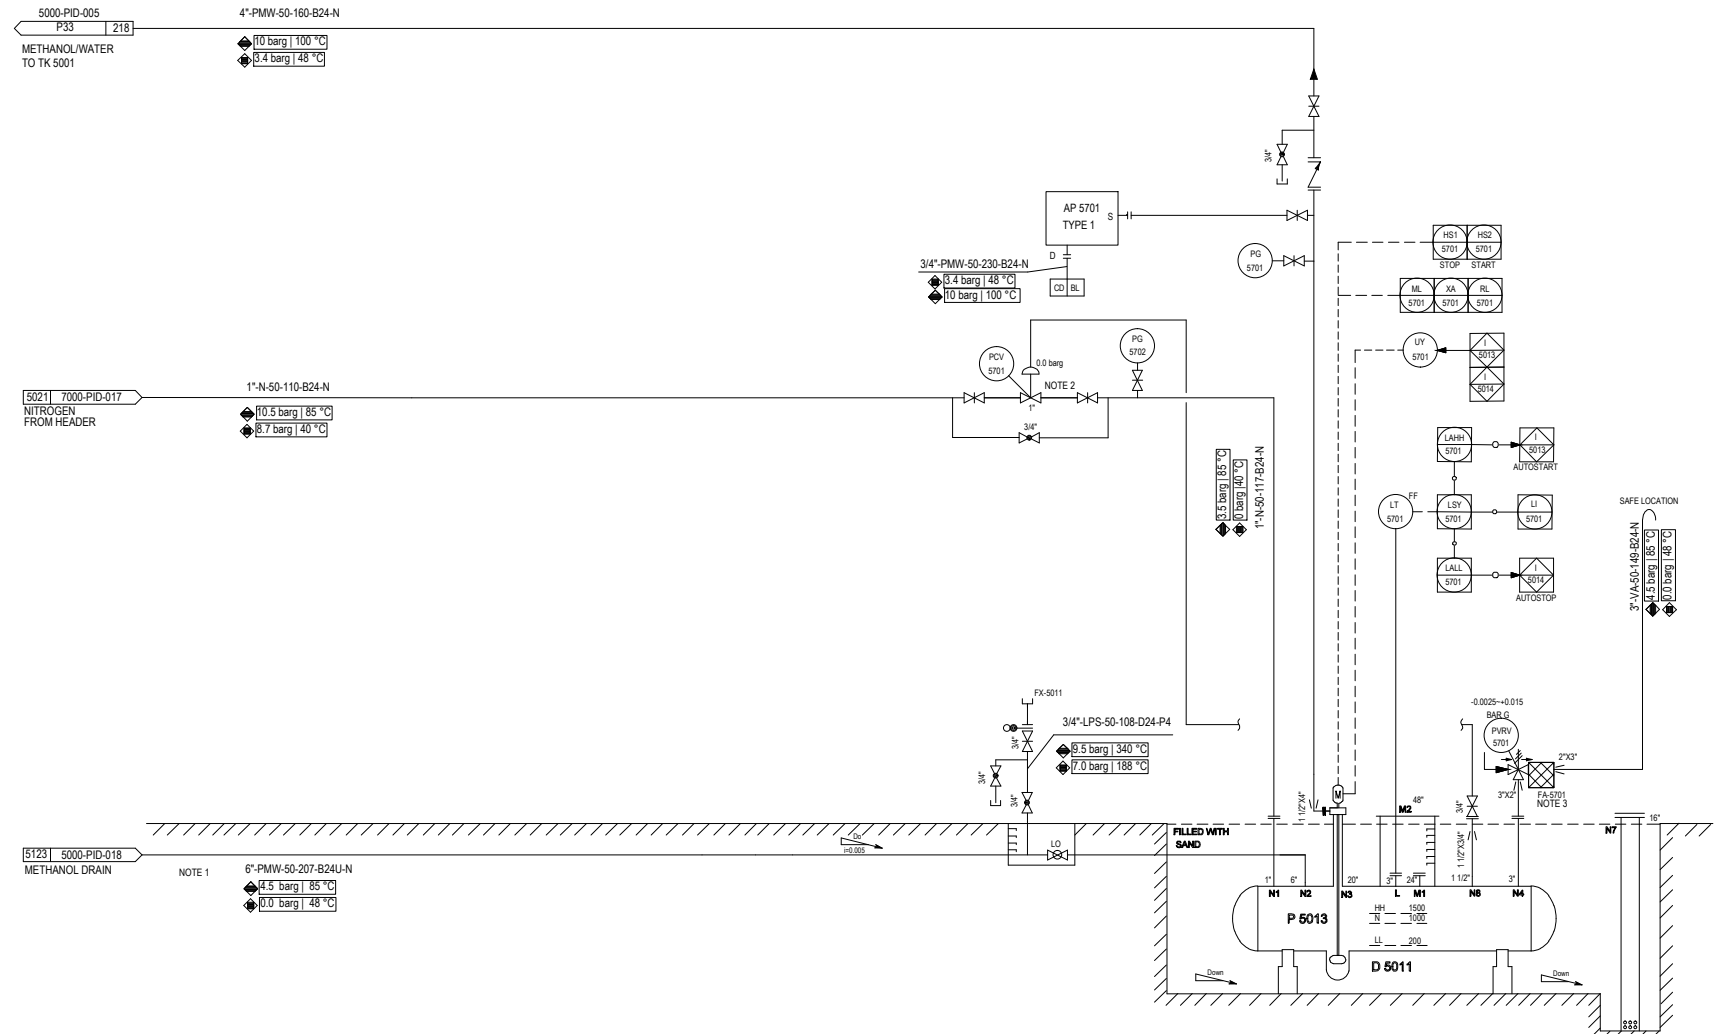

Counter	Sign	Date	SCALE: --	SHEET: 1	TOT.: 1	SIZE: A1
---------	------	------	-----------	----------	---------	----------

X 5003	NaOH DOSING UNIT
INCLUDED	TK 5050
INCLUDED	P 5070 A/B

TK 5050	NaOH TANK
ID x LENGTH(T)	1800 x 2100 mm
NET WORKING CAPACITY	4.4 m <sup>3</sup>
DESIGN PRESS.	ATM barg
DESIGN TEMP.	85 °C
INSULATION	NONE

P 5070 A/B	NaOH SOLUTION DOSING PUMP
CAPACITY	60 L/h
HEAD	50 m
DENSITY@DT	1220 kg/m <sup>3</sup>
INSULATION/TRACING	NONE
AUXILIARY PIPING	BY VENDOR

**GENERAL NOTES**

- NOTES:**
- 1) CALIBRATION POTS FOR METERING SHALL BE PROVIDED BY PUMP VENDOR.
  - 2) PUMP VENDOR TO SPECIFY PSV
  - 3) DRAIN FROM DOSING SYSTEMS INTO CLOSED DRUMS.

**GENERAL NOTE:**

LOW POINT DRAINS AND HIGH POINT VENT MUST BE ADDED DURING DETAILED ENGINEERING.


**REFERENCE DRAWINGS**

**SYMBOLS AND LEGENDS**

**KEY PLAN**


REV.	DESCRIPTION	DATE	DESIGN	DRAW	CHECK	REVIEW	APPROVE
▲	As Built	30.04.2020	Wang Yishu	Mu Yujun	Hu Qiyi		
▲	Approved for Construction	30.12.2019	Wang Yishu	Mu Yujun	Hu Qiyi		
▲	Approved for Construction	11.11.2018	Wang Yishu	Mu Yujun	Hu Qiyi		
▲	Approved for Construction	06.11.2017	Wang Yishu	Mu Yujun	Hu Qiyi		
▲	Approved for Construction	08.05.2017	Li Zhijuan	Mu Yujun	Hu Qiyi		
▲	Approved for Construction	22.03.2017	Li Zhijuan	Mu Yujun	Hu Qiyi		
▲	Approved for Construction	22.01.2017	Li Zhijuan	Mu Yujun	Hu Qiyi		
▲	Approved for Construction	14.10.2016	Li Zhijuan	Mu Yujun	Hu Qiyi		
▲	Issued for Approval	31.08.2016	Li Zhijuan	Mu Yujun	Hu Qiyi		
▲	Issued for Approval	05.07.2016	Li Zhijuan	Mu Yujun	Hu Qiyi		
▲	Issued for Comments	29.04.2016	Li Zhijuan	Mu Yujun	Hu Qiyi		

THIS DOCUMENT IS THE PROPERTY OF TCC. NO PART OF THIS DOCUMENT SHALL BE REPRODUCED OR DISCLOSED TO OTHERS OR USED FOR ANY PURPOSE WHATSOEVER EXCEPT WITH THE PRIOR WRITTEN PERMISSION OF TCC.

OWNER:  Middle East Kimiaye Pars Company

DESIGNER	HALDOR TOPSØE A/S	DOCUMENT NAME	NaOH DOSING UNIT X 5003 UTILITY DIAGRAM	JOB NO.	S-02115	CDR	42	REV.	1
CONTRACTOR	TCC 中国天辰工程有限公司	CONTRACTOR DRAWING NO.	MKP-11-AS-5000-PS09-PID-001	DWG NO.	1353322	SHAWAB	U24		
SUB-CONTRACTOR		SUB-CONTRACTOR DRAWING NO.							
				SHEET	01	TOTAL	01		
				SHEET	--	TOTAL	--		

PROJECT	MKP Methanol Project
UNIT	Distillation Unit
PHASE	As Built Drawing
OWNER DWG NO.	MKP-11-AS-5000-PR-PID-020

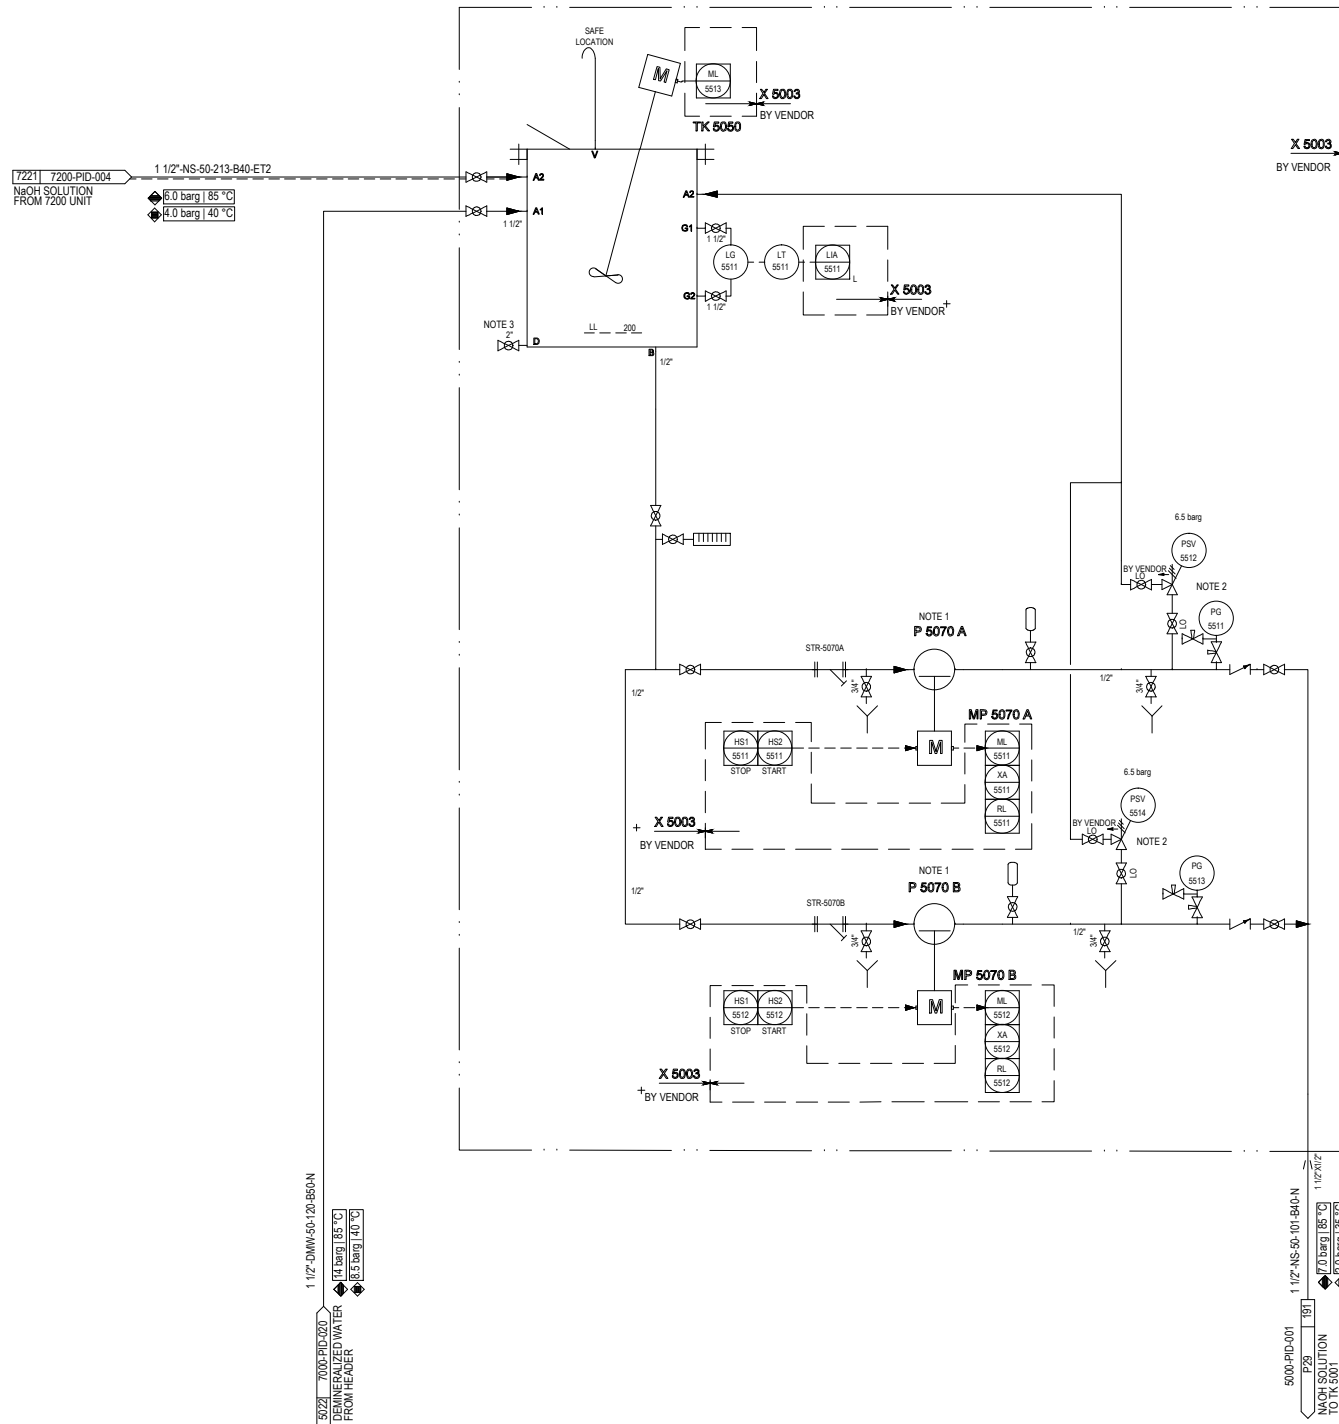

Counter	Sign	Date


SCALE: --	SHEET: 1	TOT.: 1	SIZE: A1
-----------	----------	---------	----------

MOTOR POSITION

AB	AD	AF	AH	AJ	AL	AN	AP	AR	AT	AV
AA	AC	AE	AG	AI	AK	AM	AO	AQ	AS	AU
BB	BD	BF	BH	BJ	BL	BN	BP	BR	BT	BV
BA	BC	BE	BG	BI	BK	BM	BO	BQ	BS	BU
PART 1					PART 2					
PART 3					PART 4					
CB	CD	CF	CH	CJ	CL	CN	CP	CR	CT	CV
CA	CC	CE	CG	CI	CK	CM	CO	CQ	CS	CU
DB	DD	DF	DH	DJ	DL	DN	DP	DR	DT	DV
DA	DC	DE	DG	DI	DK	DM	DO	DQ	DS	DU

L 5003	CRANE 5003
TYPE	CANTILEVER CRANE
CAPACITY	1 t
LIFT HEIGHT	12 m
SLIDING DISTANCE	1.8 m


AE 5005	LP COLUMN DH CONDENSER
DUTY	127.7 MW
ID x LENGTH(T)	BY VENDOR mm
DESIGN PRESS(TU/SH)	(F.V/3.5)/NA bar(g)
DESIGN TEMP(TU/SH)	150/NA °C

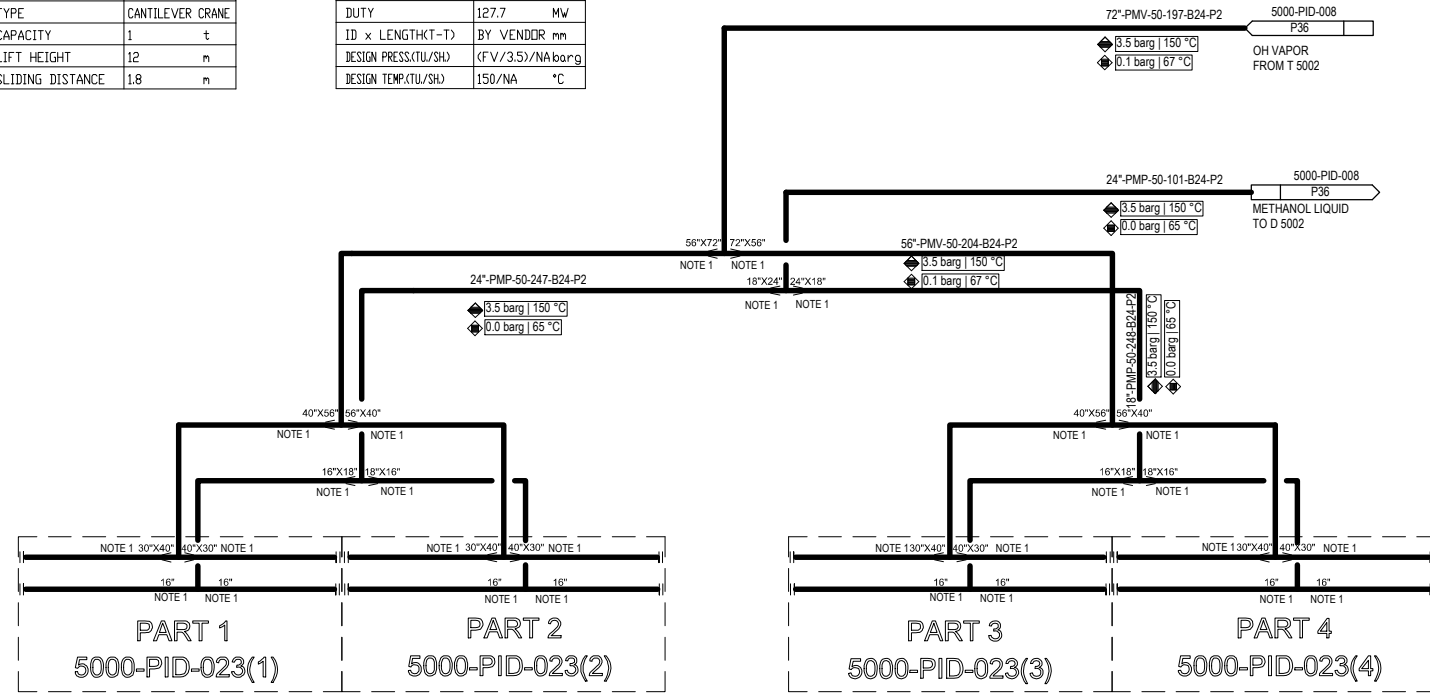

GENERAL NOTES

- NOTES:
- 1) SYMMETRICAL PIPING.
  - 2) THERMOWELL LABEL IS SHOWN BELOW:
- |              |              |           |           |
|--------------|--------------|-----------|-----------|
| MAE5005AA    | MAE5005AB    | MAE5005BA | MAE5005BB |
| 1-B1 TW5101  | 2-B1 TW5145  |           |           |
| 1-B3 TW5103  | 2-B3 TW5147  |           |           |
| MAE5005AC    | MAE5005AD    | MAE5005BC | MAE5005BD |
| 1-B5 TW5105  | 2-B5 TW5149  |           |           |
| 1-B7 TW5107  | 2-B7 TW5151  |           |           |
| MAE5005AE    | MAE5005AF    | MAE5005BE | MAE5005BF |
| 1-B9 TW5109  | 2-B9 TW5153  |           |           |
| 1-B11 TW5111 | 2-B11 TW5155 |           |           |
| MAE5005AG    | MAE5005AH    | MAE5005BG | MAE5005BH |
| 1-B13 TW5113 | 2-B13 TW5157 |           |           |
| 1-B15 TW5115 | 2-B15 TW5159 |           |           |
| MAE5005AJ    | MAE5005AK    | MAE5005BJ |           |
| 1-B17 TW5117 | 2-B17 TW5161 |           |           |
| 1-B19 TW5119 | 2-B19 TW5163 |           |           |
| MAE5005AL    | MAE5005AM    | MAE5005BL |           |
| 1-B21 TW5121 | 2-B21 TW5165 |           |           |
- 3) CRANE IS USED FOR AE 5005 MAINTENANCE.

PART 1

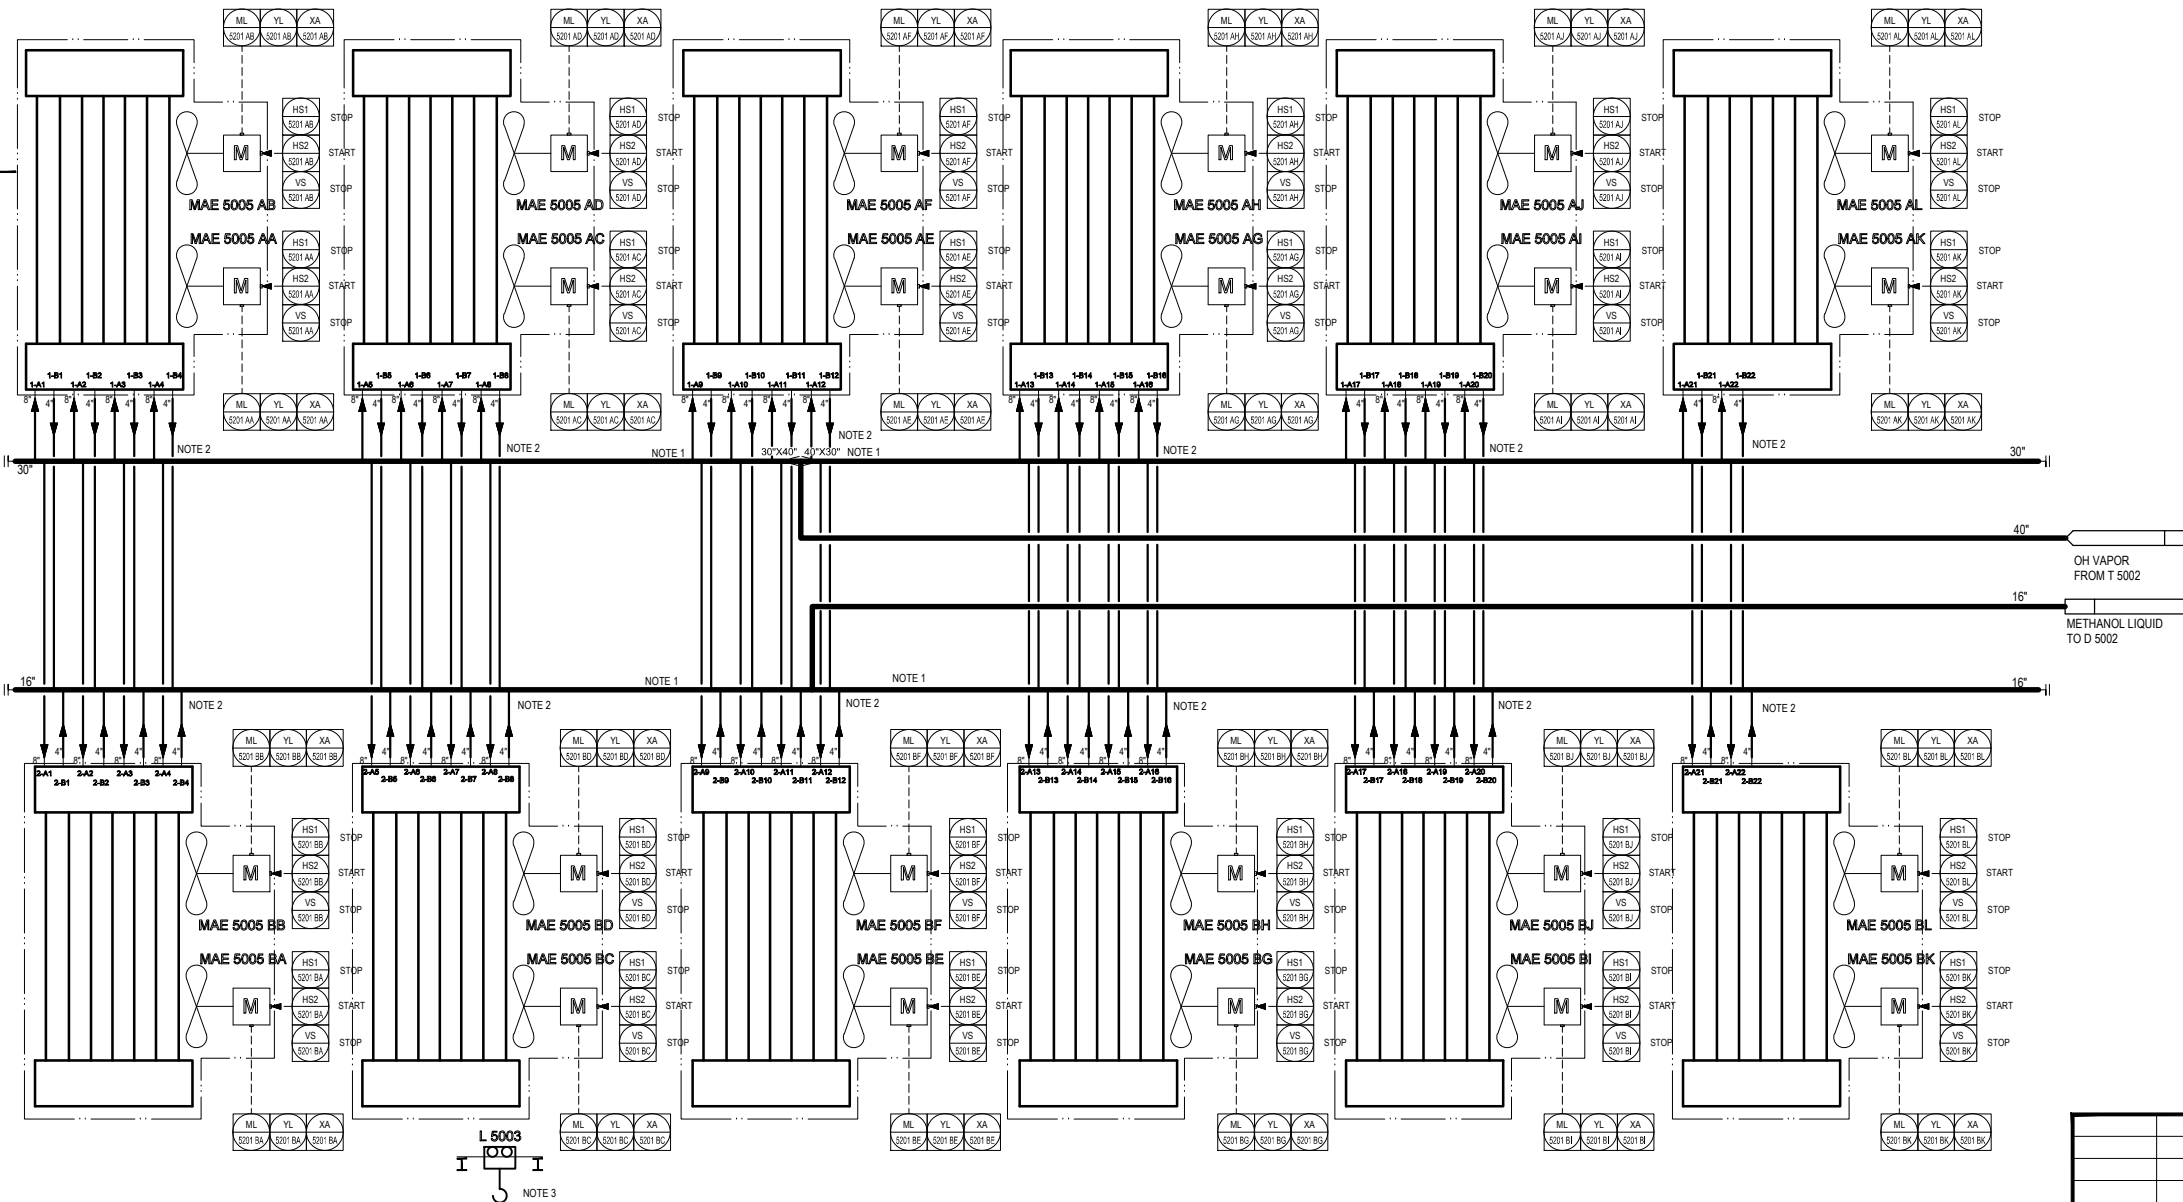

REFERENCE DRAWINGS

SYMBOLS AND LEGENDS

KEY PLAN

As Built	30.04.2020	Wang Yishu	Mu Yu jun	Hu Qiyi			
Approved for Construction	02.02.2018	Wang Yishu	Mu Yu jun	Hu Qiyi			
Approved for Construction	22.03.2017	Li Zhijuan	Mu Yu jun	Hu Qiyi			
Issued for Approval	22.11.2017	Li Zhijuan	Mu Yu jun	Hu Qiyi			
Issued for Comments	22.11.2016	Li Zhijuan	Mu Yu jun	Hu Qiyi			
REV.	DESCRIPTION	DATE	DESIGN	DRAW	CHECK	REVIEW	APPROVE

THIS DOCUMENT IS THE PROPERTY OF TCC. NO PART OF THIS DOCUMENT SHALL BE REPRODUCED OR DISCLOSED TO OTHERS OR USED FOR ANY PURPOSE WHATSOEVER EXCEPT WITH THE PRIOR WRITTEN PERMISSION OF TCC.

OWNER:

Middle East  
Kimiaye Pars Company

DOCUMENT NAME	AIR COOLER AE 5005 DETAIL PIPING AND INSTRUMENT DIAGRAM
CONTRACTOR DRAWING NO.	01
SHEET	01
TOTAL	01
PROJECT	MKP Methanol Project
UNIT	Distillation Unit
PHASE	As Built Drawing
OWNER DWG NO.	MKP-11-DE-5000-PR-PID-023

SCALE: -	SHEET: 1	TOT.: 4	SIZE: A1
----------	----------	---------	----------

AE 5005	LP COLUMN DH CONDENSER
DUTY	127.7 MW
ID x LENGTH(T)-	BY VENDOR nm
DESIGN PRESS.(TU/SH)	(FV/3.5)/NA barg
DESIGN TEMP.(TU/SH)	150/NA °C


# PART 2

## GENERAL NOTES

NOTES:

1) THERMOWELL LABEL IS SHOWN BELOW:

MAE5005AK	MAE5005AL	MAE5005BK	MAE5005BL
T-B23TW5123	T-B23TW5167		
MAE5005AM	MAE5005AN	MAE5005BM	MAE5005BN
T-B23TW5125	T-B23TW5169		
T-B27TW5127	T-B27TW5171		
MAE5005AO	MAE5005AP	MAE5005BO	MAE5005BP
T-B29TW5129	T-B29TW5173		
T-B31TW5131	T-B31TW5175		
MAE5005AQ	MAE5005AR	MAE5005BQ	MAE5005BR
T-B33TW5133	T-B33TW5177		
T-B35TW5135	T-B35TW5179		
MAE5005AS	MAE5005AT	MAE5005BS	MAE5005BT
T-B37TW5137	T-B37TW5181		
T-B39TW5139	T-B39TW5183		
MAE5005AU	MAE5005AV	MAE5005BU	MAE5005BV
T-B41TW5141	T-B41TW5185		
T-B43TW5143	T-B43TW5187		

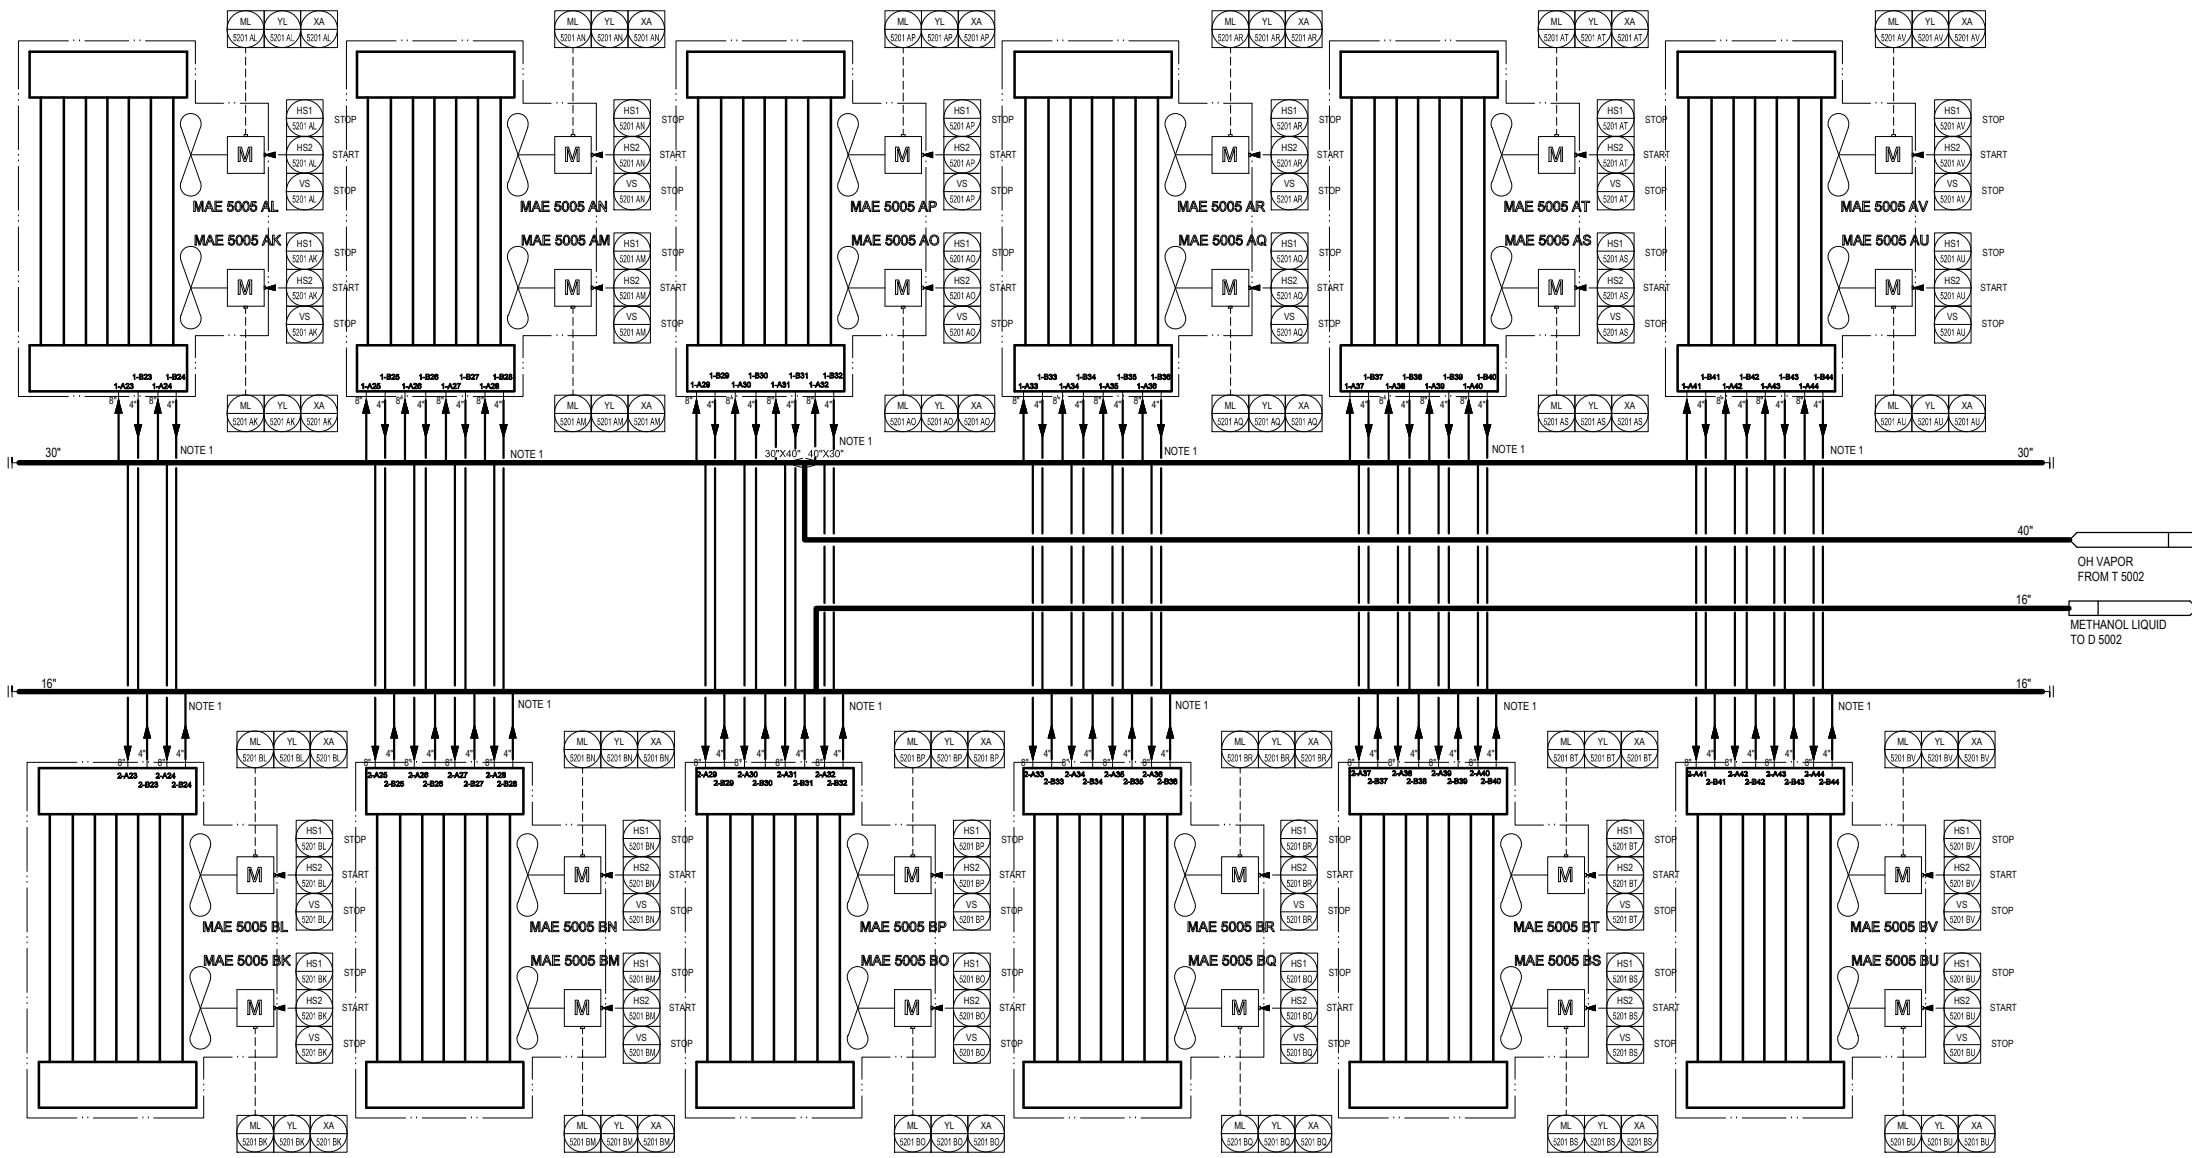

## REFERENCE DRAWINGS


## SYMBOLS AND LEGENDS

## KEY PLAN

As Built	30.04.2020	Wang Yishu	Mu Yu jun	Hu Qiuyi			
Approved for Construction	02.02.2018	Wang Yishu	Mu Yu jun	Hu Qiuyi			
Approved for Construction	22.03.2017	Li Zhijuan	Mu Yu jun	Hu Qiuyi			
Issued for Approval	22.01.2017	Li Zhijuan	Mu Yu jun	Hu Qiuyi			
Issued for Comments	22.11.2016	Li Zhijuan	Mu Yu jun	Hu Qiuyi			
REV.	DESCRIPTION	DATE	DESIGN	DRAW	CHECK	REVIEW	APPROVE

THIS DOCUMENT IS THE PROPERTY OF TCC. NO PART OF THIS DOCUMENT SHALL BE REPRODUCED OR DISCLOSED TO OTHERS OR USED FOR ANY PURPOSE WHATSOEVER EXCEPT WITH THE PRIOR WRITTEN PERMISSION OF TCC.

OWNER:



Middle East  
Kimiaye Pars Company

DOCUMENT NAME	JOB NO.	DATE	REV.
CONTRACTOR DRAWING NO.			
SHEET 01	TOTAL 01		
SUB-CONTRACTOR DRAWING NO.			
SHEET -	TOTAL -		



AIR COOLER AE 5005 DETAIL PIPING AND INSTRUMENT DIAGRAM	PROJECT	MKP Methanol Project
	UNIT	Distillation Unit
	PHASE	As Built Drawing
	OWNER DWG NO.	MKP-11-AS-5000-PR-PID-023

Counter Signing	Sign	Date



L 5002	CRANE 5002	AE 5005	LP COLUMN OH CONDENSER
TYPE	CANTILEVER CRANE	DUTY	127.7 MW
CAPACITY	1 t	ID x LENGTH(T)	BY Vendor mm
LIFT HEIGHT	12 m	DESIGN PRESS.(TL/SH)	(FV/3.5)/NA barG
SLIDING DISTANCE	1.8 m	DESIGN TEMP.(TL/SH)	150/NA °C

# PART 3

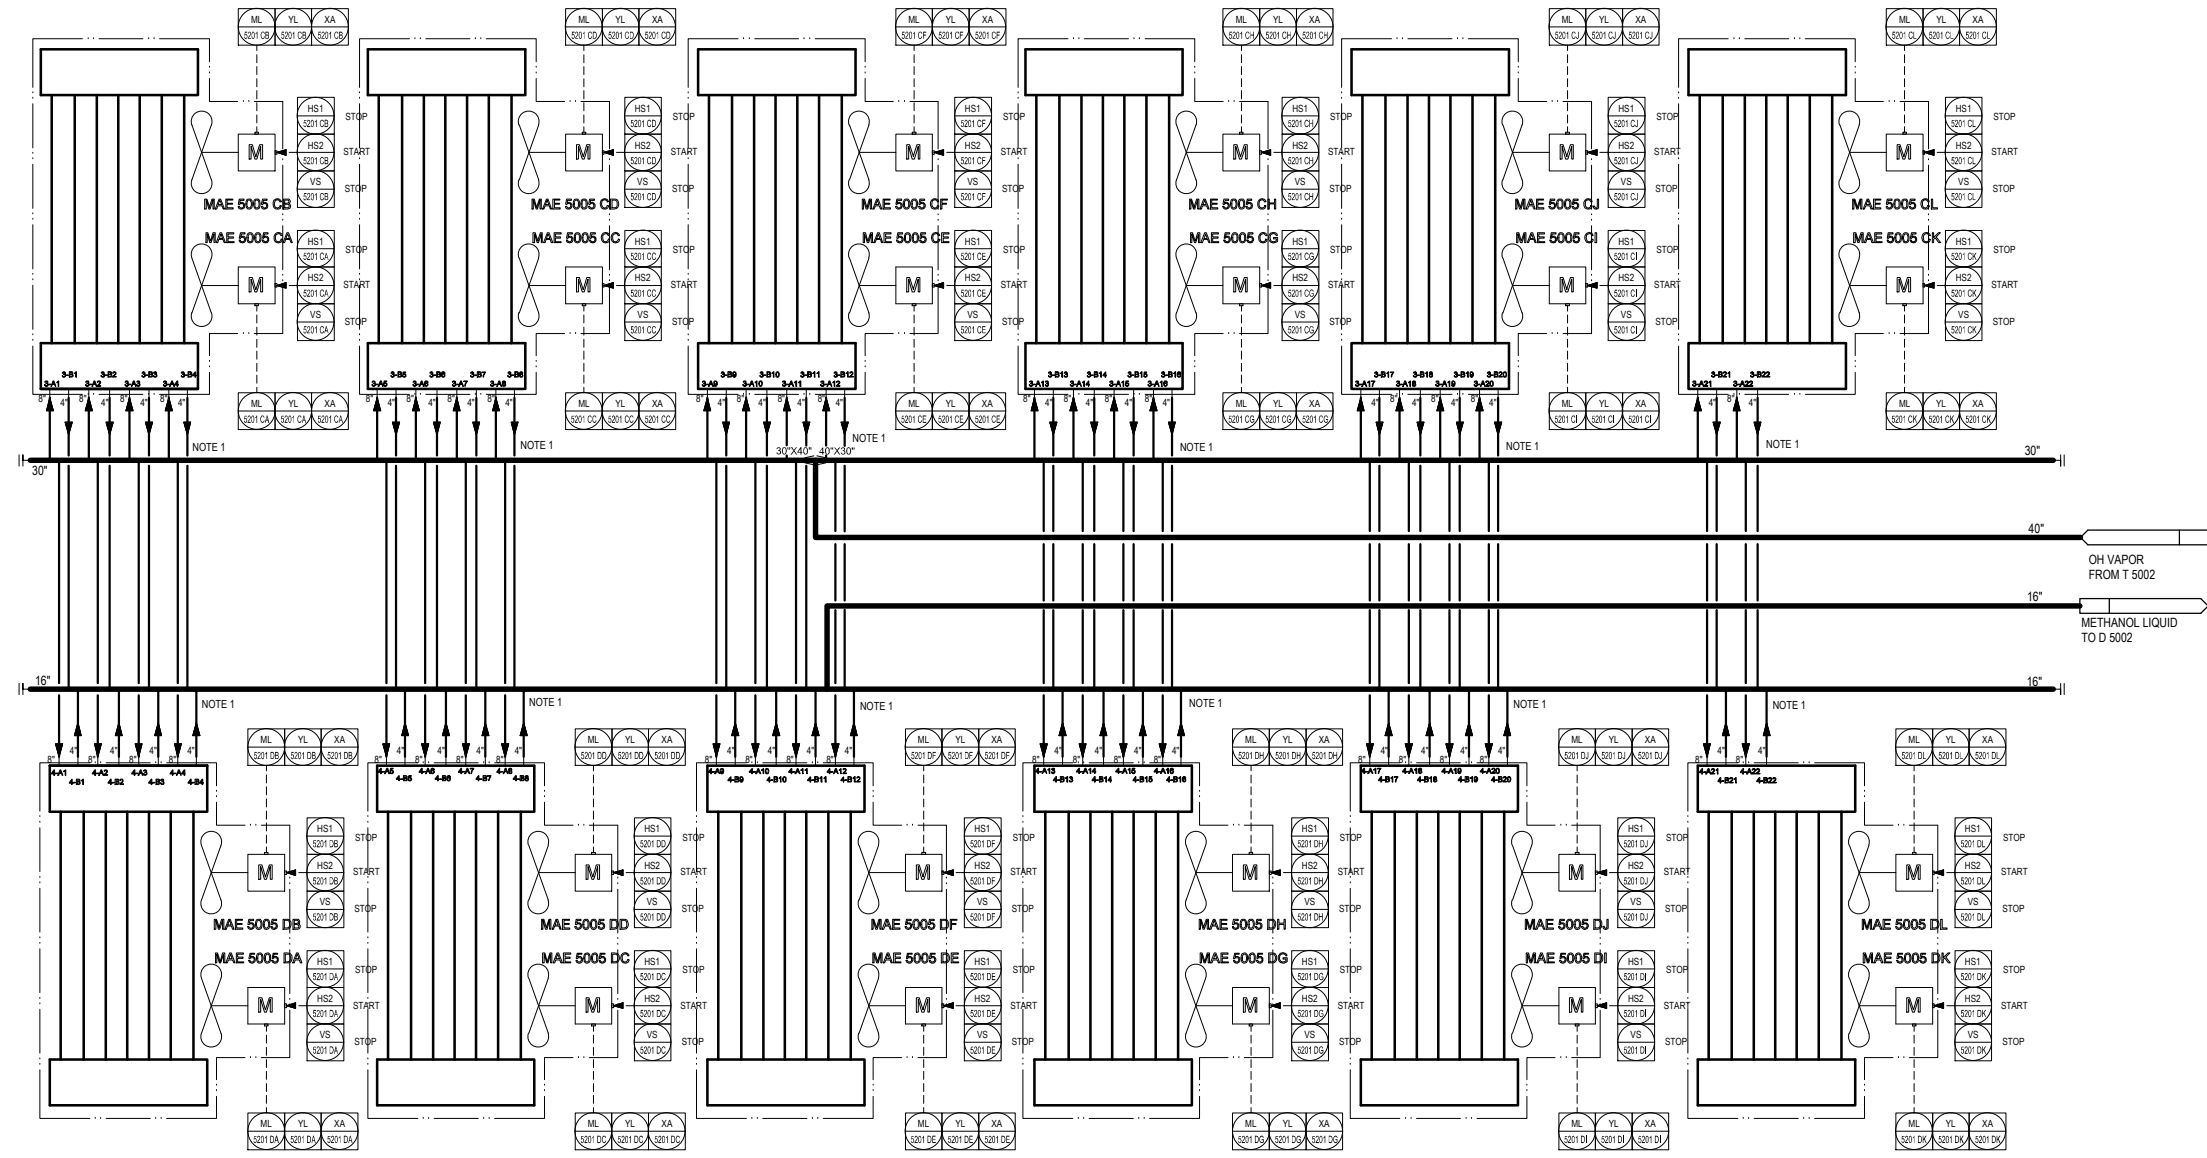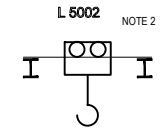

## GENERAL NOTES

- \*NOTES:
- 1) THERMOWELL LABEL IS SHOWN BELOW:  

MAE5005CA	MAE5005CB	MAE5005DA	MAE5005DB
3-B1 TW5189	4-B1 TW5233		
3-B3 TW5191	4-B3 TW5235		
MAE5005CC	MAE5005CD	MAE5005DC	MAE5005DD
3-B5 TW5193	4-B5 TW5237		
3-B7 TW5195	4-B7 TW5239		
MAE5005CE	MAE5005CF	MAE5005DE	MAE5005DF
3-B9 TW5197	4-B9 TW5241		
3-B11 TW5199	4-B11 TW5243		
MAE5005CG	MAE5005CH	MAE5005DG	MAE5005DH
3-B13 TW5201	4-B13 TW5245		
3-B15 TW5203	4-B15 TW5247		
MAE5005CI	MAE5005CJ	MAE5005DI	MAE5005DJ
3-B17 TW5205	4-B17 TW5249		
3-B19 TW5207	4-B19 TW5251		
MAE5005CK	MAE5005CL	MAE5005DK	MAE5005DL
3-B21 TW5209	4-B21 TW5253		
  - 2) CRANE IS USED FOR AE 5005 MAINTENANCE.

## REFERENCE DRAWINGS

## SYMBOLS AND LEGENDS

## KEY PLAN

As Built	30.04.2020	Wang Yishu	Mu Yujun	Hu Qiyi			
Approved for Construction	02.02.2018	Wang Yishu	Mu Yujun	Hu Qiyi			
Approved for Construction	22.03.2017	Li Zhijuan	Mu Yujun	Hu Qiyi			
Issued for Approval	22.01.2017	Li Zhijuan	Mu Yujun	Hu Qiyi			
Issued for Comments	22.11.2016	Li Zhijuan	Mu Yujun	Hu Qiyi			
REV.	DESCRIPTION	DATE	DESIGN	DRAW	CHECK	REVIEW	APPROVE

THIS DOCUMENT IS THE PROPERTY OF TCC. NO PART OF THIS DOCUMENT SHALL BE REPRODUCED OR DISCLOSED TO OTHERS OR USED FOR ANY PURPOSE WHATSOEVER EXCEPT WITH THE PRIOR WRITTEN PERMISSION OF TCC.

OWNER:

Middle East  
Kimiaye Pars Company

DOCUMENT NAME	JOB NO.	DATE	REV.
CONTRACTOR DRAWING NO.	SHEET 01	TOTAL 01	
SUB-CONTRACTOR DRAWING NO.	SHEET -	TOTAL -	

AIR COOLER AE 5005 DETAIL PIPING AND INSTRUMENT DIAGRAM	PROJECT	MKP Methanol Project
	UNIT	Distillation Unit
	PHASE	As Built Drawing
SCALE: -	SHEET: 3	TOT.: 4
SIZE: A1	OWNER	MKP-11-AS-5000-PR-PID-023


Counter Signing	Sign	Date
-----------------	------	------

AE 5005	LP COLUMN DH CONDENSER
DUTY	127.7 MW
ID x LENGTH(T-T)	BY VENDOR mm
DESIGN PRESS.(TLU/SH)	(F.V./3.5)/NA barg
DESIGN TEMP.(TLU/SH)	150/NA °C

# PART 4

## GENERAL NOTES

- NOTES:
- THERMOWELL LABEL IS SHOWN BELOW:
- |             |             |           |           |
|-------------|-------------|-----------|-----------|
| MAE5005CK   | MAE5005CL   | MAE5005CK | MAE5005DL |
| 3-B23TW5211 | 4-B23TW5255 |           |           |
| MAE5005CM   | MAE5005CN   | MAE5005DM | MAE5005DN |
| 3-B25TW5213 | 4-B25TW5257 |           |           |
| 3-B27TW5215 | 4-B27TW5259 |           |           |
| MAE5005CO   | MAE5005CP   | MAE5005DO | MAE5005DP |
| 3-B29TW5217 | 4-B29TW5261 |           |           |
| 3-B31TW5219 | 4-B31TW5263 |           |           |
| MAE5005CQ   | MAE5005CR   | MAE5005DQ | MAE5005DR |
| 3-B33TW5221 | 4-B33TW5265 |           |           |
| 3-B35TW5223 | 4-B35TW5267 |           |           |
| MAE5005CS   | MAE5005CT   | MAE5005DS | MAE5005DT |
| 3-B37TW5225 | 4-B37TW5269 |           |           |
| 3-B39TW5227 | 4-B39TW5271 |           |           |
| MAE5005CU   | MAE5005CV   | MAE5005DU | MAE5005DV |
| 3-B41TW5229 | 4-B41TW5273 |           |           |
| 3-B43TW5231 | 4-B43TW5275 |           |           |

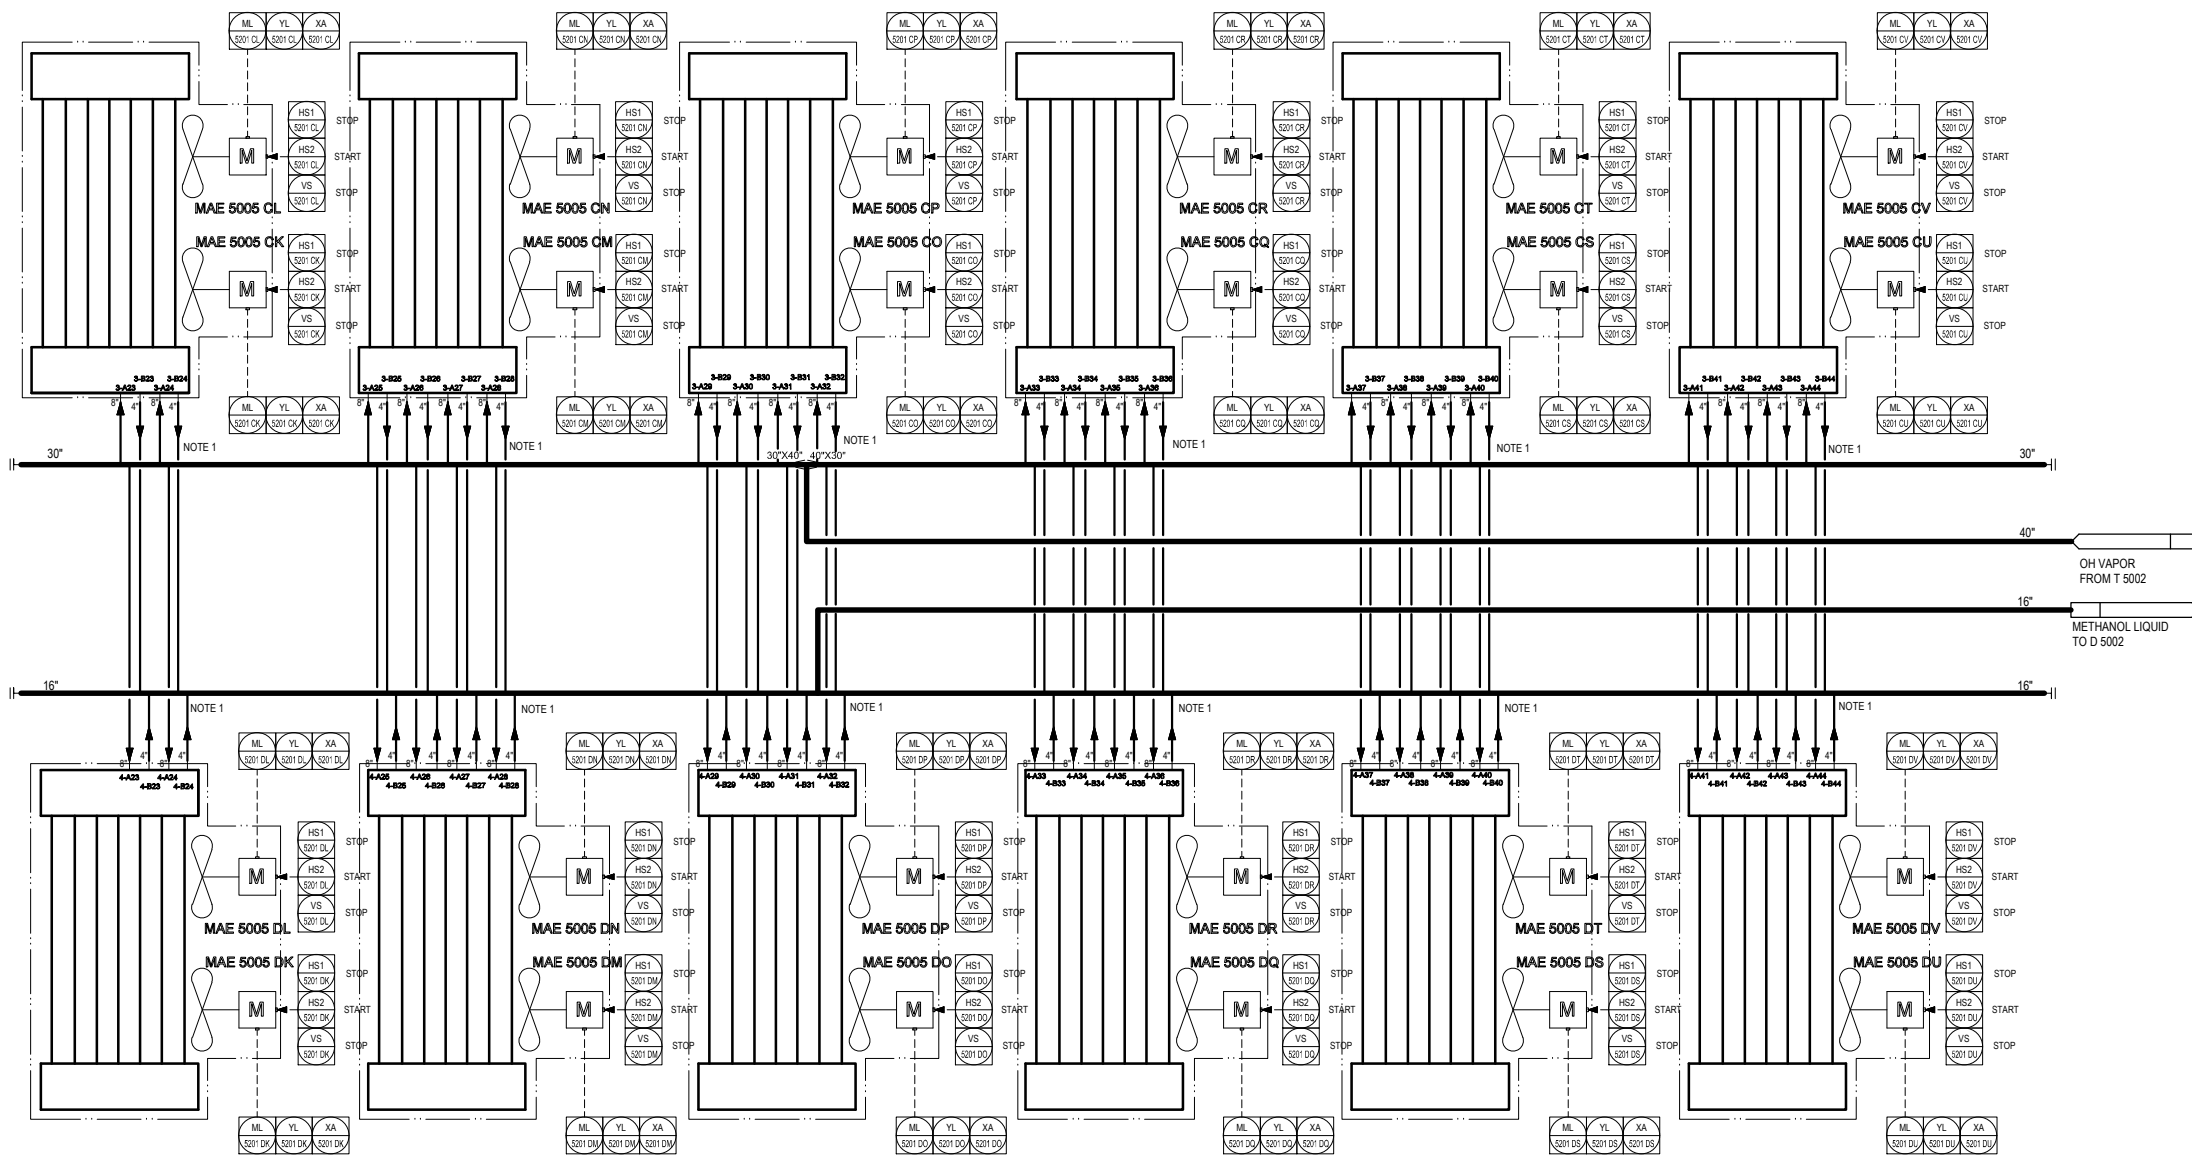

## REFERENCE DRAWINGS


## SYMBOLS AND LEGENDS

## KEY PLAN

As Built	30.04.2020	Wang Yishu	Mu Yujun	Hu Qiuyi			
Approved for Construction	02.02.2018	Wang Yishu	Mu Yujun	Hu Qiuyi			
Approved for Construction	22.03.2017	Li Zhijuan	Mu Yujun	Hu Qiuyi			
Issued for Approval	22.01.2017	Li Zhijuan	Mu Yujun	Hu Qiuyi			
Issued for Comments	22.11.2016	Li Zhijuan	Mu Yujun	Hu Qiuyi			
REV.	DESCRIPTION	DATE	DESIGN	DRAW	CHECK	REVIEW	APPROVE

THIS DOCUMENT IS THE PROPERTY OF TCC. NO PART OF THIS DOCUMENT SHALL BE REPRODUCED OR DISCLOSED TO OTHERS OR USED FOR ANY PURPOSE WHATSOEVER WITHOUT THE PRIOR WRITTEN PERMISSION OF TCC.

OWNER:



Middle East  
Kimiaye Pars Company

DOCUMENT NAME	JOB NO.	DATE	REV.
CONTRACTOR DRAWING NO.			
SHEET 01	TOTAL 01		
SUB-CONTRACTOR DRAWING NO.			
SHEET -	TOTAL -		

AIR COOLER AE 5005 DETAIL PIPING AND INSTRUMENT DIAGRAM	PROJECT	MKP Methanol Project
	UNIT	Distillation Unit
	PHASE	As Built Drawing
SCALE: -	SHEET: 4	TOT.: 4
SIZE: A1	OWNER	MKP-11-AS-5000-PR-PID-023

Counter Signing	Sign	Date

AE 5004	STABILIZER COLUMN DH CONDENSER
DUTY	33.5 MW
ID x LENGTH(T-T)	BY VENDOR mm
DESIGN PRESS.(TLU/SH)	(FV/3.5)/NA barg
DESIGN TEMP.(TLU/SH)	150/NA °C

**GENERAL NOTES**

- †NOTES:  
 1) SYMMETRICAL PIPING.  
 2) THERMOWELL LABEL IS SHOWN BELOW.
- |                    |                    |
|--------------------|--------------------|
| MAE5004A, MAE5004B | MAE5004L, MAE5004J |
| B1 ITW5001         | B11 ITW5017        |
| B3 ITW5003         | B19 ITW5019        |
| MAE5004C, MAE5004D | MAE5004K, MAE5004I |
| B5 ITW5005         | B21 ITW5021        |
| B7 ITW5007         | B23 ITW5023        |
| MAE5004E, MAE5004F | MAE5004M, MAE5004N |
| B9 ITW5009         | B25 ITW5025        |
| B11 ITW5011        | B27 ITW5027        |
| MAE5004G, MAE5004H | MAE5004O, MAE5004P |
| B13 ITW5013        | B29 ITW5029        |
| B15 ITW5015        | B31 ITW5031        |

**REFERENCE DRAWINGS**


**SYMBOLS AND LEGENDS**

**KEY PLAN**

As Built	30.04.2020	Li Zhijuan	Mu Yujun	Hu Qiyi	
Approved for Construction	22.03.2017	Li Zhijuan	Mu Yujun	Hu Qiyi	
Issued for Approval	22.01.2017	Li Zhijuan	Mu Yujun	Hu Qiyi	
Issued for Comments	22.11.2016	Li Zhijuan	Mu Yujun	Hu Qiyi	
REV.	DESCRIPTION	DATE	DESIGN	DRAW	CHECK
					REVIEW
					APPROVE

THIS DOCUMENT IS THE PROPERTY OF TCC. NO PART OF THIS DOCUMENT SHALL BE REPRODUCED OR DISCLOSED TO OTHERS OR USED FOR ANY PURPOSE WHATSOEVER EXCEPT WITH THE PRIOR WRITTEN PERMISSION OF TCC.

OWNER:




Middle East  
Kimiaye Pars Company

DOCUMENT NAME	JOB NO.	DATE	REV.
CONTRACTOR		CONTRACTOR DRAWING NO.	
TCC 中国天辰工程有限公司 CHINA TIANCHEN ENGINEERING CORPORATION		-	
		SHEET 01	TOTAL 01
SUB-CONTRACTOR DRAWING NO.		-	
		SHEET -	TOTAL -

AIR COOLER AE 5004 DETAIL PIPING AND INSTRUMENT DIAGRAM	PROJECT	MKP Methanol Project
	UNIT	Distillation Unit
	PHASE	As Built Drawing
SCALE: -	OWNER DWG. NO.	MKP-11-AS-5000-PR-PID-024

Counter	Sign	Date

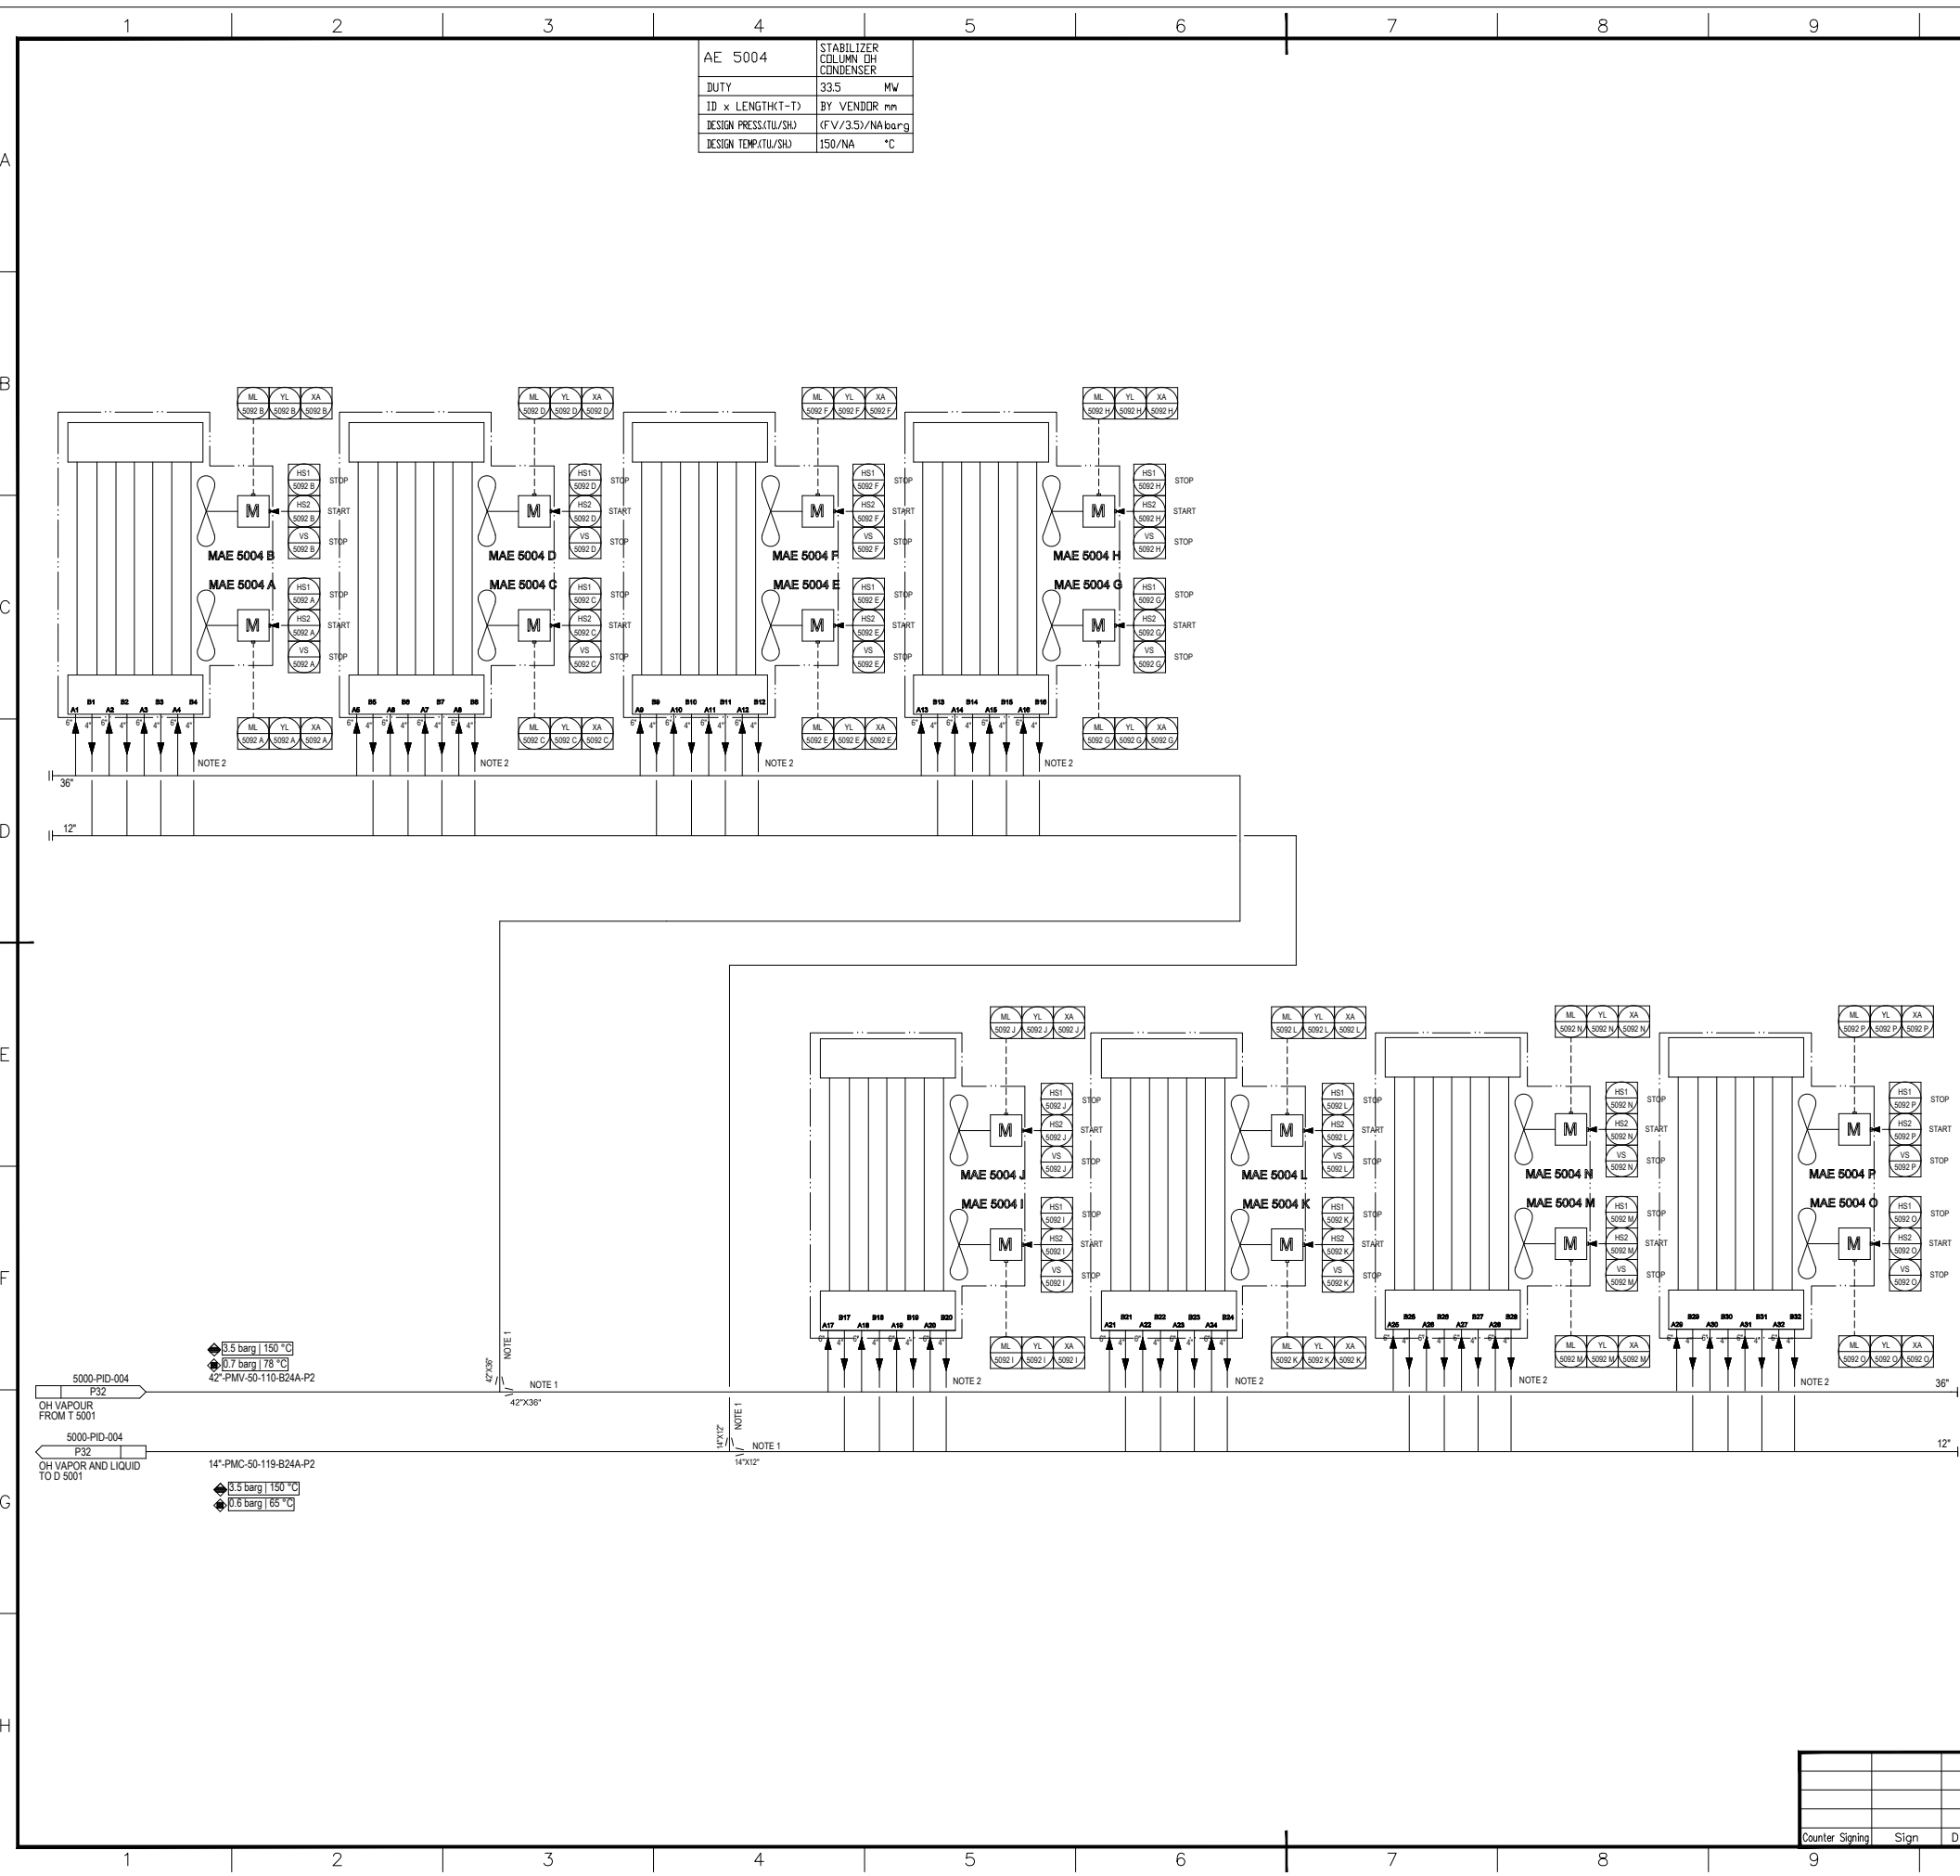

5000-PID-004  
P32  
OH VAPOUR FROM T 5001

5000-PID-004  
P32  
OH VAPOR AND LIQUID TO D 5001

14"-PMC-50-110-B24A-P2  
0.5 barg | 150 °C  
0.7 barg | 78 °C  
42"-PMV-50-110-B24A-P2  
0.5 barg | 150 °C  
0.6 barg | 85 °C

NOTE 1  
42"X36"

NOTE 1  
14"X12"

NOTE 2

NOTE 2

NOTE 2

NOTE 2

AE 5006	WASH WATER AIR COOLER
DUTY	0.8 MW
ID x LENGTH(I-T)	BY VENDOR mm
DESIGN PRESS(TU/SH)	15/NA barg
DESIGN TEMP(TU/SH)	175/NA °C

GENERAL NOTES

NOTES:  
 1) THERMOWELL LABEL IS SHOWN BELOW:  
 MAE5006A, MAE5006B  
 BT1 TW5301

REFERENCE DRAWINGS


SYMBOLS AND LEGENDS

KEY PLAN

▲	As Built	30.04.2020	Li Zhijuan		Mu Yujun	Hu Qiyi	
▲	Approved for Construction	22.03.2017	Li Zhijuan		Mu Yujun	Hu Qiyi	
▲	Issued for Approval	22.01.2017	Li Zhijuan		Mu Yujun	Hu Qiyi	
▲	Issued for Comments	22.11.2016	Li Zhijuan		Mu Yujun	Hu Qiyi	

THIS DOCUMENT IS THE PROPERTY OF TCC. NO PART OF THIS DOCUMENT SHALL BE REPRODUCED OR DISCLOSED TO OTHERS OR USED FOR ANY PURPOSE WHATSOEVER EXCEPT WITH THE PRIOR WRITTEN PERMISSION OF TCC.

OWNER:




Middle East  
Kimiaye Pars Company

DOCUMENT NAME	JOB NO.	DATE	REV.
CONTRACTOR		CONTRACTOR DRAWING NO.	
TCC 中国天辰工程有限公司 CHINA TIANCHEN ENGINEERING CORPORATION		-	
		SHEET 01	TOTAL 01
SUB-CONTRACTOR		SUB-CONTRACTOR DRAWING NO.	
		-	
		SHEET -	TOTAL -


PROJECT		MKP Methanol Project	
UNIT		Distillation Unit	
PHASE		As Built Drawing	
OWNER DWG NO.	MKP-11-AS-5000-PR-PID-026		

Counter	Sign	Date

SCALE:-- SHEET:1 TOT.:1 SIZE:A1

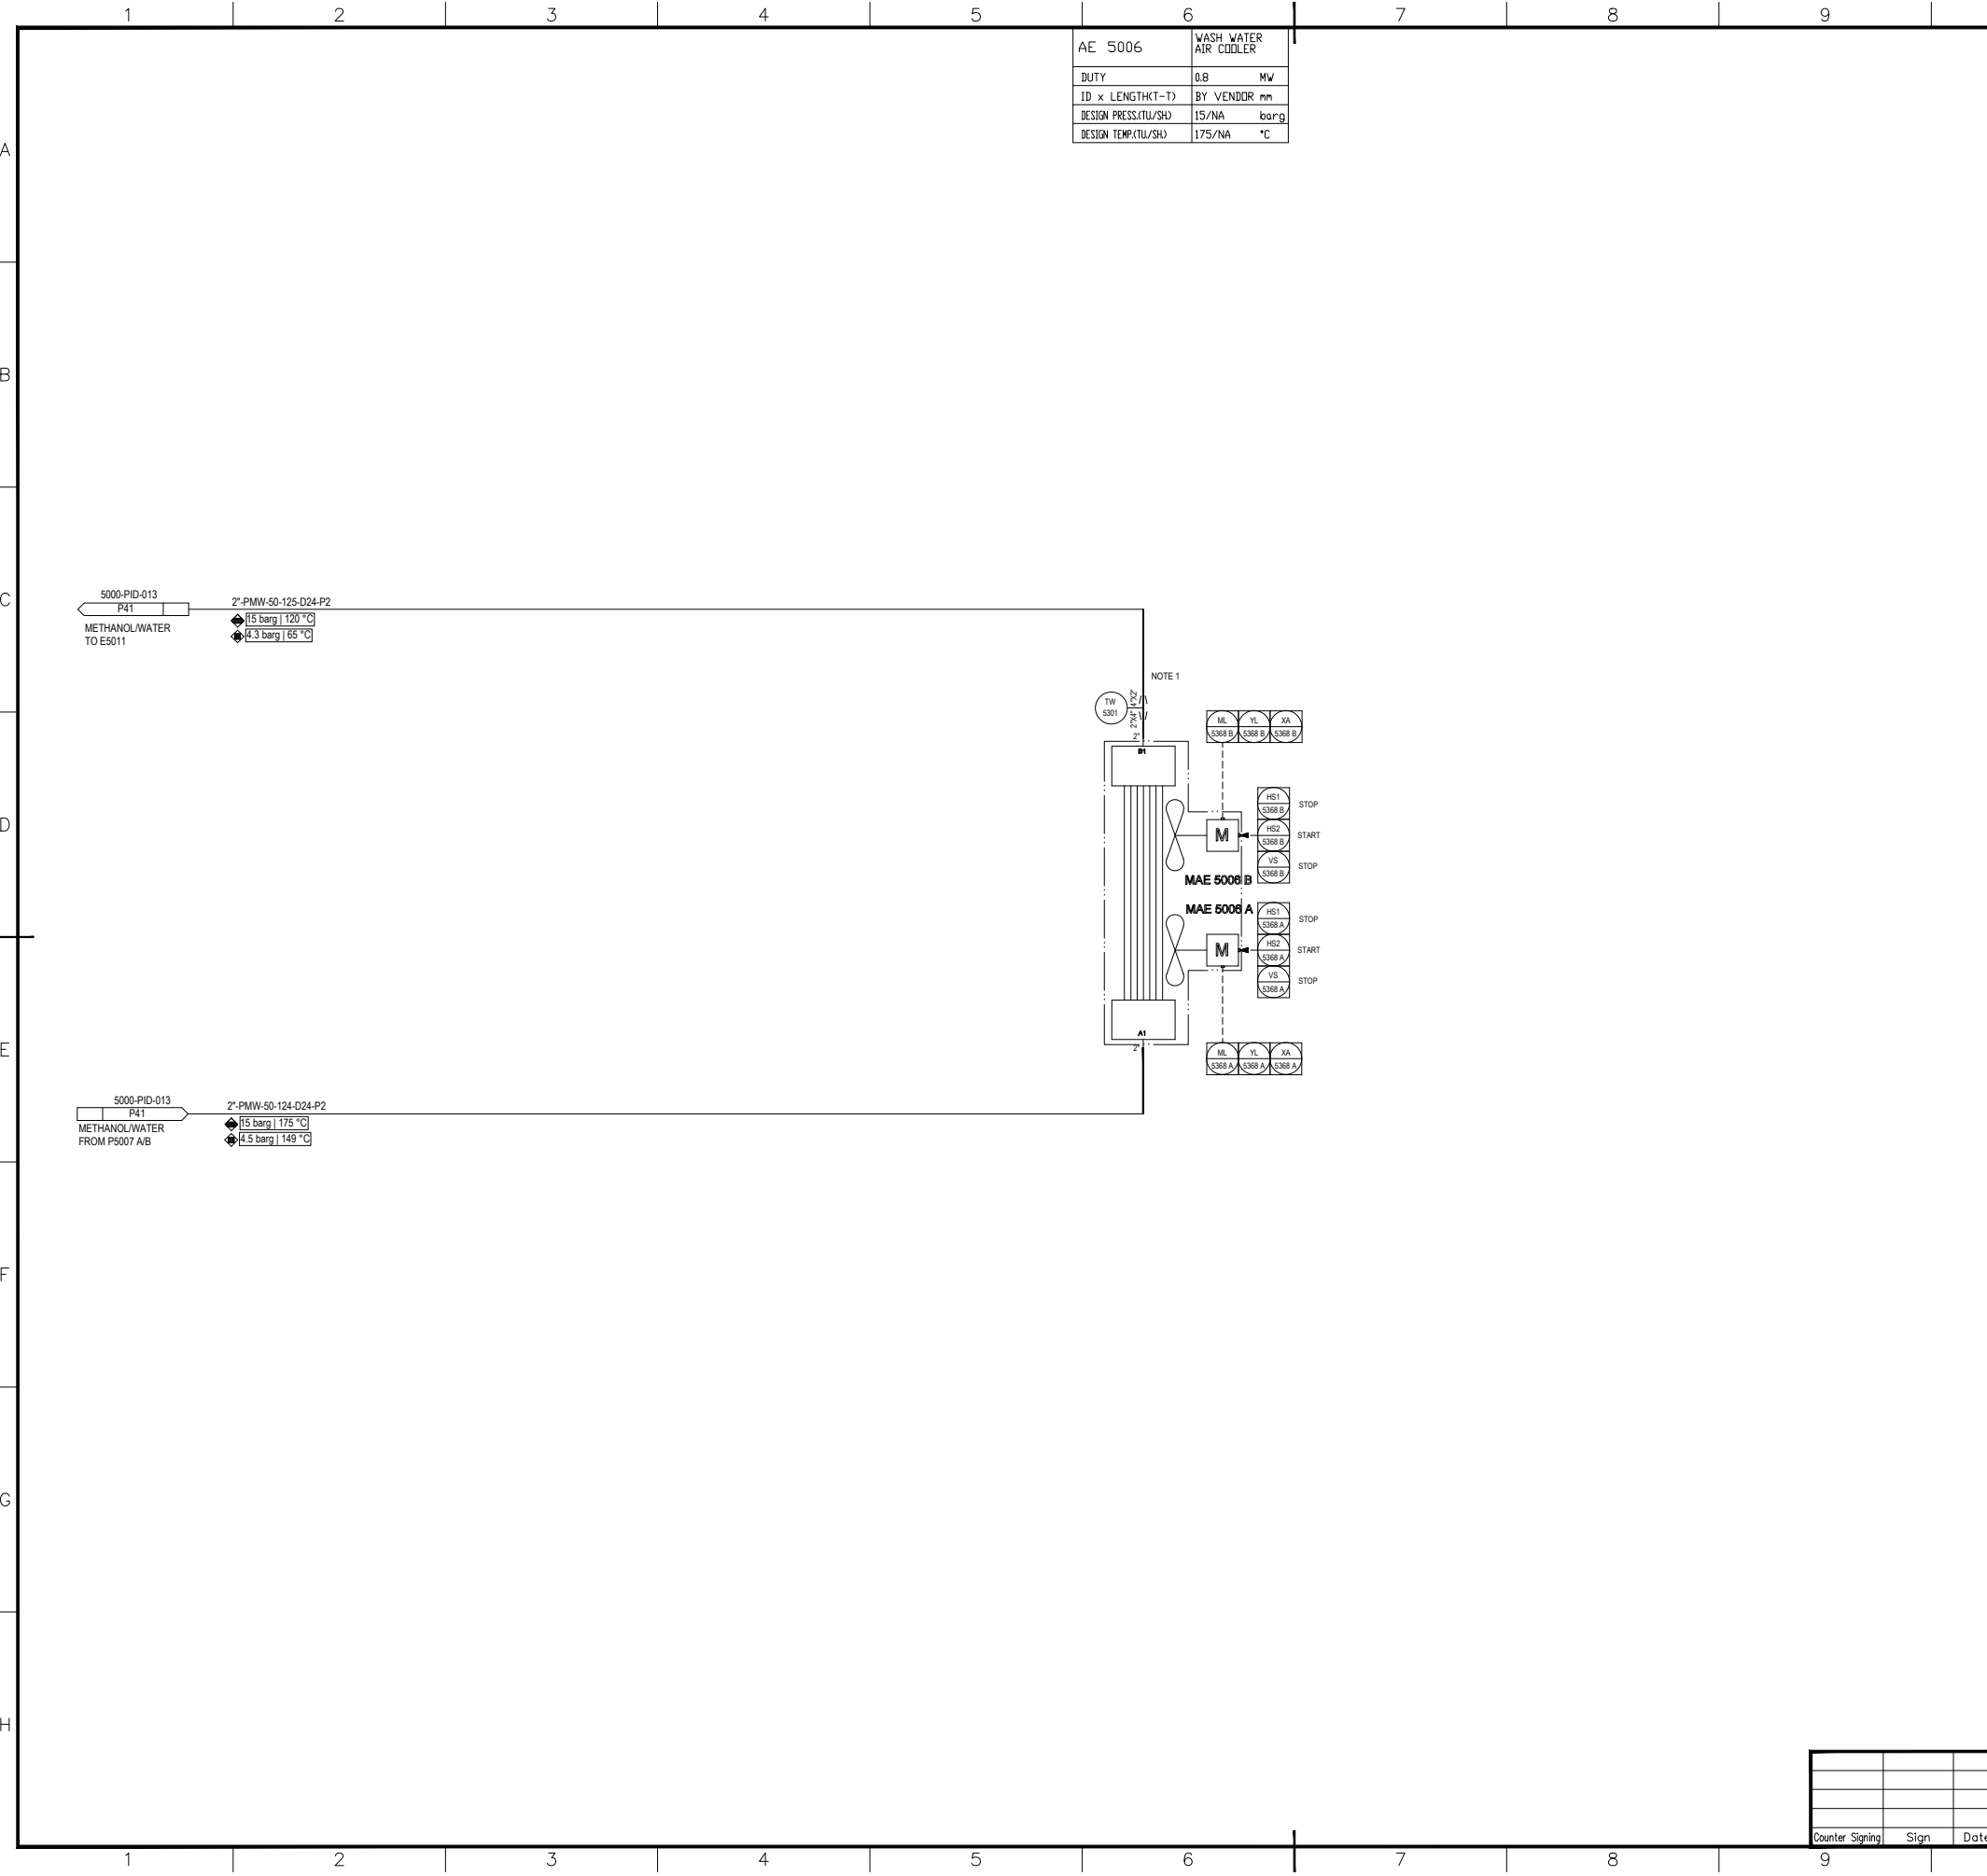




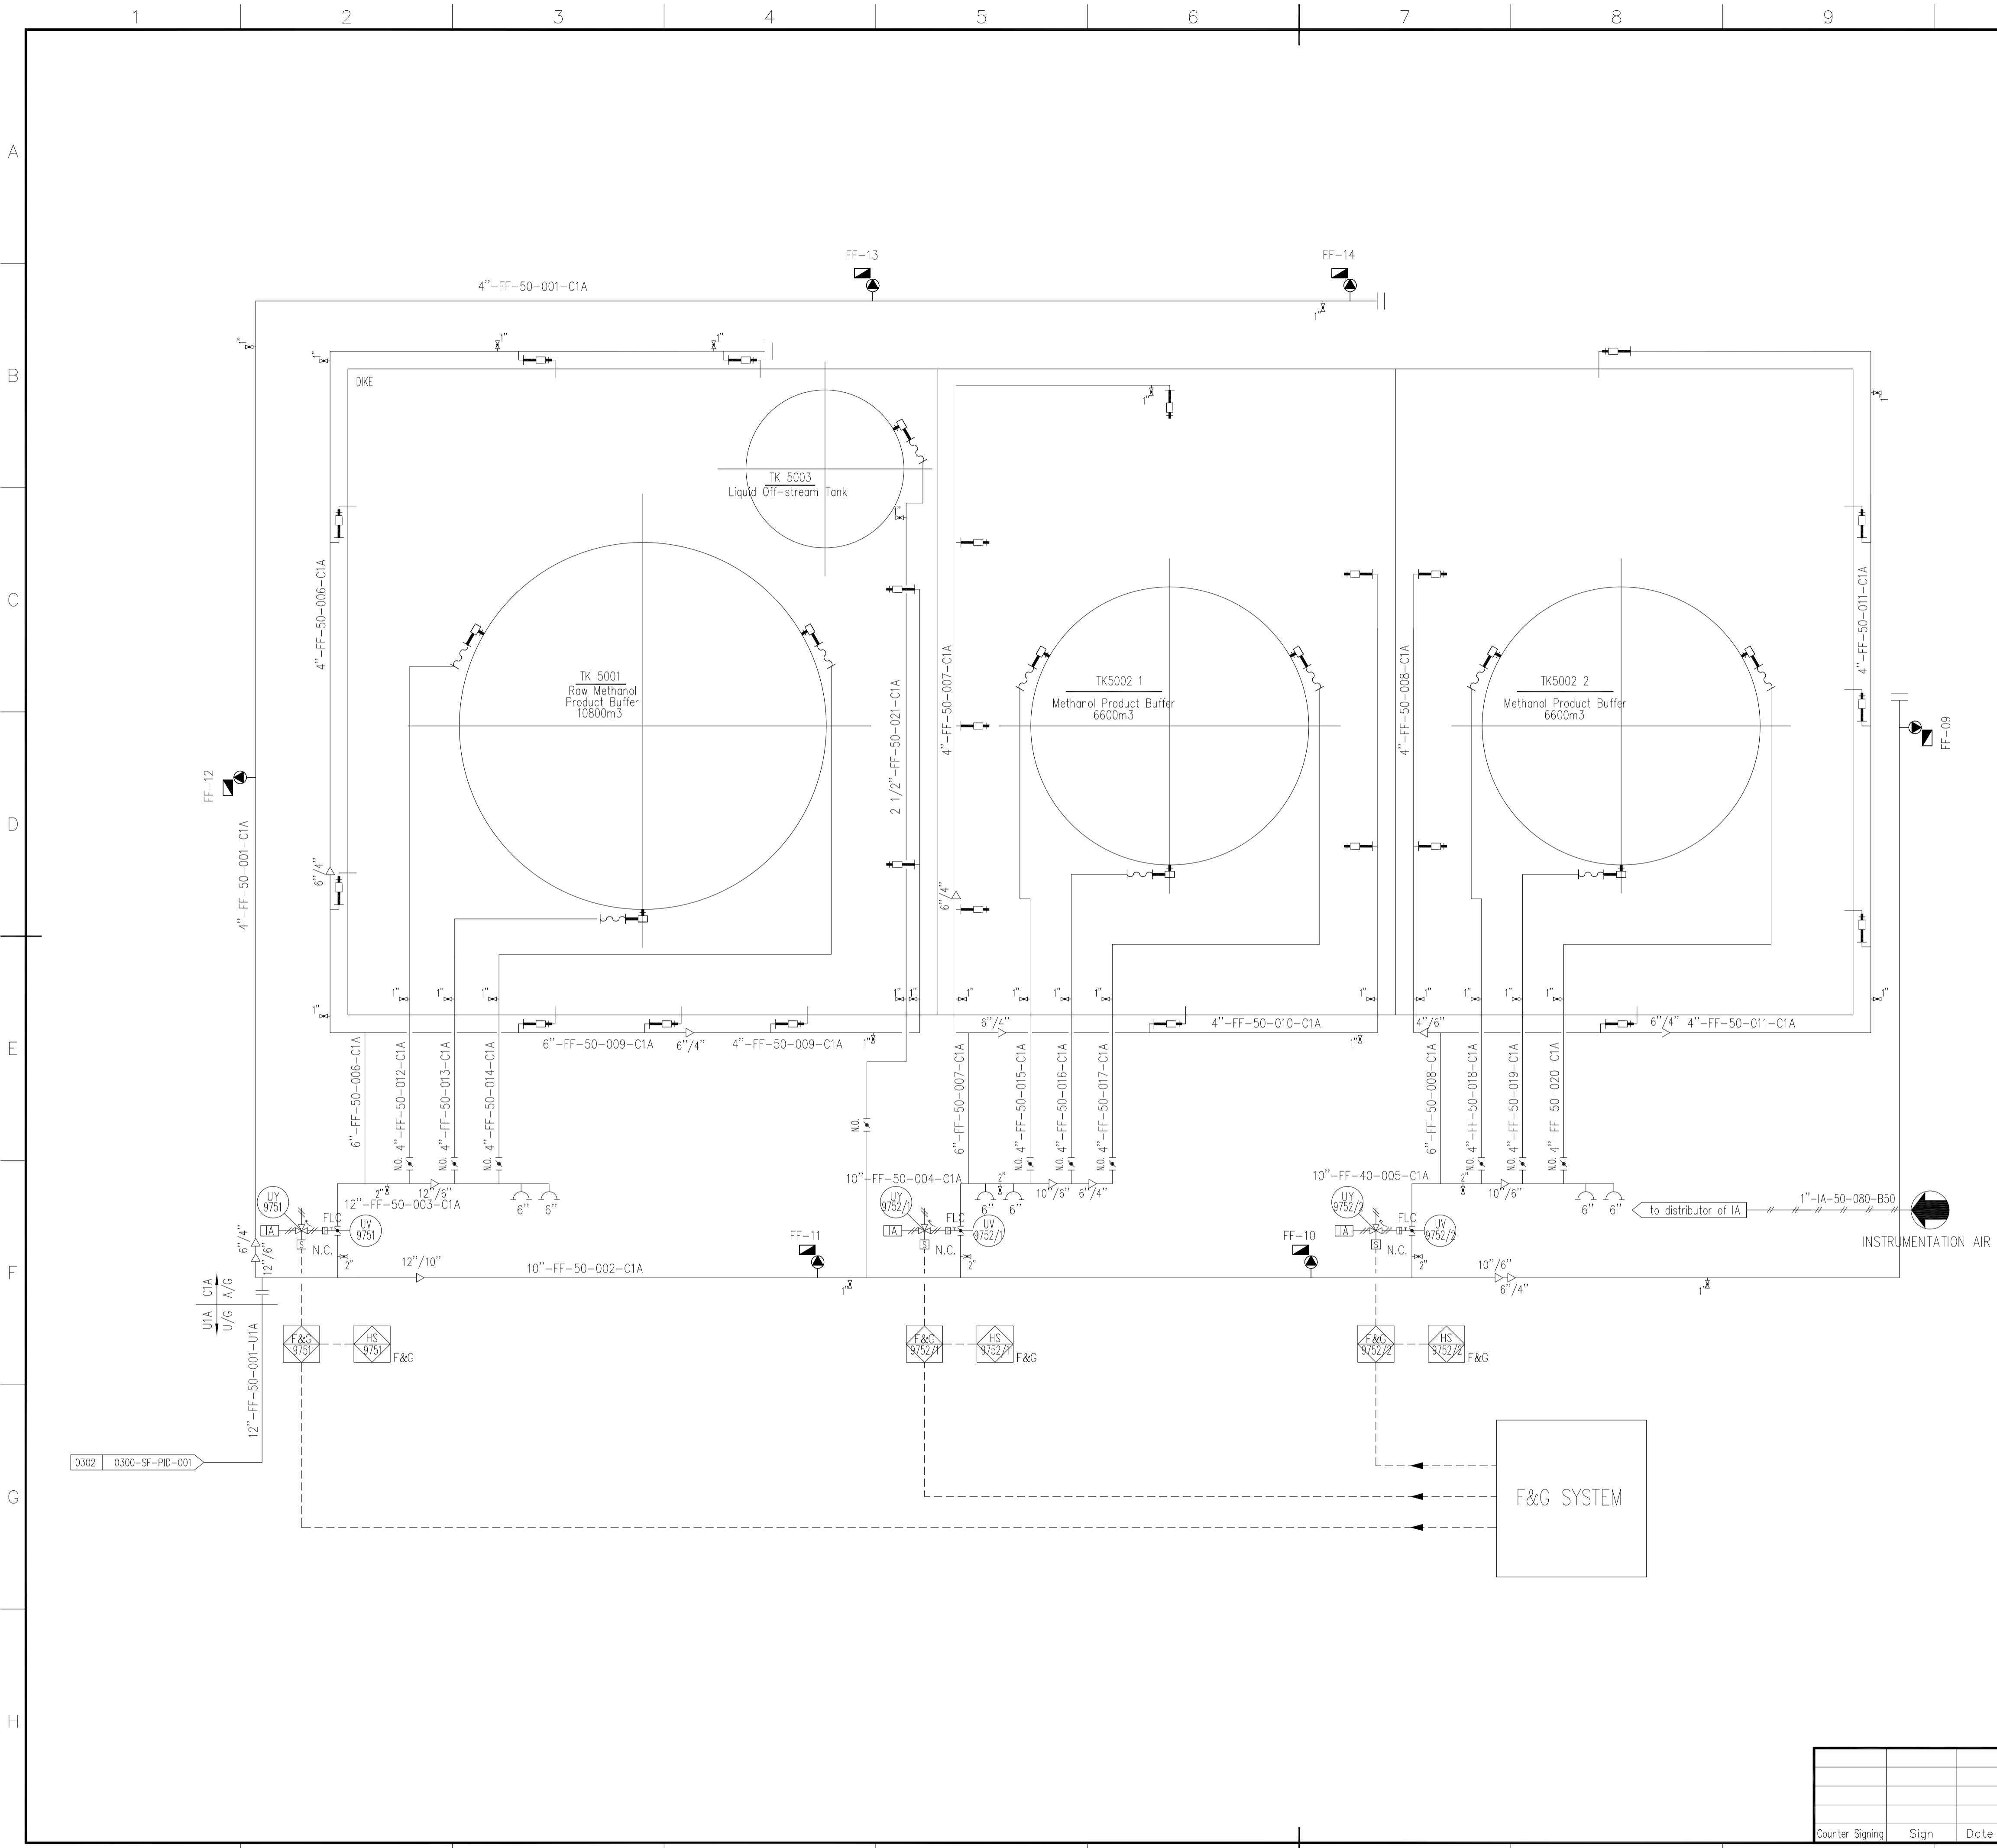

**GENERAL NOTES**

Emptying foam solution should be collected to oily water collection system.

**PIPE NUMBER**

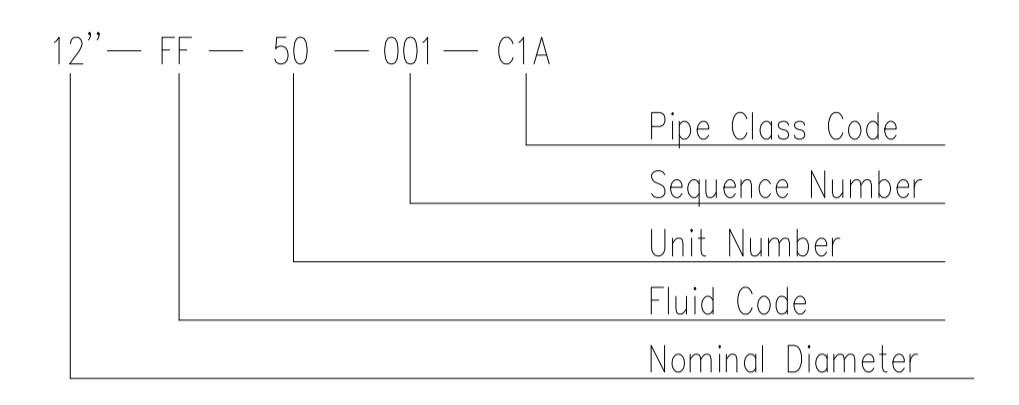

**REFERENCE DRAWINGS**

MKP-11-DE-0300-SF-PID-001	MKP-11-DE-5000-PI-PPL-019
MKP-11-DE-9700-SF-SPC-001	

**SYMBOLS AND LEGENDS**

	Foam chamber (Vertical)		Foam chamber (Horizontal)
	Metalic hose	FF	Foam solution
	Foam hydrant	N.C.	Normal close
	Foam hydrant cabinet	N.O.	Normal open
	Reducer		Fire connection

REV.	DESCRIPTION	DATE	DESIGN	DRAW	CHECK	REVIEW	APPROVE
△	As built	30.04.2020	Liu Jian		Cui Yanjun	Deng Wenhui	
△	Approved for Construction	31.12.2019	Liu Jian		Cui Yanjun	Deng Wenhui	
△	Approved for Construction	28.11.2019	Liu Jian		Cui Yanjun	Deng Wenhui	
△	Approved for Construction	12.12.2016	Li Yang		Cui Yanjun	Deng Wenhui	
△	Approved for Construction	24.10.2016	Li Yang		Cui Yanjun	Deng Wenhui	

THIS DOCUMENT IS THE PROPERTY OF TCC. NO PART OF THIS DOCUMENT SHALL BE REPRODUCED OR DISCLOSED TO OTHERS OR USED FOR ANY PURPOSE WHATSOEVER EXCEPT WITH THE PRIOR WRITTEN PERMISSION OF TCC.

OWNER: Middle East Kimiaye Pars Company

	HALDOR TOPSØE A/S	DOCUMENT NAME:	JOB NO.	DOC. GRP.	REV.
			EMPL. NO.	DIAGRAM	


	CONTRACTOR DRAWING NO.	
	MKP-11-AS-5000-PF03-PID-001	
SHEET 01		TOTAL 01

	SUB-CONTRACTOR DRAWING NO.	
	-	
SHEET -		TOTAL -

P&ID FOR FOAM SYSTEM IN UNIT 5000	PROJECT	MKP Methanol Project
	UNIT	Distillation Unit
	PHASE	As built drawing
	OWNER DWG NO.	MKP-11-AS-5000-SF-PID-001


Counter Signing	Sign	Date

SCALE N/A	SHEET 1	TOT. 1	SIZE A1
-----------	---------	--------	---------

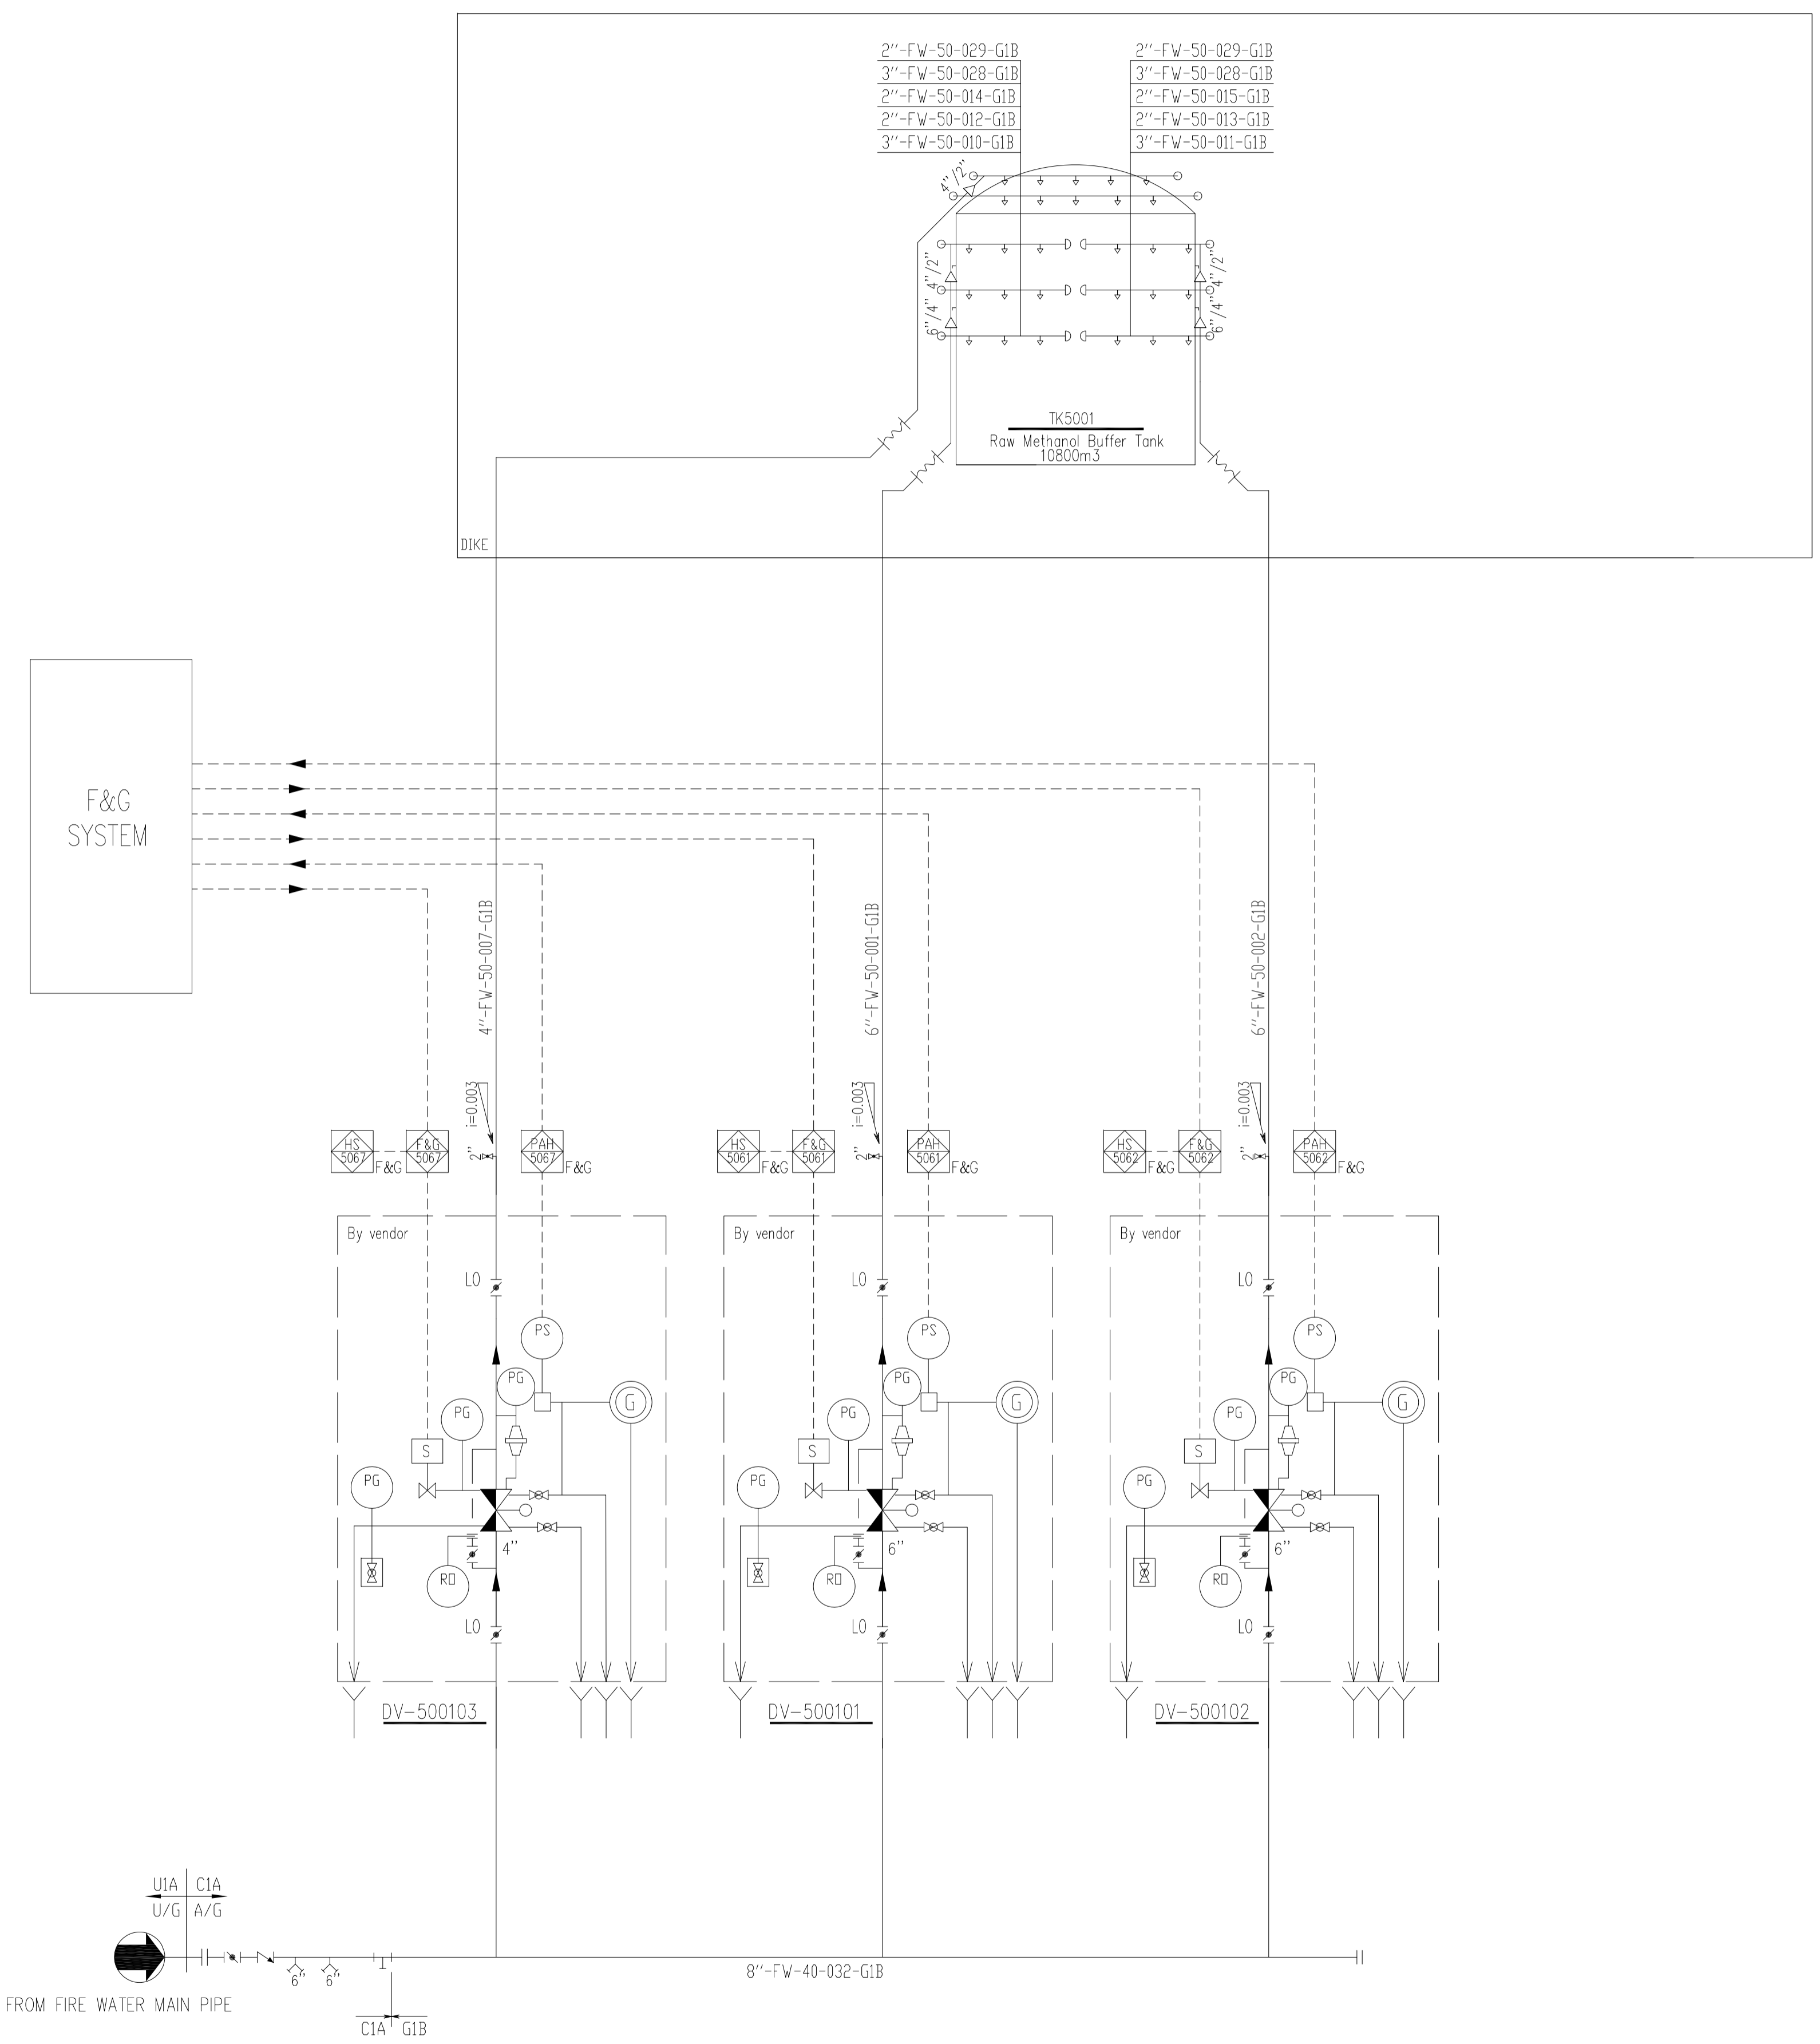

GENERAL NOTES

PIPE NUMBER

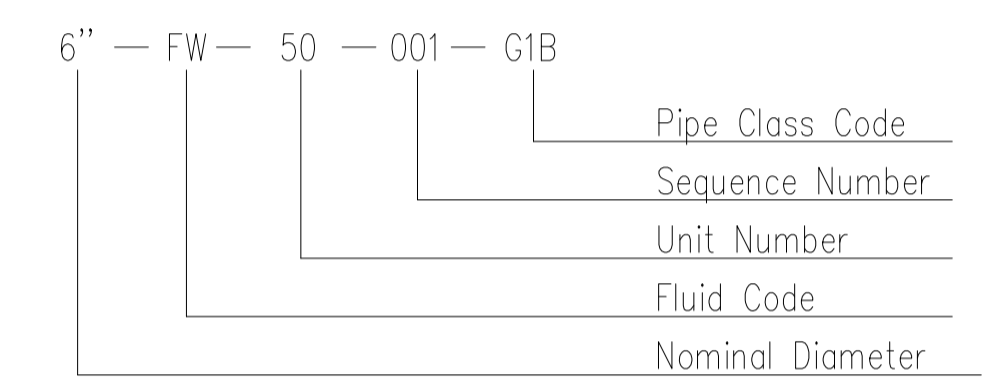

REFERENCE DRAWINGS

MKP-11-DE-9700-SF-SPC-001	MKP-11-DE-5000-PI-PPL-019
MKP-11-DE-9000-IN-CED-001	

SYMBOLS AND LEGENDS

⬇	spray nozzle	⊗	deluge valve
FW	fire fighting water	T	T type strainer
— — —	metal hose	⊘	butterfly valve
⊘	globe valve	⊘	ball valve
G	water motor gong	⊘	check valve
⊘	vacuum stiff. ring	⊘	pipe gap
⊘	pressure operated relief valve(P.O.R.V.)	⊘	emergency release

△	As built	30.04.2020	Liu Jian		Cui Yanjun	Deng Wenhui
△	Approved for Construction	15.03.2017	Li Yang		Cui Yanjun	Deng Wenhui
△	Approved for Construction	16.12.2016	Li Yang		Cui Yanjun	Deng Wenhui
△	Approved for Construction	23.09.2016	Li Yang		Cui Yanjun	Deng Wenhui

THIS DOCUMENT IS THE PROPERTY OF TCC. NO PART OF THIS DOCUMENT SHALL BE REPRODUCED OR DISCLOSED TO OTHERS OR USED FOR ANY PURPOSE WHATSOEVER EXCEPT WITH THE PRIOR WRITTEN PERMISSION OF TCC.


OWNER: Middle East Kimiaye Pars Company

LICENSOR	HALDOR TOPSØE A/S	DOCUMENT NAME:	JOB NO.	DOC. GRP.	REV.
CONTRACTOR	TCC 中国天辰工程有限公司	CONTRACTOR DRAWING NO.			

CONTRACTOR	TCC 中国天辰工程有限公司	MKP-11-AS-5000-PF03-PID-002	SHEET 01	TOTAL 01
SUB-CONTRACTOR		SUB-CONTRACTOR DRAWING NO.		
REV. DATE		SHEET		TOTAL


P&ID FOR SPRINKLER SYSTEM IN UNIT 5000	PROJECT	MKP Methanol Project
	UNIT	Distillation Unit
	PHASE	As built drawing
SCALE N/A	OWNER DWG NO.	MKP-11-AS-5000-SF-PID-002

Counter Signing	Sign	Date

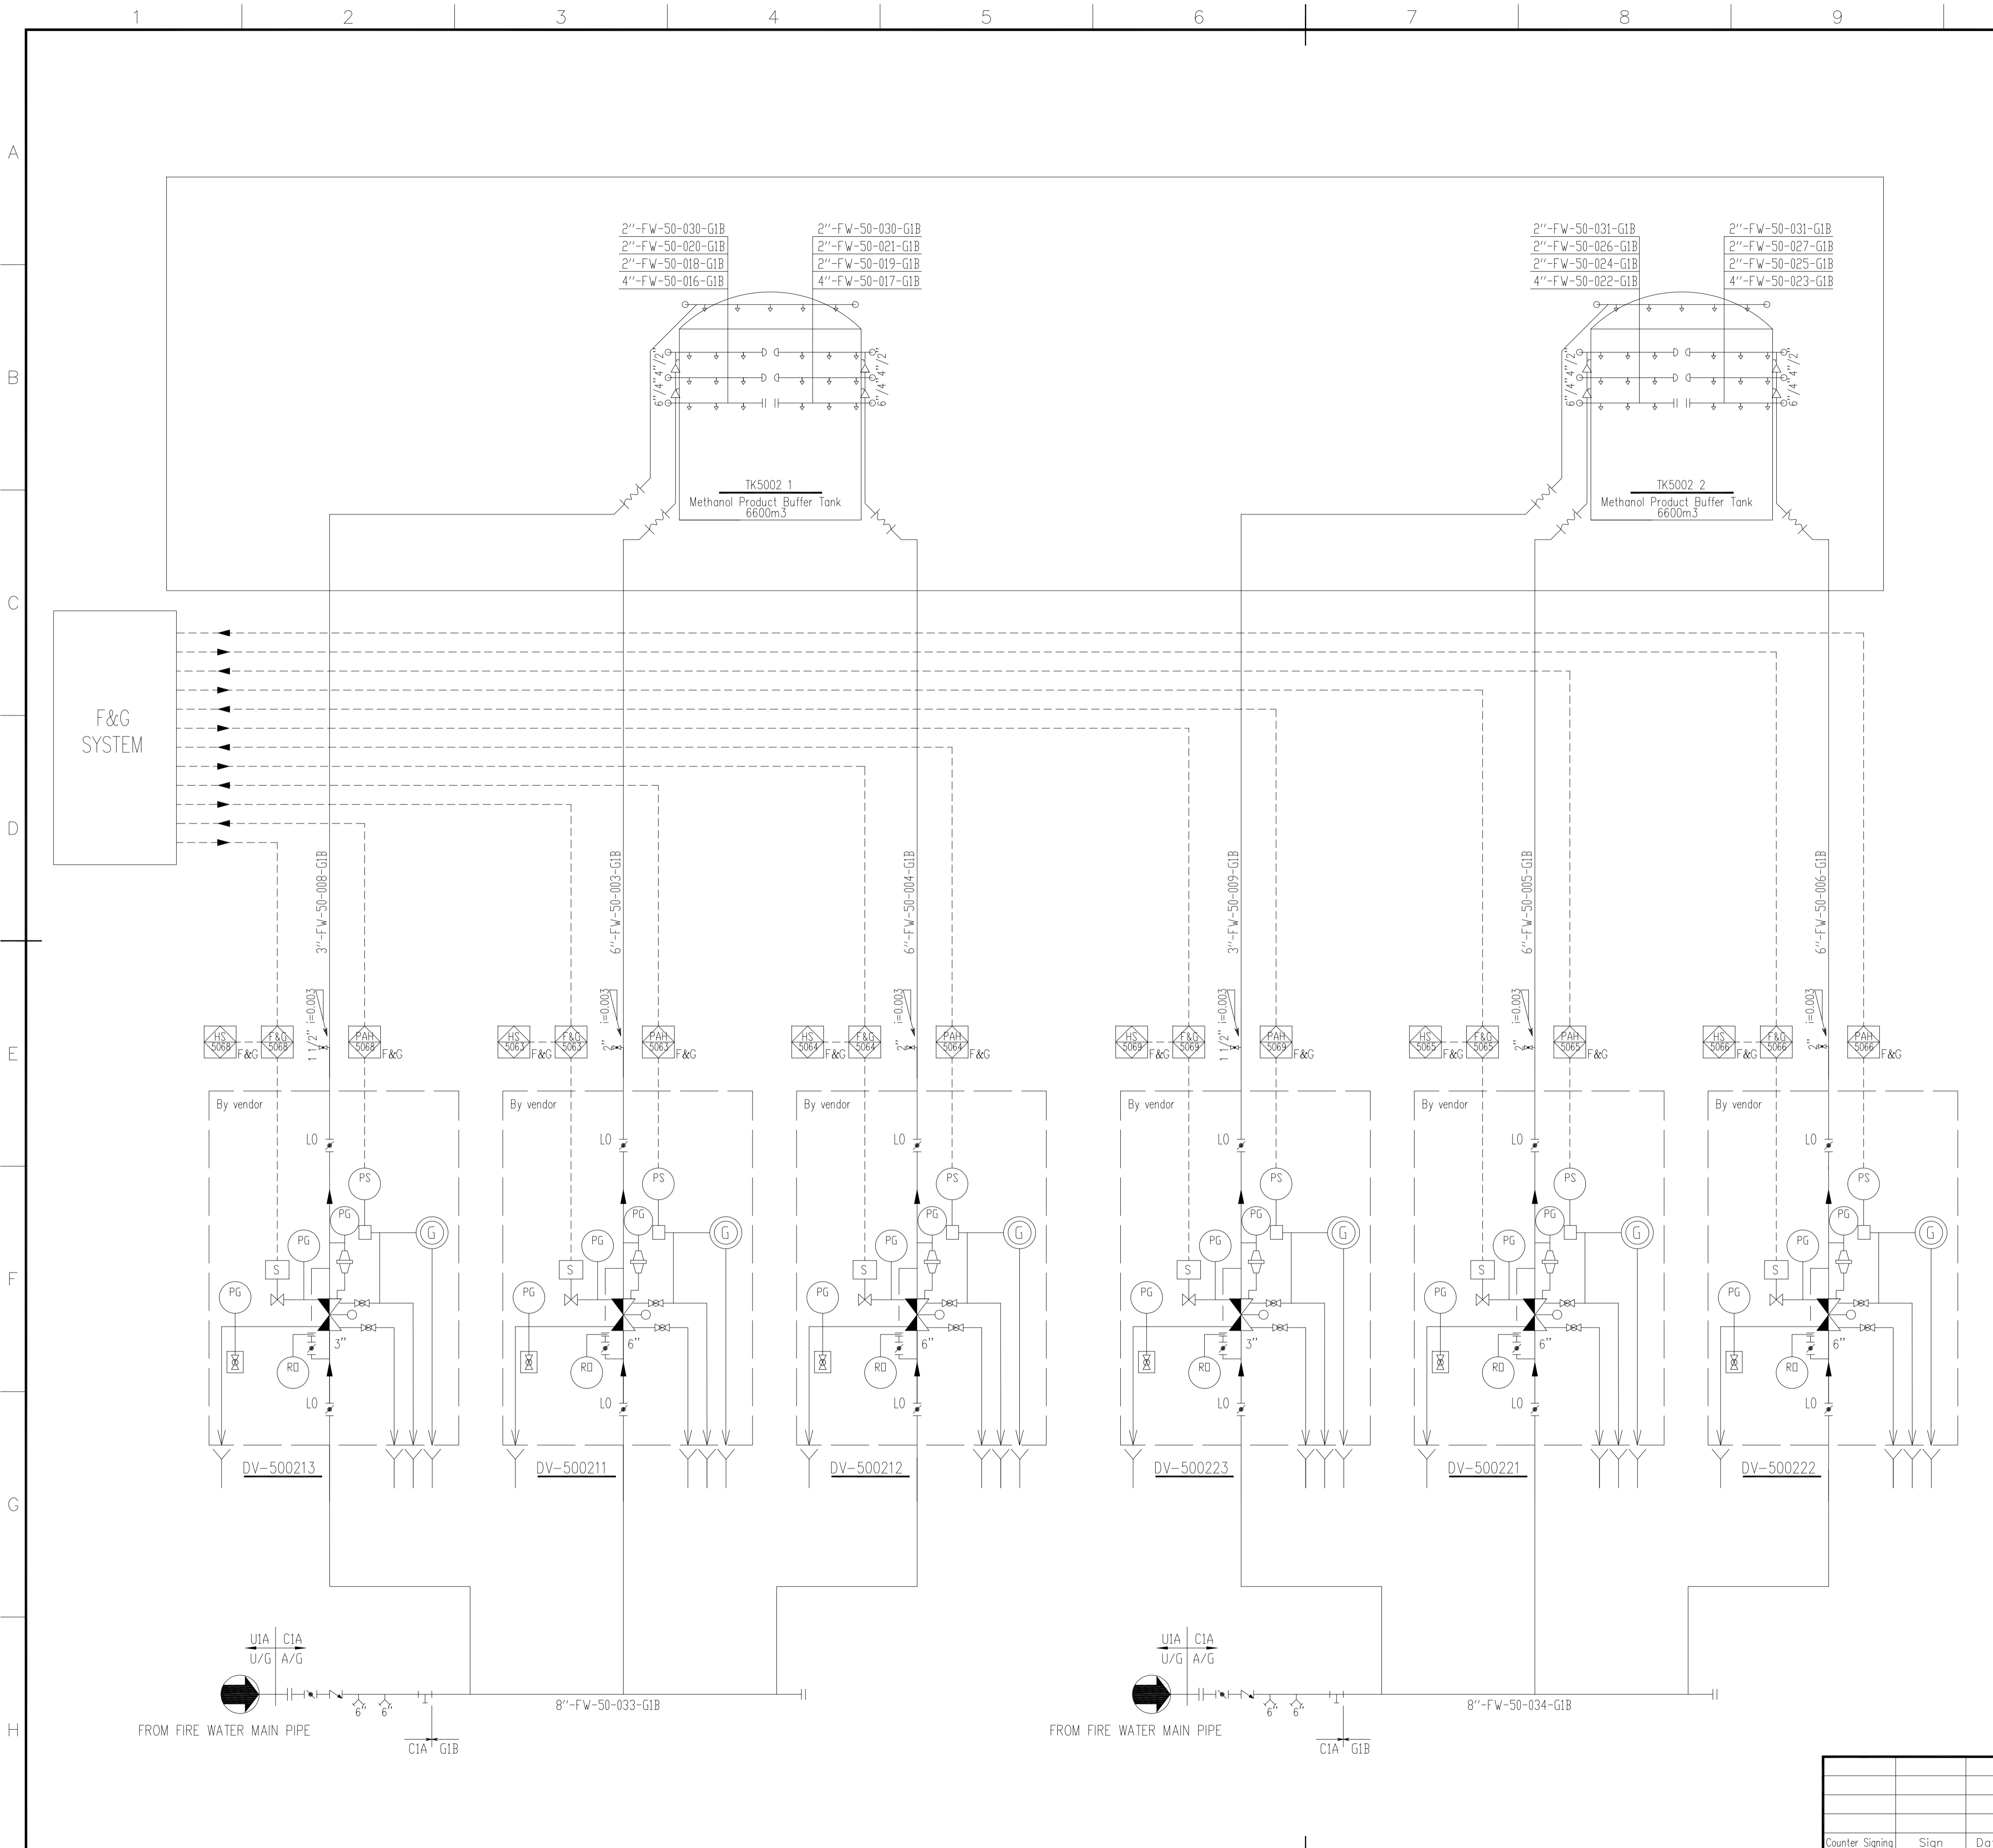

GENERAL NOTES

PIPE NUMBER

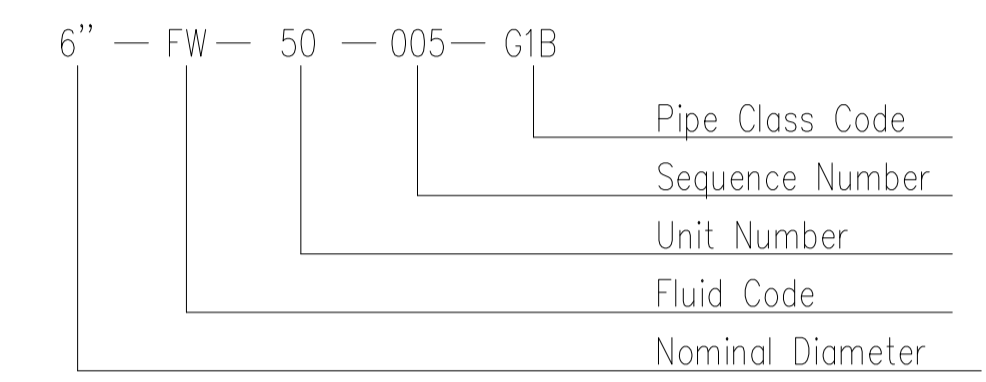

REFERENCE DRAWINGS

MKP-11-DE-9700-SF-SPC-001	MKP-11-DE-5000-PI-PPL-019
MKP-11-DE-9000-IN-CED-001	

SYMBOLS AND LEGENDS

	spray nozzle		deluge valve
FW	fire fighting water		T type strainer
	metal hose		butterfly valve
	globe valve		ball valve
	water motor gong		check valve
	vacuum stiff. ring		blind flange
	pipe gap		emergency release
	pressure operated relief valve(P.O.R.V.)		

As built	30.04.2020	Liu Jian	Cui Yanjun	Deng Wenhui
Approved for Construction	15.03.2017	Li Yang	Cui Yanjun	Deng Wenhui
Approved for Construction	16.12.2016	Li Yang	Cui Yanjun	Deng Wenhui
Approved for Construction	23.09.2016	Li Yang	Cui Yanjun	Deng Wenhui

THIS DOCUMENT IS THE PROPERTY OF TCC. NO PART OF THIS DOCUMENT SHALL BE REPRODUCED OR DISCLOSED TO OTHERS OR USED FOR ANY PURPOSE WHATSOEVER EXCEPT WITH THE PRIOR WRITTEN PERMISSION OF TCC.

OWNER: Middle East Kimiaye Pars Company

CONTRACTOR	HALDOR TOPSØE A/S	DOCUMENT NAME:		JOB NO.		DOC. GRP.		REV.	
CONTRACTOR		CONTRACTOR DRAWING NO.	MKP-11-AS-5000-PF03-PID-002	SHEET	01	TOTAL	01		


CONTRACTOR		SUB-CONTRACTOR DRAWING NO.		SHEET	-	TOTAL	-
------------	--	----------------------------	--	-------	---	-------	---

PROJECT	MKP Methanol Project
UNIT	Distillation Unit
PHASE	As built drawing
OWNER DWG NO.	MKP-11-AS-5000-SF-PID-002

SCALE	N/A	SHEET	2	TOT.	2	SIZE	A1
-------	-----	-------	---	------	---	------	----

Counter	Sign	Date
---------	------	------



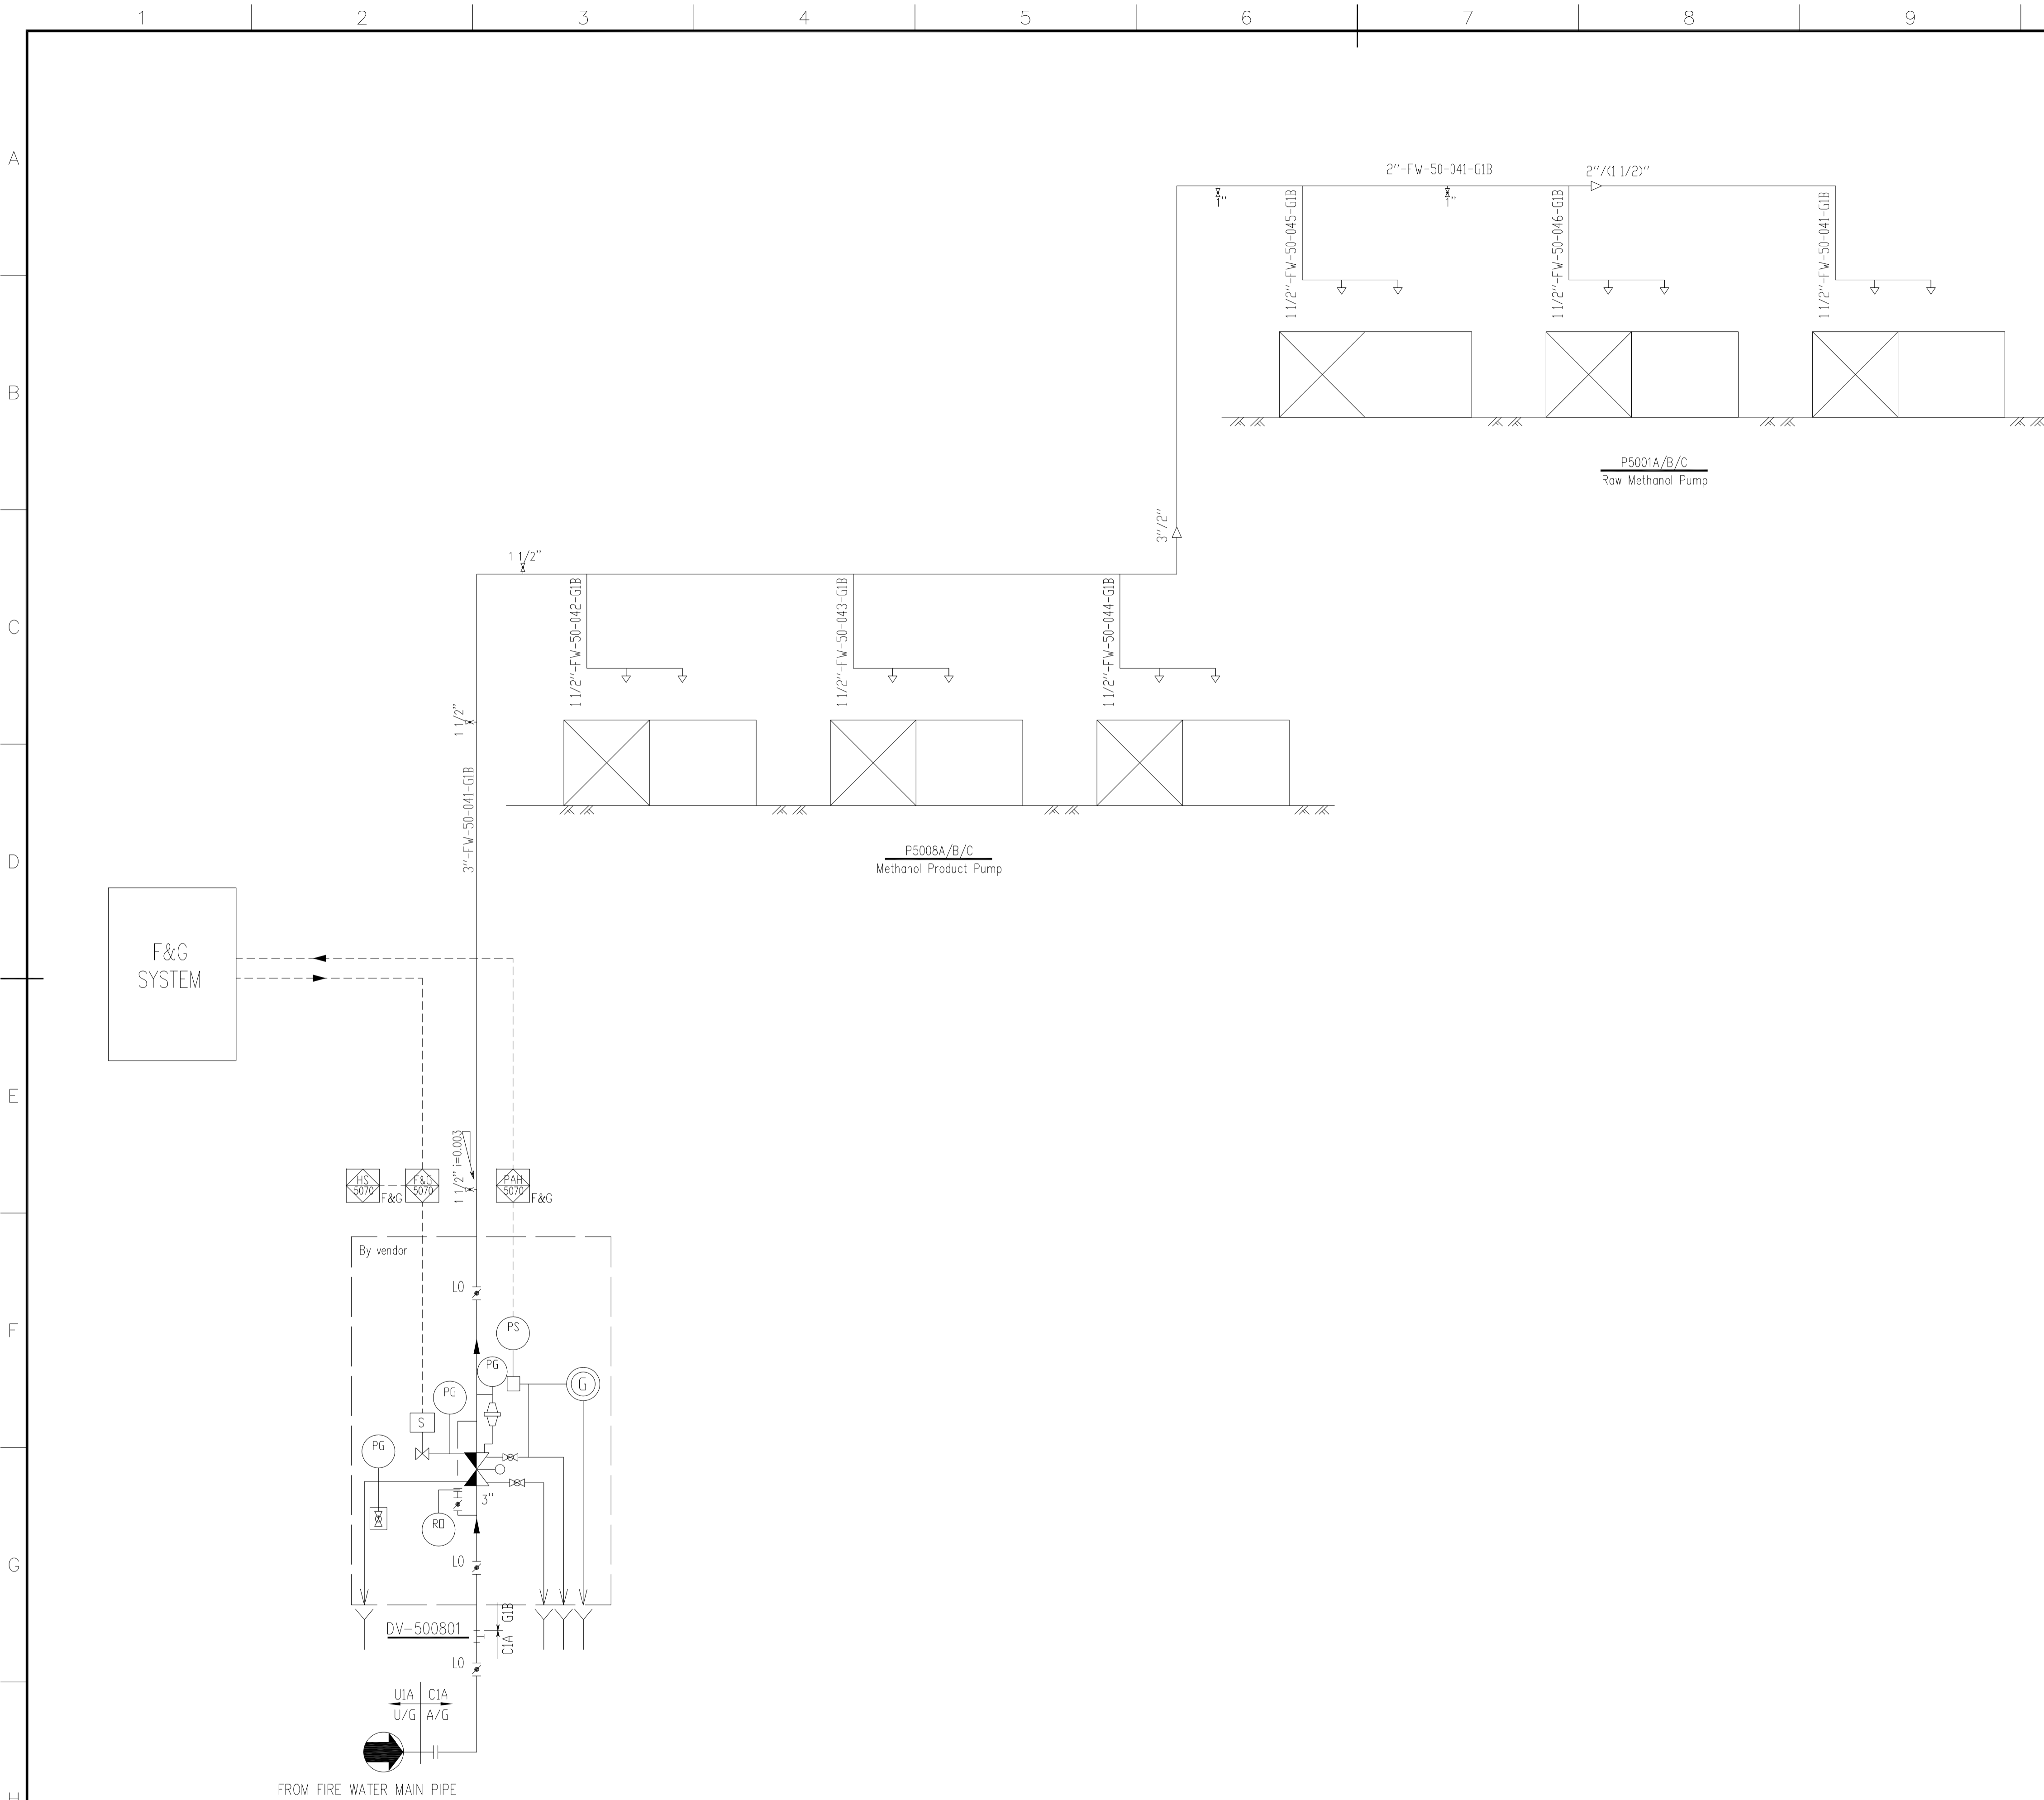


**GENERAL NOTES**

1. THE PIPE SHALL BE SLOPED TO THE DRAIN POINT, THE PIPE SHALL BE DRAINED BY DRAIN VALVE AFTER BEING USED.
2. DELUGE VALVE SHALL BE LOCATED AT A MINIMUM DISTANCE OF 15m AWAY FROM PROTECTED EQUIPMENT.
3. DOWN STREAM OF DELUGE VALVE SHALL BE CONSIDERED AS DRY SECTION AND FACILITIES SHALL BE PROVIDED TO DRAIN THE DRY PIPING AFTER OPERATION.

**DESIGN PRAMETER FOR SPRAY SYSTEM**

DELUGE VALVE		DV-500801					
EQP.NO.	P5008A	P5008B	P5008C	P5001A	P5001A	P5001A	
AREA (m <sup>2</sup> )	4.2	4.2	4.2	2.9	2.9	2.9	
INTENSITY (L/min.m <sup>2</sup> )	20.40	20.40	20.40	20.40	20.40	20.40	
SUPPLY POWER (L/s)	14.4						
PRAMETER FOR NOZZLE	TYPE	MEDIUM-SPEED SPRAY SPRINKLER (CONE NOZZLE)					
	QUANTITY	2	2	2	2	2	
	K-FACTOR	42	42	42	42	42	
	MIN WORKING PRESSUR (MPa)	0.2	0.2	0.2	0.2	0.2	
	SPRAY ANGLE	90 °	90 °	90 °	90 °	90 °	
	DISTANCE ABOVE GROUND	2000mm	2000mm	2000mm	2000mm	2000mm	

**PIPE NUMBER**

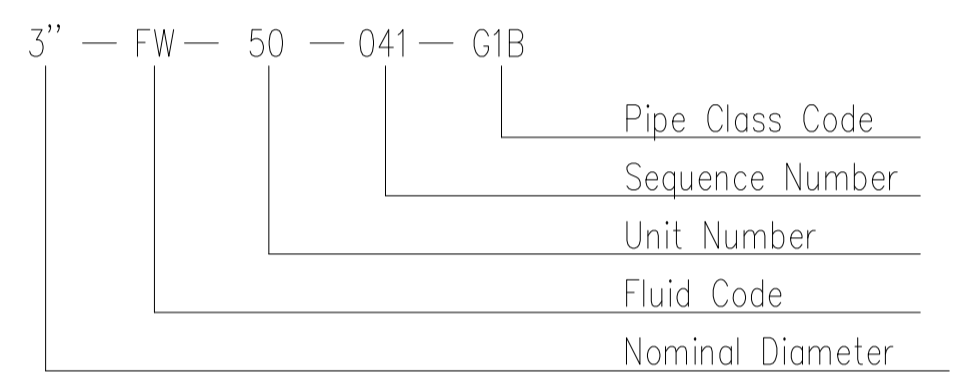

**REFERENCE DRAWINGS**

MKP-11-DE-9700-SF-SPC-001	MKP-11-DE-5000-PI-PPL-019
MKP-11-DE-9000-IN-CED-001	

**SYMBOLS AND LEGENDS**

↓	spray nozzle	⊗	deluge valve
FW	fire fighting water	┌┴┐	T type strainer
≡	pressure reducing orifice		butterfly valve
⊗	globe valve	⊗	ball valve
⊙	water motor gong	└┬┘	check valve
⊕	pressure operated relief valve(P.O.R.V.)	⊗	emergency release

△	As built	30.04.2020	Liu Jian		Cui Yanjun	Deng Wenhui
△	Approved For Construction	02.06.2017	Li Yang		Cui Yanjun	Deng Wenhui
△	Approved For Construction	15.03.2016	Li Yang		Cui Yanjun	Deng Wenhui
△	Approved For Construction	16.12.2016	Li Yang		Cui Yanjun	Deng Wenhui
△	Approved For Construction	31.10.2016	Li Yang		Cui Yanjun	Deng Wenhui

THIS DOCUMENT IS THE PROPERTY OF TCC. NO PART OF THIS DOCUMENT SHALL BE REPRODUCED OR DISCLOSED TO OTHERS OR USED FOR ANY PURPOSE WHATSOEVER EXCEPT WITH THE PRIOR WRITTEN PERMISSION OF TCC.


OWNER: Middle East Kimiaye Pars Company

LICENSOR	HALDOR TOPSØE A/S	DOCUMENT NAME:	JOB NO.	DOC. GRP.	REV.
CONTRACTOR	中国天辰工程有限公司	CONTRACTOR DRAWING NO.			
SUB-CONTRACTOR		MKP-11-AS-5000-PF03-PID-003			
		SHEET 01 TOTAL 01			
		SUB-CONTRACTOR DRAWING NO.			
		SHEET - TOTAL -			

P&ID FOR SPRINKLER SYSTEM FOR PUMPS IN UNIT 5003	PROJECT	MKP Methanol Project			
	UNIT	Distillation Unit			
	PHASE	As built drawing			
SCALE N/A	SHEET 1	TOT. 1	SIZE A1	OWNER DWG NO.	MKP-11-AS-5000-SF-PID-003

Counter Signing	Sign	Date



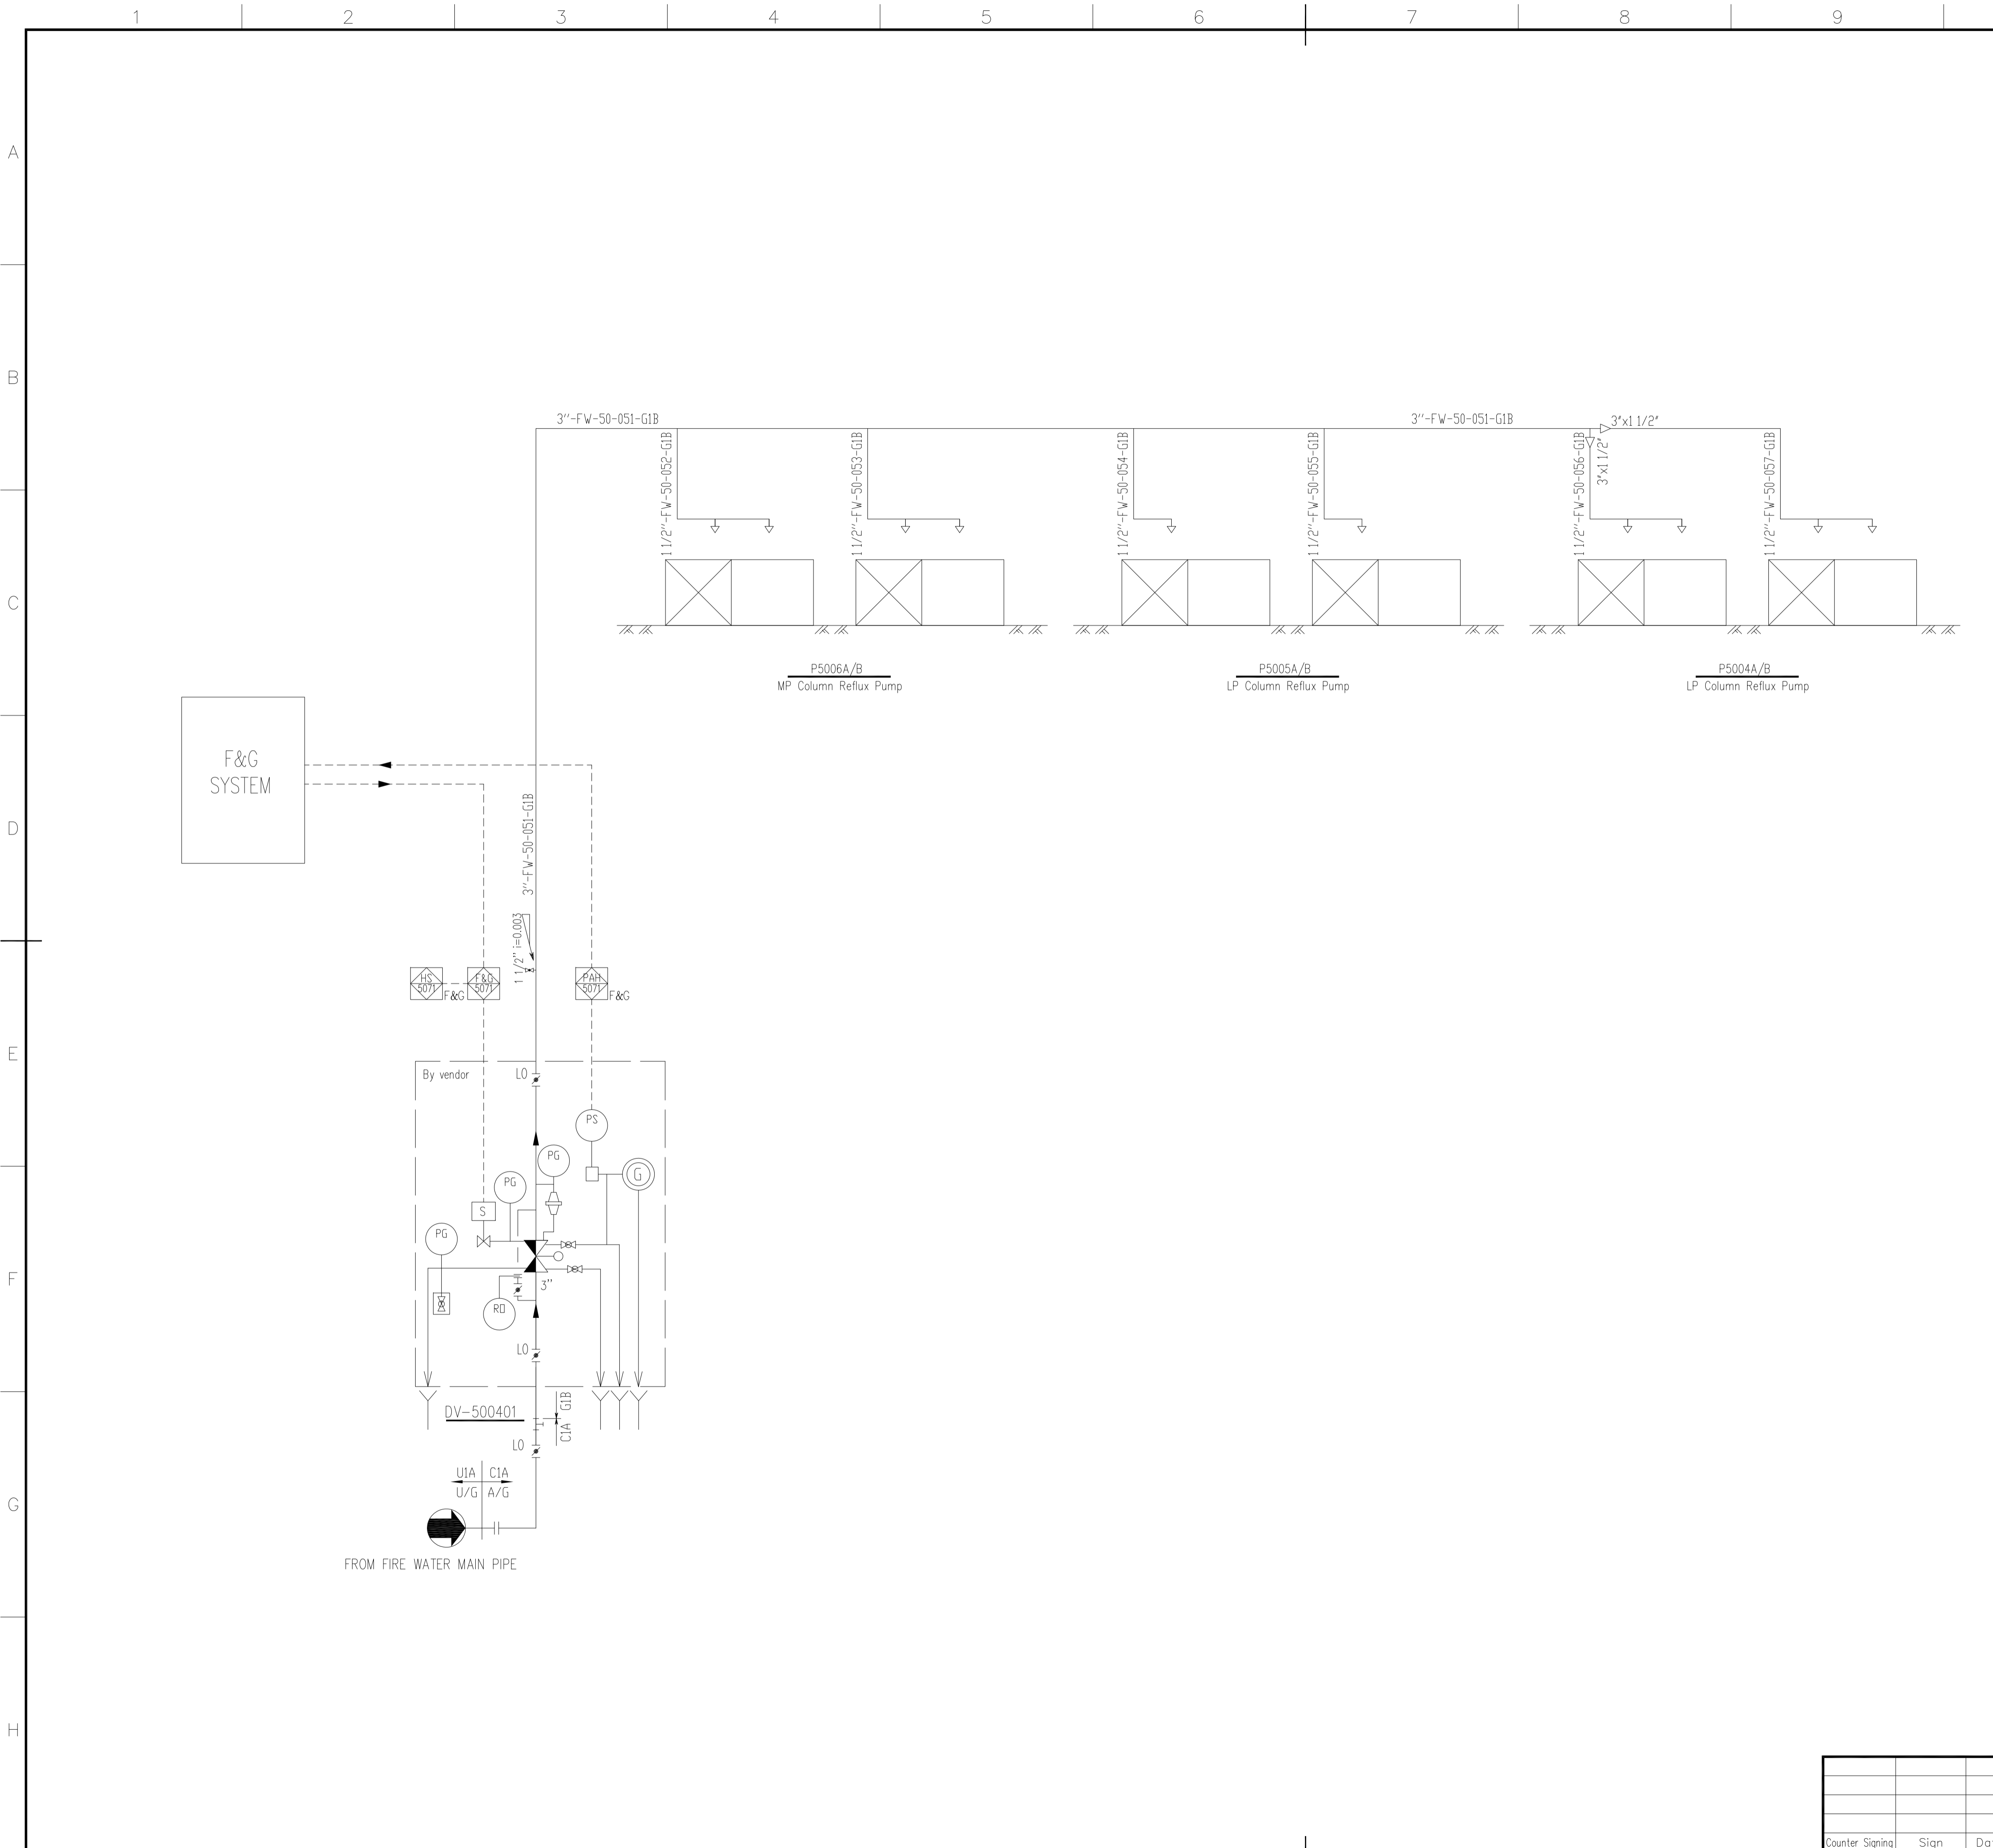


**GENERAL NOTES**

1. THE PIPE SHALL BE SLOPED TO THE DRAIN POINT . THE PIPE SHALL BE DRAINED BY DRAIN VALVE AFTER BEING USED .

**DESIGN PRAMETER FOR SPRAY SYSTEM**

DELUGE VALVE		DV-500401					
EQP.NO.	P5004A	P5004B	P5005A	P5005B	P5006A	P5006B	
AREA (m <sup>2</sup> )	8.5	8.5	3.0	3.0	8.5	8.5	
INTENSITY (L/min.m <sup>2</sup> )	20.40	20.40	20.40	20.40	20.40	20.40	
SUPPLY POWER (L/s)	13.2						
PRAMETER FOR NOZZLE	TYPE	MEDIUM-SPEED SPRAY SPRINKLER (CONE NOZZLE)					
	QUANTITY	2	2	1	1	2	2
	K-FACTOR	42	42	42	42	42	42
	MIN WORKING PRESSUR (MPa)	0.2	0.2	0.2	0.2	0.2	0.2
	SPRAY ANGLE	90°	90°	90°	90°	90°	90°
	DISTANCE TO EQUIPMENT BODY	1200mm	1200mm	1200mm	1200mm	1200mm	1200mm

**PIPE NUMBER**

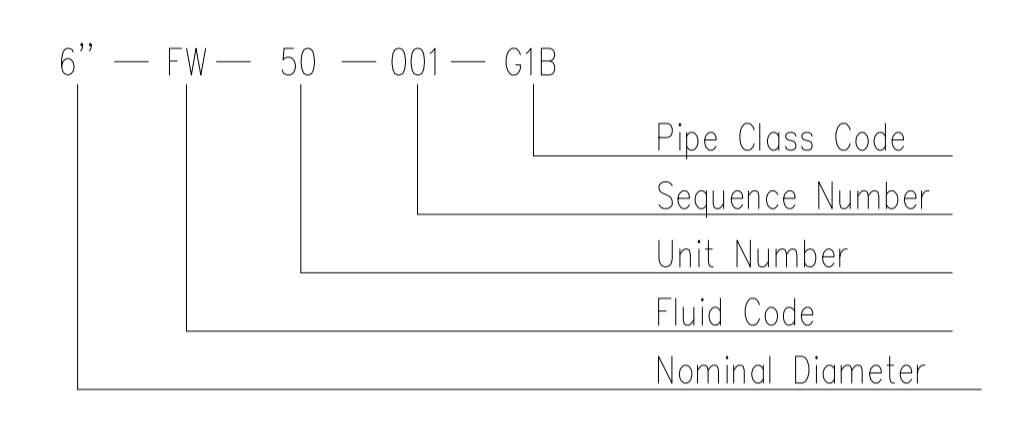

**REFERENCE DRAWINGS**

MKP-11-DE-9700-SF-SPC-001	MKP-11-DE-5000-PI-PPL-020
MKP-11-DE-9000-IN-CED-001	

**SYMBOLS AND LEGENDS**

▽	spray nozzle	⊗	deluge valve
FW	fire fighting water	⊥	T type strainer
≡	pressure reducing orifice	⊘	butterfly valve
⊘	globe valve	⊘	ball valve
⊘	water motor gong	⊘	check valve
⊘	pressure operated relief valve(P.O.R.V.)	⊘	emergency release

As built	30.04.2020	Liu Jian		Cui Yanjun	Deng Wenhui
Approved for Construction	04.06.2016	Liu Jian		Cui Yanjun	Deng Wenhui
Approved for Construction	15.03.2016	Liu Jian		Cui Yanjun	Deng Wenhui
Approved For Construction	12.12.2016	Liu Jian		Cui Yanjun	Deng Wenhui
Approved For Construction	31.10.2016	Liu Jian		Cui Yanjun	Deng Wenhui

THIS DOCUMENT IS THE PROPERTY OF TCC. NO PART OF THIS DOCUMENT SHALL BE REPRODUCED OR DISCLOSED TO OTHERS OR USED FOR ANY PURPOSE WHATSOEVER EXCEPT WITH THE PRIOR WRITTEN PERMISSION OF TCC.

OWNER: Middle East Kimiaye Pars Company

LICENSOR: HALDOR TOPSØE A/S	DOCUMENT NAME:	JOB NO.:	DOC. GRP.:	REV.:
CONTRACTOR: <b>TCC 中国天辰工程有限公司</b> CHINA TIANCHEN ENGINEERING CORPORATION	CONTRACTOR DRAWING NO.:	DATE:	DATE:	DATE:
SUB-CONTRACTOR LOGO:	MKP-11-AS-5000-PF03-PID-004			
	SHEET 01 TOTAL 01			
	SUB-CONTRACTOR DRAWING NO.:			
	SHEET - TOTAL -			

P&ID FOR SPRINKLER SYSTEM FOR PUMPS IN UNIT 5001	PROJECT	MKP Methanol Project		
	UNIT	Distillation Unit		
	PHASE	As built drawing		
SCALE N/A	SHEET 1	TOT. 1	SIZE A1	OWNER DWG NO. MKP-11-AS-5000-SF-PID-004


Counter Signing	Sign	Date

P 6002 A/B		STEAM CONDENSATE RETURN PUMP		P 6002 C		STEAM CONDENSATE RETURN PUMP	
RATED CAPACITY	351.6	m <sup>3</sup> /h		RATED CAPACITY	157	m <sup>3</sup> /h	
HEAD	155.7	m		HEAD	322	m	
DENSITY@DOT	814	kg/m <sup>3</sup>		DENSITY@DOT	653	kg/m <sup>3</sup>	
INSULATION/TRACING	NONE			INSULATION/TRACING	NONE		
AUXILIARY PIPING	By Vendor			AUXILIARY PIPING	By Vendor		
ELEV. OF EQUIPMENT	EL. +101.230m			ELEV. OF EQUIPMENT	EL. +101.230m		

**GENERAL NOTES**

†GENERAL NOTE:  
LOW POINT DRAINS AND HIGH POINT VENT MUST BE ADDED DURING DETAILED ENGINEERING.

†NOTES:  
1) TWO PHASE FLOW.  
2) LV-6021 B MUST BE LOCATED AS CLOSE AS POSSIBLE TO D-7001. ELEVATION ABOVE D 7001.  
3) THE SPARE PUMP OF P 6002 AB WOULD AUTOSTART WHEN THE OUTLET PRESSURE DECREASED.  
4) FUNCTION OF LICA-6021.  
VALVE OPENING, %  
  
 6) P 6002 C JUST FOR STARTUP CASE.

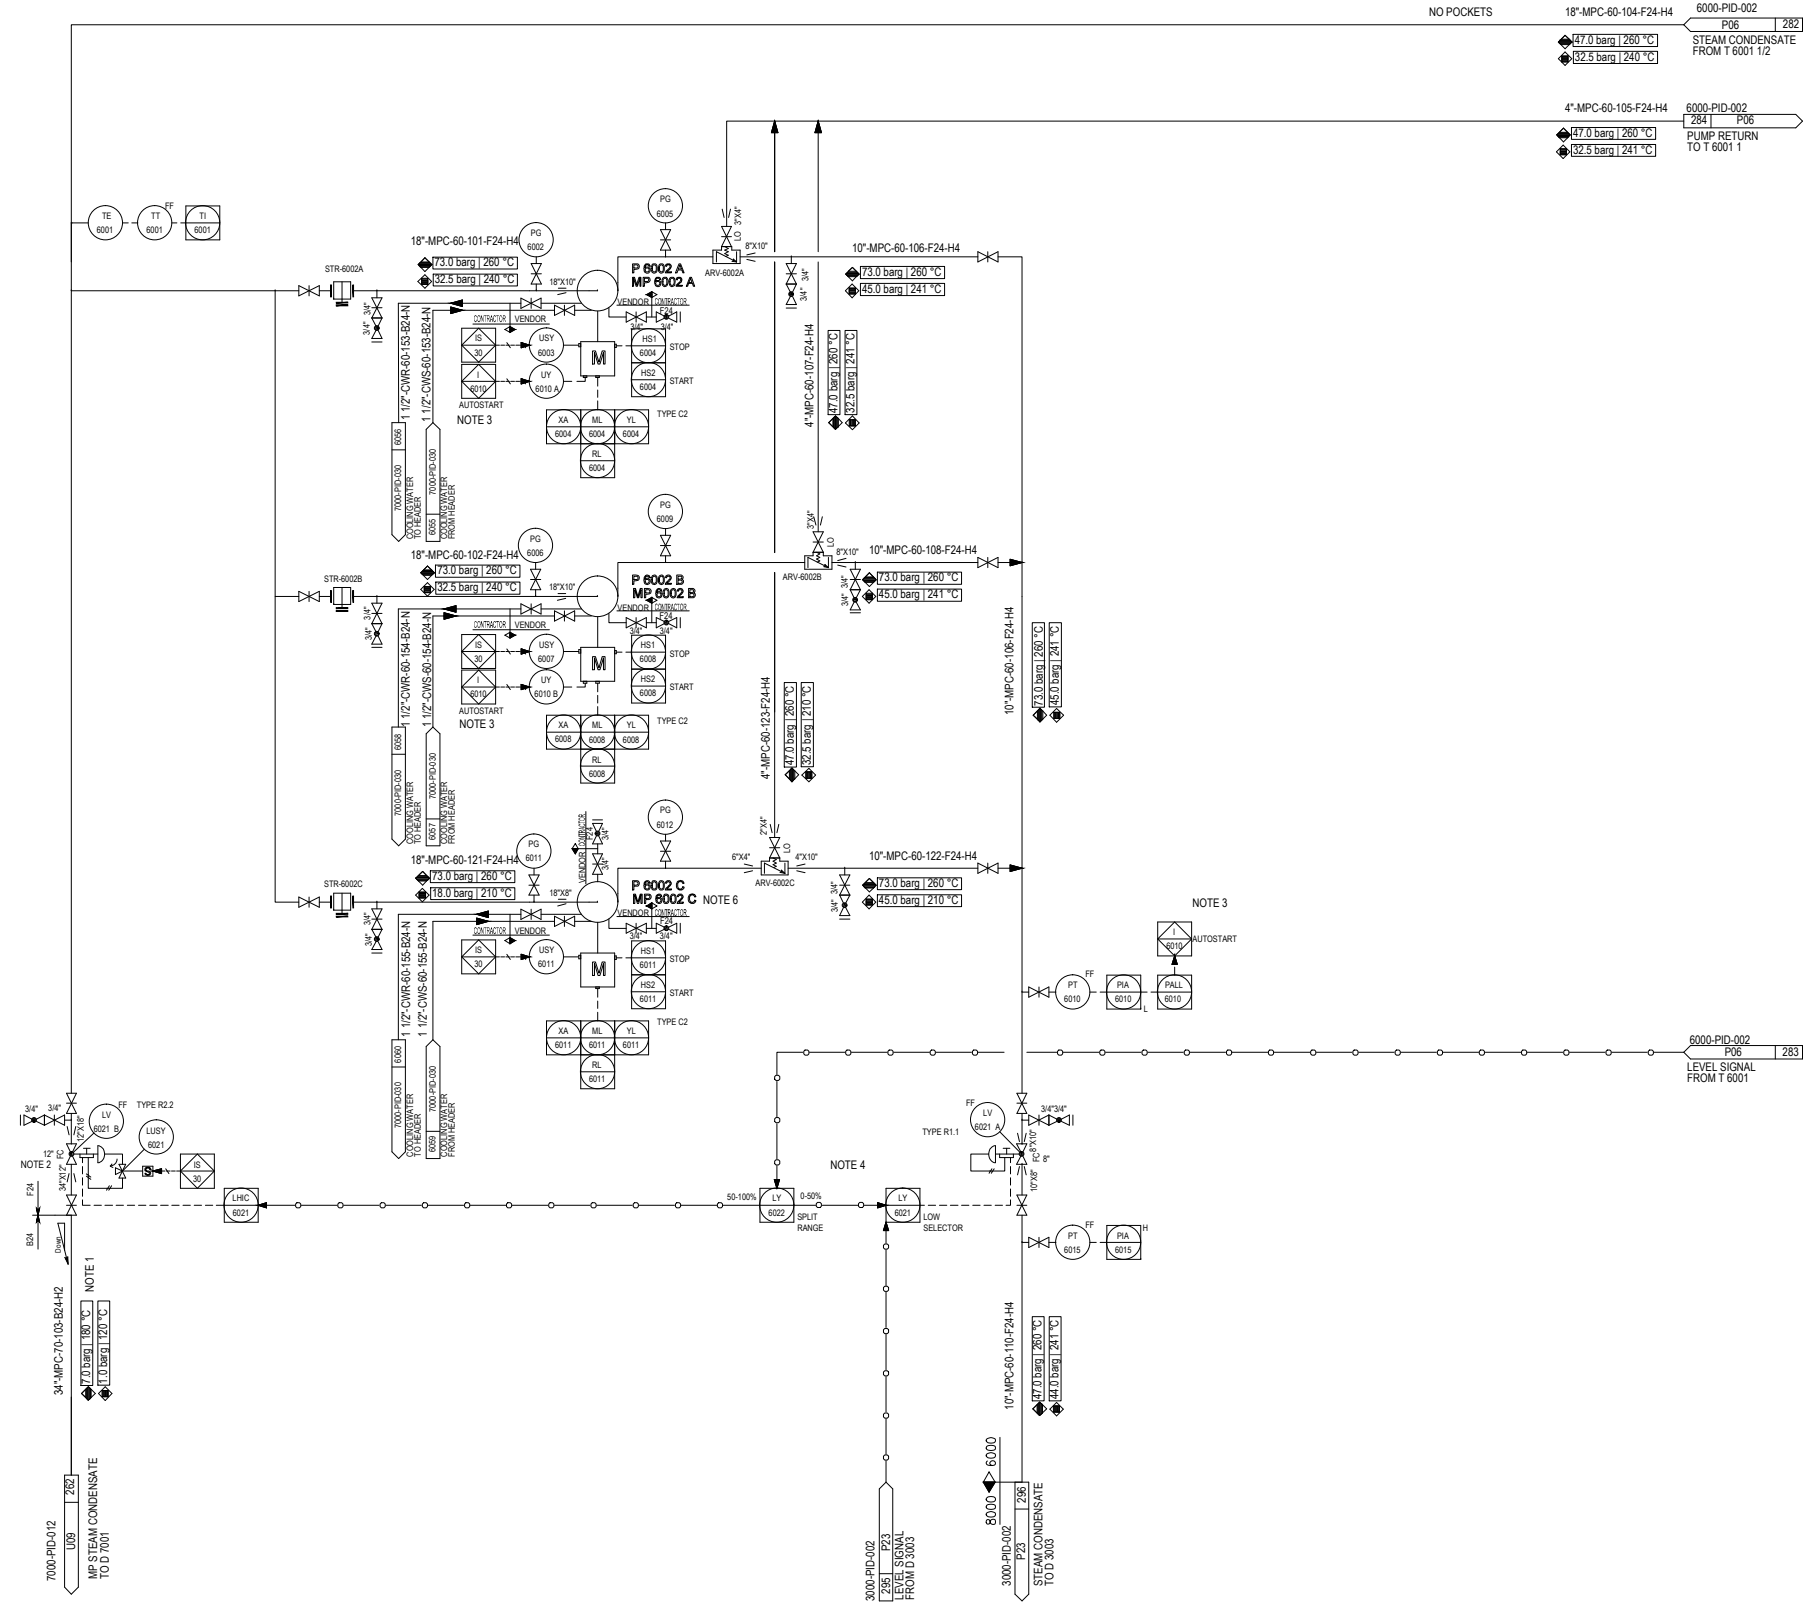

**REFERENCE DRAWINGS**

**SYMBOLS AND LEGENDS**

**KEY PLAN**

REV.	PURPOSE OF ISSUE	DATE	DESIGN	DRAW	CHECK	REVIEW	APPROVE
▲	As Built	30.04.2020	Xu Yekun		Xu Hong	Liu Shengkol	
▲	Approved for Construction	30.12.2019	Xu Yekun		Xu Hong	Liu Shengkol	
▲	Approved for Construction	02.01.2018	Xu Yekun		Xu Hong	Liu Shengkol	
▲	Approved for Construction	06.11.2017	Xu Yekun		Xu Hong	Liu Shengkol	
▲	Approved for Construction	05.05.2017	Xu Yekun		Xu Hong	Shi Jing	
▲	Approved for Construction	22.03.2017	Xu Yekun		Xu Hong	Shi Jing	
▲	Approved for Construction	22.01.2017	Xu Yekun		Xu Hong	Shi Jing	
▲	Approved for Construction	13.10.2016	Xu Yekun		Xu Hong	Shi Jing	
▲	Issued for Approval	31.08.2016	Xu Yekun		Xu Hong	Shi Jing	
▲	Issued for Approval	25.06.2016	Xu Yekun		Xu Hong	Shi Jing	
▲	Issued for Comments	29.04.2016	Xu Yekun		Xu Hong	Shi Jing	

THIS DOCUMENT IS THE PROPERTY OF TCC. NO PART OF THIS DOCUMENT SHALL BE REPRODUCED OR DISCLOSED TO OTHERS OR USED FOR ANY PURPOSE WHATSOEVER EXCEPT WITH THE PRIOR WRITTEN PERMISSION OF TCC.

OWNER:  
  
 Middle East  
 Kimiaye Pars Company

REVISION	DATE	BY	CHK	APP	REV.
1	30.04.2020	Xu Yekun		Xu Hong	Liu Shengkol

CONTRACTOR DRAWING NO.  
 MKP-11-AS-6000-PS07-PID-001  
 SHEET 01 TOTAL 01  
 SUB-CONTRACTOR DRAWING NO.  
 SHEET -- TOTAL --

PROJECT	MKP Methanol Project
UNIT	Saturator Unit
PHASE	As Built Drawing
OWNER DWG. NO.	MKP-11-AS-6000-PR-PID-001


Counter	Sign	Date
---------	------	------

T 6001 1/2	SATURATOR
DUTY	124.1 MW
DESIGN PRESS.(TU/SH)	55/7V-45 barg
DESIGN TEMP.(TU/SH)	290/300 °C
INSULATION	YES
ELEV. OF EQUIPMENT	EL. +101.240m

X 6001A/B	PARTICLE FILTER
FILTER SURFACE	N/A m <sup>2</sup>
CAPACITY	178000 kg/hr
DESIGN PRESS.	71 barg
DESIGN TEMP.	200 °C
MATERIAL SHELL	SS
MATERIAL FILTER ELEMENT	SS
ELEV. OF EQUIPMENT	EL. +101.250m

L 6001	HOIST 6001
TYPE	CHAIN HOIST
CAPACITY	3 t
LIFT HEIGHT	6 m
SLIDING DISTANCE	7 m

### GENERAL NOTES

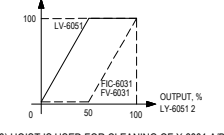- \*GENERAL NOTE:  
LOW POINT DRAINS AND HIGH POINT VENT MUST BE ADDED DURING DETAILED ENGINEERING.
- \*NOTES:  
1) SYMMETRICAL PIPING  
2) 1/2" DRIP HOLE TO BE DRILLED AT LOW POINT TO SAFE AND SUITABLE LOCATION.  
3) TWO PHASE FLOW.  
4) STEAM TRAPS TO BE PROVIDED AT LOW POINTS.  
5) NOZZLE B2 ON T 6001 1/2 MUST BE ELEVATED MIN. 4 m ABOVE P 6002 AB. TO BE CONFIRMED BY VENDOR.  
6) T 6001 1/2 MUST BE LOCATED AT SAME ELEVATION. NOZZLE B2 ON T 6001 1/2 MUST BE LOCATED MIN. 4m ABOVE P 6002 AB. TO BE CONFIRMED BY VENDOR.  
7) FUNCTION OF LY-6051 2.  

  
8) HOIST IS USED FOR CLEANING OF X 6001 AB.  
9) AS PER EQUIPMENT ENGINEER AND VENDOR'S SUGGESTION, THE VENT NOZZLE OF T 6001 1/2 (V1) ARE MOVED TO THE HIGHEST POINT OF T 6001 1/2 SHELL SIDE TO INCREASE VENTING PERFORMANCE. SINCE THE SPACE IS VERY LIMITED, THE VENT NOZZLE (V1, V2) IS SEPARATED TO TWO NOZZLES (V1 AND V3, V1').

### REFERENCE DRAWINGS

### SYMBOLS AND LEGENDS

### KEY PLAN


REV.	PURPOSE OF ISSUE	DATE	DESIGN	DRAW	CHECK	REVIEW	APPROVE
▲	As Built	30.04.2020	Xu Yekun	Xu Hong	Liu Shengkol		
▲	Approved for Construction	30.12.2019	Xu Yekun	Xu Hong	Liu Shengkol		
▲	Approved for Construction	13.12.2018	Xu Yekun	Xu Hong	Liu Shengkol		
▲	Approved for Construction	06.11.2017	Xu Yekun	Xu Hong	Liu Shengkol		
▲	Approved for Construction	05.05.2017	Xu Yekun	Xu Hong	Shi Jing		
▲	Approved for Construction	22.03.2017	Xu Yekun	Xu Hong	Shi Jing		
▲	Approved for Construction	22.01.2017	Xu Yekun	Xu Hong	Shi Jing		
▲	Approved for Construction	13.10.2016	Xu Yekun	Xu Hong	Shi Jing		
▲	Issued for Approval	31.08.2016	Xu Yekun	Xu Hong	Shi Jing		
▲	Issued for Approval	25.06.2016	Xu Yekun	Xu Hong	Shi Jing		
▲	Issued for Comments	29.04.2016	Xu Yekun	Xu Hong	Shi Jing		

OWNER: Middle East Kimiaye Pars Company


HALDOR TOPSØE A/S	DOCUMENT NAME: NG SATURATION I PIPING AND INSTRUMENT DIAGRAM	PROJ NO: S-02115	REV: 42
TCC 中国天辰工程技术有限公司	CONTRACTOR DRAWING NO. MKP-11-AS-6000-PS07-PID-002	SHEET: 01	TOTAL: 01
SUB-CONTRACTOR DRAWING NO.		SHEET: -- TOTAL: --	

PROJECT	MKP Methanol Project
UNIT	Saturator Unit
PHASE	As Built Drawing
OWNER DWG NO.	MKP-11-AS-6000-PR-PID-002

SCALE: -- SHEET: 1 TOT: 1 SIZE: A1

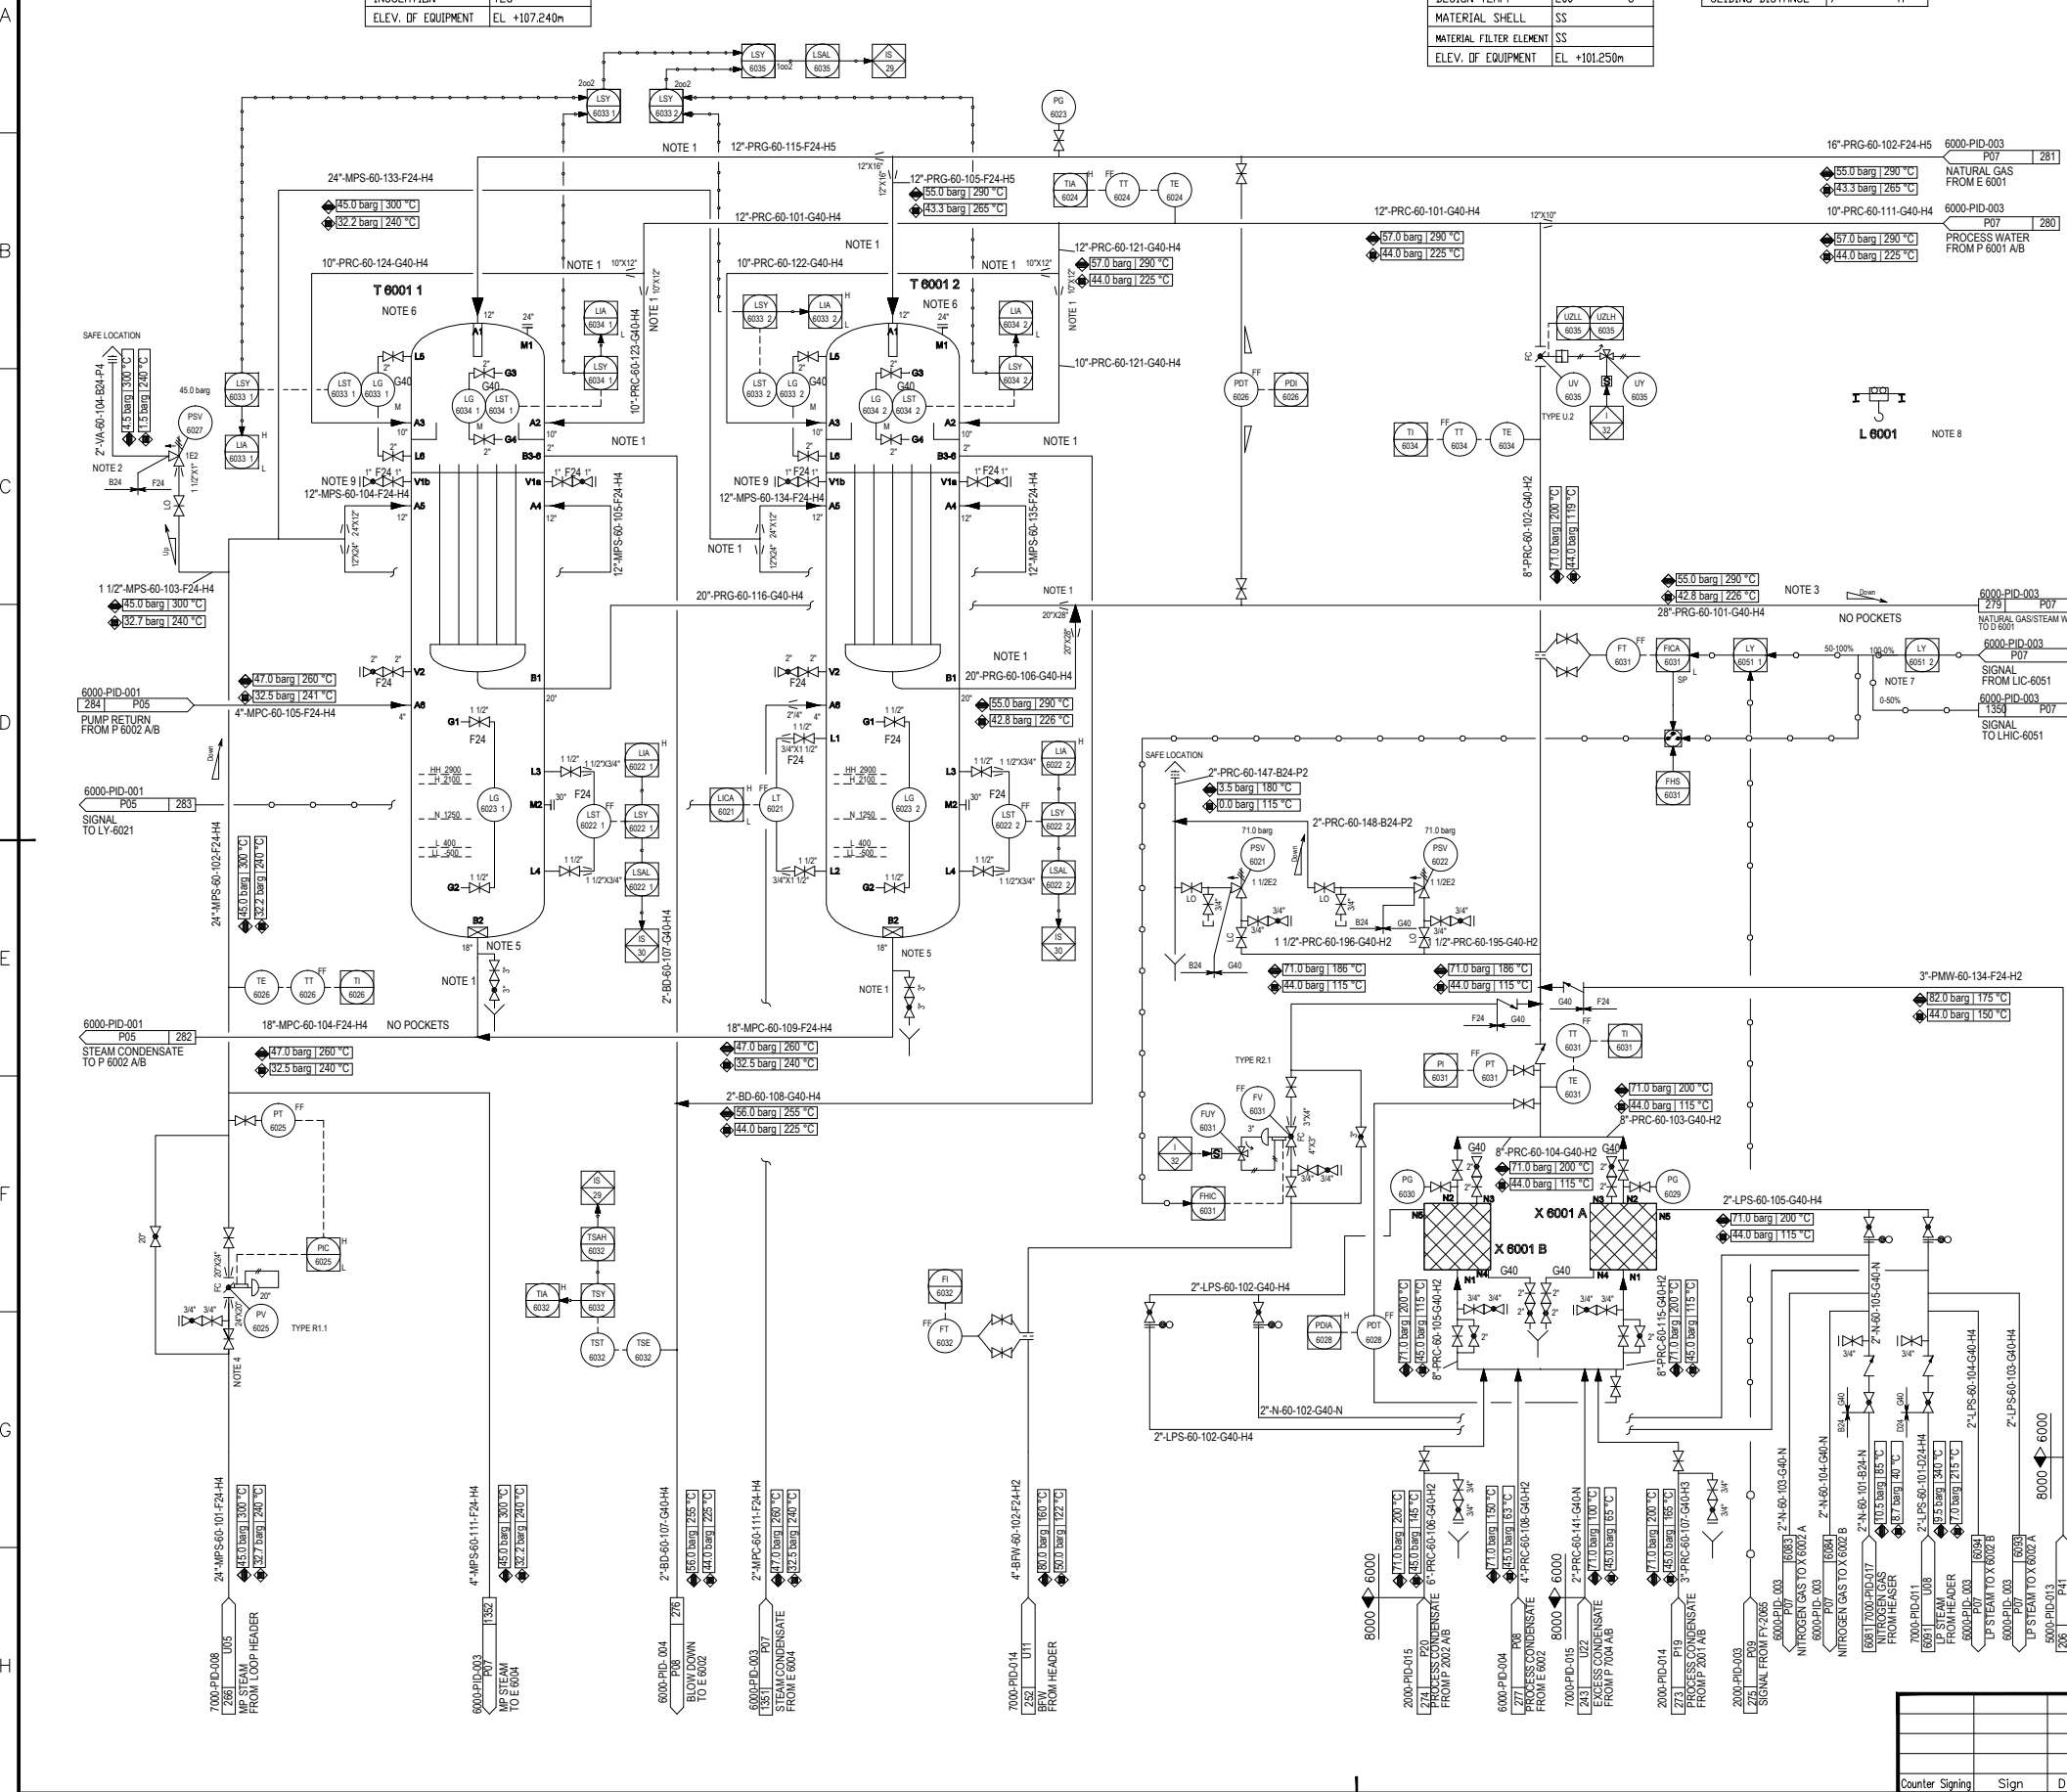

Counter Signing Sign Date

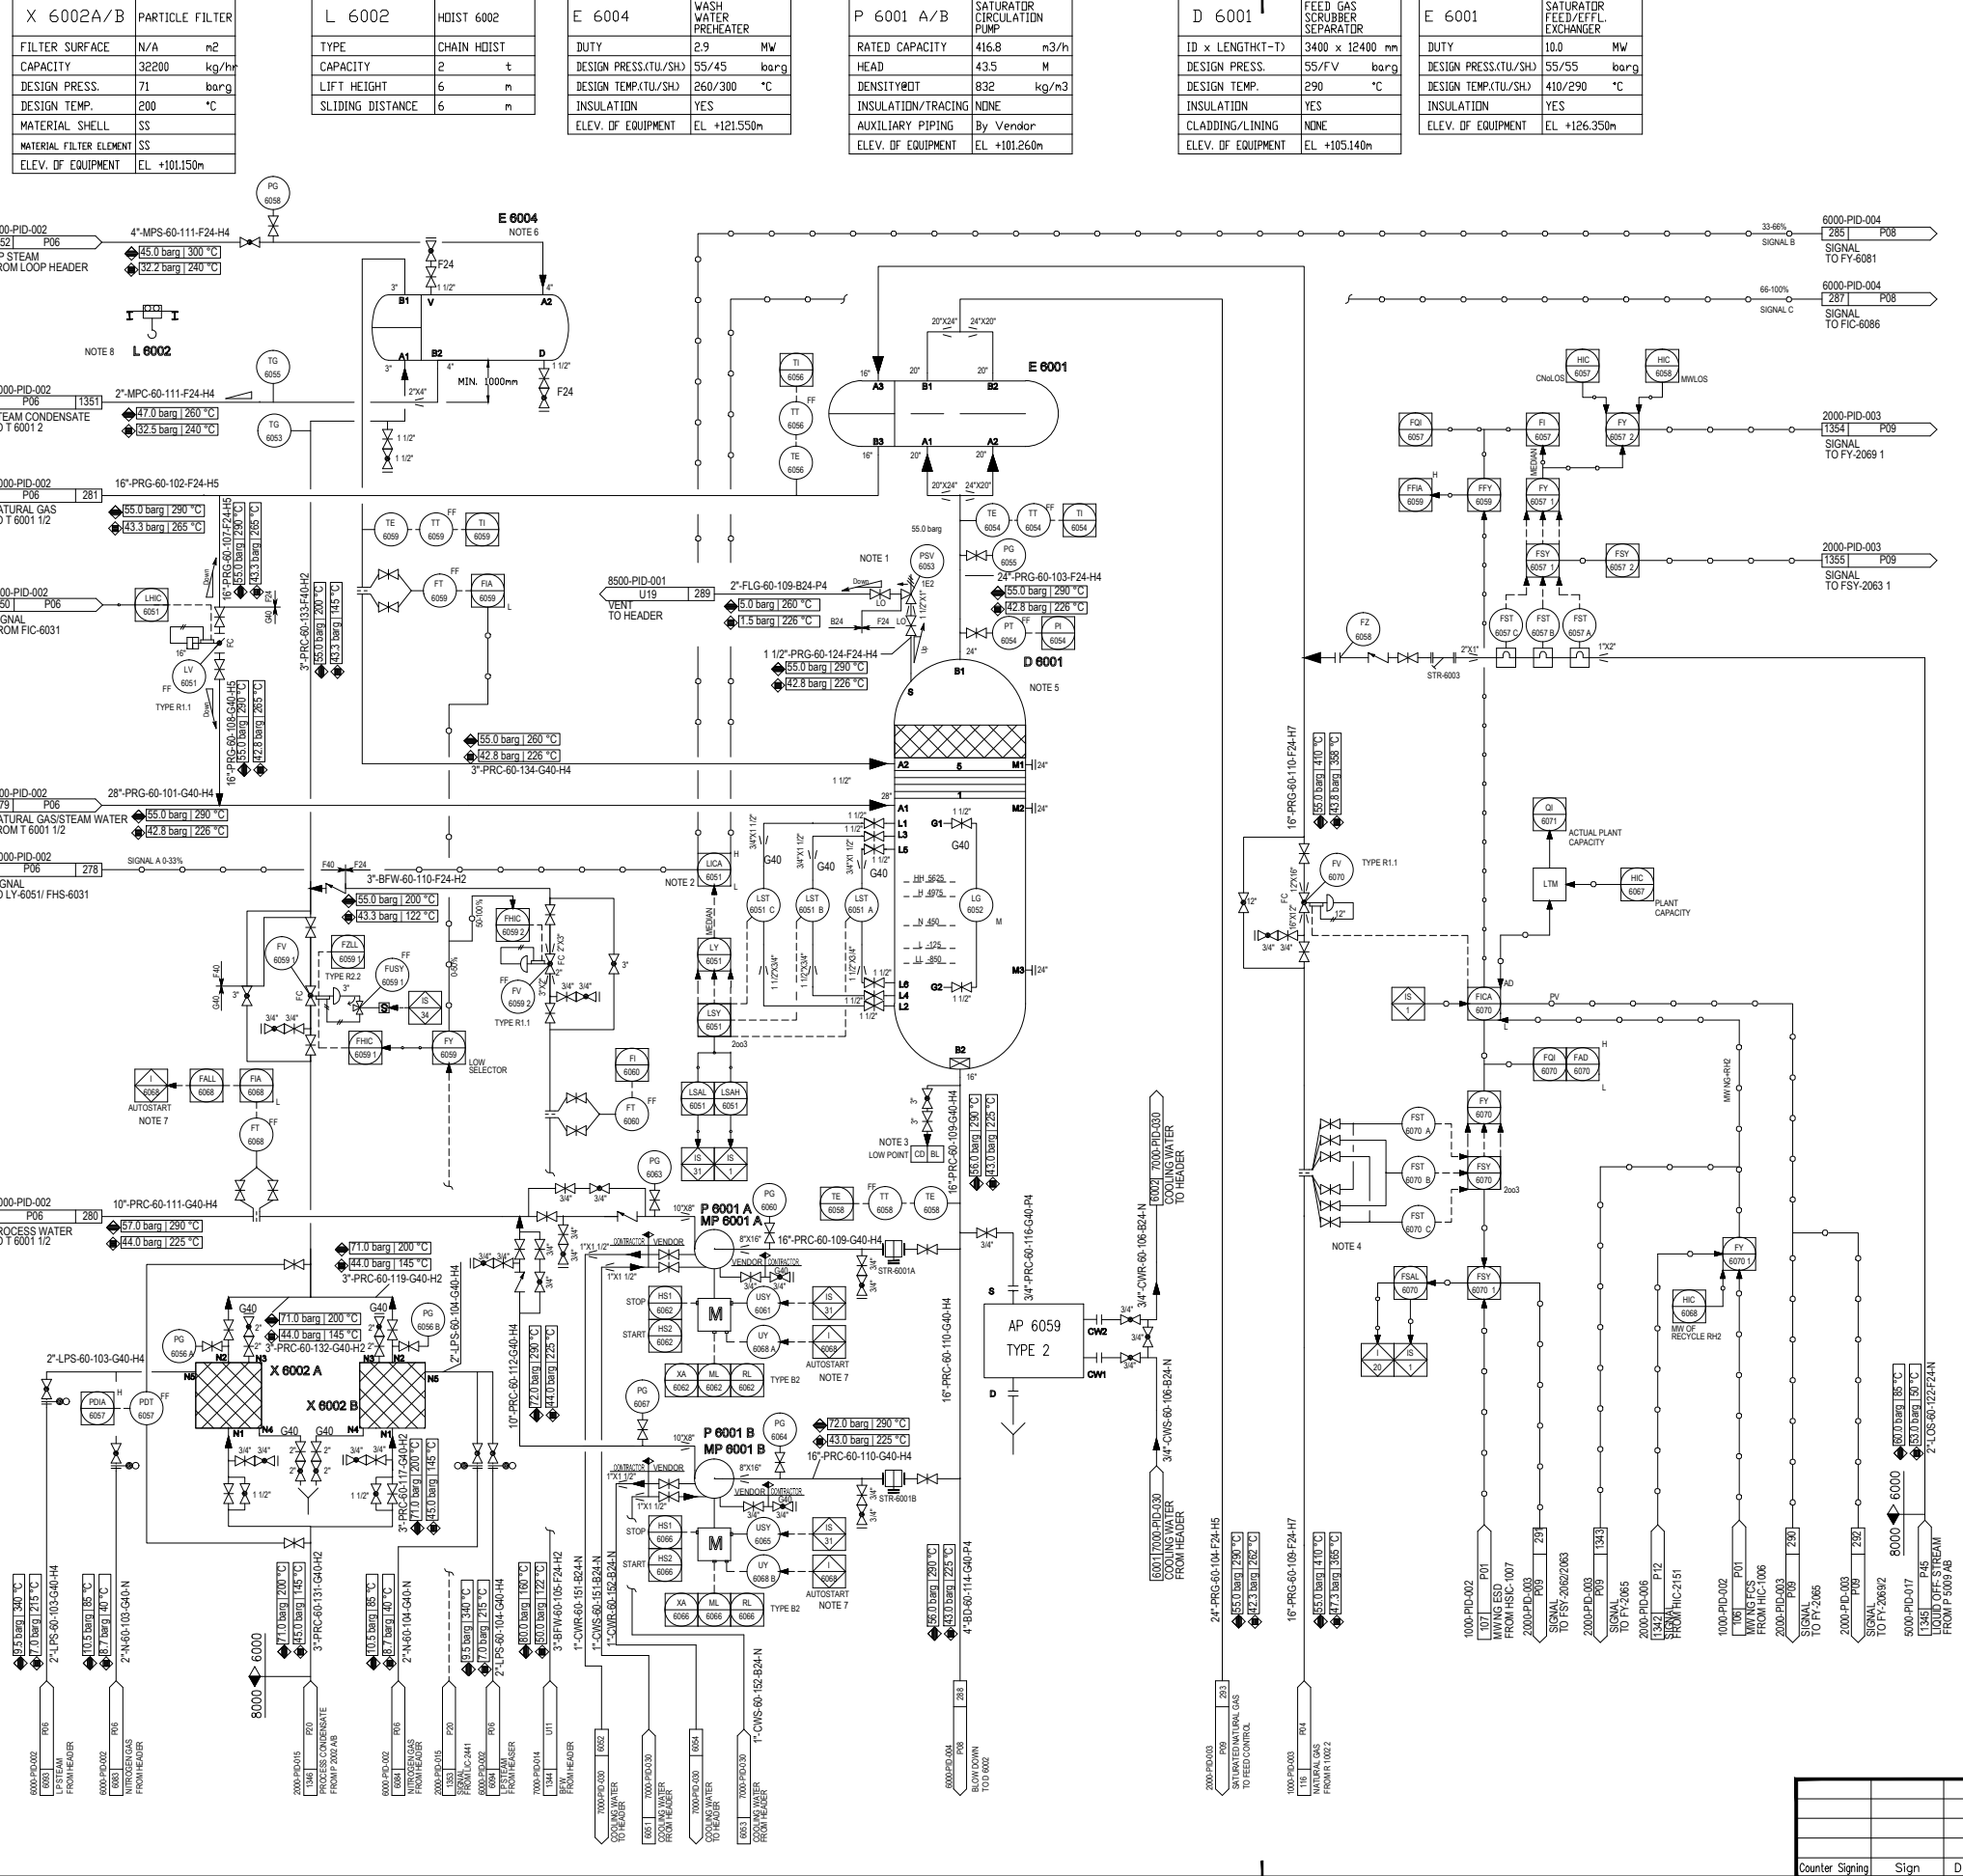

**GENERAL NOTES**

- GENERAL NOTE:  
LOW POINT DRAINS AND HIGH POINT VENT MUST BE ADDED DURING DETAILED ENGINEERING.
- NOTES:  
1) TO BE LOCATED ABOVE FLARE HEADER.  
2) FUNCTION OF LIC-6051
- 
- 3) THE CLOSED DRAIN WILL BE COLLECTED IN A PORTABLE SEALED CONTAINER.  
4) P&T COMPENSATION FROM PIC-1045, T-1045; MW COMPENSATION FROM HIC-1006.  
5) NOZZLE B2 ON D 6001 MUST BE LOCATED MIN 2m ABOVE P 6001 A/B. (TO BE CONFIRMED BY PUMP VENDOR.)  
6) E 6004 TO BE LOCATED MIN. 5m ABOVE MAX LEVEL IN T 6001 1/2.  
7) THE SPARE PUMP OF P 6001 A/B WOULD AUTOSTART WHEN THE OUTLET FLOWRATE DECREASED.  
8) HOIST IS USED FOR CLEANING OF X 6002 A/B.

**REFERENCE DRAWINGS**


**SYMBOLS AND LEGENDS**


**KEY PLAN**

REV.	PURPOSE OF ISSUE	DATE	DESIGN	DRAW	CHECK	REVIEW	APPROVE
▲	As Built	30.04.2020	Xu Yekun	Xu Hong	Liu Shengkol		
▲	Approved for Construction	30.12.2019	Xu Yekun	Xu Hong	Liu Shengkol		
▲	Approved for Construction	13.12.2018	Xu Yekun	Xu Hong	Liu Shengkol		
▲	Approved for Construction	02.02.2018	Xu Yekun	Xu Hong	Liu Shengkol		
▲	Approved for Construction	06.11.2017	Xu Yekun	Xu Hong	Liu Shengkol		
▲	Approved for Construction	05.05.2017	Xu Yekun	Xu Hong	Shi Jing		
▲	Approved for Construction	22.03.2017	Xu Yekun	Xu Hong	Shi Jing		
▲	Approved for Construction	22.01.2017	Xu Yekun	Xu Hong	Shi Jing		
▲	Approved for Construction	13.10.2016	Xu Yekun	Xu Hong	Shi Jing		
▲	Issued for Approval	31.08.2016	Xu Yekun	Xu Hong	Shi Jing		
▲	Issued for Approval	25.06.2016	Xu Yekun	Xu Hong	Shi Jing		
▲	Issued for Comments	29.04.2016	Xu Yekun	Xu Hong	Shi Jing		

OWNER: Middle East Kimiaye Pars Company

DESIGNER	HALDOR TOPSØE A/S	DOCUMENT NAME	NG SATURATION II PIPING AND INSTRUMENT DIAGRAM	PROJ NO	S-02115	CONV NO	42	REV.	1
CONTRACTOR	TCC 中国天辰工程技术有限公司	CONTRACTOR DRAWING NO.	MKP-11-AS-6000-PS07-PID-003	SHEET NO	01	TOTAL	01		
		SUB-CONTRACTOR DRAWING NO.							
		SHEET				TOTAL			

PROJECT	MKP Methanol Project
UNIT	Saturator Unit
PHASE	As Built Drawing
OWNER DWG NO.	MKP-11-AS-6000-PR-PID-003



E 6002	PROCESS CONDENSATE PREHEATER
DUTY	0.7 MW
DESIGN PRESS.(TLU/SH)	71/56 barg
DESIGN TEMP.(TLU/SH)	255/ 255 °C
INSULATION	YES
ELEV. OF EQUIPMENT	EL +101.230m

P 7003 A/B/C	EXCESS PROCESS CONDENSATE PUMP
RATED CAPACITY	22 m <sup>3</sup> /h
HEAD	63.22 M
DENSITY@DT	959 kg/m <sup>3</sup>
INSULATION/TRACING	NONE
AUXILIARY PIPING	By Vendor
ELEV. OF EQUIPMENT	EL +101.060m


D 6002	SATURATOR BLOW DOWN DRUM
ID x LENGTH(T-D)	1300 x 4375mm
DESIGN PRESS.	3.5 barg
DESIGN TEMP.	125 °C
INSULATION	NO
CLADDING/LINING	PERSONNEL PROTECTION
ELEV. OF EQUIPMENT	EL +107.240m

E 6003	SATURATOR BLOW DOWN COOLER
DUTY	1.9 MW
DESIGN PRESS.(TLU/SH)	7.5/9.9 barg
DESIGN TEMP.(TLU/SH)	100/125 °C
INSULATION	YES
ELEV. OF EQUIPMENT	EL +101.355m

**GENERAL NOTES**

†GENERAL NOTE:  
LOW POINT DRAINS AND HIGH POINT VENT MUST BE ADDED DURING DETAILED ENGINEERING.

- †NOTES:  
1) TWO PHASE FLOW.  
2) FV-6081 AND FV-6086 MUST BE LOCATED CLOSE TO D 6002.  
3) FUNCTION OF LIC-6082

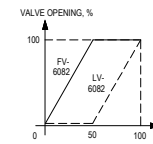

- †4) NOZZLE B ON D 6002 MUST BE LOCATED MIN. 5m ABOVE P 7003 A/B/C (TO BE CONFIRMED BY PUMP VENDOR).  
5) THE SPARE PUMP OF P 7003 A/B/C WOULD AUTOSTART WHEN THE OUTLET PRESSURE DECREASED.  
6) IN NORMAL CONDITION, THE FLOW RATE OF LINE 4"-BD-60-138-B40-N IS 0. THE MAXIMUM OPERATING TEMPERATURE OF THIS LINE IS 65°C WHEN ITS FLOW RATE ACHIEVED THE MAXIMUM VALUE.  
7) DURING THE MAXIMUM FLOW RATE PHASE, ALL OF THE THREE PUMPS WILL BE UNDER OPERATION.

**REFERENCE DRAWINGS**

**SYMBOLS AND LEGENDS**

**KEY PLAN**

REV.	PURPOSE OF ISSUE	DATE	DESIGN	DRAW	CHECK	REVIEW	APPROVE
▲	As Built	30.04.2020	Xu Yekun				Xu Hong Liu Shengkol
▲	Approved for Construction	02.02.2018	Xu Yekun				Xu Hong Liu Shengkol
▲	Approved for Construction	05.05.2017	Xu Yekun				Xu Hong Shi Jing
▲	Approved for Construction	22.03.2017	Xu Yekun				Xu Hong Shi Jing
▲	Approved for Construction	22.01.2017	Xu Yekun				Xu Hong Shi Jing
▲	Approved for Construction	13.10.2016	Xu Yekun				Xu Hong Shi Jing
▲	Approved for Construction	31.08.2016	Xu Yekun				Xu Hong Shi Jing
▲	Issued for Approval	25.06.2016	Xu Yekun				Xu Hong Shi Jing
▲	Issued for Comments	29.04.2016	Xu Yekun				Xu Hong Shi Jing


THIS DOCUMENT IS THE PROPERTY OF TCC. NO PART OF THIS DOCUMENT SHALL BE REPRODUCED OR DISCLOSED TO OTHERS OR USED FOR ANY PURPOSE WHATSOEVER EXCEPT WITH THE PRIOR WRITTEN PERMISSION OF TCC.

OWNER: Middle East Kimiaye Pars Company

DESIGNER	HALDOR TOPSØE A/S	DOCUMENT NAME	NG SATURATION III PIPING AND INSTRUMENT DIAGRAM	PROJ NO	S-02115	REV	42
DATE	13/4/18	CONTRACTOR DRAWING NO.	MKP-11-AS-6000-PS07-PID-004	SHEET	01	TOTAL	01
CONTRACTOR	TCC 中国天辰工程技术有限公司	SUB-CONTRACTOR DRAWING NO.		SHEET		TOTAL	

PROJECT	MKP Methanol Project
UNIT	Saturator Unit
PHASE	As Built Drawing
OWNER DWG NO.	MKP-11-AS-6000-PR-PID-004

SCALE: -	SHEET: 1	TOT: 1	SIZE: A1
----------	----------	--------	----------

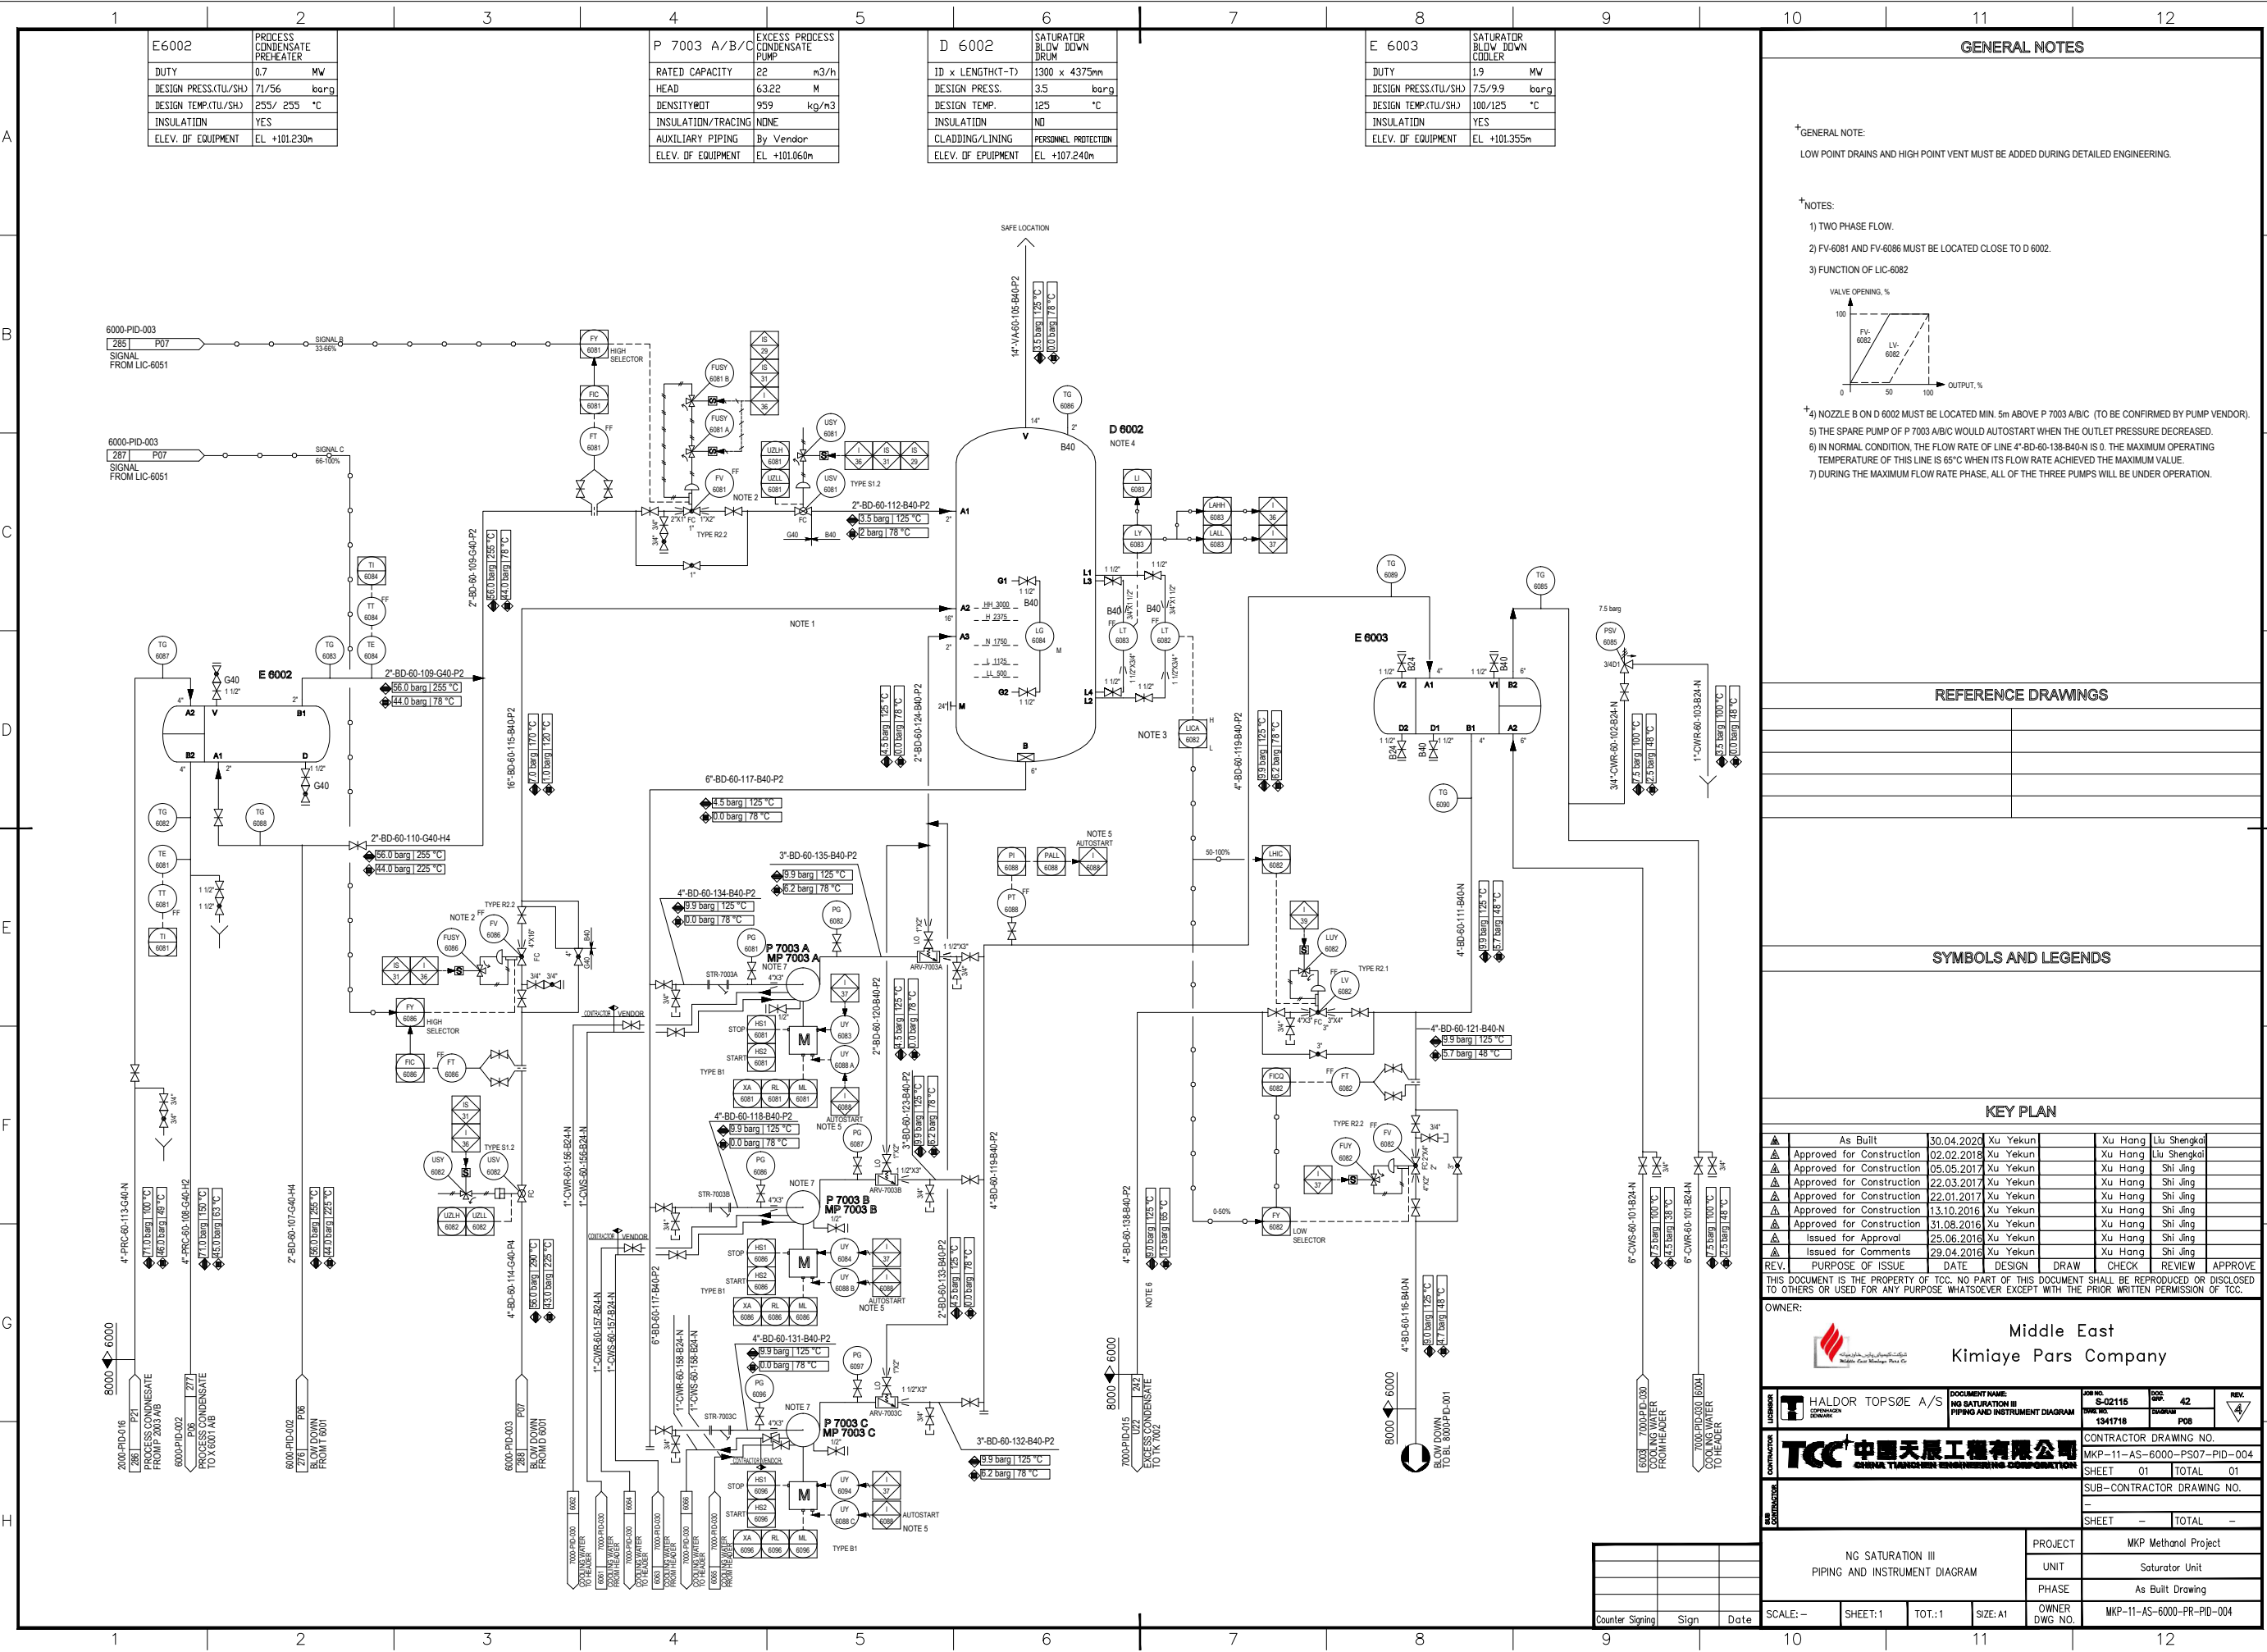


Counter Signing Sign Date

X 7011AB	HHP-HP STEAM LET DOWN STATION
CAPACITY	400,000 kg/hr
STEAM INLET PRESS.	98 barg
STEAM INLET TEMP.	454 °C
STEAM OUTLET PRESS.	44 barg
STEAM OUTLET TEMP.	345 °C

X 7010	HHP-HP STEAM LET DOWN STATION
CAPACITY	40,000 kg/hr
STEAM INLET PRESS.	98 barg
STEAM INLET TEMP.	454 °C
STEAM OUTLET PRESS.	44 barg
STEAM OUTLET TEMP.	345 °C

SI 7010	HP STEAM VENT SILENCER
CAPACITY	400,000 kg/hr
DESIGN PRESS.	12 barg
DESIGN TEMP.	410 °C
MATERIAL SHELL	CS

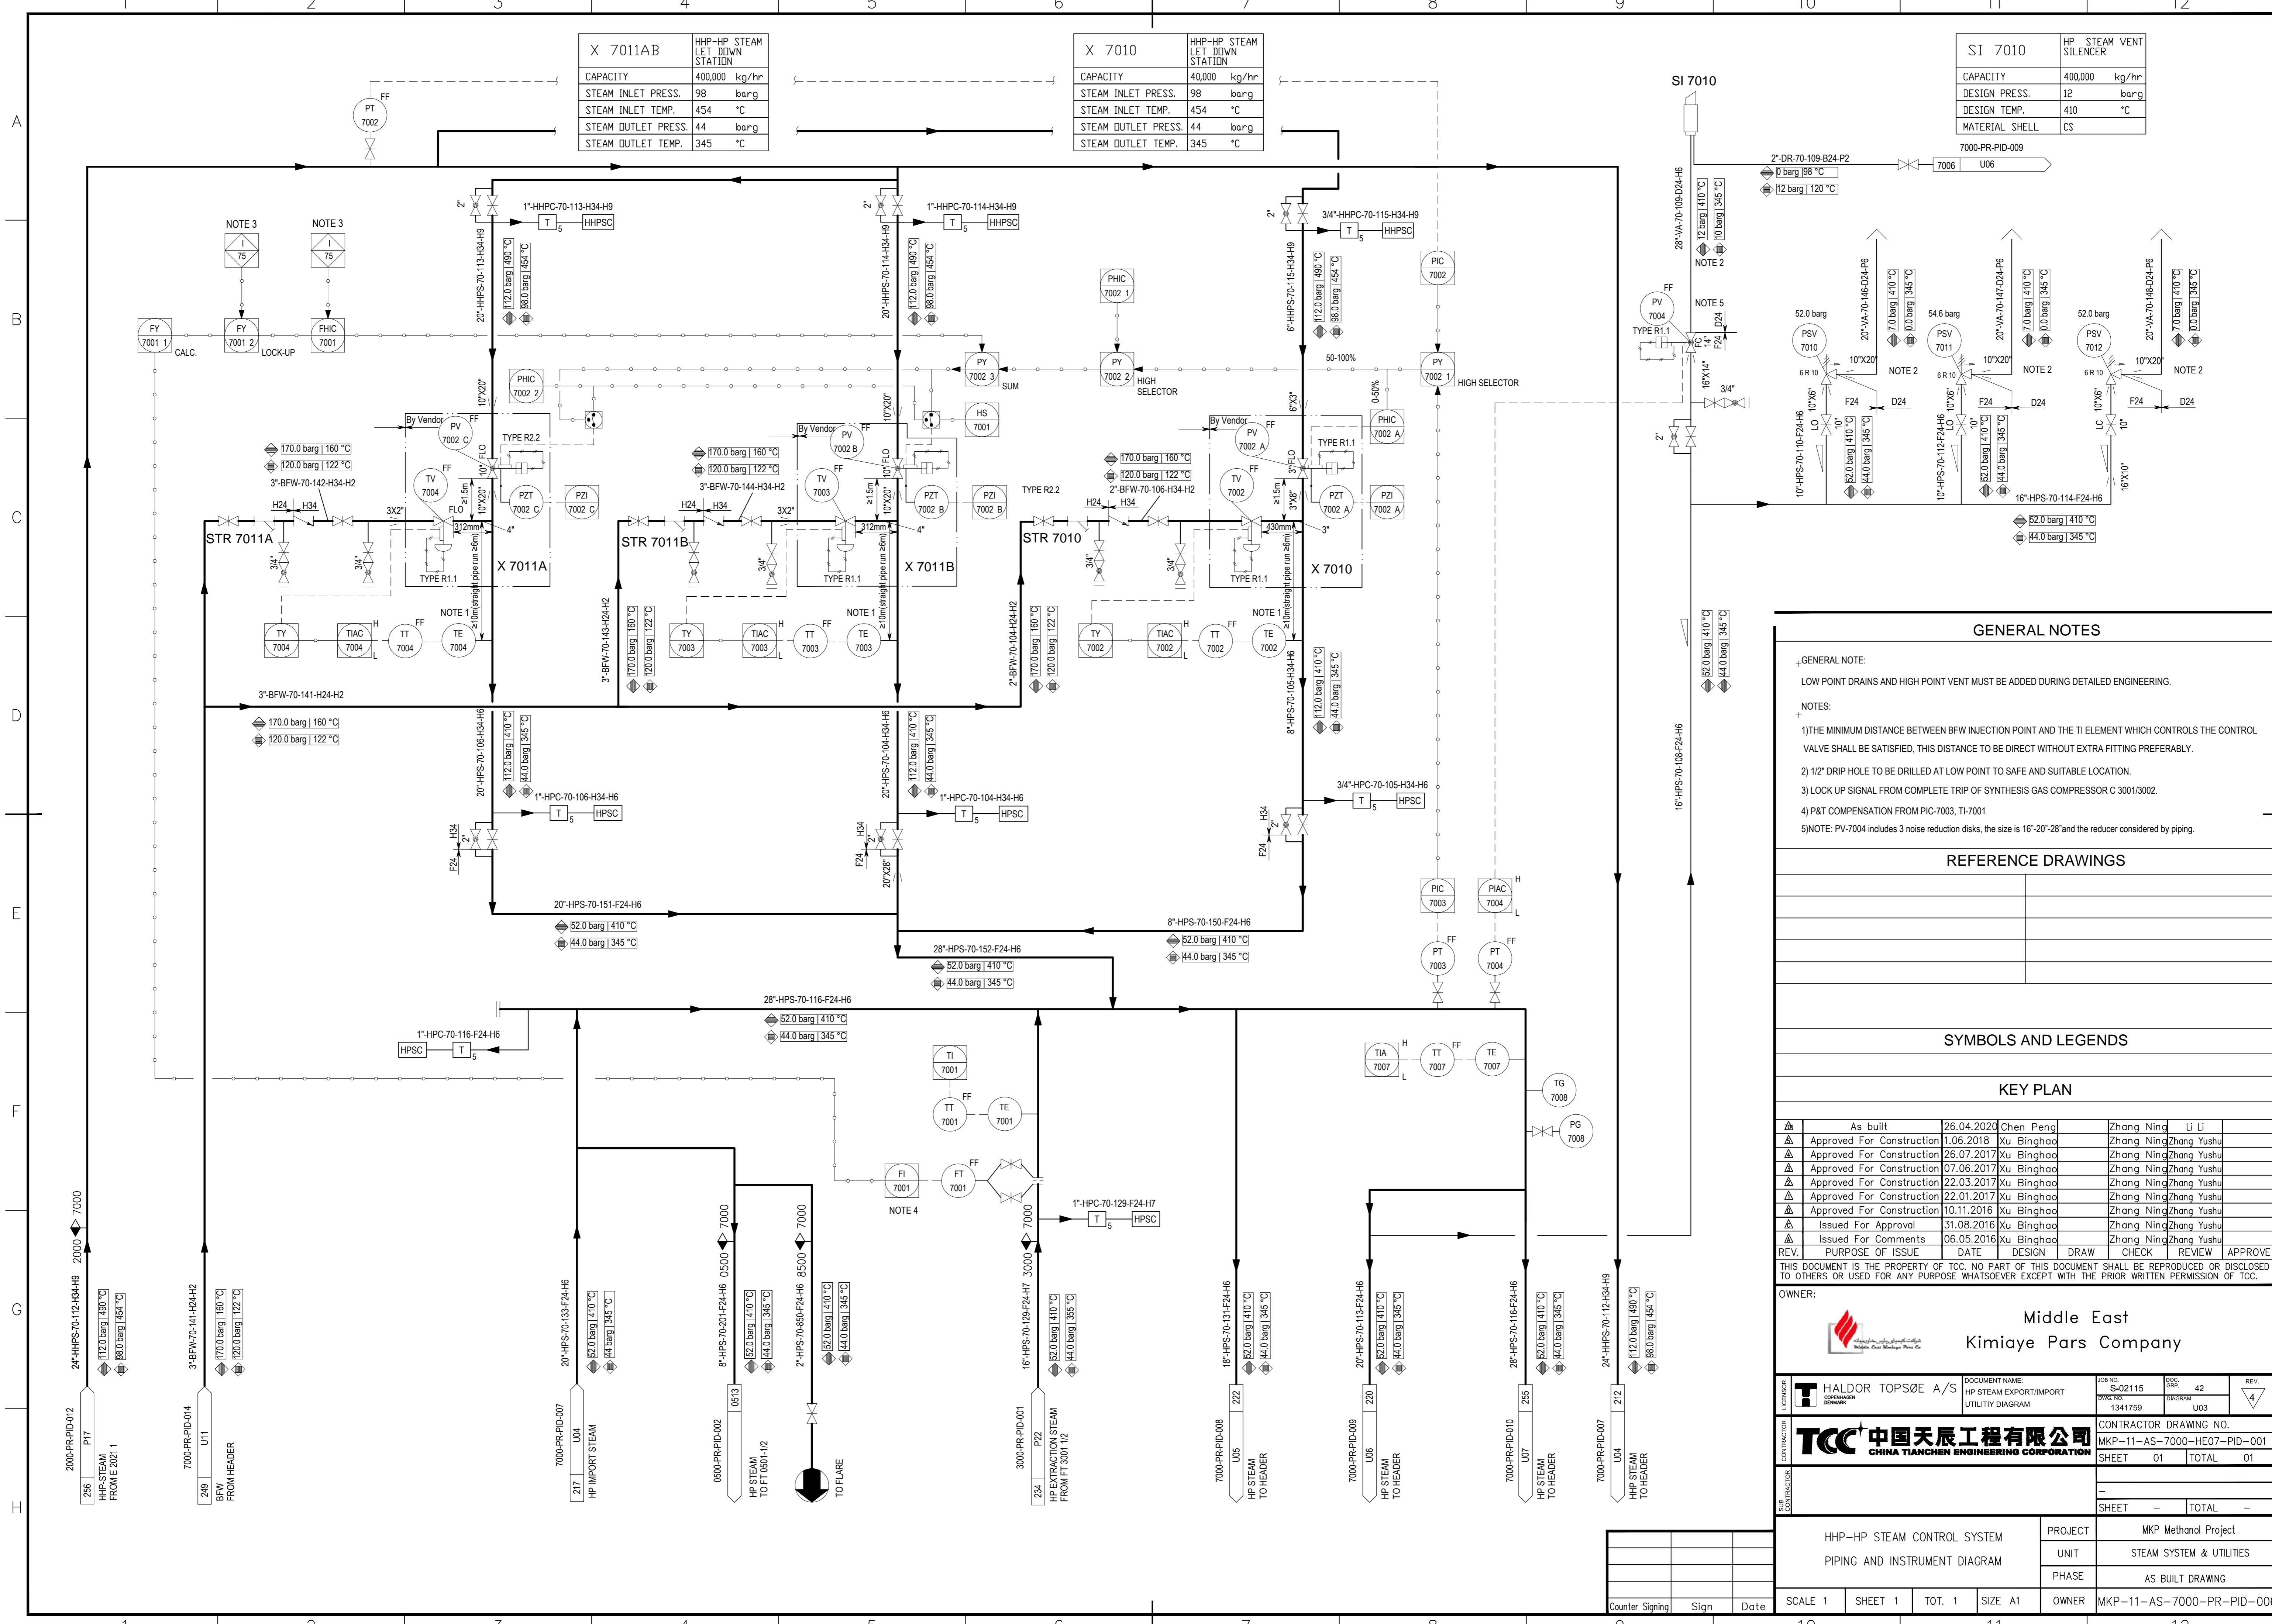

**GENERAL NOTES**

GENERAL NOTE:  
 LOW POINT DRAINS AND HIGH POINT VENT MUST BE ADDED DURING DETAILED ENGINEERING.

NOTES:  
 1) THE MINIMUM DISTANCE BETWEEN BFW INJECTION POINT AND THE TI ELEMENT WHICH CONTROLS THE CONTROL VALVE SHALL BE SATISFIED, THIS DISTANCE TO BE DIRECT WITHOUT EXTRA FITTING PREFERABLY.  
 2) 1/2" DRIP HOLE TO BE DRILLED AT LOW POINT TO SAFE AND SUITABLE LOCATION.  
 3) LOCK UP SIGNAL FROM COMPLETE TRIP OF SYNTHESIS GAS COMPRESSOR C 3001/3002.  
 4) P&T COMPENSATION FROM PIC-7003, TI-7001  
 5) NOTE: PV-7004 includes 3 noise reduction disks, the size is 16"-20"-28" and the reducer considered by piping.

**REFERENCE DRAWINGS**


**SYMBOLS AND LEGENDS**


**KEY PLAN**

As built	26.04.2020	Chen Peng	Zhang Ning	Li Li			
Approved For Construction	1.06.2018	Xu Binghao	Zhang Ning	Zhang Yushu			
Approved For Construction	26.07.2017	Xu Binghao	Zhang Ning	Zhang Yushu			
Approved For Construction	07.06.2017	Xu Binghao	Zhang Ning	Zhang Yushu			
Approved For Construction	22.03.2017	Xu Binghao	Zhang Ning	Zhang Yushu			
Approved For Construction	22.01.2017	Xu Binghao	Zhang Ning	Zhang Yushu			
Approved For Construction	10.11.2016	Xu Binghao	Zhang Ning	Zhang Yushu			
Issued For Approval	31.08.2016	Xu Binghao	Zhang Ning	Zhang Yushu			
Issued For Comments	06.05.2016	Xu Binghao	Zhang Ning	Zhang Yushu			
REV.	PURPOSE OF ISSUE	DATE	DESIGN	DRAW	CHECK	REVIEW	APPROVE

OWNER: **Middle East Kimiaye Pars Company**


HHP-HP STEAM CONTROL SYSTEM	PROJECT	MKP Methanol Project
PIPING AND INSTRUMENT DIAGRAM	UNIT	STEAM SYSTEM & UTILITIES
	PHASE	AS BUILT DRAWING
	OWNER	MKP-11-AS-7000-PR-PID-006


Counter							
Sign							
Date							

SCALE	1	SHEET	1	TOT.	1	SIZE	A1
-------	---	-------	---	------	---	------	----



X 7012A/B		HHP-HP STEAM LET DOWN STATION	
CAPACITY	115,000	kg/hr	
STEAM INLET PRESS.	98	barg	
STEAM INLET TEMP.	454	°C	
STEAM OUTLET PRESS.	44	barg	
STEAM OUTLET TEMP.	410	°C	


DS 7010A/B		HP-HP STEAM DESUPERHEATER	
CAPACITY	200,000	kg/hr	
STEAM INLET PRESS.	44	barg	
STEAM INLET TEMP.	430	°C	
STEAM OUTLET PRESS.	44	barg	
STEAM OUTLET TEMP.	345	°C	

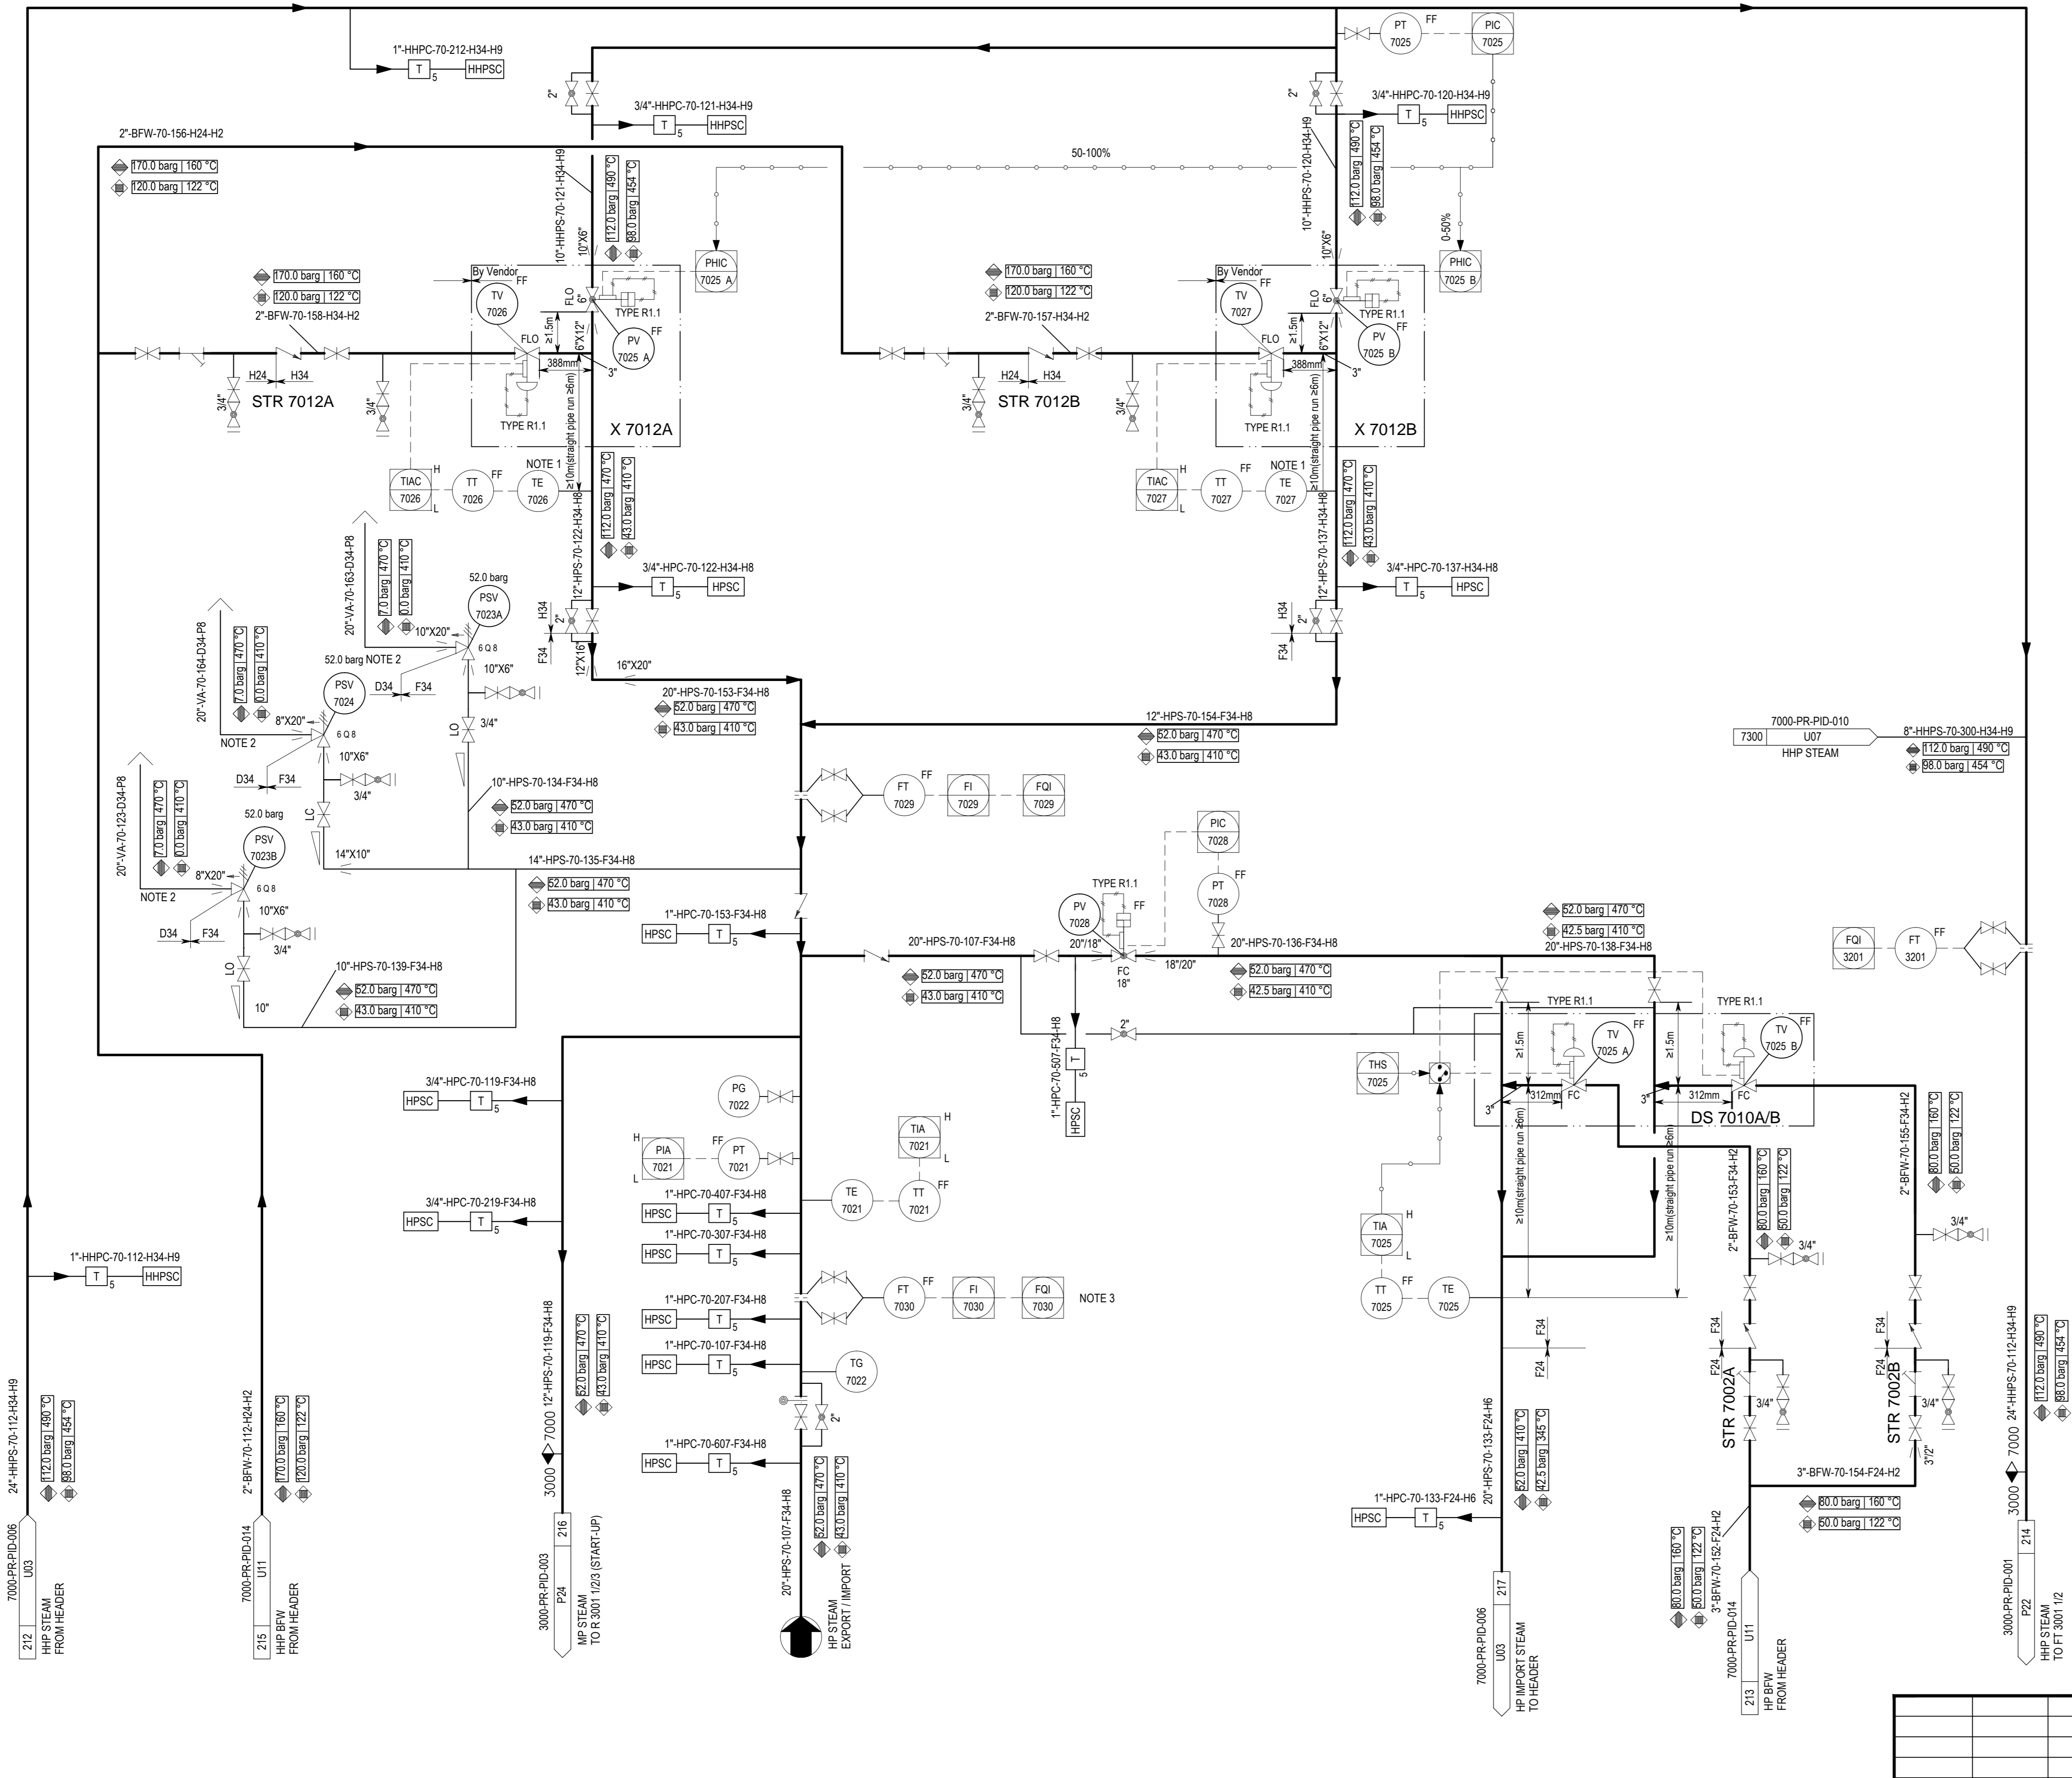

**GENERAL NOTES**

GENERAL NOTE:  
LOW POINT DRAINS AND HIGH POINT VENT MUST BE ADDED DURING DETAILED ENGINEERING.

- NOTES:
- 1) THE MINIMUM DISTANCE BETWEEN BFW INJECTION POINT AND THE TI ELEMENT WHICH CONTROLS THE CONTROL VALVE SHALL BE SATISFIED, THIS DISTANCE TO BE DIRECT WITHOUT EXTRA FITTING PREFERABLY.
  - 2) 1/2" DRIP HOLE TO BE DRILLED AT LOW POINT TO SAFE AND SUITABLE LOCATION.
  - 3) P&T COMPENSATION FROM PI-7021, TI-7021

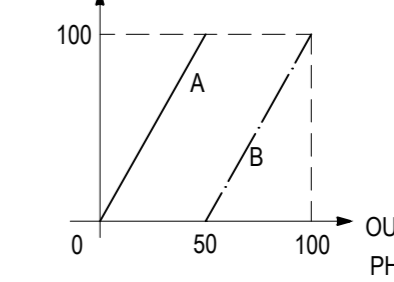

**REFERENCE DRAWINGS**

**SYMBOLS AND LEGENDS**

**KEY PLAN**

REV.	PURPOSE OF ISSUE	DATE	DESIGN	DRAW	CHECK	REVIEW	APPROVE
As built		26.04.2020	Chen Peng	Zhang Ning	Li Li		
Approved For Construction		01.06.2018	Xu Binghao	Zhang Ning	Zhang Yushu		
Approved For Construction		07.06.2017	Xu Binghao	Zhang Ning	Zhang Yushu		
Approved For Construction		22.03.2017	Xu Binghao	Zhang Ning	Zhang Yushu		
Approved For Construction		22.01.2017	Xu Binghao	Zhang Ning	Zhang Yushu		
Approved For Construction		10.11.2016	Xu Binghao	Zhang Ning	Zhang Yushu		
Issued For Approval		31.08.2016	Xu Binghao	Zhang Ning	Zhang Yushu		
Issued For Comments		29.04.2016	Xu Binghao	Zhang Ning	Zhang Yushu		

OWNER: **Middle East Kimiaye Pars Company**

<b>HALDOR TOPSØE A/S</b> CONTRACTOR <b>TCC 中国天辰工程有限公司</b> CHINA TIANCHEN ENGINEERING CORPORATION	DOCUMENT NAME: HP STEAM EXPORT/IMPORT UTILITY DIAGRAM	JOB NO. S-02115 DWG NO. 1341760 SHEET 01 TOTAL 01	REV. 3 CONTRACTOR DRAWING NO. MKP-11-AS-7000-HE07-PID-002 SHEET 01 TOTAL 01
---	--	---	---

HP STEAM EXPORT/IMPORT PIPING AND INSTRUMENT DIAGRAM	PROJECT: MKP Methanol Project
	UNIT: STEAM SYSTEM & UTILITIES
	PHASE: AS BUILT DRAWING
SCALE 1 SHEET 1 TOT. 1 SIZE A1	OWNER: MKP-11-AS-7000-PR-PID-007


Counter Sign Sign Date



X 7013A/B	HHP-MP STEAM LET DOWN STATION
CAPACITY	260,000 kg/hr
STEAM INLET PRESS.	44 barg
STEAM INLET TEMP.	345 °C
STEAM OUTLET PRESS.	34 barg
STEAM OUTLET TEMP.	260 °C

X 7014A/B	MP-LP STEAM LET DOWN STATION
CAPACITY	50,000 kg/hr
STEAM INLET PRESS.	40 barg
STEAM INLET TEMP.	252 °C
STEAM OUTLET PRESS.	7.5 barg
STEAM OUTLET TEMP.	188 °C

SI 7011	MP STEAM VENT SILENCER
CAPACITY	280,000 kg/hr
DESIGN PRESS.	12 barg
DESIGN TEMP.	300 °C
MATERIAL SHELL	CS

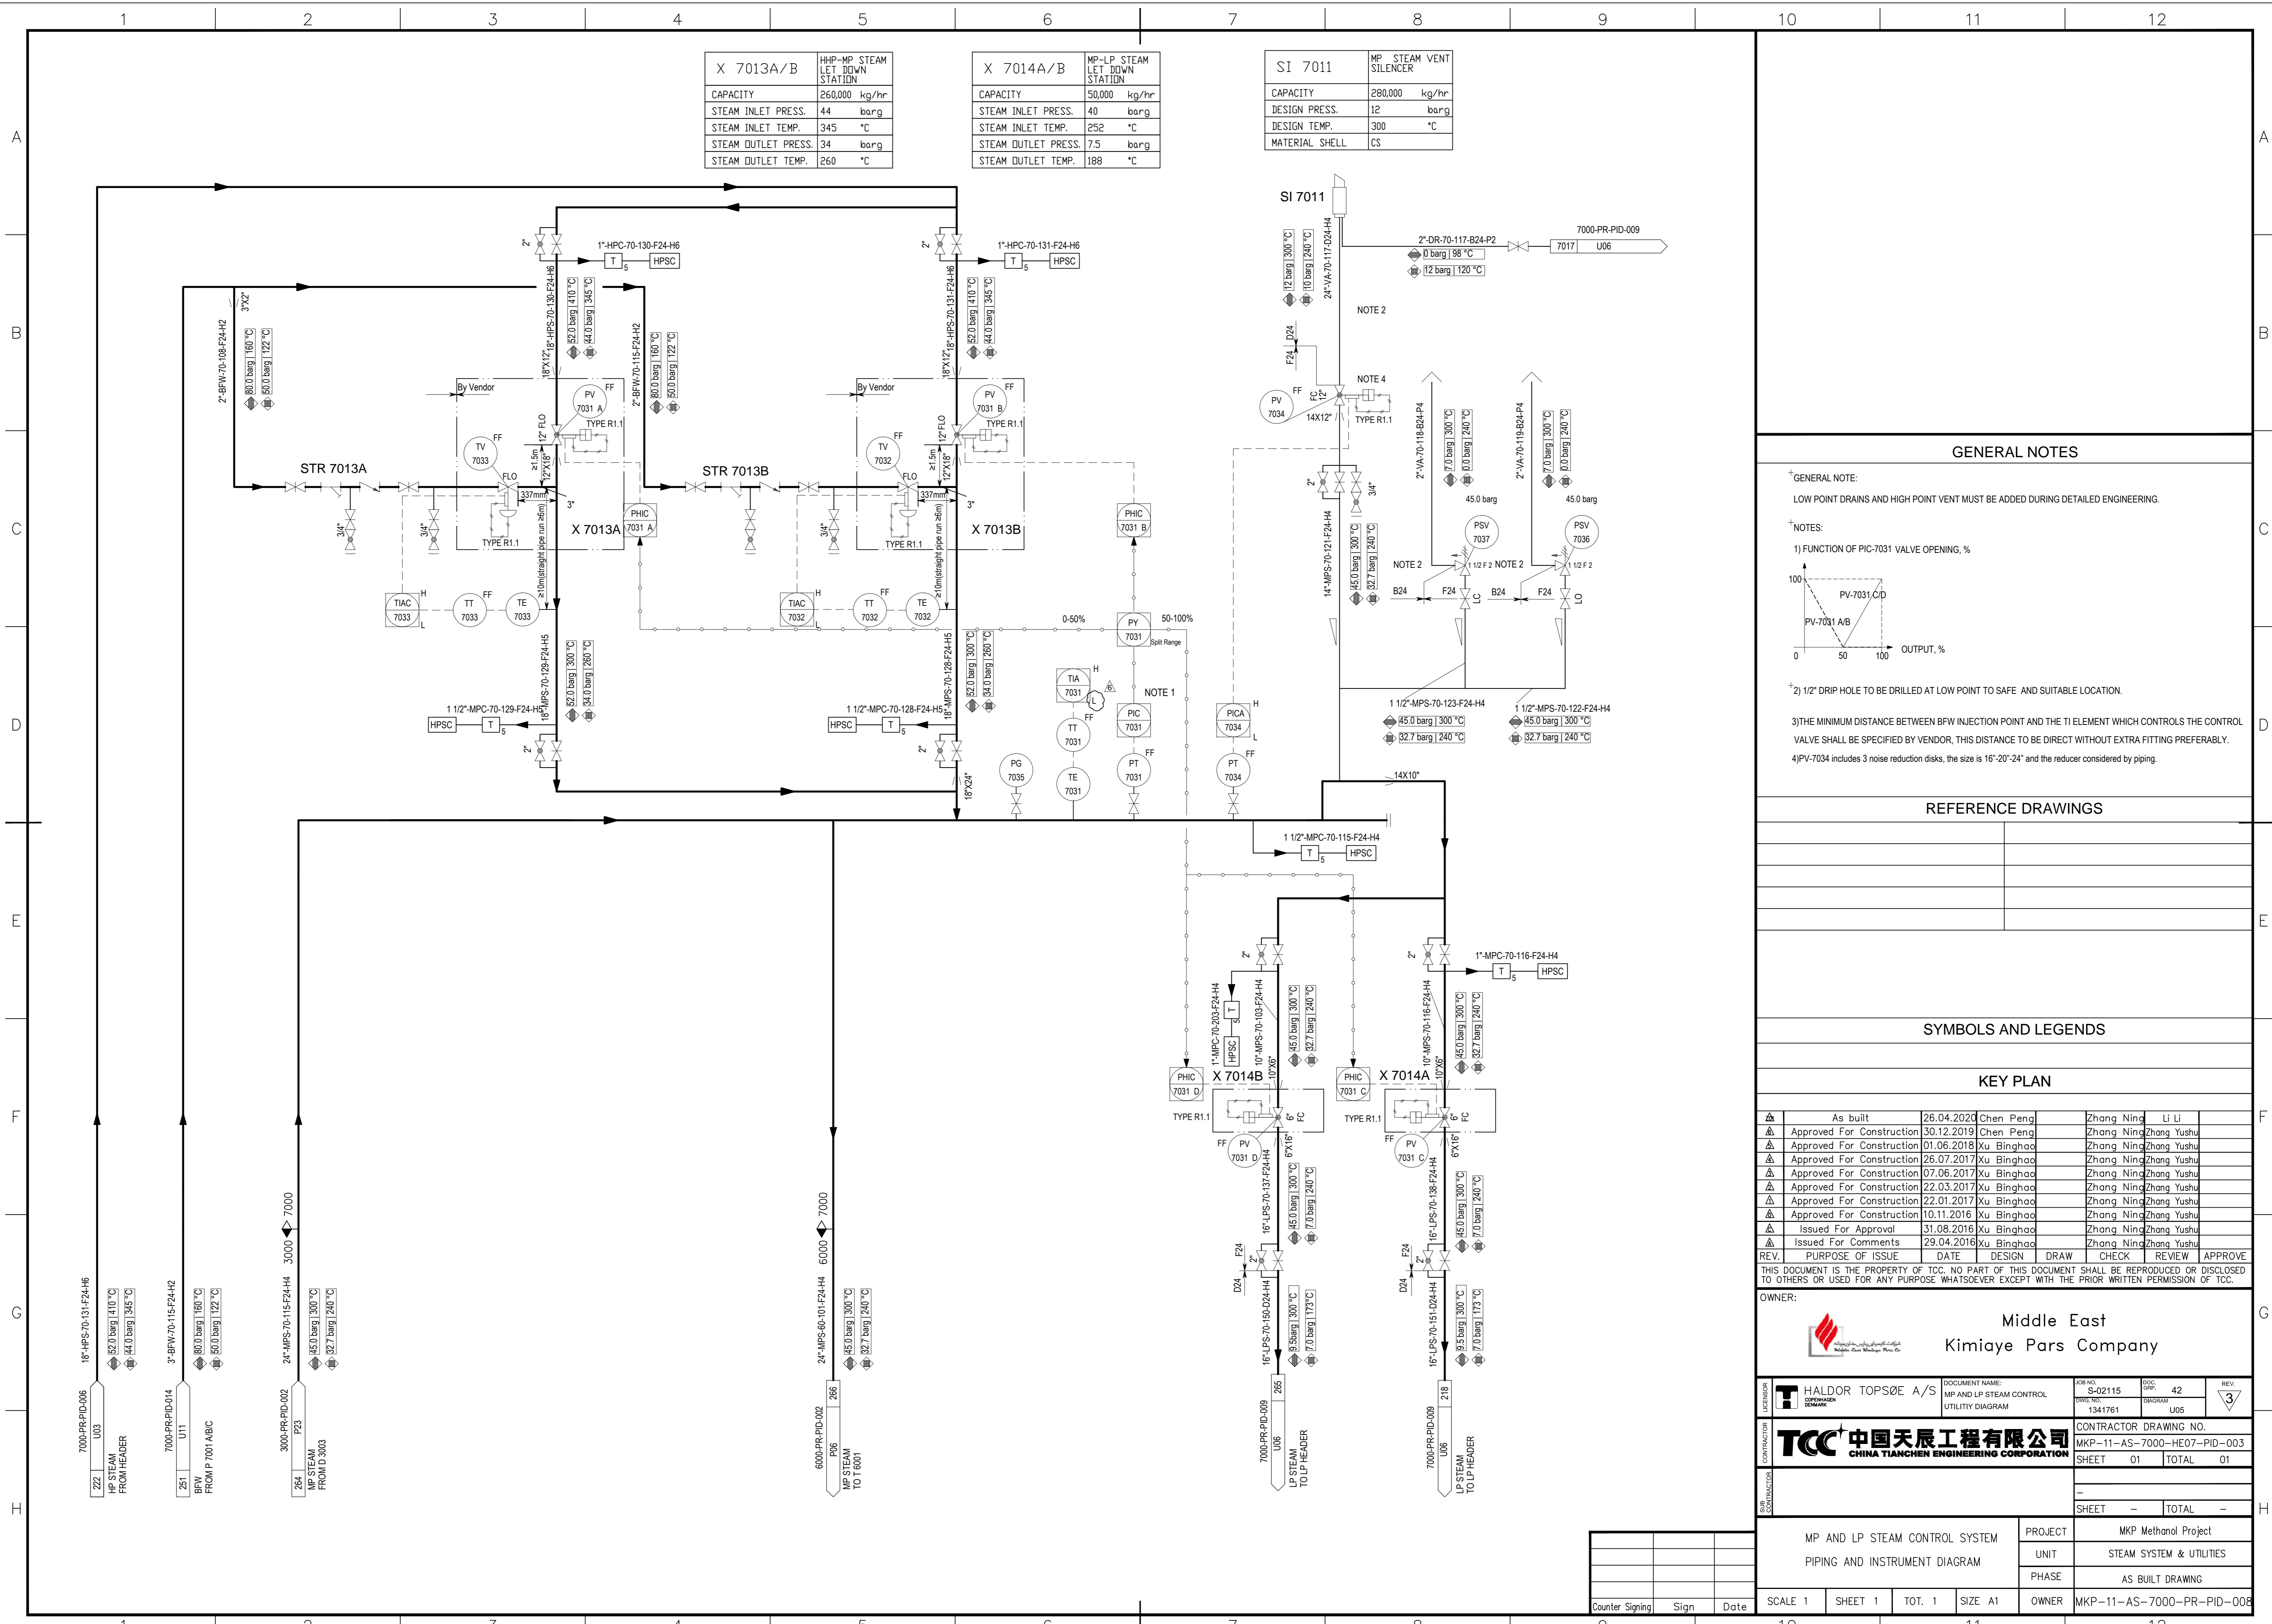

**GENERAL NOTES**

- GENERAL NOTE:  
LOW POINT DRAINS AND HIGH POINT VENT MUST BE ADDED DURING DETAILED ENGINEERING.
- NOTES:  
1) FUNCTION OF PIC-7031 VALVE OPENING, %  
  
2) 1/2" DRIP HOLE TO BE DRILLED AT LOW POINT TO SAFE AND SUITABLE LOCATION.  
3) THE MINIMUM DISTANCE BETWEEN BFW INJECTION POINT AND THE TI ELEMENT WHICH CONTROLS THE CONTROL VALVE SHALL BE SPECIFIED BY VENDOR, THIS DISTANCE TO BE DIRECT WITHOUT EXTRA FITTING PREFERABLY.  
4) PV-7034 includes 3 noise reduction disks, the size is 16"-20"-24" and the reducer considered by piping.

**REFERENCE DRAWINGS**

**SYMBOLS AND LEGENDS**

**KEY PLAN**

As built	26.04.2020	Chen Peng	Zhang Ning	Li Li			
Approved For Construction	30.12.2019	Chen Peng	Zhang Ning	Zhang Yushu			
Approved For Construction	01.06.2018	Xu Binghao	Zhang Ning	Zhang Yushu			
Approved For Construction	26.07.2017	Xu Binghao	Zhang Ning	Zhang Yushu			
Approved For Construction	07.06.2017	Xu Binghao	Zhang Ning	Zhang Yushu			
Approved For Construction	22.03.2017	Xu Binghao	Zhang Ning	Zhang Yushu			
Approved For Construction	22.01.2017	Xu Binghao	Zhang Ning	Zhang Yushu			
Approved For Construction	10.11.2016	Xu Binghao	Zhang Ning	Zhang Yushu			
Issued For Approval	31.08.2016	Xu Binghao	Zhang Ning	Zhang Yushu			
Issued For Comments	29.04.2016	Xu Binghao	Zhang Ning	Zhang Yushu			
REV.	PURPOSE OF ISSUE	DATE	DESIGN	DRAW	CHECK	REVIEW	APPROVE

OWNER: **Middle East Kimiaye Pars Company**

LENSOR	HALDOR TOPSØE A/S	DOCUMENT NAME	MP AND LP STEAM CONTROL UTILITY DIAGRAM	JOB NO.	S-02115	DOC. GRP.	42	REV.	3
CONTRACTOR	<b>TCC 中国天辰工程有限公司</b> CHINA TIANCHEN ENGINEERING CORPORATION	CONTRACTOR DRAWING NO.	MKP-11-AS-7000-HE07-PID-003	DATE	1341761	DEPARTMENT	U05	SHEET	01
SHEET	01	TOTAL	01						

PROJECT	MKP Methanol Project
UNIT	STEAM SYSTEM & UTILITIES
PHASE	AS BUILT DRAWING
OWNER	MKP-11-AS-7000-PR-PID-008

Counter Signing	Sign	Date
-----------------	------	------

SCALE	1	SHEET	1	TOT.	1	SIZE	A1
-------	---	-------	---	------	---	------	----



X 7015A/B	
CAPACITY	130,000 kg/hr
STEAM INLET PRESS.	44 barg
STEAM INLET TEMP.	345 °C
STEAM OUTLET PRESS.	7.5 barg
STEAM OUTLET TEMP.	190 °C

SI 7012	
CAPACITY	200,000 kg/hr
DESIGN PRESS.	7 barg
DESIGN TEMP.	340 °C
MATERIAL SHELL	CS

**GENERAL NOTES**

† GENERAL NOTE:  
LOW POINT DRAINS AND HIGH POINT VENT MUST BE ADDED DURING DETAILED ENGINEERING.

† NOTES:  
1) 1/2" DRIP HOLE TO BE DRILLED AT LOW POINT TO SAFE AND SUITABLE LOCATION.  
2) THE MINIMUM DISTANCE BETWEEN BFW INJECTION POINT AND THE TI ELEMENT WHICH CONTROLS THE CONTROL VALVE SHALL BE SPECIFIED BY VENDOR, THIS DISTANCE TO BE DIRECT WITHOUT EXTRA FITTING PREFERABLY.  
3) PV-7056 includes 1 noise reduction disks, the size is 20" and the reducer considered by piping.

**REFERENCE DRAWINGS**


**SYMBOLS AND LEGENDS**


**KEY PLAN**

As built	26.04.2020	Chen Peng	Zhang Ning	Li Li			
Approved For Construction	01.06.2018	Xu Binghao	Zhang Ning	Zhang Yushu			
Approved For Construction	26.07.2017	Xu Binghao	Zhang Ning	Zhang Yushu			
Approved For Construction	07.06.2017	Xu Binghao	Zhang Ning	Zhang Yushu			
Approved For Construction	22.03.2017	Xu Binghao	Zhang Ning	Zhang Yushu			
Approved For Construction	22.01.2017	Xu Binghao	Zhang Ning	Zhang Yushu			
Approved For Construction	10.11.2016	Xu Binghao	Zhang Ning	Zhang Yushu			
Issued For Approval	31.08.2016	Xu Binghao	Zhang Ning	Zhang Yushu			
Issued For Comments	29.04.2016	Xu Binghao	Zhang Ning	Zhang Yushu			
REV.	PURPOSE OF ISSUE	DATE	DESIGN	DRAW	CHECK	REVIEW	APPROVE

THIS DOCUMENT IS THE PROPERTY OF TCC. NO PART OF THIS DOCUMENT SHALL BE REPRODUCED OR DISCLOSED TO OTHERS OR USED FOR ANY PURPOSE WHATSOEVER EXCEPT WITH THE PRIOR WRITTEN PERMISSION OF TCC.


OWNER: Middle East Kimiaye Pars Company

CONTRACTOR: TCC 中国天辰工程有限公司 CHINA TIANCHEN ENGINEERING CORPORATION

CONTRACTOR DRAWING NO. MKP-11-AS-7000-HE07-PID-004

SHEET 01 TOTAL 01

LP STEAM CONTROL	PROJECT	MKP Methanol Project
PIPING AND INSTRUMENT DIAGRAM	UNIT	STEAM SYSTEM & UTILITIES
	PHASE	AS BUILT DRAWING
	OWNER	MKP-11-AS-7000-PR-PID-009

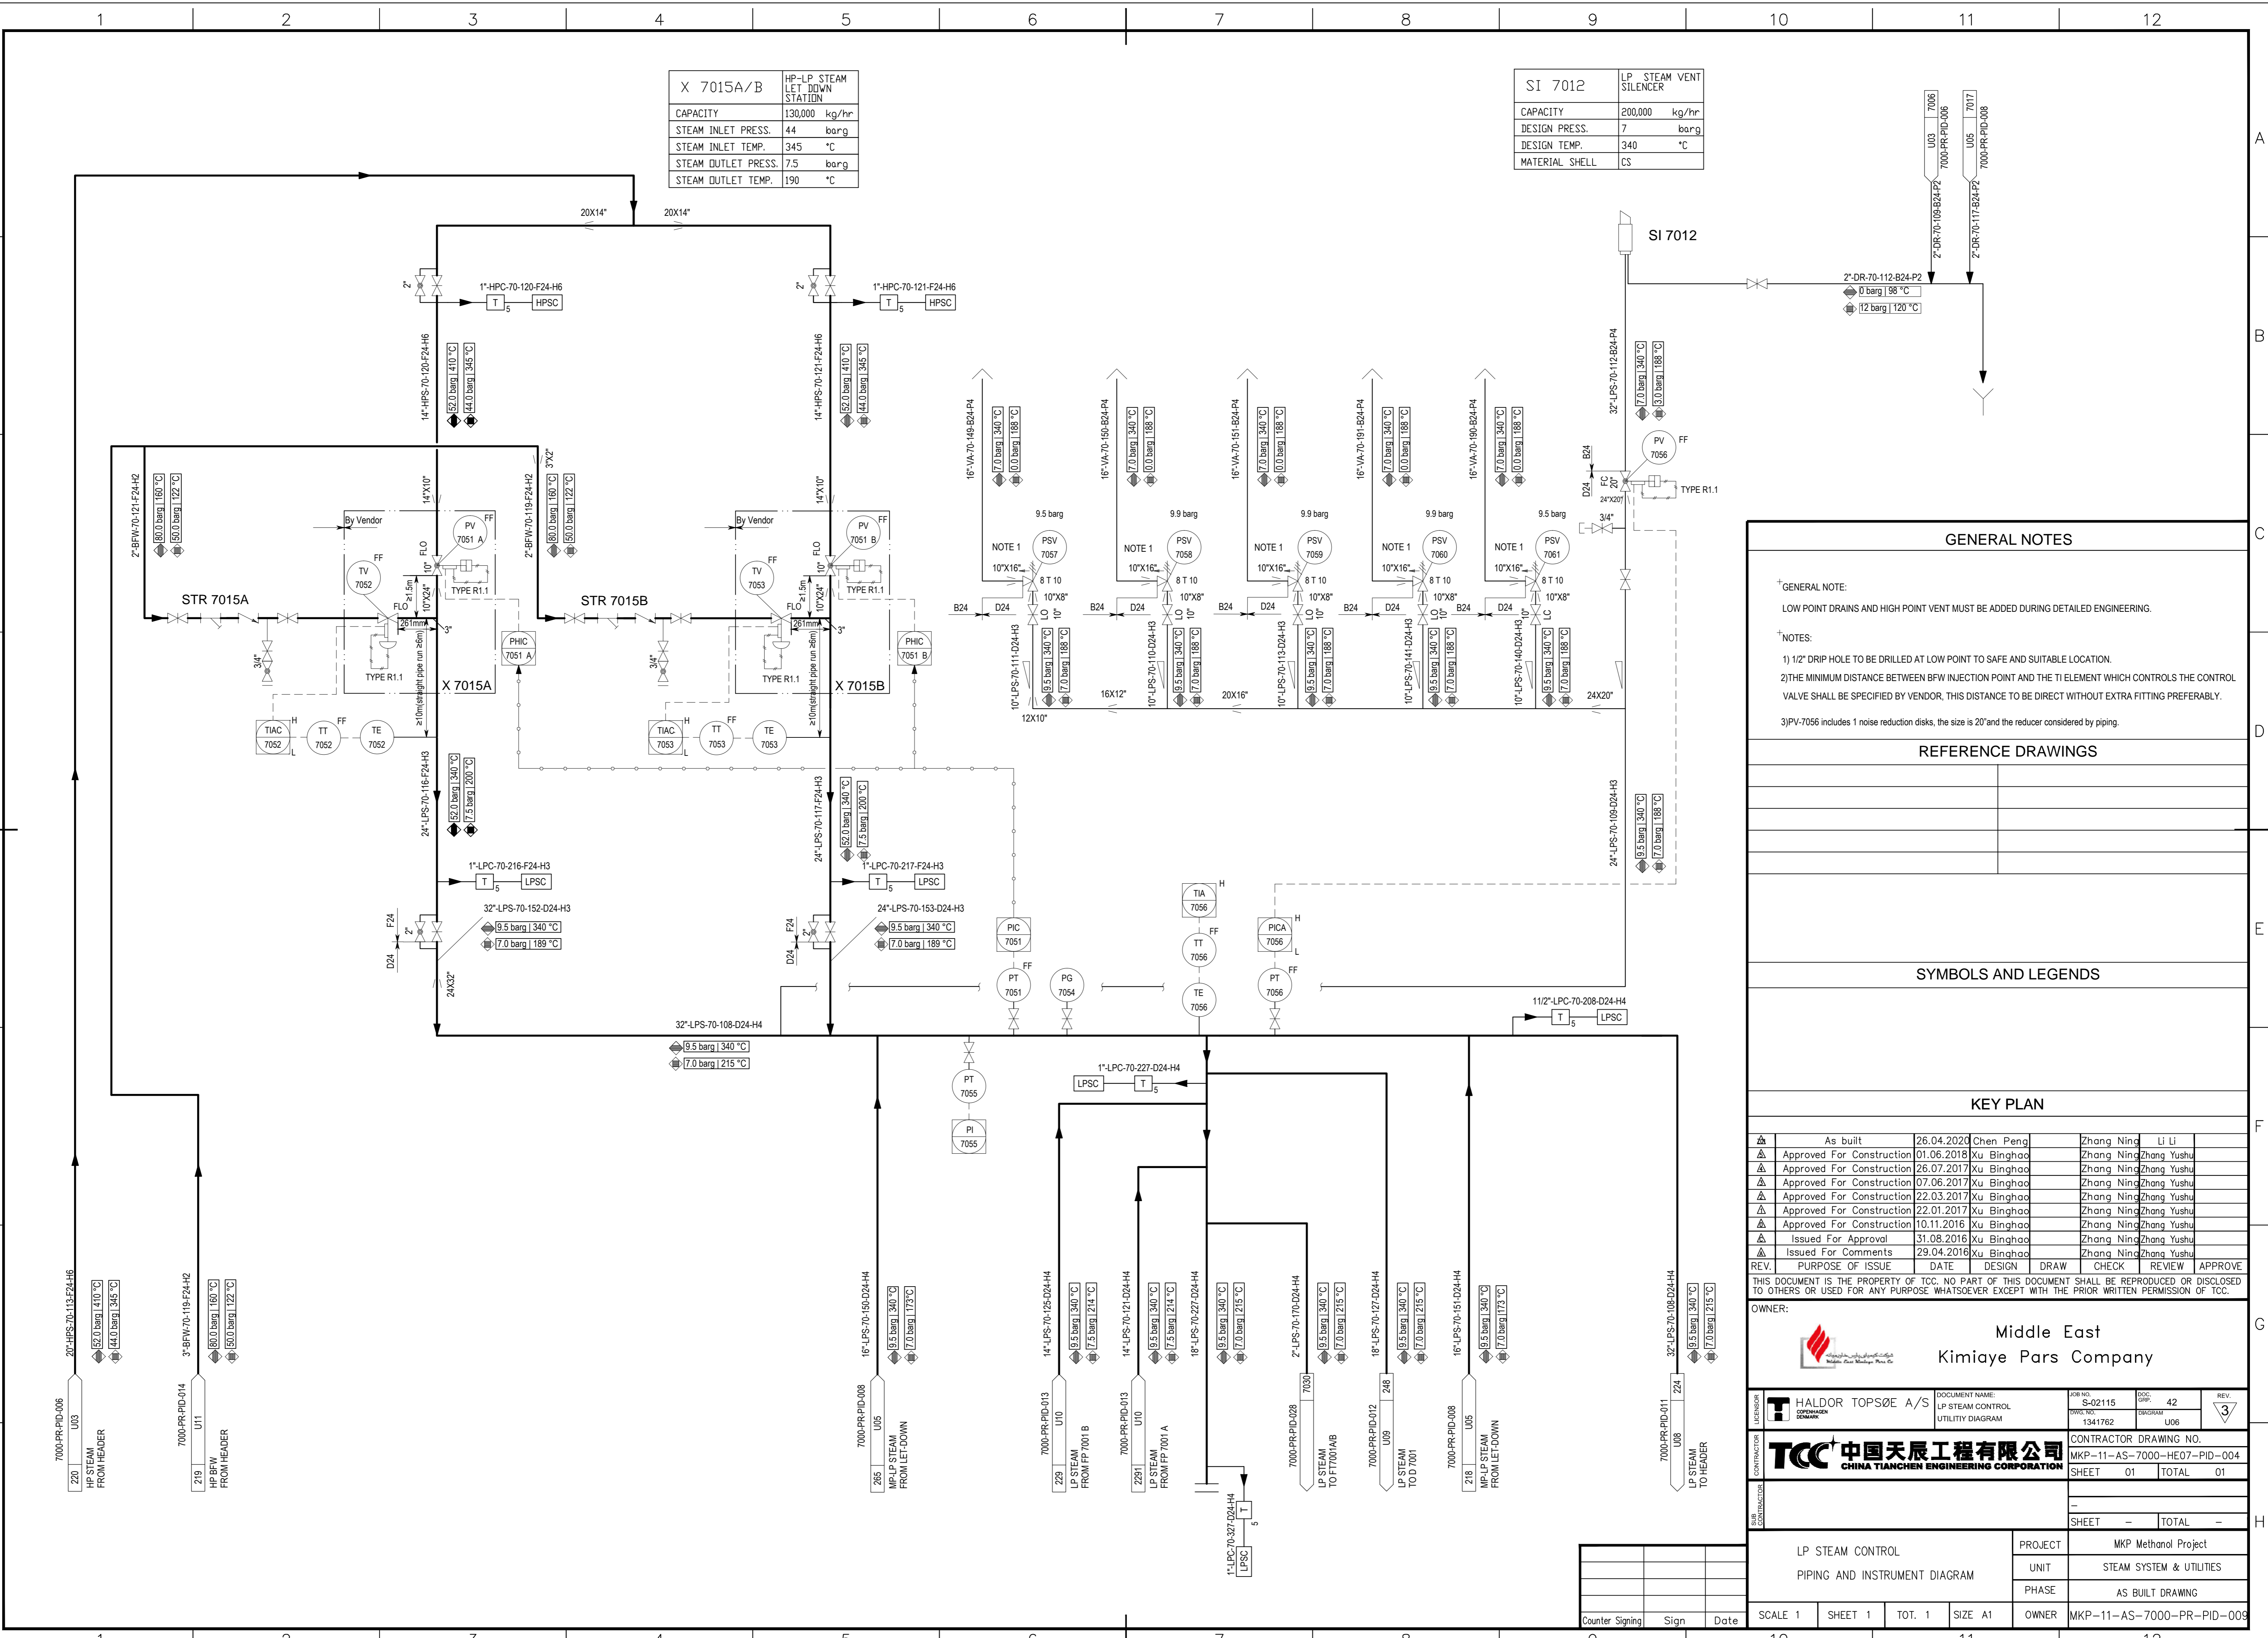

Counter Signing	Sign	Date

DS 7011A/B	HP-HP STEAM DESUPERHEATER
CAPACITY	15,000 kg/hr
STEAM INLET PRESS.	44 barg
STEAM INLET TEMP.	345 °C
STEAM OUTLET PRESS.	44 barg
STEAM OUTLET TEMP.	272 °C

**GENERAL NOTES**

- GENERAL NOTE:  
LOW POINT DRAINS AND HIGH POINT VENT MUST BE ADDED DURING DETAILED ENGINEERING.
- NOTES:  
1) THE MINIMUM DISTANCE BETWEEN BFW INJECTION POINT AND THE TI ELEMENT WHICH CONTROLS THE CONTROL VALVE SHALL BE SATISFIED, THIS DISTANCE TO BE DIRECT WITHOUT EXTRA FITTING PREFERABLY.  
2) THE SELECTOR SWITCH THS-7071 ALLOWS OPERATOR TO SELECT CONTROL TV-7071A or TV-7071B  
3) Steam line only used for FT3001 commissioning, the blind flange must be assembled in normal operation.

**REFERENCE DRAWINGS**


**SYMBOLS AND LEGENDS**


**KEY PLAN**

REV.	PURPOSE OF ISSUE	DATE	DESIGN	DRAW	CHECK	REVIEW	APPROVE

THIS DOCUMENT IS THE PROPERTY OF TCC. NO PART OF THIS DOCUMENT SHALL BE REPRODUCED OR DISCLOSED TO OTHERS OR USED FOR ANY PURPOSE WHATSOEVER EXCEPT WITH THE PRIOR WRITTEN PERMISSION OF TCC.


OWNER: **Middle East Kimiaye Pars Company**

LENSOR: **HALDOR TOPSØE A/S** | DOCUMENT NAME: HHP-HP STEAM CONTROL SYSTEM UTILITY DIAGRAM | JOB NO: S-02115 | DOC. GRP: 42 | REV. 1

CONTRACTOR: **TCC 中国天辰工程有限公司** | CONTRACTOR DRAWING NO. MKP-11-AS-7000-HE07-PID-005 | SHEET 01 TOTAL 01



HHP AND HP STEAM HEADER	PROJECT	MKP Methanol Project
PIPING AND INSTRUMENT DIAGRAM	UNIT	STEAM SYSTEM & UTILITIES
	PHASE	AS BUILT DRAWING
	OWNER	MKP-11-AS-7000-PR-PID-010

SCALE 1	SHEET 1	TOT. 1	SIZE A1
---------	---------	--------	---------

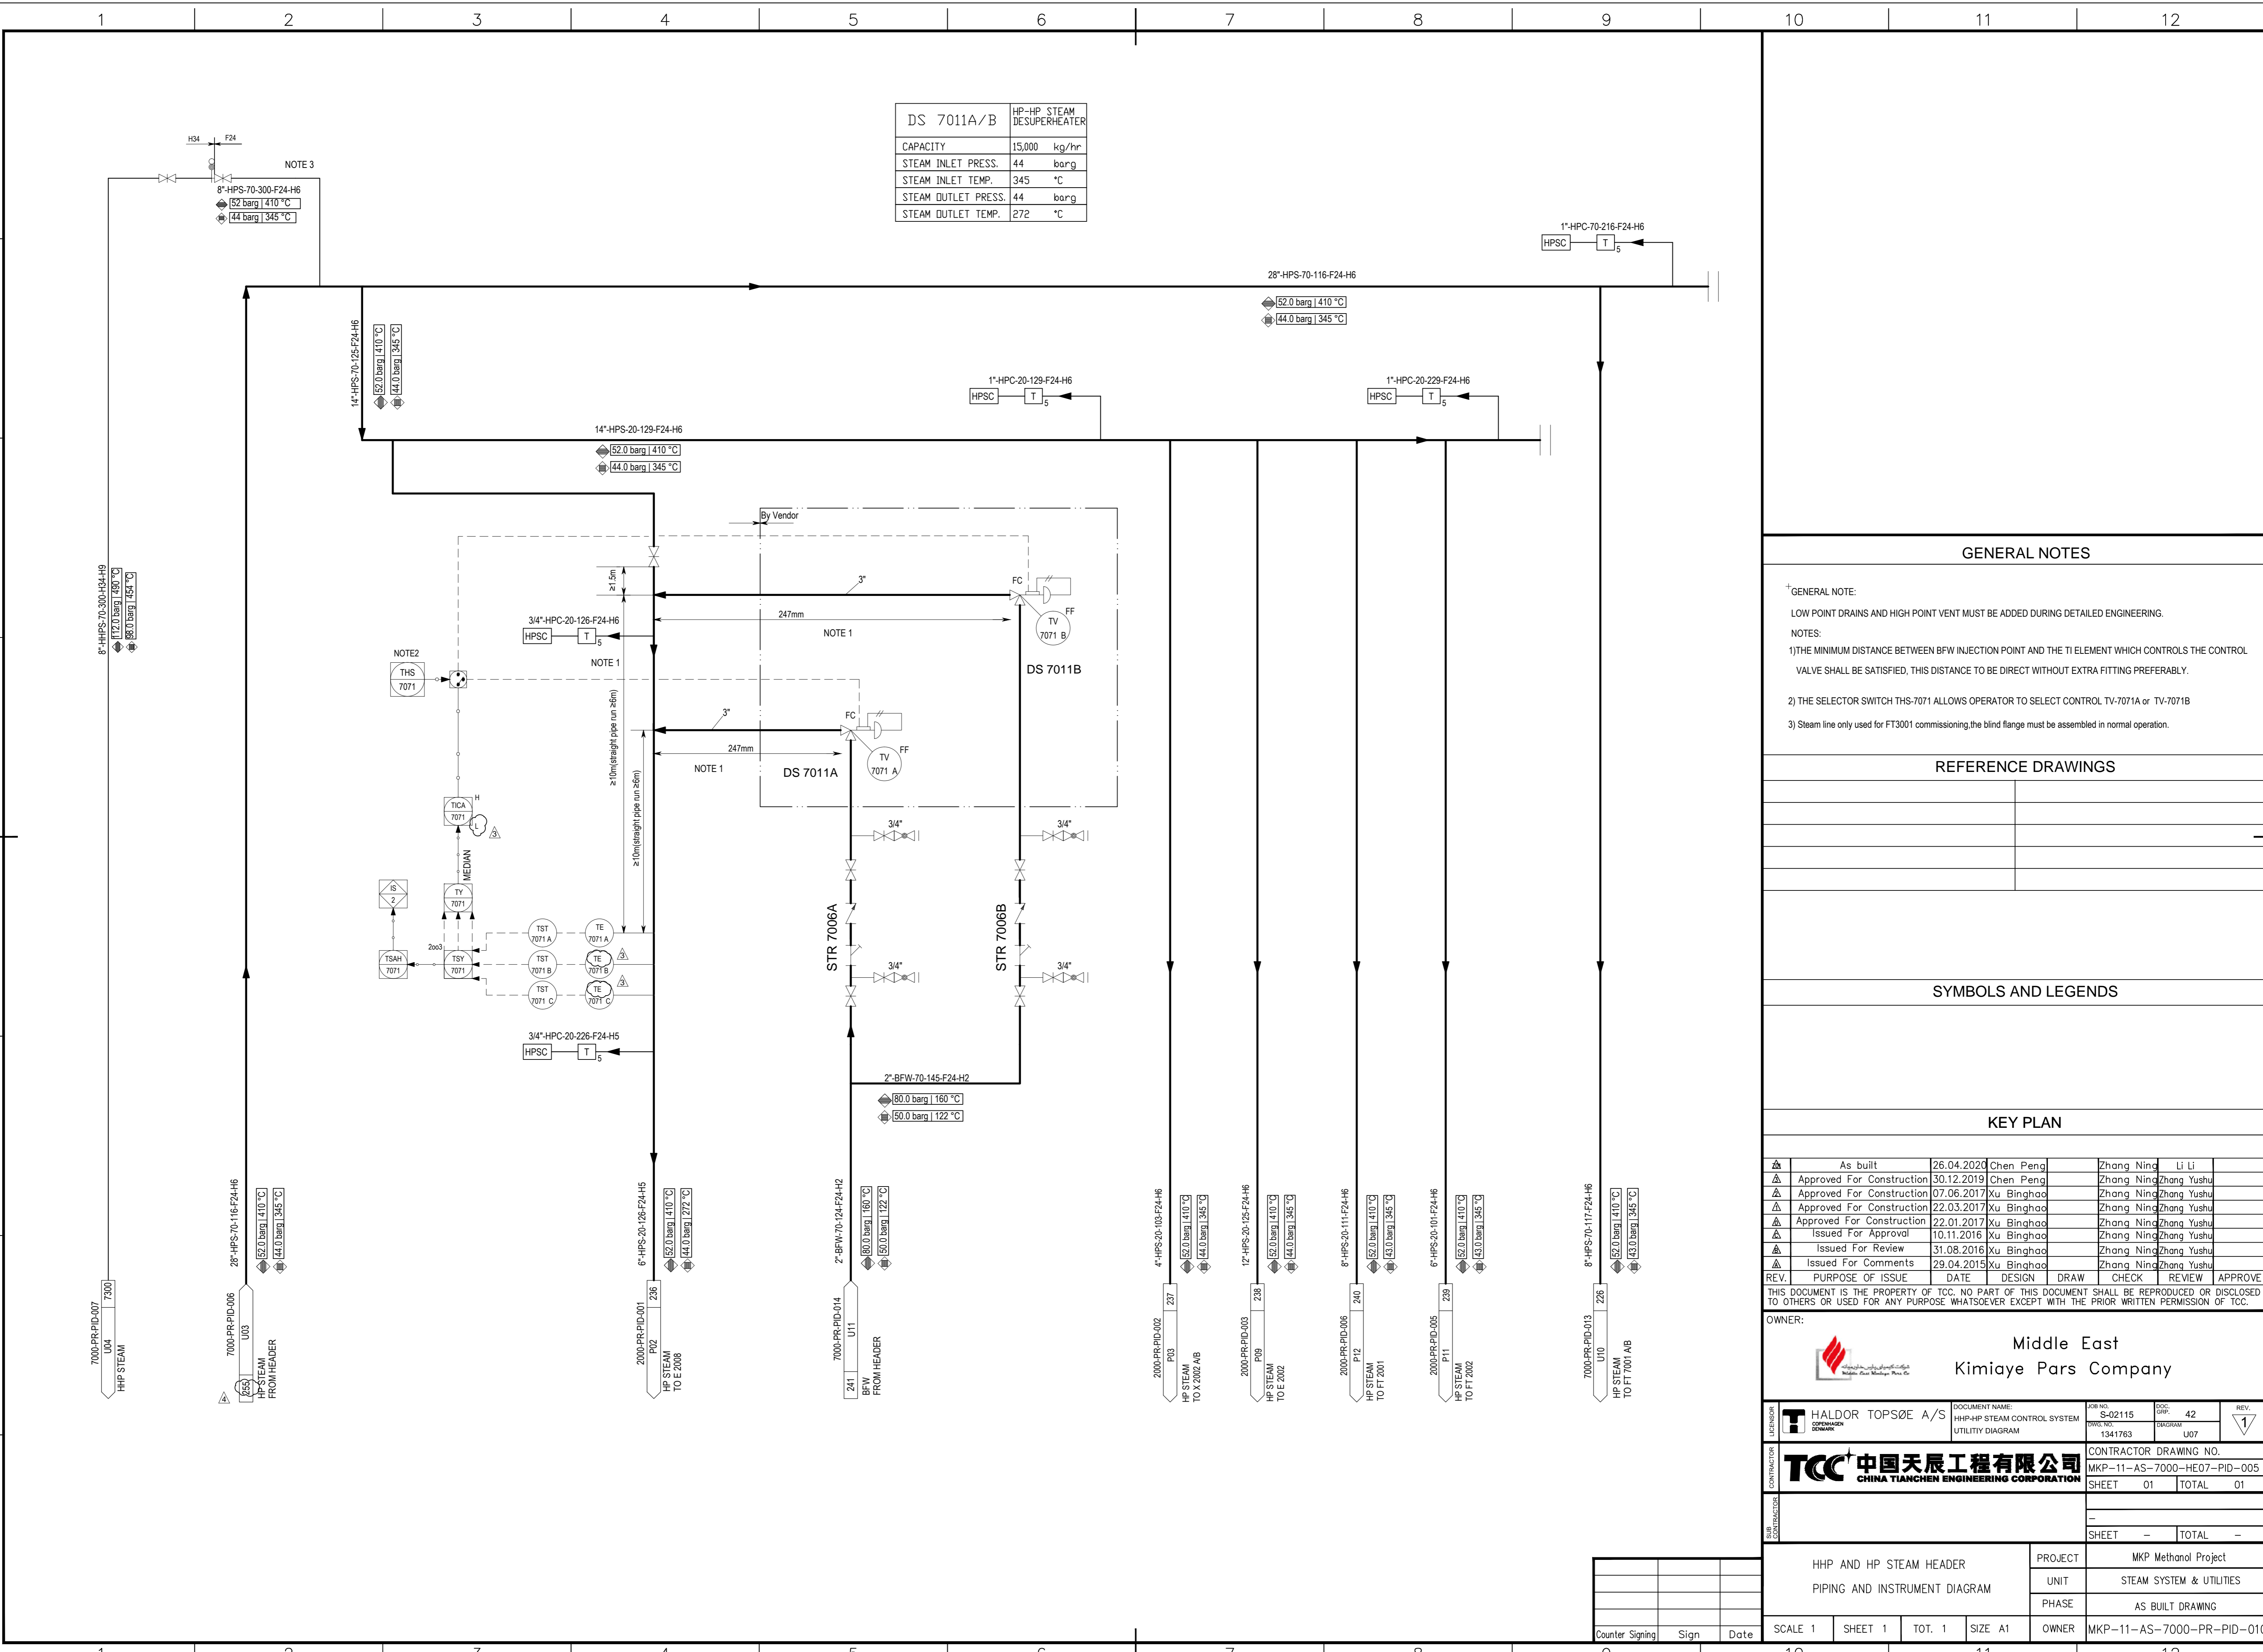

Counter Signing	Sign	Date
-----------------	------	------



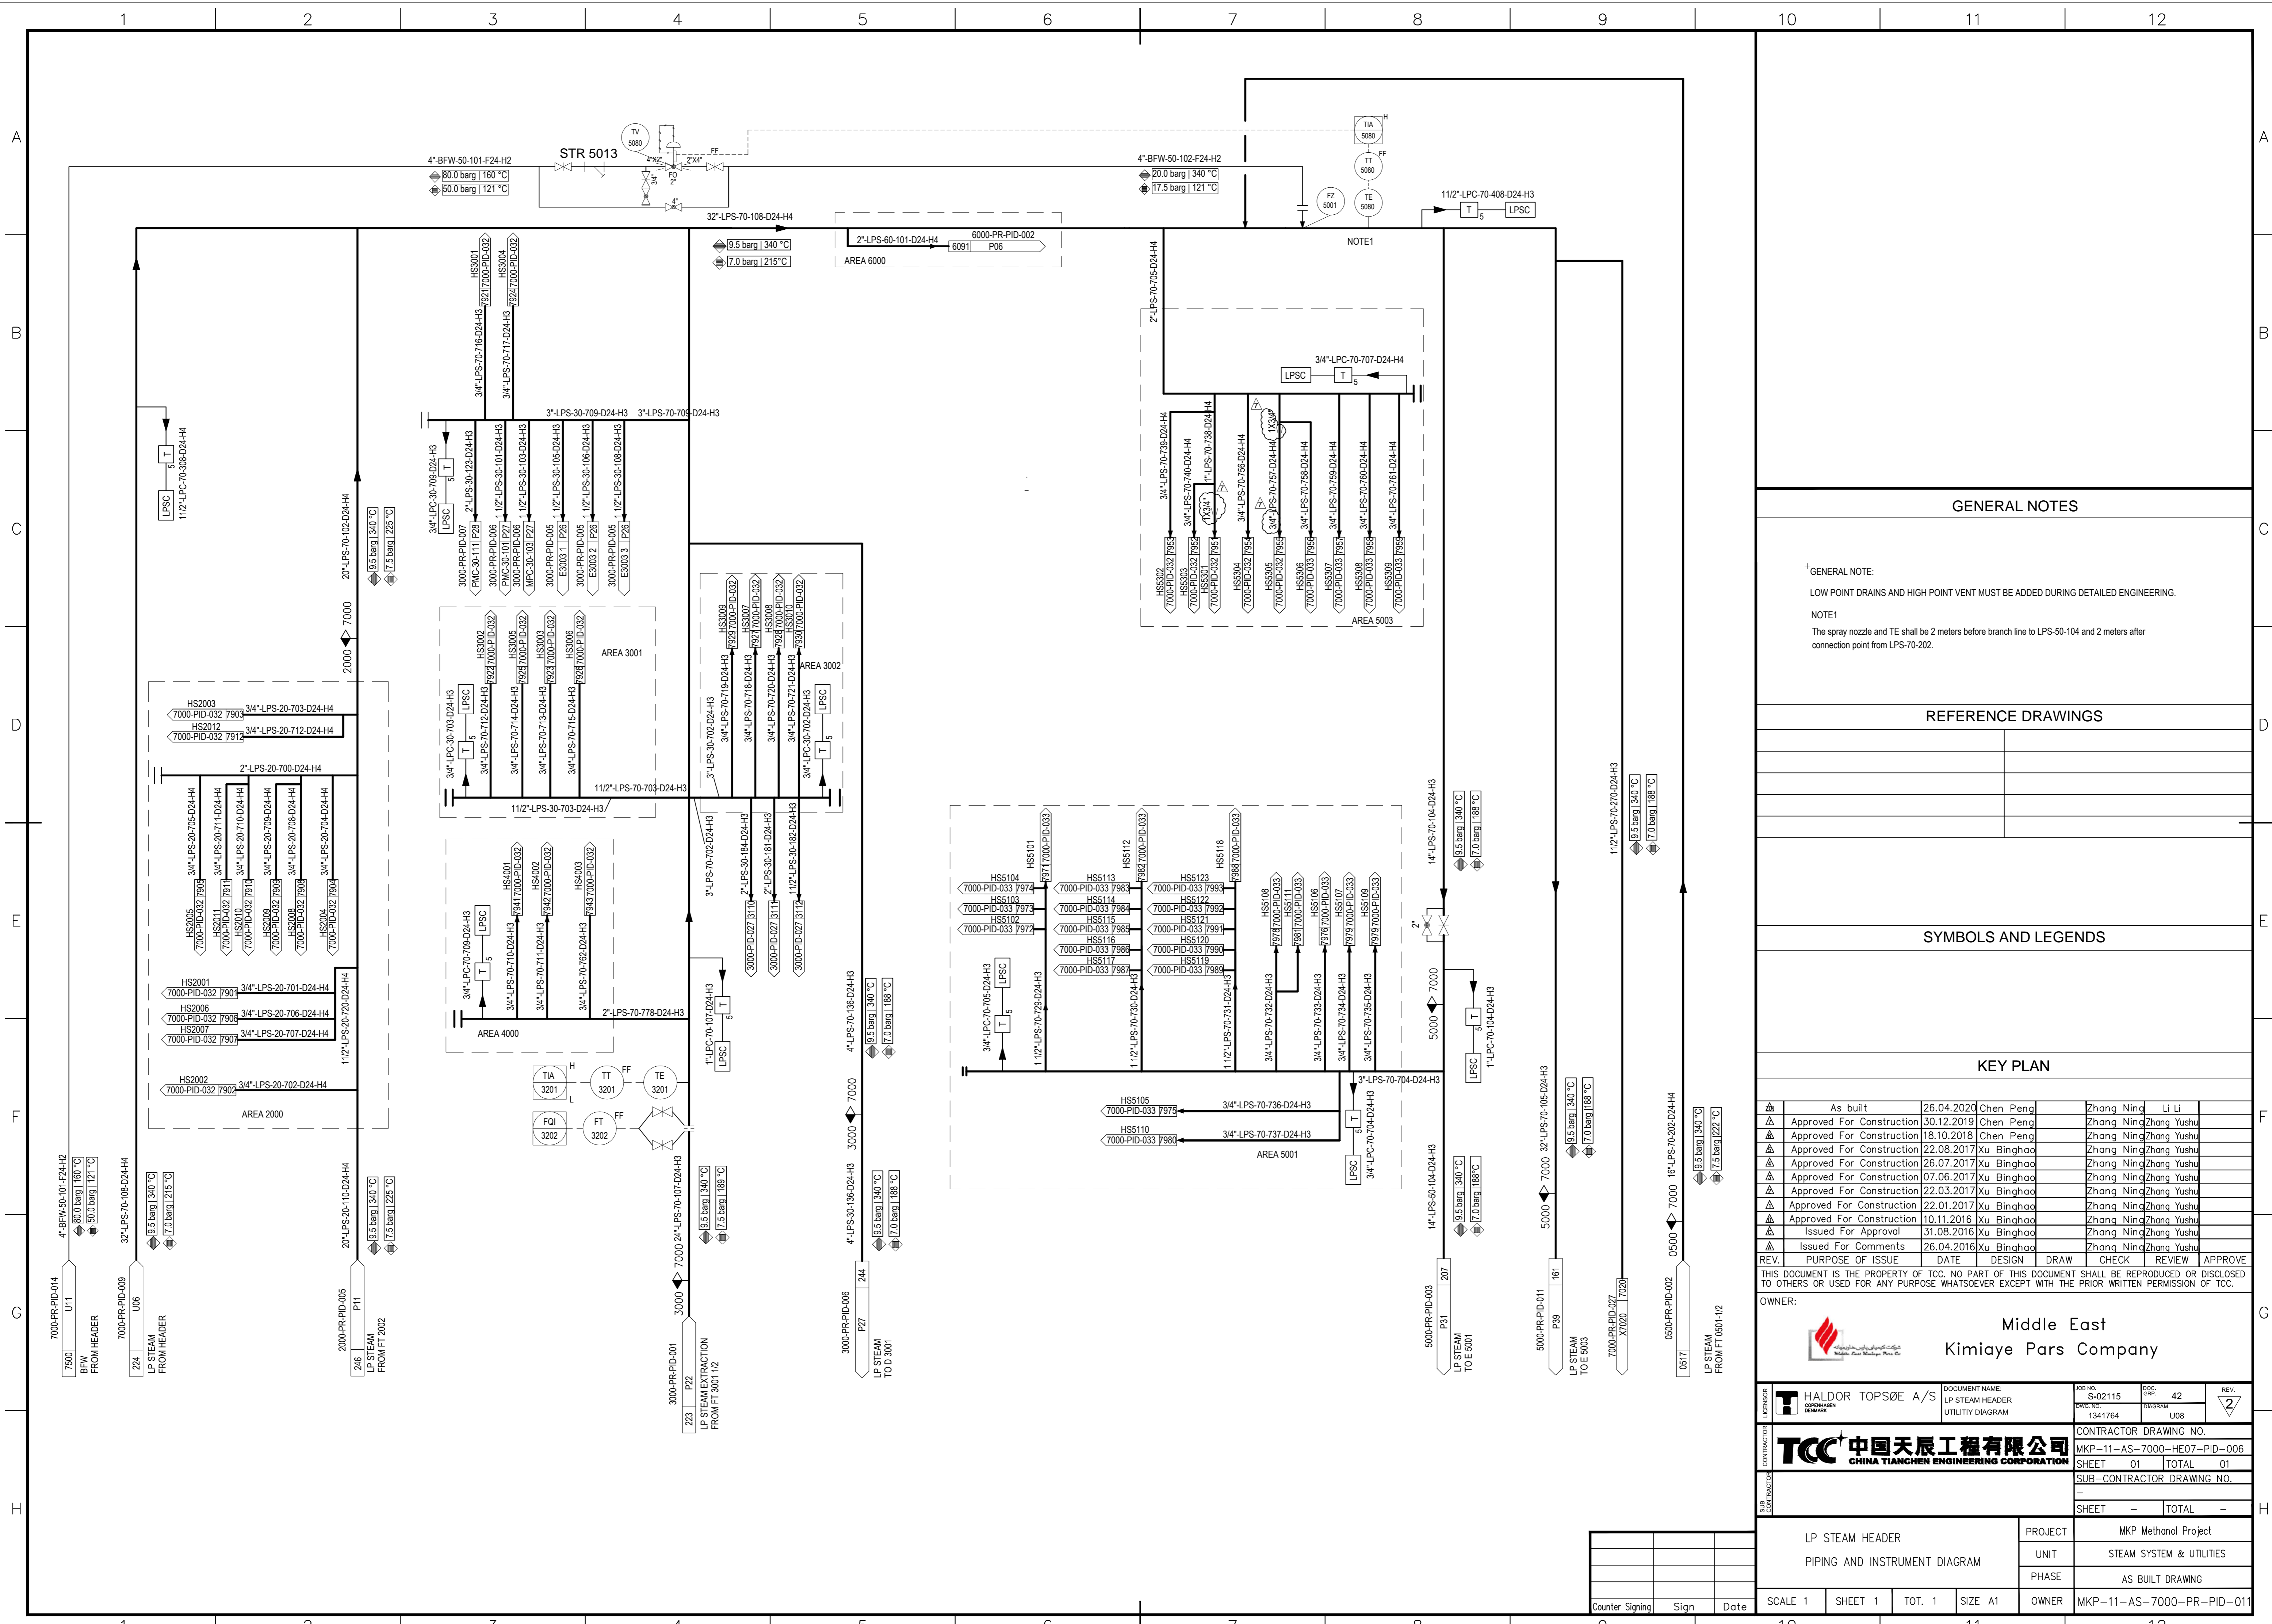

**GENERAL NOTES**

GENERAL NOTE:  
 LOW POINT DRAINS AND HIGH POINT VENT MUST BE ADDED DURING DETAILED ENGINEERING.

NOTE1  
 The spray nozzle and TE shall be 2 meters before branch line to LPS-50-104 and 2 meters after connection point from LPS-70-202.

**REFERENCE DRAWINGS**

**SYMBOLS AND LEGENDS**

**KEY PLAN**

REV.	PURPOSE OF ISSUE	DATE	DESIGN	DRAW	CHECK	REVIEW	APPROVE
As built		26.04.2020	Chen Peng		Zhang Ning	Li Li	
Approved For Construction		30.12.2019	Chen Peng		Zhang Ning	Zhang Yushu	
Approved For Construction		18.10.2018	Chen Peng		Zhang Ning	Zhang Yushu	
Approved For Construction		22.08.2017	Xu Binghao		Zhang Ning	Zhang Yushu	
Approved For Construction		26.07.2017	Xu Binghao		Zhang Ning	Zhang Yushu	
Approved For Construction		07.06.2017	Xu Binghao		Zhang Ning	Zhang Yushu	
Approved For Construction		22.03.2017	Xu Binghao		Zhang Ning	Zhang Yushu	
Approved For Construction		22.01.2017	Xu Binghao		Zhang Ning	Zhang Yushu	
Approved For Construction		10.11.2016	Xu Binghao		Zhang Ning	Zhang Yushu	
Issued For Approval		31.08.2016	Xu Binghao		Zhang Ning	Zhang Yushu	
Issued For Comments		26.04.2016	Xu Binghao		Zhang Ning	Zhang Yushu	

THIS DOCUMENT IS THE PROPERTY OF TCC. NO PART OF THIS DOCUMENT SHALL BE REPRODUCED OR DISCLOSED TO OTHERS OR USED FOR ANY PURPOSE WHATSOEVER EXCEPT WITH THE PRIOR WRITTEN PERMISSION OF TCC.

OWNER: **Middle East Kimiaye Pars Company**

LICENSOR <b>TCC</b> 中国天辰工程 CHINA TIANCHEN ENGINEERING CORPORATION	HALDOR TOPSØE A/S	DOCUMENT NAME LP STEAM HEADER UTILITY DIAGRAM	DOC NO. S-02115	DOC REV. 42	REV. 2
			DRWG. NO. 1341764	DESKMAN U08	
CONTRACTOR	CONTRACTOR DRAWING NO. MKP-11-AS-7000-HE07-PID-006		SHEET 01 TOTAL 01		
CONTRACTOR	SUB-CONTRACTOR DRAWING NO.		SHEET - TOTAL -		

LP STEAM HEADER	PROJECT	MKP Methanol Project
PIPING AND INSTRUMENT DIAGRAM	UNIT	STEAM SYSTEM & UTILITIES
	PHASE	AS BUILT DRAWING
SCALE 1	SHEET 1	TOT. 1
SIZE A1	OWNER	MKP-11-AS-7000-PR-PID-011

Counter Signing	Sign	Date
-----------------	------	------



D 7001	DEAERATOR
ID x LENGTH-T	4400 x 13350 mm
DESIGN PRESS.	3.5 barg
DESIGN TEMP.	200 °C
INSULATION	YES
CLADDING/LINING	NONE
LEVEL OF EQUIPMENT	118.55m

GENERAL NOTES

- GENERAL NOTE:  
LOW POINT DRAINS AND HIGH POINT VENT MUST BE ADDED DURING DETAILED ENGINEERING.
- NOTES:  
1) AS CLOSE AS POSSIBLE TO D 7001.  
2) VALVE TO BE ACCESSIBLE.  
3) PUMP IS STOPPED IN CASE OF LOW SUCTION PRESSURE.  
4) CHECK VALVE AND MIN. FLOW VALVE TO BE OF DIFFERENT MAKE.  
5) COMMON HEADER AT ELEVATION ABOVE INLET NOZZLE TO D 7001.  
6) 1/2" DRIP HOLE TO BE DRILLED AT LOW POINT TO SAFE AND SUITABLE LOCATION.  
7) PIC-7094 SPLIT RANGE CONTROL VALVE OPENING, %
- 
- 8) ANALYSER ELEMENT TO BE INSTALLED MIN. 15x PIPE ID DOWNSTREAM THE MIXING POINT.  
9) NOZZLE B1 ON D 7001 MUST BE LOCATED MIN. 10 m ABOVE P 7001 A/B/C. TO BE CONFIRMED BY PUMP VENDOR.  
10) LV-2016 MUST BE LOCATED AS CLOSE AS POSSIBLE TO D 7001.  
11) HV-2371 MUST BE LOCATED CLOSE TO D 7001.  
12) LV-5070 MUST BE PLACED AS CLOSE AS POSSIBLE TO D 7001. ELEVATION ABOVE D 7001.  
13) FV-5301 MUST BE PLACED AS CLOSE AS POSSIBLE TO D 7001.  
14) TWO PHASE FLOW.  
15) PV-7101 includes 1 noise reduction disks, the size is 20' and the reducer considered by piping.

REFERENCE DRAWINGS

SYMBOLS AND LEGENDS

KEY PLAN


REV.	DESCRIPTION	DATE	DESIGN	DRAW	CHECK	REVIEW	APPROVE
As built		26.04.2020	Chen Peng	Zhang Ning	Li Li		
Approved For Construction		30.12.2019	Chen Peng	Zhang Ning	Zhang Yushu		
Approved For Construction		01.06.2018	Xu Binghao	Zhang Ning	Zhang Yushu		
Approved For Construction		26.07.2017	Xu Binghao	Zhang Ning	Zhang Yushu		
Approved For Construction		07.06.2017	Xu Binghao	Zhang Ning	Zhang Yushu		
Approved For Construction		22.03.2017	Xu Binghao	Zhang Ning	Zhang Yushu		
Approved For Construction		22.01.2017	Xu Binghao	Zhang Ning	Zhang Yushu		
Approved For Construction		10.11.2016	Xu Binghao	Zhang Ning	Zhang Yushu		
Issued For Approval		31.08.2016	Xu Binghao	Zhang Ning	Zhang Yushu		
Issued For Comments		29.04.2015	Xu Binghao	Zhang Ning	Zhang Yushu		

THIS DOCUMENT IS THE PROPERTY OF TCC. NO PART OF THIS DOCUMENT SHALL BE REPRODUCED OR DISCLOSED TO OTHERS OR USED FOR ANY PURPOSE WHATSOEVER EXCEPT WITH THE PRIOR WRITTEN PERMISSION OF TCC.

OWNER: Middle East Kimiaye Pars Company

LICENSOR <b>T</b> HALDOR TOPSØE A/S COPENHAGEN DENMARK	DOCUMENT NAME: DEAERATOR UTILITY DIAGRAM	JOB NO. S-02115	DOC. GRP. 42	REV. 3
	CONTRACTOR <b>TCC</b> 中国天辰工程有限公司 CHINA TIANCHEN ENGINEERING CORPORATION	CONTRACTOR DRAWING NO. MKP-11-AS-7000-HE07-PID-007	SHEET 01	TOTAL 01

DEAERATOR	PROJECT	MKP Methanol Project
PIPING AND INSTRUMENT DIAGRAM	UNIT	STEAM SYSTEM & UTILITIES
	PHASE	AS BUILT DRAWING
SCALE 1	SHEET 1	TOT. 1
SIZE A1	OWNER	MKP-11-AS-7000-PR-PID-012

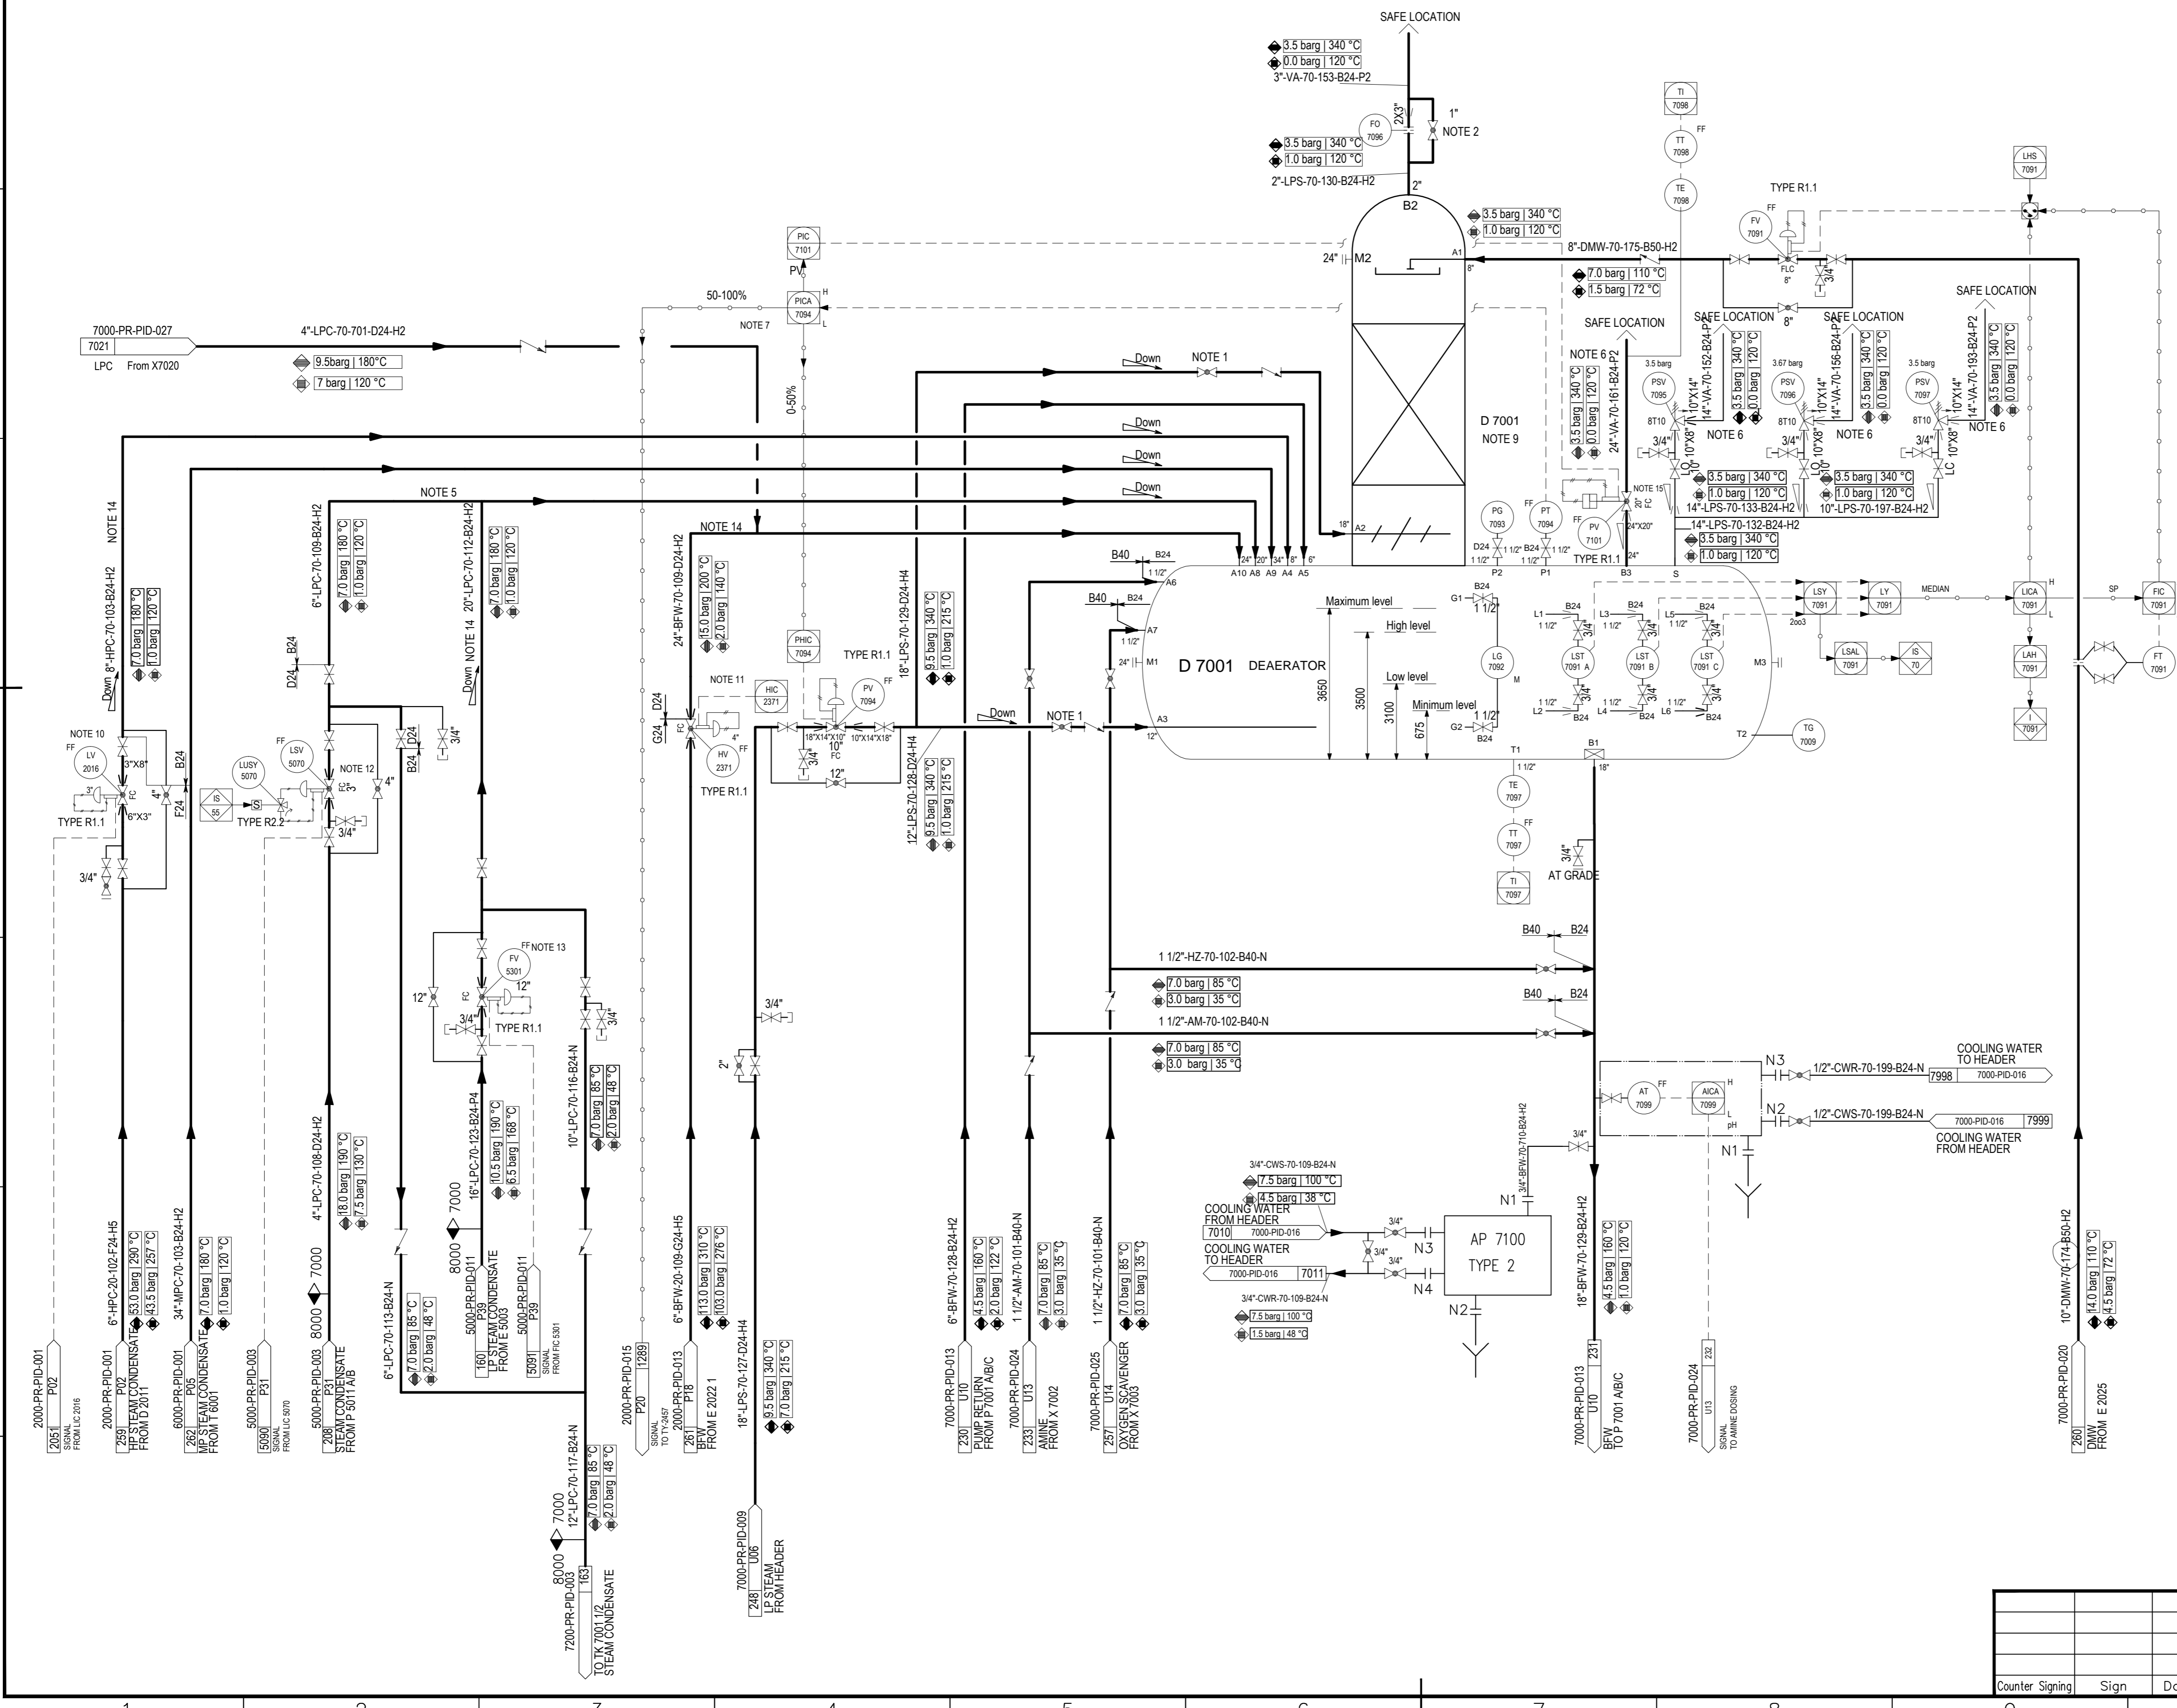

1 2 3 4 5 6 7 8 9 10 11 12

A B C D E F G H

A B C D E F G H




Counter Signing Sign Date



SI 7013	HP STEAM VENT SILENCER
CAPACITY	20,000 kg/hr
DESIGN PRESS.	7 barg
DESIGN TEMP.	410 °C
MATERIAL SHELL	CS

FT 7001A/B	STEAM TURBINE FOR P7001 A/B
TYPE	BACK PRESSURE
DESIGN PRESS.	52 barg
DESIGN TEMP.	410 °C
MATERIAL	CS
RATED POWER	1344.5 kW


P 7001A/BC	BFW PUMP
CAPACITY	267.3 m <sup>3</sup> /h
HEAD	1374.3 m
DENSITY@OT	943 barg
INSULATION/TRACING	NONE
AUXILIARY PIPING	By Vendor
AUXILIARY PIPING	By Vendor
LEVEL OF EQUIPMENT	103.09m

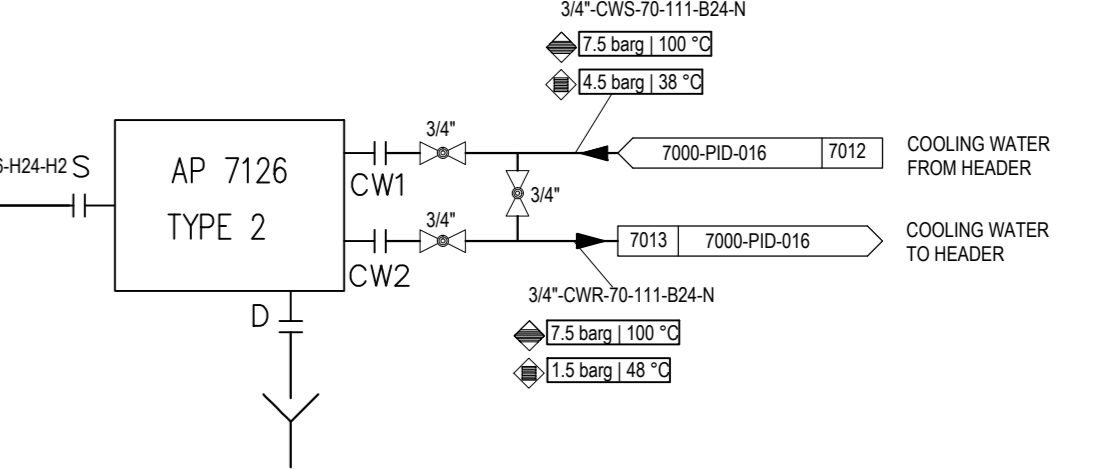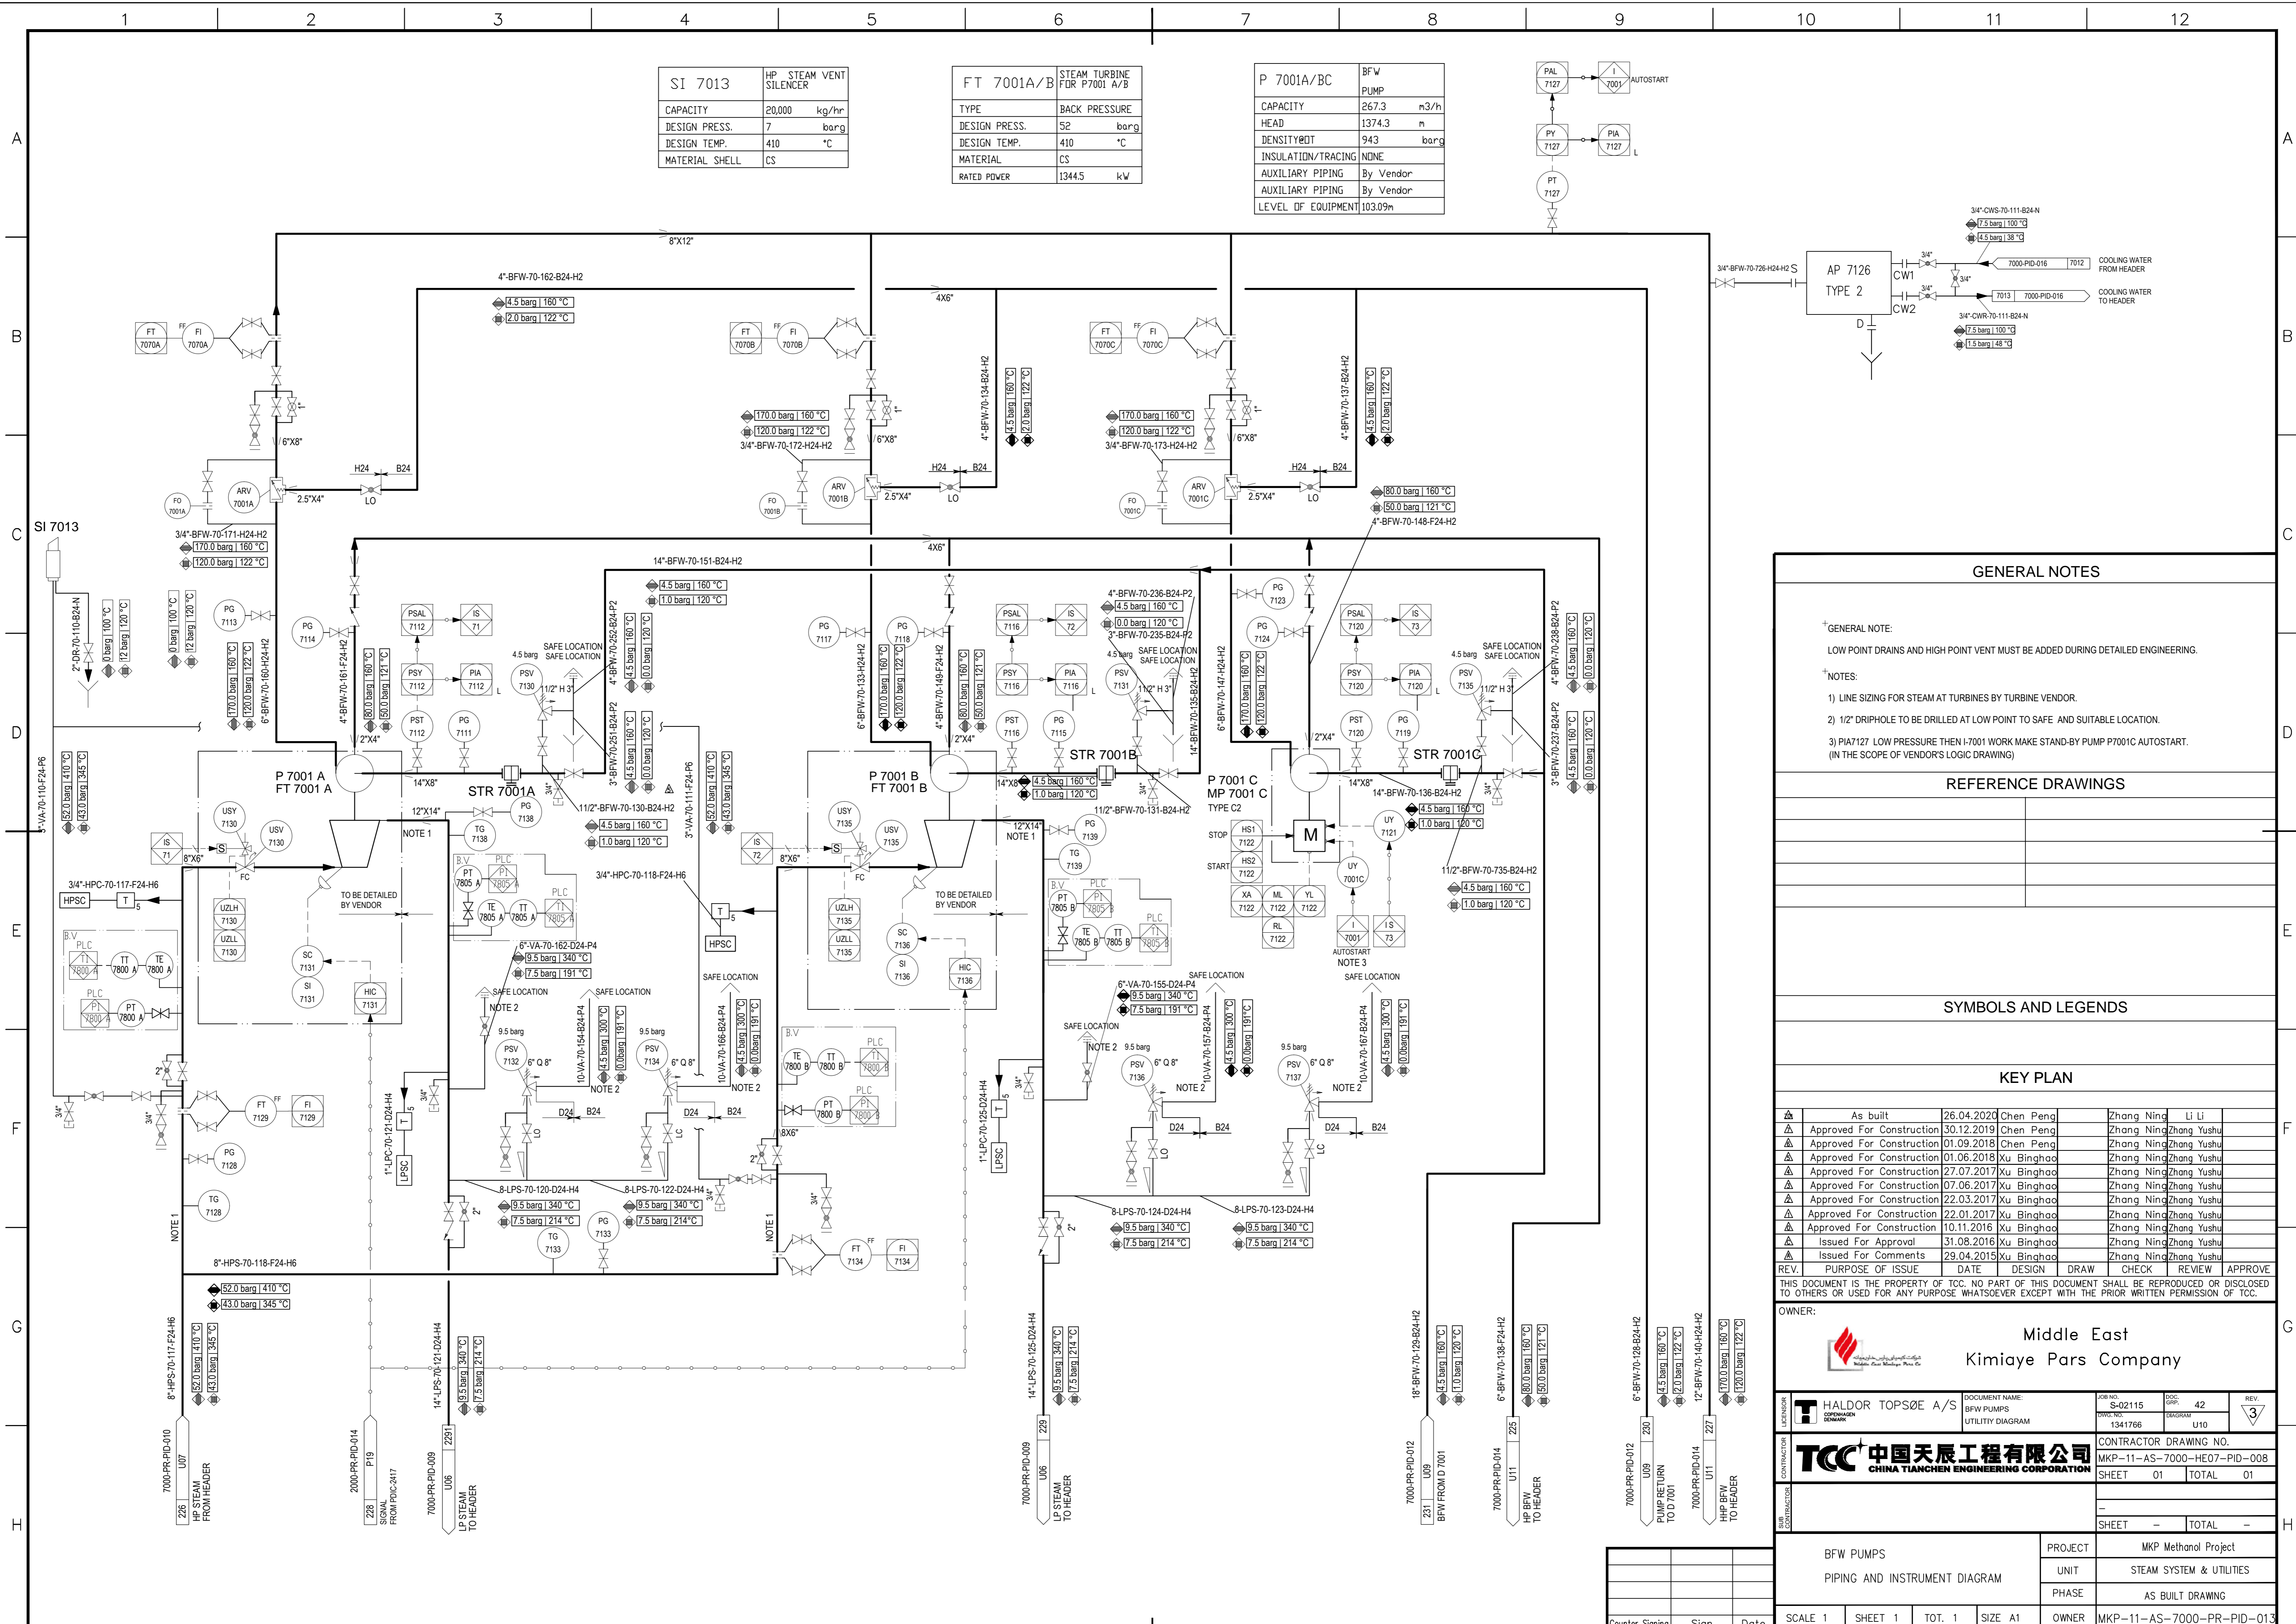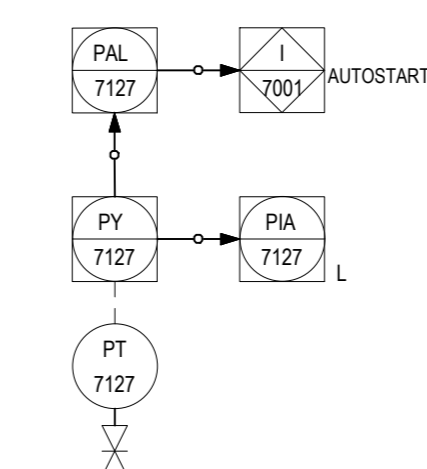

GENERAL NOTES							
+GENERAL NOTE: LOW POINT DRAINS AND HIGH POINT VENT MUST BE ADDED DURING DETAILED ENGINEERING.							
+NOTES: 1) LINE SIZING FOR STEAM AT TURBINES BY TURBINE VENDOR. 2) 1/2" DRIPHOLE TO BE DRILLED AT LOW POINT TO SAFE AND SUITABLE LOCATION. 3) PIA7127 LOW PRESSURE THEN I-7001 WORK MAKE STAND-BY PUMP P7001C AUTOSTART. (IN THE SCOPE OF VENDOR'S LOGIC DRAWING)							
REFERENCE DRAWINGS							
SYMBOLS AND LEGENDS							
KEY PLAN							
As built	26.04.2020	Chen Peng	Zhang Ning	Li Li			
Approved For Construction	30.12.2019	Chen Peng	Zhang Ning	Zhang Yushu			
Approved For Construction	01.09.2018	Chen Peng	Zhang Ning	Zhang Yushu			
Approved For Construction	01.06.2018	Xu Binghao	Zhang Ning	Zhang Yushu			
Approved For Construction	27.07.2017	Xu Binghao	Zhang Ning	Zhang Yushu			
Approved For Construction	07.06.2017	Xu Binghao	Zhang Ning	Zhang Yushu			
Approved For Construction	22.03.2017	Xu Binghao	Zhang Ning	Zhang Yushu			
Approved For Construction	22.01.2017	Xu Binghao	Zhang Ning	Zhang Yushu			
Approved For Construction	10.11.2016	Xu Binghao	Zhang Ning	Zhang Yushu			
Issued For Approval	31.08.2016	Xu Binghao	Zhang Ning	Zhang Yushu			
Issued For Comments	29.04.2015	Xu Binghao	Zhang Ning	Zhang Yushu			
REV.	PURPOSE OF ISSUE	DATE	DESIGN	DRAW	CHECK	REVIEW	APPROVE
OWNER:							
Middle East Kimiaye Pars Company							
LICENSOR: <b>T HALDOR TOPSØE A/S</b>		DOCUMENT NAME: BFW PUMPS UTILITY DIAGRAM		JOB NO. S-02115	ECC. GRP. 42	REV. 3	
CONTRACTOR: <b>TCC 中国天辰工程有限公司</b> CHINA TIANCHEN ENGINEERING CORPORATION		CONTRACTOR DRAWING NO. MKP-11-AS-7000-HE07-PID-008		CONTRACTOR 1341766	CONTRACTOR U10		
SHEET 01		TOTAL 01					
SHEET -		TOTAL -					
BFW PUMPS		PROJECT		MKP Methanol Project			
PIPING AND INSTRUMENT DIAGRAM		UNIT		STEAM SYSTEM & UTILITIES			
		PHASE		AS BUILT DRAWING			
SCALE 1		SHEET 1		TOT. 1		SIZE A1	
OWNER		MKP-11-AS-7000-PR-PID-013					

Counter Signing Sign Date



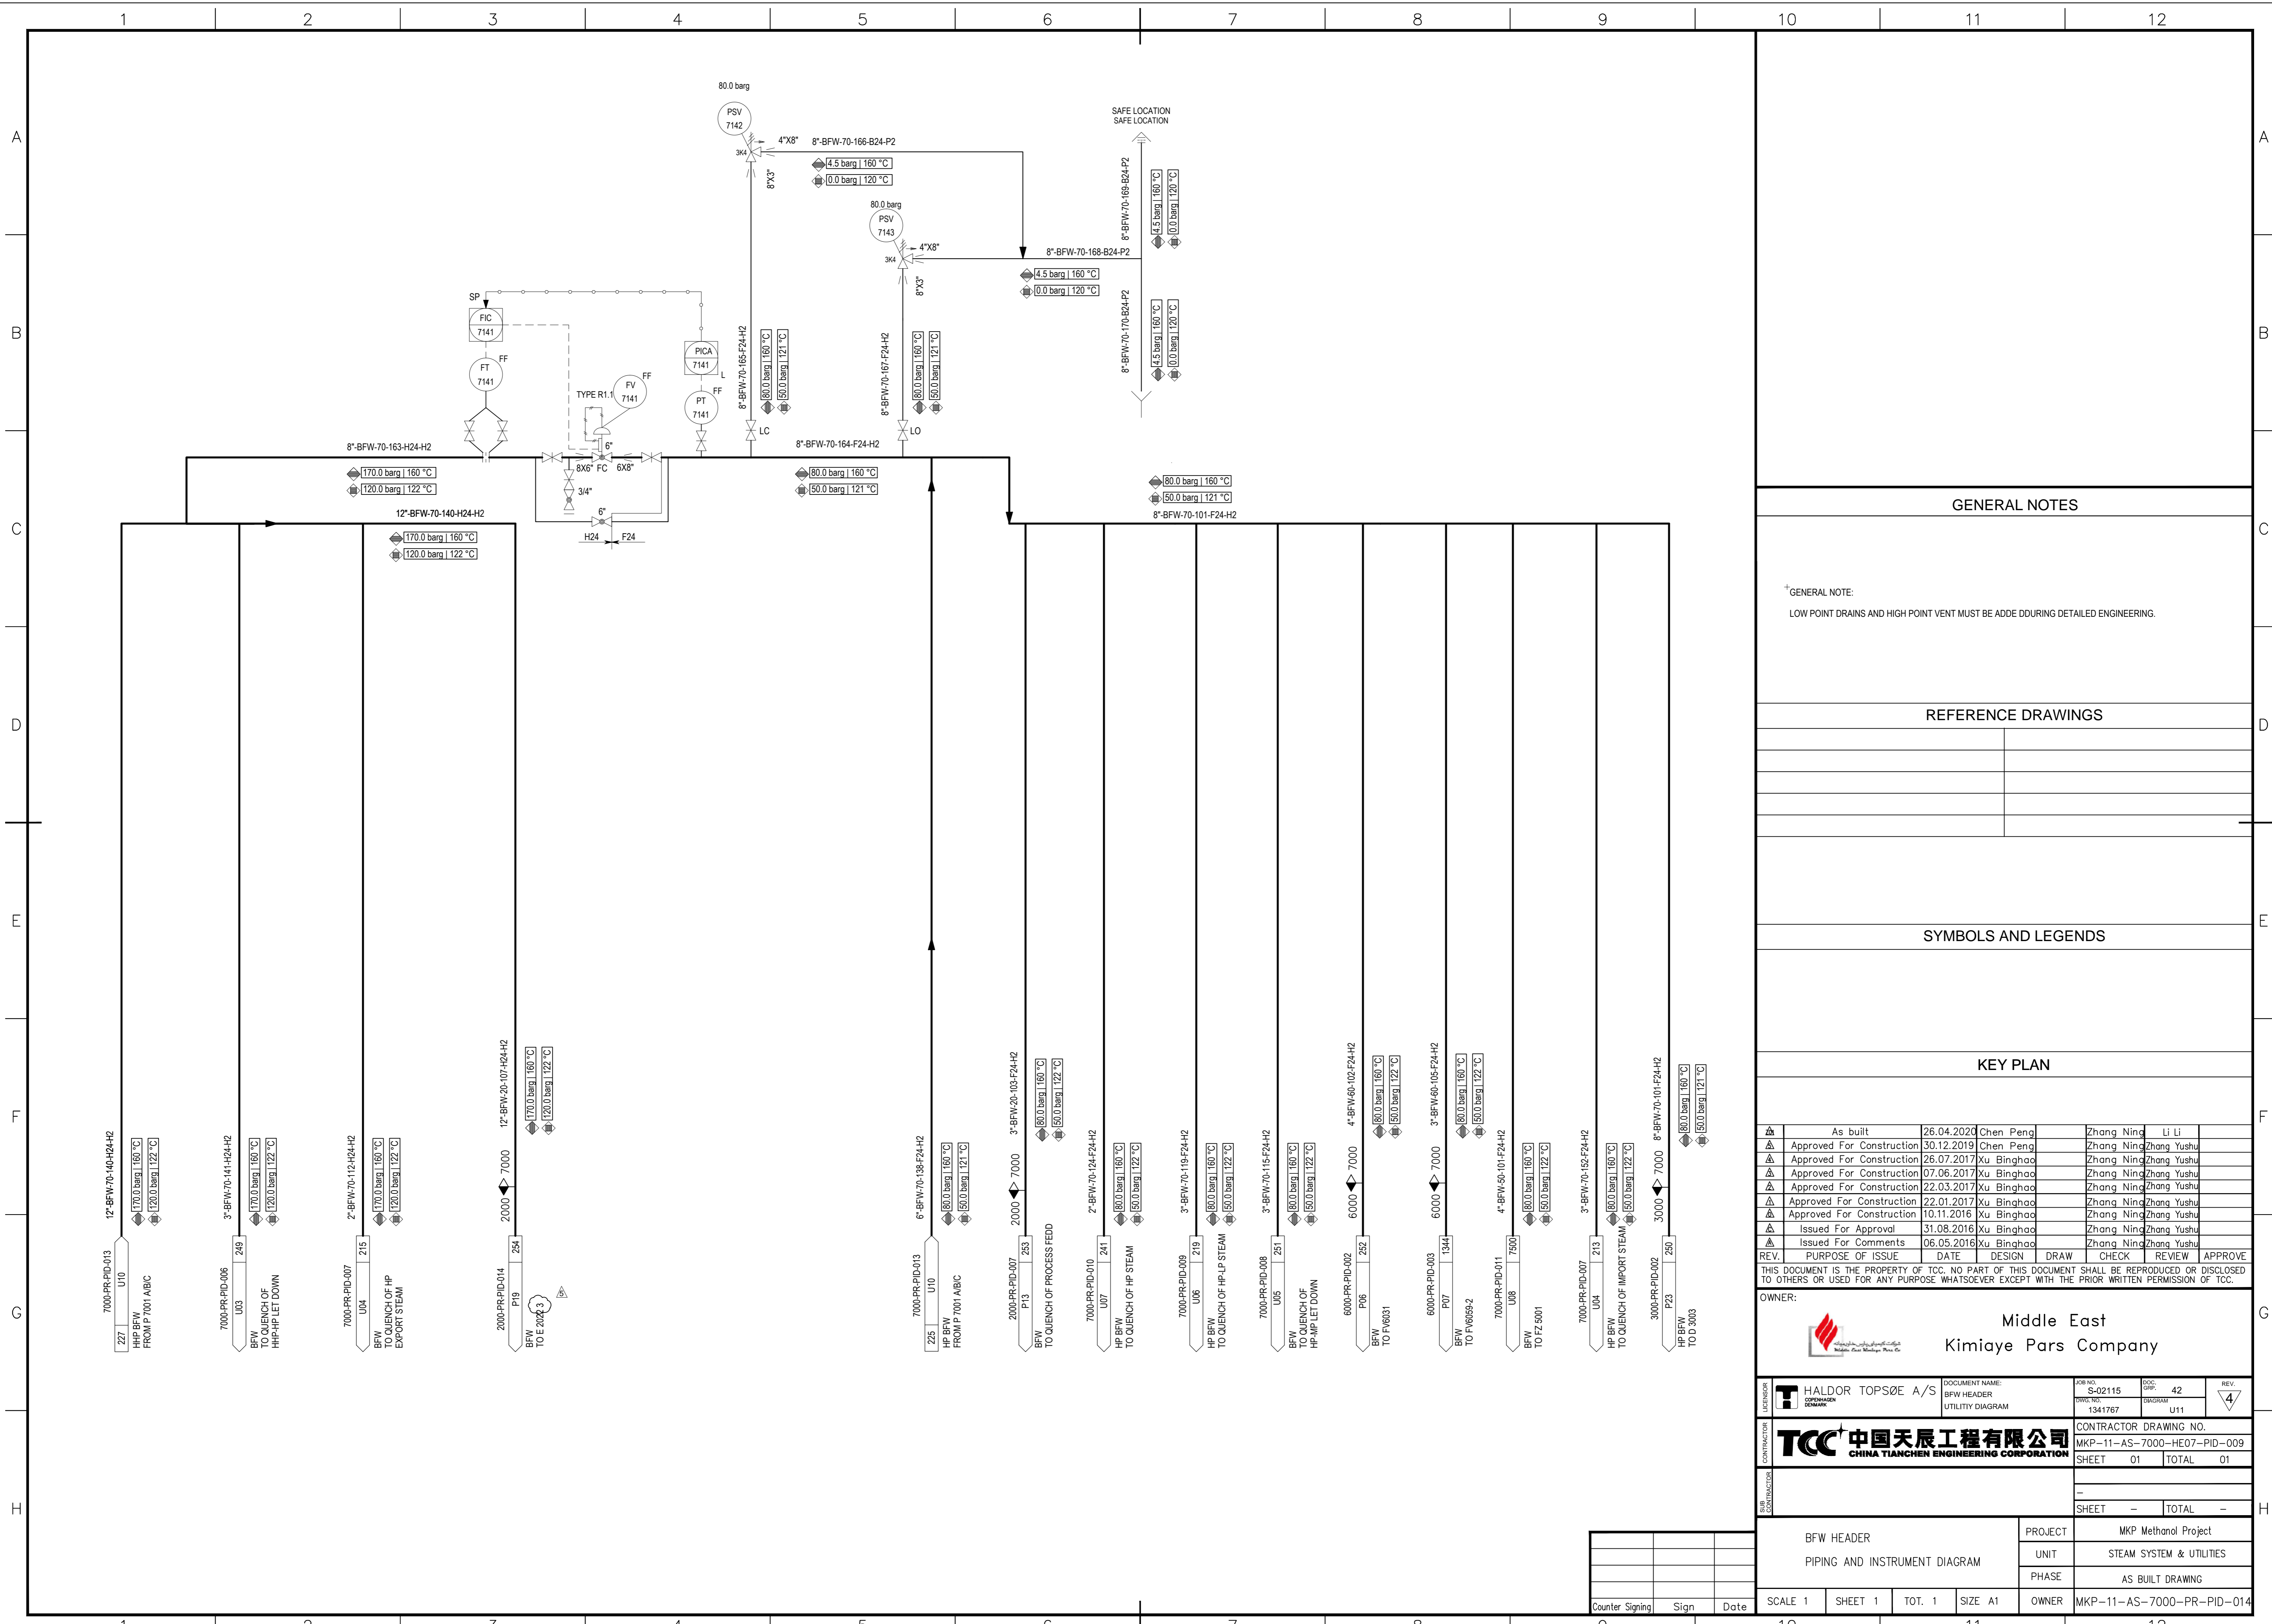

GENERAL NOTES

† GENERAL NOTE:  
LOW POINT DRAINS AND HIGH POINT VENT MUST BE ADDED DURING DETAILED ENGINEERING.

REFERENCE DRAWINGS

SYMBOLS AND LEGENDS

KEY PLAN

REV.	PURPOSE OF ISSUE	DATE	DESIGN	DRAW	CHECK	REVIEW	APPROVE
As built		26.04.2020	Chen Peng		Zhang Ning	Li Li	
Approved For Construction		30.12.2019	Chen Peng		Zhang Ning	Zhang Yushu	
Approved For Construction		26.07.2017	Xu Binghao		Zhang Ning	Zhang Yushu	
Approved For Construction		07.06.2017	Xu Binghao		Zhang Ning	Zhang Yushu	
Approved For Construction		22.03.2017	Xu Binghao		Zhang Ning	Zhang Yushu	
Approved For Construction		22.01.2017	Xu Binghao		Zhang Ning	Zhang Yushu	
Approved For Construction		10.11.2016	Xu Binghao		Zhang Ning	Zhang Yushu	
Issued For Approval		31.08.2016	Xu Binghao		Zhang Ning	Zhang Yushu	
Issued For Comments		06.05.2016	Xu Binghao		Zhang Ning	Zhang Yushu	

THIS DOCUMENT IS THE PROPERTY OF TCC. NO PART OF THIS DOCUMENT SHALL BE REPRODUCED OR DISCLOSED TO OTHERS OR USED FOR ANY PURPOSE WHATSOEVER EXCEPT WITH THE PRIOR WRITTEN PERMISSION OF TCC.

OWNER:  Middle East Kimiaye Pars Company

LICENSOR <b>T</b> HALDOR TOPSØE A/S COPENHAGEN DENMARK	DOCUMENT NAME: BFW HEADER UTILITY DIAGRAM	JOB NO. S-02115	DOC. GRP. 42	REV. 4
	CONTRACTOR <b>TCC</b> 中国天辰工程有限公司 CHINA TIANCHEN ENGINEERING CORPORATION	CONTRACTOR DRAWING NO. MKP-11-AS-7000-HE07-PID-009	SHEET 01	TOTAL 01
SHEET -		TOTAL -		

BFW HEADER PIPING AND INSTRUMENT DIAGRAM		PROJECT MKP Methanol Project
		UNIT STEAM SYSTEM & UTILITIES
		PHASE AS BUILT DRAWING
SCALE 1		OWNER MKP-11-AS-7000-PR-PID-014


Counter Signing	Sign	Date

P7004A/B	EXCESS CONDENSATE RETURN PUMP
RATED CAPACITY	6.1 m <sup>3</sup> /h
HEAD	542 m
DENSITY@DT	980 kg/m <sup>3</sup>
INSULATION/TRACING	NONE
AUXILIARY PIPING	By Vendor
ELEV. of EQUIPMENT	EL+101.050m

TK7002	PROCESS CONDENSATE BUFFER TANK
ID x LENGTH	12000x10000 mm
NET WORKING CAPACITY	1000 m <sup>3</sup>
DESIGN PRESS.	0.02 barg
DESIGN TEMP.	100 °C
INSULATION	NONE
ELEV. of EQUIPMENT	EL+101.540m

GENERAL NOTES

- †GENERAL NOTE:  
LOW POINT DRAINS AND HIGH POINT VENT MUST BE ADDED DURING DETAILED ENGINEERING.
- †NOTES:  
1) PSV AND PULSATION DAMPER ARE IN VENDOR'S SUPPLY SCOPE.  
2) THIS VALVE ONLY COULD BE CLOSED WHEN XH-7002B NEEDS TO BE REMOVED.

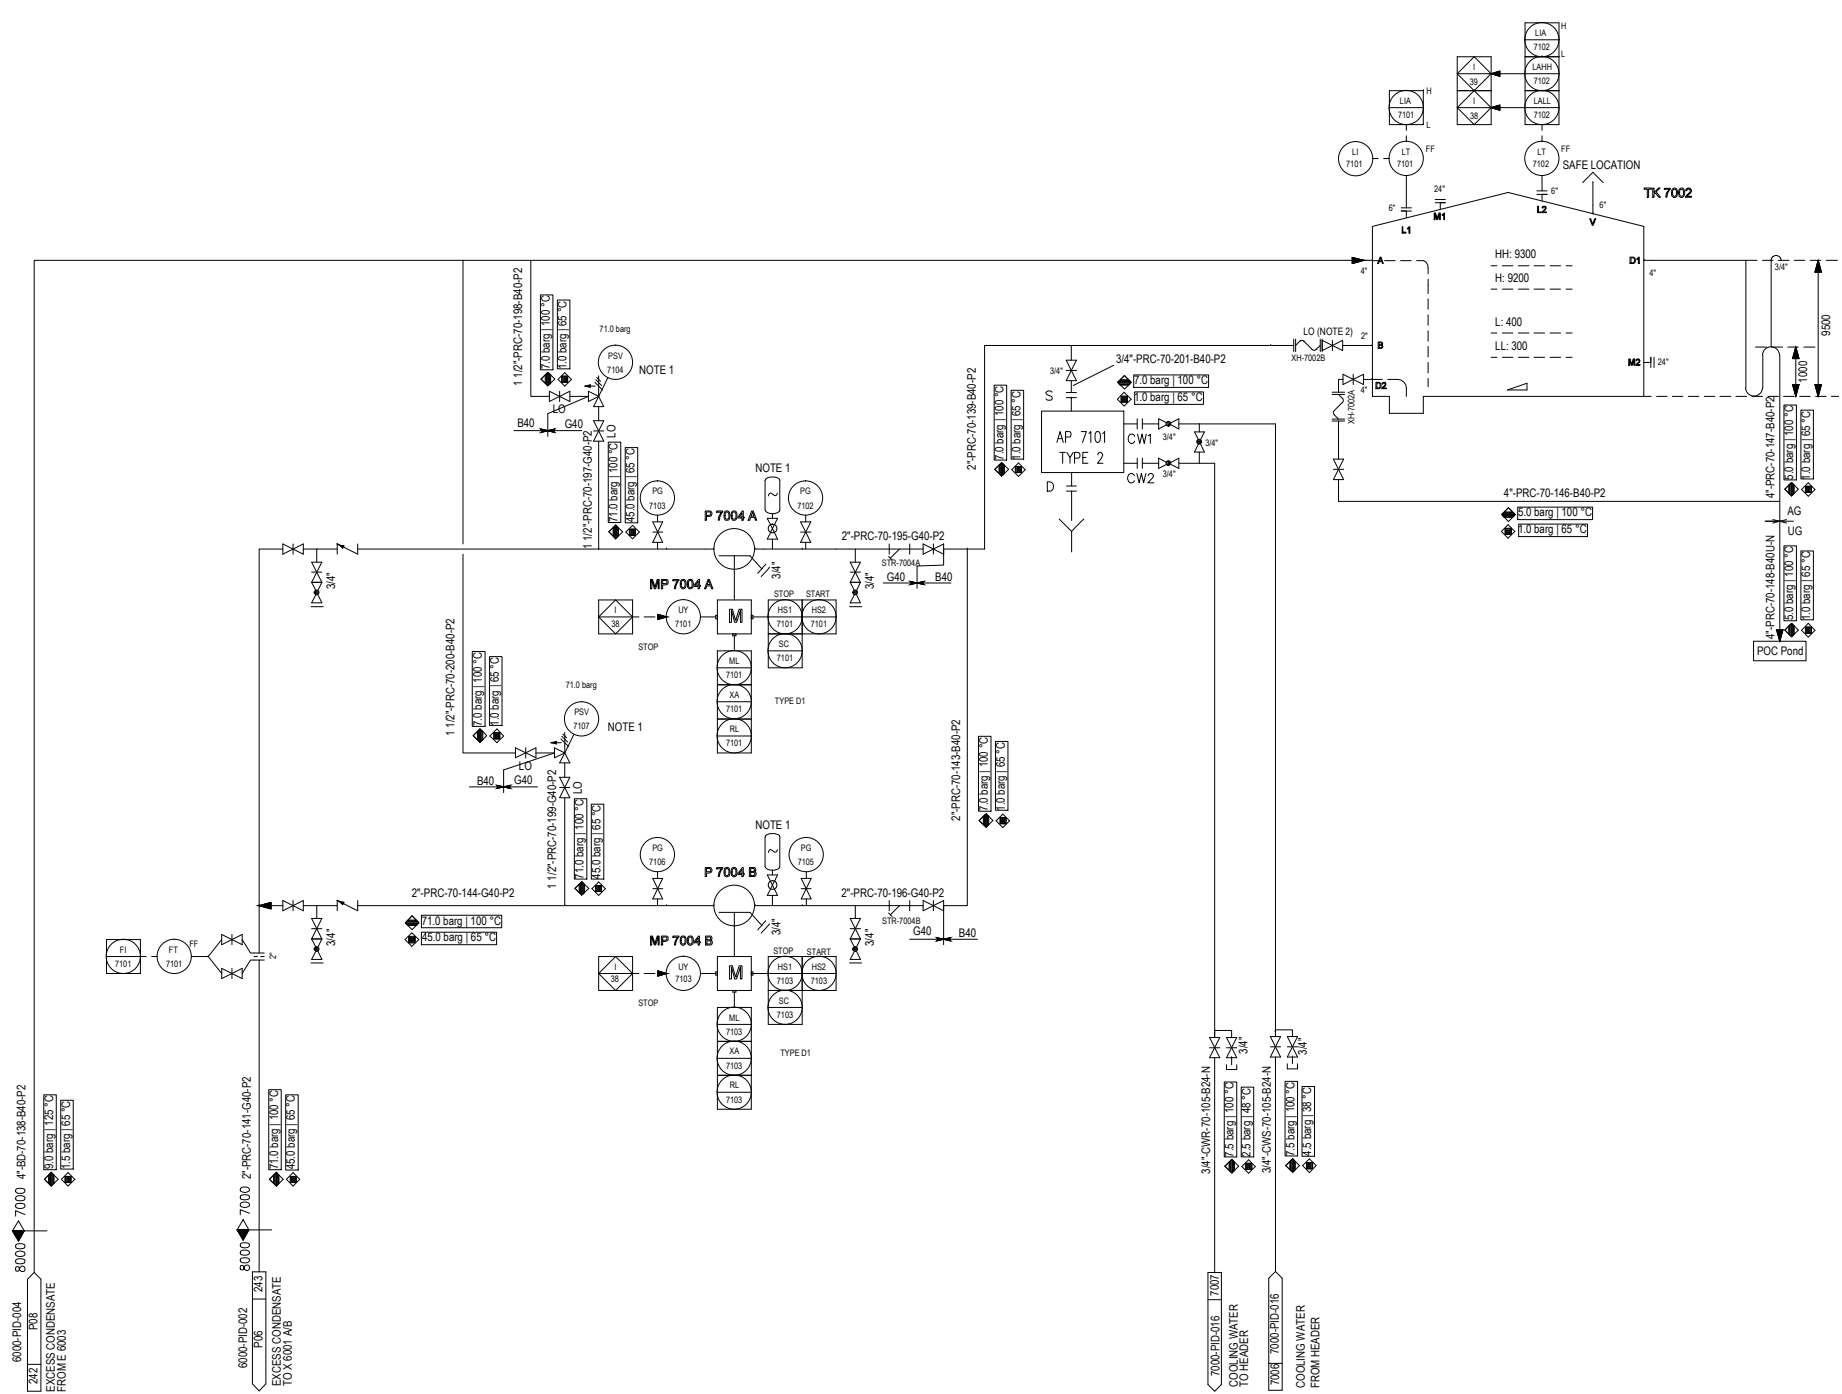

REFERENCE DRAWINGS

SYMBOLS AND LEGENDS

KEY PLAN

▲	As Built	30.04.2020	Jiang Yu		Xu Hang	Liu Shengkai
▲	Approved for Construction	30.12.2019	Jiang Yu		Xu Hang	Liu Shengkai
▲	Approved for Construction	06.11.2017	Chen Tao		Xu Hang	Liu Shengkai
▲	Approved for Construction	04.05.2017	Chen Tao		Xu Hang	Shi Jing
▲	Approved for Construction	12.04.2017	Chen Tao		Xu Hang	Shi Jing
▲	Approved for Construction	20.01.2017	Chen Tao		Xu Hang	Shi Jing
▲	Issued for Approval	16.10.2016	Chen Tao		Xu Hang	Shi Jing
▲	Issued for Approval	31.08.2016	Chen Tao		Xu Hang	Shi Jing
▲	Issued for Approval	29.06.2016	Chen Tao		Xu Hang	Shi Jing
▲	Issued for Comments	29.04.2016	Chen Tao		Xu Hang	Shi Jing

THIS DOCUMENT IS THE PROPERTY OF TCC. NO PART OF THIS DOCUMENT SHALL BE REPRODUCED OR DISCLOSED TO OTHERS OR USED FOR ANY PURPOSE WHATSOEVER EXCEPT WITH THE PRIOR WRITTEN PERMISSION OF TCC.


OWNER: **Middle East Kimiaye Pars Company**

CONTRACTOR	HALDOR TOPSØE A/S	DOCUMENT NAME	PROCESS CONDENSATE STORAGE UTILITY DIAGRAM	JOB NO.	S-02115	CDR	42	REV.	2
CONTRACT NO.	1353319	DATE	202003	SCALE	UZZ				

CONTRACTOR DRAWING NO.	
MKP-11-AS-7000-PS09-PID-015	
SHEET	TOTAL
01	01
SUB-CONTRACTOR DRAWING NO.	
SHEET - TOTAL -	

PROJECT	MKP Methanol Project
UNIT	Steam System & Utilities
PHASE	As Built Drawing
OWNER DWG NO.	MKP-11-AS-7000-PR-PID-015

Counter	Sign	Date

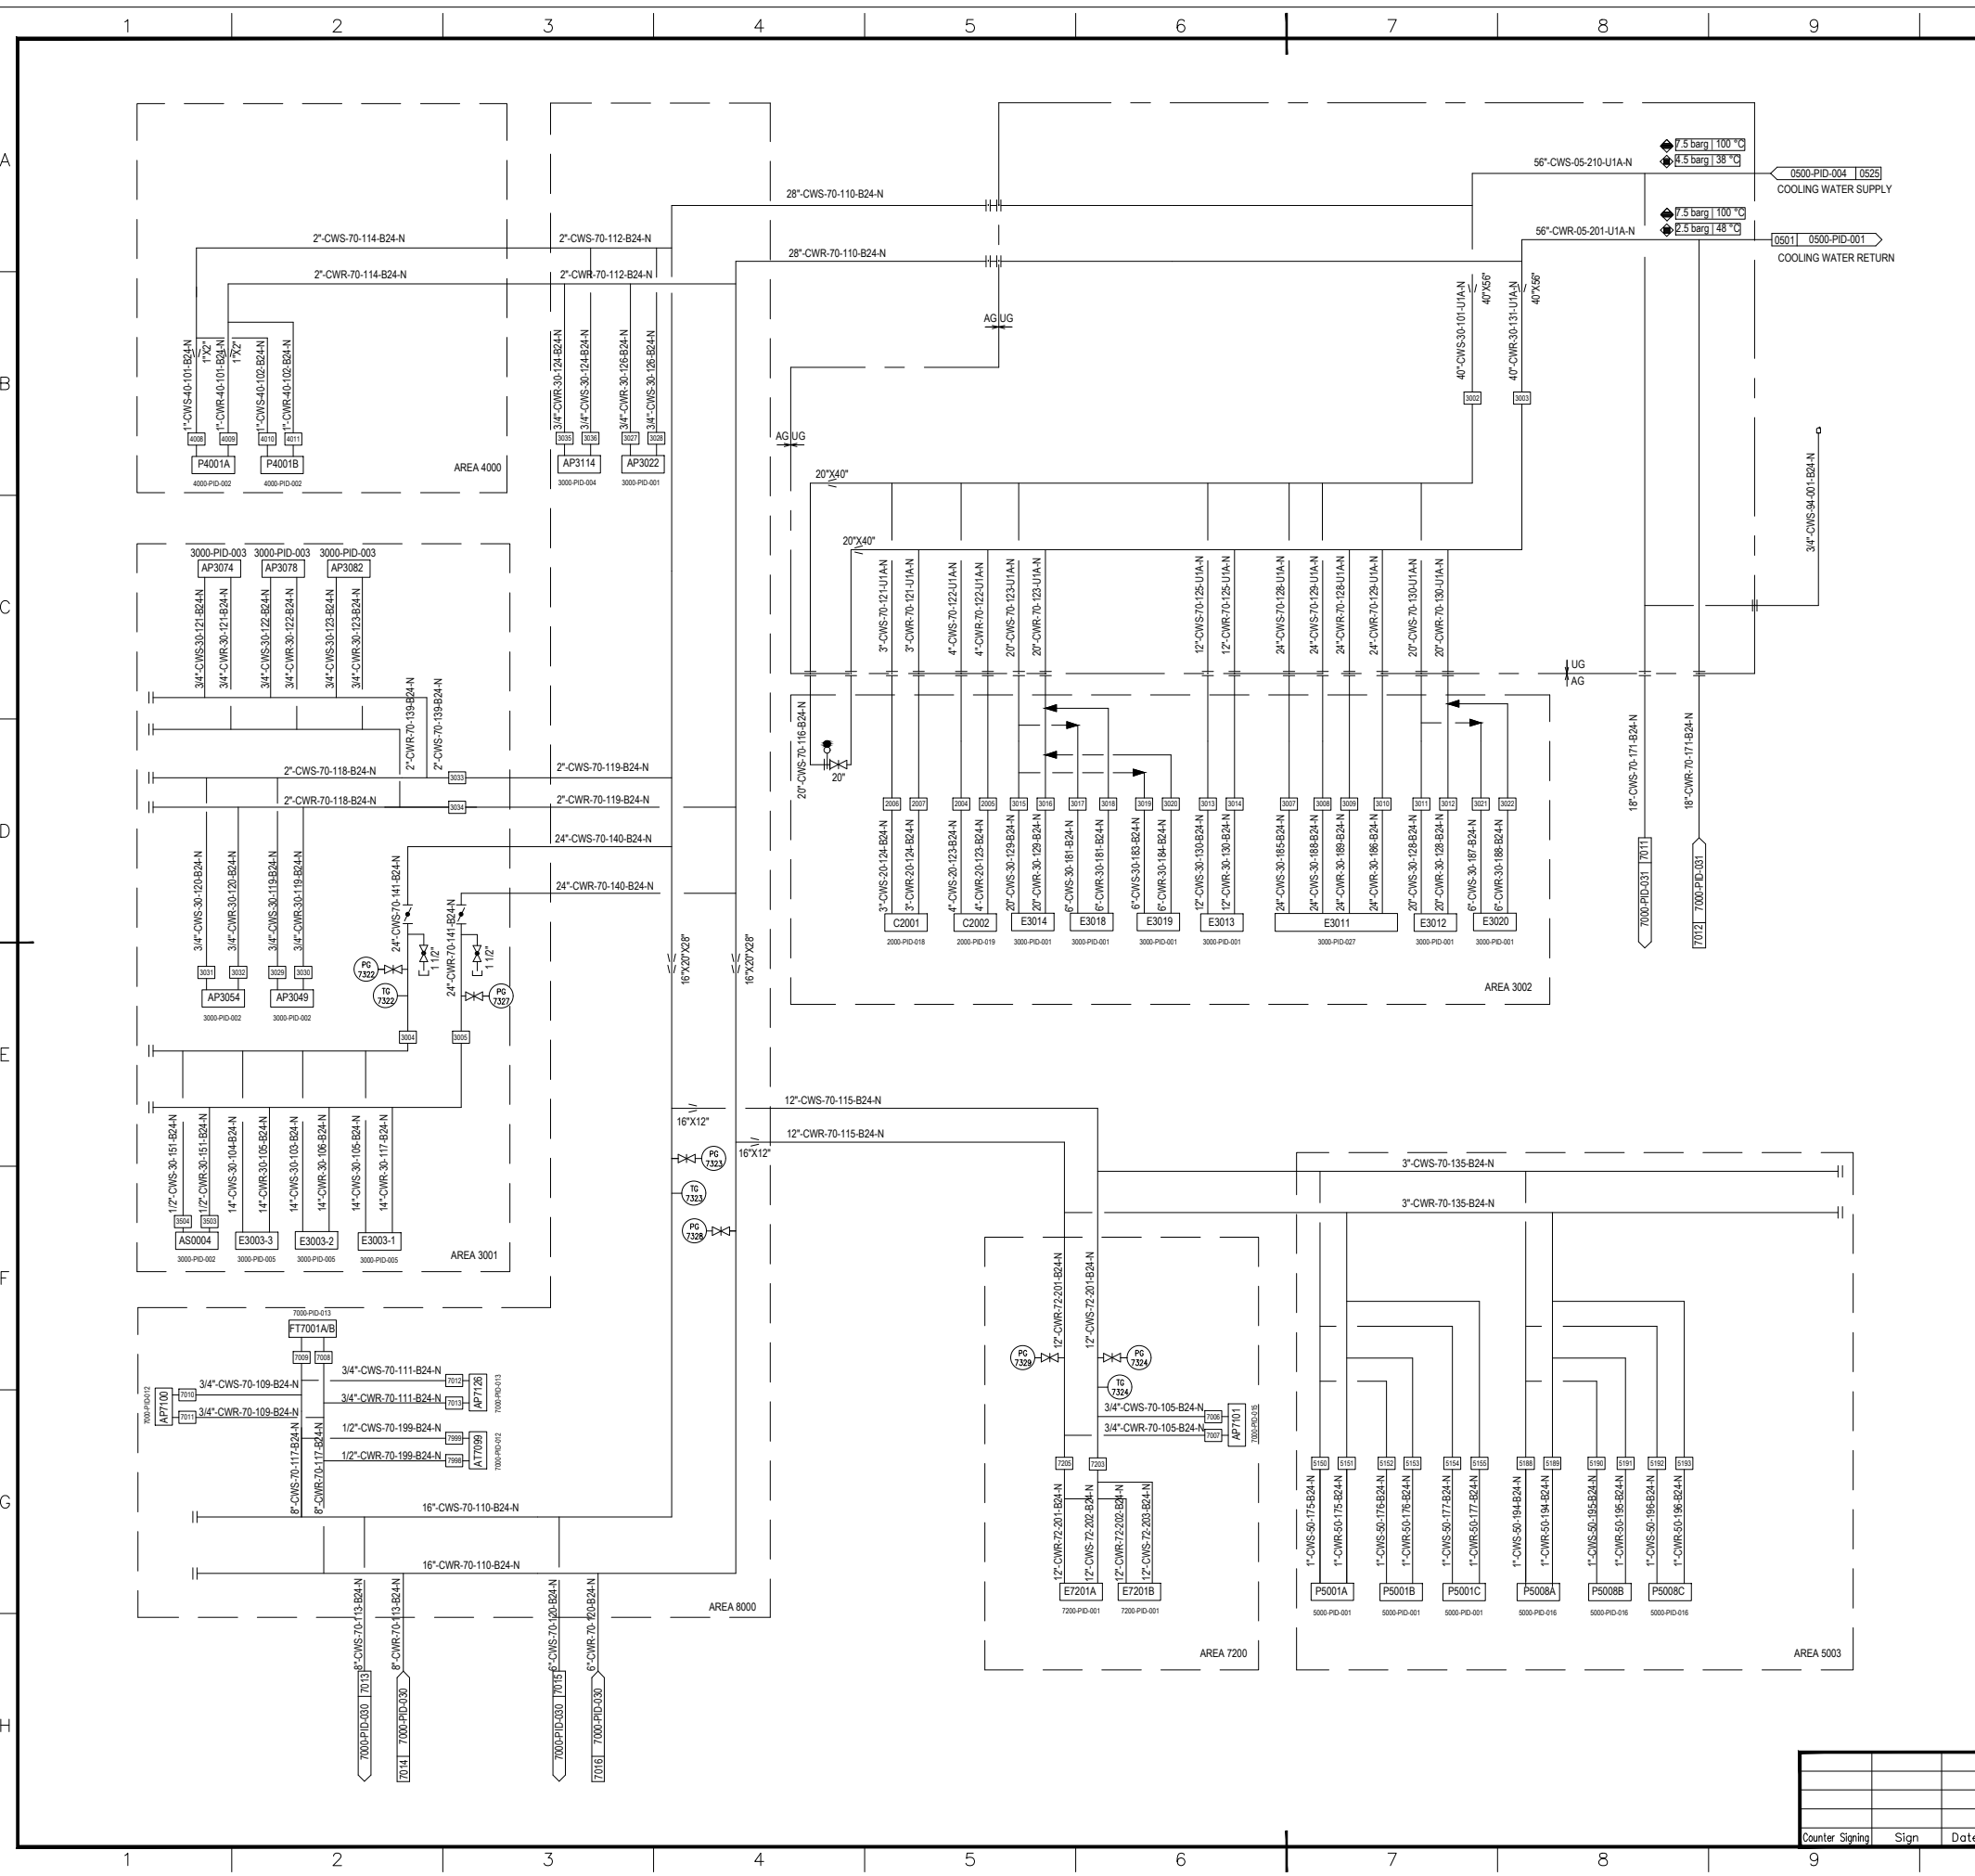

### GENERAL NOTES

GENERAL NOTE:  
LOW POINT DRAINS AND HIGH POINT VENT MUST BE ADDED DURING DETAILED ENGINEERING.

---

### REFERENCE DRAWINGS


---

### SYMBOLS AND LEGENDS

---

### KEY PLAN

REV.	PURPOSE OF ISSUE	DATE	DESIGN	DRAW	CHECK	REVIEW	APPROVE
▲	As Built	30.04.2020	Jiang Yu		Xu Hang	Liu Shengkol	
▲	Approved for Construction	30.12.2019	Jiang Yu		Xu Hang	Liu Shengkol	
▲	Approved for Construction	16.11.2018	Jiang Yu		Xu Hang	Liu Shengkol	
▲	Approved for Construction	02.02.2018	Chen Tao		Xu Hang	Liu Shengkol	
▲	Approved for Construction	06.11.2017	Chen Tao		Xu Hang	Liu Shengkol	
▲	Approved for Construction	04.05.2017	Chen Tao		Xu Hang	Shi Jing	
▲	Approved for Construction	12.04.2017	Chen Tao		Xu Hang	Shi Jing	
▲	Approved for Construction	20.01.2017	Chen Tao		Xu Hang	Shi Jing	
▲	Approved for Construction	16.10.2016	Chen Tao		Xu Hang	Shi Jing	
▲	Approved for Construction	31.08.2016	Chen Tao		Xu Hang	Shi Jing	
▲	Issued for Review	29.06.2016	Chen Tao		Xu Hang	Shi Jing	
▲	Issued for Comments	29.04.2016	Chen Tao		Xu Hang	Shi Jing	

THIS DOCUMENT IS THE PROPERTY OF TCC. NO PART OF THIS DOCUMENT SHALL BE REPRODUCED OR DISCLOSED TO OTHERS OR USED FOR ANY PURPOSE WHATSOEVER EXCEPT WITH THE PRIOR WRITTEN PERMISSION OF TCC.


OWNER: **Middle East Kimiaye Pars Company**

<b>TCC</b> 中国天辰工程有限公司 CHINA TIANCHEN ENGINEERING CORPORATION	CONTRACTOR	DOCUMENT NAME	JOB NO.	REV.
SUB-CONTRACTOR LOGO	CONTRACTOR DRAWING NO.			
SUB-CONTRACTOR LOGO	SUB-CONTRACTOR DRAWING NO.			
PROJECT		MKP Methanol Project		
UNIT		Steam System & Utilities		
PHASE		As Built Drawing		
OWNER DWG NO.		MKP-11-AS-7000-PR-PID-016		

SCALE: - SHEET: 01 TOT.: 01 SIZE: A1

Counter Signing	Sign	Date



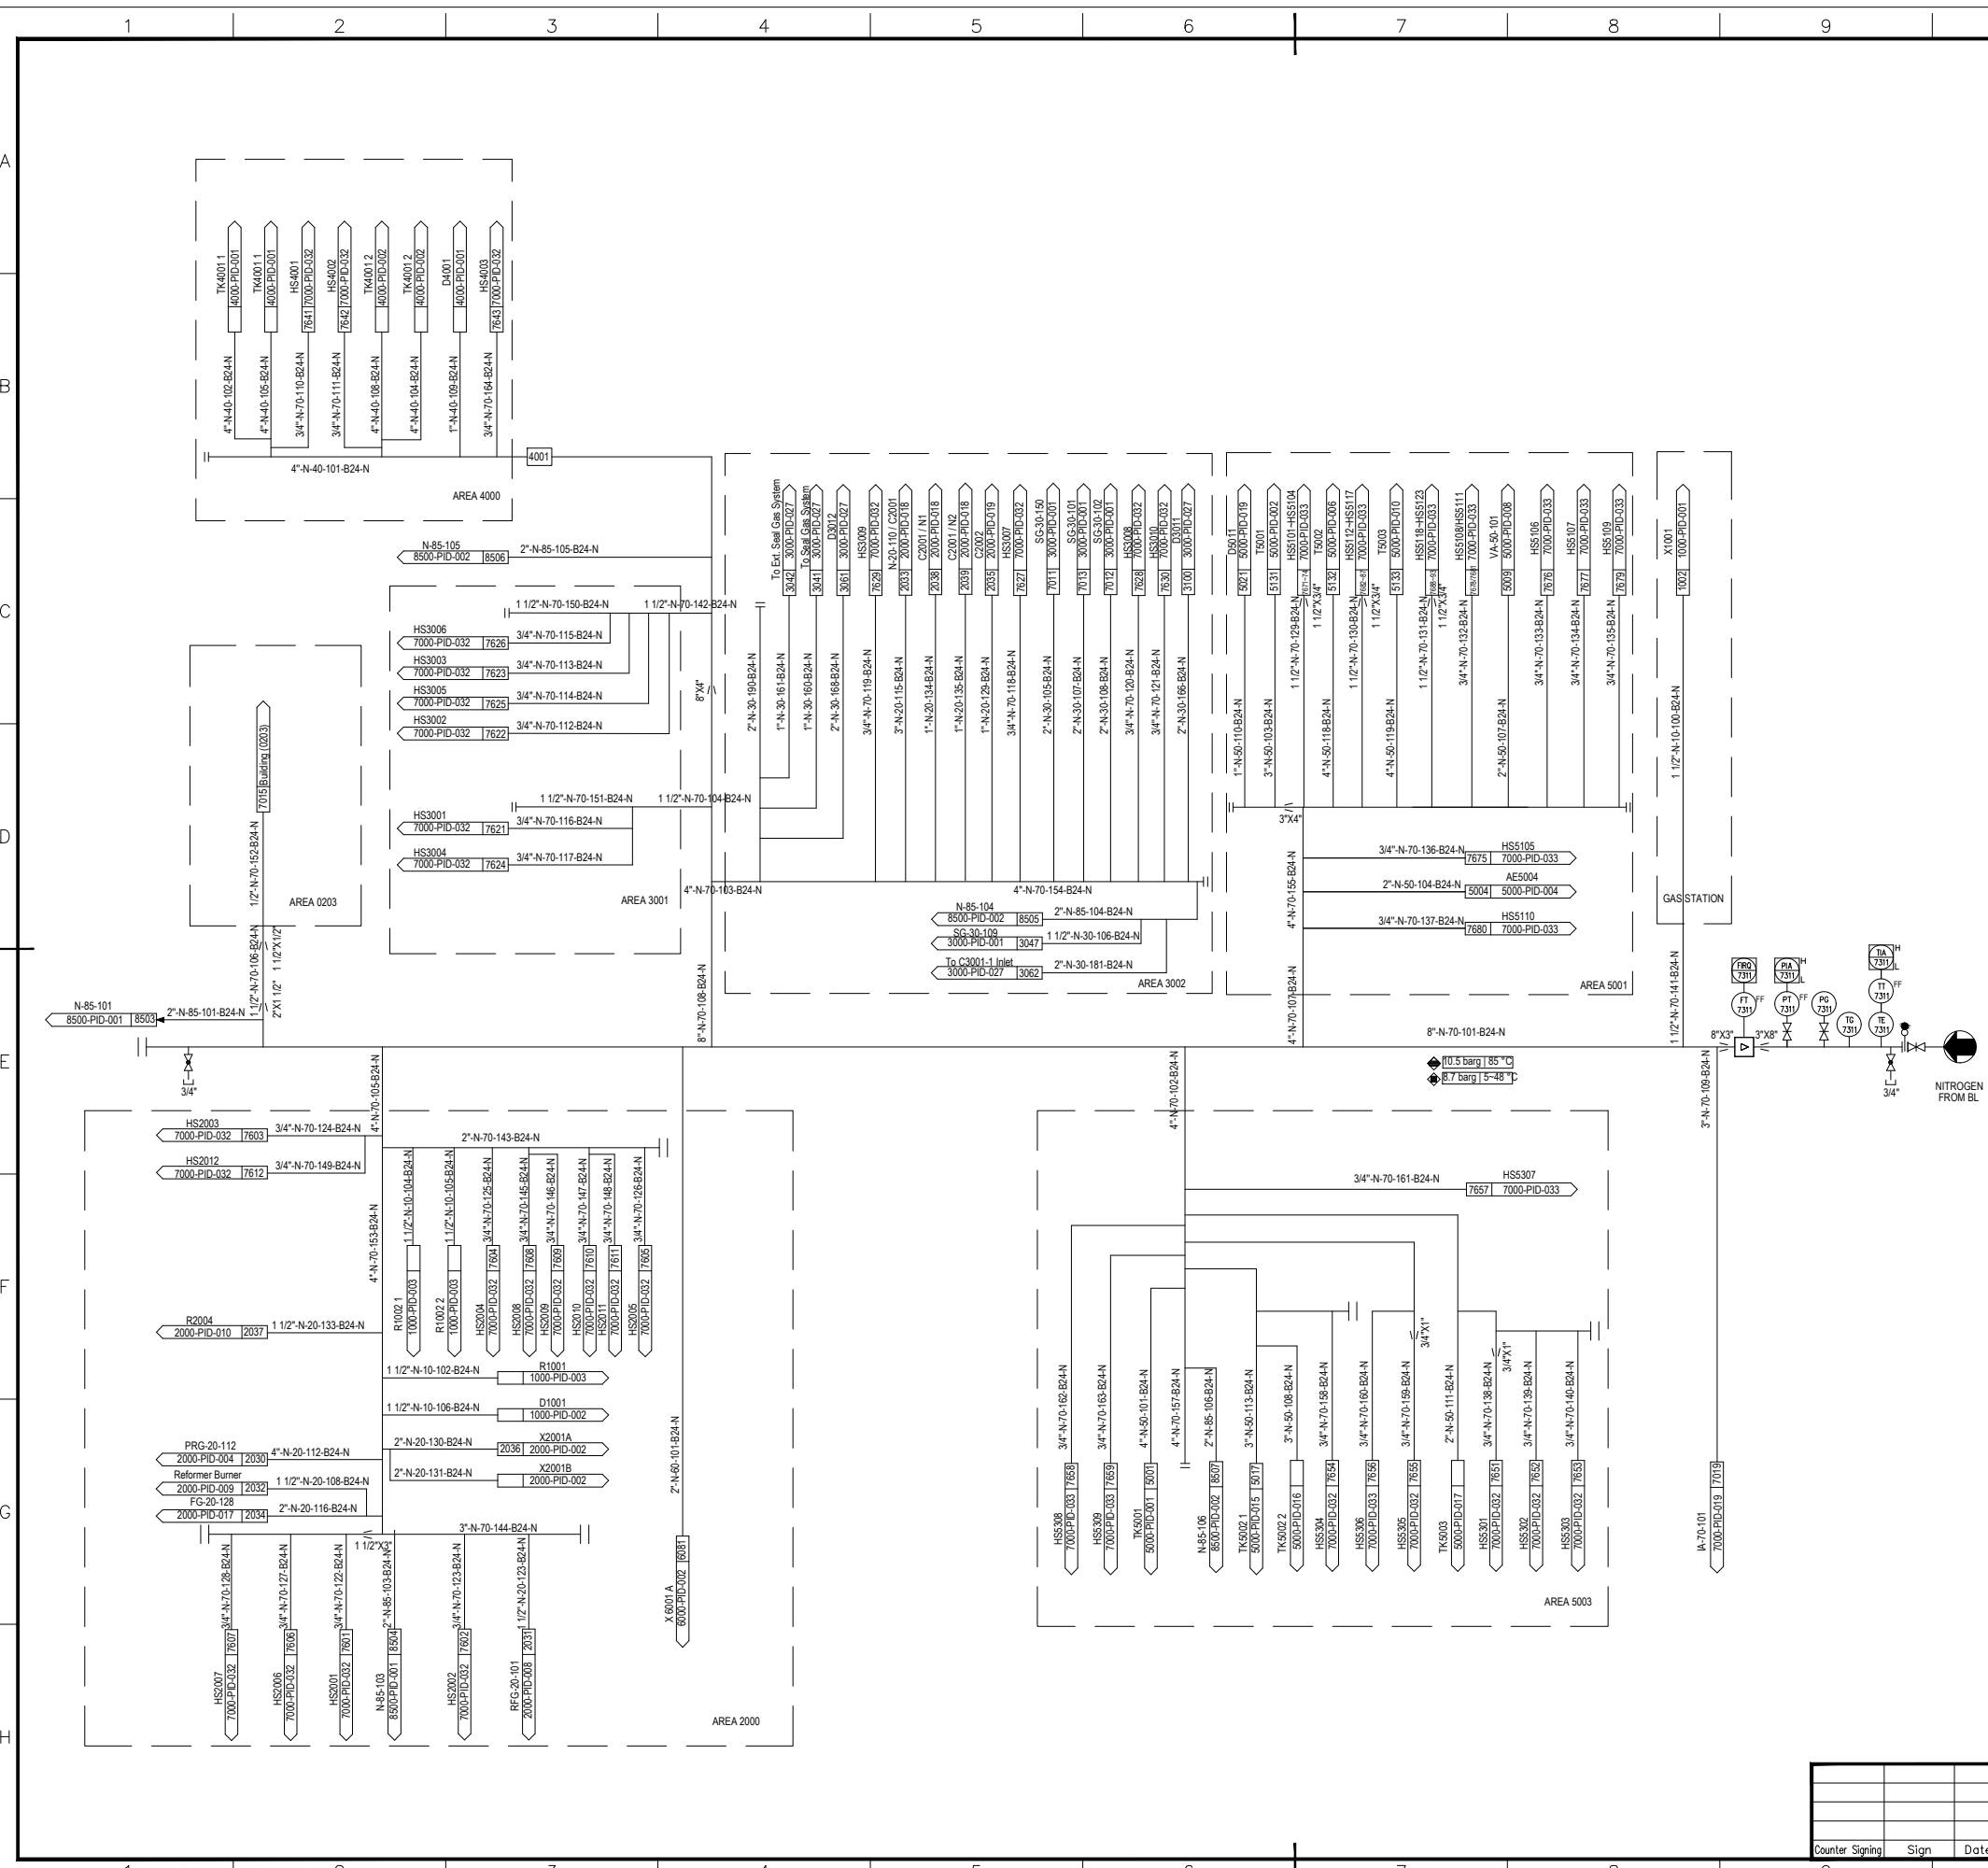

**GENERAL NOTES**

\*GENERAL NOTE:  
LOW POINT DRAINS AND HIGH POINT VENT MUST BE ADDED DURING DETAILED ENGINEERING.

**REFERENCE DRAWINGS**


**SYMBOLS AND LEGENDS**


**KEY PLAN**


REV.	PURPOSE OF ISSUE	DATE	DESIGN	DRAW	CHECK	REVIEW	APPROVE
▲	As Built	30.04.2020	Chen Tao	Xu Hang	Liu Shengkol		
▲	Approved for Construction	06.11.2017	Chen Tao	Xu Hang	Liu Shengkol		
▲	Approved for Construction	04.05.2017	Chen Tao	Xu Hang	Shi Jing		
▲	Approved for Construction	12.04.2017	Chen Tao	Xu Hang	Shi Jing		
▲	Approved for Construction	20.01.2017	Chen Tao	Xu Hang	Shi Jing		
▲	Approved for Construction	16.10.2016	Chen Tao	Xu Hang	Shi Jing		
▲	Approved for Construction	31.08.2016	Chen Tao	Xu Hang	Shi Jing		
▲	Issued for Approval	29.06.2016	Chen Tao	Xu Hang	Shi Jing		
▲	Issued for Comments	29.04.2016	Chen Tao	Xu Hang	Shi Jing		


OWNER: **Middle East Kimiaye Pars Company**




SCALE: - SHEET: 01 TOT.: 01 SIZE: A1


PROJECT: MKP Methanol Project  
UNIT: Steam System & Utilities  
PHASE: As Built Drawing  
OWNER DWG NO.: MKP-11-AS-7000-PR-PID-017

Counter	Sign	Date

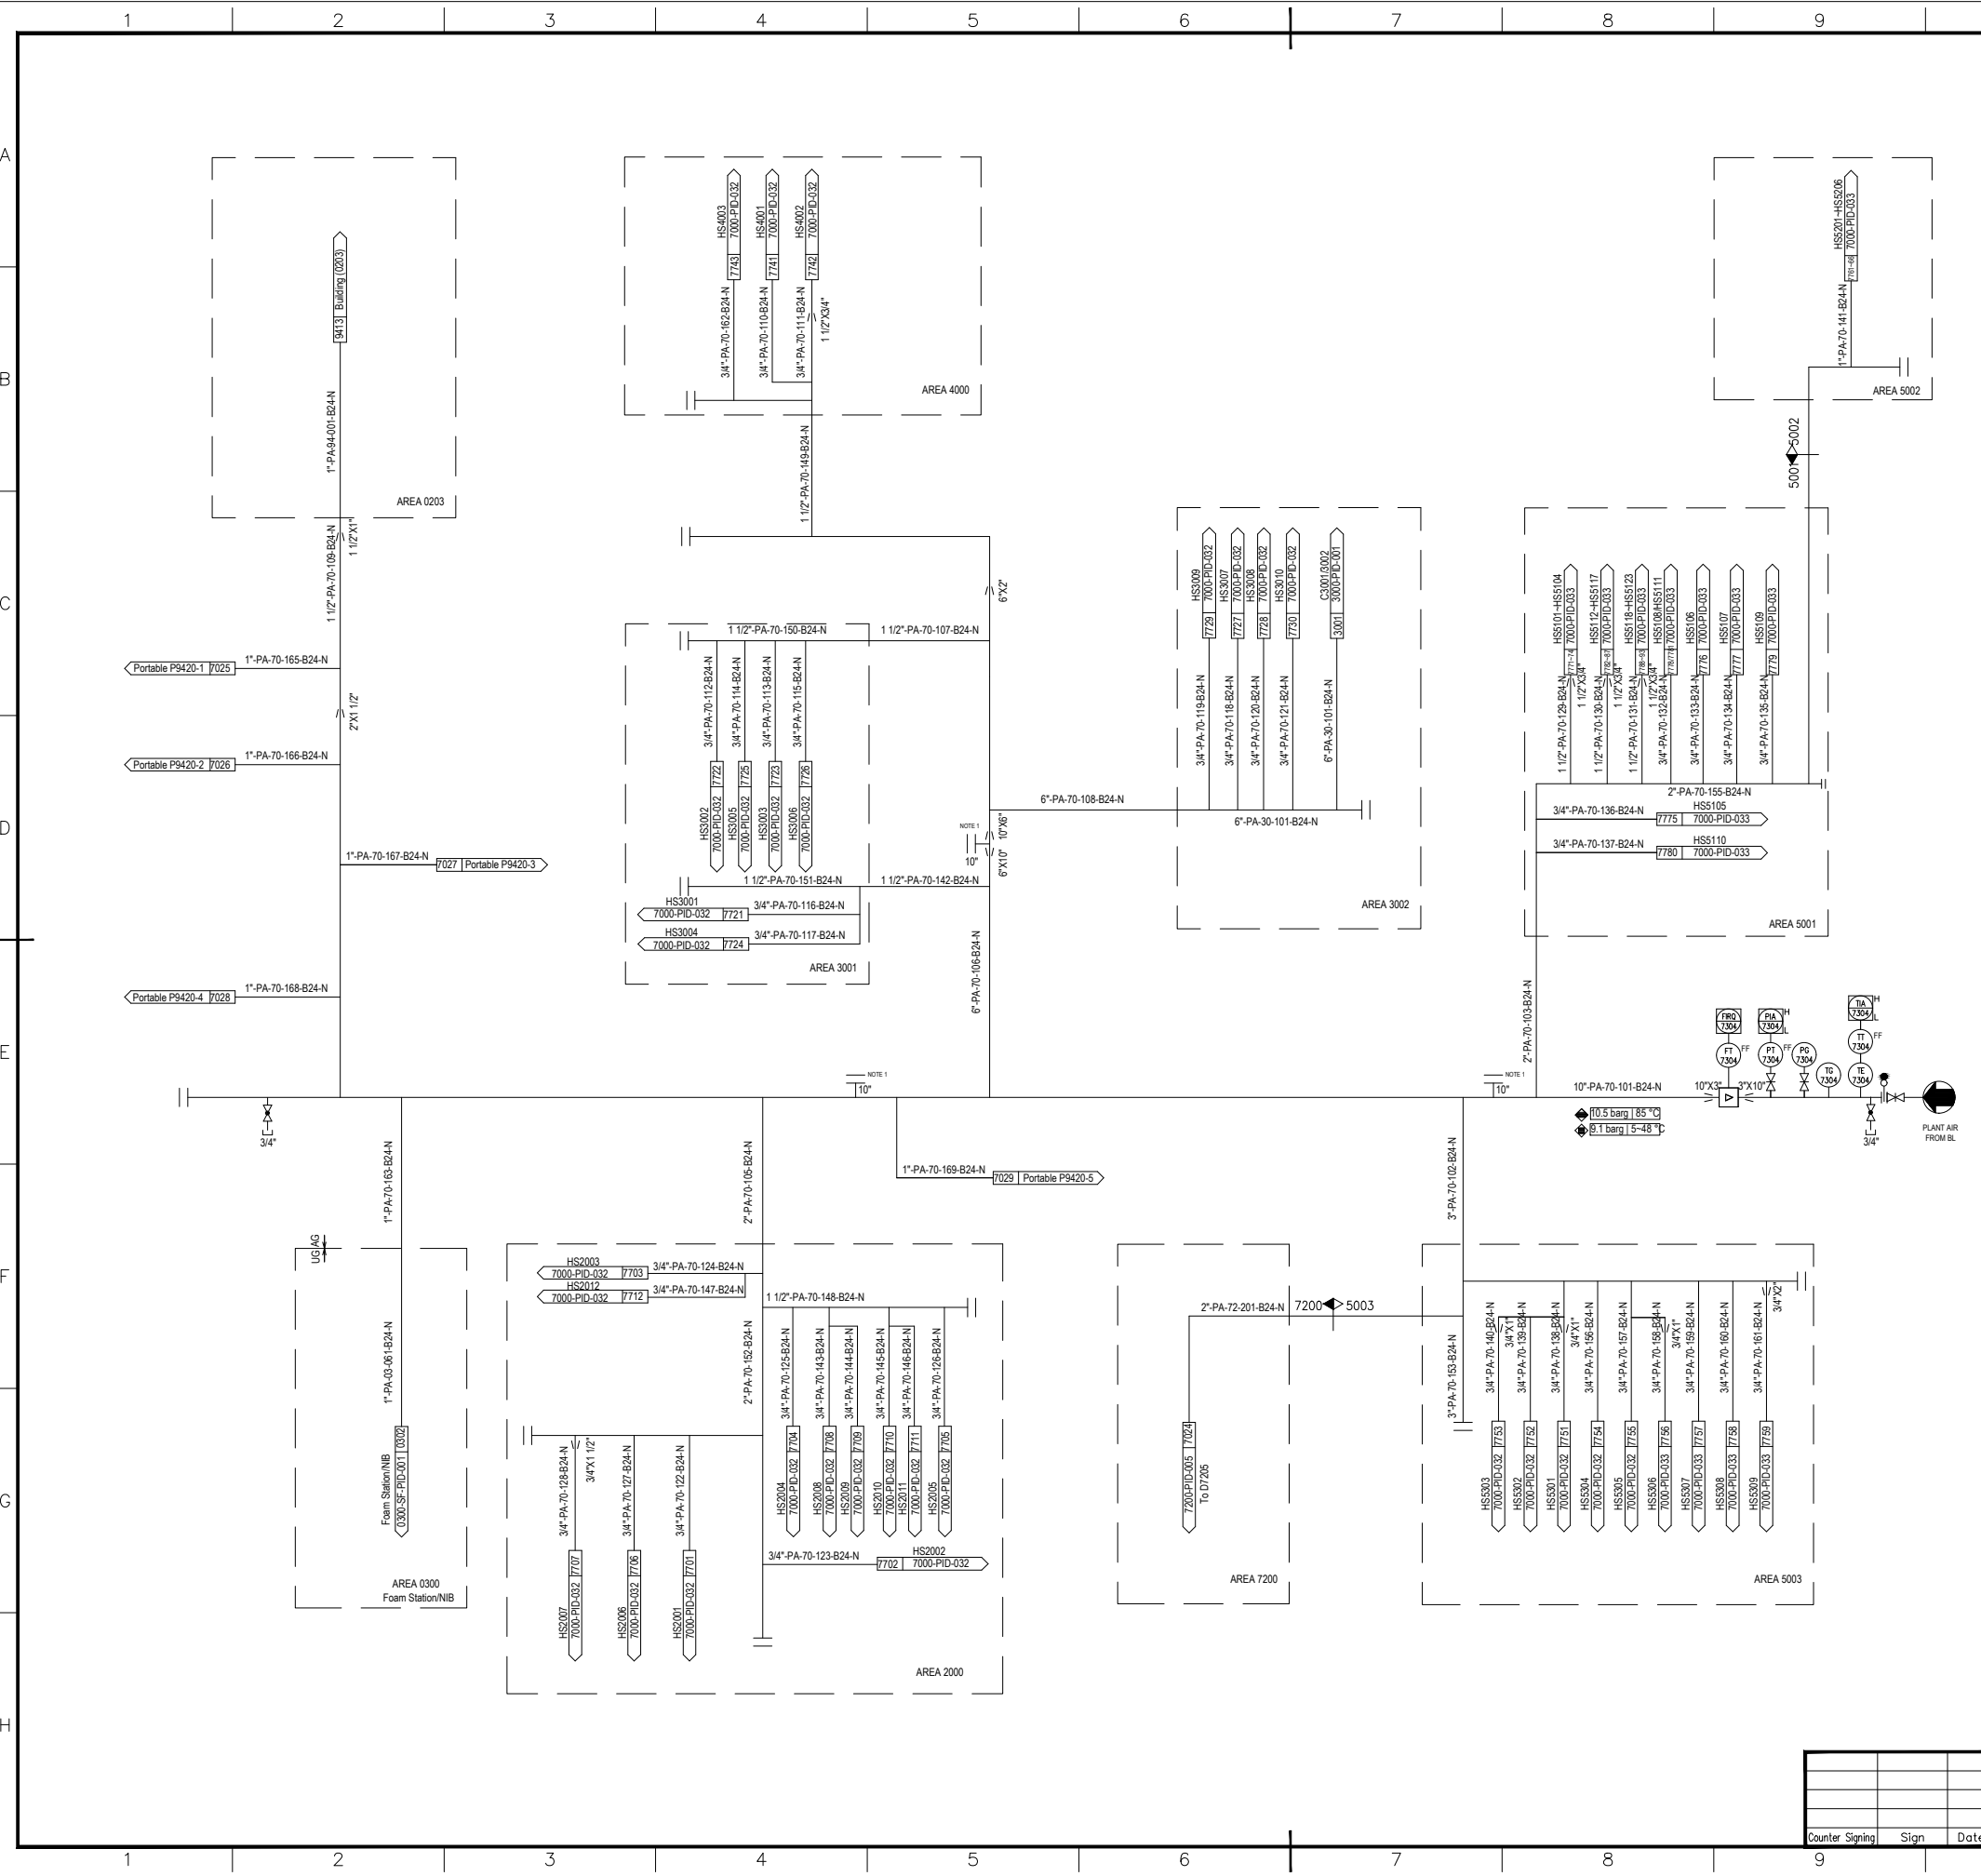

**GENERAL NOTES**

\*GENERAL NOTE:  
LOW POINT DRAINS AND HIGH POINT VENT MUST BE ADDED DURING DETAILED ENGINEERING.

\*NOTES:  
1) THIS TEE IS JUST USED FOR PURGING.

**REFERENCE DRAWINGS**


**SYMBOLS AND LEGENDS**

10.5 barg 85°C  
8.1 barg 5-48°C

PLANT AIR FROM BL

**KEY PLAN**

REV.	PURPOSE OF ISSUE	DATE	DESIGN	DRAW	CHECK	REVIEW	APPROVE
▲	As Built	30.04.2020	Jiang Yu			Xu Hang	Liu Shengkol
▲	Approved for Construction	11.11.2018	Jiang Yu			Xu Hang	Liu Shengkol
▲	Approved for Construction	06.11.2017	Chen Tao			Xu Hang	Liu Shengkol
▲	Approved for Construction	04.05.2017	Chen Tao			Xu Hang	Shi Jing
▲	Approved for Construction	12.04.2017	Chen Tao			Xu Hang	Shi Jing
▲	Approved for Construction	20.01.2017	Chen Tao			Xu Hang	Shi Jing
▲	Approved for Construction	16.10.2016	Chen Tao			Xu Hang	Shi Jing
▲	Approved for Construction	31.08.2016	Chen Tao			Xu Hang	Shi Jing
▲	Issued for Approval	29.06.2016	Chen Tao			Xu Hang	Shi Jing
▲	Issued for Comments	29.04.2016	Chen Tao			Xu Hang	Shi Jing


OWNER:  
**Middle East Kimiaye Pars Company**

<b>HALDOR TOPSØE A/S</b> COMPANY ENGINEER	DOCUMENT NAME	JOB NO.	REV.
	DATE	DATE	DATE
<b>TCC 中国天辰工程有限公司</b> CHINA TIANCHEN ENGINEERING CORPORATION	CONTRACTOR DRAWING NO.		
	MKP-11-AS-7000-PS09-PID-018		
SUB-CONTRACTOR LOGO	SUB-CONTRACTOR DRAWING NO.		
	SHEET 01 TOTAL 01		

PROJECT UNIT PHASE OWNER DWG NO.	PROJECT MKP Methanol Project
	UNIT Steam System & Utilities
PHASE As Built Drawing	OWNER MKP-11-AS-7000-PR-PID-018

Counter	Sign	Date

SCALE: - SHEET: 01 TOT.: 01 SIZE: A1

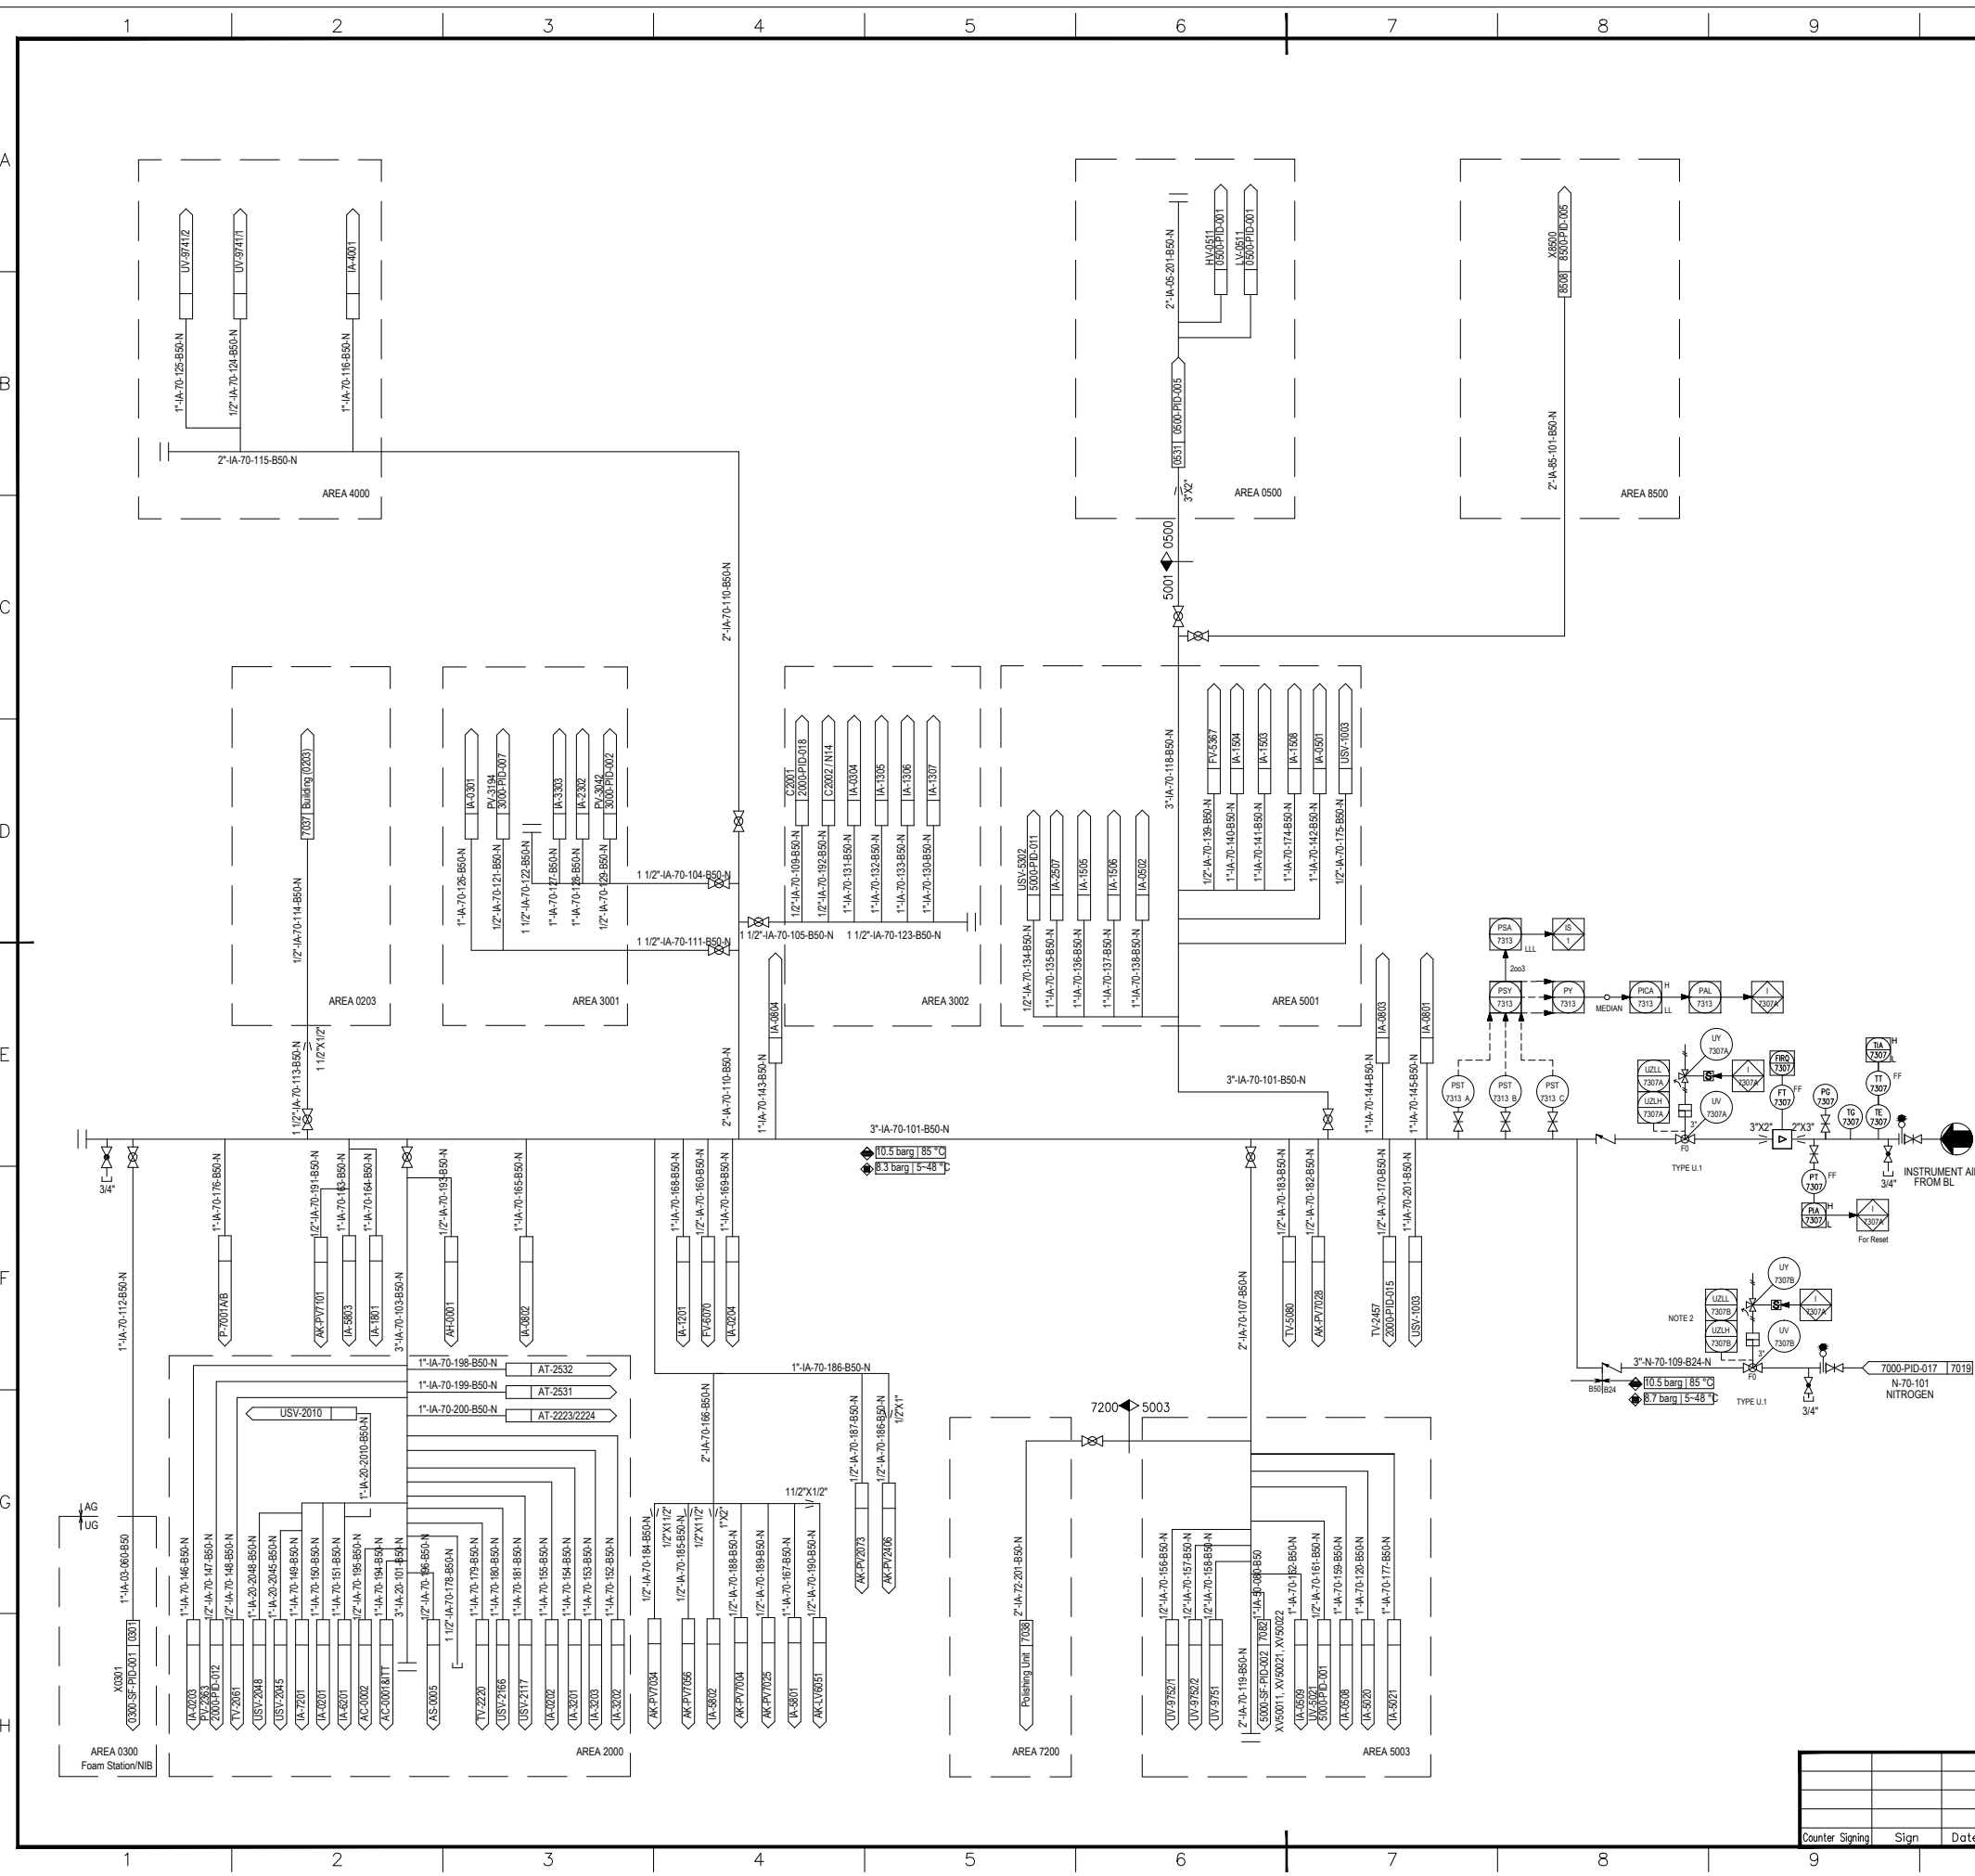

**GENERAL NOTES**

- \*GENERAL NOTE:  
LOW POINT DRAINS AND HIGH POINT VENT MUST BE ADDED DURING DETAILED ENGINEERING.
- \*NOTES:  
1. THE POSITION OF ACTUAL INSTRUMENT USER SHALL REFER TO THE INSTRUMENT AIR PIPING LAYOUT.  
2. WHEN N2 VALVE COME SHIFT TO OPEN AN ALARM SHALL INFORM OPERATOR THAT INSTRUMENT AIR HEADER IS CHARGED BY N2.

**REFERENCE DRAWINGS**

**SYMBOLS AND LEGENDS**

**KEY PLAN**


REV.	PURPOSE OF ISSUE	DATE	DESIGN	DRAW	CHECK	REVIEW	APPROVE
▲	As Built	30.04.2020	Jiang Yu		Xu Hang	Liu Shengkol	
▲	Approved for Construction	30.12.2019	Jiang Yu		Xu Hang	Liu Shengkol	
▲	Approved for Construction	11.11.2018	Jiang Yu		Xu Hang	Liu Shengkol	
▲	Approved for Construction	02.02.2018	Chen Tao		Xu Hang	Liu Shengkol	
▲	Approved for Construction	06.11.2017	Chen Tao		Xu Hang	Liu Shengkol	
▲	Approved for Construction	04.05.2017	Chen Tao		Xu Hang	Shi Jing	
▲	Approved for Construction	12.04.2017	Chen Tao		Xu Hang	Shi Jing	
▲	Approved for Construction	20.01.2017	Chen Tao		Xu Hang	Shi Jing	
▲	Approved for Construction	16.10.2016	Chen Tao		Xu Hang	Shi Jing	
▲	Approved for Construction	31.08.2016	Chen Tao		Xu Hang	Shi Jing	
▲	Issued for Approval	29.06.2016	Chen Tao		Xu Hang	Shi Jing	
▲	Issued for Comments	29.04.2016	Chen Tao		Xu Hang	Shi Jing	

OWNER: **Middle East Kimiaye Pars Company**

	<b>HALDOR TOPSØE A/S</b> DOCUMENT NAME: _____ JOB NO.: _____ DATE: _____	CONTRACTOR DRAWING NO. <b>MKP-11-AS-7000-PS09-PID-019</b> SHEET 01 TOTAL 01
	<b>TCC 中国天辰工程有限公司</b> CHINA TIANCHEN ENGINEERING CORPORATION	SUB-CONTRACTOR DRAWING NO. SHEET -- TOTAL --

INSTRUMENT AIR HEADER UTILITY DIAGRAM PROJECT: MKP Methanol Project UNIT: Steam System & Utilities PHASE: As Built Drawing OWNER DWG NO.: MKP-11-AS-7000-PR-PID-019	SCALE: - SHEET: 01 TOT.: 01 SIZE: A1
---	---

Counter	Sign	Date

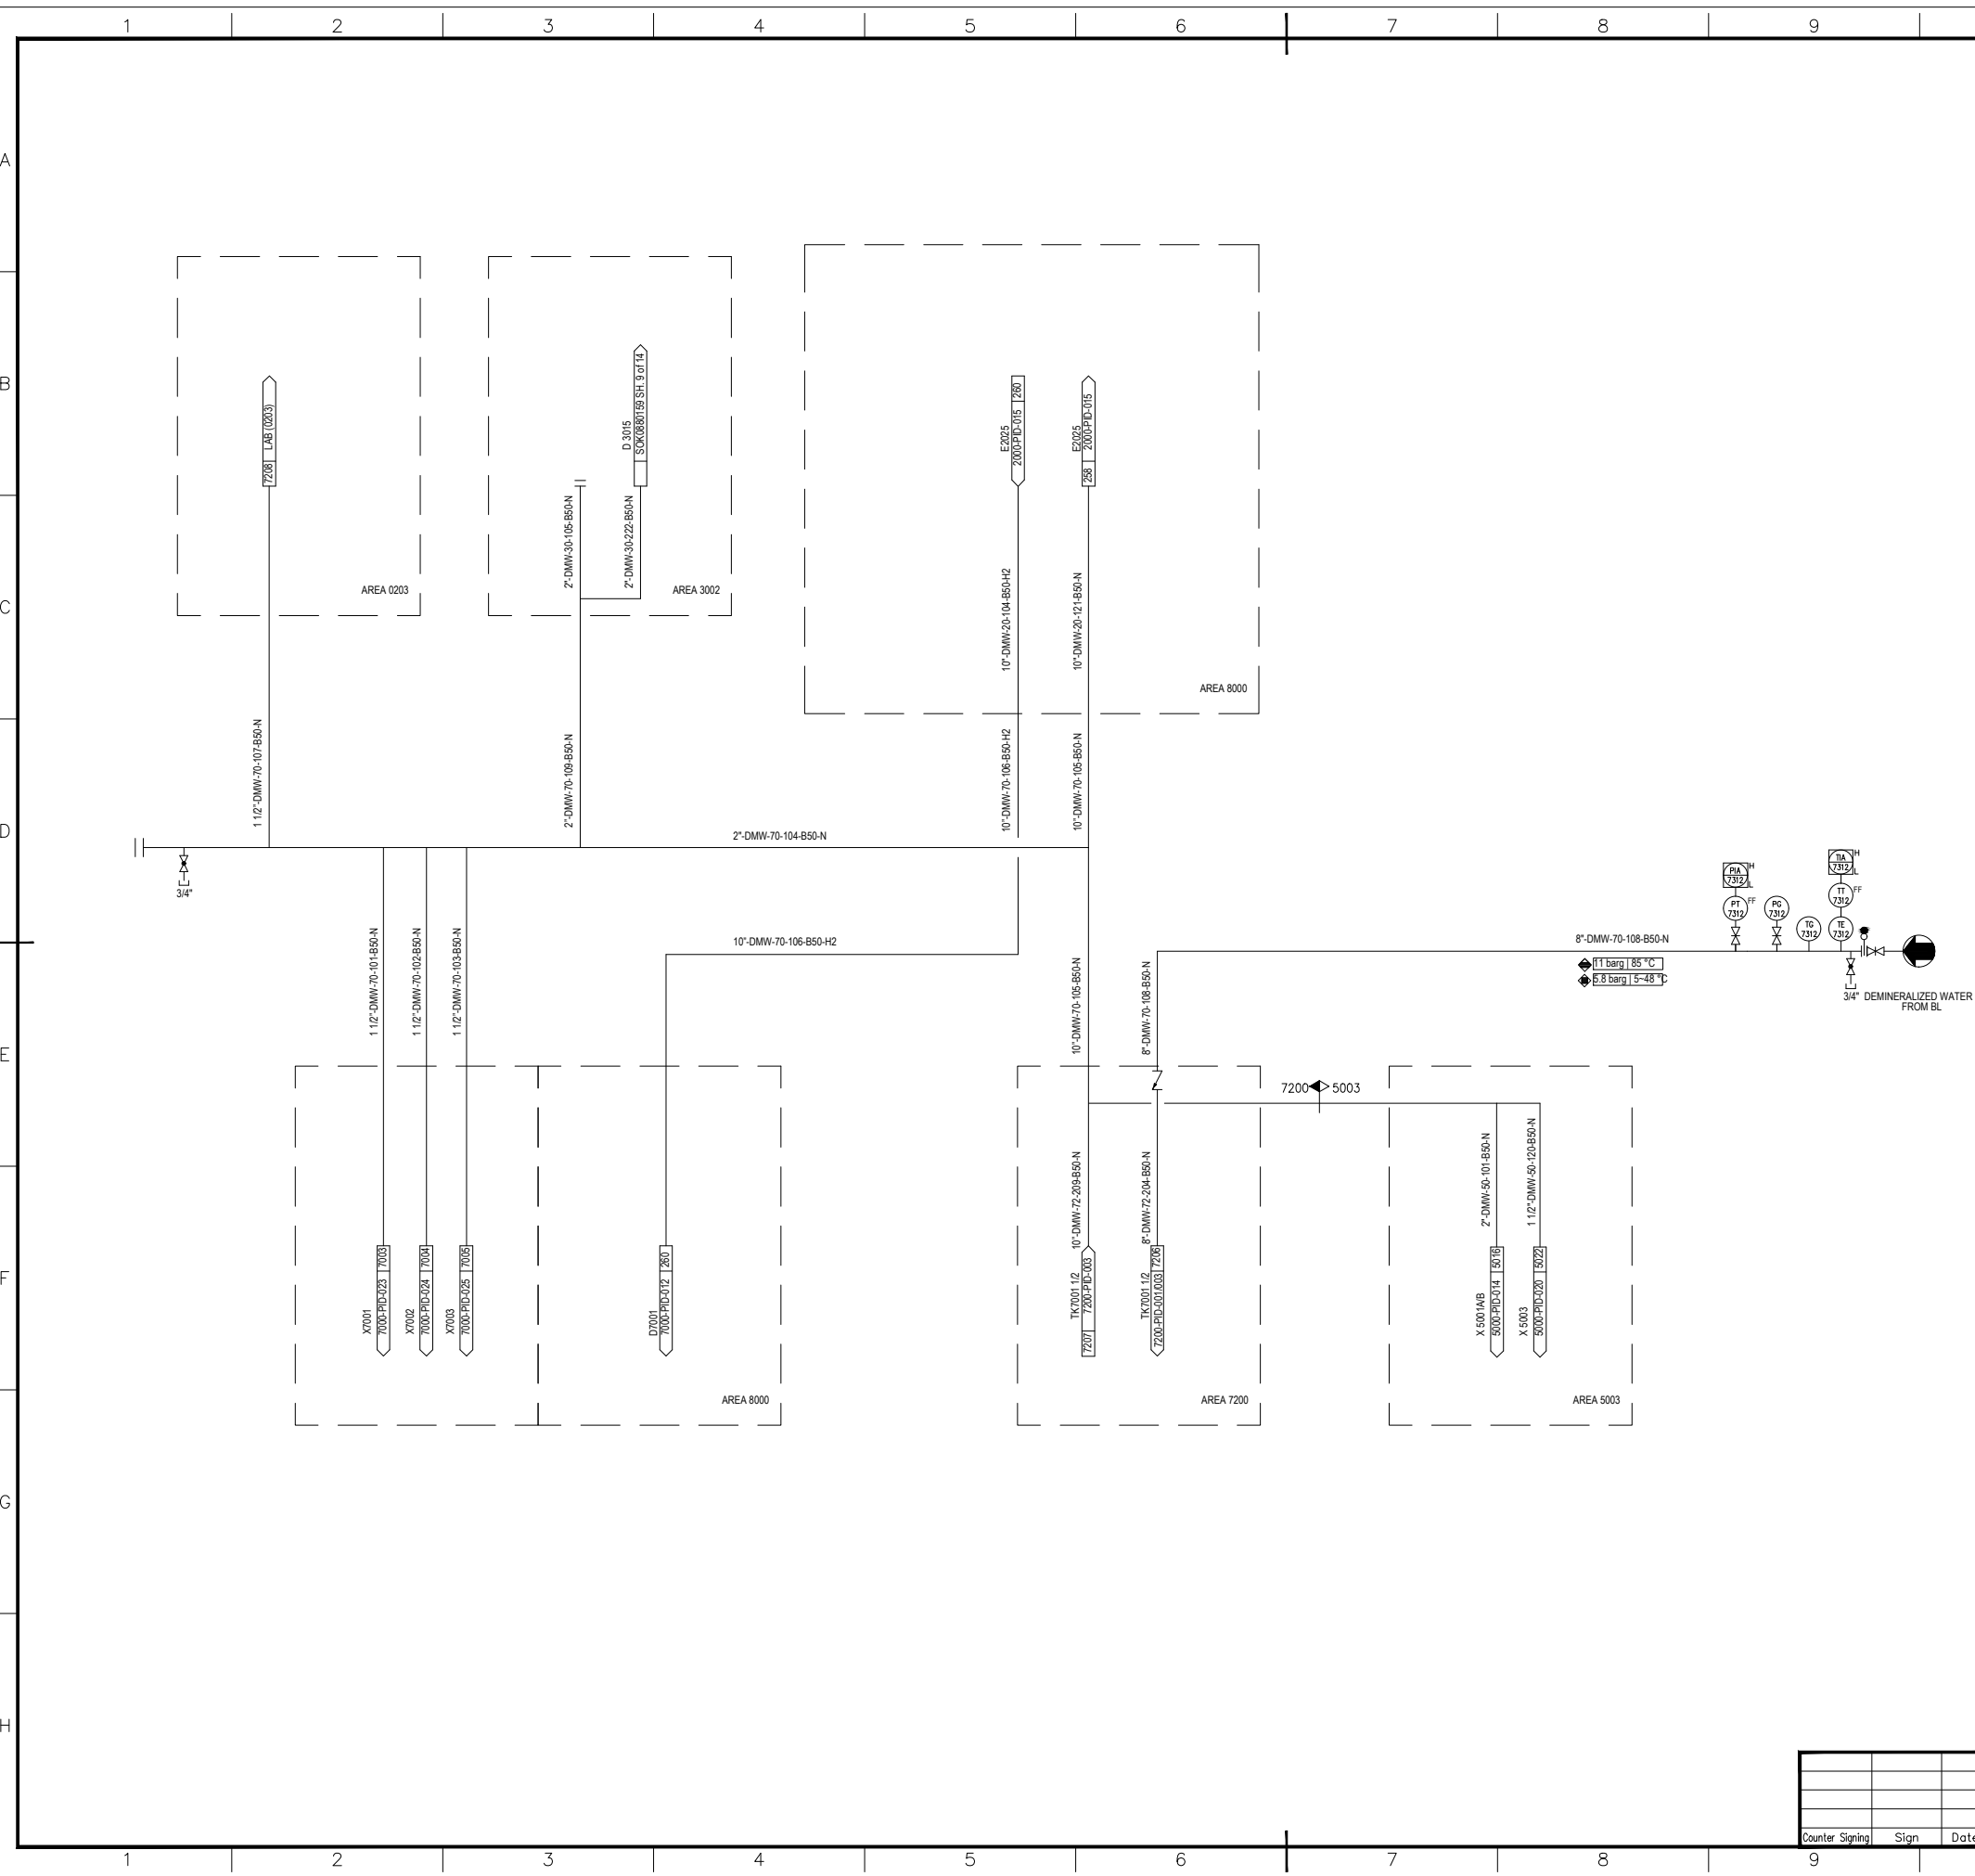

**GENERAL NOTES**

\*GENERAL NOTE:  
LOW POINT DRAINS AND HIGH POINT VENT MUST BE ADDED DURING DETAILED ENGINEERING.

**REFERENCE DRAWINGS**

**SYMBOLS AND LEGENDS**

**KEY PLAN**

REV.	PURPOSE OF ISSUE	DATE	DESIGN	DRAW	CHECK	REVIEW	APPROVE
▲	As Built	30.04.2020	Jiang Yu		Xu Hang	Liu Shengkol	
▲	Approved for Construction	30.12.2019	Jiang Yu		Xu Hang	Liu Shengkol	
▲	Approved for Construction	11.11.2018	Jiang Yu		Xu Hang	Liu Shengkol	
▲	Approved for Construction	04.05.2017	Chen Tao		Xu Hang	Shi Jing	
▲	Approved for Construction	12.04.2017	Chen Tao		Xu Hang	Shi Jing	
▲	Approved for Construction	20.01.2017	Chen Tao		Xu Hang	Shi Jing	
▲	Approved for Construction	16.10.2016	Chen Tao		Xu Hang	Shi Jing	
▲	Approved for Construction	31.08.2016	Chen Tao		Xu Hang	Shi Jing	
▲	Issued for Approval	29.06.2016	Chen Tao		Xu Hang	Shi Jing	
▲	Issued for Comments	29.04.2016	Chen Tao		Xu Hang	Shi Jing	

THIS DOCUMENT IS THE PROPERTY OF TCC. NO PART OF THIS DOCUMENT SHALL BE REPRODUCED OR DISCLOSED TO OTHERS OR USED FOR ANY PURPOSE WHATSOEVER EXCEPT WITH THE PRIOR WRITTEN PERMISSION OF TCC.

OWNER:

Middle East  
Kimiaye Pars Company

OWNER	HALDOR TOPSØE A/S	DOCUMENT NAME	JOB NO.	CONTRACT NO.	REV.
-------	-------------------	---------------	---------	--------------	------


CONTRACTOR	TCC 中国天辰工程有限公司 CHINA TIANCHEN ENGINEERING CORPORATION	CONTRACTOR DRAWING NO.	MKP-11-AS-7000-PS09-PID-020
		SHEET	01 TOTAL 01

CONTRACTOR	SUB-CONTRACTOR LOGO	SUB-CONTRACTOR DRAWING NO.	
		SHEET	-- TOTAL --

PROJECT	MKP Methanol Project
UNIT	Steam System & Utilities
PHASE	As Built Drawing
OWNER DWG NO.	MKP-11-AS-7000-PR-PID-020

Counter	Sign	Date



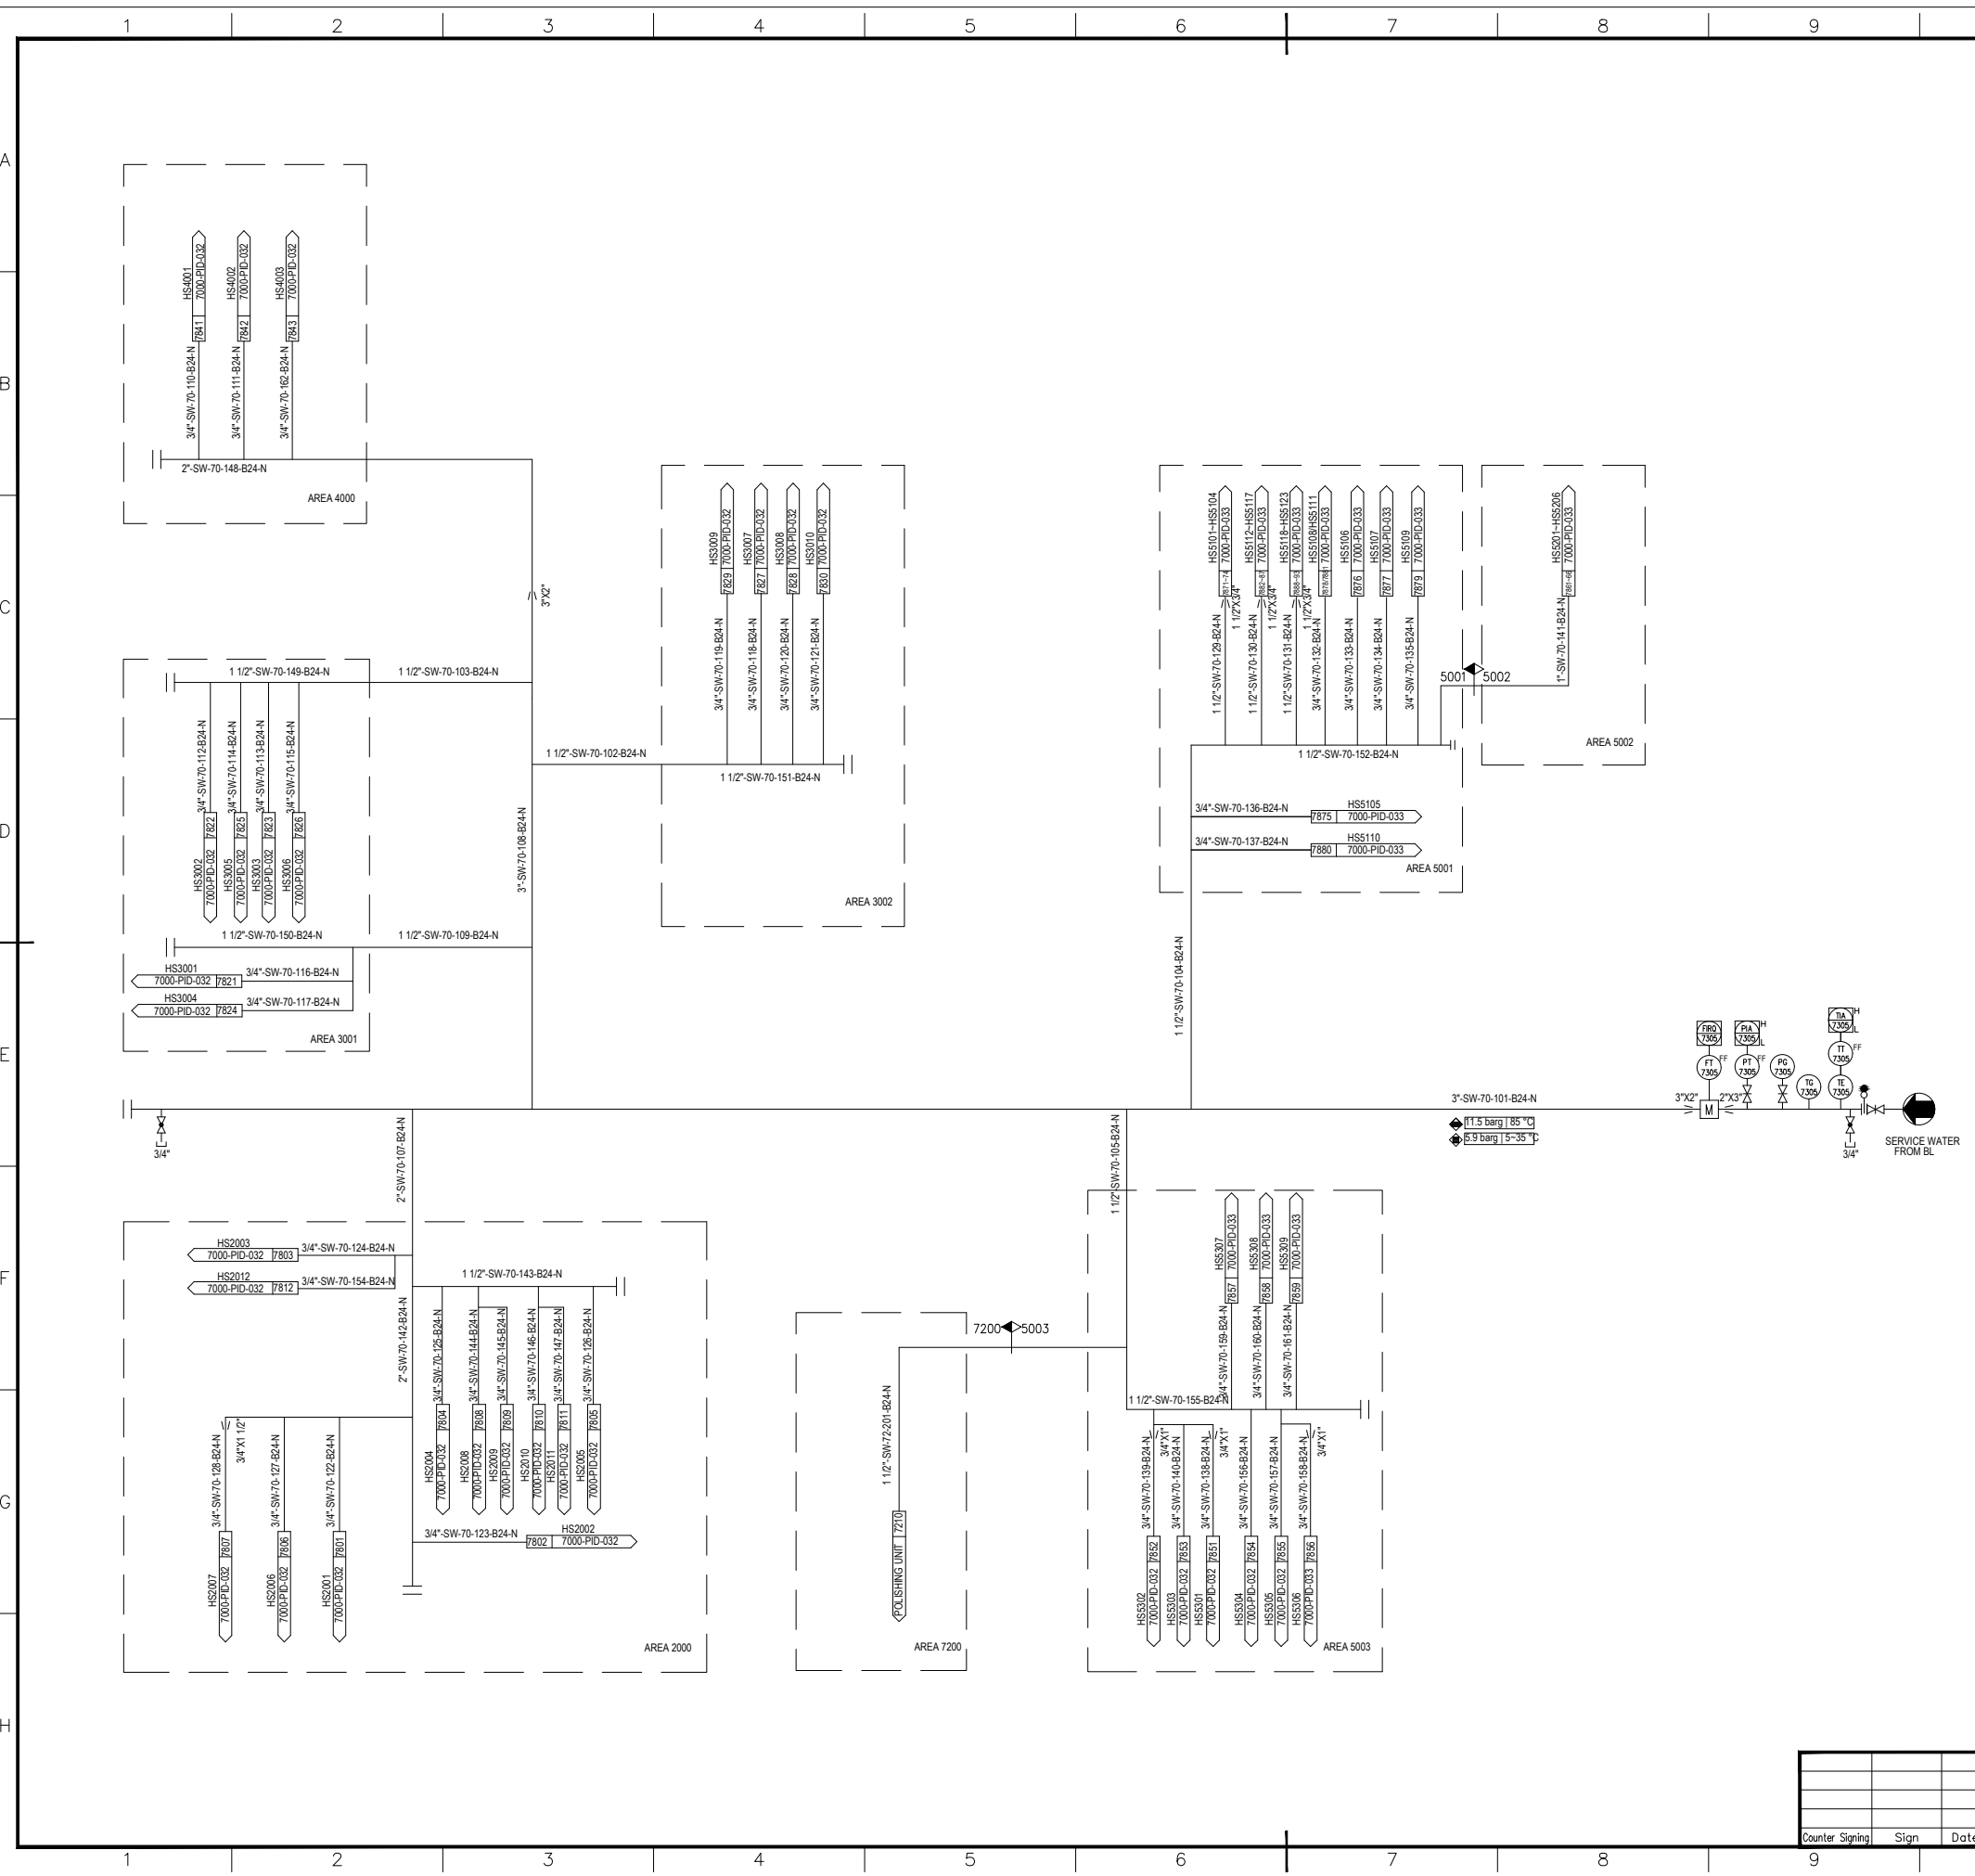

**GENERAL NOTES**

\*GENERAL NOTE:  
LOW POINT DRAINS AND HIGH POINT VENT MUST BE ADDED DURING DETAILED ENGINEERING.

**REFERENCE DRAWINGS**


**SYMBOLS AND LEGENDS**

**KEY PLAN**



REV.	PURPOSE OF ISSUE	DATE	DESIGN	DRAW	CHECK	REVIEW	APPROVE
▲	As Built	30.04.2020	Jiang Yu		Xu Hang	Liu Shengkol	
▲	Approved for Construction	11.11.2018	Jiang Yu		Xu Hang	Liu Shengkol	
▲	Approved for Construction	06.11.2017	Chen Tao		Xu Hang	Liu Shengkol	
▲	Approved for Construction	04.05.2017	Chen Tao		Xu Hang	Shi Jing	
▲	Approved for Construction	12.04.2017	Chen Tao		Xu Hang	Shi Jing	
▲	Approved for Construction	20.01.2017	Chen Tao		Xu Hang	Shi Jing	
▲	Approved for Construction	16.10.2016	Chen Tao		Xu Hang	Shi Jing	
▲	Approved for Construction	31.08.2016	Chen Tao		Xu Hang	Shi Jing	
▲	Issued for Approval	29.06.2016	Chen Tao		Xu Hang	Shi Jing	
▲	Issued for Comments	29.04.2016	Chen Tao		Xu Hang	Shi Jing	

THIS DOCUMENT IS THE PROPERTY OF TCC. NO PART OF THIS DOCUMENT SHALL BE REPRODUCED OR DISCLOSED TO OTHERS OR USED FOR ANY PURPOSE WHATSOEVER EXCEPT WITH THE PRIOR WRITTEN PERMISSION OF TCC.

OWNER:




Middle East  
Kimiaye Pars Company

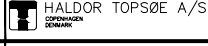 HALDOR TOPSØE A/S CONTRACTOR ENGINEER	DOCUMENT NAME	JOB NO.	SCALE	REV.
	 TCC 中国天辰工程有限公司 CHINA TIANCHEN ENGINEERING CORPORATION	CONTRACTOR DRAWING NO.		
SUB-CONTRACTOR LOGO		SHEET		TOTAL
		SHEET		TOTAL

SERVICE WATER HEADER UTILITY DIAGRAM	PROJECT	MKP Methanol Project
	UNIT	Steam System & Utilities
PHASE	As Built Drawing	
OWNER DWG NO.	MKP-11-AS-7000-PR-PID-021	

Counter	Sign	Date

SCALE: - SHEET: 01 TOT.: 01 SIZE: A1

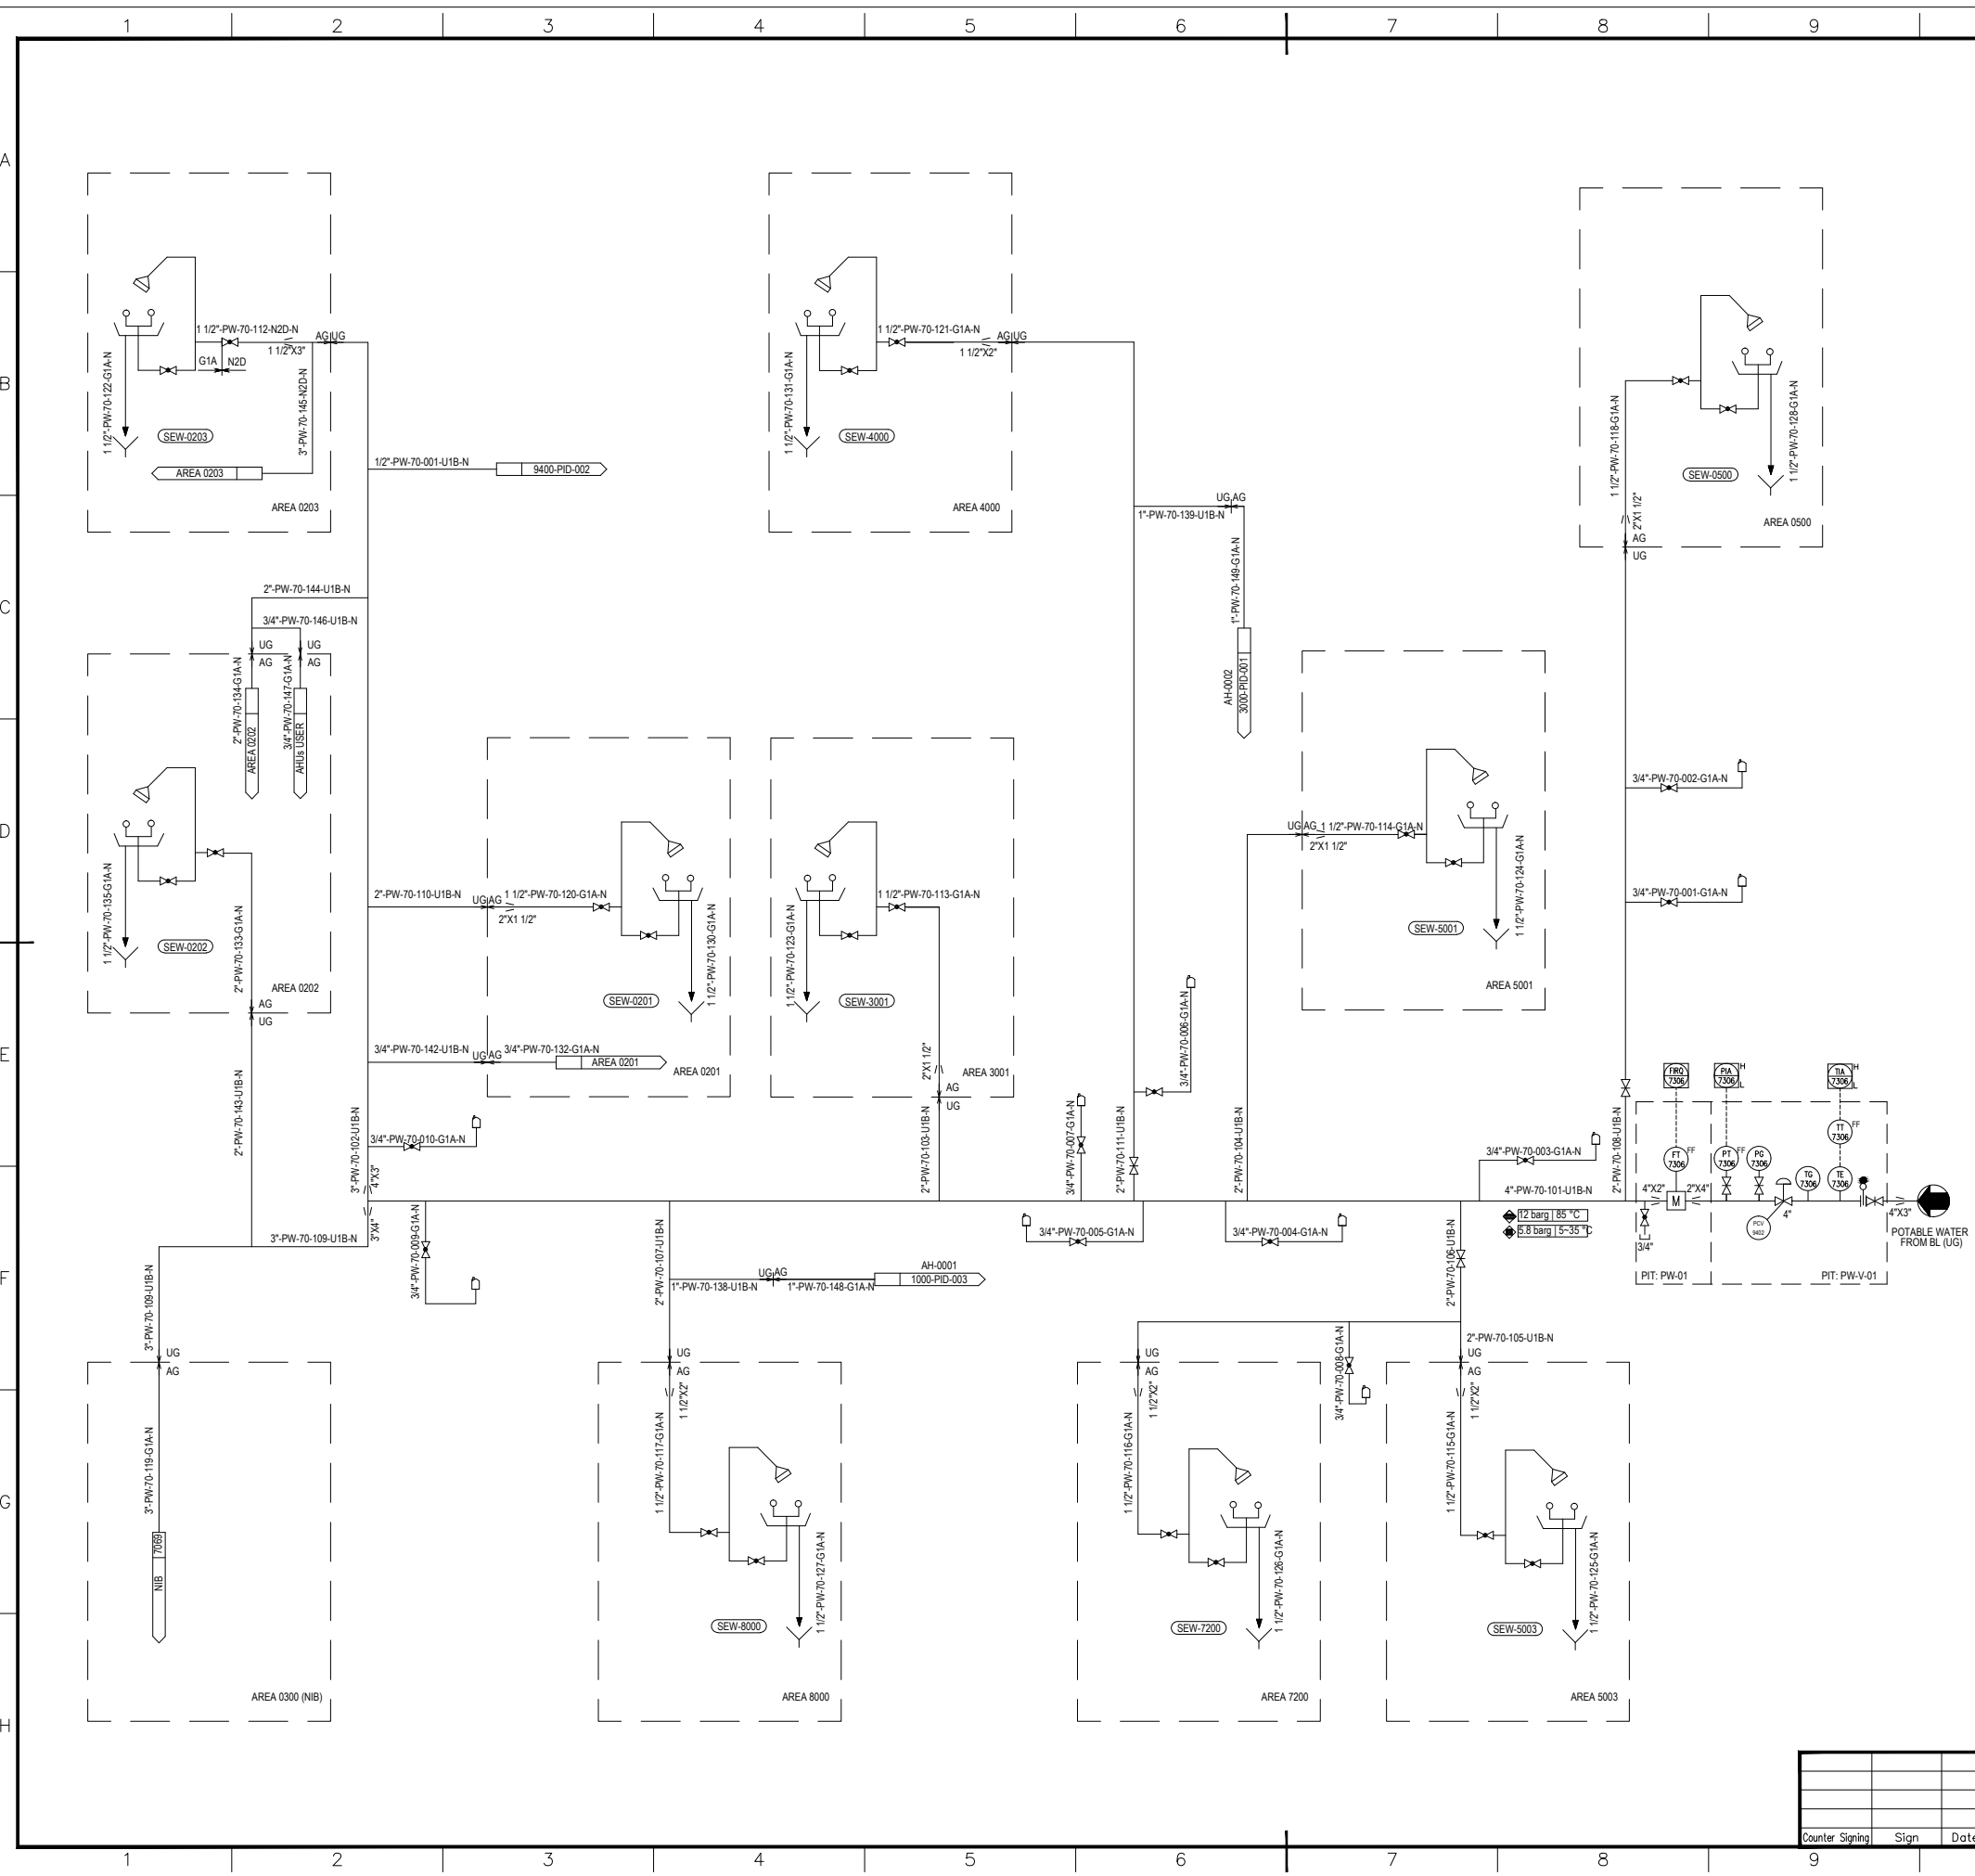

**GENERAL NOTES**

\*GENERAL NOTE:  
LOW POINT DRAINS AND HIGH POINT VENT MUST BE ADDED DURING DETAILED ENGINEERING.

**REFERENCE DRAWINGS**


**SYMBOLS AND LEGENDS**

**KEY PLAN**

REV.	PURPOSE OF ISSUE	DATE	DESIGN	DRAW	CHECK	REVIEW	APPROVE
▲	As Built	30.04.2020	Jiang Yu		Xu Hong	Liu Shengkol	
▲	Approved for Construction	30.12.2019	Jiang Yu		Xu Hong	Liu Shengkol	
▲	Approved for Construction	11.11.2018	Jiang Yu		Xu Hong	Liu Shengkol	
▲	Approved for Construction	02.02.2018	Chen Tao		Xu Hong	Liu Shengkol	
▲	Approved for Construction	06.11.2017	Chen Tao		Xu Hong	Liu Shengkol	
▲	Approved for Construction	04.05.2017	Chen Tao		Xu Hong	Shi Jing	
▲	Approved for Construction	12.04.2017	Chen Tao		Xu Hong	Shi Jing	
▲	Approved for Construction	20.01.2017	Chen Tao		Xu Hong	Shi Jing	
▲	Approved for Construction	16.10.2016	Chen Tao		Xu Hong	Shi Jing	
▲	Approved for Construction	31.08.2016	Chen Tao		Xu Hong	Shi Jing	
▲	Issued for Approval	29.06.2016	Chen Tao		Xu Hong	Shi Jing	
▲	Issued for Comments	29.04.2016	Chen Tao		Xu Hong	Shi Jing	


THIS DOCUMENT IS THE PROPERTY OF TCC. NO PART OF THIS DOCUMENT SHALL BE REPRODUCED OR DISCLOSED TO OTHERS OR USED FOR ANY PURPOSE WHATSOEVER EXCEPT WITH THE PRIOR WRITTEN PERMISSION OF TCC.

OWNER:  
**Middle East Kimiaye Pars Company**

<b>HALDOR TOPSØE A/S</b> COMPANY ENGINEER	DOCUMENT NAME	JOB NO.	DATE	REV.
	CONTRACTOR <b>TCC 中国天辰工程有限公司</b> CHINA TIANCHEN ENGINEERING CORPORATION	CONTRACTOR DRAWING NO. MKP-11-AS-7000-PS09-PID-022	SHEET 01	TOTAL 01
SUB-CONTRACTOR LOGO		SUB-CONTRACTOR DRAWING NO.		
		SHEET -- TOTAL --		

POTABLE WATER HEADER UTILITY DIAGRAM	PROJECT	MKP Methanol Project
	UNIT	Steam System & Utilities
PHASE	As Built Drawing	
OWNER DWG NO.	MKP-11-AS-7000-PR-PID-022	

Counter	Sign	Date

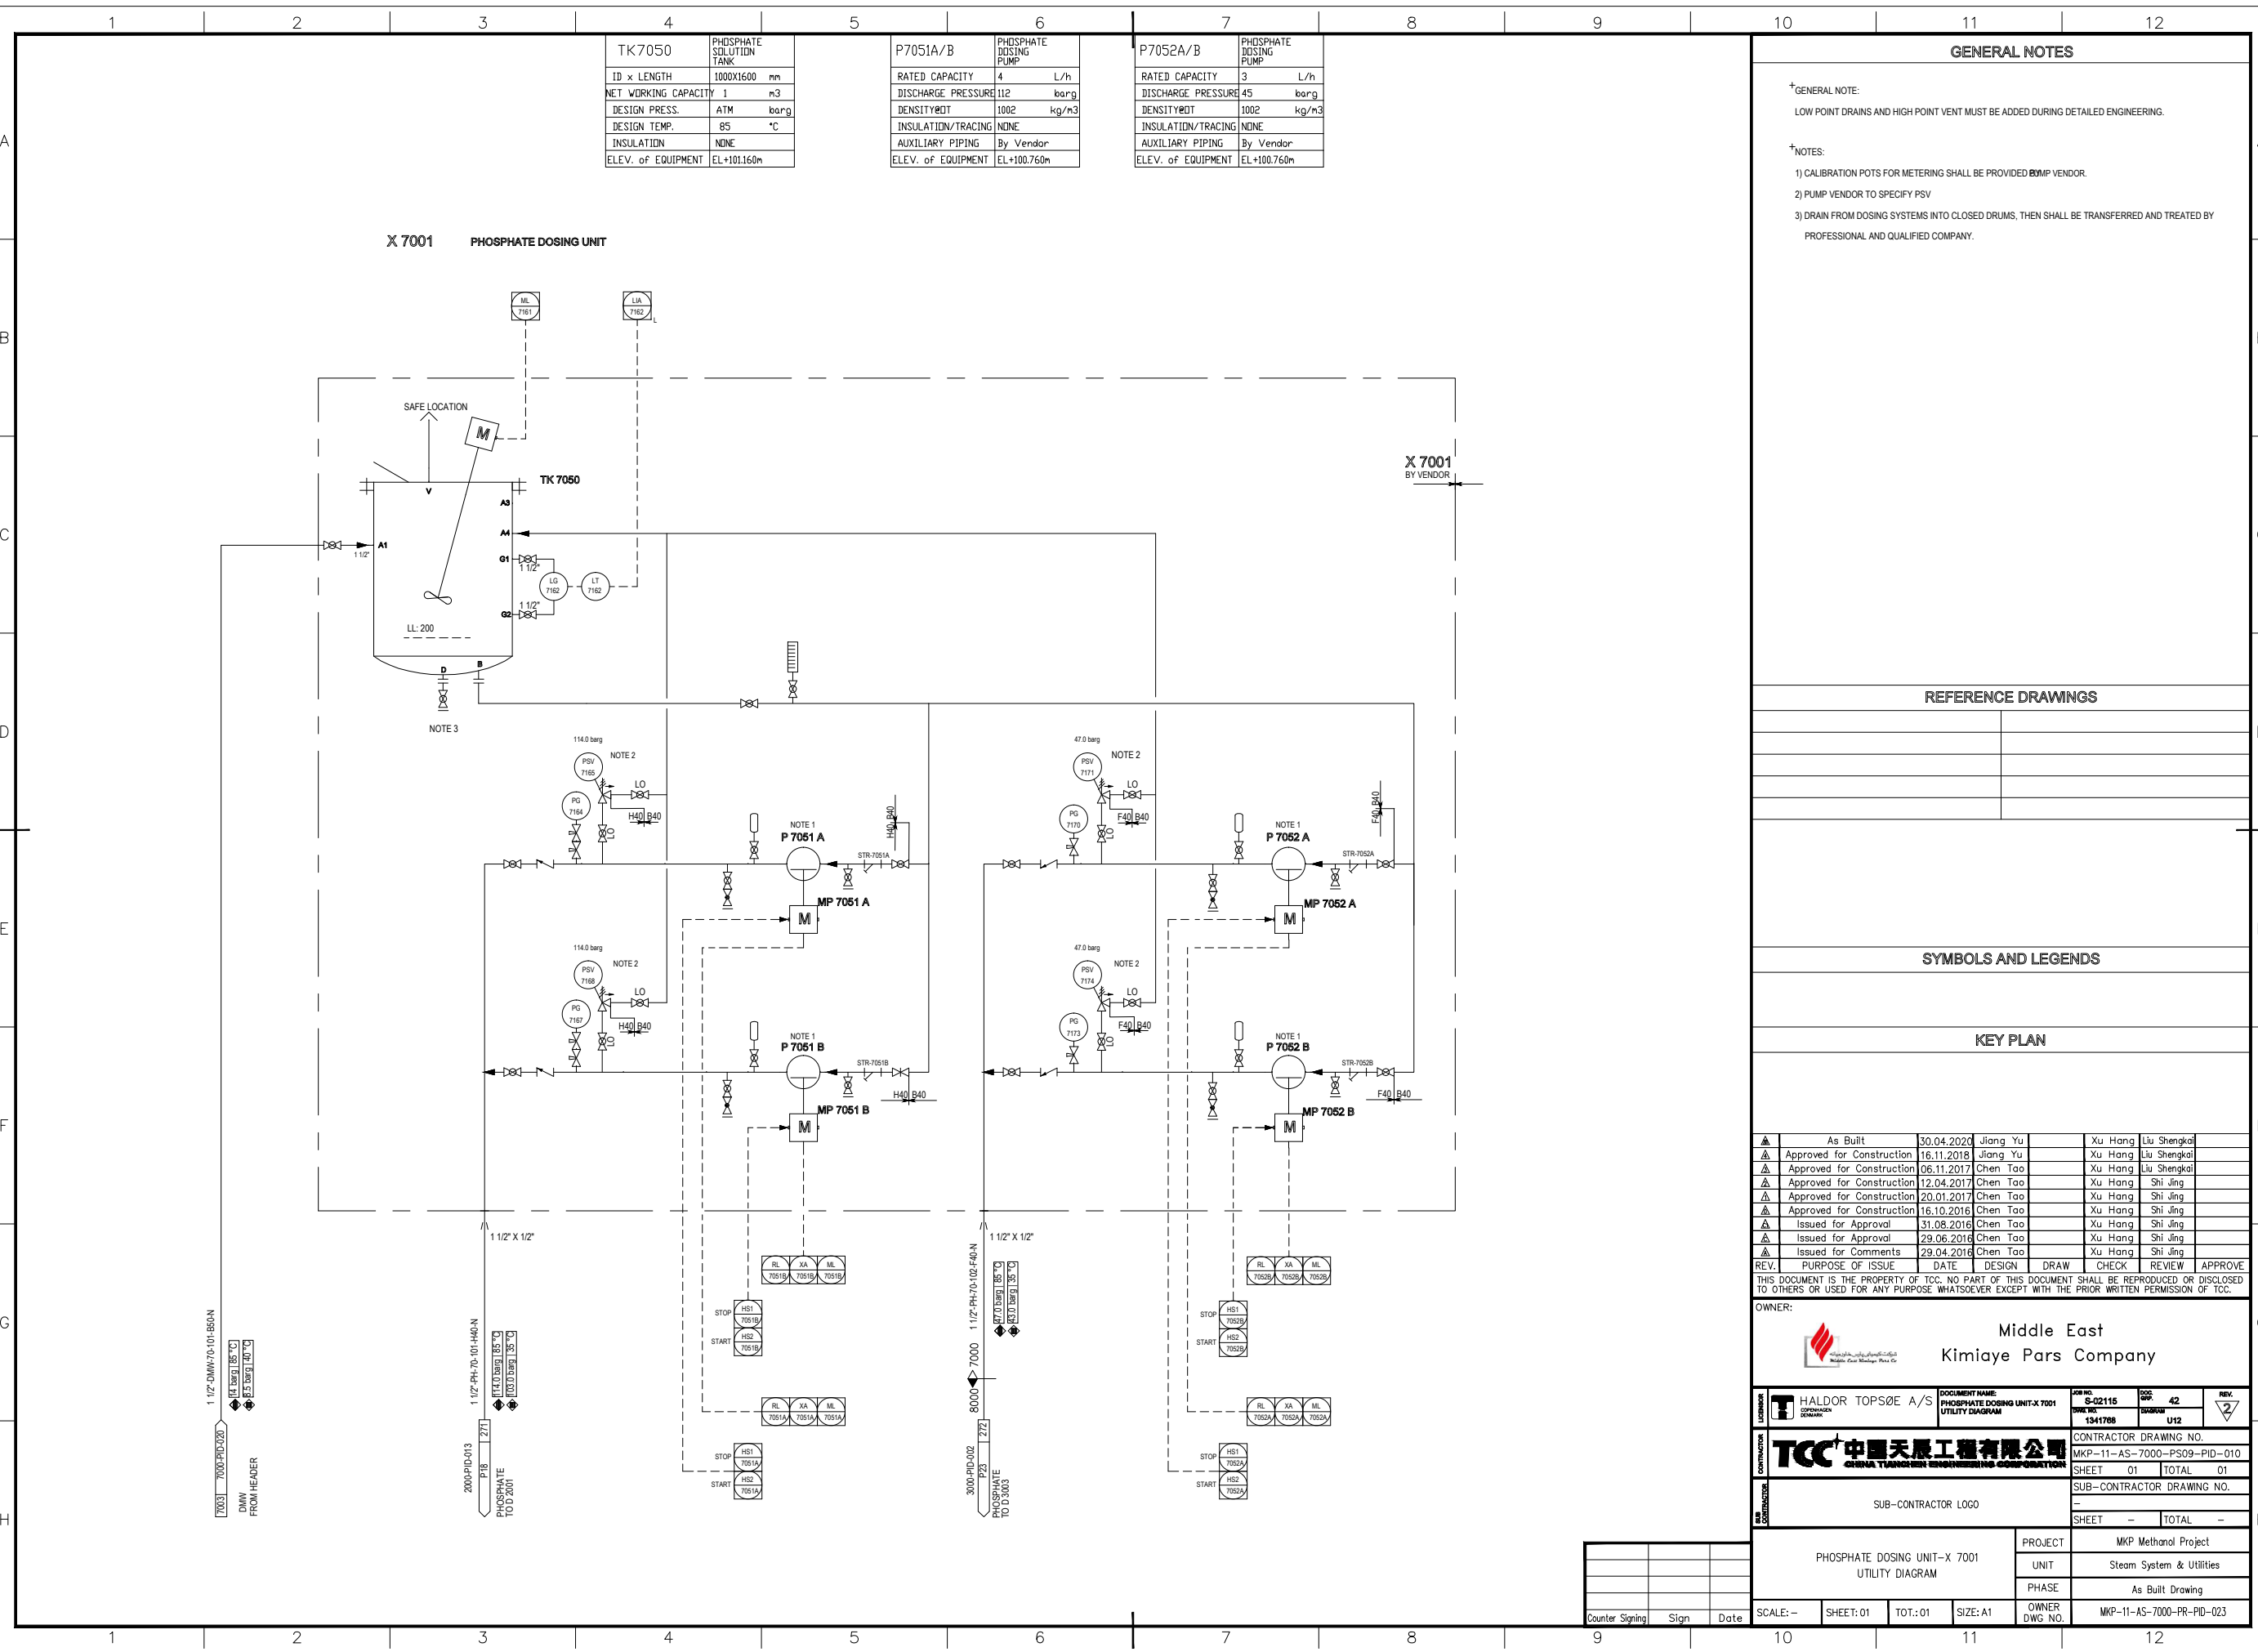

TK7050	
ID x LENGTH	1000X1600 mm
NET WORKING CAPACITY	1 m <sup>3</sup>
DESIGN PRESS.	ATM barg
DESIGN TEMP.	85 °C
INSULATION	NDNE
ELEV. of EQUIPMENT	EL+101.160m

P7051A/B	
RATED CAPACITY	4 L/h
DISCHARGE PRESSURE	112 barg
DENSITY@OT	1002 kg/m <sup>3</sup>
INSULATION/TRACING	NDNE
AUXILIARY PIPING	By Vendor
ELEV. of EQUIPMENT	EL+100.760m

P7052A/B	
RATED CAPACITY	3 L/h
DISCHARGE PRESSURE	45 barg
DENSITY@OT	1002 kg/m <sup>3</sup>
INSULATION/TRACING	NDNE
AUXILIARY PIPING	By Vendor
ELEV. of EQUIPMENT	EL+100.760m

**GENERAL NOTES**

- †GENERAL NOTE:  
LOW POINT DRAINS AND HIGH POINT VENT MUST BE ADDED DURING DETAILED ENGINEERING.
- †NOTES:  
1) CALIBRATION POTS FOR METERING SHALL BE PROVIDED BY VENDOR.  
2) PUMP VENDOR TO SPECIFY PSV  
3) DRAIN FROM DOSING SYSTEMS INTO CLOSED DRUMS, THEN SHALL BE TRANSFERRED AND TREATED BY PROFESSIONAL AND QUALIFIED COMPANY.

**REFERENCE DRAWINGS**

**SYMBOLS AND LEGENDS**

**KEY PLAN**

As Built	30.04.2020	Jiang Yu	Xu Hong	Liu Shengkol			
Approved for Construction	16.11.2018	Jiang Yu	Xu Hong	Liu Shengkol			
Approved for Construction	06.11.2017	Chen Tao	Xu Hong	Liu Shengkol			
Approved for Construction	12.04.2017	Chen Tao	Xu Hong	Shi Jing			
Approved for Construction	20.01.2017	Chen Tao	Xu Hong	Shi Jing			
Approved for Construction	16.10.2016	Chen Tao	Xu Hong	Shi Jing			
Issued for Approval	31.08.2016	Chen Tao	Xu Hong	Shi Jing			
Issued for Approval	29.06.2016	Chen Tao	Xu Hong	Shi Jing			
Issued for Comments	29.04.2016	Chen Tao	Xu Hong	Shi Jing			
REV.	PURPOSE OF ISSUE	DATE	DESIGN	DRAW	CHECK	REVIEW	APPROVE

OWNER:		Middle East Kimiaye Pars Company	
DESIGNER	HALDOR TOPSØE A/S	DOCUMENT NAME	PHOSPHATE DOSING UNIT-X 7001 UTILITY DIAGRAM
CONTRACTOR	TCC 中国天辰工程技术有限公司 CHINA TIANCHEN ENGINEERING CORPORATION	PROJ NO	S-02115
CONTRIBUTOR		CONTRACTOR DRAWING NO.	1341788
		MKP-11-AS-7000-PS09-PID-010	
		SHEET 01	TOTAL 01
		SUB-CONTRACTOR DRAWING NO.	
		SHEET --	TOTAL --


PROJECT		MKP Methanol Project	
UNIT		Steam System & Utilities	
PHASE		As Built Drawing	
OWNER DWG NO.		MKP-11-AS-7000-PR-PID-023	

Counter	Sign	Date

TK7060	AMMONIA TANK
ID x LENGTH	1600X2100 mm
NET WORKING CAPACITY	3.6 m <sup>3</sup>
DESIGN PRESS.	ATM barg
DESIGN TEMP.	85 °C
INSULATION	YES
ELEV. of EQUIPMENT	EL+101.310m

P7060A/B	AMMONIA DOSING PUMP
RATED CAPACITY	40 L/h
DISCHARGE PRESSURE	5.5 barg
DENSITY@DT	948 kg/m <sup>3</sup>
INSULATION/TRACING	NONE
AUXILIARY PIPING	By Vendor
ELEV. of EQUIPMENT	EL+100.780m

**X 7002 AMMONIA DOSING UNIT**

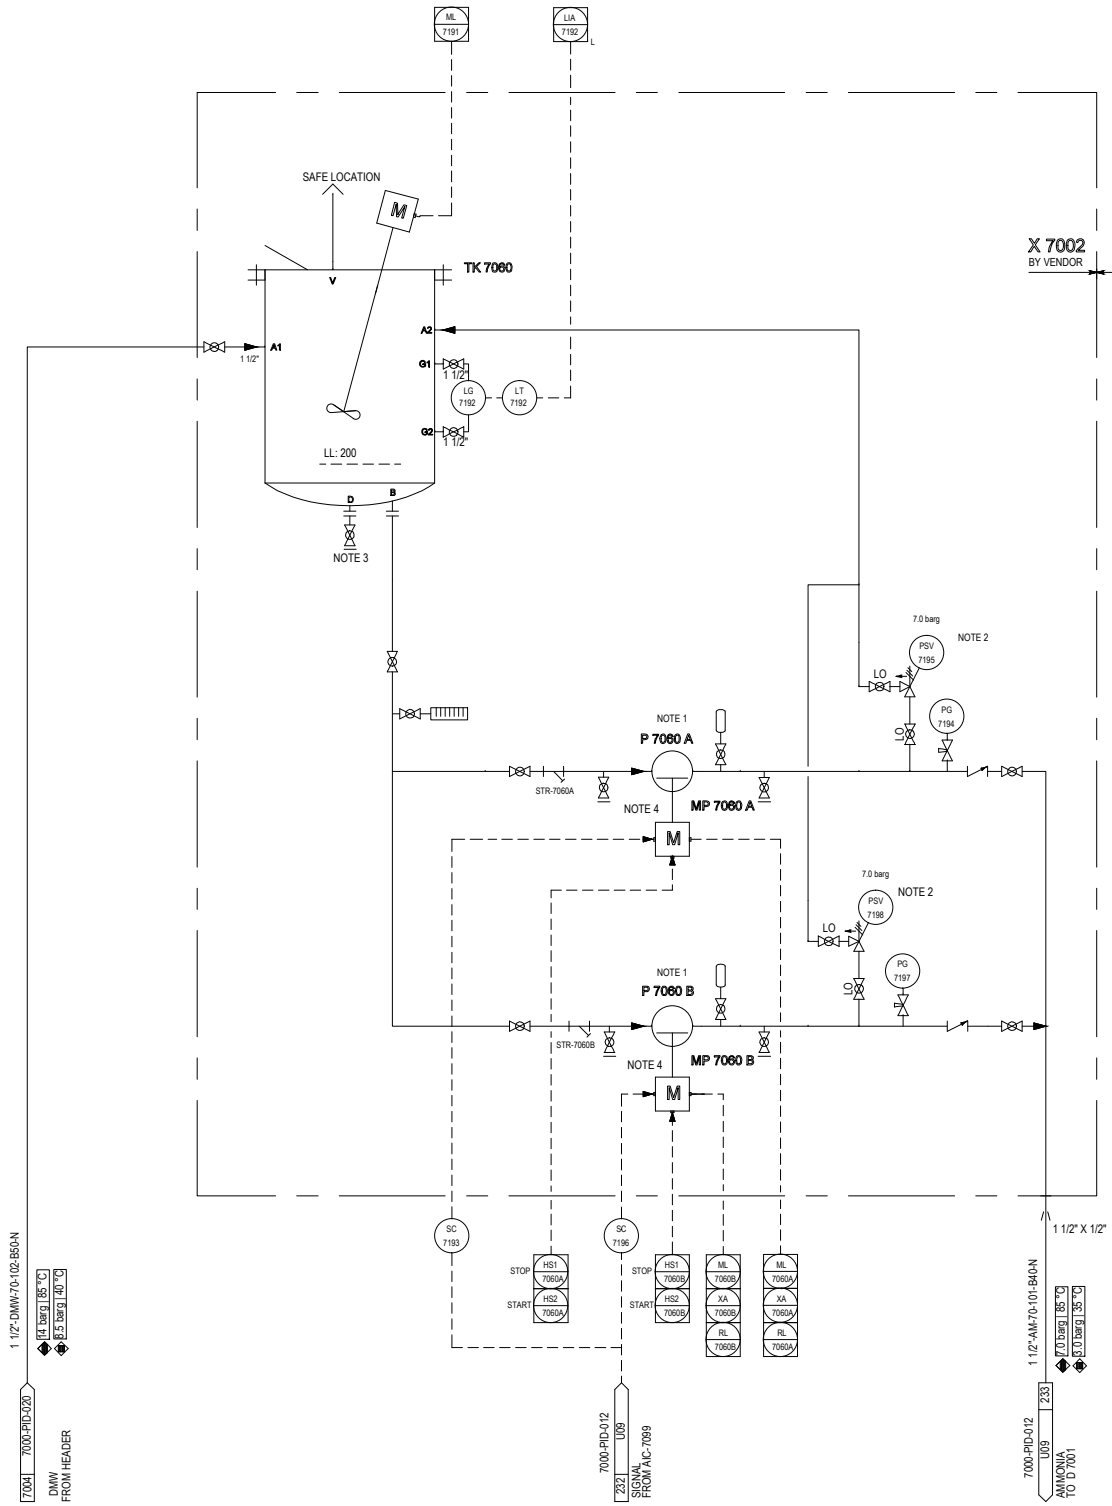

**GENERAL NOTES**

- \*GENERAL NOTE:  
LOW POINT DRAINS AND HIGH POINT VENT MUST BE ADDED DURING DETAILED ENGINEERING.
- \*NOTES:  
1) CALIBRATION POTS FOR METERING SHALL BE PROVIDED BY VENDOR.  
2) PUMP VENDOR TO SPECIFY PSV.  
3) DRAIN FROM DOSING SYSTEMS INTO CLOSED DRUMS, THEN SHALL BE TRANSFERRED AND TREATED BY PROFESSIONAL AND QUALIFIED COMPANY.  
4) SPEED CONTROL IS PERFORMED BY ELECTRICAL STROKE ADJUSTMENT (SERVO MOTOR).

**REFERENCE DRAWINGS**

**SYMBOLS AND LEGENDS**

**KEY PLAN**

As Built	30.04.2020	Jiang Yu	Xu Hong	Liu Shengkai			
Approved for Construction	16.11.2018	Jiang Yu	Xu Hong	Liu Shengkai			
Approved for Construction	06.11.2017	Chen Tao	Xu Hong	Liu Shengkai			
Approved for Construction	12.04.2017	Chen Tao	Xu Hong	Shi Jing			
Approved for Construction	20.01.2017	Chen Tao	Xu Hong	Shi Jing			
Approved for Construction	16.10.2016	Chen Tao	Xu Hong	Shi Jing			
Approved for Construction	31.08.2016	Chen Tao	Xu Hong	Shi Jing			
Issued for Approval	29.06.2016	Chen Tao	Xu Hong	Shi Jing			
Issued for Comments	29.04.2016	Chen Tao	Xu Hong	Shi Jing			
REV.	PURPOSE OF ISSUE	DATE	DESIGN	DRAW	CHECK	REVIEW	APPROVE

THIS DOCUMENT IS THE PROPERTY OF TCC. NO PART OF THIS DOCUMENT SHALL BE REPRODUCED OR DISCLOSED TO OTHERS OR USED FOR ANY PURPOSE WHATSOEVER EXCEPT WITH THE PRIOR WRITTEN PERMISSION OF TCC.

OWNER: **Middle East Kimiaye Pars Company**

DESIGNER	HALDOR TOPSØE A/S	DOCUMENT NAME	AMMONIA DOSING UNIT-X 7002 UTILITY DIAGRAM	JOB NO.	S-02115	CONTRACT NO.	42	REV.	2
DATE	13/11/2018	SCALE	UTS	CONTRACTOR DRAWING NO.	MKP-11-AS-7000-PS09-PID-011	SHEET	01	TOTAL	01
SUB-CONTRACTOR LOGO					SUB-CONTRACTOR DRAWING NO.				
SHEET					TOTAL				

PROJECT	MKP Methanol Project
UNIT	Steam System & Utilities
PHASE	As Built Drawing
OWNER DWG NO.	MKP-11-AS-7000-PR-PID-024

Counter	Sign	Date
---------	------	------

SCALE: -	SHEET: 01	TOT.: 01	SIZE: A1
----------	-----------	----------	----------




TK7070	OXYGEN SCAVENGER TANK
ID x LENGTH	1500x2200 mm
NET WORKING CAPACITY	3.2 m <sup>3</sup>
DESIGN PRESS.	ATM barg
DESIGN TEMP.	100 °C
INSULATION	NONE
ELEV. of EQUIPMENT	EL+101.290m

P7070A/B	OXYGEN SCAVENGER PUMP
RATED CAPACITY	38 L/h
DISCHARGE PRESSURE	5.5 barg
DENSITY@OT	990 kg/m <sup>3</sup>
INSULATION/TRACING	NONE
AUXILIARY PIPING	By Vendor
ELEV. of EQUIPMENT	EL+100.780m

**GENERAL NOTES**

- \*GENERAL NOTE:  
LOW POINT DRAINS AND HIGH POINT VENT MUST BE ADDED DURING DETAILED ENGINEERING.
- \*NOTES:  
1) CALIBRATION POTS FOR METERING SHALL BE PROVIDED BY PUMP VENDOR.  
2) PUMP VENDOR TO SPECIFY PSV.  
3) DRAIN FROM DOSING SYSTEMS INTO CLOSED DRUMS, THEN SHALL BE TRANSFERRED AND TREATED BY PROFESSIONAL AND QUALIFIED COMPANY.

**X 7003 OXYGEN SCAVENGER DOSING UNIT**

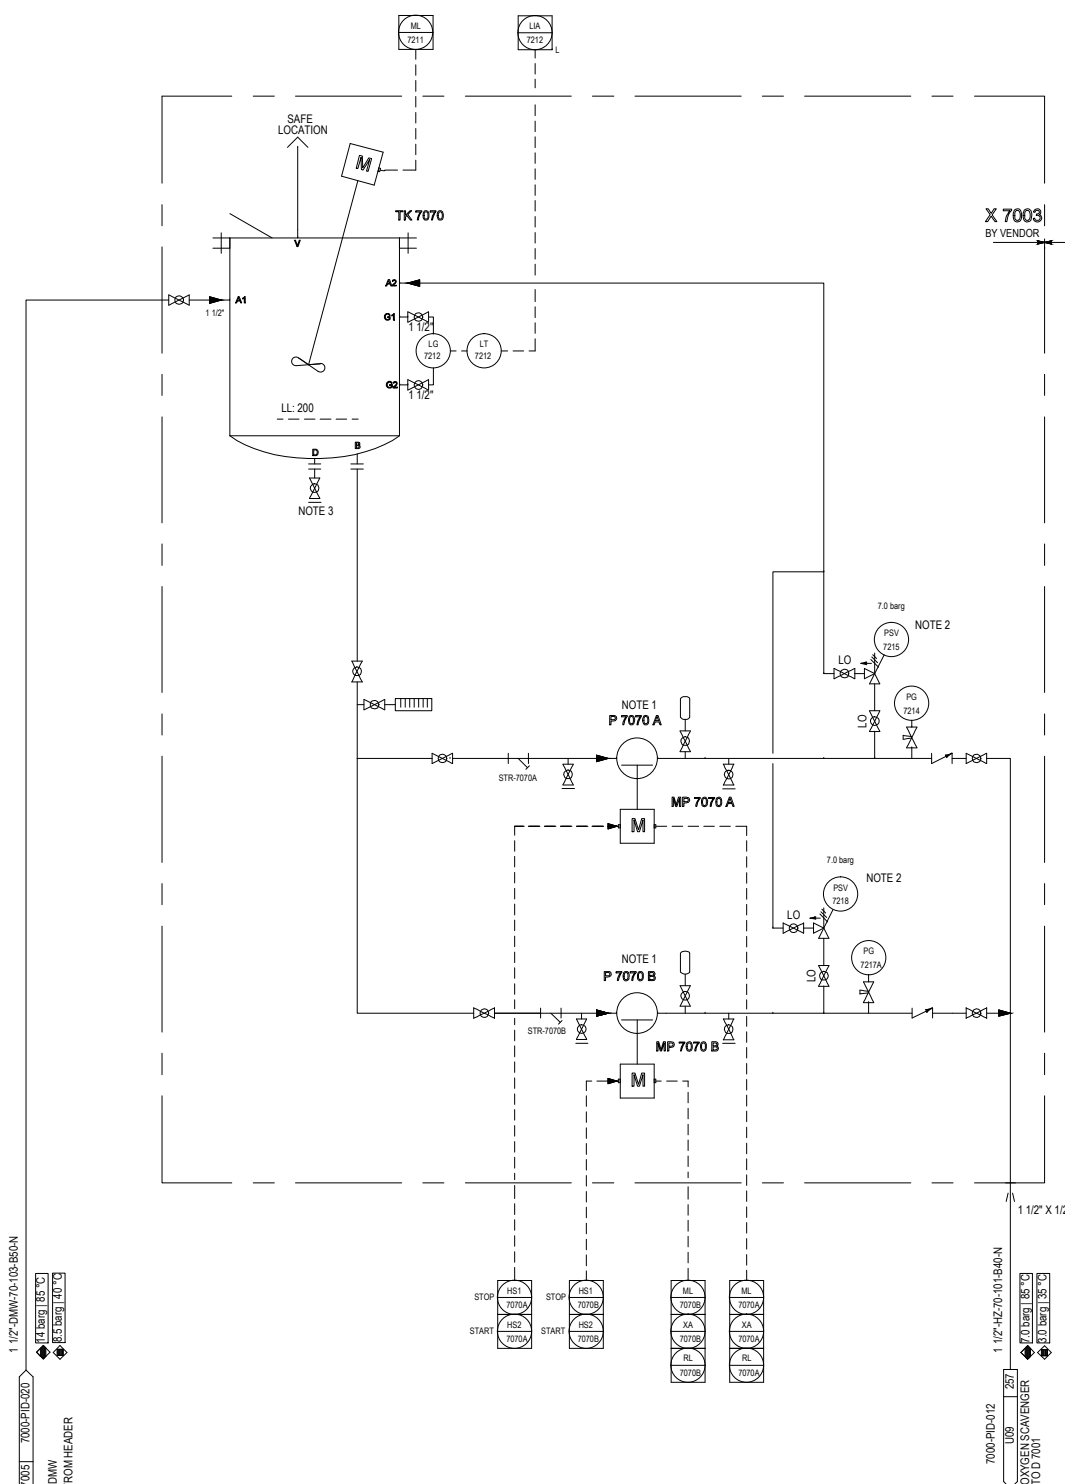

**REFERENCE DRAWINGS**

**SYMBOLS AND LEGENDS**

**KEY PLAN**

As Built	30.04.2020	Jiang Yu		Xu Hong	Liu Shengkol
Approved for Construction	30.12.2019	Jiang Yu		Xu Hong	Liu Shengkol
Approved for Construction	16.11.2018	Jiang Yu		Xu Hong	Liu Shengkol
Approved for Construction	06.11.2017	Chen Tao		Xu Hong	Liu Shengkol
Approved for Construction	12.04.2017	Chen Tao		Xu Hong	Shi Jing
Approved for Construction	20.01.2017	Chen Tao		Xu Hong	Shi Jing
Approved for Construction	16.10.2016	Chen Tao		Xu Hong	Shi Jing
Approved for Construction	31.08.2016	Chen Tao		Xu Hong	Shi Jing
Issued for Approval	29.06.2016	Chen Tao		Xu Hong	Shi Jing
Issued for Comments	29.04.2016	Chen Tao		Xu Hong	Shi Jing

REV. PURPOSE OF ISSUE DATE DESIGN DRAW CHECK REVIEW APPROVE  
THIS DOCUMENT IS THE PROPERTY OF TCC. NO PART OF THIS DOCUMENT SHALL BE REPRODUCED OR DISCLOSED TO OTHERS OR USED FOR ANY PURPOSE WHATSOEVER EXCEPT WITH THE PRIOR WRITTEN PERMISSION OF TCC.

OWNER: **Middle East Kimiaye Pars Company**

DESIGNER	HALDOR TOPSØE A/S	DOCUMENT NAME	OXYGEN SCAVENGER DOSING UNIT-X 7003 UTILITY DIAGRAM	PRO NO	S-02115	CON NO	42	REV.	2
DATE	13/11/2019	CONTRACTOR DRAWING NO.	MKP-11-AS-7000-PS09-PID-012	DWG NO.	1341770	ISSUE NO.	U14		
CONTRACTOR	<b>TCC 中国天辰工程有限公司</b>	SHEET	01	TOTAL	01	SUB-CONTRACTOR DRAWING NO.			
CONTRACTOR		SHEET		TOTAL					

PROJECT	MKP Methanol Project
UNIT	Steam System & Utilities
PHASE	As Built Drawing
OWNER DWG NO.	MKP-11-AS-7000-PR-PID-025

Counter Signing	Sign	Date
-----------------	------	------

SCALE: -	SHEET: 01	TOT.: 01	SIZE: A1
----------	-----------	----------	----------

D7002	CONTINUOUS BLOW-DOWN DRUM NO. 1
ID x LENGTH(T)	750x3325 mm
DESIGN PRESS.	F.V/9.5 barg
DESIGN TEMP.	340 °C
INSULATION	YES
CLADDING/LINING	NONE
ELEV. of EQUIPMENT	EL+105.870m

D7003	INTERMITTENT BLOW-DOWN DRUM NO. 1
ID x LENGTH(T)	1250x1825 mm
DESIGN PRESS.	3.5 barg
DESIGN TEMP.	150 °C
INSULATION	YES
CLADDING/LINING	NONE
ELEV. of EQUIPMENT	EL+102.940m

D7004	INTERMITTENT BLOW-DOWN DRUM NO. 2
ID x LENGTH(T)	950x1575 mm
DESIGN PRESS.	3.5 barg
DESIGN TEMP.	150 °C
INSULATION	YES
CLADDING/LINING	NONE
ELEV. of EQUIPMENT	EL+102.500m

P7005A/B	BOILER BLOW-DOWN PUMP
RATED CAPACITY	10 m <sup>3</sup> /h
HEAD	80 m
DENSITY@OT	958 kg/m <sup>3</sup>
INSULATION/TRACING	NONE
AUXILIARY PIPING	By Vendor
ELEV. of EQUIPMENT	EL+101.040m

E7001	BLOW-DOWN COOLER FOR D 7003
DUTY	0.5 Mw
DESIGN PRESS.(TU./SH.)	7.5/3.5 barg
DESIGN TEMP.(TU./SH.)	100/150 °C
INSULATION	YES
ELEV. of EQUIPMENT	EL+101.040m

**GENERAL NOTES**


- †GENERAL NOTE:  
LOW POINT DRAINS AND HIGH POINT VENT MUST BE ADDED DURING DETAILED ENGINEERING.
- ‡NOTES:  
1) 1/2" DRIPHOLE TO BE DRILLED AT LOW POINT TO SAFE AND SUITABLE LOCATION.  
2) ELEVATION AT MAX LEVEL IN D 7004.  
3) CONTINUOUS BLOW-DOWN VALVE TO BE PLACED AS CLOSE AS POSSIBLE TO D 7002.  
4) INTERMITTENT BLOW-DOWN VALVE TO BE PLACED AS CLOSE AS POSSIBLE TO D 7004.  
5) DISTANCE BETWEEN E-7001 AND D-7003 SHALL BE MINIMIZED IN ORDER TO REDUCE THE RISK OF VAPORIZING THE HOT CONDENSATE DUE TO PRESSURE DROP IN THE LINE.



**REFERENCE DRAWINGS**

**SYMBOLS AND LEGENDS**


**KEY PLAN**


REV.	PURPOSE OF ISSUE	DATE	DESIGN	DRAW	CHECK	REVIEW	APPROVE
▲	As Built	30.04.2020	Jiang Yu	Xu Hang	Liu Shengko		
▲	Approved for Construction	30.12.2019	Jiang Yu	Xu Hang	Liu Shengko		
▲	Approved for Construction	24.04.2018	Jiang Yu	Xu Hang	Liu Shengko		
▲	Approved for Construction	13.08.2018	Jiang Yu	Xu Hang	Liu Shengko		
▲	Approved for Construction	26.03.2018	Chen Tao	Xu Hang	Liu Shengko		
▲	Approved for Construction	06.11.2017	Chen Tao	Xu Hang	Liu Shengko		
▲	Approved for Construction	04.05.2017	Chen Tao	Xu Hang	Shi Jing		
▲	Approved for Construction	12.04.2017	Chen Tao	Xu Hang	Shi Jing		
▲	Approved for Construction	20.01.2017	Chen Tao	Xu Hang	Shi Jing		
▲	Approved for Construction	16.10.2016	Chen Tao	Xu Hang	Shi Jing		
▲	Approved for Construction	31.08.2016	Chen Tao	Xu Hang	Shi Jing		
▲	Issued for Approval	29.06.2016	Chen Tao	Xu Hang	Shi Jing		
▲	Issued for Comments	29.04.2016	Chen Tao	Xu Hang	Shi Jing		

OWNER:  Middle East Kimiaye Pars Company

 HALDOR TOPSØE A/S COMPANY ENGINEER	DOCUMENT NAME: BOILER BLOW-DOWN UTILITY DIAGRAM	PROJ NO: S-02115	CONTRACT NO: 42	REV. 4
	 TCC 中国天辰工程有限公司 CHINA TIANCHEN ENGINEERING CORPORATION	CONTRACTOR DRAWING NO. MKP-11-AS-7000-PS09-PID-013	SHEET NO: 1341772	TOTAL SHEETS: 42
SUB-CONTRACTOR LOGO		SUB-CONTRACTOR DRAWING NO.		
		SHEET 01 TOTAL 01		

BOILER BLOW-DOWN UTILITY DIAGRAM	PROJECT	MKP Methanol Project
	UNIT	Steam System & Utilities
PHASE	As Built Drawing	
OWNER DWG NO.	MKP-11-AS-7000-PR-PID-026	

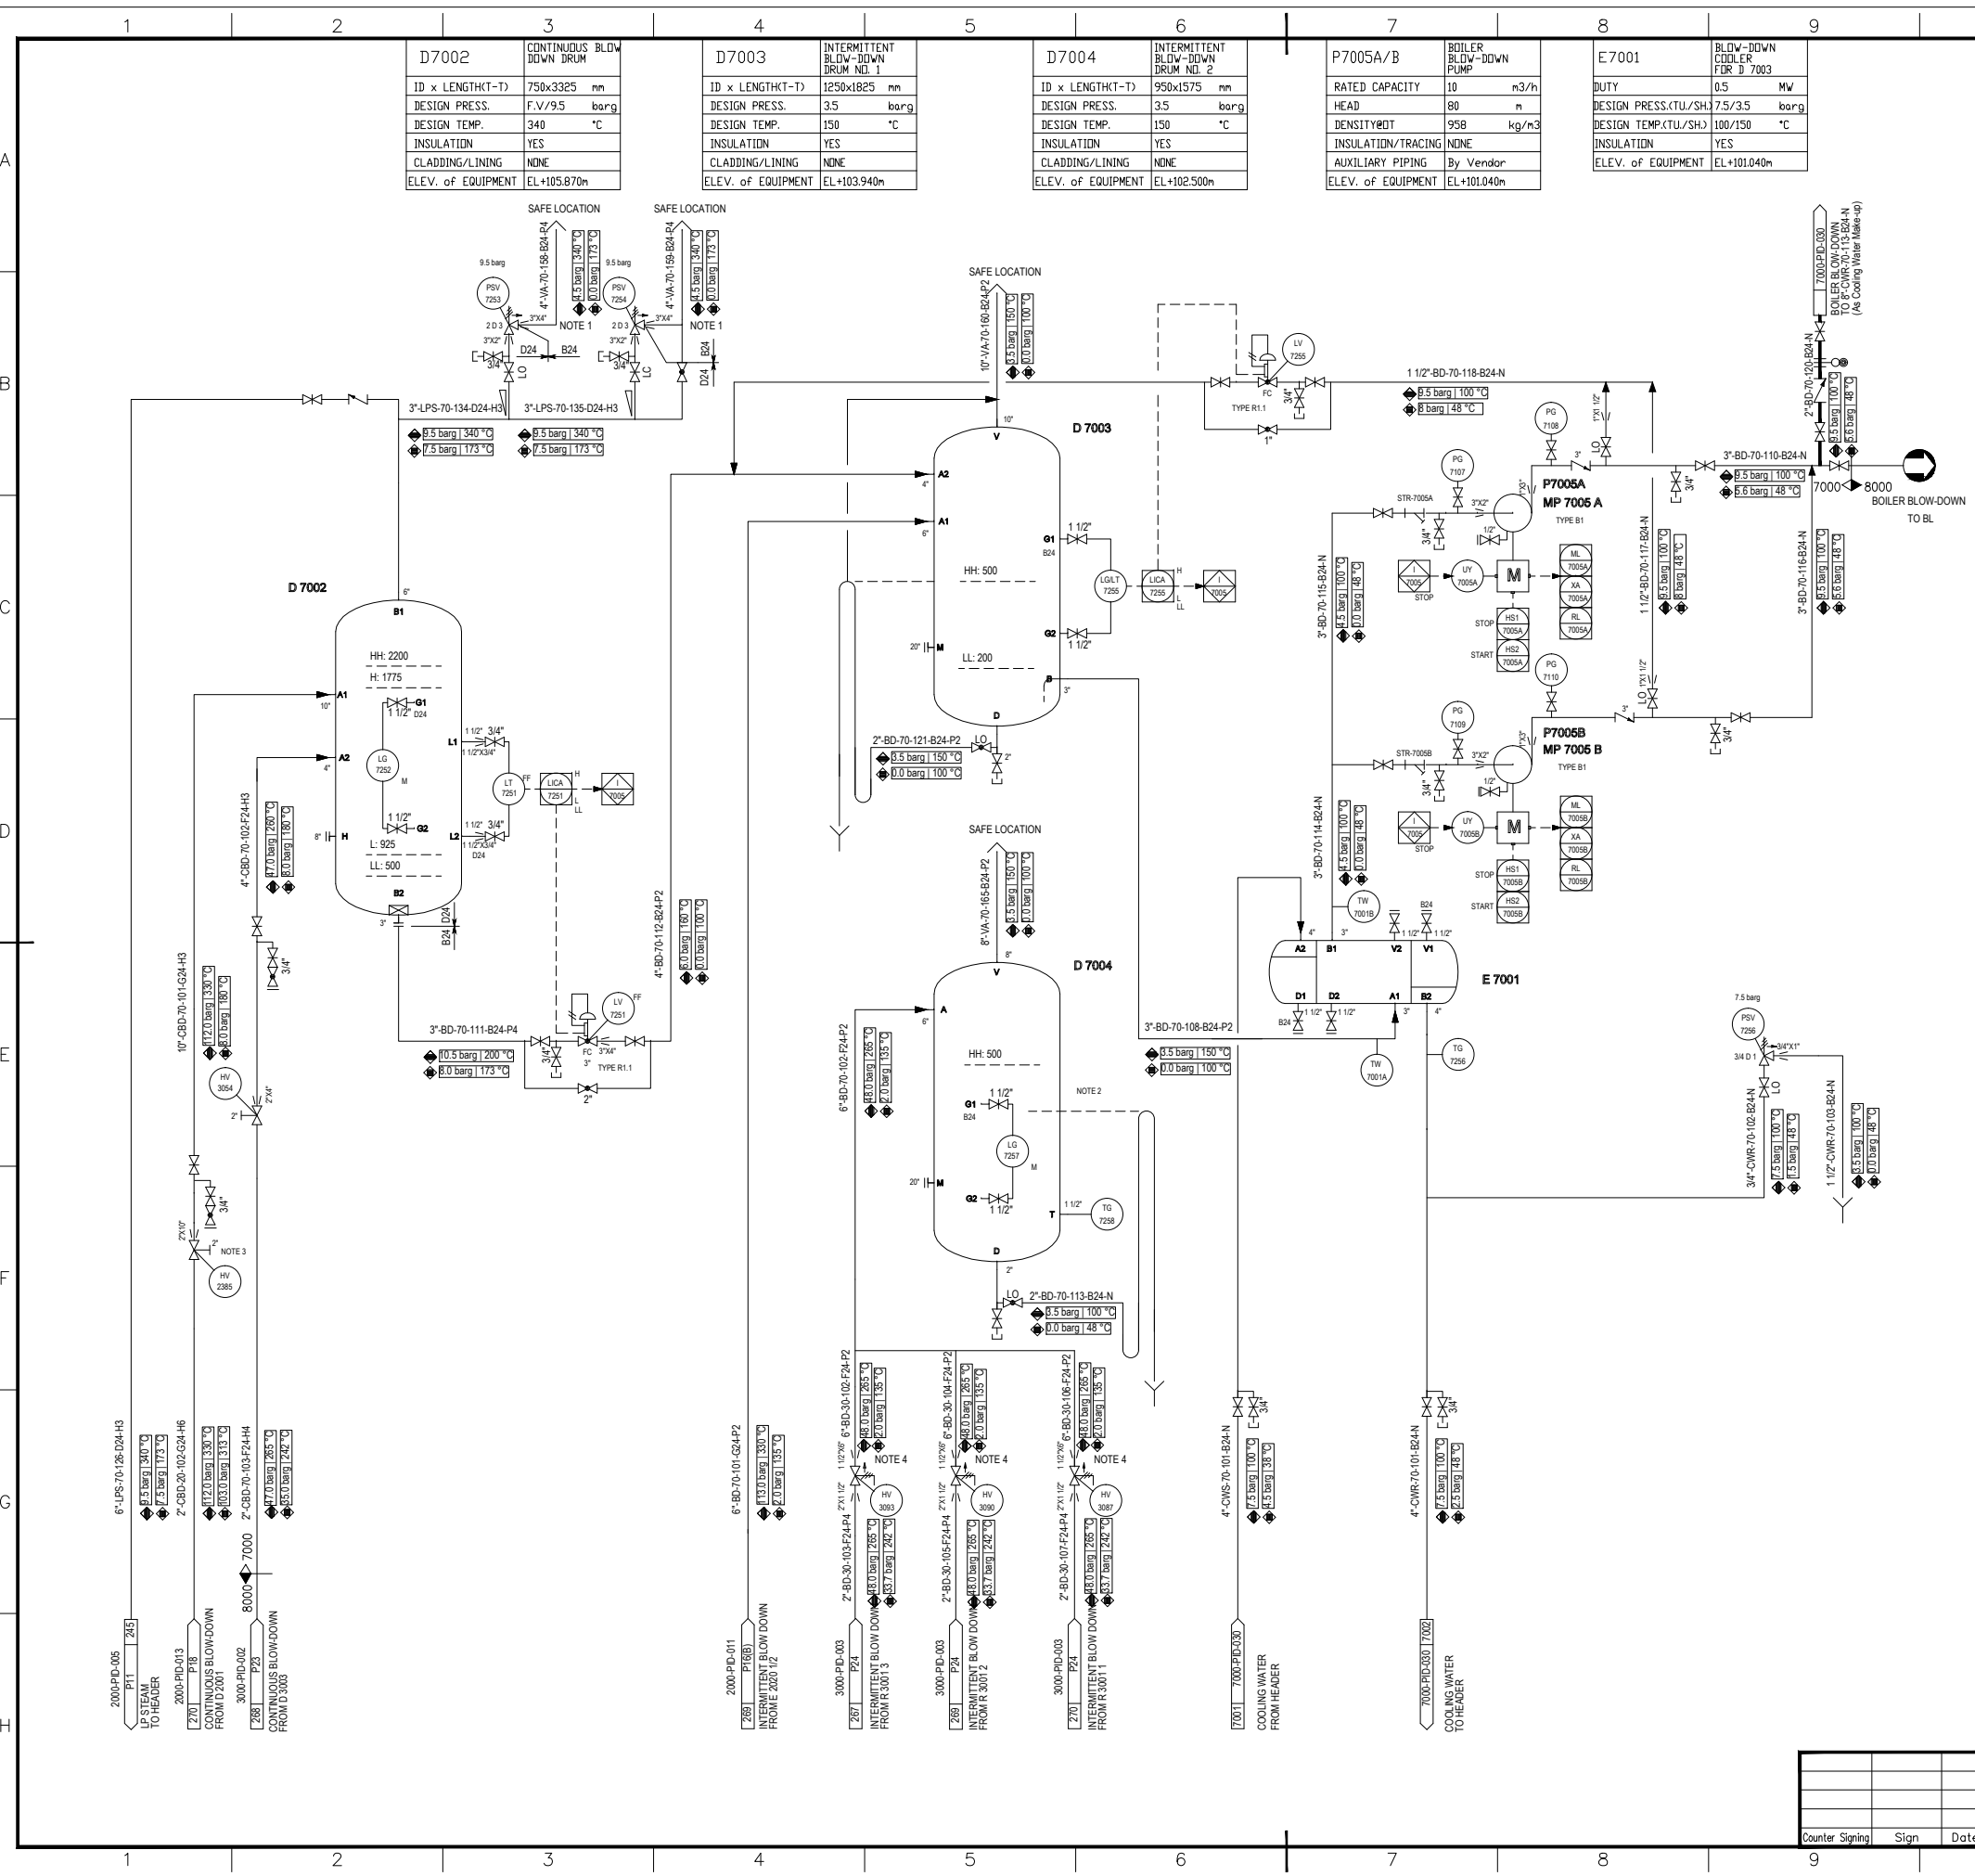

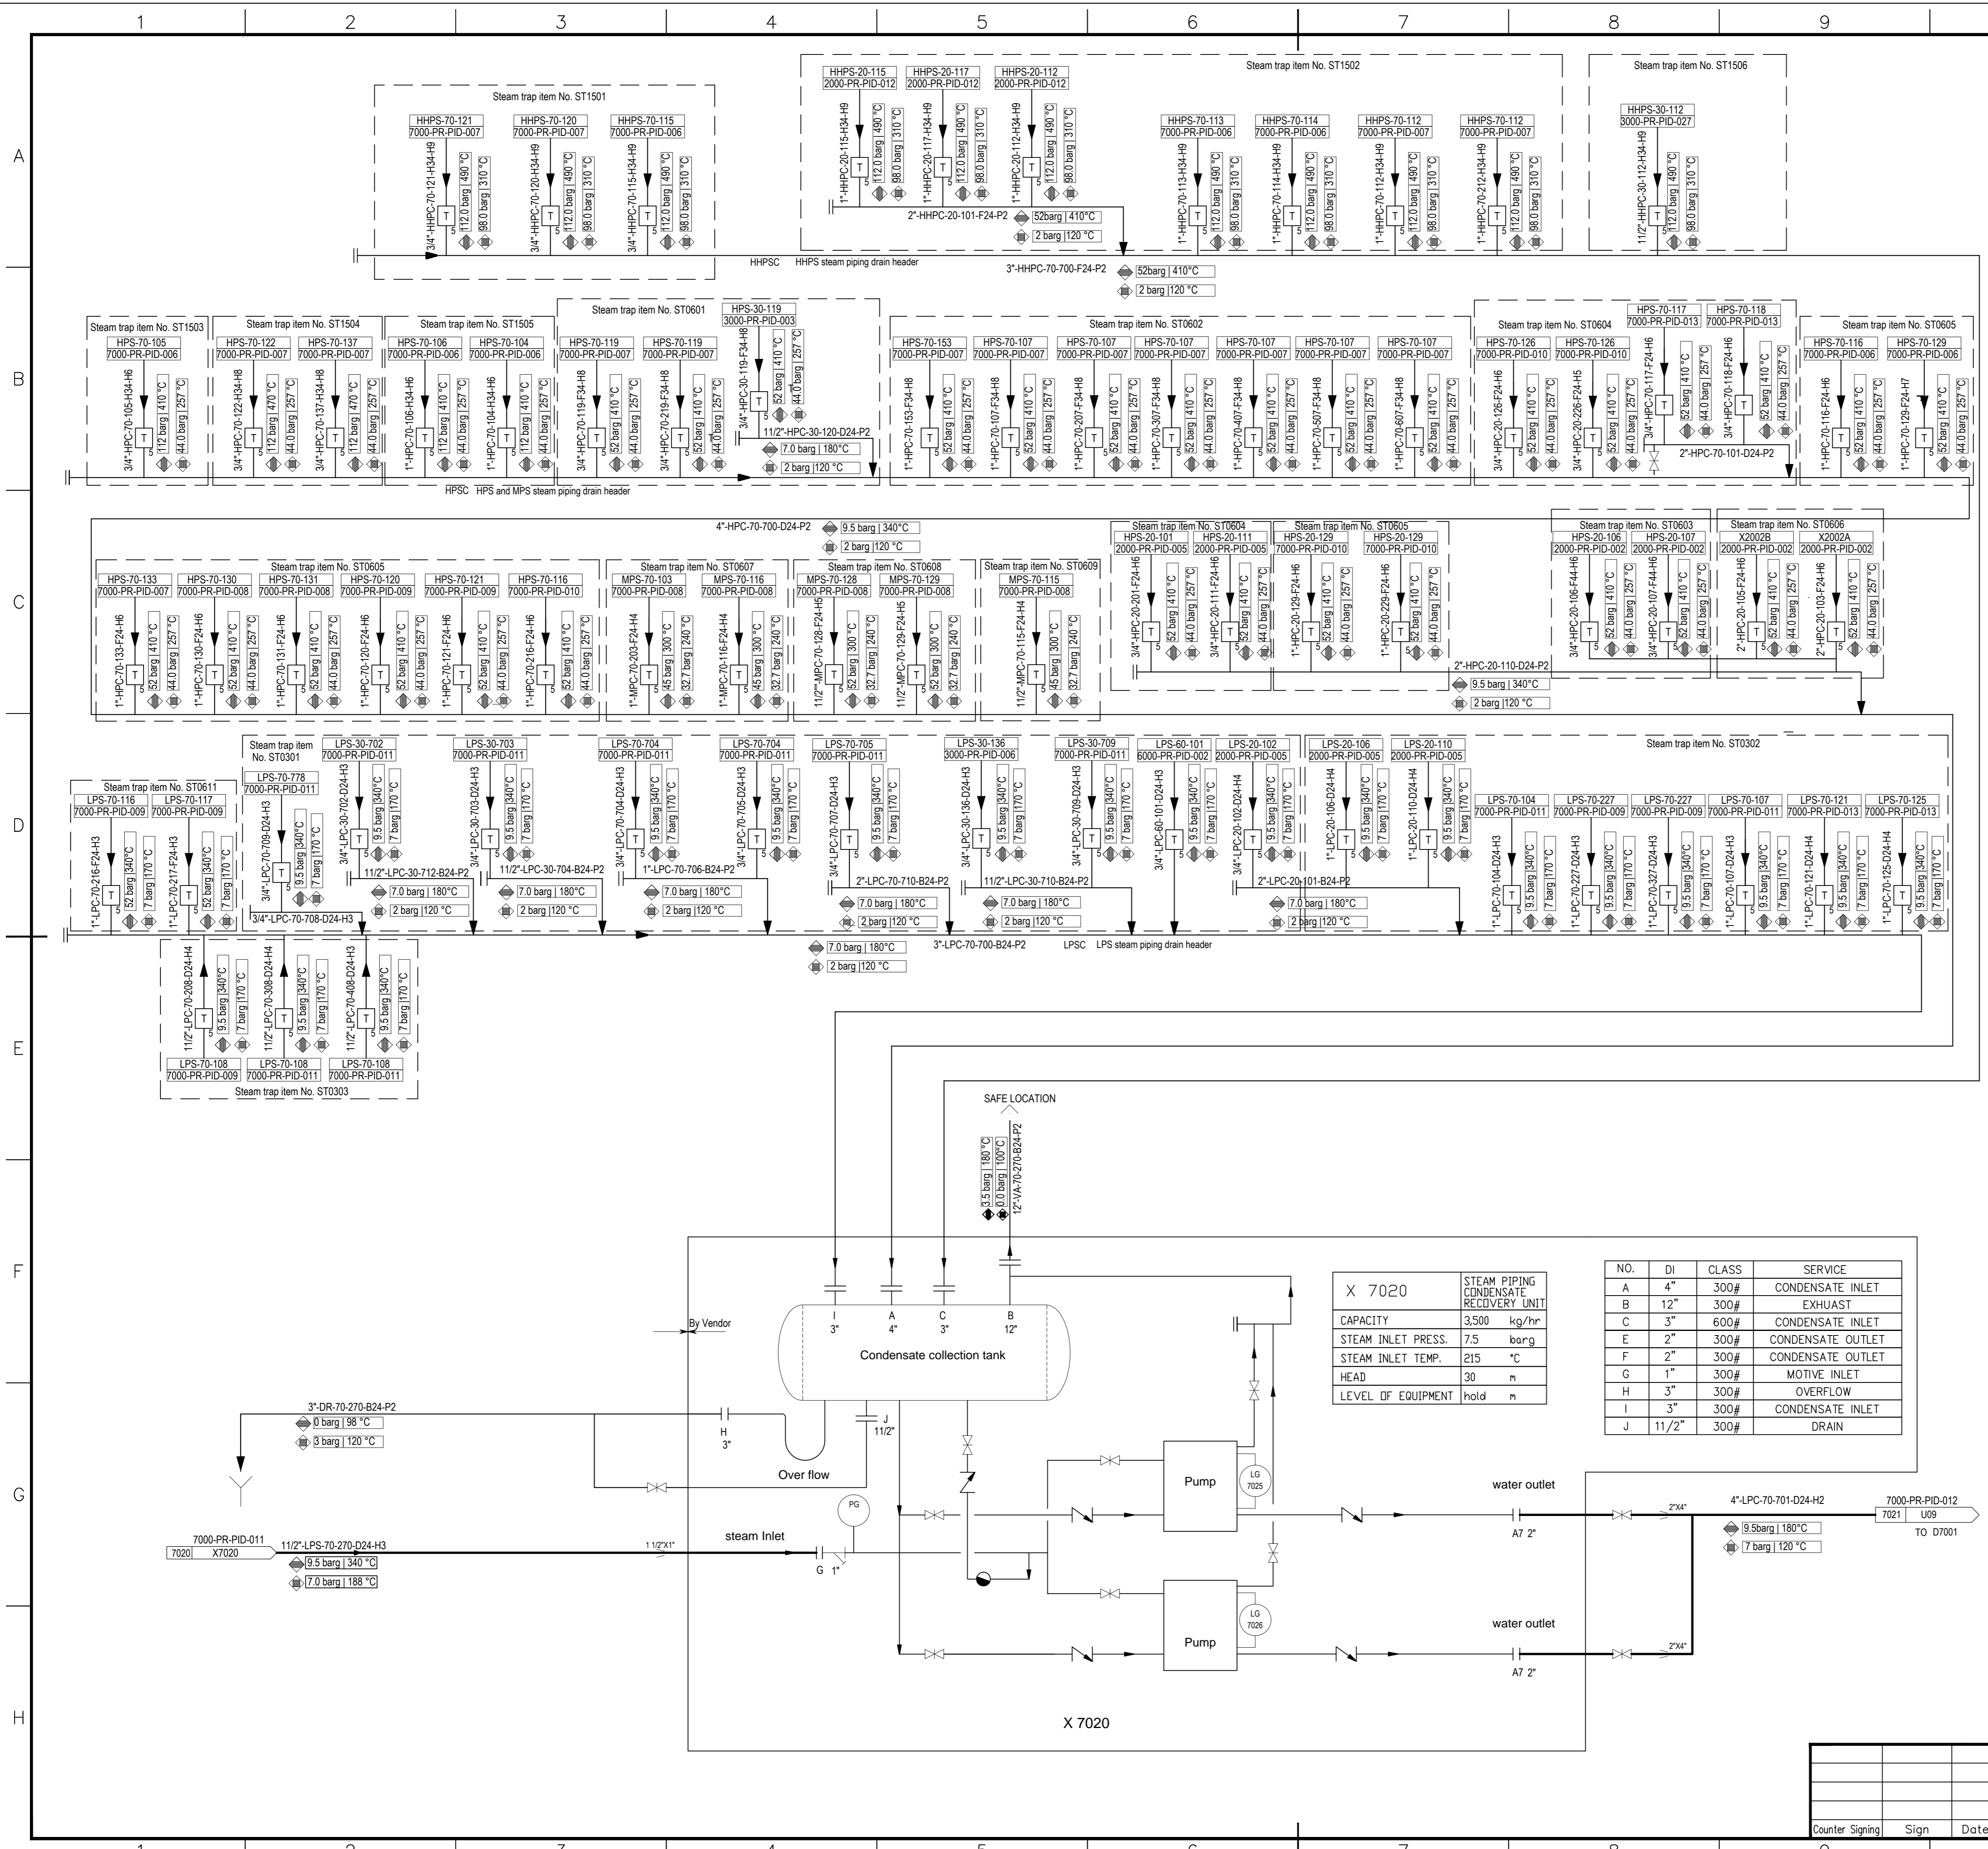

**GENERAL NOTES**

GENERAL NOTE:  
 LOW POINT DRAINS AND HIGH POINT VENT MUST BE ADDED DURING DETAILED ENGINEERING.  
 Steam trap item No. is according with "MKP-11-DE-9000-PI-DSH-009 DATA SHEET FOR STEAM TRAP"

**REFERENCE DRAWINGS**


**SYMBOLS AND LEGENDS**


**KEY PLAN**


NO.	DI	CLASS	SERVICE
A	4"	300#	CONDENSATE INLET
B	12"	300#	EXHAUST
C	3"	600#	CONDENSATE INLET
E	2"	300#	CONDENSATE OUTLET
F	2"	300#	CONDENSATE OUTLET
G	1"	300#	MOTIVE INLET
H	3"	300#	OVERFLOW
I	3"	300#	CONDENSATE INLET
J	11/2"	300#	DRAIN

OWNER: **Middle East Kimiaye Pars Company**

<b>HALDOR TOPSØE A/S</b> ENGINEERING DENMARK	DOCUMENT NAME: BFW HEADER UTILITY DIAGRAM	JOB NO. DWG. NO.	ECC. GRP. SHEET NO.
<b>TCC 中国天辰工程有限公司</b> CHINA TIANCHEN ENGINEERING CORPORATION		CONTRACTOR DRAWING NO. MKP-11-AS-7000-HE07-PID-010	
SHEET 01 TOTAL 01		SHEET - TOTAL -	

STEAM CONDENSATE RECOVERY UNIT	PROJECT	MKP Methanol Project
PIPING AND INSTRUMENT DIAGRAM	UNIT	STEAM SYSTEM & UTILITIES
	PHASE	AS BUILT DRAWING
SCALE 1	SHEET 1	TOT. 1
COUNTER SIGNING	Sign	Date
OWNER	MKP-11-AS-7000-PR-PID-027	



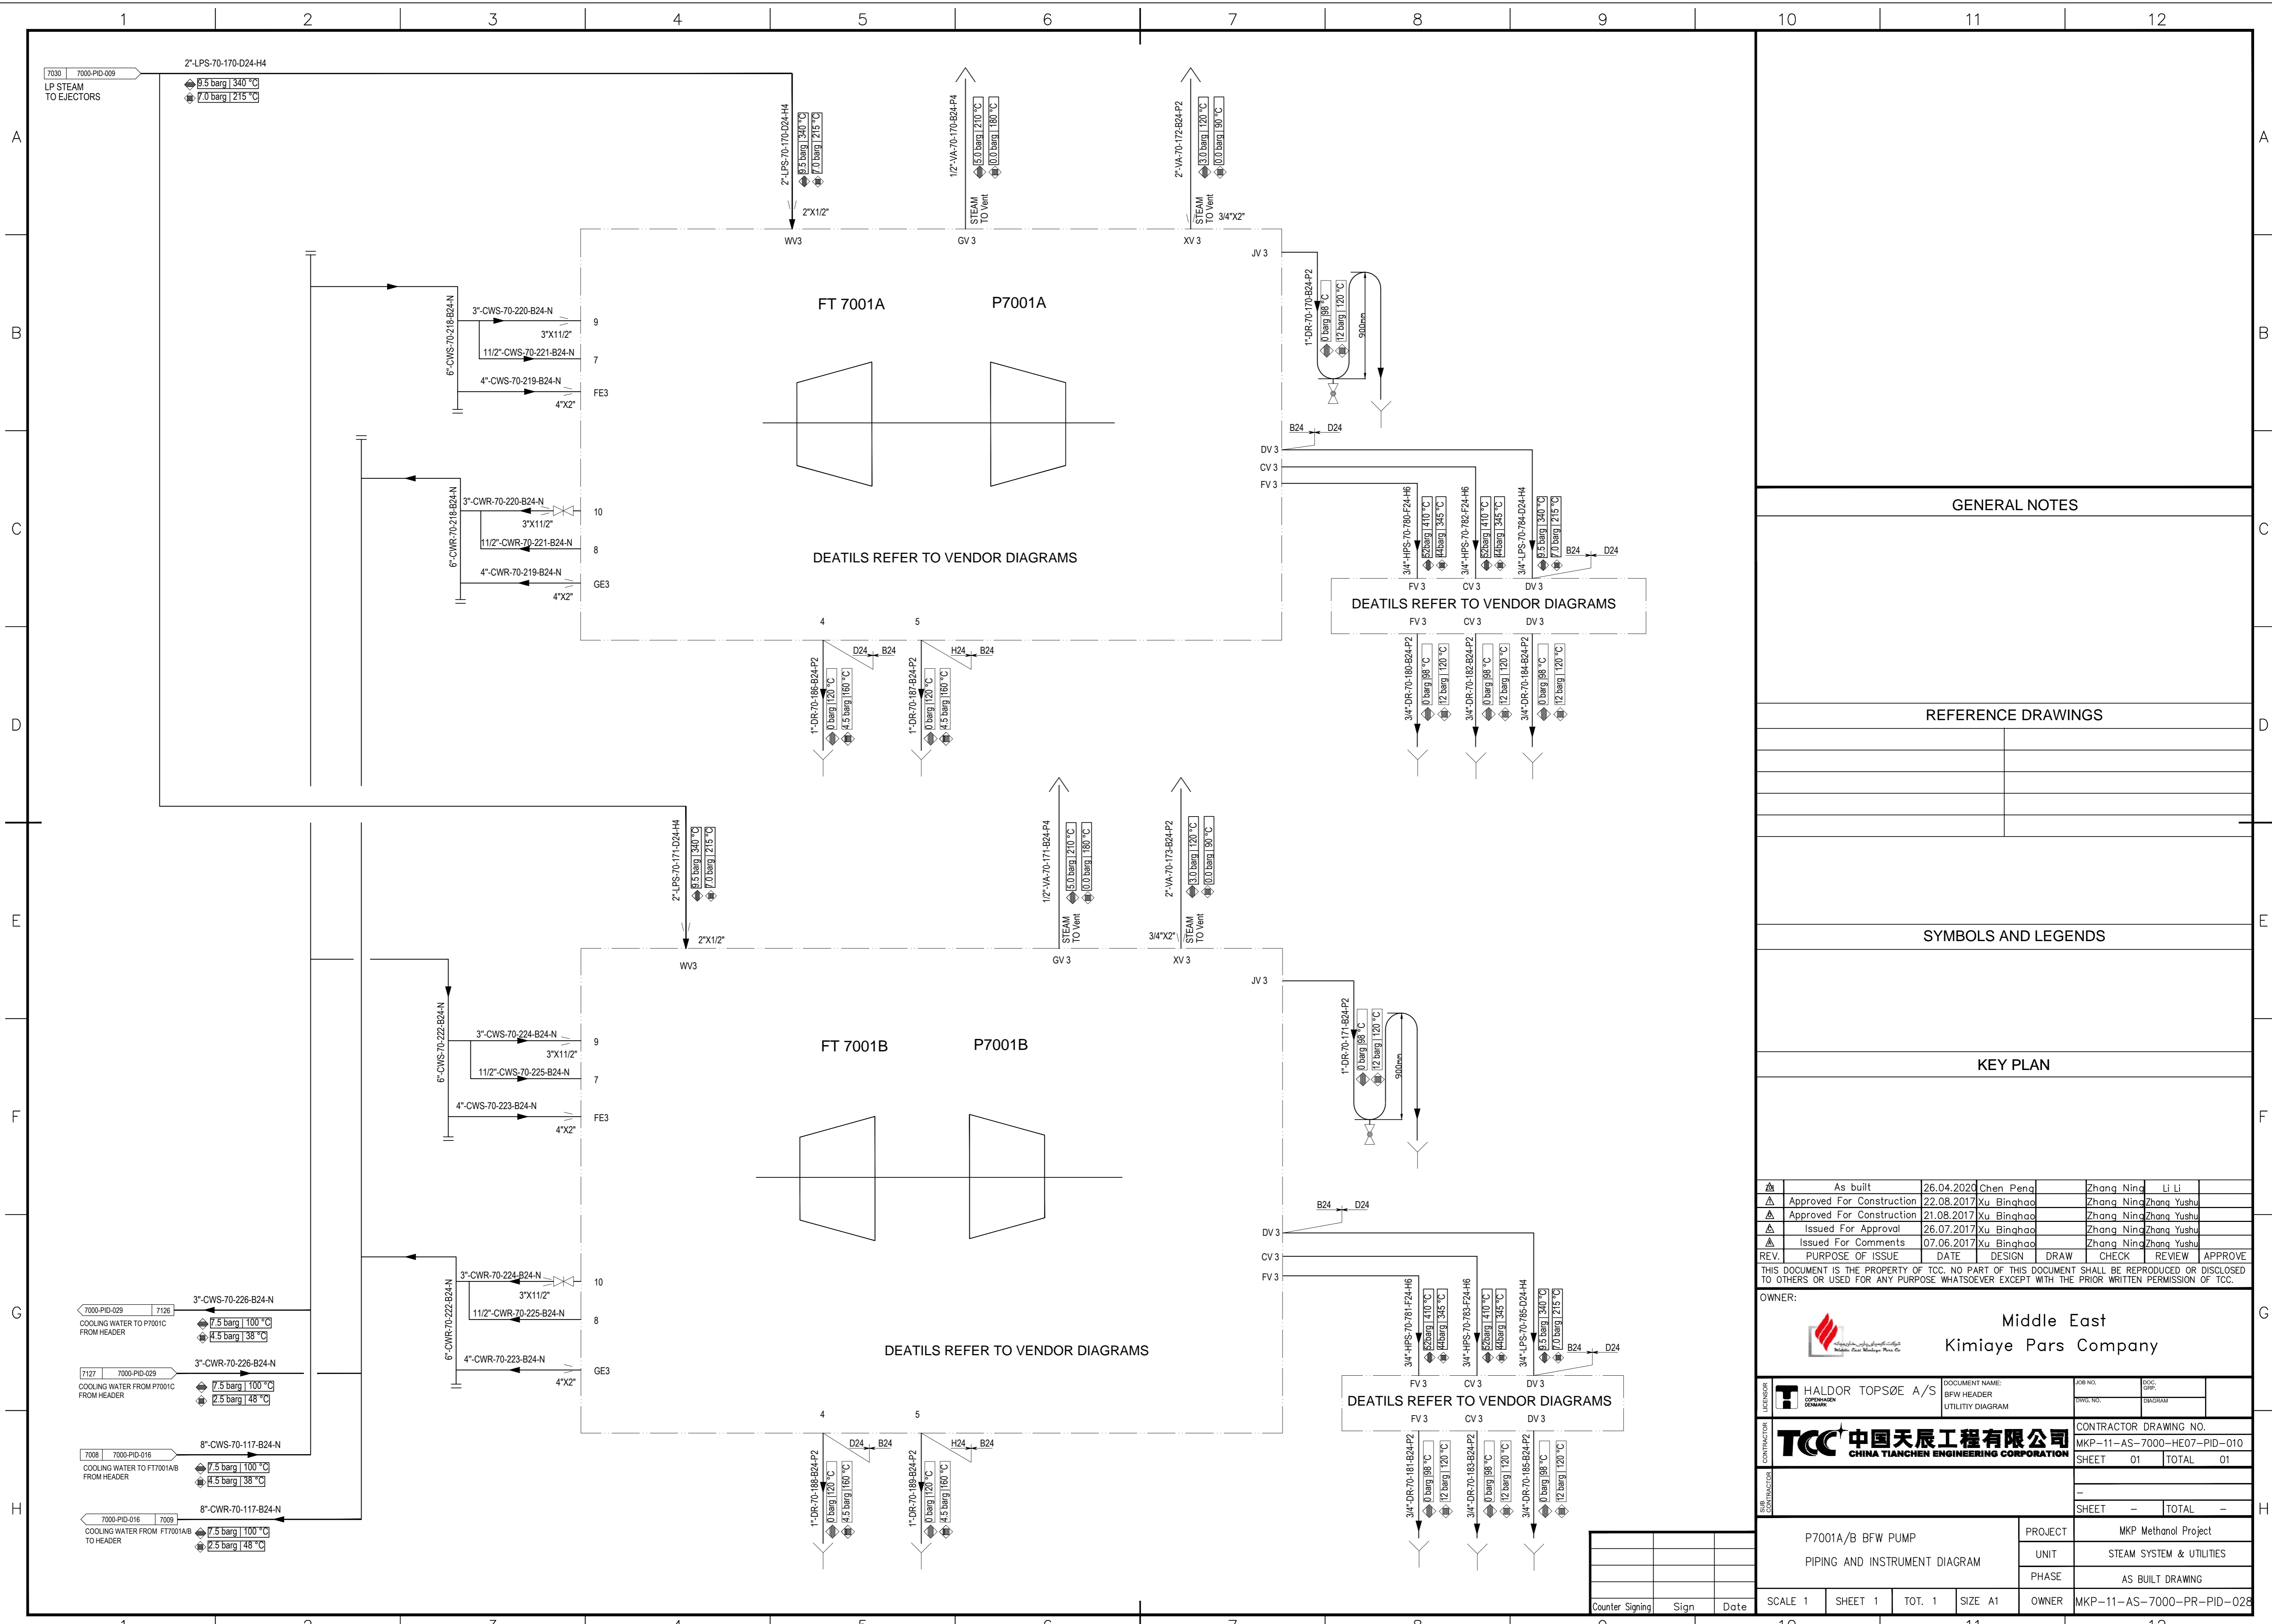

GENERAL NOTES

REFERENCE DRAWINGS

SYMBOLS AND LEGENDS

KEY PLAN

As built	26.04.2020	Chen Peng	Zhang Ning	Li Li			
Approved For Construction	22.08.2017	Xu Binghao	Zhang Ning	Zhang Yushu			
Approved For Construction	21.08.2017	Xu Binghao	Zhang Ning	Zhang Yushu			
Issued For Approval	26.07.2017	Xu Binghao	Zhang Ning	Zhang Yushu			
Issued For Comments	07.06.2017	Xu Binghao	Zhang Ning	Zhang Yushu			
REV.	PURPOSE OF ISSUE	DATE	DESIGN	DRAW	CHECK	REVIEW	APPROVE

THIS DOCUMENT IS THE PROPERTY OF TCC. NO PART OF THIS DOCUMENT SHALL BE REPRODUCED OR DISCLOSED TO OTHERS OR USED FOR ANY PURPOSE WHATSOEVER EXCEPT WITH THE PRIOR WRITTEN PERMISSION OF TCC.



OWNER: Middle East Kimiaye Pars Company

LICENSOR	HALDOR TOPSØE A/S	DOCUMENT NAME:	BFW HEADER UTILITY DIAGRAM	JOB NO.	DOC. GRP.
	CONTRACTOR	TCC 中国天辰工程有限公司 CHINA TIANCHEN ENGINEERING CORPORATION	CONTRACTOR DRAWING NO.	MKP-11-AS-7000-HE07-PID-010	SHEET 01 TOTAL 01

PROJECT	MKP Methanol Project
UNIT	STEAM SYSTEM & UTILITIES
PHASE	AS BUILT DRAWING
OWNER	MKP-11-AS-7000-PR-PID-028


SCALE	1	SHEET	1	TOT.	1	SIZE	A1
Counter Signing	Sign	Date					



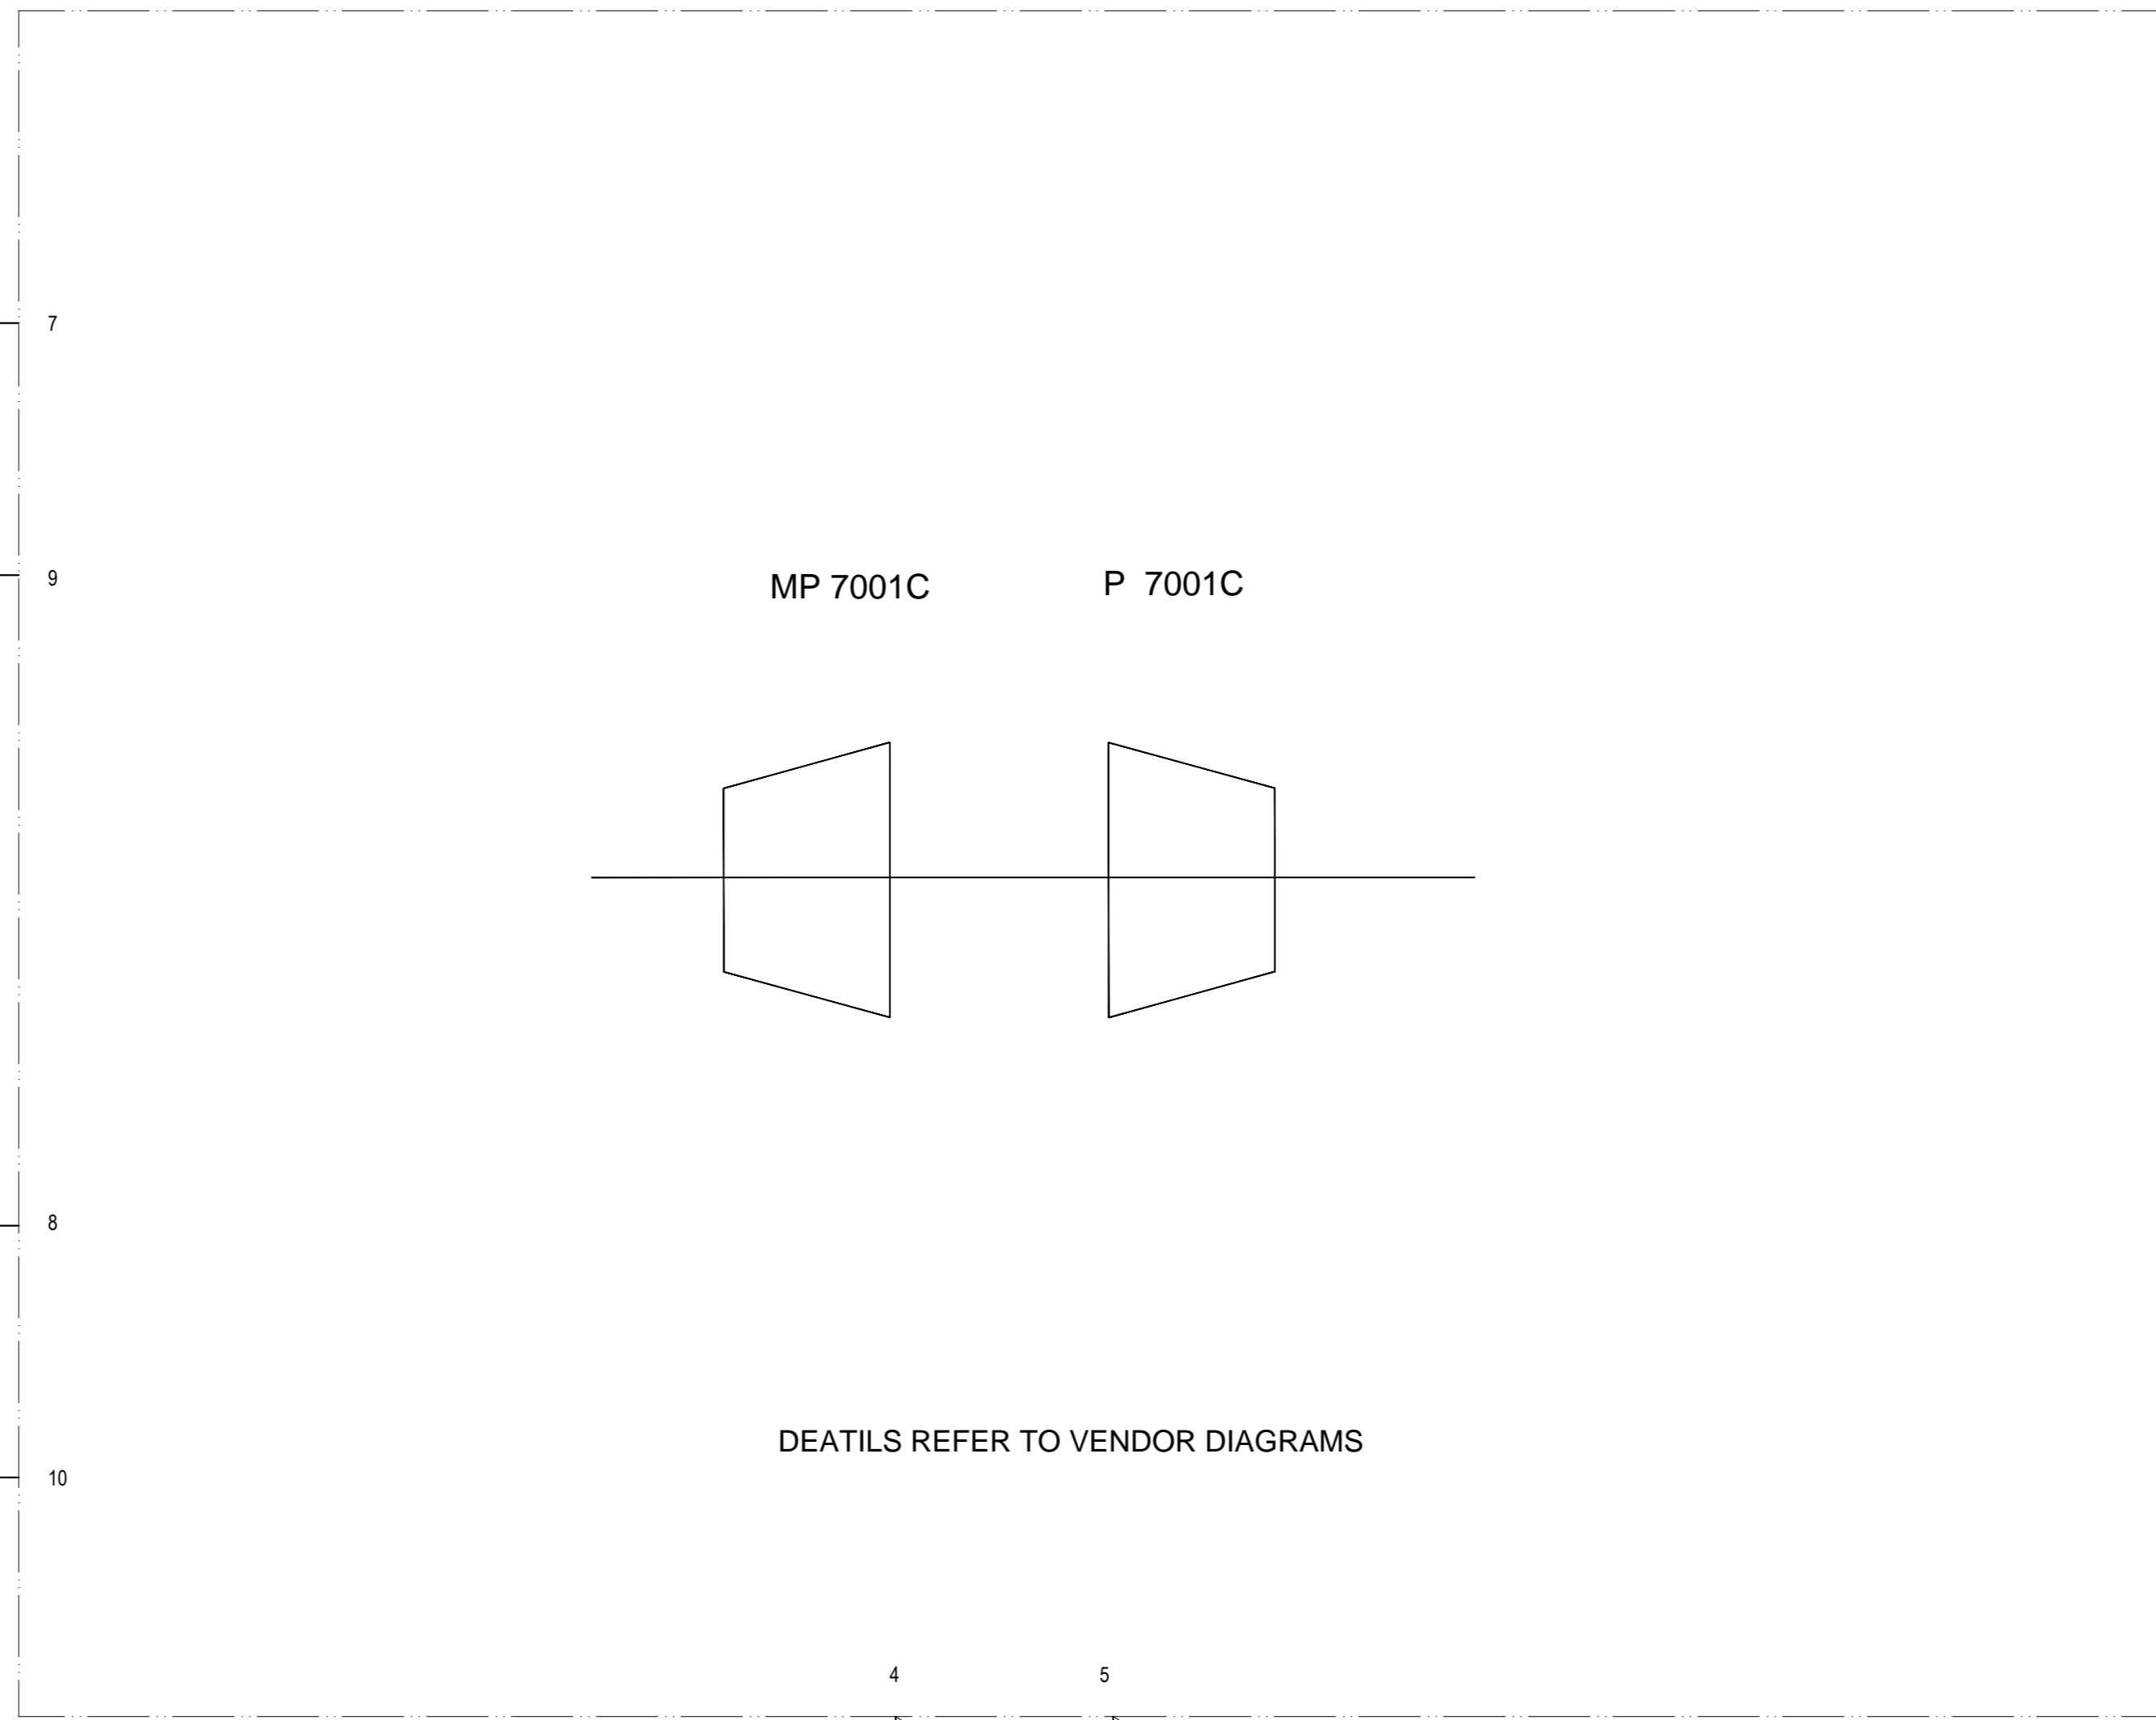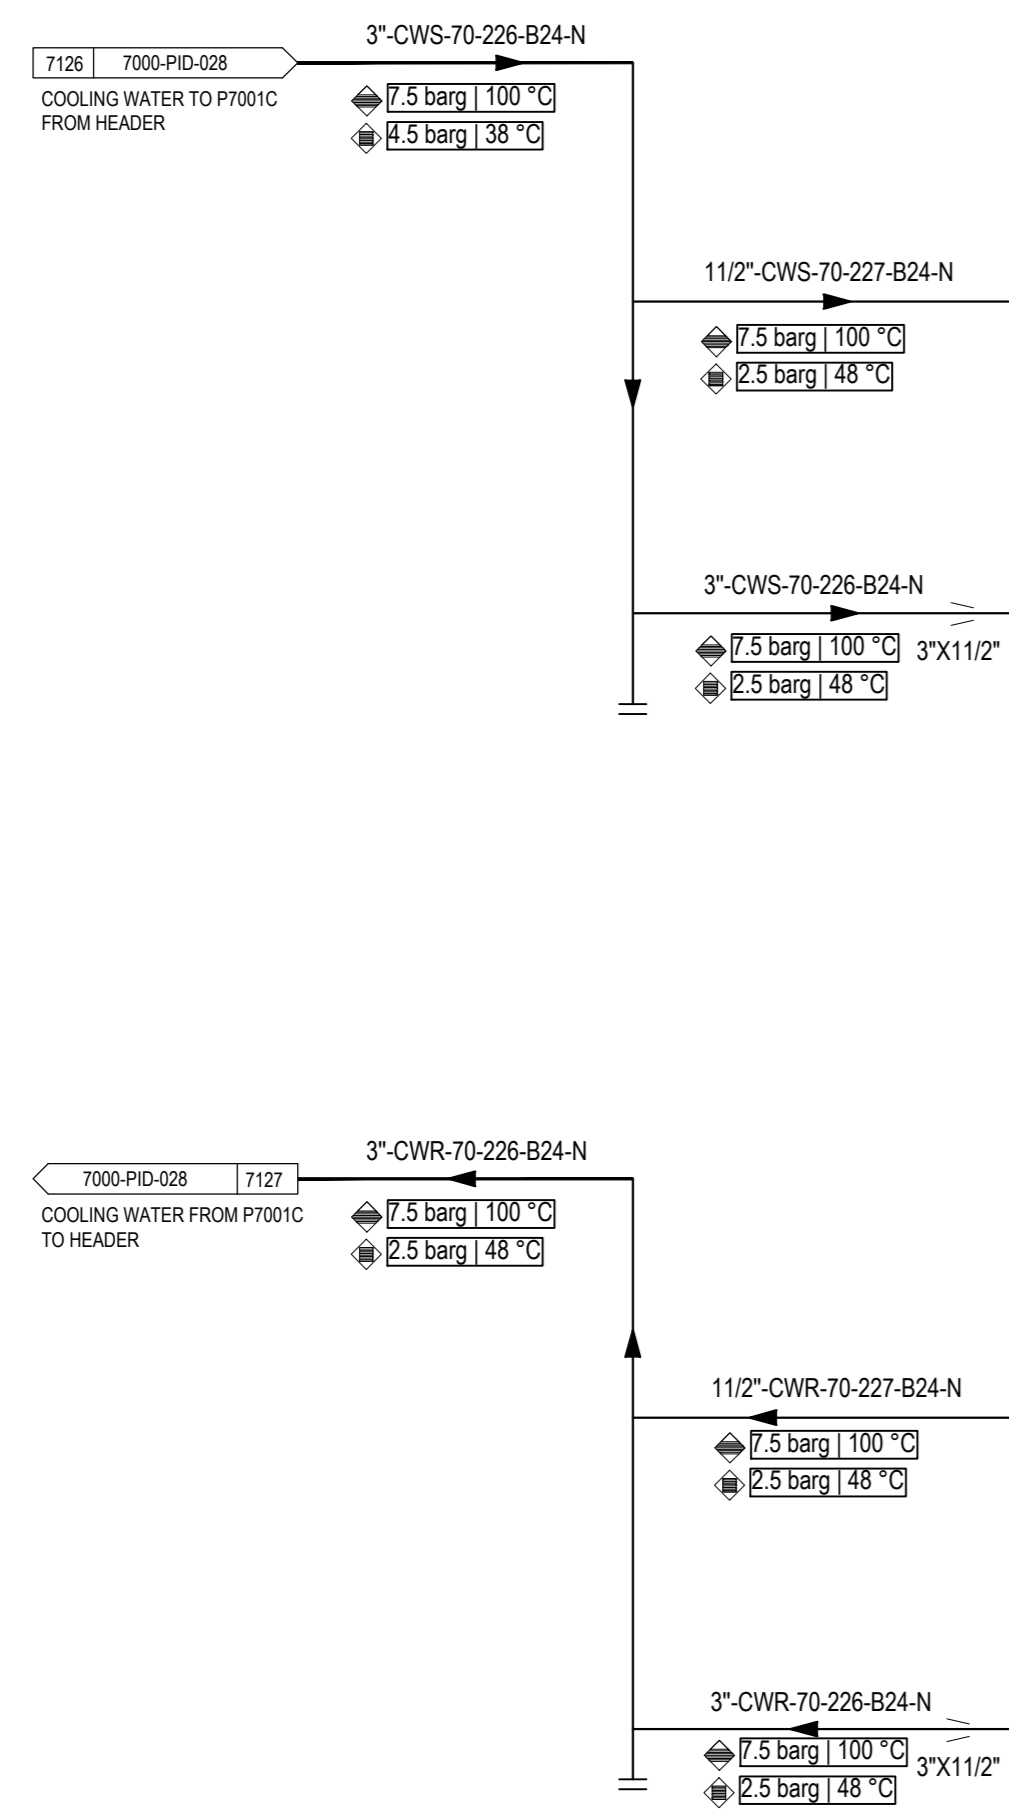

MP 7001C P 7001C

DEATILS REFER TO VENDOR DIAGRAMS

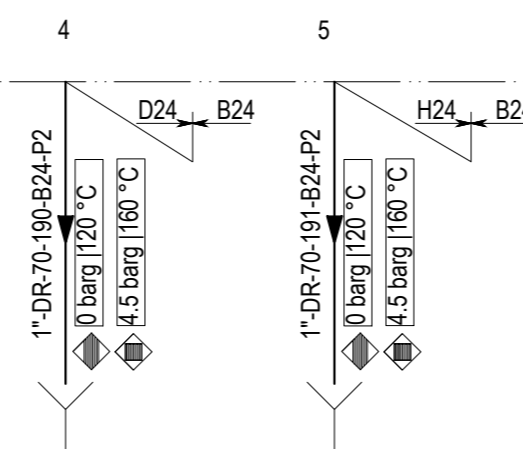

GENERAL NOTES

REFERENCE DRAWINGS

SYMBOLS AND LEGENDS

KEY PLAN

As built	26.04.2020	Chen Peng	Zhang Ning	Li Li			
Approved For Construction	22.08.2017	Xu Binghao	Zhang Ning	Zhang Yushu			
Approved For Construction	21.08.2017	Xu Binghao	Zhang Ning	Zhang Yushu			
Issued For Approval	26.07.2017	Xu Binghao	Zhang Ning	Zhang Yushu			
Issued For Comments	07.06.2017	Xu Binghao	Zhang Ning	Zhang Yushu			
REV.	PURPOSE OF ISSUE	DATE	DESIGN	DRAW	CHECK	REVIEW	APPROVE

THIS DOCUMENT IS THE PROPERTY OF TCC. NO PART OF THIS DOCUMENT SHALL BE REPRODUCED OR DISCLOSED TO OTHERS OR USED FOR ANY PURPOSE WHATSOEVER EXCEPT WITH THE PRIOR WRITTEN PERMISSION OF TCC.

OWNER: Middle East  
Kimiaye Pars Company


HALDOR TOPSØE A/S  
DOCUMENT NAME: BFW HEADER UTILITY DIAGRAM  
JOB NO.:  
DOC. NO.:  
CONTRACTOR DRAWING NO.

TCC 中国天辰工程有限公司  
CHINA TIANCHEN ENGINEERING CORPORATION  
MKP-11-AS-7000-HE07-PID-010  
SHEET 01 TOTAL 01

P7001C BFW PUMP  
PROJECT: MKP Methanol Project  
UNIT: STEAM SYSTEM & UTILITIES  
PHASE: AS BUILT DRAWING  
OWNER: MKP-11-AS-7000-PR-PID-029

Counter Signing	Sign	Date

SCALE 1	SHEET 1	TOT. 1	SIZE A1
10	11	12	

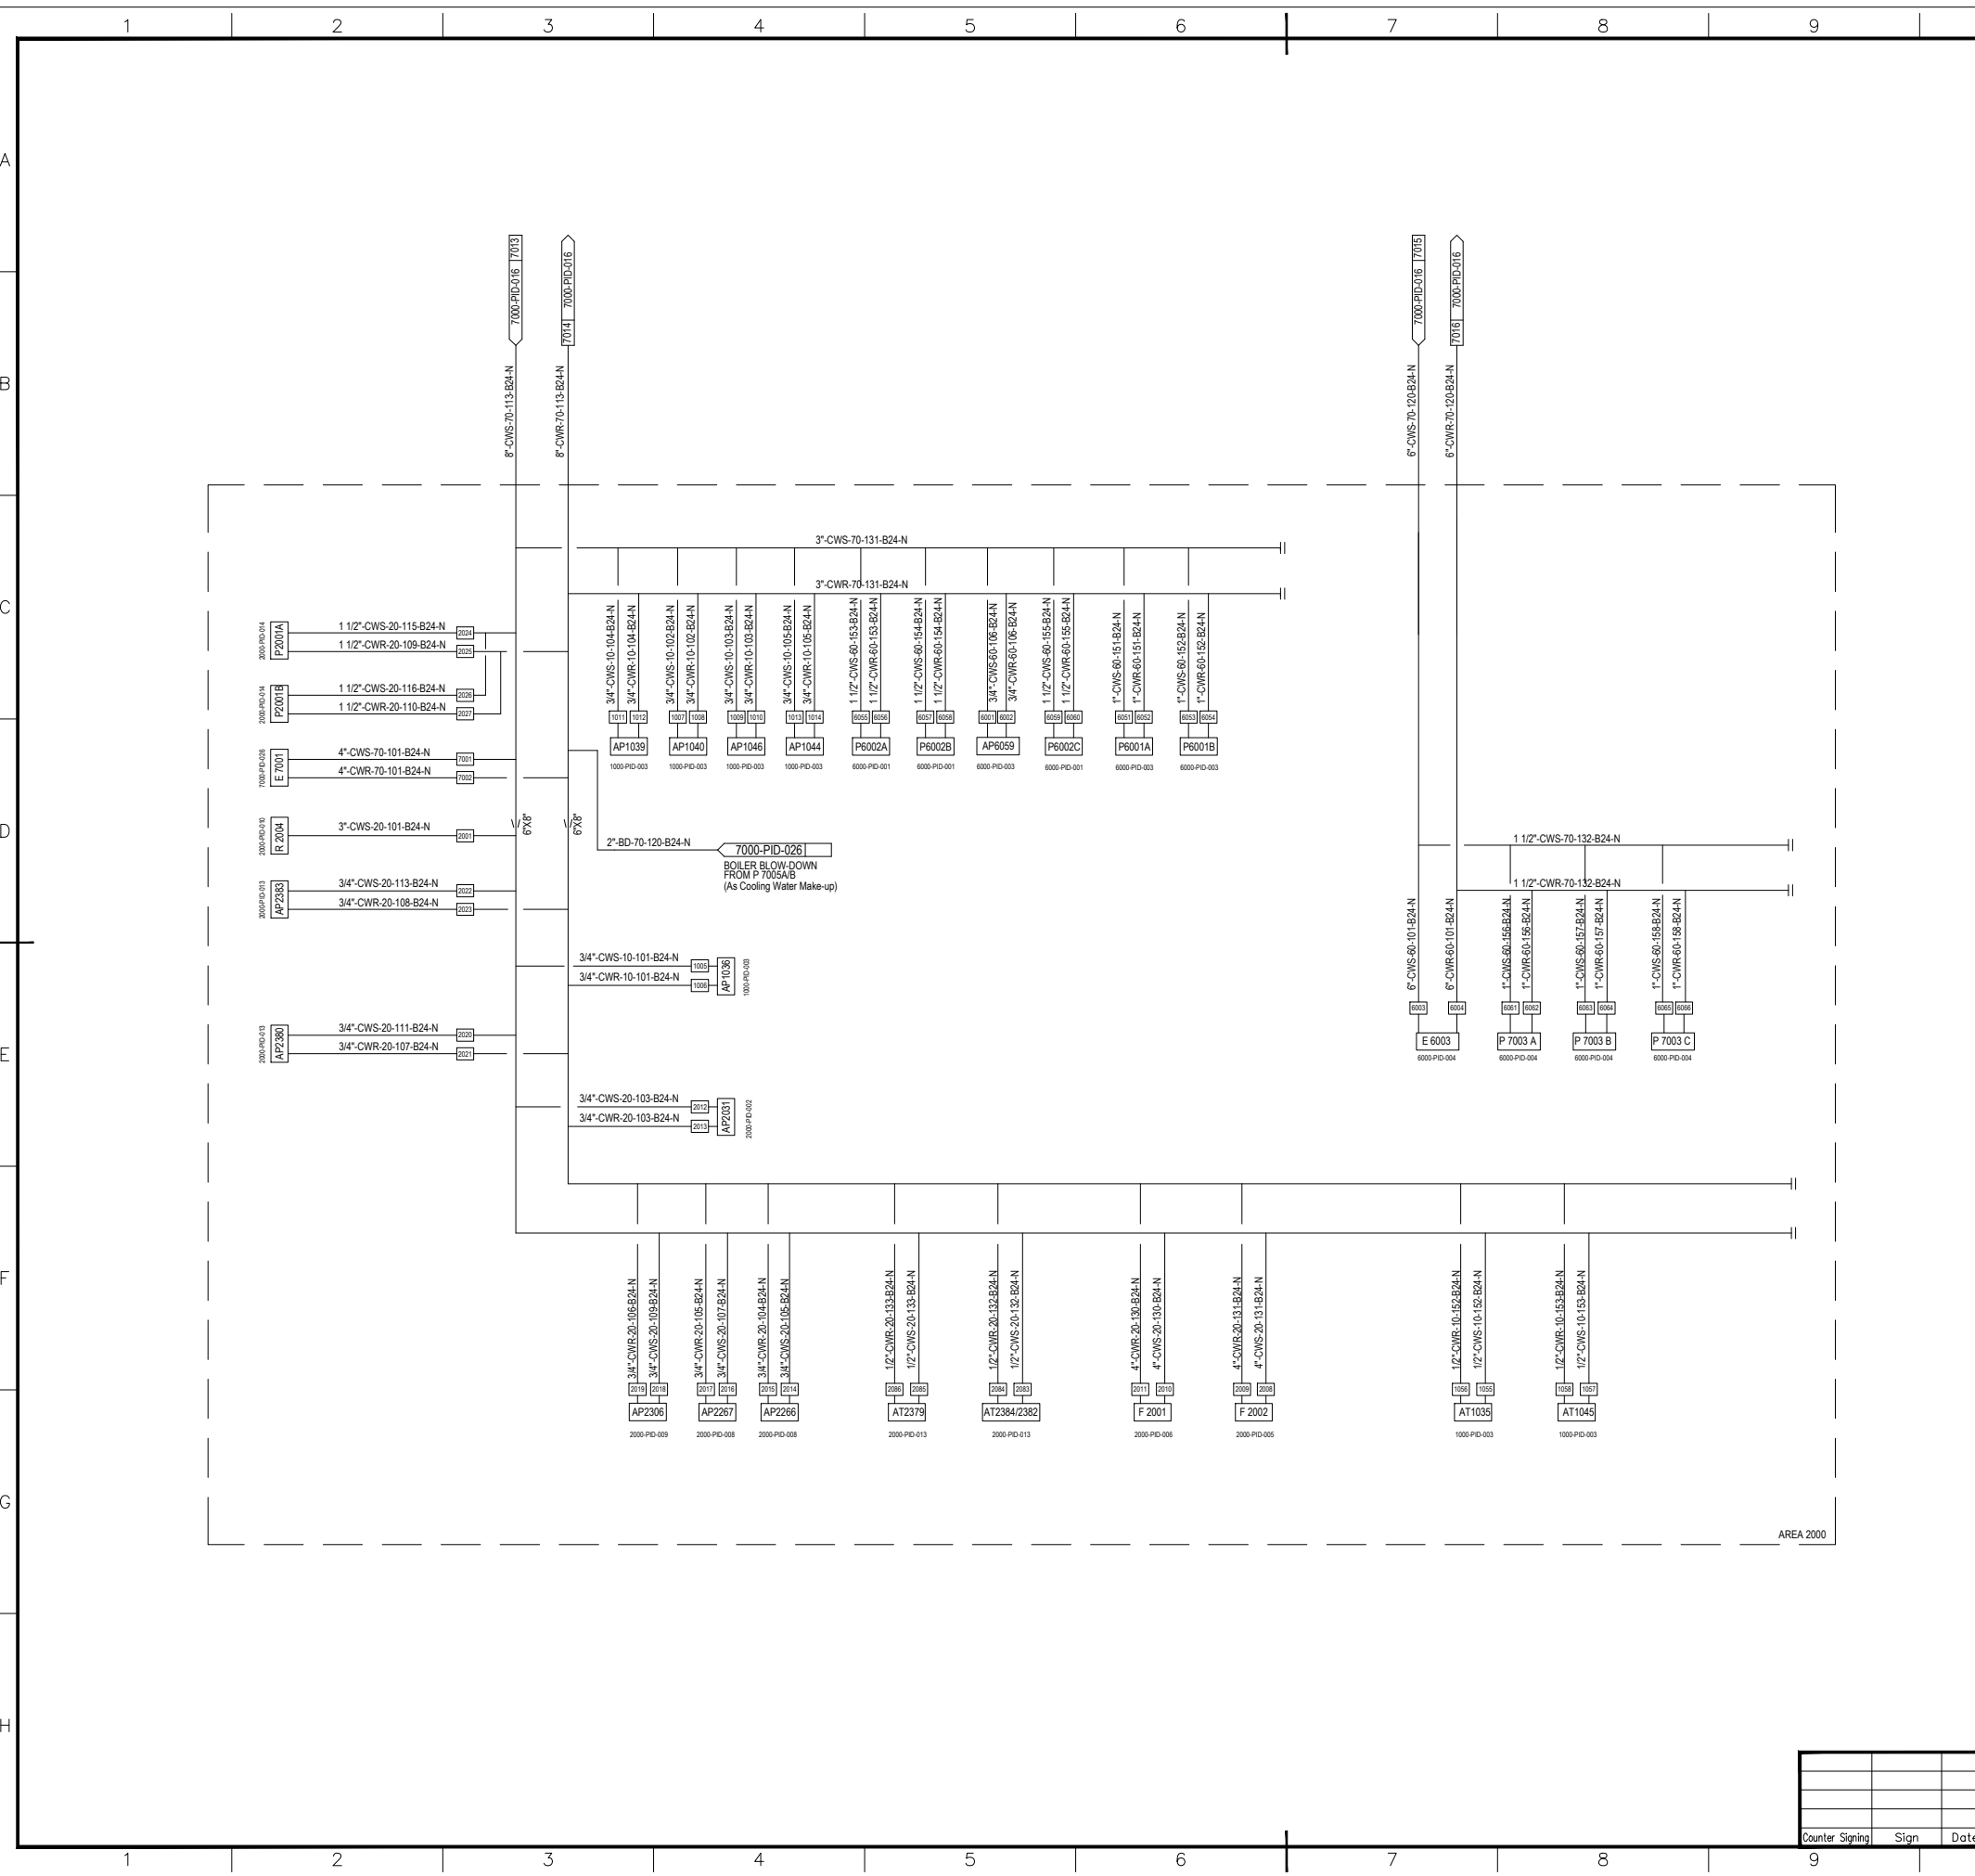

**GENERAL NOTES**

†GENERAL NOTE:  
LOW POINT DRAINS AND HIGH POINT VENT MUST BE ADDED DURING DETAILED ENGINEERING.

**REFERENCE DRAWINGS**


**SYMBOLS AND LEGENDS**

**KEY PLAN**



REV.	PURPOSE OF ISSUE	DATE	DESIGN	DRAW	CHECK	REVIEW	APPROVE
▲	As Built	30.04.2020	Jiang Yu		Xu Hong	Liu Shengkol	
▲	Approved for Construction	13.08.2018	Jiang Yu		Xu Hong	Liu Shengkol	
▲	Approved for Construction	06.11.2017	Chen Tao		Xu Hong	Liu Shengkol	
▲	Approved for Construction	16.07.2017	Chen Tao		Xu Hong	Shi Jing	
▲	Issued for Review	04.05.2017	Chen Tao		Xu Hong	Shi Jing	
▲	Issued for Comments	12.04.2017	Chen Tao		Xu Hong	Shi Jing	

THIS DOCUMENT IS THE PROPERTY OF TCC. NO PART OF THIS DOCUMENT SHALL BE REPRODUCED OR DISCLOSED TO OTHERS OR USED FOR ANY PURPOSE WHATSOEVER EXCEPT WITH THE PRIOR WRITTEN PERMISSION OF TCC.


OWNER:



Middle East  
Kimiaye Pars Company

 HALDOR TOPSØE A/S CONTRACTOR	DOCUMENT NAME	JOB NO.	SCALE	REV.
	 TCC 中国天辰工程有限公司 CHINA TIANCHEN ENGINEERING CORPORATION SUB-CONTRACTOR LOGO	CONTRACTOR DRAWING NO.		
		MKP-11-AS-7000-PS09-PID-030		
		SHEET 01	TOTAL 01	
		SUB-CONTRACTOR DRAWING NO.		
		SHEET --	TOTAL --	

PROJECT MKP Methanol Project UNIT Steam System & Utilities PHASE As Built Drawing OWNER DWG NO.	SCALE: --	SHEET: 01	TOT.: 01	SIZE: A1
	Counter Signing Sign Date			

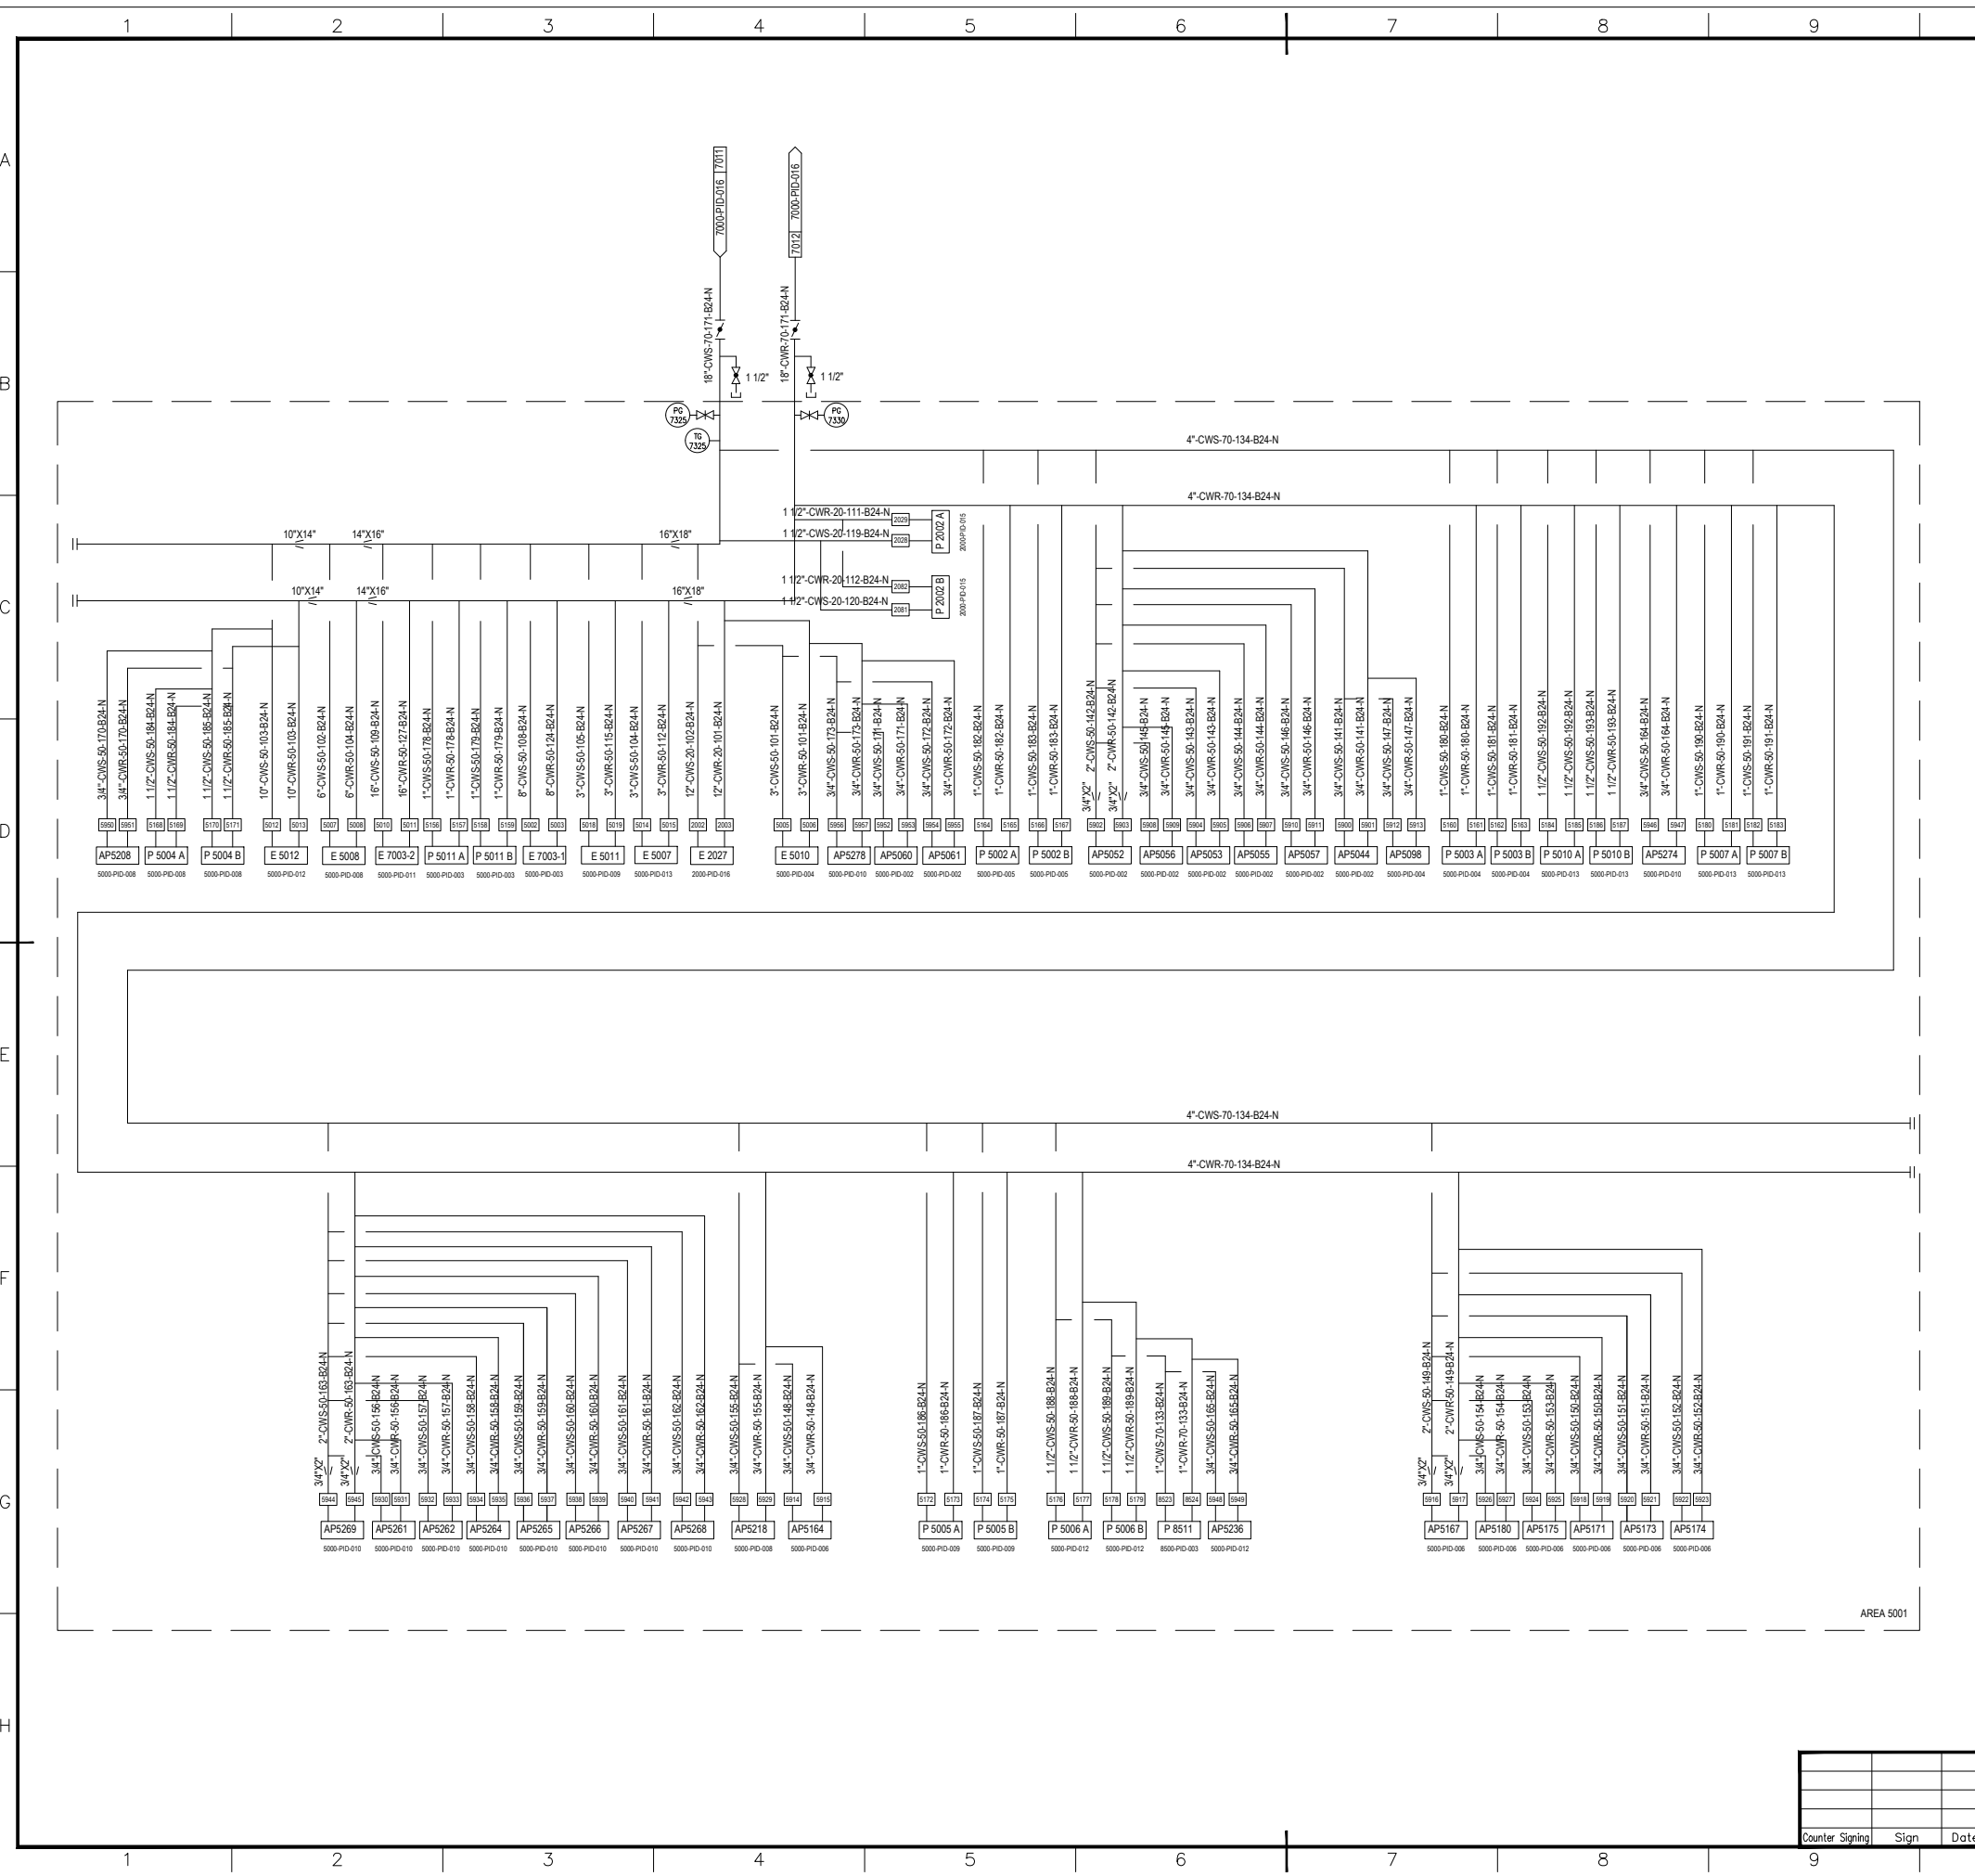

**GENERAL NOTES**


GENERAL NOTE:  
LOW POINT DRAINS AND HIGH POINT VENT MUST BE ADDED DURING DETAILED ENGINEERING.



**REFERENCE DRAWINGS**

**SYMBOLS AND LEGENDS**

**KEY PLAN**

REV.	PURPOSE OF ISSUE	DATE	DESIGN	DRAW	CHECK	REVIEW	APPROVE
▲	As Built	30.04.2020	Chen Tao	Xu Hong	Shi Jing		
▲	Approved for Construction	24.07.2017	Chen Tao	Xu Hong	Shi Jing		
▲	Issued for Approval	16.07.2017	Chen Tao	Xu Hong	Shi Jing		
▲	Issued for Review	04.05.2017	Chen Tao	Xu Hong	Shi Jing		
▲	Issued for Comments	12.04.2017	Chen Tao	Xu Hong	Shi Jing		


OWNER:  
 Middle East Kimiaye Pars Company

 HALDOR TOPSØE A/S  <b>TCC</b> 中国天辰工程有限公司 CHINA TIANCHEN ENGINEERING CORPORATION	DOCUMENT NAME	JOB NO.	DATE	REV.
	CONTRACTOR DRAWING NO. MKP-11-AS-7000-PS09-PID-031			
SUB-CONTRACTOR LOGO		SHEET 01 TOTAL 01		
		SHEET -- TOTAL --		

COOLING WATER HEADER III UTILITY DIAGRAM	PROJECT	MKP Methanol Project
	UNIT	Steam System & Utilities
	PHASE	As Built Drawing
SCALE: --	OWNER DWG NO.	MKP-11-AS-7000-PR-PID-031

Counter Signing	Sign	Date

AREA 5001

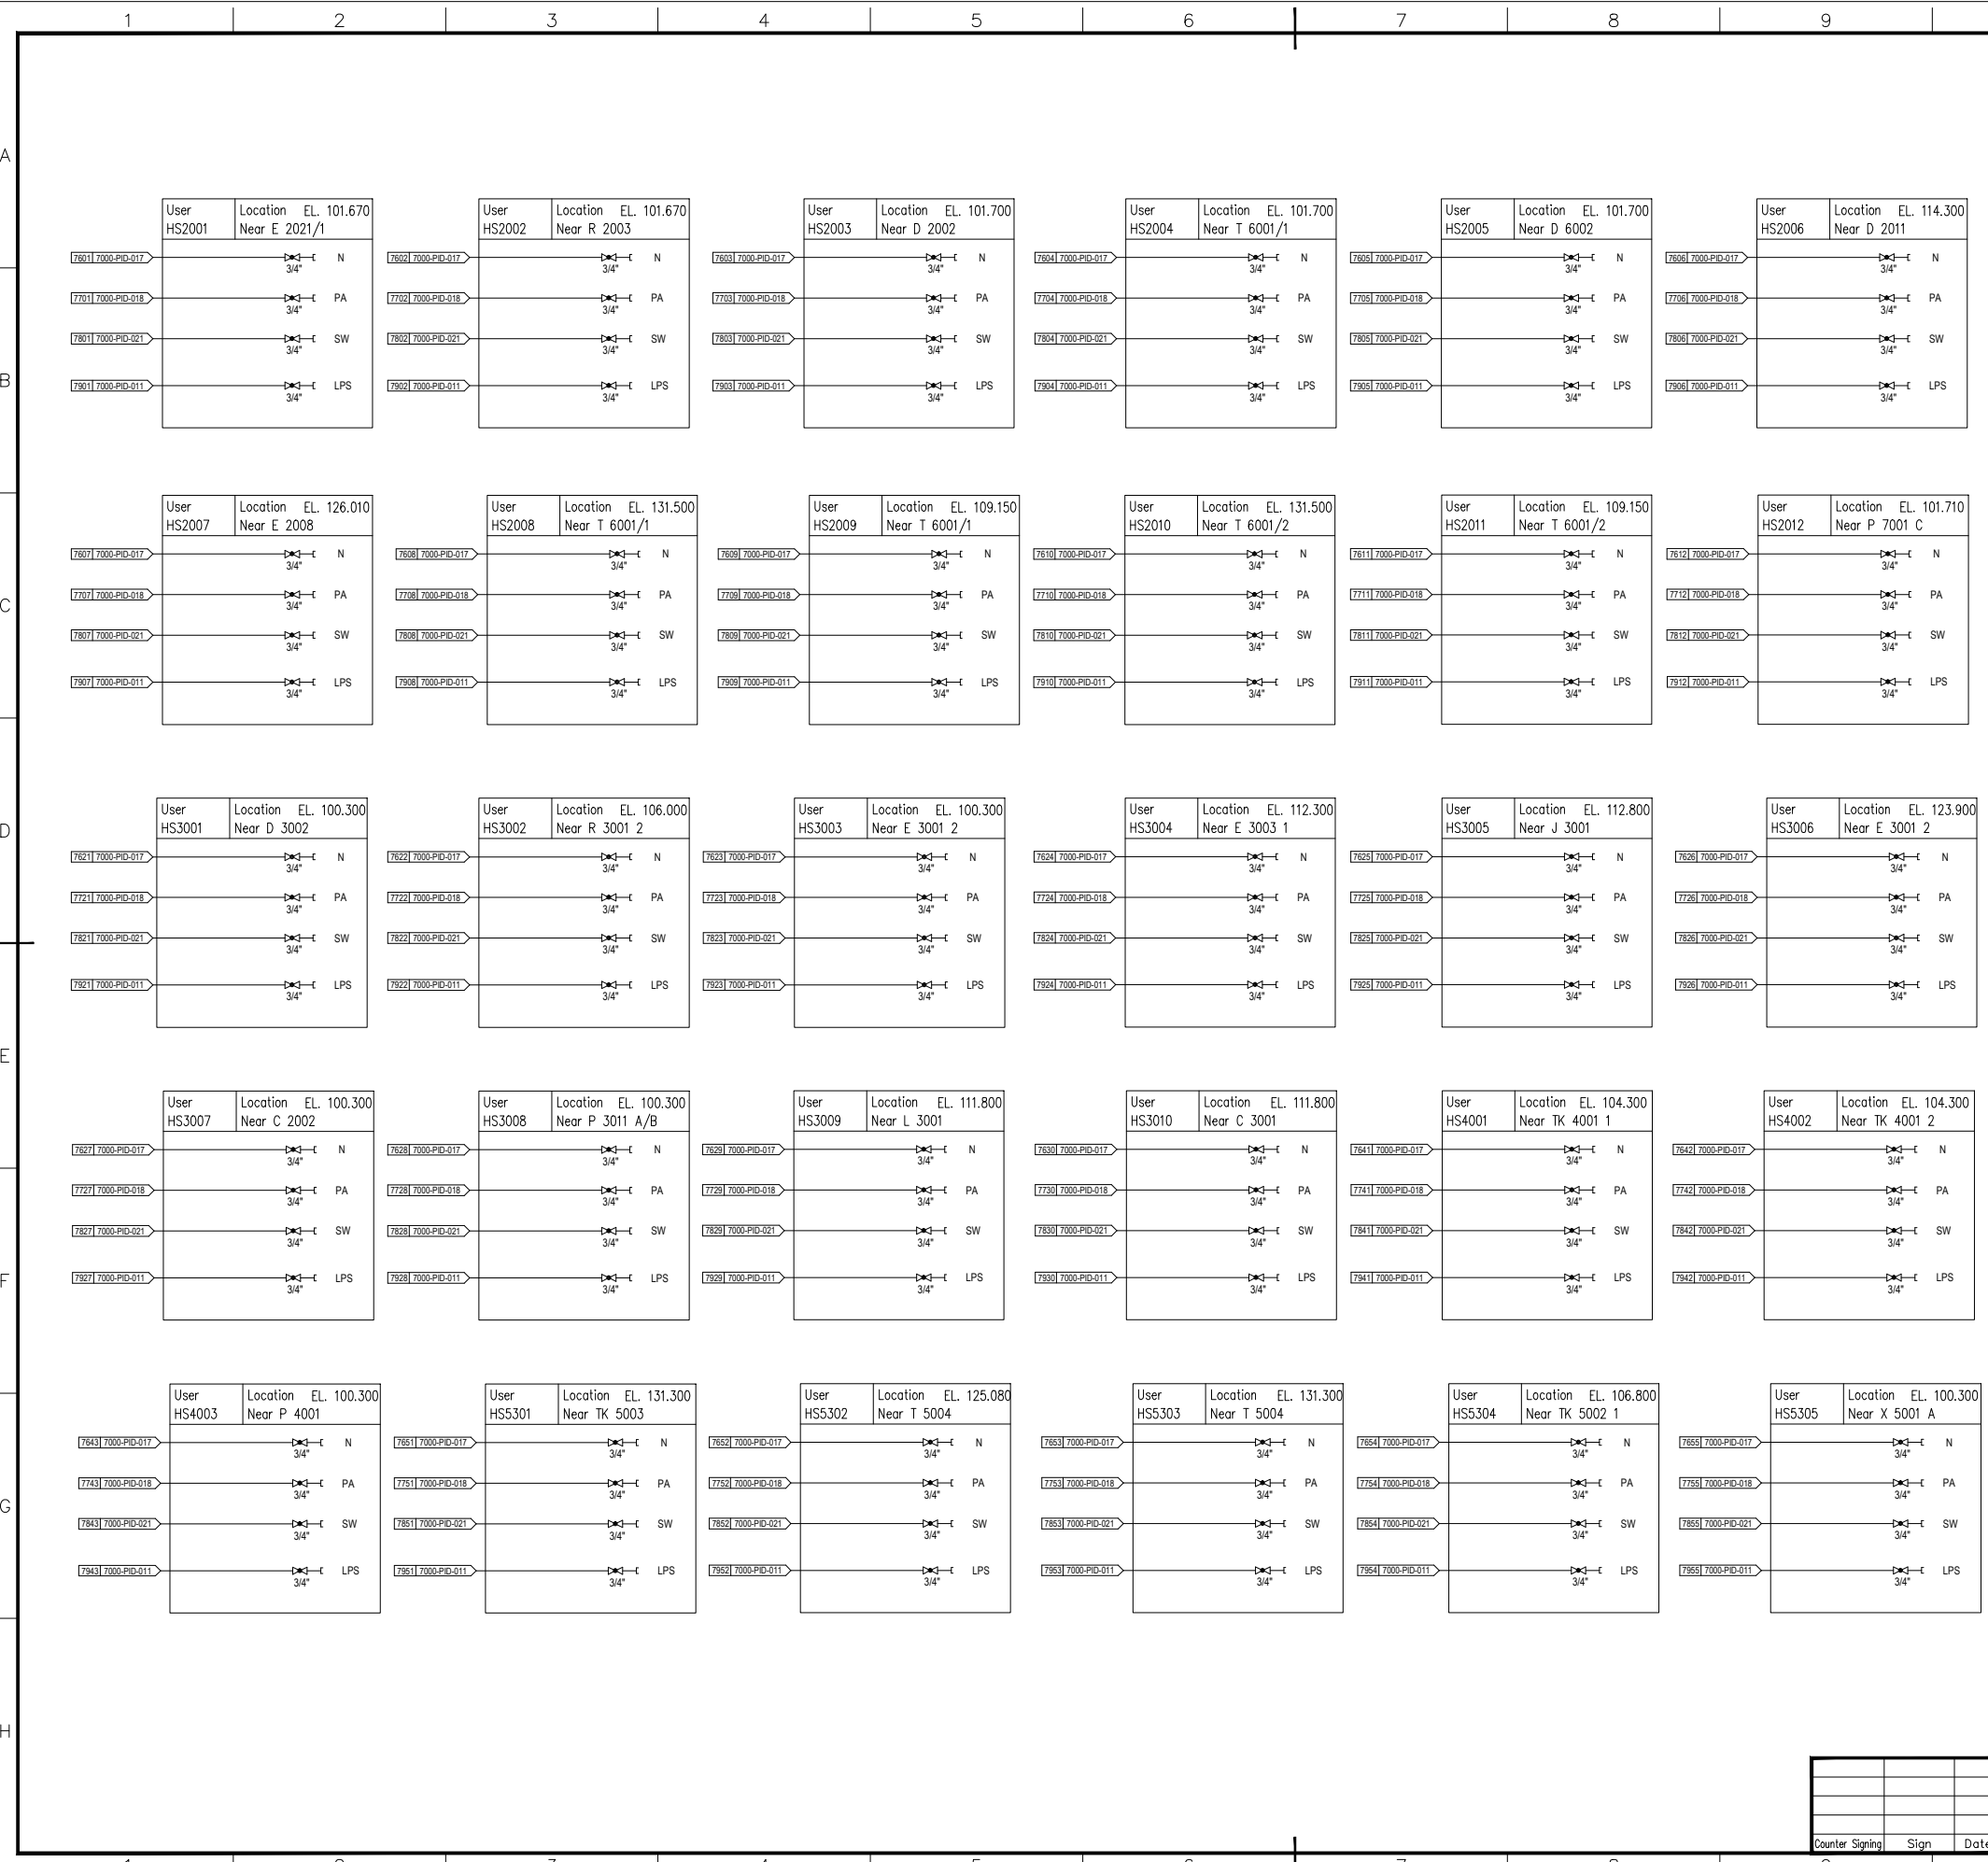

**GENERAL NOTES**

\*GENERAL NOTE:  
LOW POINT DRAINS AND HIGH POINT VENT MUST BE ADDED DURING DETAILED ENGINEERING.

**REFERENCE DRAWINGS**



**SYMBOLS AND LEGENDS**


**KEY PLAN**


▲	As Built	30.04.2020	Chen Tao		Xu Hang	Liu Shengkol	
▲	Approved for Construction	06.11.2017	Chen Tao		Xu Hang	Liu Shengkol	
▲	Approved for Construction	24.07.2017	Chen Tao		Xu Hang	Shi Jing	
▲	Issued for Approval	16.07.2017	Chen Tao		Xu Hang	Shi Jing	
▲	Issued for Review	04.05.2017	Chen Tao		Xu Hang	Shi Jing	
▲	Issued for Comments	12.04.2017	Chen Tao		Xu Hang	Shi Jing	
REV.	PURPOSE OF ISSUE	DATE	DESIGN	DRAW	CHECK	REVIEW	APPROVE

THIS DOCUMENT IS THE PROPERTY OF TCC. NO PART OF THIS DOCUMENT SHALL BE REPRODUCED OR DISCLOSED TO OTHERS OR USED FOR ANY PURPOSE WHATSOEVER EXCEPT WITH THE PRIOR WRITTEN PERMISSION OF TCC.


OWNER:



Middle East  
Kimiaye Pars Company



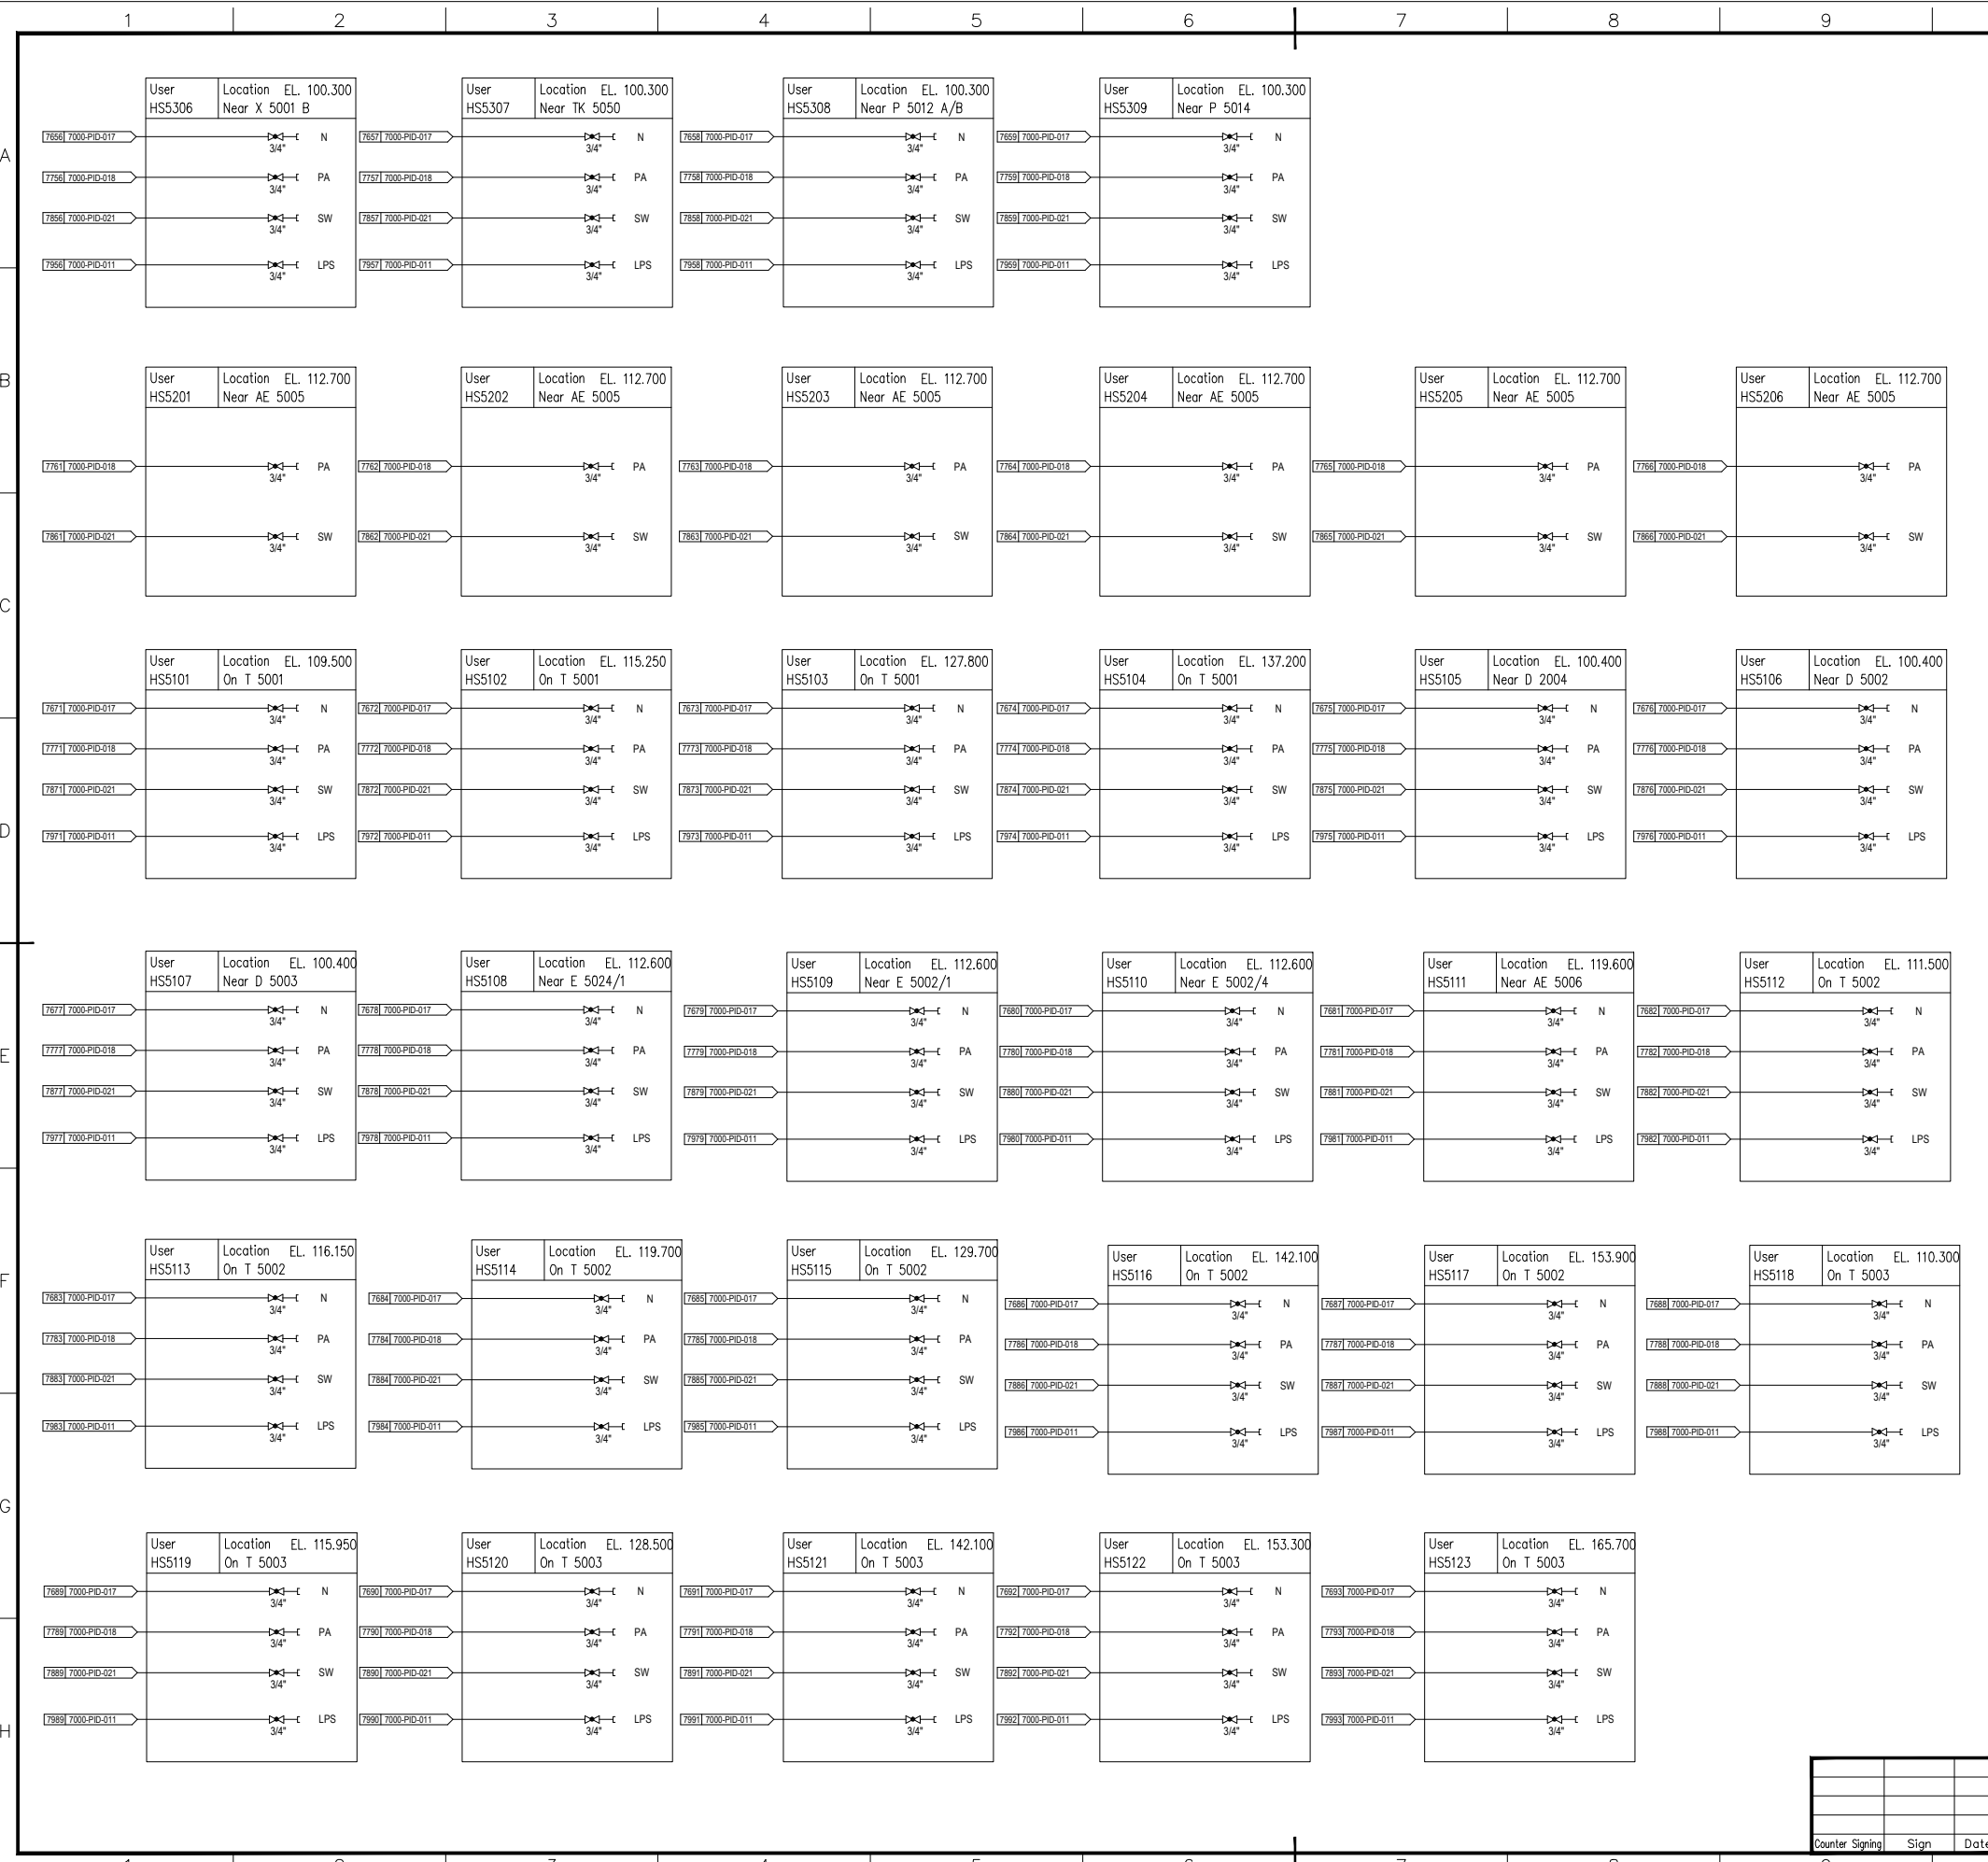

**GENERAL NOTES**

\*GENERAL NOTE:  
LOW POINT DRAINS AND HIGH POINT VENT MUST BE ADDED DURING DETAILED ENGINEERING.


**REFERENCE DRAWINGS**



**SYMBOLS AND LEGENDS**

**KEY PLAN**

REV.	PURPOSE OF ISSUE	DATE	DESIGN	DRAW	CHECK	REVIEW	APPROVE
▲	As Built	30.04.2020	Chen Tao		Xu Hang	Shi Jing	
▲	Approved for Construction	24.07.2017	Chen Tao		Xu Hang	Shi Jing	
▲	Issued for Approval	16.07.2017	Chen Tao		Xu Hang	Shi Jing	
▲	Issued for Review	04.05.2017	Chen Tao		Xu Hang	Shi Jing	
▲	Issued for Comments	12.04.2017	Chen Tao		Xu Hang	Shi Jing	

THIS DOCUMENT IS THE PROPERTY OF TCC. NO PART OF THIS DOCUMENT SHALL BE REPRODUCED OR DISCLOSED TO OTHERS OR USED FOR ANY PURPOSE WHATSOEVER EXCEPT WITH THE PRIOR WRITTEN PERMISSION OF TCC.

OWNER:  Middle East Kimiaye Pars Company

 HALDOR TOPSØE A/S CONTRACTOR	DOCUMENT NAME: HOSE STATION SYSTEM II UTILITY DIAGRAM	JOB NO.: SHEET NO.:	DATE: SHEET TOTAL:	REV.
 TCC 中国天辰工程有限公司 CHINA TIANCHEN ENGINEERING CORPORATION			CONTRACTOR DRAWING NO. MKP-11-AS-7000-PS09-PID-033	
SUB-CONTRACTOR LOGO			SHEET 01 TOTAL 01	
HOSE STATION SYSTEM II UTILITY DIAGRAM			PROJECT: MKP Methanol Project UNIT: Steam System & Utilities PHASE: As Built Drawing OWNER DWG NO.: MKP-11-AS-7000-PR-PID-033	

Counter	Sign	Date

NO	PIP Numbers	Medium	From/To	SPEC NO.
1	1400-PR-PIE-002	POC	3"POC-80-102-C1A-N	9407
2	3000-PR-PIE-002	Continuous Blow-Down	2"CB-80-101-F24H4	288
3	3000-PR-PIE-006	Off Gas	2"FG-30-101-B24N	338
4	3000-PR-PIE-007	Off Gas	8"FG-80-101-B40N	3047
5	3000-PR-PIE-002	Phosphate Solution	110"PH-30-102-F40N	272
6	3000-PR-PIE-006	Off Gas	8"FG-30-101-B24N	204
7	3000-PR-PIE-002	MPS-Condensate	10"APC-30-101-F24H4	286
8	3000-PR-PIE-007	Crude Methanol	14"MAC-30-101-B40N	192

NO	PIP Numbers	Medium	From/To	SPEC NO.
1	1400-PR-PIE-002	POC	3"POC-80-102-C1A-N	9407

NO	PIP Numbers	Medium	From/To	SPEC NO.
1	1400-PR-PIE-002	POC	3"POC-80-102-C1A-N	9407
2	7000-PR-PIE-007	Phosphate Solution	110"PH-30-102-F40N	272
3	7000-PR-PIE-008	Off Gas	2"FG-30-101-B24N	338
4	7000-PR-PIE-009	Off Gas	2"FG-30-101-B24N	338
5	7000-PR-PIE-010	Off Gas	2"FG-30-101-B24N	338
6	7000-PR-PIE-011	Off Gas	2"FG-30-101-B24N	338
7	7000-PR-PIE-012	Off Gas	2"FG-30-101-B24N	338
8	7000-PR-PIE-013	Off Gas	2"FG-30-101-B24N	338
9	7000-PR-PIE-014	Off Gas	2"FG-30-101-B24N	338
10	7000-PR-PIE-015	Off Gas	2"FG-30-101-B24N	338
11	7000-PR-PIE-016	Off Gas	2"FG-30-101-B24N	338
12	7000-PR-PIE-017	Off Gas	2"FG-30-101-B24N	338
13	7000-PR-PIE-018	Off Gas	2"FG-30-101-B24N	338
14	7000-PR-PIE-019	Off Gas	2"FG-30-101-B24N	338
15	7000-PR-PIE-020	Off Gas	2"FG-30-101-B24N	338
16	7000-PR-PIE-021	Off Gas	2"FG-30-101-B24N	338
17	7000-PR-PIE-022	Off Gas	2"FG-30-101-B24N	338
18	7000-PR-PIE-023	Off Gas	2"FG-30-101-B24N	338
19	7000-PR-PIE-024	Off Gas	2"FG-30-101-B24N	338
20	7000-PR-PIE-025	Off Gas	2"FG-30-101-B24N	338



NO	PIP Numbers	Medium	From/To	SPEC NO.
1	1000-PR-PIE-001	Off Water	2"OW-10-101-B24N	104
2	1000-PR-PIE-002	Natural Gas	14"NG-80-101-F30N	9530

NO	PIP Numbers	Medium	From/To	SPEC NO.
1	6000-PR-PIE-001	MPS-Condensate	10"APC-30-101-F24H4	286
2	6000-PR-PIE-002	Process Condensate	4"PC-30-101-F24H4	286
3	6000-PR-PIE-003	Process Condensate	4"PC-30-101-F24H4	286
4	6000-PR-PIE-004	Process Condensate	4"PC-30-101-F24H4	286
5	6000-PR-PIE-005	Process Condensate	4"PC-30-101-F24H4	286
6	6000-PR-PIE-006	Process Condensate	4"PC-30-101-F24H4	286
7	6000-PR-PIE-007	Process Condensate	4"PC-30-101-F24H4	286
8	6000-PR-PIE-008	Process Condensate	4"PC-30-101-F24H4	286
9	6000-PR-PIE-009	Process Condensate	4"PC-30-101-F24H4	286
10	6000-PR-PIE-010	Process Condensate	4"PC-30-101-F24H4	286
11	6000-PR-PIE-011	Process Condensate	4"PC-30-101-F24H4	286
12	6000-PR-PIE-012	Process Condensate	4"PC-30-101-F24H4	286
13	6000-PR-PIE-013	Process Condensate	4"PC-30-101-F24H4	286
14	6000-PR-PIE-014	Process Condensate	4"PC-30-101-F24H4	286
15	6000-PR-PIE-015	Process Condensate	4"PC-30-101-F24H4	286
16	6000-PR-PIE-016	Process Condensate	4"PC-30-101-F24H4	286
17	6000-PR-PIE-017	Process Condensate	4"PC-30-101-F24H4	286
18	6000-PR-PIE-018	Process Condensate	4"PC-30-101-F24H4	286
19	6000-PR-PIE-019	Process Condensate	4"PC-30-101-F24H4	286
20	6000-PR-PIE-020	Process Condensate	4"PC-30-101-F24H4	286

NO	PIP Numbers	Medium	From/To	SPEC NO.
1	4000-PR-PIE-001	Rxn Methanol LHM	10"APC-30-101-F24H4	400
2	4000-PR-PIE-002	Rxn Methanol LHM	10"APC-30-101-F24H4	400
3	4000-PR-PIE-003	Rxn Methanol LHM	10"APC-30-101-F24H4	400
4	4000-PR-PIE-004	POC	3"POC-80-102-C1A-N	9407

NO	PIP Numbers	Medium	From/To	SPEC NO.
1	4000-PR-PIE-001	POC	3"POC-80-102-C1A-N	9407
2	2000-PR-PIE-010	Hydrogen Gas	2"HG-30-101-F24H4	338
3	2000-PR-PIE-010	Hydrogen Gas	2"HG-30-101-F24H4	338
4	2000-PR-PIE-010	Hydrogen Gas	2"HG-30-101-F24H4	338
5	2000-PR-PIE-010	Hydrogen Gas	2"HG-30-101-F24H4	338
6	2000-PR-PIE-010	Hydrogen Gas	2"HG-30-101-F24H4	338
7	2000-PR-PIE-010	Hydrogen Gas	2"HG-30-101-F24H4	338
8	2000-PR-PIE-010	Hydrogen Gas	2"HG-30-101-F24H4	338
9	2000-PR-PIE-010	Hydrogen Gas	2"HG-30-101-F24H4	338

NO	PIP Numbers	Medium	From/To	SPEC NO.
1	5000-PR-PIE-001	Process Condensate	4"PC-30-101-F24H4	286
2	5000-PR-PIE-002	Process Condensate	4"PC-30-101-F24H4	286
3	5000-PR-PIE-003	Process Condensate	4"PC-30-101-F24H4	286
4	5000-PR-PIE-004	Process Condensate	4"PC-30-101-F24H4	286
5	5000-PR-PIE-005	Process Condensate	4"PC-30-101-F24H4	286
6	5000-PR-PIE-006	Process Condensate	4"PC-30-101-F24H4	286
7	5000-PR-PIE-007	Process Condensate	4"PC-30-101-F24H4	286
8	5000-PR-PIE-008	Process Condensate	4"PC-30-101-F24H4	286
9	5000-PR-PIE-009	Process Condensate	4"PC-30-101-F24H4	286
10	5000-PR-PIE-010	Process Condensate	4"PC-30-101-F24H4	286
11	5000-PR-PIE-011	Process Condensate	4"PC-30-101-F24H4	286
12	5000-PR-PIE-012	Process Condensate	4"PC-30-101-F24H4	286
13	5000-PR-PIE-013	Process Condensate	4"PC-30-101-F24H4	286
14	5000-PR-PIE-014	Process Condensate	4"PC-30-101-F24H4	286
15	5000-PR-PIE-015	Process Condensate	4"PC-30-101-F24H4	286
16	5000-PR-PIE-016	Process Condensate	4"PC-30-101-F24H4	286
17	5000-PR-PIE-017	Process Condensate	4"PC-30-101-F24H4	286
18	5000-PR-PIE-018	Process Condensate	4"PC-30-101-F24H4	286
19	5000-PR-PIE-019	Process Condensate	4"PC-30-101-F24H4	286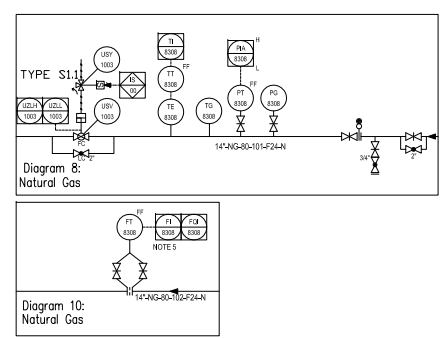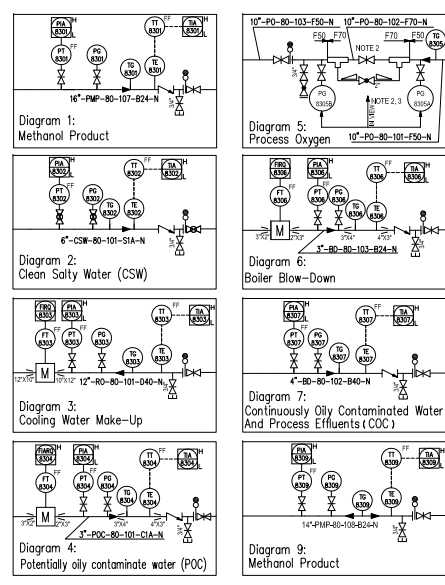
13	5000-PR-PIE-013	Process Condensate	4"PC-30-101-F24H4	286
14	5000-PR-PIE-014	Process Condensate	4"PC-30-101-F24H4	286
15	5000-PR-PIE-015	Process Condensate	4"PC-30-101-F24H4	286
16	5000-PR-PIE-016	Process Condensate	4"PC-30-101-F24H4	286
17	5000-PR-PIE-017	Process Condensate	4"PC-30-101-F24H4	286
18	5000-PR-PIE-018	Process Condensate	4"PC-30-101-F24H4	286
19	5000-PR-PIE-019	Process Condensate	4"PC-30-101-F24H4	286
20	5000-PR-PIE-020	Process Condensate	4"PC-30-101-F24H4	286

NO	PIP Numbers	Medium	From/To	SPEC NO.
1	8000-PR-PIE-002	POC	3"POC-80-102-C1A-N	9407
2	0500-PR-PIE-005	Clean Salty Water	6"CSW-80-101-F30N	9530
3	0500-PR-PIE-001	Cooling Water Make-Up	12"CW-80-101-F30N	9592

NO	PIP Numbers	Medium	From/To	SPEC NO.
1	1000-PR-PIE-001	Off Water	2"OW-10-101-B24N	104
2	1000-PR-PIE-002	Natural Gas	14"NG-80-101-F30N	9530
3	1000-PR-PIE-003	Natural Gas	14"NG-80-101-F30N	9530

NOTE: 1) ● THIS DOT REPRESENTS THAT TWO PIPELINES ARE CONNECTED.  
 2) SAFE AREA FOR EMERGENCY ISOLATION OF OXYGEN SUPPLY: THE OXYGEN VALVE SHOULD BE POSITIONED IN SUCH A WAY THAT IT CAN BE SAFELY OPERATED (THE SHELF/ CONCRETE MUST BE PROVIDED).  
 3) BY PASS FOR PRESSURIZATION SHALL BE MADE OF MONEL. CONNECTIONS HAVE TO BE TOP OF MAINLINE.  
 4) THE 14" OXYGEN PROCESS OXYGEN LINE SHALL BE CONNECTED WITH TWO SEQUENCING REDUCERS OF 1/4"X1/2" AND 1/2"X1/2". IGC DOC 13120E. OXYGEN PIPELINE AND PIPING SYSTEMS SHOULD BE FOLLOWED.  
 5) PPT COMPRESSION FROM PH-303 TO PH-304.  
 6) UNDERGROUND CONNECTION POINT NEAR THE GATE OF PLANT.

REV.	DESCRIPTION	DATE	DESIGN	DRAW	CHECK	REVIEW	APPROVE
▲	As Built	30.04.2020					
▲	Approved For Construction	30.12.2019					
▲	Approved For Construction	01.11.2018					
▲	Approved For Construction	06.11.2017					
▲	Approved For Construction	28.07.2017					
▲	Issued For Approval	22.03.2017					
▲	Issued For Review	03.03.2017					
▲	Issued For Review	20.01.2017					
▲	Issued For Review	15.11.2016					
▲	Issued For Review	09.10.2016					
▲	Issued For Review	06.07.2016					
▲	Issued For Comments	29.4.2016					

Middle East  
Kimiya Pars Company

CONTRACTOR DRAWING NO.  
MKP-11-AS-8000-PS07-PIE-001

SHEET 01 TOTAL 01

CONTRACTOR DRAWING NO.  
SUB-CONTRACTOR DRAWING NO.


SHEET - TOTAL -

PROJECT: MKP Methanol Project  
UNIT: Pipe Rack and Pipe Net  
PHASE: As Built Drawing  
OWNER: MKP-11-AS-8000-PR-PIE-001

PIPE RACK AND PIPE NET SYSTEM  
PIPING AND INSTRUMENT DIAGRAM

SCALE: - SHEET:1 TOT:1 SIZE:A1

COUNTER SIGNING: Sign Date

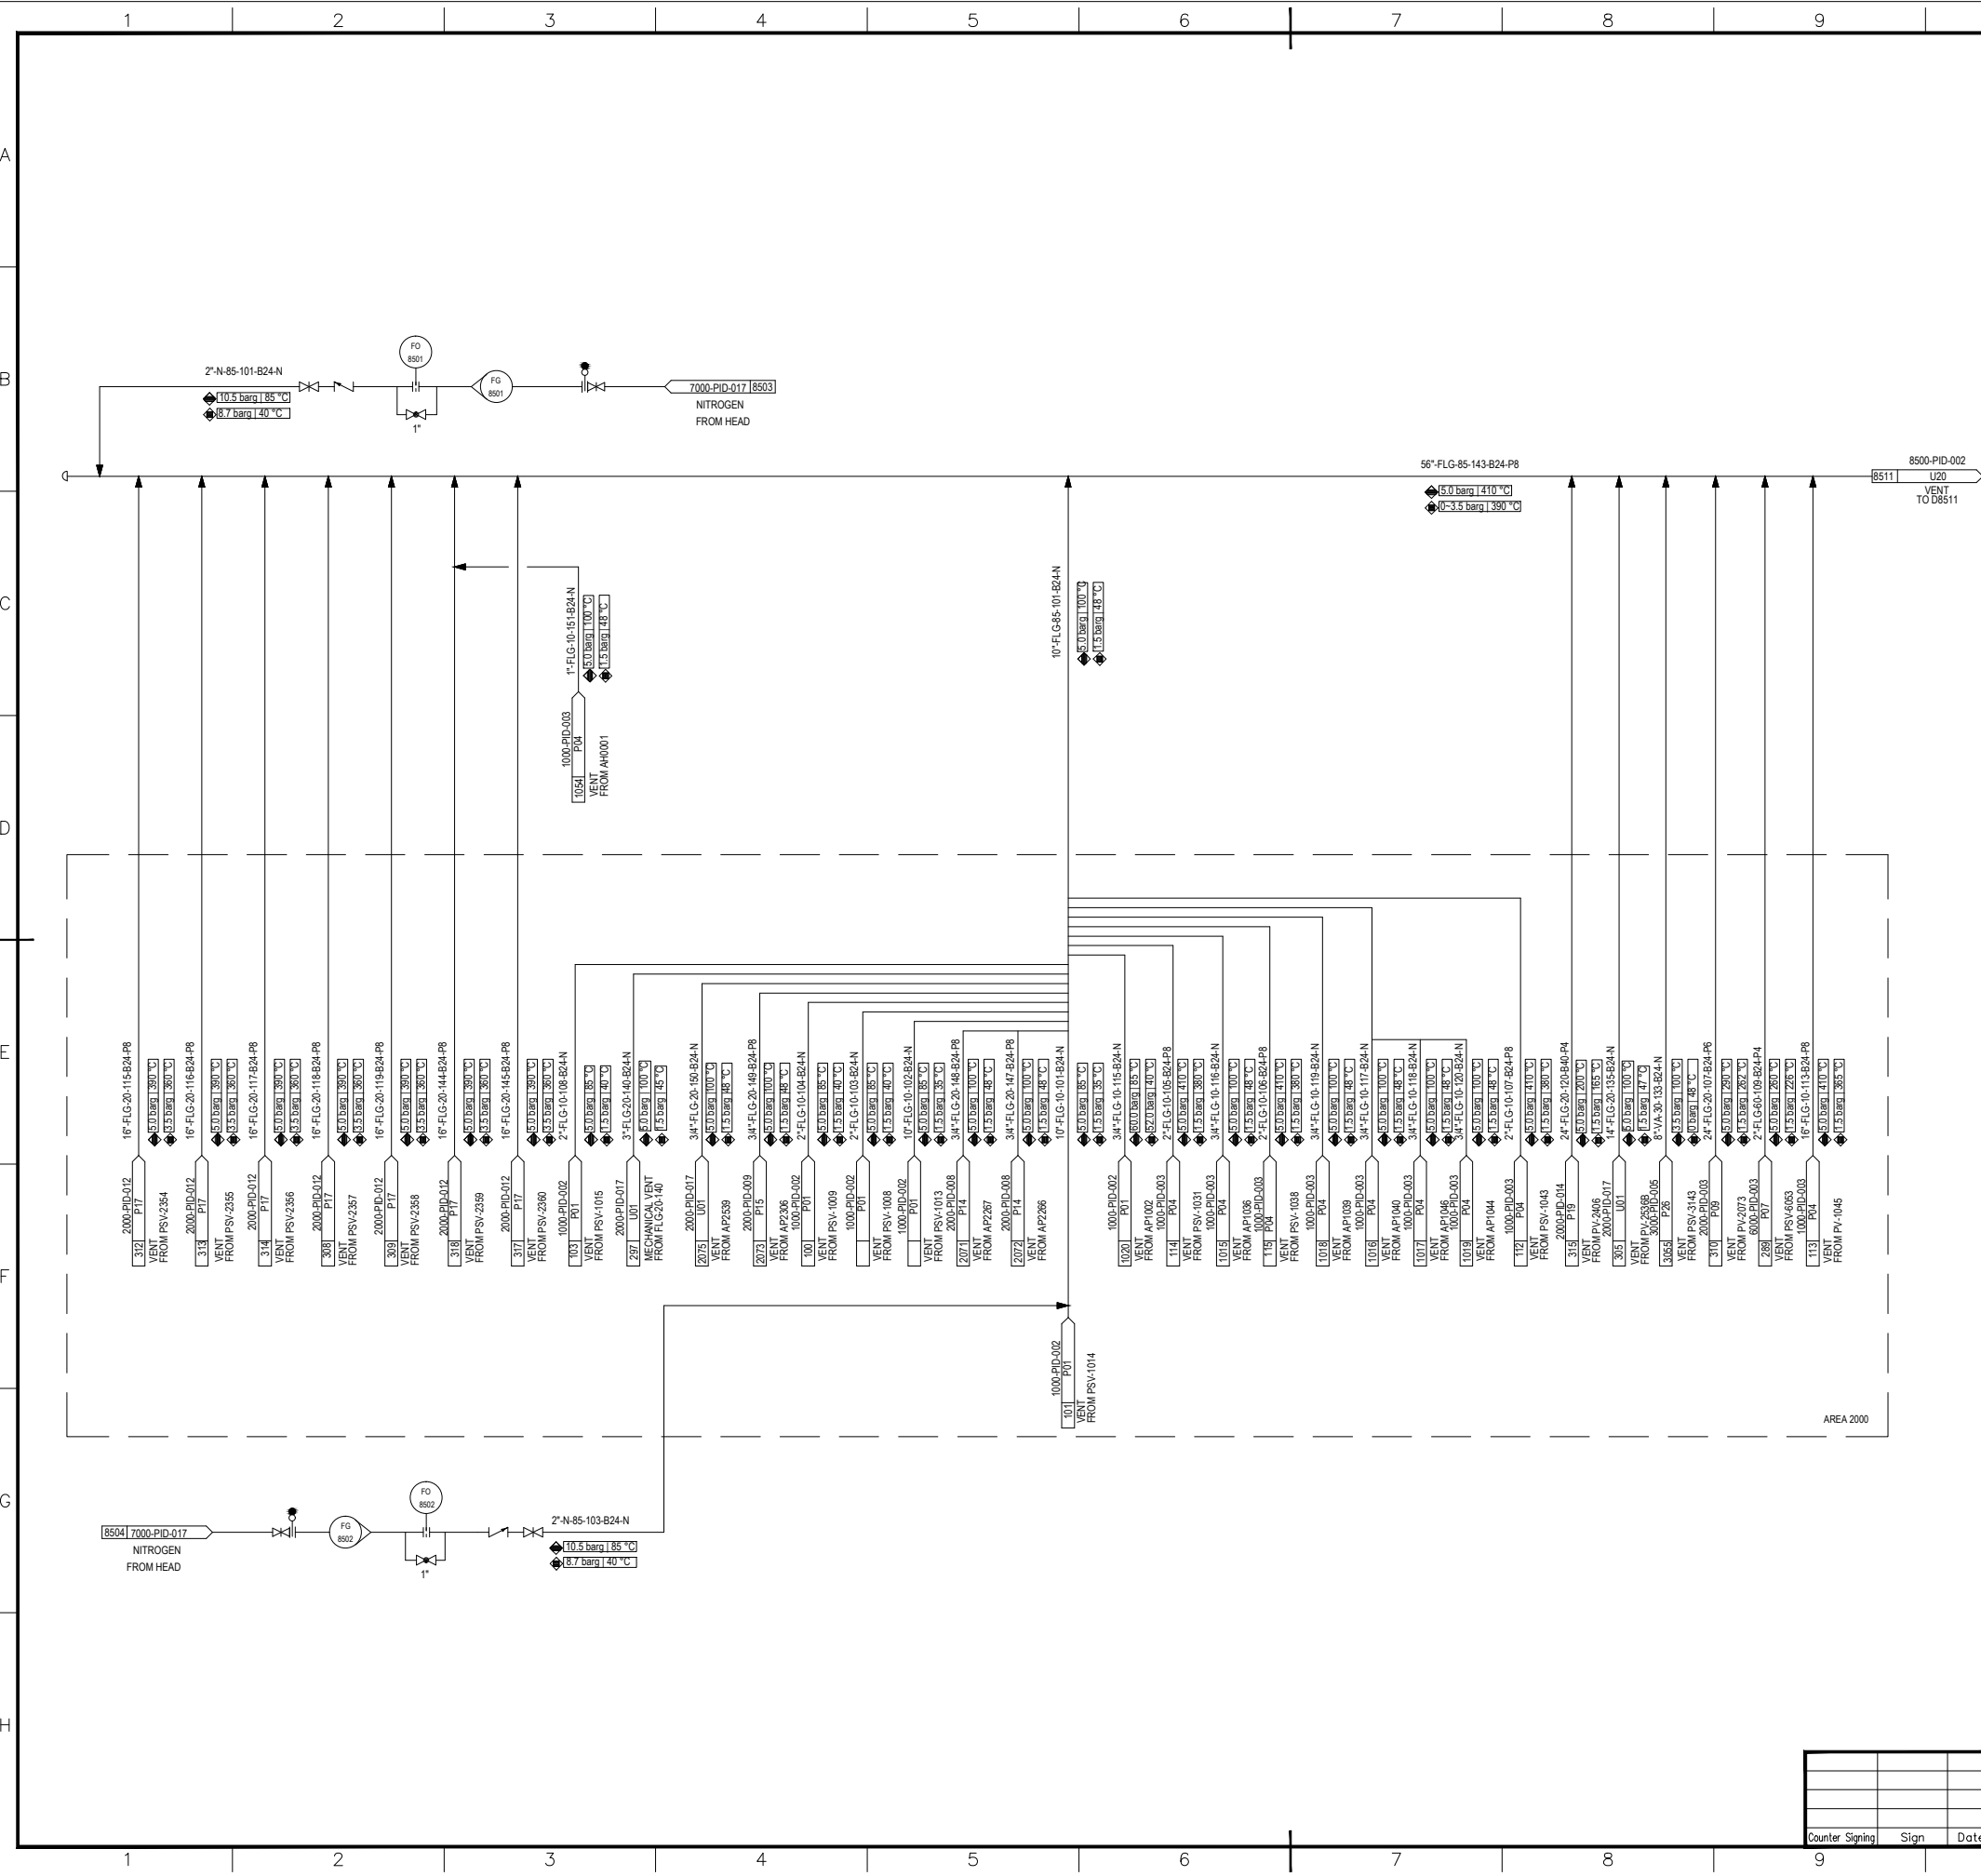

**GENERAL NOTES**

- †GENERAL NOTE:  
LOW POINT DRAINS AND HIGH POINT VENT MUST BE ADDED.
- †NOTE:  
1) THE DIRECT ROUTING DISTANCE BETWEEN THE TIE-IN POINT LOCATION OF THE METHANOL PLANT AND THE ACTUAL FLARE SITE IS ABOUT 1600 M.  
2) FOR THE FLARE PIPING ROUTING, ONE STRESS EXPANSION LOOP IS SET AT ABOUT EVERY 60M DISTANCE.

**REFERENCE DRAWINGS**

**SYMBOLS AND LEGENDS**

**KEY PLAN**

REV.	DESCRIPTION	DATE	DESIGN	DRAW	CHECK	REVIEW	APPROVE
▲	As Built	30.04.2020	Chen Tao		Xu Hang	Liu Shengkol	
▲	Approved For Construction	11.11.2018	Chen Tao		Xu Hang	Liu Shengkol	
▲	Approved For Construction	06.11.2017	Chen Tao		Xu Hang	Liu Shengkol	
▲	Approved For Construction	22.3.2017	Chen Tao		Xu Hang	Shi Jing	
▲	Approved For Construction	20.12.2016	Chen Tao		Xu Hang	Shi Jing	
▲	Issued For Approval	12.10.2016	Chen Tao		Xu Hang	Shi Jing	
▲	Issued For Review	31.8.2016	Chen Tao		Xu Hang	Shi Jing	
▲	Issued For Comments	29.4.2016	Chen Tao		Xu Hang	Shi Jing	

THIS DOCUMENT IS THE PROPERTY OF TCC. NO PART OF THIS DOCUMENT SHALL BE REPRODUCED OR DISCLOSED TO OTHERS OR USED FOR ANY PURPOSE WHATSOEVER EXCEPT WITH THE PRIOR WRITTEN PERMISSION OF TCC.


OWNER: Middle East Kimiaye Pars Company

HALDOR TOPSØE A/S CORPORATION DANISH	DOCUMENT NAME: FLARE HEADER I UTILITY DIAGRAM	JOB NO. S-02115	CONTRACT NO. 42	REV. 3
	DATE: 13/4/17	SCALE: U10		
TCC 中国天辰工程技术有限公司 CHINA TIANCHEN ENGINEERING CORPORATION	CONTRACTOR DRAWING NO.			
	MKP-11-AS-8500-PS09-PID-001			
	SHEET 01		TOTAL 01	
SUB-CONTRACTOR DRAWING NO.				
SHEET -- TOTAL --				

UTILITY DISTRIBUTION DIAGRAM FLARE HEADER I		PROJECT	MKP Methanol Project
		UNIT	Flare
		PHASE	As Built Drawing
SCALE: --	SHEET: 1	TOT: 1	SIZE: A1
OWNER DWG NO.	MKP-11-AS-8500-PR-PID-001		

Counter Sign	Sign	Date

Drawing2.dwg

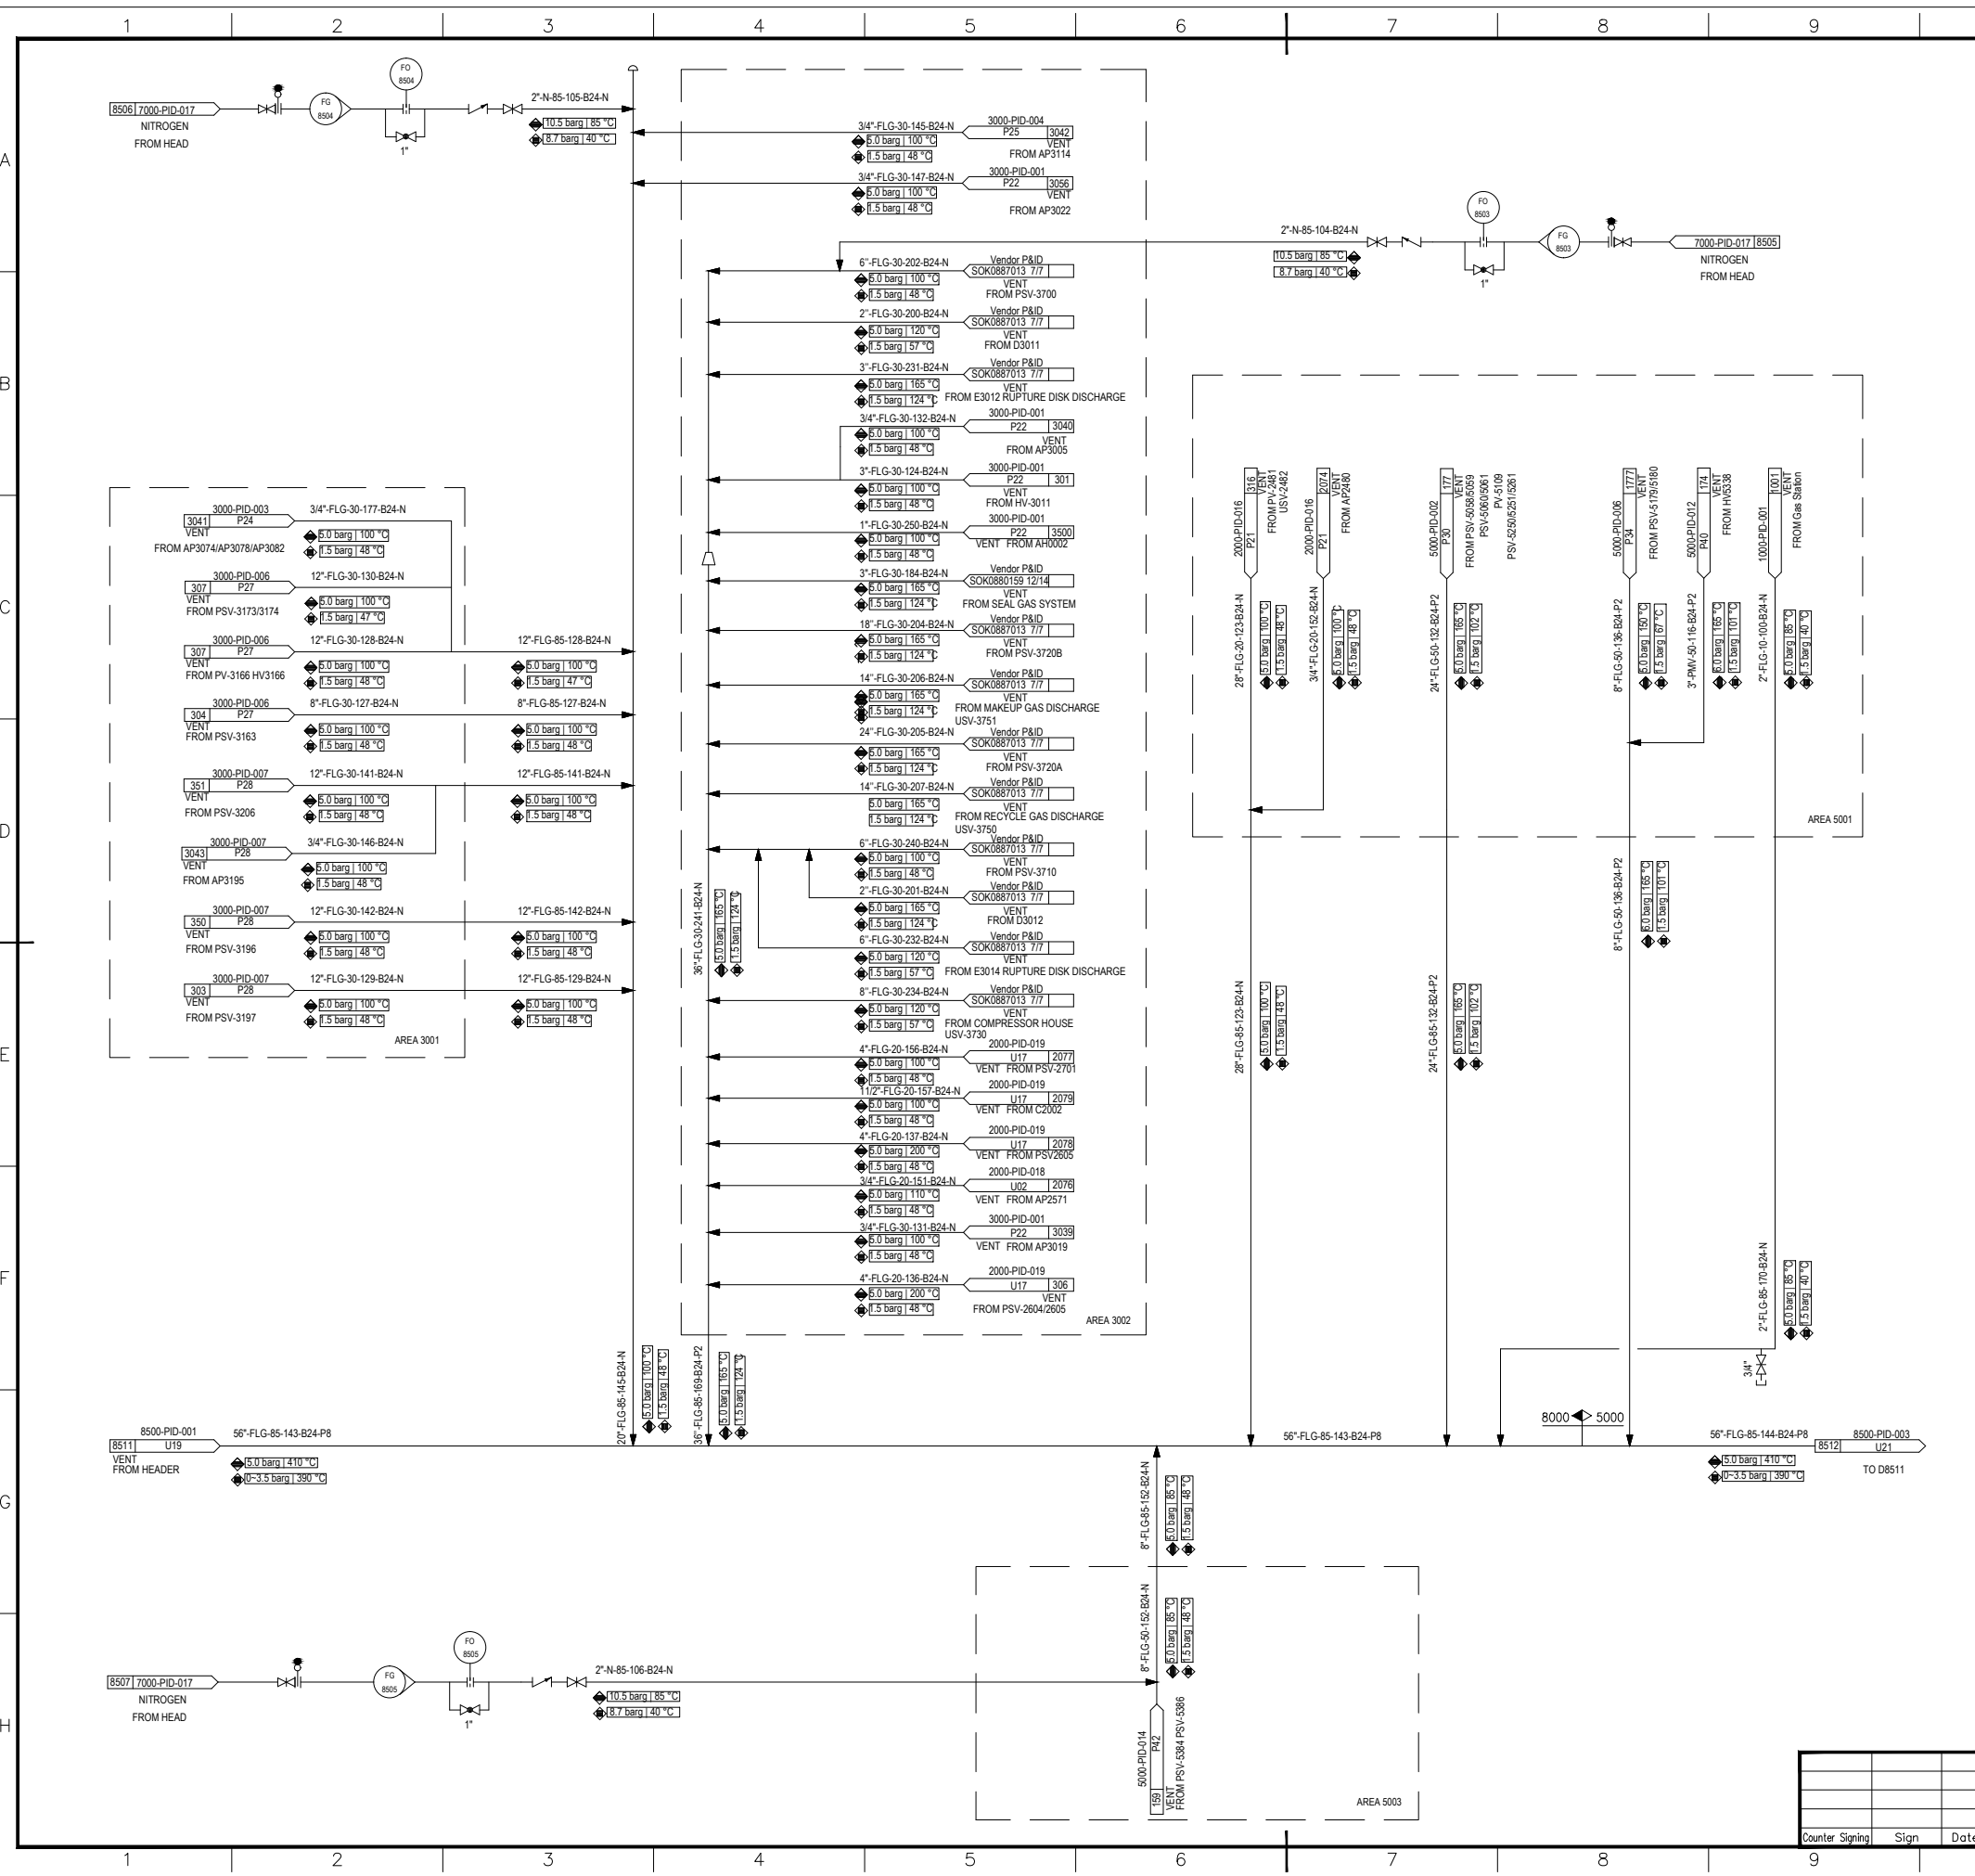

### GENERAL NOTES

<sup>+</sup>GENERAL NOTE:  
LOW POINT DRAINS AND HIGH POINT VENT MUST BE ADDED.

<sup>+</sup>NOTE:  
1) THE DIRECT ROUTING DISTANCE BETWEEN THE TIE-IN POINT LOCATION OF THE METHANOL PLANT AND THE ACTUAL FLARE SITE IS ABOUT 1600 M.  
2) FOR THE FLARE PIPING ROUTING, ONE STRESS EXPANSION LOOP IS SET AT ABOUT EVERY 60M DISTANCE.

---

### REFERENCE DRAWINGS


---

### SYMBOLS AND LEGENDS


---

### KEY PLAN

REV.	DESCRIPTION	DATE	DESIGN	DRAW	CHECK	REVIEW	APPROVE
▲	As Built	30.04.2020	Chen Tao		Xu Hang	Liu Shengkai	
▲	Approved For Construction	16.12.2018	Chen Tao		Xu Hang	Liu Shengkai	
▲	Approved For Construction	11.11.2018	Chen Tao		Xu Hang	Liu Shengkai	
▲	Approved For Construction	09.01.2018	Chen Tao		Xu Hang	Liu Shengkai	
▲	Approved For Construction	06.11.2017	Chen Tao		Xu Hang	Liu Shengkai	
▲	Approved For Construction	22.3.2017	Chen Tao		Xu Hang	Shi Jing	
▲	Approved For Construction	20.12.2016	Chen Tao		Xu Hang	Shi Jing	
▲	Issued For Approval	12.10.2016	Chen Tao		Xu Hang	Shi Jing	
▲	Issued For Review	31.8.2016	Chen Tao		Xu Hang	Shi Jing	
▲	Issued For Comments	29.4.2016	Chen Tao		Xu Hang	Shi Jing	

THIS DOCUMENT IS THE PROPERTY OF TCC. NO PART OF THIS DOCUMENT SHALL BE REPRODUCED OR DISCLOSED TO OTHERS OR USED FOR ANY PURPOSE WHATSOEVER EXCEPT WITH THE PRIOR WRITTEN PERMISSION OF TCC.

OWNER: **Middle East Kimiaye Pars Company**


<b>TCC</b> 中国天辰工程技术有限公司 CHINA TIANCHEN ENGINEERING CORPORATION	CONTRACTOR	HALDOR TOPSØE A/S	DOCUMENT NAME	FLARE HEADER II UTILITY DIAGRAM	PRO NO.	S-02115	CON NO.	42	REV.	1	
	CONTRACTOR	CONTRACTOR	CONTRACTOR	CONTRACTOR	CONTRACTOR	CONTRACTOR	CONTRACTOR	CONTRACTOR	CONTRACTOR	CONTRACTOR	
CONTRACTOR DRAWING NO.		MKP-11-AS-8500-PS09-PID-002		SHEET		01		TOTAL		01	
SUB-CONTRACTOR DRAWING NO.				SHEET				TOTAL			
PROJECT		MKP Methanol Project		UNIT		Flare		PHASE		As Built Drawing	
SCALE: -		SHEET: 1		TOT: 1		SIZE: A1		OWNER DWG NO.		MKP-11-AS-8500-PR-PID-002	

Drawing2.dwg



<b>P 8511</b>	<b>KNOCK-OUT DRUM PUMP</b>
CAPACITY	30 m <sup>3</sup> /h
HEAD	30 m
DENSITY@DT	990 kg/m <sup>3</sup>
INSULATION/TRACING	NONE
AUXILIARY PIPING	By Vendor
ELEV. of EQUIPMENT	EL+101.100m

<b>D 8511</b>	<b>FLARE KNOCK OUT DRUM</b>
ID x LENGTH(T-D)	5000 x 11000 mm
DESIGN PRESS.	5.5 barg
DESIGN TEMP.	410 °C
INSULATION	YES
CLADDING/LINING	NONE
ELEV. of EQUIPMENT	EL+102.700m

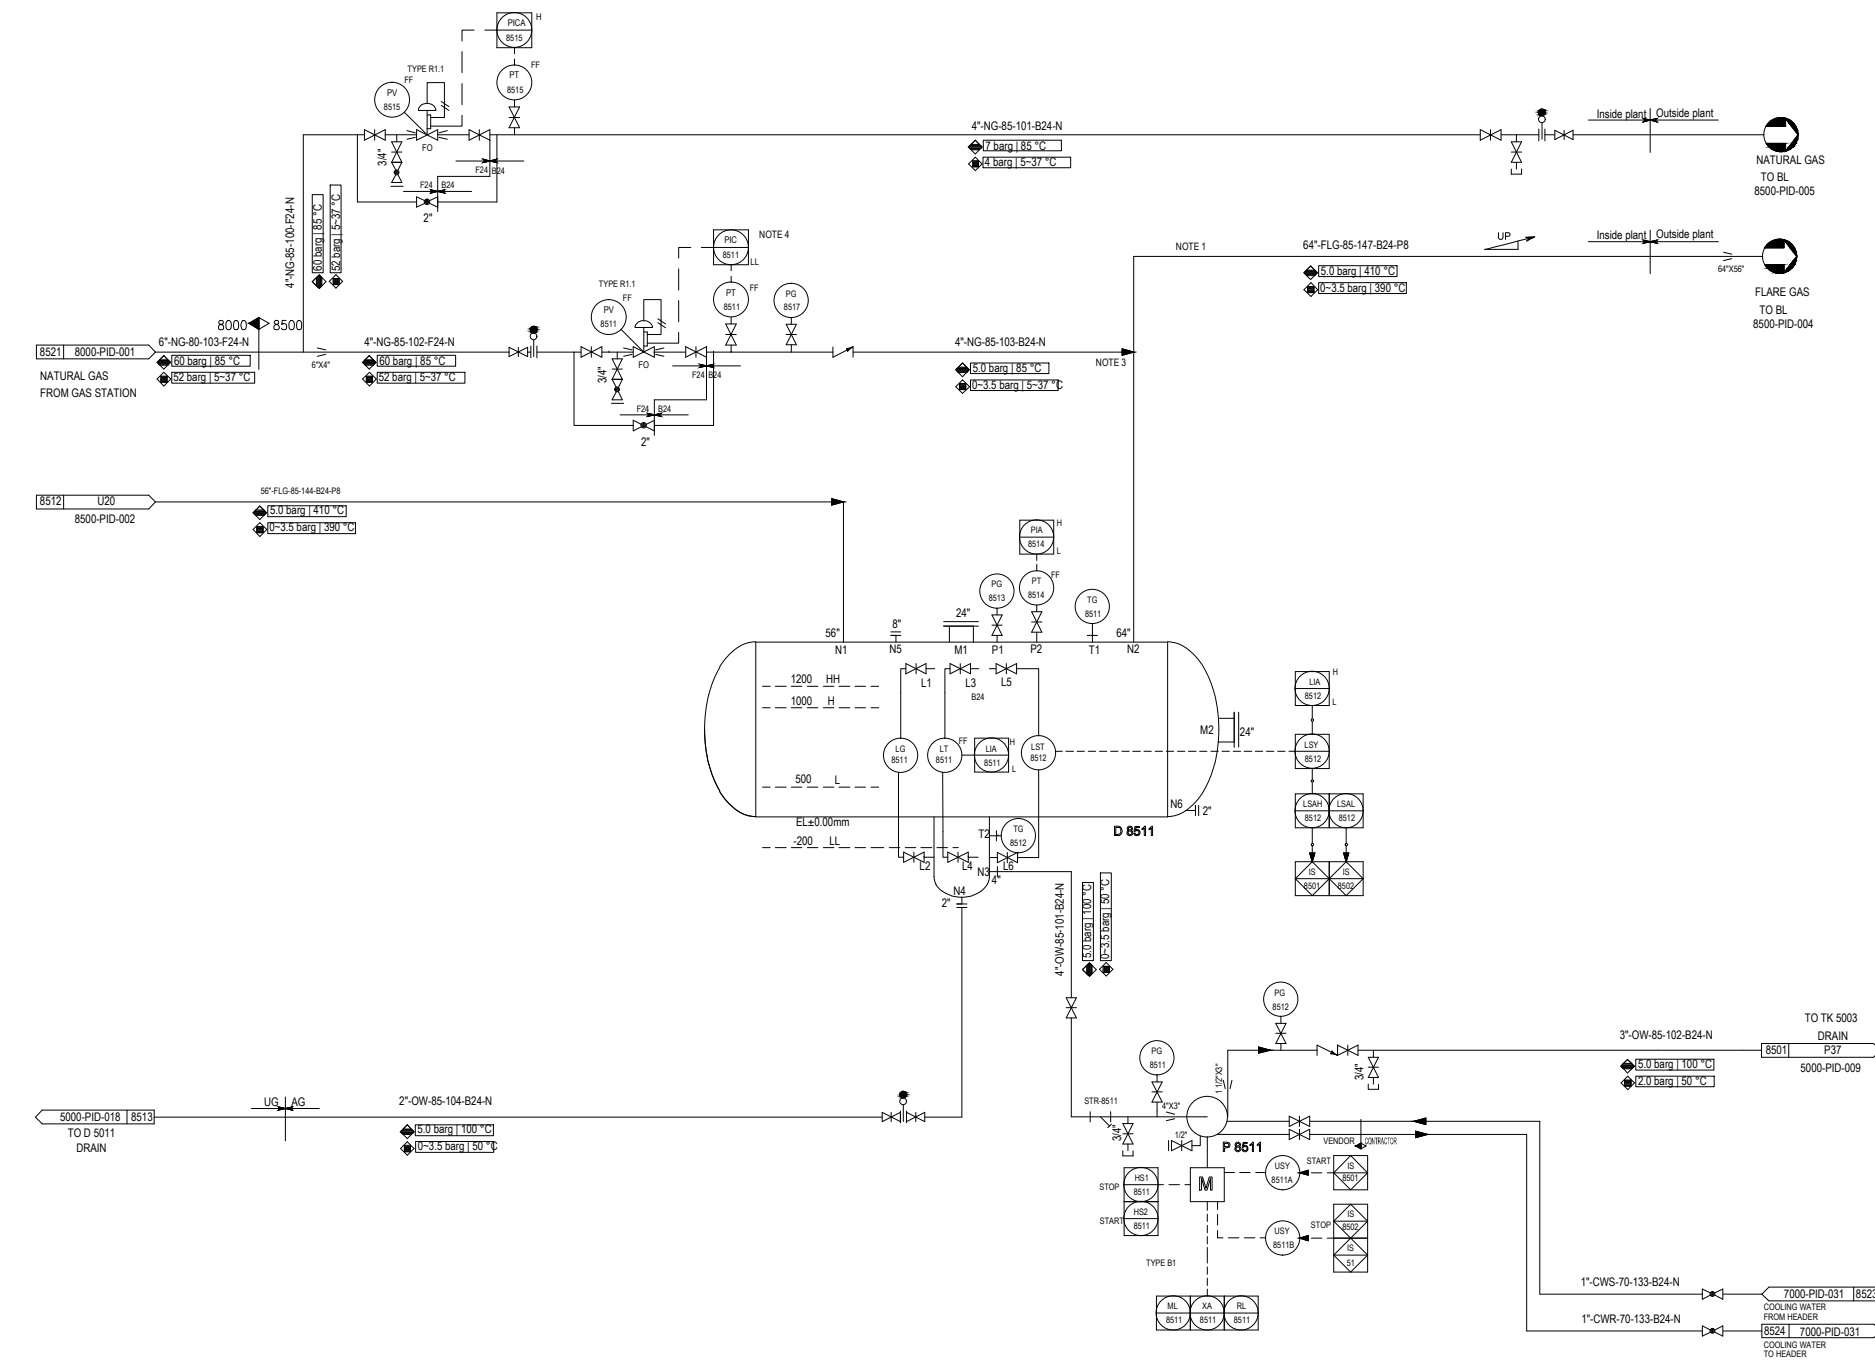

**GENERAL NOTES**

- † GENERAL NOTE:
- 1) LOW POINT DRAINS AND HIGH POINT VENT MUST BE ADDED.
  - 2) FLARE LINE WITH AN UPWARD SLOPE SHALL ADD LOW POINT DRAINS.
- † NOTE:
- 1) THE DIRECT ROUTING DISTANCE BETWEEN THE TIE-IN POINT LOCATION OF THE METHANOL PLANT AND THE ACTUAL FLARE SITE IS ABOUT 1600 M.
  - 2) FOR THE FLARE PIPING ROUTING, ONE STRESS EXPANSION LOOP IS SET AT ABOUT EVERY 60M DISTANCE.
  - 3) THIS CONNECTION POINT IS NEAR TO K.O.D INSIDE OF PLANT B.L.
  - 4) CONTROLLER TO MANUAL WITH 100% OUTPUT WHEN LOWER THAN SETTING PRESSURE DATA. TO PREVENT VACUUM.

**REFERENCE DRAWINGS**

**SYMBOLS AND LEGENDS**

**KEY PLAN**

REV.	DESCRIPTION	DATE	DESIGN	DRAW	CHECK	REVIEW	APPROVE
▲	As Built	30.04.2020	Chen Tao		Xu Hang	Liu Shengke	
▲	Approved For Construction	30.12.2019	Chen Tao		Xu Hang	Liu Shengke	
▲	Approved For Construction	16.12.2018	Chen Tao		Xu Hang	Liu Shengke	
▲	Approved For Construction	11.11.2018	Chen Tao		Xu Hang	Liu Shengke	
▲	Approved For Construction	02.01.2018	Chen Tao		Xu Hang	Liu Shengke	
▲	Approved For Construction	06.11.2017	Chen Tao		Xu Hang	Liu Shengke	
▲	Approved For Construction	22.3.2017	Chen Tao		Xu Hang	Shi Jing	
▲	Approved For Construction	20.1.2017	Chen Tao		Xu Hang	Shi Jing	
▲	Issued For Approval	20.12.2016	Chen Tao		Xu Hang	Shi Jing	
▲	Issued For Approval	12.10.2016	Chen Tao		Xu Hang	Shi Jing	
▲	Issued For Review	31.8.2016	Chen Tao		Xu Hang	Shi Jing	
▲	Issued For Comments	29.4.2016	Chen Tao		Xu Hang	Shi Jing	

THIS DOCUMENT IS THE PROPERTY OF TCC. NO PART OF THIS DOCUMENT SHALL BE REPRODUCED OR DISCLOSED TO OTHERS OR USED FOR ANY PURPOSE WHATSOEVER EXCEPT WITH THE PRIOR WRITTEN PERMISSION OF TCC.

OWNER: **Middle East Kimiaye Pars Company**

	DOCUMENT NAME <b>FLARE STACK UTILITY DIAGRAM</b>	JOB NO. <b>S-02115</b>	SHEET NO. <b>42</b>	REV. <b>1</b>
	CONTRACTOR DRAWING NO. <b>1344013</b>	DRAWING NO. <b>U21</b>		
		CONTRACTOR DRAWING NO. <b>MKP-11-AS-8500-PS09-PID-003</b>		
SHEET 01 TOTAL 01		SUB-CONTRACTOR DRAWING NO.		
SHEET -- TOTAL --				

P&ID FLARE K.O. DRUM	PROJECT	MKP Methanol Project
	UNIT	Flare
	PHASE	As Built Drawing
SCALE: --	OWNER DWG. NO.	MKP-11-AS-8500-PR-PID-003

Counter	Sign	Date


D-8501	Knock-Out Drum
ID x LENGTH(T)	DN3600xH10000 mm
DESIGN PRESS.	7.0 barg
DESIGN TEMP.	410 °C
INSULATION	YES
CLADDING/LINING	NONE

FL-8501	Flare Stack
ID x LENGTH(T)	DN1600xH44450mm
DESIGN PRESS.	7.0 barg
DESIGN TEMP.	410 °C
INSULATION	NONE

FL-8502	Flare Tip
ID x LENGTH(T)	DN1600xH5000 mm
DESIGN PRESS.	0.5 barg
DESIGN TEMP.	1200 °C
INSULATION	NONE

FL-8503	Molecular Seal
ID x LENGTH(T)	DN3000xH5000 mm
DESIGN PRESS.	5.0 barg
DESIGN TEMP.	410 °C
INSULATION	NONE

X-8502	Derrick
HEIGHT	64 m
ROOT LENGTH	12 m
TYPE	BOLTING CONNECTED
MATERIAL	CSHOT RIP GALVANIZED

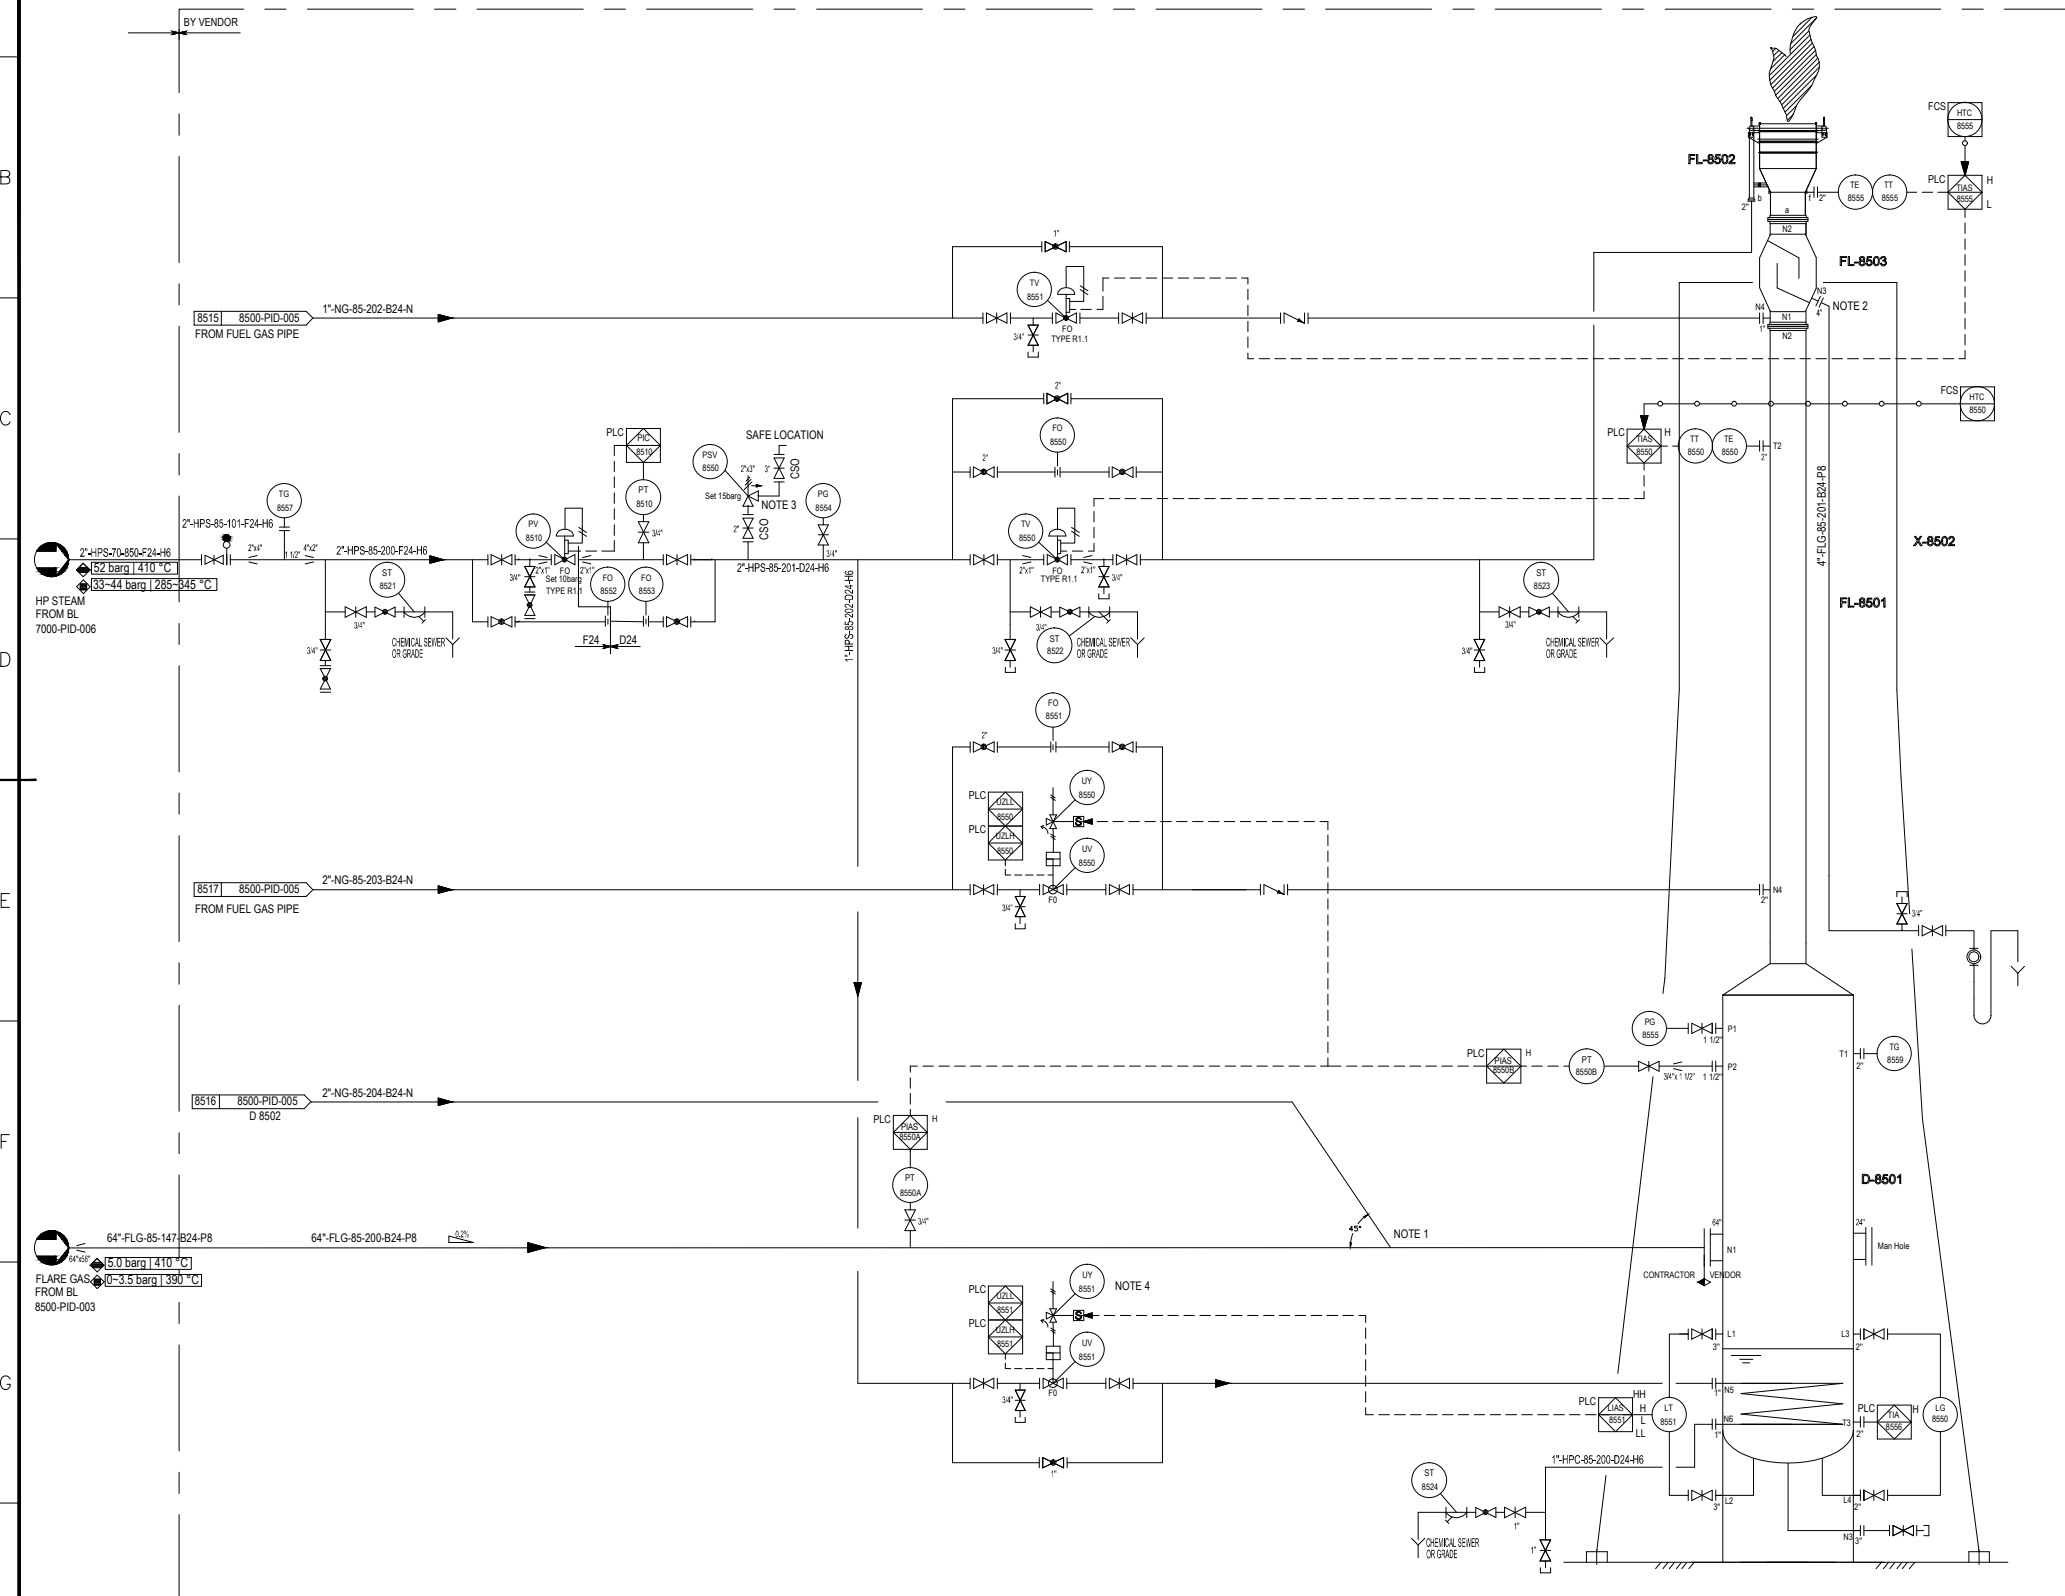

**GENERAL NOTES**

- †GENERAL NOTE:
- 1) LOW POINT DRAINS AND HIGH POINT VENT MUST BE ADDED DURING DETAILED ENGINEERING.
  - 2) FLARE LINE WITH AN UPWARD SLOPE SHALL ADD LOW POINT DRAINS, THE DETAIL INFORMATION ABOUT IT SHOULD SPECIFY IN DE PHASE.
- †NOTE:
- 1) TO ENTER VENT TO FLARE HEADER AT 45 DEGREES TO HEADER AXIS IN DIRECTION OF FLOW.
  - 2) MOLECULAR SEAL FLARE TYPE INSTEAD OF WATER SEAL TYPE, UTILIZING NATURAL GAS AS THE EMERGENCY SUPPLEMENTARY PRESSURE, (MAKE UP GAS) WITH PRESSURE CONTROL VALVE.
  - 3) A Ø 6 HOLE SHOULD BE OPENED ON HORIZONTAL PIPE AFTER SAFETY VALVE.
  - 4) WHEN THE LIQUID LEVEL IS AT HH, INTERLOCK SWITCH VALVE UV-8551 OPEN.

**REFERENCE DRAWINGS**


**SYMBOLS AND LEGENDS**


**KEY PLAN**


REV.	DESCRIPTION	DATE	DESIGN	DRAW	CHECK	REVIEW	APPROVE
▲	As Built	30.04.2020	Chen Tao		Xu Hang	LiuShengkai	
▲	Approved For Construction	30.12.2019	Chen Tao		Xu Hang	LiuShengkai	
▲	Approved For Construction	30.06.2018	Chen Tao		Xu Hang	LiuShengkai	
▲	Approved For Construction	24.01.2018	Chen Tao		Xu Hang	LiuShengkai	
▲	Approved For Construction	20.1.2017	Chen Tao		Xu Hang	Shi Jing	
▲	Issued For Approval	20.12.2016	Chen Tao		Xu Hang	Shi Jing	
▲	Issued For Approval	12.10.2016	Chen Tao		Xu Hang	Shi Jing	
▲	Issued For Comments	31.8.2016	Chen Tao		Xu Hang	Shi Jing	

THIS DOCUMENT IS THE PROPERTY OF TCC. NO PART OF THIS DOCUMENT SHALL BE REPRODUCED OR DISCLOSED TO OTHERS OR USED FOR ANY PURPOSE, WHATSOEVER EXCEPT WITH THE PRIOR WRITTEN PERMISSION OF TCC.

OWNER:


Middle East Kimiaye Pars Company

DESIGNER	HALDOR TOPSØE A/S	DOCUMENT NAME		JOB NO.		REV.	
CONTRACTOR	中国天辰工程有限公司	CONTRACTOR DRAWING NO.	MKP-11-AS-8500-PS09-PID-004	SHEET NO.	01	TOTAL	01
		SUB-CONTRACTOR DRAWING NO.		SHEET		TOTAL	

PROJECT	MKP Methanol Project
	UNIT
PHASE	As Built Drawing
OWNER DWG NO.	MKP-11-AS-8500-PR-PID-004

SCALE: - SHEET: 1 TOT: 1 SIZE: A1

Counter	Sign	Date

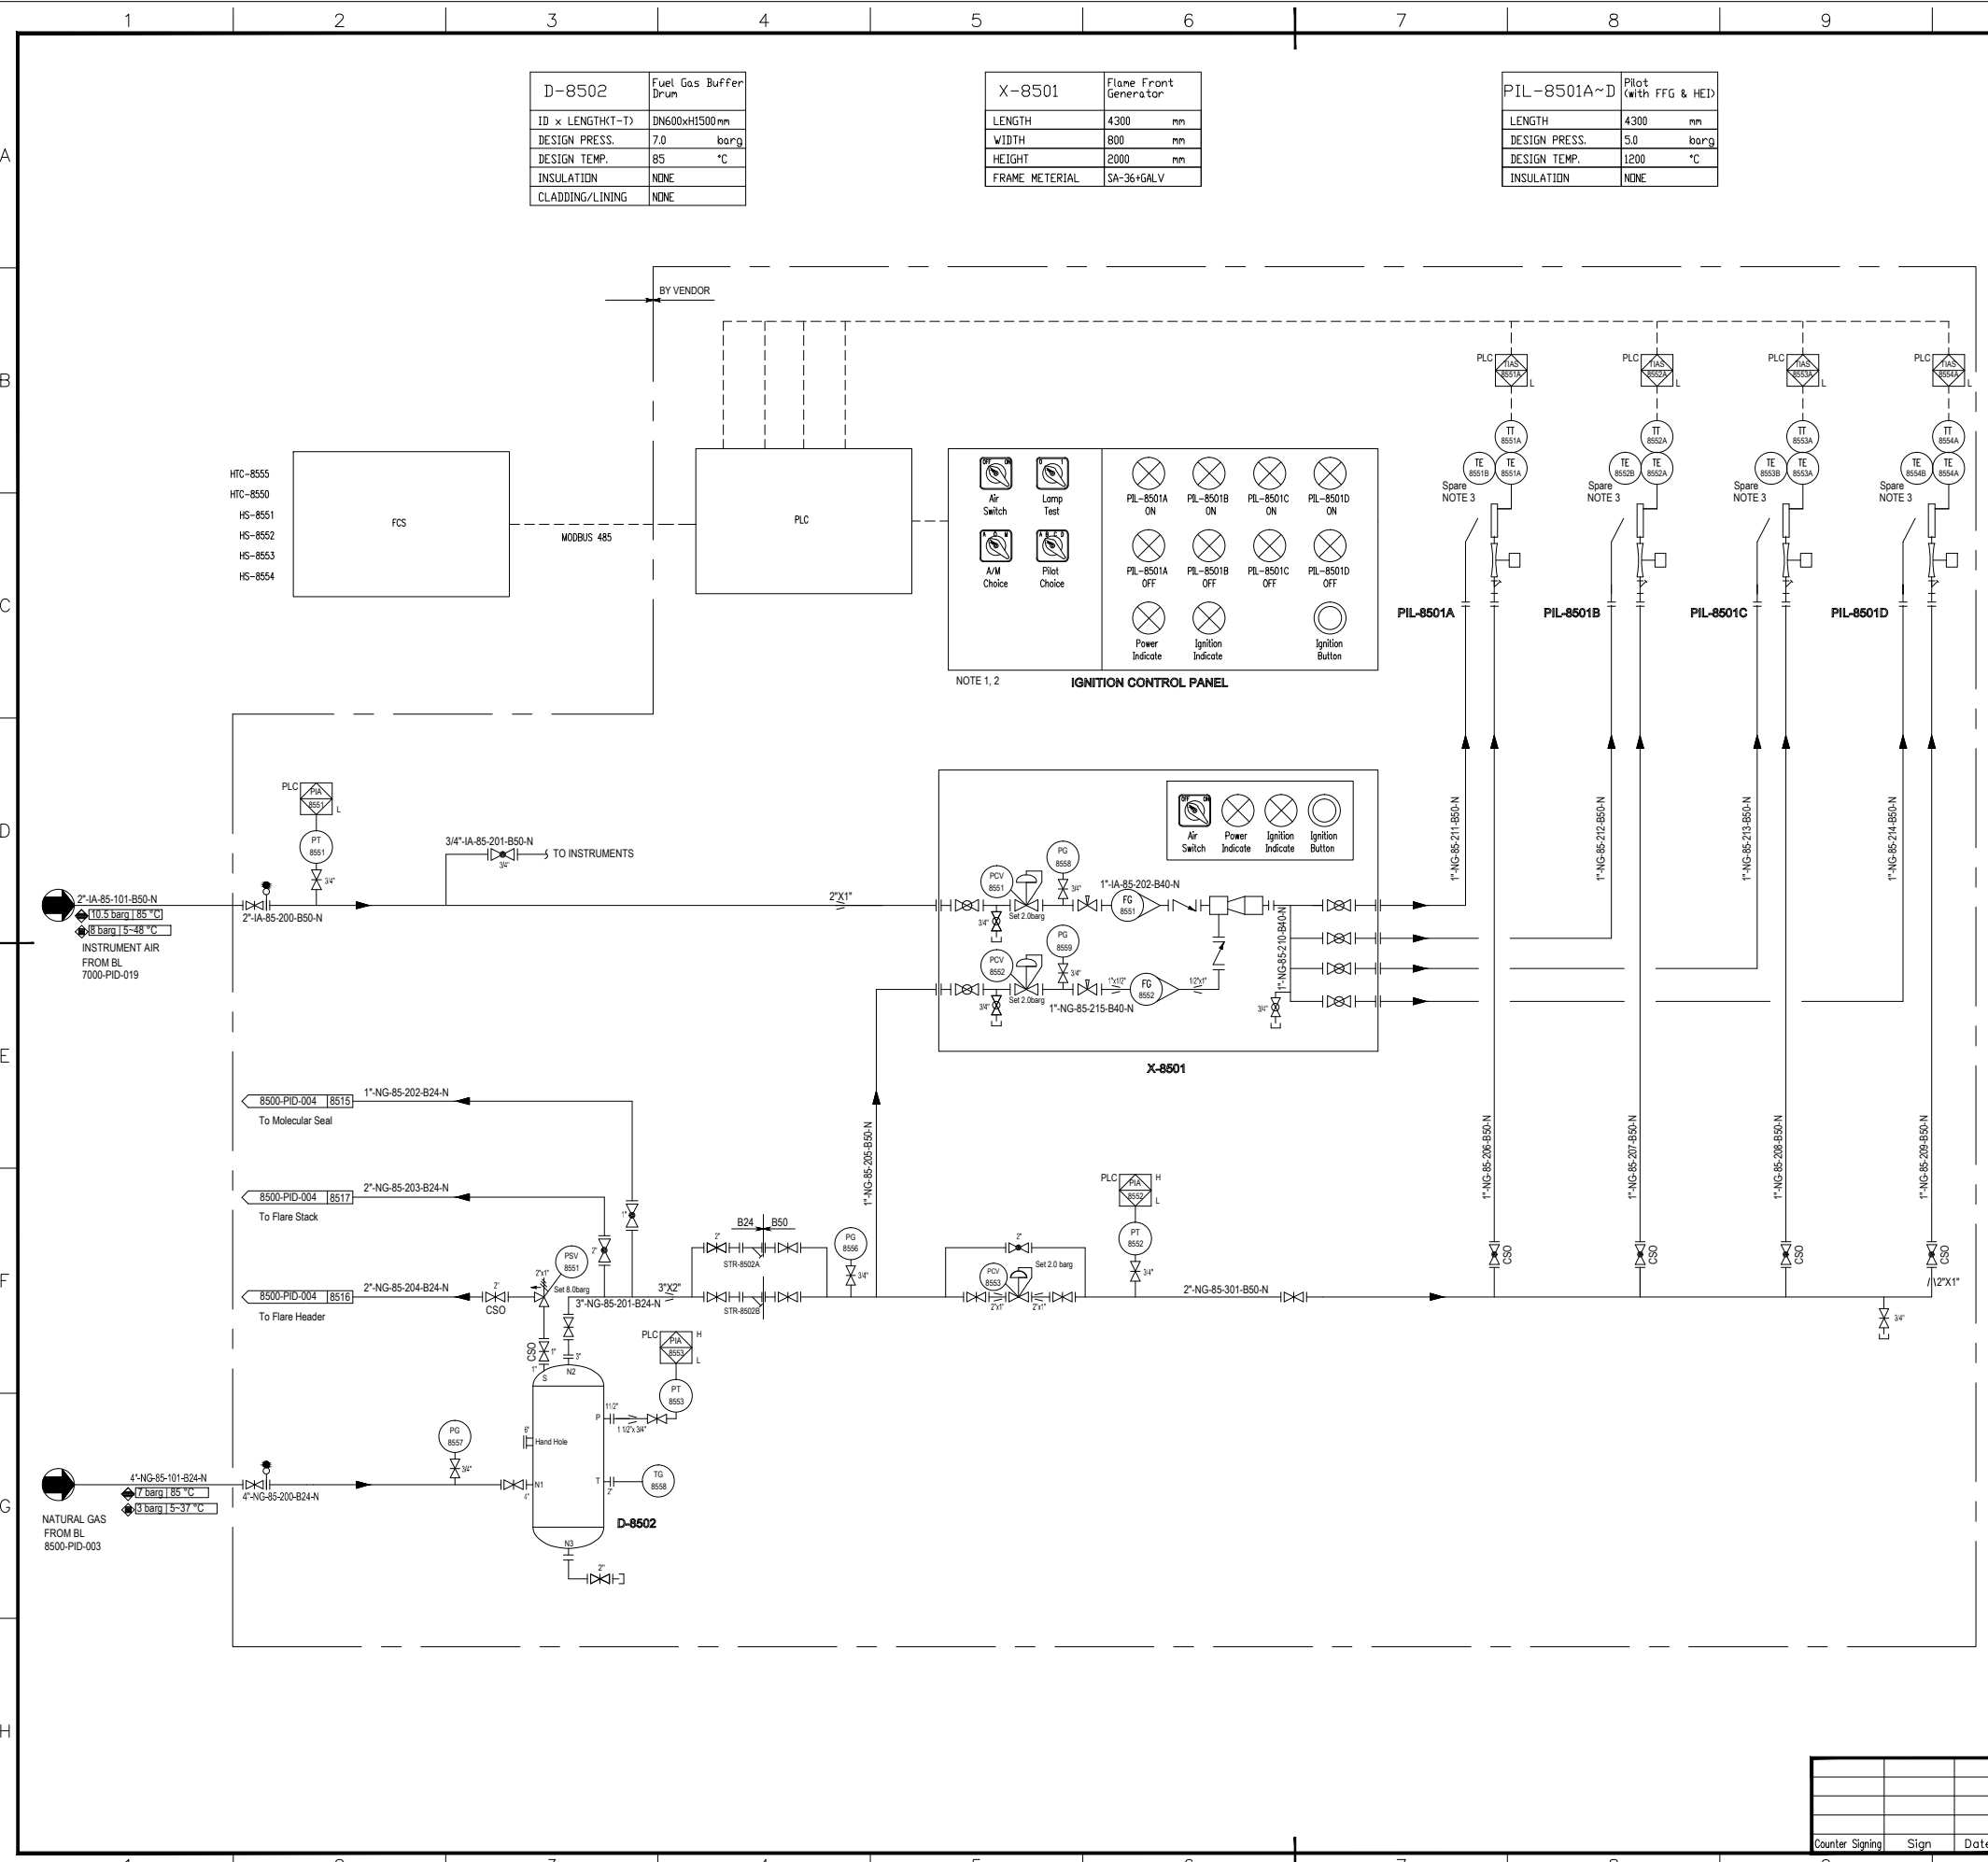

D-8502	
ID x LENGTH-T	Fuel Gas Buffer Drum
DESIGN PRESS.	DN600xH1500 mm
DESIGN TEMP.	7.0 barg
INSULATION	85 °C
CLADDING/LINING	NONE
	NONE

X-8501	
LENGTH	4300 mm
WIDTH	800 mm
HEIGHT	2000 mm
FRAME MATERIAL	SA-36+GALV

PIL-8501A~D	
LENGTH	Pilot (with FFG & HED)
DESIGN PRESS.	4300 mm
DESIGN TEMP.	5.0 barg
INSULATION	1200 °C
	NONE

**GENERAL NOTES**

- † GENERAL NOTE:
- 1) LOW POINT DRAINS AND HIGH POINT VENT MUST BE ADDED DURING DETAILED ENGINEERING.
  - 2) FLARE LINE WITH AN UPWARD SLOPE SHALL ADD LOW POINT DRAINS, THE DETAIL INFORMATION ABOUT IT SHOULD SPECIFY IN DE PHASE.
- † NOTE:
- 1) XL-01-04: PILOT CONDITION INDICATION LAMP, WHEN PIL-8501A/B/C/D ARE IN NORMAL CONDITION, THE RELEVANT LAMP IS ON.
  - 2) TAL-01-04: PILOT TEMPERATURE LOW ALARM LAMP, WHEN THE TEMPERATURE OF ANY ONE IN PIL-8501A/B/C/D IS LOWER THAN 150 °C, THE RELEVANT LAMP IS ON.
  - 3) THERMOCOUPLE IS THE K TYPE DUAL SHEATH THERMOCOUPLE. ONE IS DUTY, ANOTHER ONE IS SPARE.

**REFERENCE DRAWINGS**

**SYMBOLS AND LEGENDS**

**KEY PLAN**

REV.	DESCRIPTION	DATE	DESIGN	DRAW	CHECK	REVIEW	APPROVE
▲	As Built	30.04.2020	Chen Tao		Xu Hong	Liu Shengke	
▲	Approved For Construction	30.12.2019	Chen Tao		Xu Hong	Liu Shengke	
▲	Approved For Construction	24.01.2018	Chen Tao		Xu Hong	Liu Shengke	
▲	Approved For Construction	20.1.2017	Chen Tao		Xu Hong	Shi Jing	
▲	Approved For Construction	20.12.2016	Chen Tao		Xu Hong	Shi Jing	
▲	Approved For Construction	12.10.2016	Chen Tao		Xu Hong	Shi Jing	
▲	Issued For Comments	31.8.2016	Chen Tao		Xu Hong	Shi Jing	

THIS DOCUMENT IS THE PROPERTY OF TCC. NO PART OF THIS DOCUMENT SHALL BE REPRODUCED OR DISCLOSED TO OTHERS OR USED FOR ANY PURPOSE WHATSOEVER EXCEPT WITH THE PRIOR WRITTEN PERMISSION OF TCC.

OWNER: **Middle East Kimiaye Pars Company**

DESIGNER	HALDOR TOPSØE A/S	DOCUMENT NAME		JOB NO.		DATE		REV.	
----------	-------------------	---------------	--	---------	--	------	--	------	--

CONTRACTOR	<b>TCC 中国天辰工程有限公司</b> CHINA TIANCHEN ENGINEERING CORPORATION	CONTRACTOR DRAWING NO.	MKP-11-AS-8500-PS09-PID-005
		SHEET	01 / TOTAL 01
		SUB-CONTRACTOR DRAWING NO.	
		SHEET	- / TOTAL -

P&ID FLARE STACK II		PROJECT	MKP Methanol Project
		UNIT	Flare
		PHASE	As Built Drawing
SCALE: -	SHEET: 1	TOT: 1	SIZE: A1
OWNER DWG NO.	MKP-11-AS-8500-PR-PID-005		

Counter	Sign	Date

SYMBOLS FOR PROCESS AND INSTRUMENTATION		SYMBOLS FOR PIPING ELEMENTS		LETTER CODE FOR INSTRUMENTATION		LETTER CODE FOR PROCESS EQUIPMENT AND PIPING FITTINGS		IDENTIFICATION:		GENERAL NOTES:		LIST OF DIAGRAMS																																																																																																																																																																																																																																		
PIPES		LINE SYMBOLS		FIRST LETTER		PROCESS EQUIPMENT		PIPE NUMBER:		GENERAL NOTES:		DIAGRAM NUMBER	TITLE	DWG. NO.																																																																																																																																																																																																																																
1	2	3	4	5	6	7	8	9	10	11	12																																																																																																																																																																																																																																			
<p><b>SYMBOLS FOR PROCESS AND INSTRUMENTATION</b></p> <p>PIPES</p> <p>MAIN PROCESS LINE</p> <p>OTHER LINE</p> <p>STEAM TRACING</p> <p>ELECTRIC TRACED</p> <p>TRACED-MEDIA UNSPECIFIED</p> <p>STEAM JACKETED</p> <p>SLOPE DOWN</p> <p>SLOPE UP</p> <p>FREE DRAINING</p> <p>INSTRUMENT LINES</p> <p>CONNECT TO PROCESS OR UNDEFINED SIGNAL</p> <p>PNEUMATIC SIGNAL</p> <p>ELECTRIC SIGNAL</p> <p>ELECTRIC BINARY SIGNAL</p> <p>CAPILLARY TUBE</p> <p>HYDRAULIC SIGNAL</p> <p>DATA LINE OR SOFTWARE</p> <p>MECHANICAL LINK</p> <p>BY VENDOR (B.V.)</p> <p>AUTOMATIC MANIFOLD</p> <p>INSTRUMENT OR FUNCTION</p> <p>INSTRUMENT SURROUNDED BY BOX IS PART OF DISTRIBUTED CONTROL SYSTEM/ESD SYSTEM</p> <p>FIELD MOUNTED</p> <p>BEHIND-PANEL DEVICE (NORM. INACCESSIBLE)</p> <p>AUXILIARY LOCATION (LOCAL PANEL)</p> <p>INTERLOCK FUNCTION (GROUP 1)</p> <p>ESD SYSTEM (GROUP 1)</p> <p>INTERLOCK LOGIC (GROUP 1)</p> <p>SWITCH</p> <p>INSTRUMENT WITH ELECTRIC TRACING</p> <p>TYPICAL EQUIPMENT SYMBOLS</p> <p>CENTRIFUGAL PUMP</p> <p>RECIPROCATING PUMP</p> <p>SUBMERGED PUMP</p> <p>AIR BLOWER</p> <p>VERTICAL PUMP</p> <p>MOTOR</p> <p>EJECTOR</p> <p>TURBINE</p> <p>ROOT'S COMPRESSOR</p> <p>CRANE</p>		<p><b>SYMBOLS FOR PIPING ELEMENTS</b></p> <p>GATE VALVE</p> <p>GLOBE VALVE</p> <p>NEEDLE VALVE</p> <p>BALL VALVE</p> <p>PLUG VALVE</p> <p>DIAPHRAGM VALVE</p> <p>BUTTERFLY VALVE</p> <p>HAND OPERATED CONTROL VALVE</p> <p>SOLENOID VALVE</p> <p>ELECTRIC MOTOR OPERATED VALVE</p> <p>SELF OPERATING BACK PRESSURE REGULATING VALVE</p> <p>SELF OPERATING PRESSURE REDUCING VALVE</p> <p>SPRING VALVE</p> <p>SPRING LOADED RELIEF VALVE</p> <p>SPRING LOADED QUICK CLOSING VALVE-INTERMITTENT BLOW DOWN</p> <p>SPRING LOADED SAFETY RELIEF VALVE</p> <p>SPRING LOADED VACUUM RELIEF VALVE</p> <p>BREATHING VALVE</p> <p>EMERGENCY RELIEF MANHOLE</p> <p>RUPTURE DISC</p> <p>ORIFICE</p> <p>VENTURI</p> <p>FLOW NOZZLE</p> <p>ROTAMETER</p> <p>TURBINE OR PROPELLER TYPE FLOW METER</p> <p>ANNUBAR TYPE FLOW ELEMENT</p> <p>AVERAGE PILOT TUBE OR ANNUBAR</p> <p>POSITIVE DIS-PLACEMENT METER</p> <p>VORTEX FLOWMETER</p> <p>ULTRASONIC FLOWMETER</p> <p>CORIOLIS FLOWMETER</p> <p>MAGNETIC FLOWMETER</p> <p>3-WAY SOLENOID VALVE: ARROW INDICATES STATE WHEN DE-ENERGIZED</p> <p>ELECTRO/PNEUMATIC CONVERTER</p> <p>DAMPER</p> <p>TEST POINT</p>		<p><b>LETTER CODE FOR INSTRUMENTATION</b></p> <p>MEASURED OR INITIATING VARIABLES</p> <p>ANALYSIS</p> <p>BURNER, COMBUSTION</p> <p>VOLTAGE (EMF)</p> <p>FLOW RATE</p> <p>HAND (MANUALLY INITIATED)</p> <p>CURRENT (ELECTRICAL)</p> <p>POWER</p> <p>TIME, TIME SCHEDULE LEVEL</p> <p>MONITORING (MOTORS)</p> <p>PRESSURE, VACUUM</p> <p>QUANTITY</p> <p>RADIOACTIVITY</p> <p>SPEED, FREQUENCY</p> <p>TEMPERATURE</p> <p>MULTIVARIABLE VIBRATION</p> <p>WEIGHT, FORCE</p> <p>UNCLASSIFIED</p> <p>EVENT, STATE, PRESENCE</p> <p>POSITION, DIMENSION</p> <p>RUNNING</p> <p>STOP STATUS</p> <p>LOCAL/REMOTE</p> <p>FAULT</p> <p>READY FOR START</p> <p>HST STOP</p> <p>HS2 START</p> <p>LTM LOAD AND TEMPERATURE MANAGEMENT SYSTEM</p> <p>FF INSTRUMENT</p> <p>SUCCESSING LETTER</p> <p>ALARM</p> <p>CONTROL</p> <p>PRIMARY ELEMENT</p> <p>GLASS, GAUGE</p> <p>INDICATE</p> <p>CONTROL STATION</p> <p>LIGHT</p> <p>MANUAL INPUT</p> <p>ORIFICE (RESTRICTION)</p> <p>POINT (TEST CONN.)</p> <p>RECORD</p> <p>SWITCH</p> <p>TRANSMIT</p> <p>MULTIFUNCTION</p> <p>VALVE, DAMPER, LOUVER</p> <p>WELL</p> <p>UNCLASSIFIED</p> <p>Z</p> <p>ALARM</p> <p>ALARM ON DCS ARE IDENTIFIED BY PLACING INSTRUMENT DESIGNATION ADJACENT TO THE INSTRUMENT SYMBOLS i.e. :</p> <p>HIGH ALARM : UPPER RIGHT SIDE</p> <p>LOW ALARM : LOWER RIGHT SIDE</p> <p>TYPE OF LEVEL GAUGE:</p> <p>B = BICOLOR</p> <p>C = CONDUCTIVITY</p> <p>M = MAGNETIC</p> <p>R = REFLEX</p> <p>T = TRANSPARENT</p> <p>GENERAL NOTE:</p> <p>1. LETTER CODE FOR INSTRUMENTATION: IDENTIFICATION LETTERS ARE IN ACCORDANCE WITH ANSI-ISA-5.1</p> <p>2. ALL GAS AND STEAM FLOW MEASUREMENTS IN DCS-ARE PRESSURE AND TEMPERATURE COMPENSATED</p>		<p><b>LETTER CODE FOR PROCESS EQUIPMENT AND PIPING FITTINGS</b></p> <p>PROCESS EQUIPMENT</p> <p>PROCESS FILTER</p> <p>COOLER, CONDENSER</p> <p>BLOWER, DRUM</p> <p>COMPRESSOR</p> <p>VESSEL, SEPARATOR</p> <p>HEAT EXCHANGER</p> <p>FAN</p> <p>TURBINE</p> <p>ALTERNATOR</p> <p>HEATER</p> <p>NOT TO BE USED</p> <p>EJECTOR</p> <p>ELECTRICAL EQUIPMENT</p> <p>ELECTRIC MOTOR (PREFIX TO K, P, W OR X)</p> <p>CONVEYER</p> <p>NOT TO BE USED</p> <p>PUMP</p> <p>AVAILABLE</p> <p>REACTOR, CONVERTER</p> <p>STACK, STRUCTURE</p> <p>COLUMN, TOWER</p> <p>TANK, STORAGE</p> <p>FOUNDATION</p> <p>FOUNDATION (PREFIX TO B, D, E, F, H, R, T ETC.)</p> <p>VENT, FLARE</p> <p>ELEVATOR</p> <p>MISCELLANEOUS EQUIPMENT</p> <p>INTERNAL (HARDWARE)</p> <p>INTERNAL (CATALYST)</p> <p>INTERNAL (CATALYST) (PREFIX TO R)</p> <p>MULTIFUNCTIONAL HYDRAULIC CONTROL VALVE</p> <p>POND</p> <p>RESIN TRAPPER</p> <p>FOR SUMP</p> <p>PIPING FITTINGS</p> <p>AUTOMATIC RECIRCULATION VALVE</p> <p>BLOW DOWN VALVE</p> <p>EMERGENCY RELIEF MANHOLE</p> <p>FLAME ARRESTOR/DEMISTER</p> <p>RESTRICTION ORIFICE</p> <p>FLEXIBLE CONNECTION</p> <p>SPRAY NOZZLE</p> <p>MINIMUM STOP VALVE</p> <p>MIXER</p> <p>OVER FLOW</p> <p>SAFETY RELIEF VALVES</p> <p>PRESSURE AND VACUUM RELIEF VALVE (BREATHING VALVE)</p> <p>RUPTURE DISC</p> <p>SAFETY SHOWER AND EYE WASHER</p> <p>SPECIAL PIPING ELEMENT</p> <p>STEAM TRAP</p> <p>STRAINER</p> <p>SIGHT GLASS</p> <p>HOSE</p> <p>DESIGNATION OF NOZZLES ON PROCESS EQUIPMENT</p> <p>INLET</p> <p>OUTLET</p> <p>DRAIN</p> <p>LEVEL SWITCH</p> <p>LEVEL GAUGE</p> <p>HANDHOLE</p> <p>LEVEL INSTRUMENT</p> <p>MANHOLE</p> <p>SAMPLE CONNECTION</p> <p>PRESSURE MEASUREMENT</p> <p>SAFETY VALVE</p> <p>TEMPERATURE MEASUREMENT</p> <p>UTILITY</p> <p>VENT</p>		<p><b>IDENTIFICATION:</b></p> <p>PIPE NUMBER:</p> <p>INSULATION CLASS</p> <p>INSULATION PURPOSE</p> <p>PIPE CLASS CODE</p> <p>SEQUENCE NUMBER</p> <p>UNIT NUMBER</p> <p>FLUID CODE</p> <p>NOMINAL DIAMETER</p> <p>EQUIPMENT NUMBER:</p> <p>MAIN STAND BY</p> <p>FIRST OF TWO PARTS</p> <p>SERIAL NUMBER</p> <p>UNIT NUMBER</p> <p>EQUIPMENT GROUP LETTER</p> <p>INSTRUMENT NUMBER:</p> <p>MAIN STAND BY</p> <p>FIRST OF TWO PARTS</p> <p>LOOP OR INSTRUMENT NUMBER</p> <p>FUNCTIONAL IDENTIFICATION</p> <p>FLUID CODES:</p> <p>AM AMMONIA WATER</p> <p>BD BOILER BLOW DOWN</p> <p>BFW BOILER FEED WATER</p> <p>BW WARM UP WATER</p> <p>CBD CONTINUOUS BLOW DOWN</p> <p>CD CLOSED DRAIN</p> <p>CH1 CORROSION INHIBITOR SOLUTION</p> <p>CH2 ANTISCALE SOLUTION</p> <p>CLO Co(OH)<sub>2</sub> SOLUTION</p> <p>CS CAUSTIC SOLUTION</p> <p>CSW CLEAN SALTY WATER</p> <p>CWR COOLING WATER RETURN</p> <p>CWS COOLING WATER SUPPLY</p> <p>DR DRAIN</p> <p>DMW DEMINERALIZED WATER</p> <p>FF FOAM SOLUTION</p> <p>FC FUEL GAS</p> <p>FLG FLARE VENT GAS</p> <p>FW FIRE FIGHTING WATER</p> <p>HG HYDROGEN GAS</p> <p>HHP HHP HIGH PRESSURE STEAM CONDENSATE</p> <p>HHS HIGH HIGH PRESSURE STEAM</p> <p>HPC HIGH PRESSURE CONDENSATE</p> <p>HPS HIGH PRESSURE STEAM</p> <p>OX OXYGEN SCAVENGER</p> <p>IA INSTRUMENT AIR</p> <p>LO LUBRICANT OIL</p> <p>LOS LIQUID OFF STREAM METHANOL</p> <p>LPC LOW PRESSURE STEAM CONDENSATE</p> <p>LP LOW PRESSURE STEAM</p> <p>MC CONDENSATE LIQUID</p> <p>METHANOL</p> <p>MPC MEDIUM PRESSURE STEAM CONDENSATE</p> <p>MPS MEDIUM PRESSURE STEAM</p> <p>N NITROGEN</p> <p>NG NATURAL GAS</p> <p>NS NaOH SOLUTION</p> <p>OW OILY WATER</p> <p>PA PROCESS AIR</p> <p>PH OFF GAS</p> <p>PMC PHOSPHATE SOLUTION</p> <p>PMV CRUDE METHANOL</p> <p>PMP RICH METHANOL LIQUID</p> <p>PO RICH METHANOL GAS</p> <p>PW METHANOL WATER</p> <p>POC PROCESS OXYGEN</p> <p>PRC POTENTIALLY OILY CONTAMINATE WATER</p> <p>PRG PROCESS CONDENSATE</p> <p>RW RO WATER</p> <p>RFG REFORMED GAS</p> <p>RG RYNTHESIS GAS</p> <p>SN SANITARY SEWAGE</p> <p>SU H2SO4 SOLUTION (98%)</p> <p>SW SERVICE WATER</p> <p>VA TURBINE CONDENSATE</p> <p>VE VENT TO ATMOSPHERE</p> <p>VG VENT EXTRACTION</p> <p>VG VENT GAS</p>		<p><b>GENERAL NOTES:</b></p> <p>1) LOOP TAG NUMBERING EG. FHS, FHC.</p> <p>F = LOOP DESIGNATION</p> <p>H = HAND</p> <p>S = SWITCH</p> <p>I = INDICATING</p> <p>C = CONTROLLER</p> <p>2) AUTOSTART:</p> <p>FAILURE OF RUNNING PUMP TO START STANDBY PUMP.</p> <p><b>IDENTIFICATION:</b></p> <p>VALVE STATE</p> <p>CSC CAR SEALED CLOSED</p> <p>CSO CAR SEALED OPEN</p> <p>FO FAILURE OPEN</p> <p>FCO FAILURE CLOSED</p> <p>FL FAILURE LOCKED</p> <p>FLO FAILURE LOCKED OPEN</p> <p>FLC FAILURE LOCKED CLOSED</p> <p>LO LOCKED OPEN</p> <p>LC LOCKED CLOSED</p> <p>NO NORMALLY OPEN</p> <p>NC NORMALLY CLOSED</p> <p>C COLD INSULATED</p> <p>H HOT INSULATED</p> <p>N NOT INSULATED</p> <p>P PERSONNEL PROTECTION INSULATED</p> <p>HEAT TRACING CODES:</p> <p>ET ELECTRIC TRACED</p> <p>ST STEAM TRACED</p> <p>SJ STEAM JACKETED</p> <p>TR TRACED-MEDIA UNSPECIFIED</p> <p>PIPE CLASS CODES:</p> <p>FIRST LETTER INDICATES FLANGE RATING:</p> <p>B = class 150</p> <p>D = class 300</p> <p>F = class 600</p> <p>G = class 900</p> <p>H = class 1500</p> <p>J = class 2500</p> <p>NUMBER</p> <p>24 = CS</p> <p>34 = P11</p> <p>36 = P22</p> <p>40 = SS304L</p> <p>42 = SS316L</p> <p>44 = SS321</p> <p>50 = SS304</p> <p>64 = SS321H</p> <p>66 = SS347H</p> <p>70 = MNL</p> <p>EXAMPLE: B24</p> <p>MISCELLANEOUS:</p> <p>CIA = CS class 150 RF</p> <p>GIA = CS / GALV class 150 RF</p> <p>GIB = CS / GALV class 150 RF</p> <p>LIA = CS / PVC LINED class 150 RF</p> <p>NOA = PVC-U GRAVITY FLOW</p> <p>NOC = PE GRAVITY FLOW</p> <p>NZA = GRP class 150 RF</p> <p>NZB = HDPE class 150 RF</p> <p>NZC = PVC-C FN16 FF</p> <p>NZD = PP-R FN16 FF</p> <p>UTA = CS PIPE COATED class 150 RF</p> <p>B24U = As Built</p> <p>B24 FOR UNDERGROUND</p>		<p><b>LIST OF DIAGRAMS</b></p> <table border="1"> <thead> <tr> <th>DIAGRAM NUMBER</th> <th>TITLE</th> <th>DWG. NO.</th> </tr> </thead> <tbody> <tr><td>S01</td><td>SYMBOLS AND IDENTIFICATIONS</td><td>1341708</td></tr> <tr><td>S02</td><td>SYMBOLS AND IDENTIFICATIONS</td><td>1341709</td></tr> <tr><td>P01</td><td>NATURAL GAS DISTRIBUTION</td><td>1341711</td></tr> <tr><td>P02</td><td>PROCESS OXYGEN</td><td>1341712</td></tr> <tr><td>P03</td><td>OXYGEN PREHEATING</td><td>1341713</td></tr> <tr><td>P04</td><td>DESULPHURISATION</td><td>1341714</td></tr> <tr><td>P05</td><td>STEAM CONDENSATE RETURN</td><td>1341715</td></tr> <tr><td>P06</td><td>NG SATURATION I</td><td>1341716</td></tr> <tr><td>P07</td><td>NG SATURATION II</td><td>1341717</td></tr> <tr><td>P08</td><td>NG SATURATION III</td><td>1341718</td></tr> <tr><td>P09</td><td>S C RATIO CONTROL I</td><td>1341719</td></tr> <tr><td>P10</td><td>S C RATIO CONTROL II</td><td>1341720</td></tr> <tr><td>P11</td><td>FLUE GAS WHS I</td><td>1341721</td></tr> <tr><td>P12</td><td>FLUE GAS WHS II</td><td>1341722</td></tr> <tr><td>P13</td><td>FLUE GAS WHS III</td><td>1341723</td></tr> <tr><td>P14</td><td>FLUE GAS WHS IV</td><td>1341724</td></tr> <tr><td>P15</td><td>TUBULAR REFORMER</td><td>1341725</td></tr> <tr><td>P16A</td><td>SECONDARY REFORMER I</td><td>1341726</td></tr> <tr><td>P16B</td><td>SECONDARY REFORMER II</td><td>1341727</td></tr> <tr><td>P17</td><td>STEAM SUPERHEATER</td><td>1341727</td></tr> <tr><td>P18</td><td>STEAM GENERATION</td><td>1341728</td></tr> <tr><td>P19</td><td>GAS COOLING AND SEPARATION I</td><td>1341729</td></tr> <tr><td>P20</td><td>GAS COOLING AND SEPARATION II</td><td>1341730</td></tr> <tr><td>P21</td><td>GAS COOLING AND SEPARATION III</td><td>1341731</td></tr> <tr><td>P22</td><td>SYNTHESIS GAS COMPRESSOR</td><td>1341732</td></tr> <tr><td>P23</td><td>SYNTHESIS, PART I</td><td>1341733</td></tr> <tr><td>P24</td><td>METHANOL SYNTHESIS</td><td>1341734</td></tr> <tr><td>P25</td><td>METHANOL F E EXCHANGER</td><td>1341735</td></tr> <tr><td>P26</td><td>SYNTHESIS GAS COOLING</td><td>1341736</td></tr> <tr><td>P27</td><td>SYNTHESIS, PART II</td><td>1341737</td></tr> <tr><td>P28</td><td>RAW PRODUCT FLASH</td><td>1341738</td></tr> <tr><td>P29</td><td>CRUDE METHANOL TANK</td><td>1341739</td></tr> <tr><td>P30</td><td>STABILIZER COLUMN</td><td>1341740</td></tr> <tr><td>P31</td><td>STABILIZER COLUMN REBOILER</td><td>1341741</td></tr> <tr><td>P32</td><td>STABILIZER COLUMN OH SYSTEM</td><td>1341742</td></tr> <tr><td>P33</td><td>STABILIZER COLUMN PUMPS</td><td>1341743</td></tr> <tr><td>P34</td><td>LP METHANOL COLUMN</td><td>1341744</td></tr> <tr><td>P35</td><td>LP METHANOL COLUMN REBOILER</td><td>1341745</td></tr> <tr><td>P36</td><td>LP METHANOL COLUMN OH SYSTEM</td><td>1341746</td></tr> <tr><td>P37</td><td>MP METHANOL COLUMN FEED PUMP</td><td>1341747</td></tr> <tr><td>P38</td><td>MP METHANOL COLUMN</td><td>1341748</td></tr> <tr><td>P39</td><td>MP COLUMN REBOILERS</td><td>1341749</td></tr> <tr><td>P40</td><td>MP METHANOL COLUMN OH SYSTEM</td><td>1341750</td></tr> <tr><td>P41</td><td>MP METHANOL COLUMN BY PRODUCT</td><td>1341751</td></tr> <tr><td>P42</td><td>METHANOL PRODUCT</td><td>1341752</td></tr> <tr><td>P43</td><td>METHANOL PRODUCT BUFFER TANK I</td><td>1341753</td></tr> <tr><td>P44</td><td>METHANOL PRODUCT BUFFER TANK II</td><td>1341754</td></tr> <tr><td>P45</td><td>LIQUID OFF-STREAM TANK</td><td>1341755</td></tr> <tr><td>U01</td><td>FUEL SYSTEM</td><td>1341757</td></tr> <tr><td>U02</td><td>START-UP BLOWER</td><td>1341758</td></tr> <tr><td>U03</td><td>HHP-HP CONTROL STEAM</td><td>1341759</td></tr> <tr><td>U04</td><td>HP STEAM EXPORT IMPORT</td><td>1341760</td></tr> <tr><td>U05</td><td>MP AND LP STEAM CONTROL</td><td>1341761</td></tr> <tr><td>U06</td><td>LP STEAM CONTROL</td><td>1341762</td></tr> <tr><td>U07</td><td>HHP AND HP STEAM HEADER</td><td>1341763</td></tr> <tr><td>U08</td><td>LP STEAM HEADER</td><td>1341764</td></tr> <tr><td>U09</td><td>DEAERATOR</td><td>1341765</td></tr> <tr><td>U10</td><td>BFW PUMPS</td><td>1341766</td></tr> <tr><td>U11</td><td>BFW HEADER</td><td>1341767</td></tr> <tr><td>U12</td><td>PHOSPHATE DOSING UNIT-X 7001</td><td>1341768</td></tr> <tr><td>U13</td><td>AMINE DOSING UNIT-X 7002</td><td>1341769</td></tr> <tr><td>U14</td><td>OXYGEN SCAV. DOSING UNIT-X 7003</td><td>1341770</td></tr> <tr><td>U15</td><td>MORPHOLINE DOSING UNIT</td><td>1341771</td></tr> <tr><td>U16</td><td>BOILER BLOW DOWN</td><td>1341772</td></tr> <tr><td>U17</td><td>H2 RECYCLE SYSTEM</td><td>1341773</td></tr> <tr><td>U18</td><td>DEMINERALIZED WATER STORAGE</td><td>1341774</td></tr> <tr><td>U19</td><td>FLARE HEADER I</td><td>1341775</td></tr> <tr><td>U20</td><td>FLARE HEADER II</td><td>1341776</td></tr> <tr><td>U21</td><td>FLARE STACK</td><td>1341777</td></tr> <tr><td>U22</td><td>PROCESS CONDENSATE STORAGE</td><td>1353319</td></tr> <tr><td>U23A</td><td>ION EXCHANGE UNIT (OPTIONAL)</td><td>1353320</td></tr> <tr><td>U23B</td><td>ION EXCHANGE UNIT (OPTIONAL)</td><td>1353321</td></tr> <tr><td>U24</td><td>NO.01 DOSING UNIT X 5003</td><td>1353322</td></tr> <tr><td>U25</td><td>LIQUID OFF-STREAM STRIPPER</td><td>1354612</td></tr> </tbody> </table>		DIAGRAM NUMBER	TITLE	DWG. NO.	S01	SYMBOLS AND IDENTIFICATIONS	1341708	S02	SYMBOLS AND IDENTIFICATIONS	1341709	P01	NATURAL GAS DISTRIBUTION	1341711	P02	PROCESS OXYGEN	1341712	P03	OXYGEN PREHEATING	1341713	P04	DESULPHURISATION	1341714	P05	STEAM CONDENSATE RETURN	1341715	P06	NG SATURATION I	1341716	P07	NG SATURATION II	1341717	P08	NG SATURATION III	1341718	P09	S C RATIO CONTROL I	1341719	P10	S C RATIO CONTROL II	1341720	P11	FLUE GAS WHS I	1341721	P12	FLUE GAS WHS II	1341722	P13	FLUE GAS WHS III	1341723	P14	FLUE GAS WHS IV	1341724	P15	TUBULAR REFORMER	1341725	P16A	SECONDARY REFORMER I	1341726	P16B	SECONDARY REFORMER II	1341727	P17	STEAM SUPERHEATER	1341727	P18	STEAM GENERATION	1341728	P19	GAS COOLING AND SEPARATION I	1341729	P20	GAS COOLING AND SEPARATION II	1341730	P21	GAS COOLING AND SEPARATION III	1341731	P22	SYNTHESIS GAS COMPRESSOR	1341732	P23	SYNTHESIS, PART I	1341733	P24	METHANOL SYNTHESIS	1341734	P25	METHANOL F E EXCHANGER	1341735	P26	SYNTHESIS GAS COOLING	1341736	P27	SYNTHESIS, PART II	1341737	P28	RAW PRODUCT FLASH	1341738	P29	CRUDE METHANOL TANK	1341739	P30	STABILIZER COLUMN	1341740	P31	STABILIZER COLUMN REBOILER	1341741	P32	STABILIZER COLUMN OH SYSTEM	1341742	P33	STABILIZER COLUMN PUMPS	1341743	P34	LP METHANOL COLUMN	1341744	P35	LP METHANOL COLUMN REBOILER	1341745	P36	LP METHANOL COLUMN OH SYSTEM	1341746	P37	MP METHANOL COLUMN FEED PUMP	1341747	P38	MP METHANOL COLUMN	1341748	P39	MP COLUMN REBOILERS	1341749	P40	MP METHANOL COLUMN OH SYSTEM	1341750	P41	MP METHANOL COLUMN BY PRODUCT	1341751	P42	METHANOL PRODUCT	1341752	P43	METHANOL PRODUCT BUFFER TANK I	1341753	P44	METHANOL PRODUCT BUFFER TANK II	1341754	P45	LIQUID OFF-STREAM TANK	1341755	U01	FUEL SYSTEM	1341757	U02	START-UP BLOWER	1341758	U03	HHP-HP CONTROL STEAM	1341759	U04	HP STEAM EXPORT IMPORT	1341760	U05	MP AND LP STEAM CONTROL	1341761	U06	LP STEAM CONTROL	1341762	U07	HHP AND HP STEAM HEADER	1341763	U08	LP STEAM HEADER	1341764	U09	DEAERATOR	1341765	U10	BFW PUMPS	1341766	U11	BFW HEADER	1341767	U12	PHOSPHATE DOSING UNIT-X 7001	1341768	U13	AMINE DOSING UNIT-X 7002	1341769	U14	OXYGEN SCAV. DOSING UNIT-X 7003	1341770	U15	MORPHOLINE DOSING UNIT	1341771	U16	BOILER BLOW DOWN	1341772	U17	H2 RECYCLE SYSTEM	1341773	U18	DEMINERALIZED WATER STORAGE	1341774	U19	FLARE HEADER I	1341775	U20	FLARE HEADER II	1341776	U21	FLARE STACK	1341777	U22	PROCESS CONDENSATE STORAGE	1353319	U23A	ION EXCHANGE UNIT (OPTIONAL)	1353320	U23B	ION EXCHANGE UNIT (OPTIONAL)	1353321	U24	NO.01 DOSING UNIT X 5003	1353322	U25	LIQUID OFF-STREAM STRIPPER	1354612
DIAGRAM NUMBER	TITLE	DWG. NO.																																																																																																																																																																																																																																												
S01	SYMBOLS AND IDENTIFICATIONS	1341708																																																																																																																																																																																																																																												
S02	SYMBOLS AND IDENTIFICATIONS	1341709																																																																																																																																																																																																																																												
P01	NATURAL GAS DISTRIBUTION	1341711																																																																																																																																																																																																																																												
P02	PROCESS OXYGEN	1341712																																																																																																																																																																																																																																												
P03	OXYGEN PREHEATING	1341713																																																																																																																																																																																																																																												
P04	DESULPHURISATION	1341714																																																																																																																																																																																																																																												
P05	STEAM CONDENSATE RETURN	1341715																																																																																																																																																																																																																																												
P06	NG SATURATION I	1341716																																																																																																																																																																																																																																												
P07	NG SATURATION II	1341717																																																																																																																																																																																																																																												
P08	NG SATURATION III	1341718																																																																																																																																																																																																																																												
P09	S C RATIO CONTROL I	1341719																																																																																																																																																																																																																																												
P10	S C RATIO CONTROL II	1341720																																																																																																																																																																																																																																												
P11	FLUE GAS WHS I	1341721																																																																																																																																																																																																																																												
P12	FLUE GAS WHS II	1341722																																																																																																																																																																																																																																												
P13	FLUE GAS WHS III	1341723																																																																																																																																																																																																																																												
P14	FLUE GAS WHS IV	1341724																																																																																																																																																																																																																																												
P15	TUBULAR REFORMER	1341725																																																																																																																																																																																																																																												
P16A	SECONDARY REFORMER I	1341726																																																																																																																																																																																																																																												
P16B	SECONDARY REFORMER II	1341727																																																																																																																																																																																																																																												
P17	STEAM SUPERHEATER	1341727																																																																																																																																																																																																																																												
P18	STEAM GENERATION	1341728																																																																																																																																																																																																																																												
P19	GAS COOLING AND SEPARATION I	1341729																																																																																																																																																																																																																																												
P20	GAS COOLING AND SEPARATION II	1341730																																																																																																																																																																																																																																												
P21	GAS COOLING AND SEPARATION III	1341731																																																																																																																																																																																																																																												
P22	SYNTHESIS GAS COMPRESSOR	1341732																																																																																																																																																																																																																																												
P23	SYNTHESIS, PART I	1341733																																																																																																																																																																																																																																												
P24	METHANOL SYNTHESIS	1341734																																																																																																																																																																																																																																												
P25	METHANOL F E EXCHANGER	1341735																																																																																																																																																																																																																																												
P26	SYNTHESIS GAS COOLING	1341736																																																																																																																																																																																																																																												
P27	SYNTHESIS, PART II	1341737																																																																																																																																																																																																																																												
P28	RAW PRODUCT FLASH	1341738																																																																																																																																																																																																																																												
P29	CRUDE METHANOL TANK	1341739																																																																																																																																																																																																																																												
P30	STABILIZER COLUMN	1341740																																																																																																																																																																																																																																												
P31	STABILIZER COLUMN REBOILER	1341741																																																																																																																																																																																																																																												
P32	STABILIZER COLUMN OH SYSTEM	1341742																																																																																																																																																																																																																																												
P33	STABILIZER COLUMN PUMPS	1341743																																																																																																																																																																																																																																												
P34	LP METHANOL COLUMN	1341744																																																																																																																																																																																																																																												
P35	LP METHANOL COLUMN REBOILER	1341745																																																																																																																																																																																																																																												
P36	LP METHANOL COLUMN OH SYSTEM	1341746																																																																																																																																																																																																																																												
P37	MP METHANOL COLUMN FEED PUMP	1341747																																																																																																																																																																																																																																												
P38	MP METHANOL COLUMN	1341748																																																																																																																																																																																																																																												
P39	MP COLUMN REBOILERS	1341749																																																																																																																																																																																																																																												
P40	MP METHANOL COLUMN OH SYSTEM	1341750																																																																																																																																																																																																																																												
P41	MP METHANOL COLUMN BY PRODUCT	1341751																																																																																																																																																																																																																																												
P42	METHANOL PRODUCT	1341752																																																																																																																																																																																																																																												
P43	METHANOL PRODUCT BUFFER TANK I	1341753																																																																																																																																																																																																																																												
P44	METHANOL PRODUCT BUFFER TANK II	1341754																																																																																																																																																																																																																																												
P45	LIQUID OFF-STREAM TANK	1341755																																																																																																																																																																																																																																												
U01	FUEL SYSTEM	1341757																																																																																																																																																																																																																																												
U02	START-UP BLOWER	1341758																																																																																																																																																																																																																																												
U03	HHP-HP CONTROL STEAM	1341759																																																																																																																																																																																																																																												
U04	HP STEAM EXPORT IMPORT	1341760																																																																																																																																																																																																																																												
U05	MP AND LP STEAM CONTROL	1341761																																																																																																																																																																																																																																												
U06	LP STEAM CONTROL	1341762																																																																																																																																																																																																																																												
U07	HHP AND HP STEAM HEADER	1341763																																																																																																																																																																																																																																												
U08	LP STEAM HEADER	1341764																																																																																																																																																																																																																																												
U09	DEAERATOR	1341765																																																																																																																																																																																																																																												
U10	BFW PUMPS	1341766																																																																																																																																																																																																																																												
U11	BFW HEADER	1341767																																																																																																																																																																																																																																												
U12	PHOSPHATE DOSING UNIT-X 7001	1341768																																																																																																																																																																																																																																												
U13	AMINE DOSING UNIT-X 7002	1341769																																																																																																																																																																																																																																												
U14	OXYGEN SCAV. DOSING UNIT-X 7003	1341770																																																																																																																																																																																																																																												
U15	MORPHOLINE DOSING UNIT	1341771																																																																																																																																																																																																																																												
U16	BOILER BLOW DOWN	1341772																																																																																																																																																																																																																																												
U17	H2 RECYCLE SYSTEM	1341773																																																																																																																																																																																																																																												
U18	DEMINERALIZED WATER STORAGE	1341774																																																																																																																																																																																																																																												
U19	FLARE HEADER I	1341775																																																																																																																																																																																																																																												
U20	FLARE HEADER II	1341776																																																																																																																																																																																																																																												
U21	FLARE STACK	1341777																																																																																																																																																																																																																																												
U22	PROCESS CONDENSATE STORAGE	1353319																																																																																																																																																																																																																																												
U23A	ION EXCHANGE UNIT (OPTIONAL)	1353320																																																																																																																																																																																																																																												
U23B	ION EXCHANGE UNIT (OPTIONAL)	1353321																																																																																																																																																																																																																																												
U24	NO.01 DOSING UNIT X 5003	1353322																																																																																																																																																																																																																																												
U25	LIQUID OFF-STREAM STRIPPER	1354612																																																																																																																																																																																																																																												

THIS DOCUMENT IS THE PROPERTY OF TCC. NO PART OF THIS DOCUMENT SHALL BE REPRODUCED OR DISCLOSED TO OTHERS OR USED FOR ANY PURPOSE WHATSOEVER EXCEPT WITH THE PRIOR WRITTEN PERMISSION OF TCC.

OWNER: Middle East Kimiaye Pars Company

HALDOR TOPSØE A/S	DOCUMENT NAME: SYMBOLS AND IDENTIFICATIONS FOR PIPING AND INSTRUMENT DIAGRAM(1)	DATE: 02.12.2018	REV: 42
CONTRACTOR DRAWING NO. MKP-11-AS-9000-PS07-PID-001		SHEET 01 TOTAL 01	
SUB-CONTRACTOR DRAWING NO.		SHEET - TOTAL -	

SYMBOLS AND IDENTIFICATIONS FOR PIPING AND INSTRUMENT DIAGRAM(1)

PROJECT: MKP Methanol Project

UNIT: General Technical


PHASE: As Built Drawing

OWNER DWG. NO.: MKP-11-AS-9000-PR-PID-001

SCALE: -	SHEET: 1	TOT: 1	SIZE: A1
Counter Signing	Sign	Date	



VARIOUS SYMBOLS

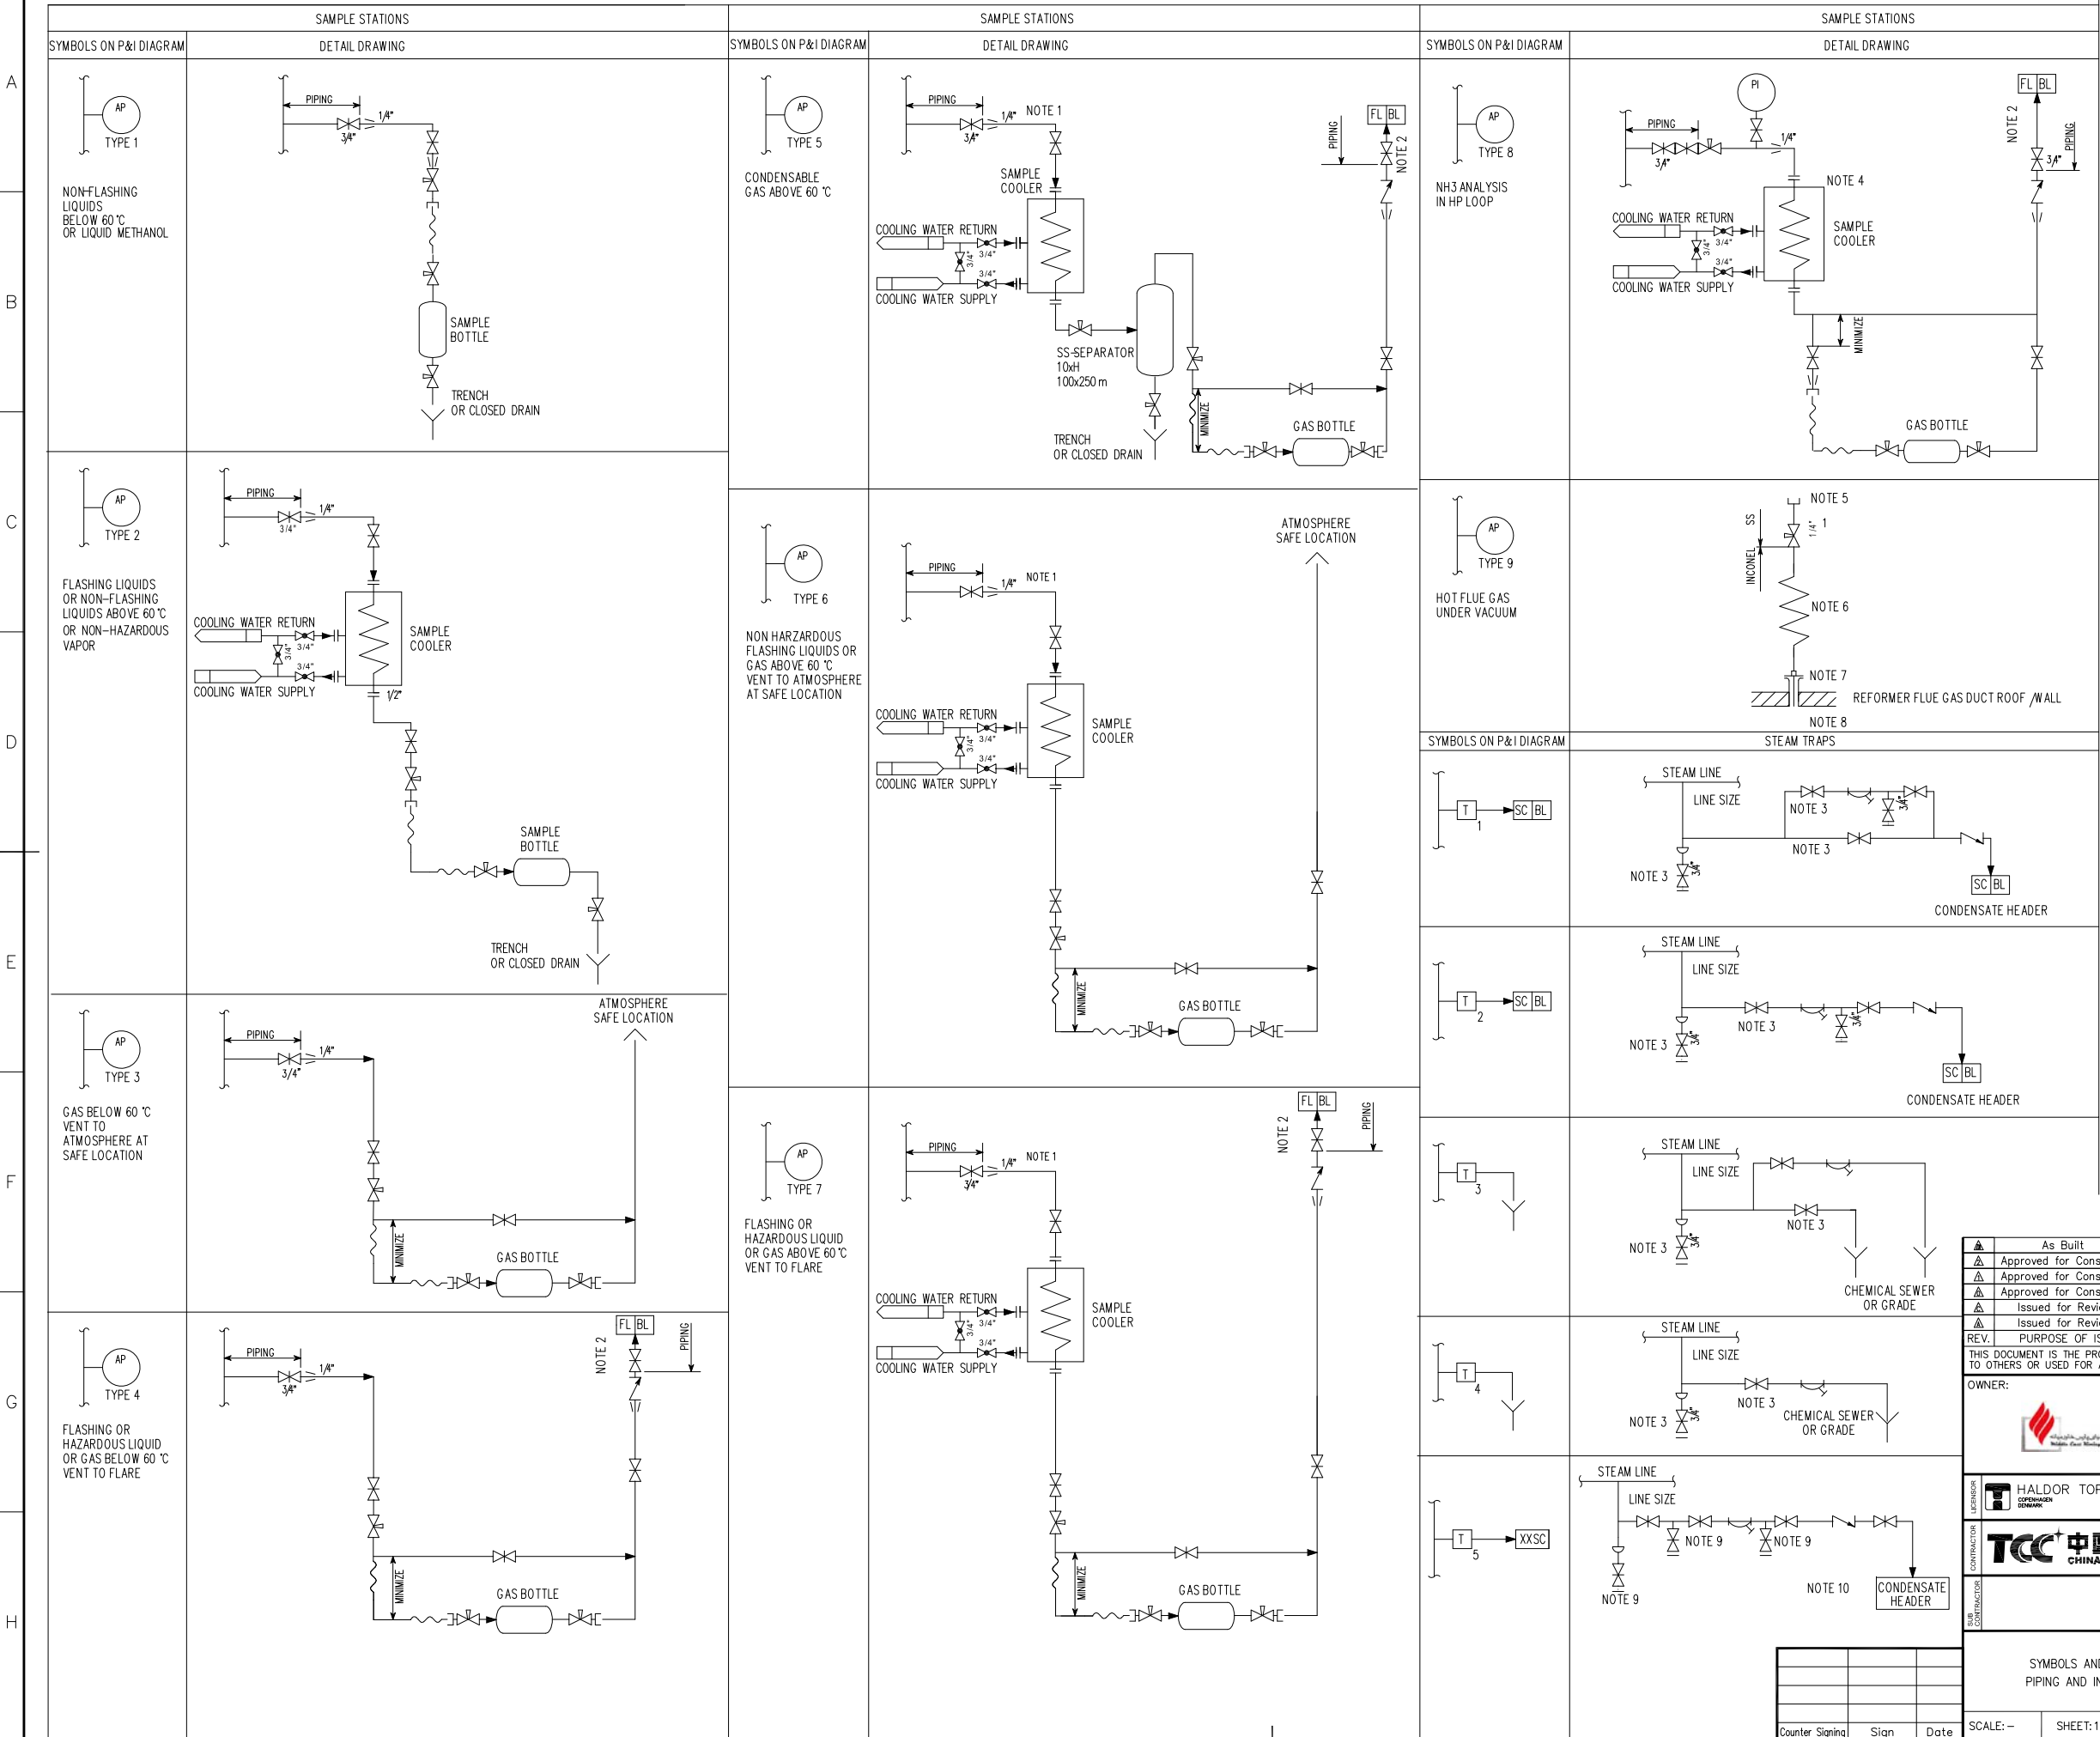

- NOTES:
- 1) MINIMUM 4m BARE TUBE FOR AIR COOLING BEFORE ENTERING WATER COOLER.
  - 2) VALVE TO FLARE TO BE IN ACCORDANCE WITH PROCESS PIPE CLASS.
  - 3) VALVES TO BE DOUBLED IN HIGH PRESSURE SYSTEMS.
  - 4) SAMPLE COOLER TO BE OMITTED IF TEMPERATURE <math>< 60^{\circ}\text{C}</math>.
  - 5) CONNECTION TO SUIT PORTABLE SAMPLE BOTTLE WITH VACUUM PUMP OR PORTABLE ANALYSER.
  - 6) MIN 4m OF BARE 1/4" INCONEL TUBE.
  - 7) CONAX FITTING WITH LAVA SEAL.
  - 8) TUBE INSERTED CLOSE TO EDGE OF BRICK WORK.
  - 9) THE PRINCIPLE FOR DRAIN VALVES AS FOLLOWS:
    - A. USING ONE SHUT-OFF VALVE AND THREADED PIPE CAP IF PIPE CLASS LESS THAN CLASS 600.
    - B. USING TWO SHUT-OFF VALVES AND BLIND FLANGE IF PIPE CLASS EQUAL OR MORE THAN CLASS 600, BUT LESS THAN CLASS 1500.
    - C. USING TWO WELDING SHUT-OFF VALVES AND ONE SHORT PIPE IN THE END IF PIPE CLASS EQUAL CLASS 1500.
  - 10) THE PRINCIPLE FOR STEAM CONDENSATE HEADER AS FOLLOWS:
    - A. FOR HHPs STEAM PIPE, CONDENSATE HEADER HHPSC.
    - B. FOR HPS AND MPS STEAM PIPE, CONDENSATE HEADER HPSC.
    - C. FOR LPS STEAM PIPE, CONDENSATE HEADER LPS.

- GENERAL NOTES:
- 1) REQUIREMENTS FOR TRACING TO BE CONSIDERED.
  - 2) ALL SAMPLE CONNECTIONS SHALL BE FROM TOP OF PROCESS PIPE.
  - 3) ALL SAMPLE TUBING TO BE 1/4" SS.

As Built	30.04.2020	Xu Yekun		Xu Hang	Liu Shengkai
Approved for Construction	06.11.2017	Xu Yekun		Xu Hang	Liu Shengkai
Approved for Construction	22.03.2017	Xu Yekun		Xu Hang	Liu Shengkai
Approved for Construction	22.01.2017	Xu Yekun		Xu Hang	Liu Shengkai
Issued for Review	10.10.2016	Jiang Yu		Xu Hang	Liu Shengkai
Issued for Review	25.06.2016	Jiang Yu		Xu Hang	Liu Shengkai

OWNER: Middle East Kimiye Pars Company

HALDOR TOPSØE A/S

CONTRACTOR: TCC 中國天辰工程有限公司 CHINA TIANCHEN ENGINEERING CORPORATION



CONTRACTOR DRAWING NO.	MKP-11-AS-9000-PS07-PID-002
SHEET	01 TOTAL 01
SUB-CONTRACTOR DRAWING NO.	
SHEET	TOTAL

SYMBOLS AND IDENTIFICATIONS FOR PIPING AND INSTRUMENT DIAGRAM(2)	PROJECT	MKP Methanol Project
	UNIT	General Technical
	PHASE	As Built Drawing
SCALE: - SHEET: 1 TOT.: 1 SIZE: A1	OWNER DWG NO.	MKP-11-AS-9000-PR-PID-002

Counter	Signing	Sign	Date

SYMBOLS FOR TYPICAL MCC

SYMBOLS FOR TYPICAL VALVE

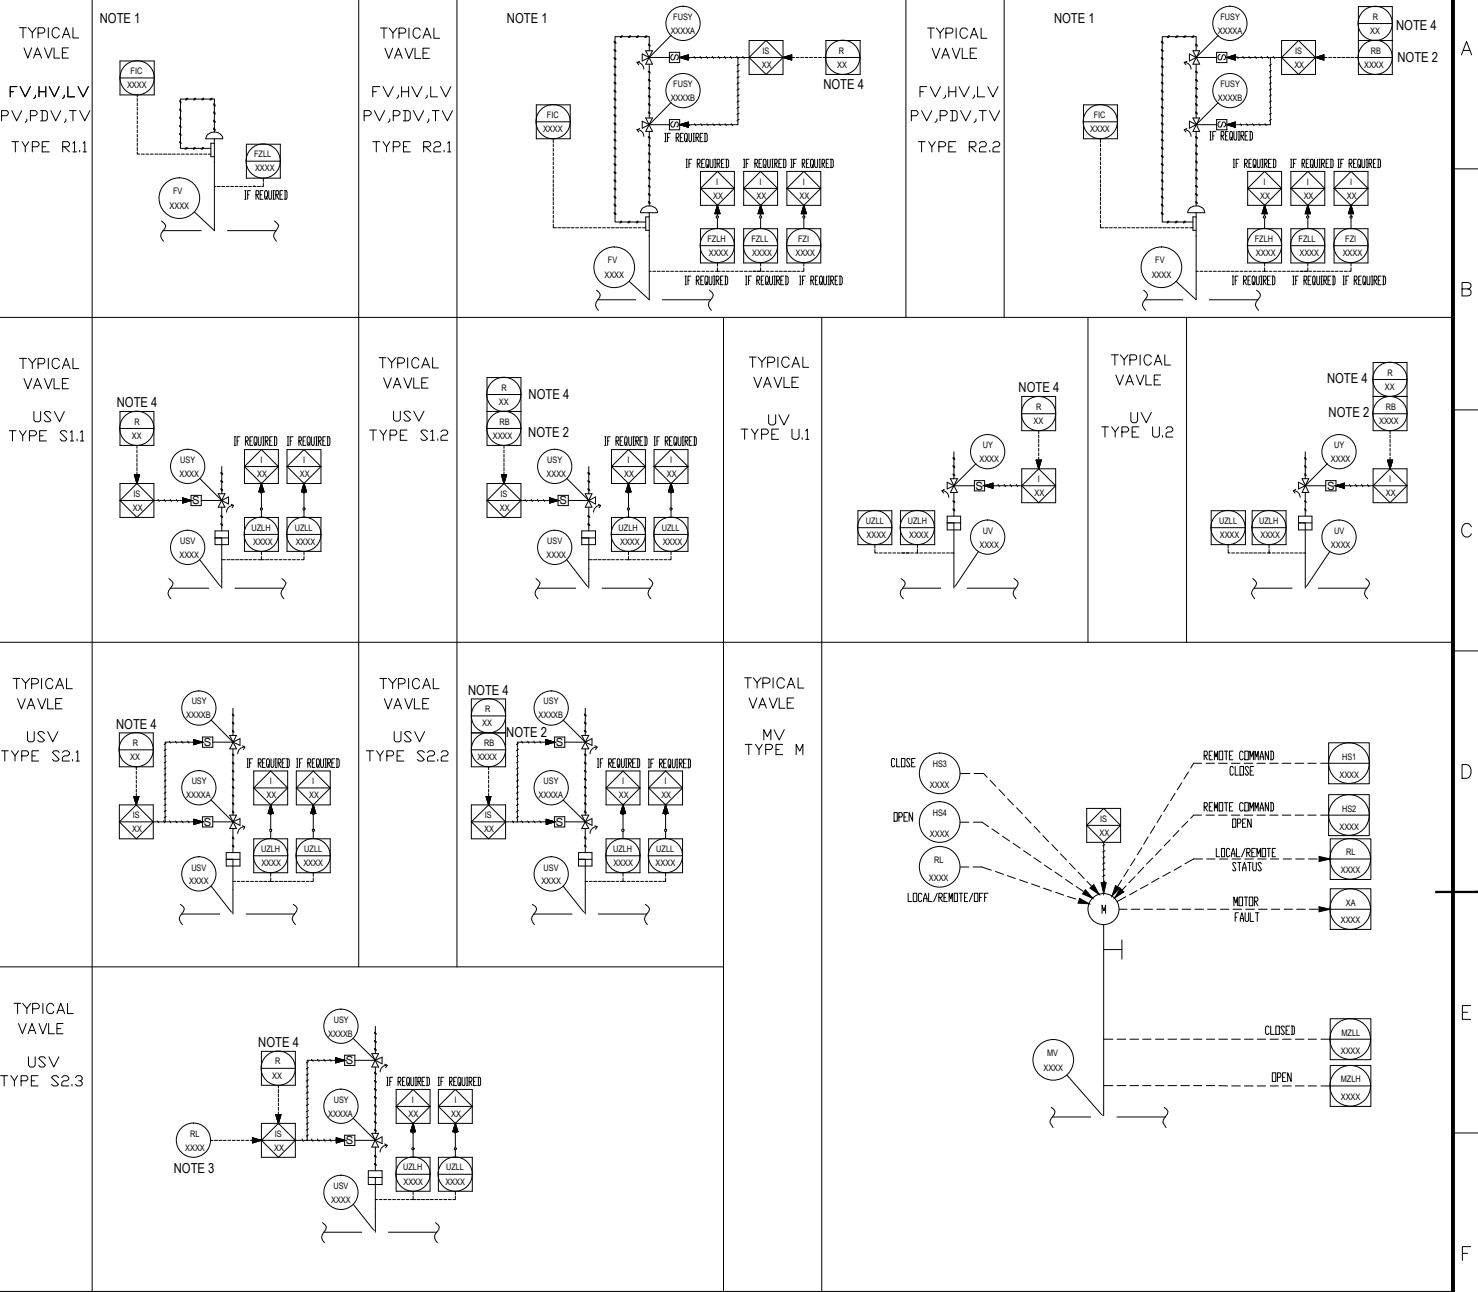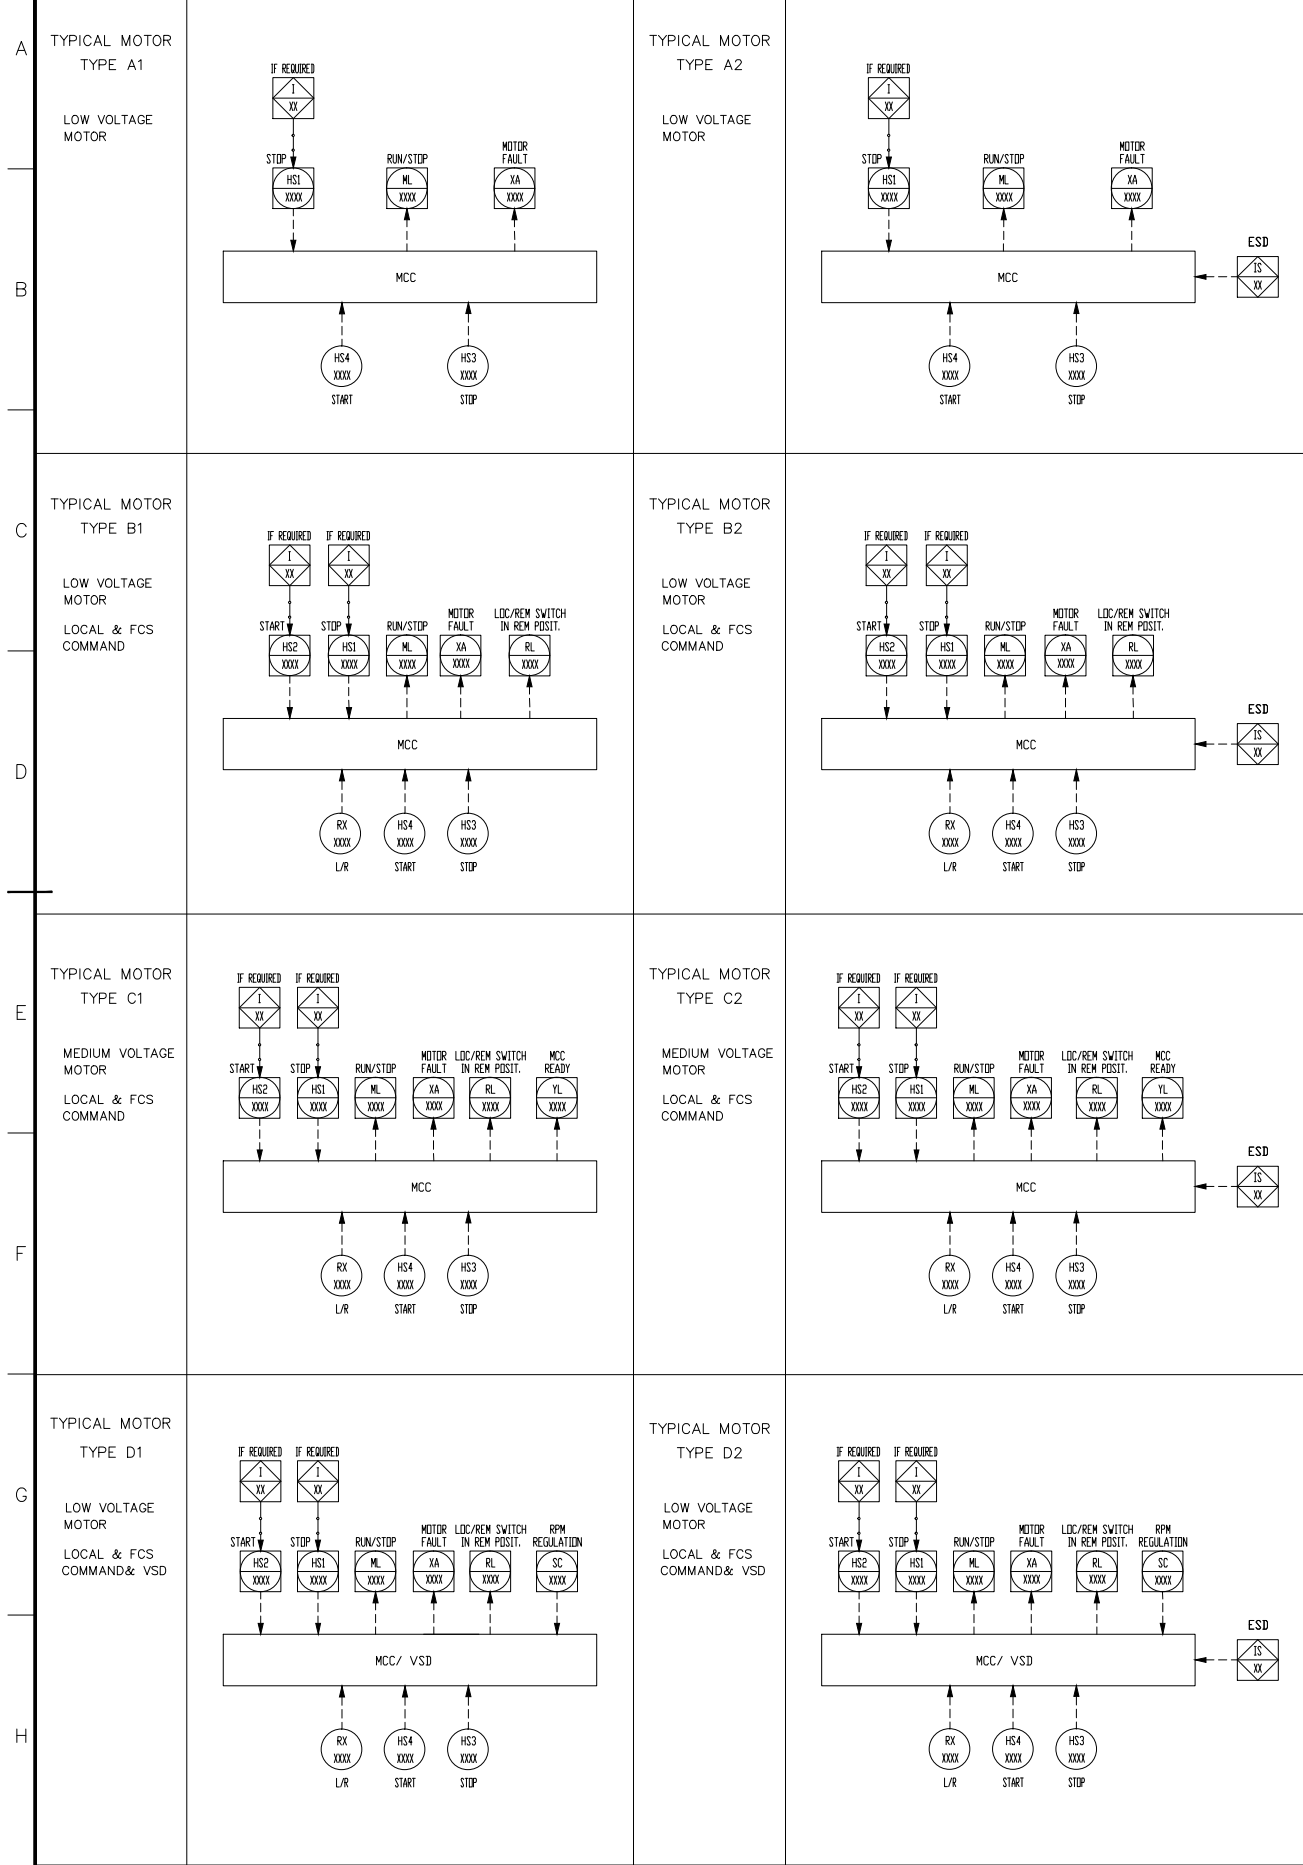

- NOTES:
1. "F" SHALL BE "F", "H", "L", "P", "PD", OR "T" FOR DIFFERENT SERVICE.
  2. RB: FINAL ELEMENT TO BE RESET ON CONTROL PANEL AFTER RESET OF IS-UNIT OR I-UNIT.
  3. RL: FINAL ELEMENT TO BE RESET LOCALLY AFTER RESET OF IS-UNIT.
  4. R: RESET OF IS-UNIT OR I-UNIT.

As Built	30.04.2020	Xu Yekun	Xu Hong	Liu Shengkol			
Approved for Construction	15.05.2017	Xu Yekun	Xu Hong	Liu Shengkol			
Issued for Review	05.05.2017	Xu Yekun	Xu Hong	Liu Shengkol			
Issued for Review	22.03.2017	Xu Yekun	Xu Hong	Liu Shengkol			
REV.	PURPOSE OF ISSUE	DATE	DESIGN	DRAW	CHECK	REVIEW	APPROVE

THIS DOCUMENT IS THE PROPERTY OF TCC. NO PART OF THIS DOCUMENT SHALL BE REPRODUCED OR DISCLOSED TO OTHERS OR USED FOR ANY PURPOSE WHATSOEVER EXCEPT WITH THE PRIOR WRITTEN PERMISSION OF TCC.

OWNER: Middle East Kimiaye Pars Company


HALDOR TOPSØE A/S	DOCUMENT NAME:	DWG NO:	DATE:	REV:
TCC 中国天辰工程有限公司	CONTRACTOR DRAWING NO.	MKP-11-AS-9000-PS07-PID-003	SHEET 01	TOTAL 01
	SUB-CONTRACTOR DRAWING NO.		SHEET --	TOTAL --

PROJECT	MKP Methanol Project
UNIT	General Technical
PHASE	As Built Drawing
OWNER DWG NO.	MKP-11-AS-9000-PR-PID-003

SCALE: - SHEET: 1 TOT: 1 SIZE: A1

Counter Signing Sign Date



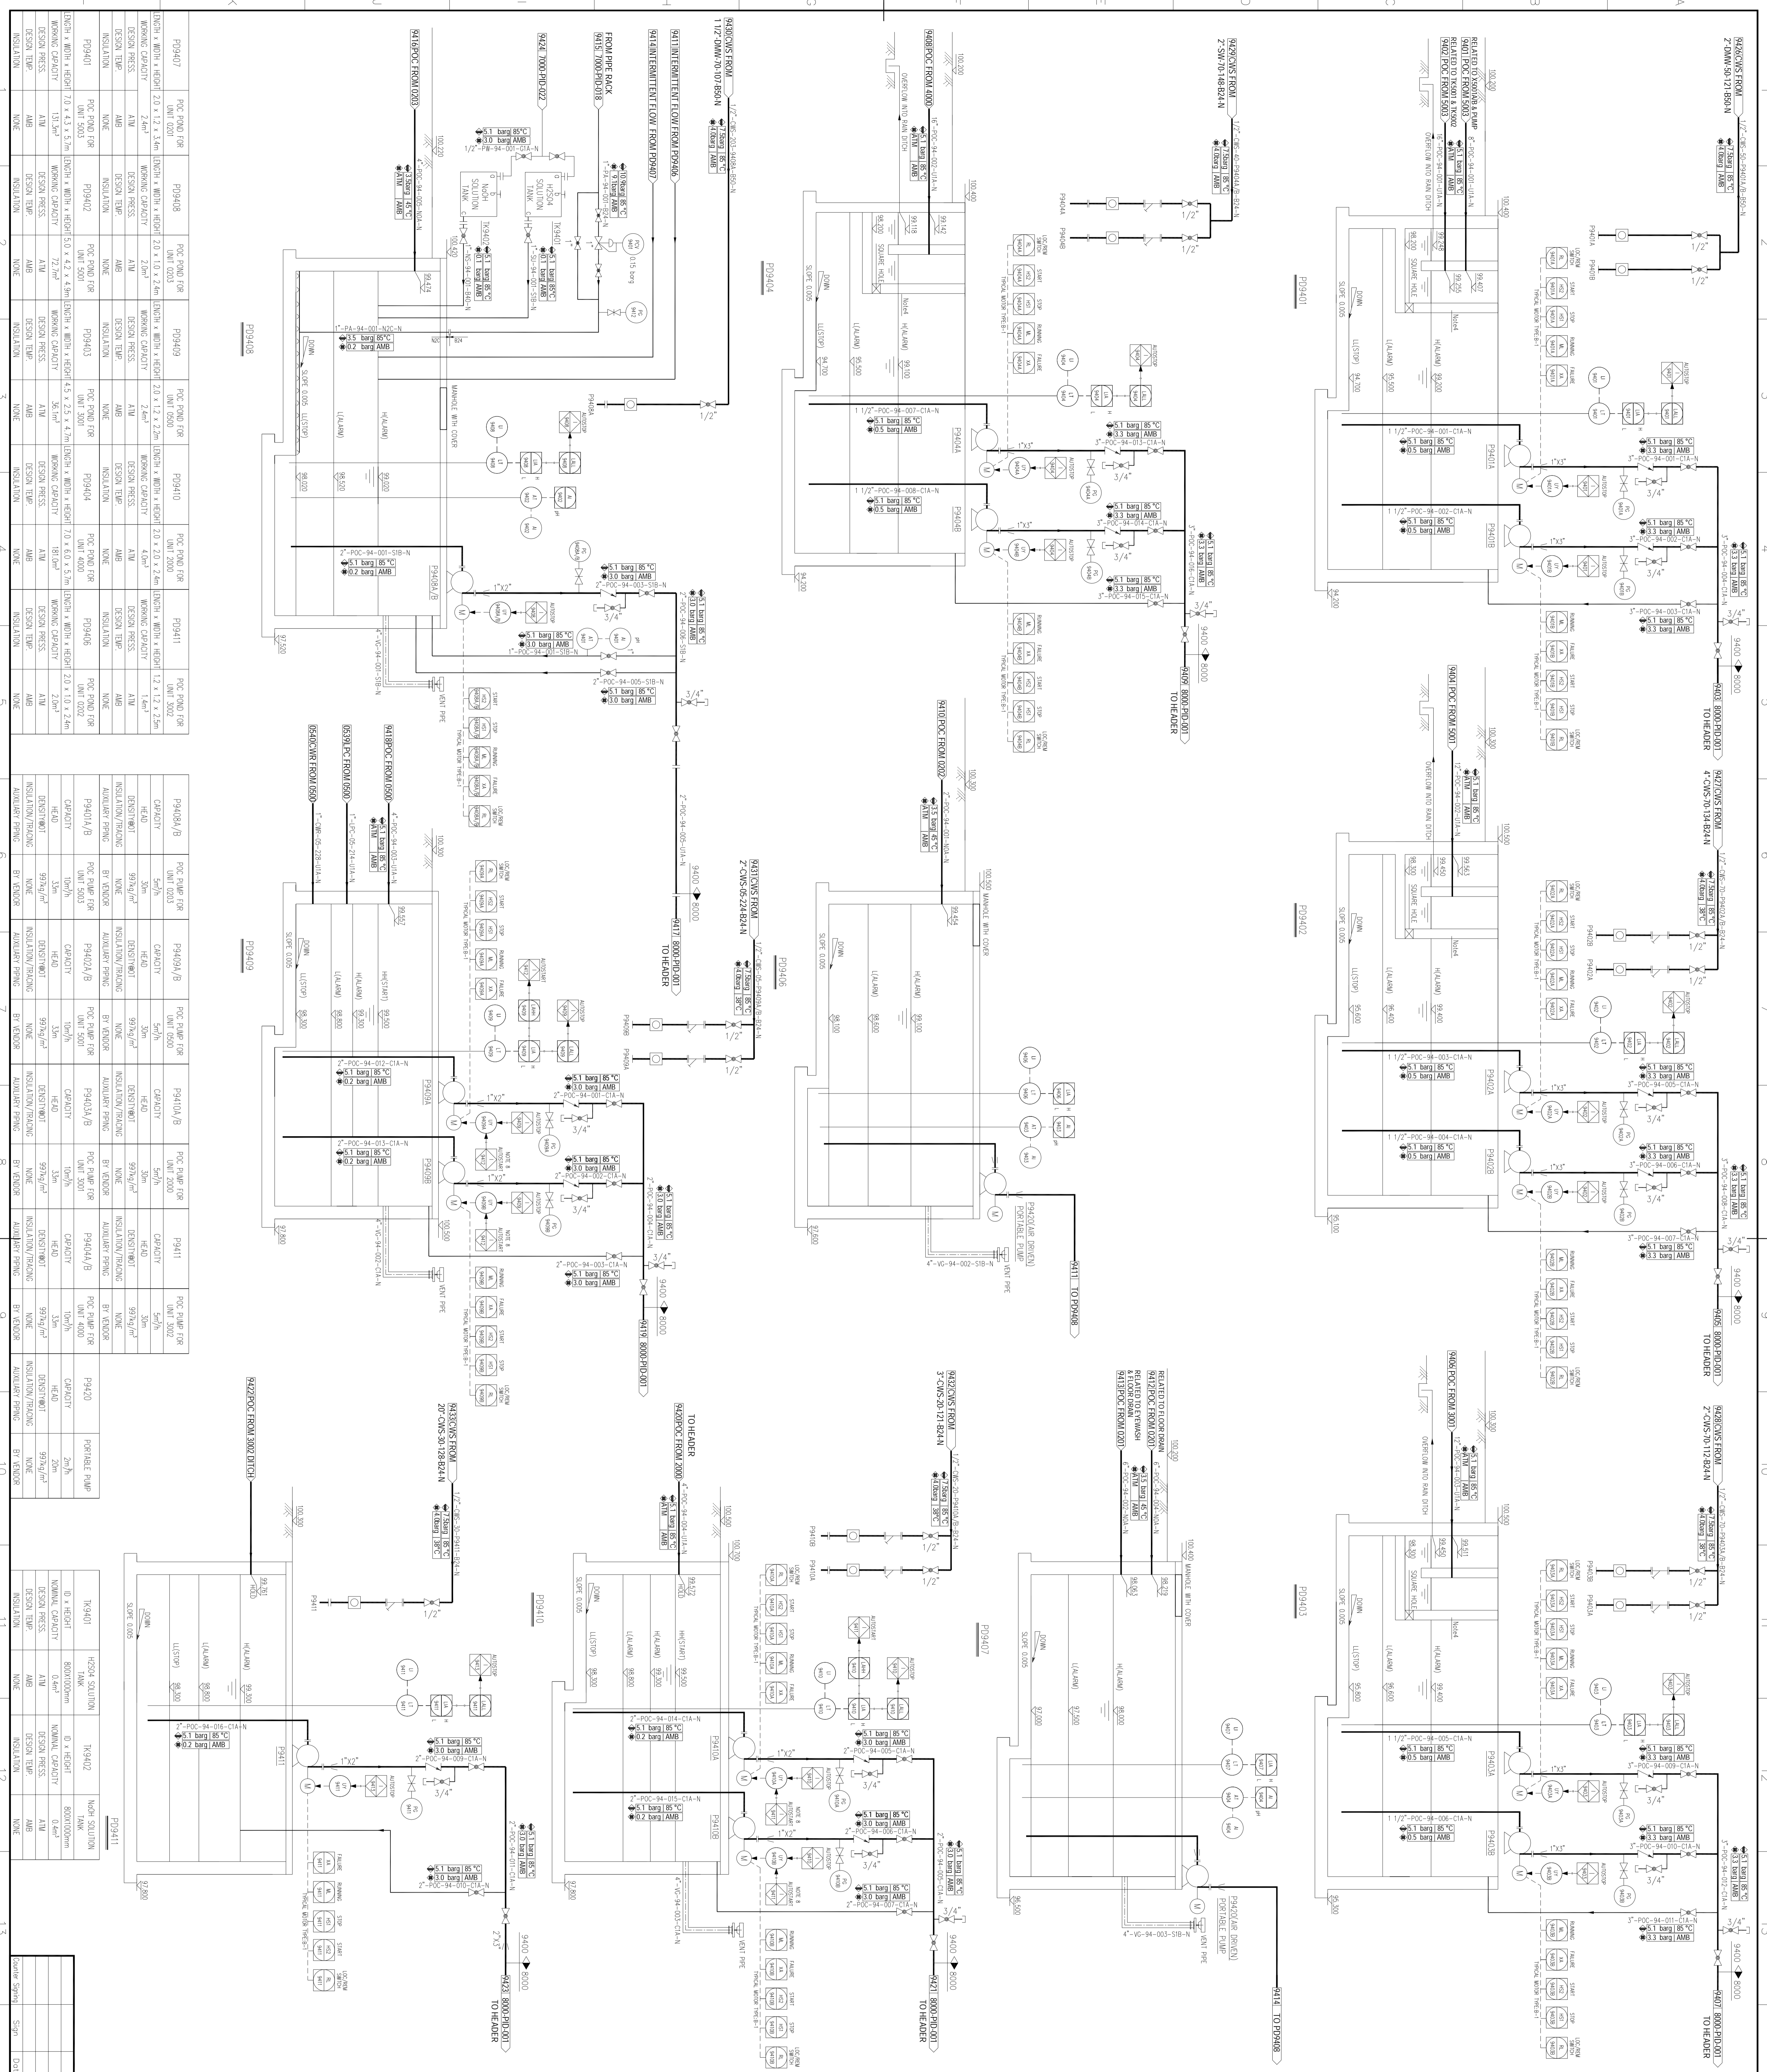

**GENERAL NOTES**

- P9401~P9404 RESPECTIVELY SET TO COLLECT POC IN THE AREA 5000, 5001, 5004&5005
- P9406~P9411 RESPECTIVELY SET TO COLLECT POC AT 0202, 0201, 0203, 0204&0205.
- BOTTOM OF POUNDS WITH A SLOPE OF 0/05.
- THIS WALL SEPARATES THE POUND INTO TWO PARTS, ONE FOR OIL-SEPARATING, THE OTHER FOR STORING WATER.
- INPUTS TO POUNDS IS BY SLOPED PRESS.
- THE POUNDS AND RELATED TANKS SHOULD BE CONSIDERED IN FENCE AREA.
- THE ELEVATION OF PIPE @ UNDER BOTTOM ELEVATION.
- SOFTWARE SWITCH WILL BE SET FOR SELECTION OF AUTOMATIC PUMP # OR B.

**REFERENCE DRAWINGS**

POC PROCESS FLOW DIAGRAM	MAP-11-DC-5400-PR-P94-005
ENVIRONMENT ENGINEERING DESCRIPTION	MAP-11-DC-5400-0-SPC-004

**SYMBOLS AND LEGENDS**

**KEY PLAN**

NO.	DESCRIPTION	DATE	DESIGN	CHECK	REVIEW	APPROVE
1	Issued For Approval	30/04/2020	Wong Le	Wong Le	Wong Le	Wong Le
2	Approved for Construction	14/01/2019	Wong Le	Wong Le	Wong Le	Wong Le
3	Approved for Construction	17/07/2018	Wong Le	Wong Le	Wong Le	Wong Le
4	Approved for Construction	18/04/2017	Wong Le	Wong Le	Wong Le	Wong Le
5	Issued For Approval	22/02/2017	Wong Le	Wong Le	Wong Le	Wong Le
6	Issued For Approval	03/02/2017	Wong Le	Wong Le	Wong Le	Wong Le
7	Issued For Approval	11/01/2017	Wong Le	Wong Le	Wong Le	Wong Le
8	Issued For Approval	19/12/2016	Wong Le	Wong Le	Wong Le	Wong Le
9	Issued For Approval	03/10/2016	Wong Le	Wong Le	Wong Le	Wong Le
10	Issued For Approval	05/06/2016	Wong Le	Wong Le	Wong Le	Wong Le

**CONTRACTOR**

**TCC 中国天辰工程技术有限公司**  
CHINA TIANCHEN ENGINEERING CORPORATION

**PROJECT**

POC AND INSTRUMENT DIAGRAM FOR POC


**OWNER**

Middle East  
Kimioye Pars Company

**SCALE**

SHEET 1 OF 1



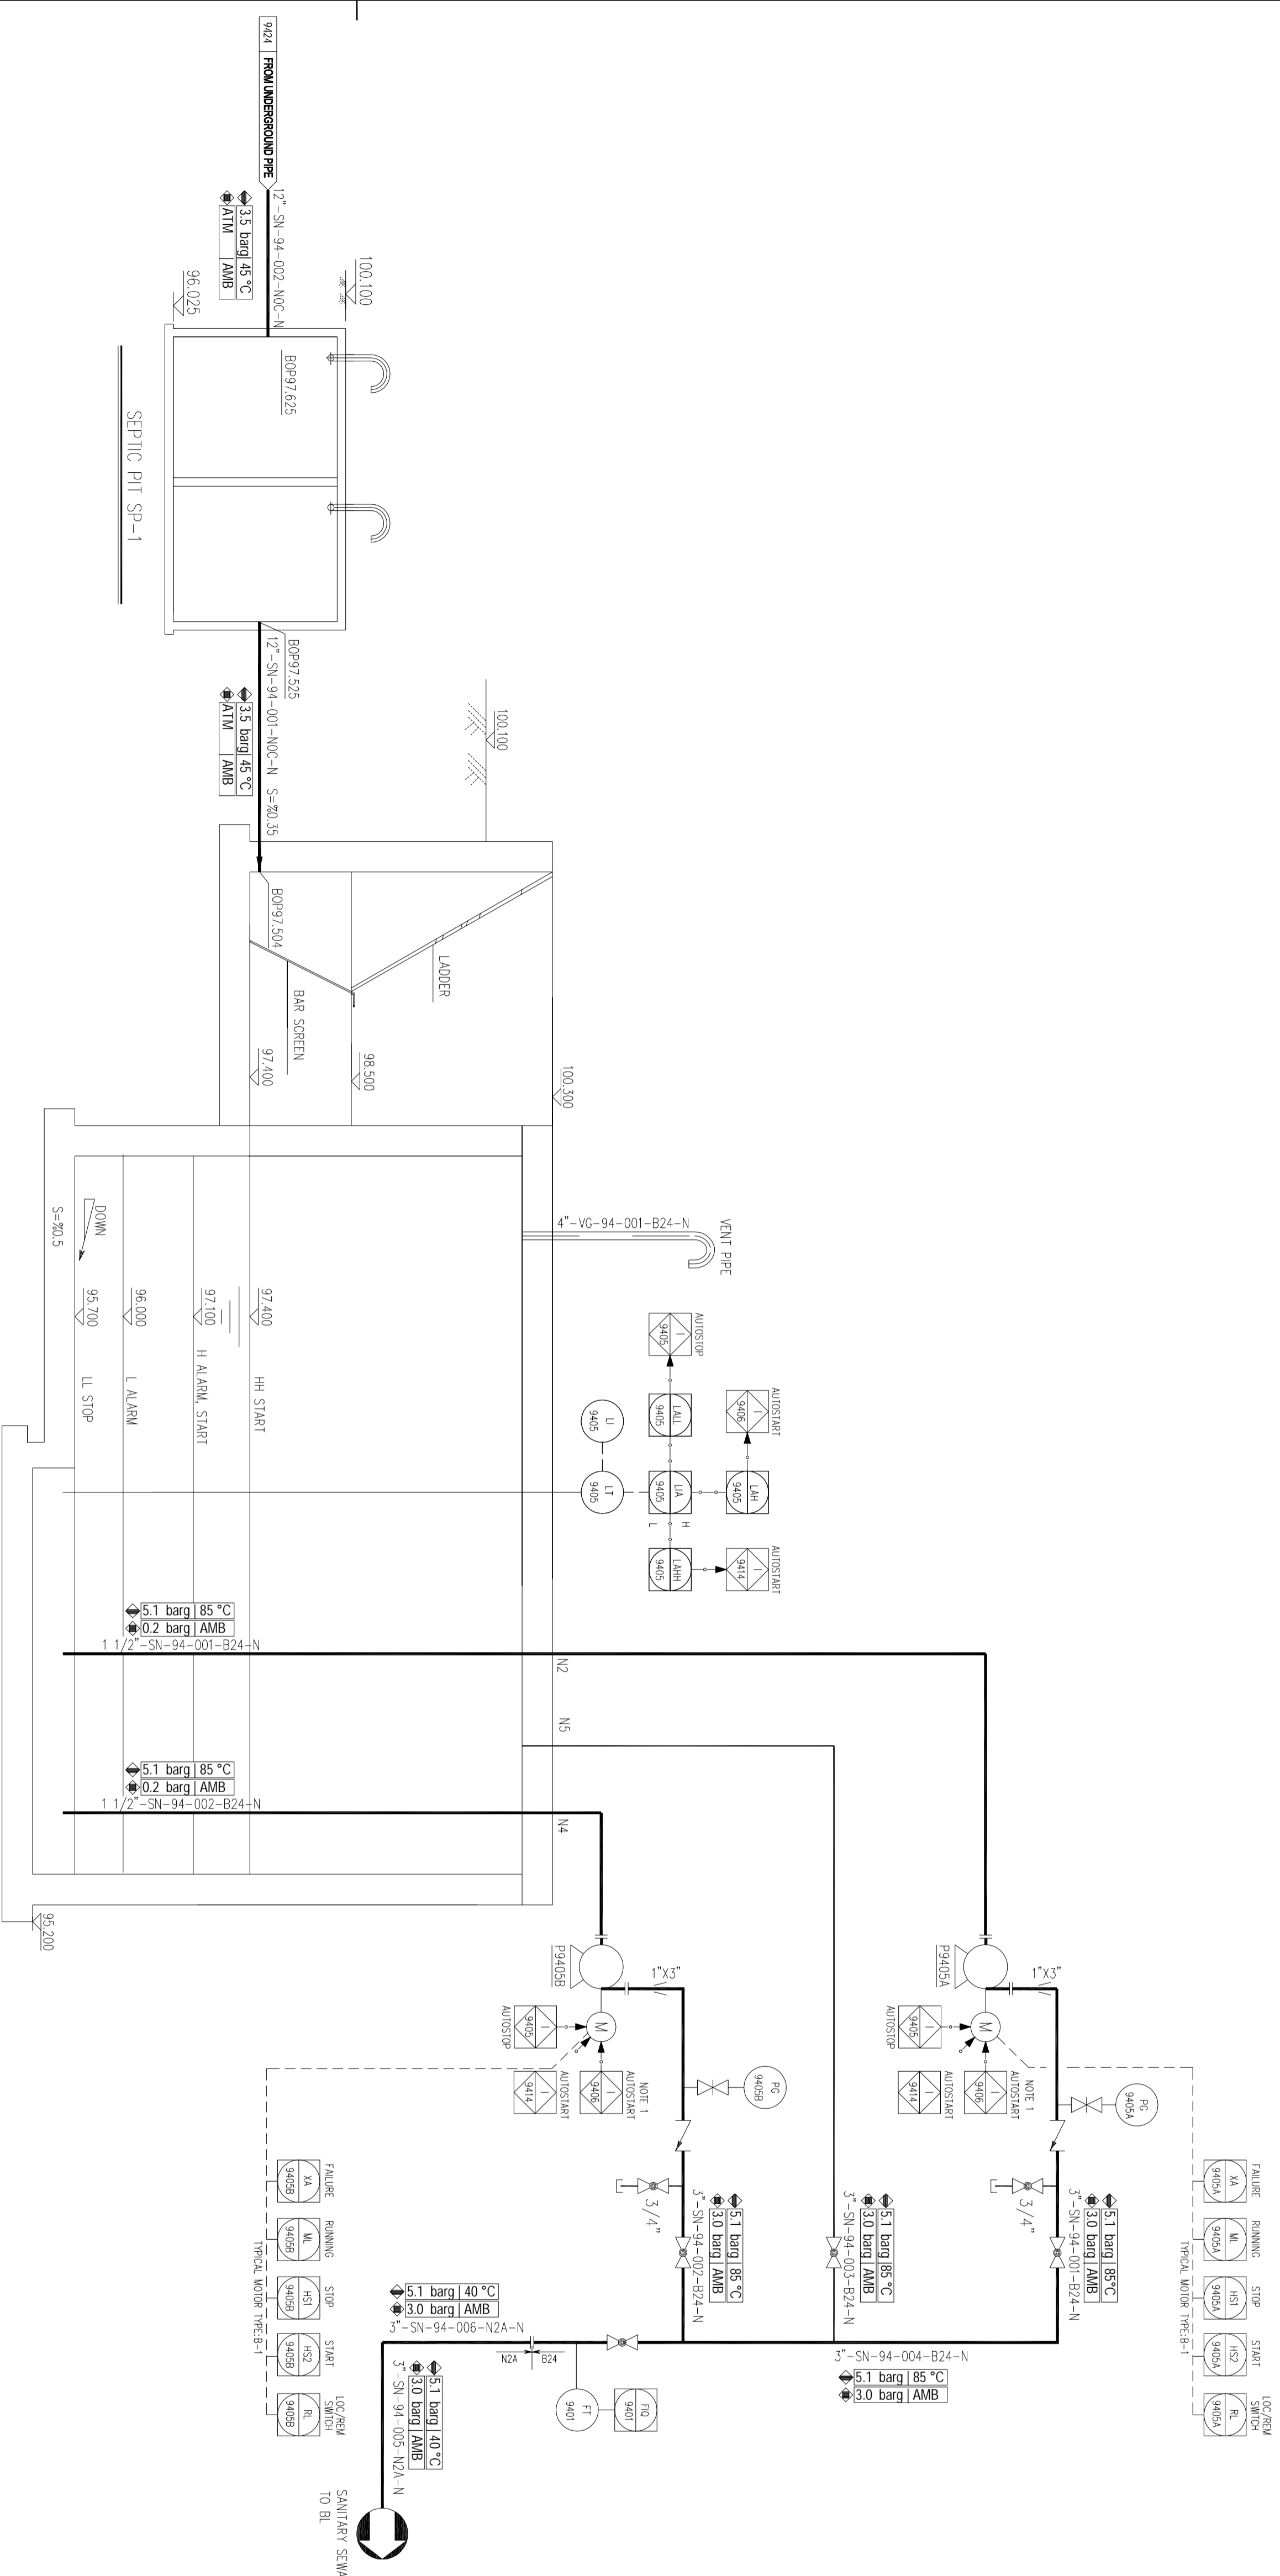

P9405 SANITARY SEWAGE POND

**GENERAL NOTES**

1. SOFTWARE SWITCH WILL BE SET FOR SELECTION OF AUTOSTART PUMP A OR B.

**REFERENCE DRAWINGS**

**SYMBOLS AND LEGENDS**

**KEY PLAN**

As built	30/04/2020	Wong Lei	Wong Lei	Du Guifu	Xie Xuan
Approved For Construction	7/11/2019	Wong Lei	Wong Lei	Tan Too	Xie Xuan
Approved For Construction	17/06/2019	Wong Lei	Wong Lei	Tan Too	Xie Xuan
Approved For Construction	27/02/2019	Wong Lei	Wong Lei	Tan Too	Xie Xuan
Approved For Construction	14/12/2018	Wong Lei	Wong Lei	Tan Too	Xie Xuan
Approved For Construction	01/08/2018	Wong Lei	Wong Lei	Tan Too	Xie Xuan
Approved For Construction	17/07/2018	Wong Lei	Wong Lei	Tan Too	Xie Xuan
Approved For Construction	09/10/2016	Wong Lei	Wong Lei	Tan Too	Xie Xuan
Issued For Comments	06/06/2016	Wong Lei	Wong Lei	Tan Too	Xie Xuan
PURPOSE OF ISSUE	DATE	DESIGN	DRAW	CHECK	REVIEW
APPROVE					

OWNERS:



Middle East  
Kiniaye Pars Company

CONTRACTOR: HALDOR TOPSOE A/S

CONTRACTOR: **TCC 中国天辰工程**  
CHINA TIANCHEN ENGINEERING CORPORATION

CONTRACTOR DRAWING NO.	MKP-11-AS-9400-EE06-PI0-003
SHEET	01
TOTAL	01
SUB-CONTRACTOR DRAWING NO.	
SHEET	
TOTAL	

PROJECT	MPK Metrolink Project
UNIT	WATER SUPPLY & DRAINAGE FOR WHOLE PLANT
PHASE	As built, drawing
OWNER	MKP-11-AS-9400-PR-PI0-003
DWC NO.	

PG9405	SANITARY SEWAGE POND	PG9405A/B	SANITARY SEWAGE PUMP	Y9401	BAR SCREEN	SP-1	SEPTIC PIT
ID x HEIGHT	3.0x3.0x4.6m	CAPACITY	10m <sup>3</sup> /h	LENGTH	1.0m	ID x HEIGHT	9.5x4.8x4.0/7.5m
NOMINAL CAPACITY	15.3m <sup>3</sup>	HEAD	30m	BREADTH	0.5m	NOMINAL CAPACITY	75m <sup>3</sup>
DESIGN PRESS.	ATM	DENSITY/WT	9970kg/m <sup>3</sup>	BAR SCREEN CAP	20mm	DESIGN PRESS.	ATM
DESIGN TEMP.	AMB	INSULATION/RAIACNG	NONE	INSULATION/RAIACNG	NONE	DESIGN TEMP.	AMB
INSULATION	NONE	AUXILIARY PIPING	BY VENDOR	INSULATION/RAIACNG		INSULATION	NONE

Counter Signing	Sign	Date

SCALE	SHEET	TOT	SIZE
-	1	1	A1