


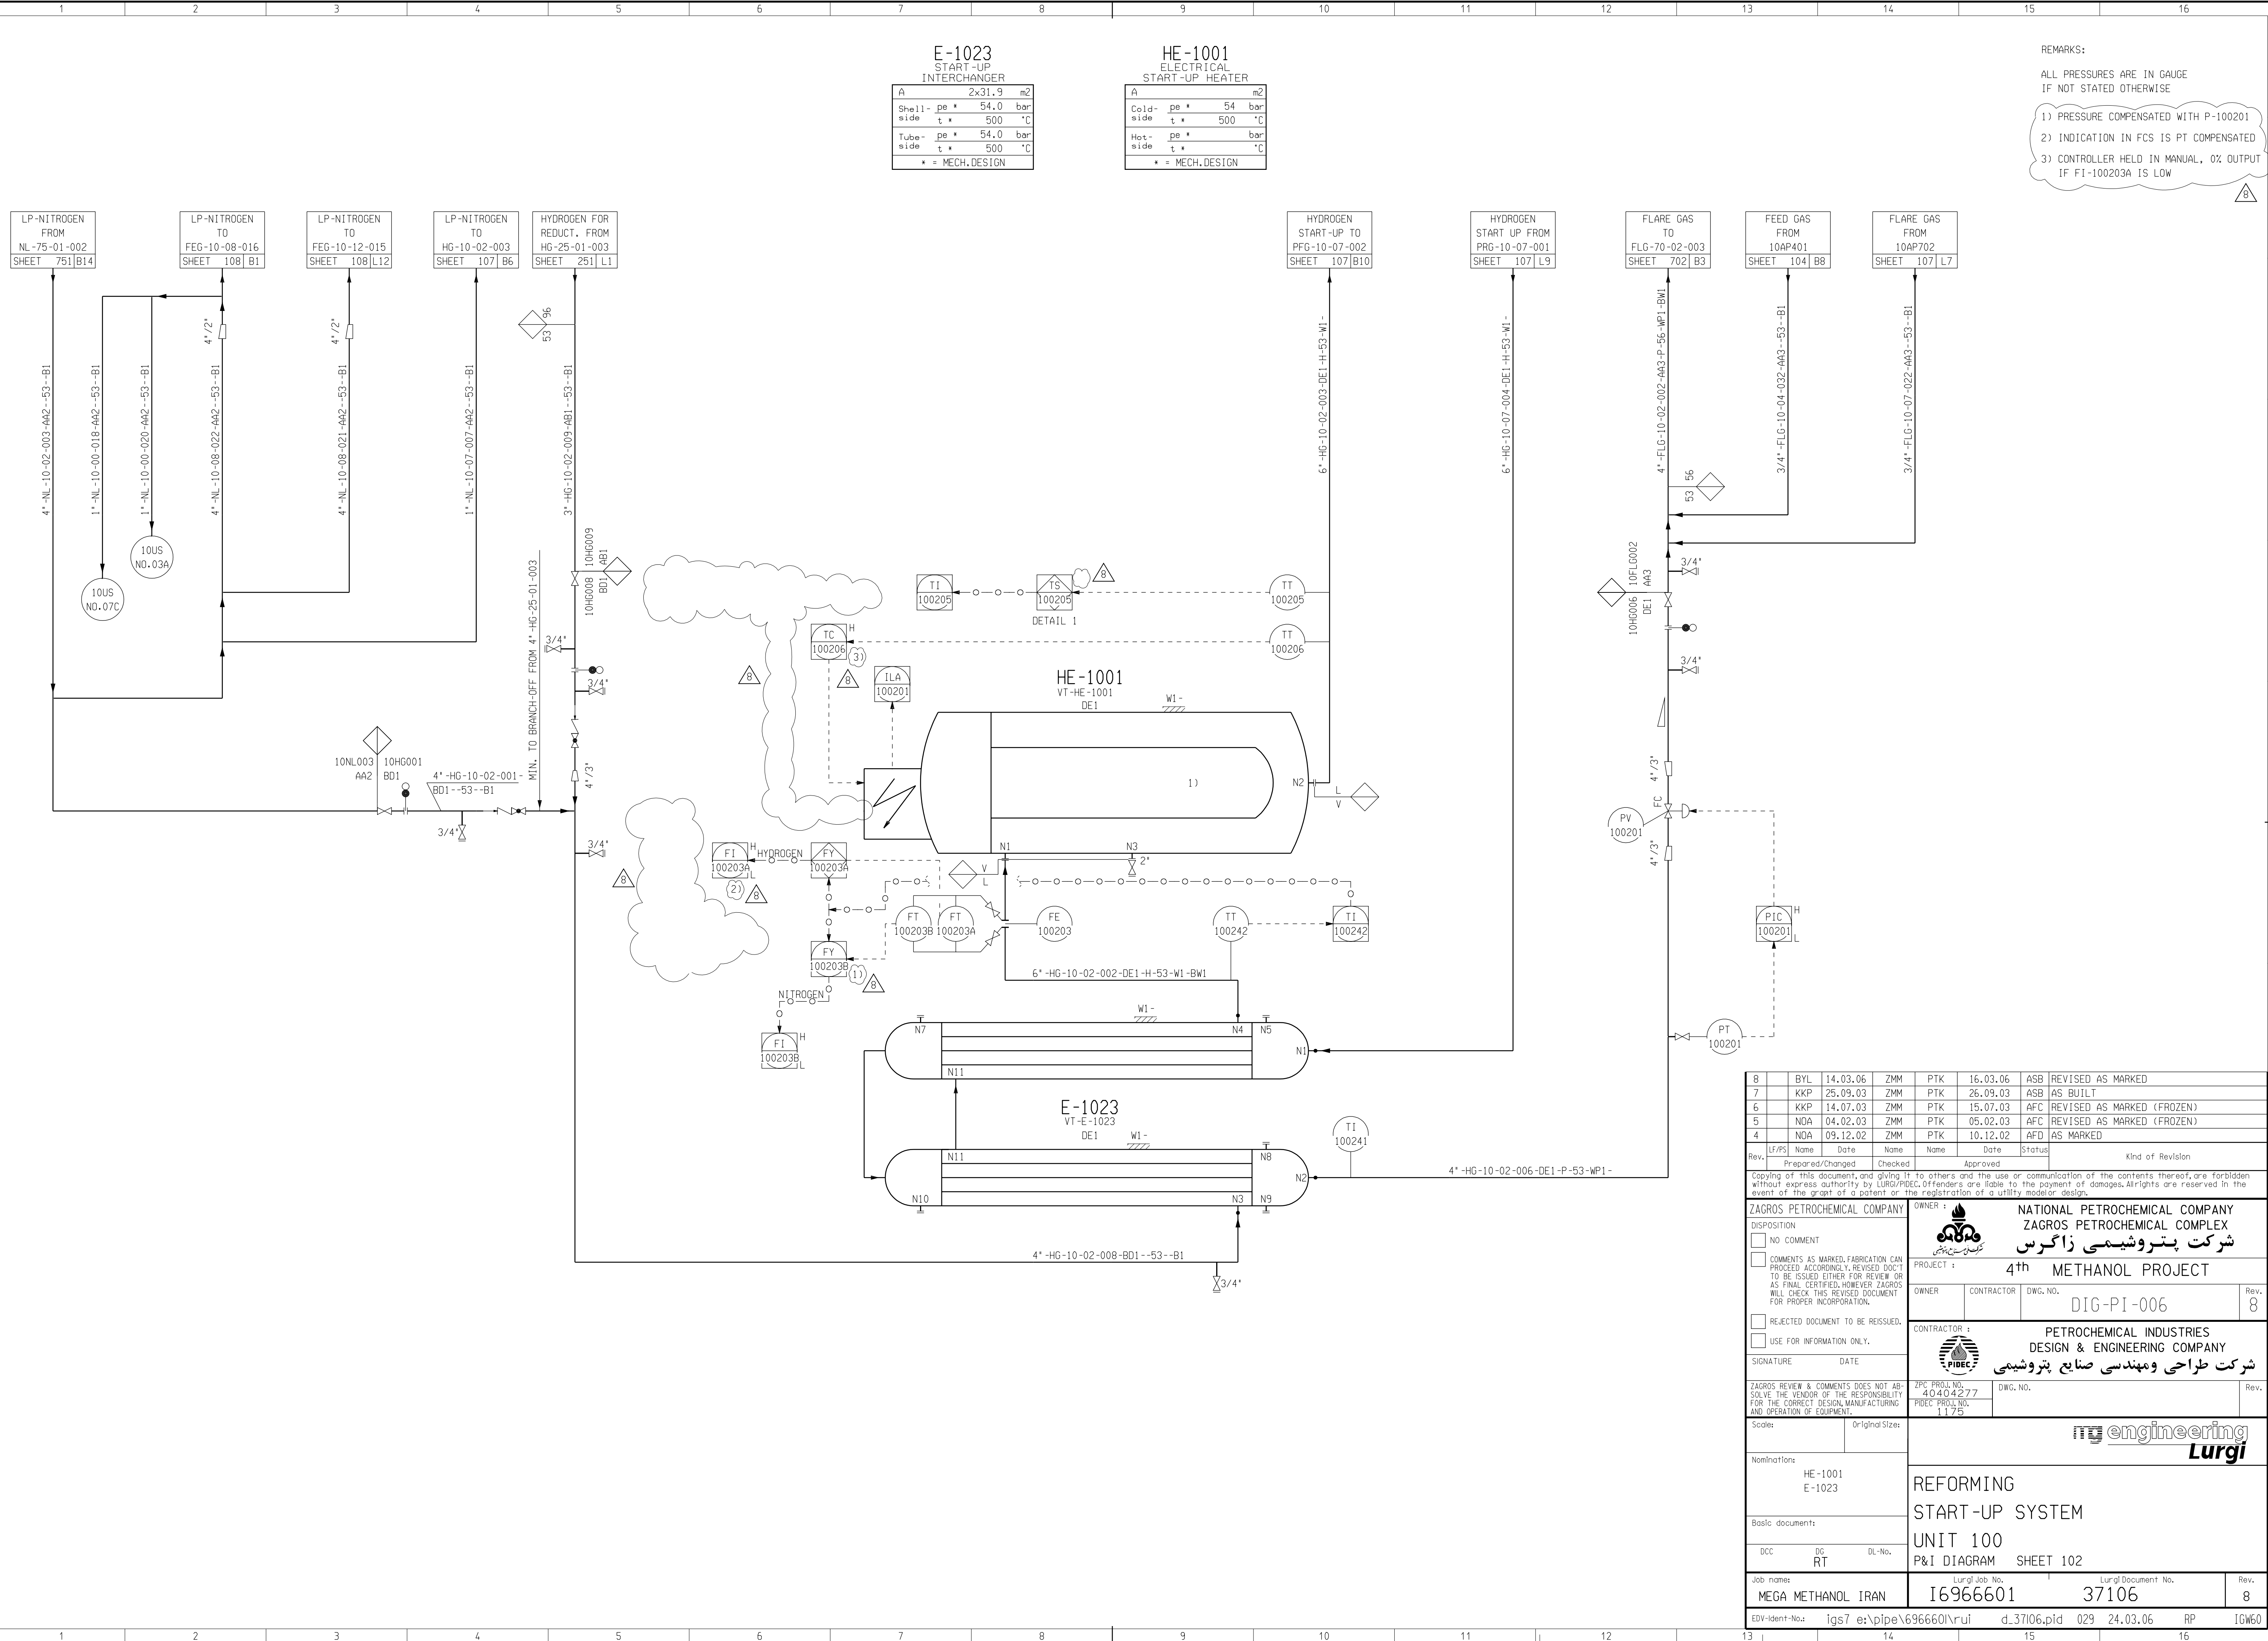

8	BYL	14.07.06	ZMM	PTK	16.03.06	ASB	REVISED AS MARKED	
7	KKP	25.09.03	ZMM	PTK	26.09.03	ASB	AS BUILT	
6	KKP	14.07.03	ZMM	PTK	15.07.03	AFC	REVISED AS MARKED (FROZEN)	
5	NDA	04.02.03	ZMM	PTK	05.02.03	AFC	REVISED AS MARKED (FROZEN)	
4	NDA	09.12.02	ZMM	PTK	10.12.02	AFD	AS MARKED	
Rev.	LF/PS	Name	Date	Name	Date	Status	Kind of Revision	
	Prepared/Changed		Checked	Approved				
Copying of this document, and giving it to others and the use or communication of the contents thereof, are forbidden without express authority by LURG/PI. Offenders are liable to the payment of damages. Allrights are reserved in the event of the grant of a patent or the registration of a utility model design.								
ZAGROS PETROCHEMICAL COMPANY			OWNER :		NATIONAL PETROCHEMICAL COMPANY ZAGROS PETROCHEMICAL COMPLEX شرکت پتروشیمی زاگرس			
DISPOSITION								
☐ NO COMMENT			PROJECT :		4 th METHANOL PROJECT			
☐ COMMENTS AS MARKED; FABRICATION CAN PROCEED ACCORDINGLY. REVISED DOTT TO BE ISSUED EITHER FOR REVIEW OR AS FINAL CERTIFIED. HOWEVER ZAGROS WILL CHECK THIS REVISED DOCUMENT FOR PROPER INCORPORATION.			OWNER		CONTRACTOR	DWG. NO.	Rev.	
☐ REJECTED DOCUMENT TO BE REISSUED. ☐ USE FOR INFORMATION ONLY.						DIG-PI-006	8	
SIGNATURE			DATE		CONTRACTOR :			
					PETROCHEMICAL INDUSTRIES DESIGN & ENGINEERING COMPANY شرکت طراحی و مهندسی صنایع پتروشیمی			
ZAGROS REVIEW & COMMENTS MUST NOT ABSOLVE THE VENDOR OF THE RESPONSIBILITY FOR THE CORRECT DESIGN, MANUFACTURING AND OPERATION OF EQUIPMENT.			ZPC PROJ.NO. 40404277 PIDE PROJ.NO. 1175		DWG. NO.		Rev.	
Scodes:			Original Sizes		Lurgi engineering Lurgi			
Nominations			HE-1001 E-1023		REFORMING START-UP SYSTEM UNIT 100 P&I DIAGRAM SHEET 102			
Basic documents:			DCC DC RT DL-No.					
Job name:			Lurgi Job No.		Lurgi Document No.		Rev.	
MEGA METHANOL IRAN			I6966601		37106		8	
EDV-Ident-No.:			igs7 e:\pipe\696660\l\ruir		d_37106.pid		029 24.03.06 RP ICW6	