


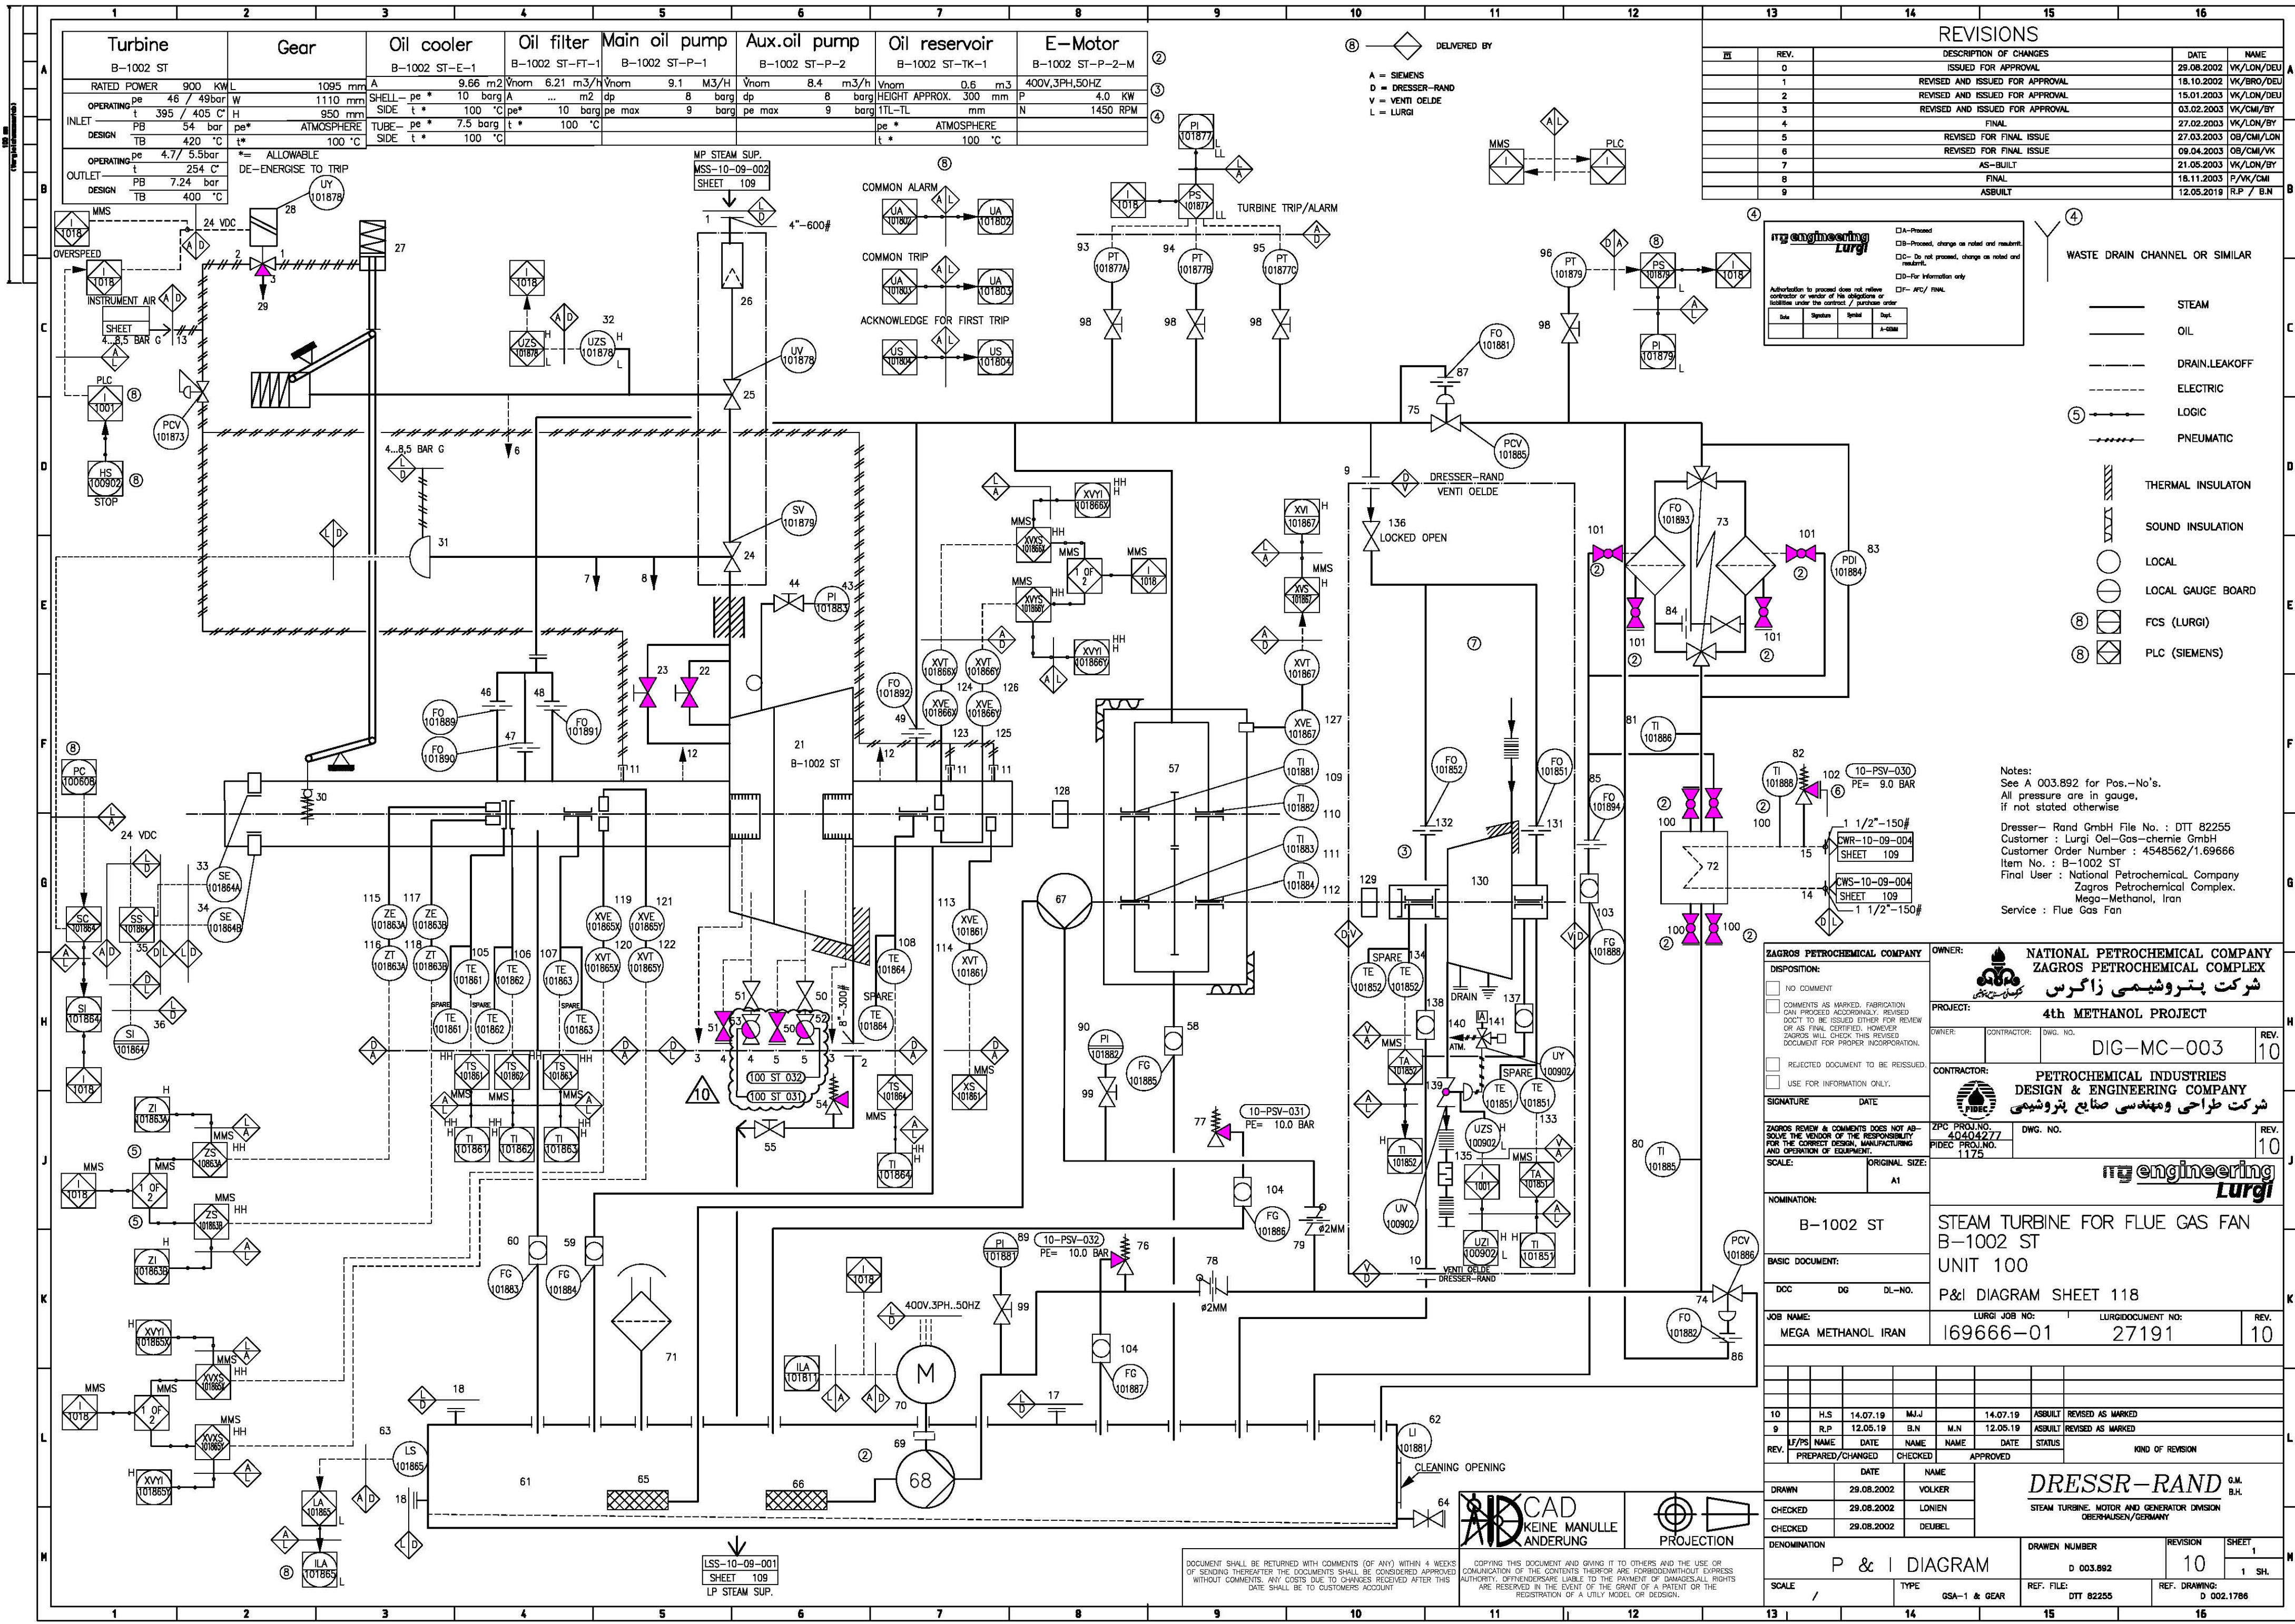

REVISIONS			
REV.	DESCRIPTION OF CHANGES	DATE	NAME
0	ISSUED FOR APPROVAL	28.08.2002	VK/LON/DEU
1	REVISED AND ISSUED FOR APPROVAL	18.10.2002	VK/BRO/DEU
2	REVISED AND ISSUED FOR APPROVAL	15.01.2003	VK/LON/DEU
3	REVISED AND ISSUED FOR APPROVAL	03.02.2003	VK/CM/DEU
4	FINAL	27.02.2003	VK/LON/DEU
5	REVISED FOR FINAL ISSUE	27.03.2003	OB/CM/LON
6	REVISED FOR FINAL ISSUE	09.04.2003	OB/CM/LON
7	AS-BUILT	21.05.2003	VK/LON/DEU
8	FINAL	18.11.2003	P/VK/CM
9	ASBUILT	12.05.2019	R.F. / B.N.

Engineering Lurgi

Authorization to proceed does not relieve contractor or vendor of his obligations or liabilities under the contract / purchase order.

Date	Signature	Special	Dept.

- STEAM
- OIL
- DRAIN/LEAKOFF
- ELECTRIC
- LOGIC
- PNEUMATIC
- THERMAL INSULATION
- SOUND INSULATION
- LOCAL
- LOCAL GAUGE BOARD
- FCS (LURGI)
- PLC (SIEMENS)

Notes:
See A 003.892 for Pos.-No's.
All pressure are in gauge, if not stated otherwise.
Dresser-Rand GmbH File No.: DTT 82255
Customer: Lurgi Oil-Gas-chemie GmbH
Customer Order Number: 4548562/1.69666
Item No.: B-1002 ST
Final User: National Petrochemical Company
Zagros Petrochemical Complex.
Mega-Methanol, Iran
Service: Flue Gas Fan

ZAGROS PETROCHEMICAL COMPANY		OWNER: NATIONAL PETROCHEMICAL COMPANY															
DISPOSITION: ☐ NO COMMENT ☐ COMMENTS AS MARKED. FABRICATION CAN PROCEED ACCORDINGLY. REVISED DOCT TO BE ISSUED EITHER FOR REVIEW OR AS FINAL CERTIFIED. HOWEVER ZAGROS WILL CHECK THIS REVISED DOCUMENT FOR PROPER INCORPORATION. ☐ SELECTED DOCUMENT TO BE REISSUED. ☐ USE FOR INFORMATION ONLY.		PROJECT: 4th METHANOL PROJECT															
SIGNATURE: _____ DATE: _____		CONTRACTOR: PETROCHEMICAL INDUSTRIES DESIGN & ENGINEERING COMPANY															
ZAGROS REVIEW & COMMENTS DOES NOT ABSOLVE THE VENDOR OF THE RESPONSIBILITY FOR THE CORRECT DESIGN, MANUFACTURING AND OPERATION OF EQUIPMENT.		ZPC PROJ. NO: 40404277 FIDEC PROJ. NO: 1175															
SCALE: _____ ORIGINAL SIZE: A1		DWG. NO. _____ REV. 10															
NOMINATION: B-1002 ST		STEAM TURBINE FOR FLUE GAS FAN															
BASIC DOCUMENT: _____		UNIT 100															
DCC DG DL-NO. _____		P&I DIAGRAM SHEET 118															
JOB NAME: MEGA METHANOL IRAN		LURGI JOB NO: 169666-01															
LURGI DOCUMENT NO: 27191		REV. 10															
<table><tr><td>10</td><td>H.S.</td><td>14.07.19</td><td>M.J.J.</td><td>14.07.19</td><td>ASBUILT</td><td>REVISED AS MARKED</td></tr><tr><td>9</td><td>R.P.</td><td>12.05.19</td><td>B.N.</td><td>12.05.19</td><td>ASBUILT</td><td>REVISED AS MARKED</td></tr></table>				10	H.S.	14.07.19	M.J.J.	14.07.19	ASBUILT	REVISED AS MARKED	9	R.P.	12.05.19	B.N.	12.05.19	ASBUILT	REVISED AS MARKED
10	H.S.	14.07.19	M.J.J.	14.07.19	ASBUILT	REVISED AS MARKED											
9	R.P.	12.05.19	B.N.	12.05.19	ASBUILT	REVISED AS MARKED											
REV. PREPARED/CHANGED CHECKED APPROVED																	
DATE NAME																	
DRAWN 29.08.2002 VOLKER																	
CHECKED 29.08.2002 LONEN																	
CHECKED 29.08.2002 DEUBEL																	
DENOMINATION: P & I DIAGRAM																	
DRAWN NUMBER: D 003.892																	
REVISION: 10																	
SHEET: 1 SH.																	
SCALE: _____ TYPE: GSA-1 & GEAR																	
REF. FILE: DTT 82255																	
REF. DRAWING: D 002.1786																	