


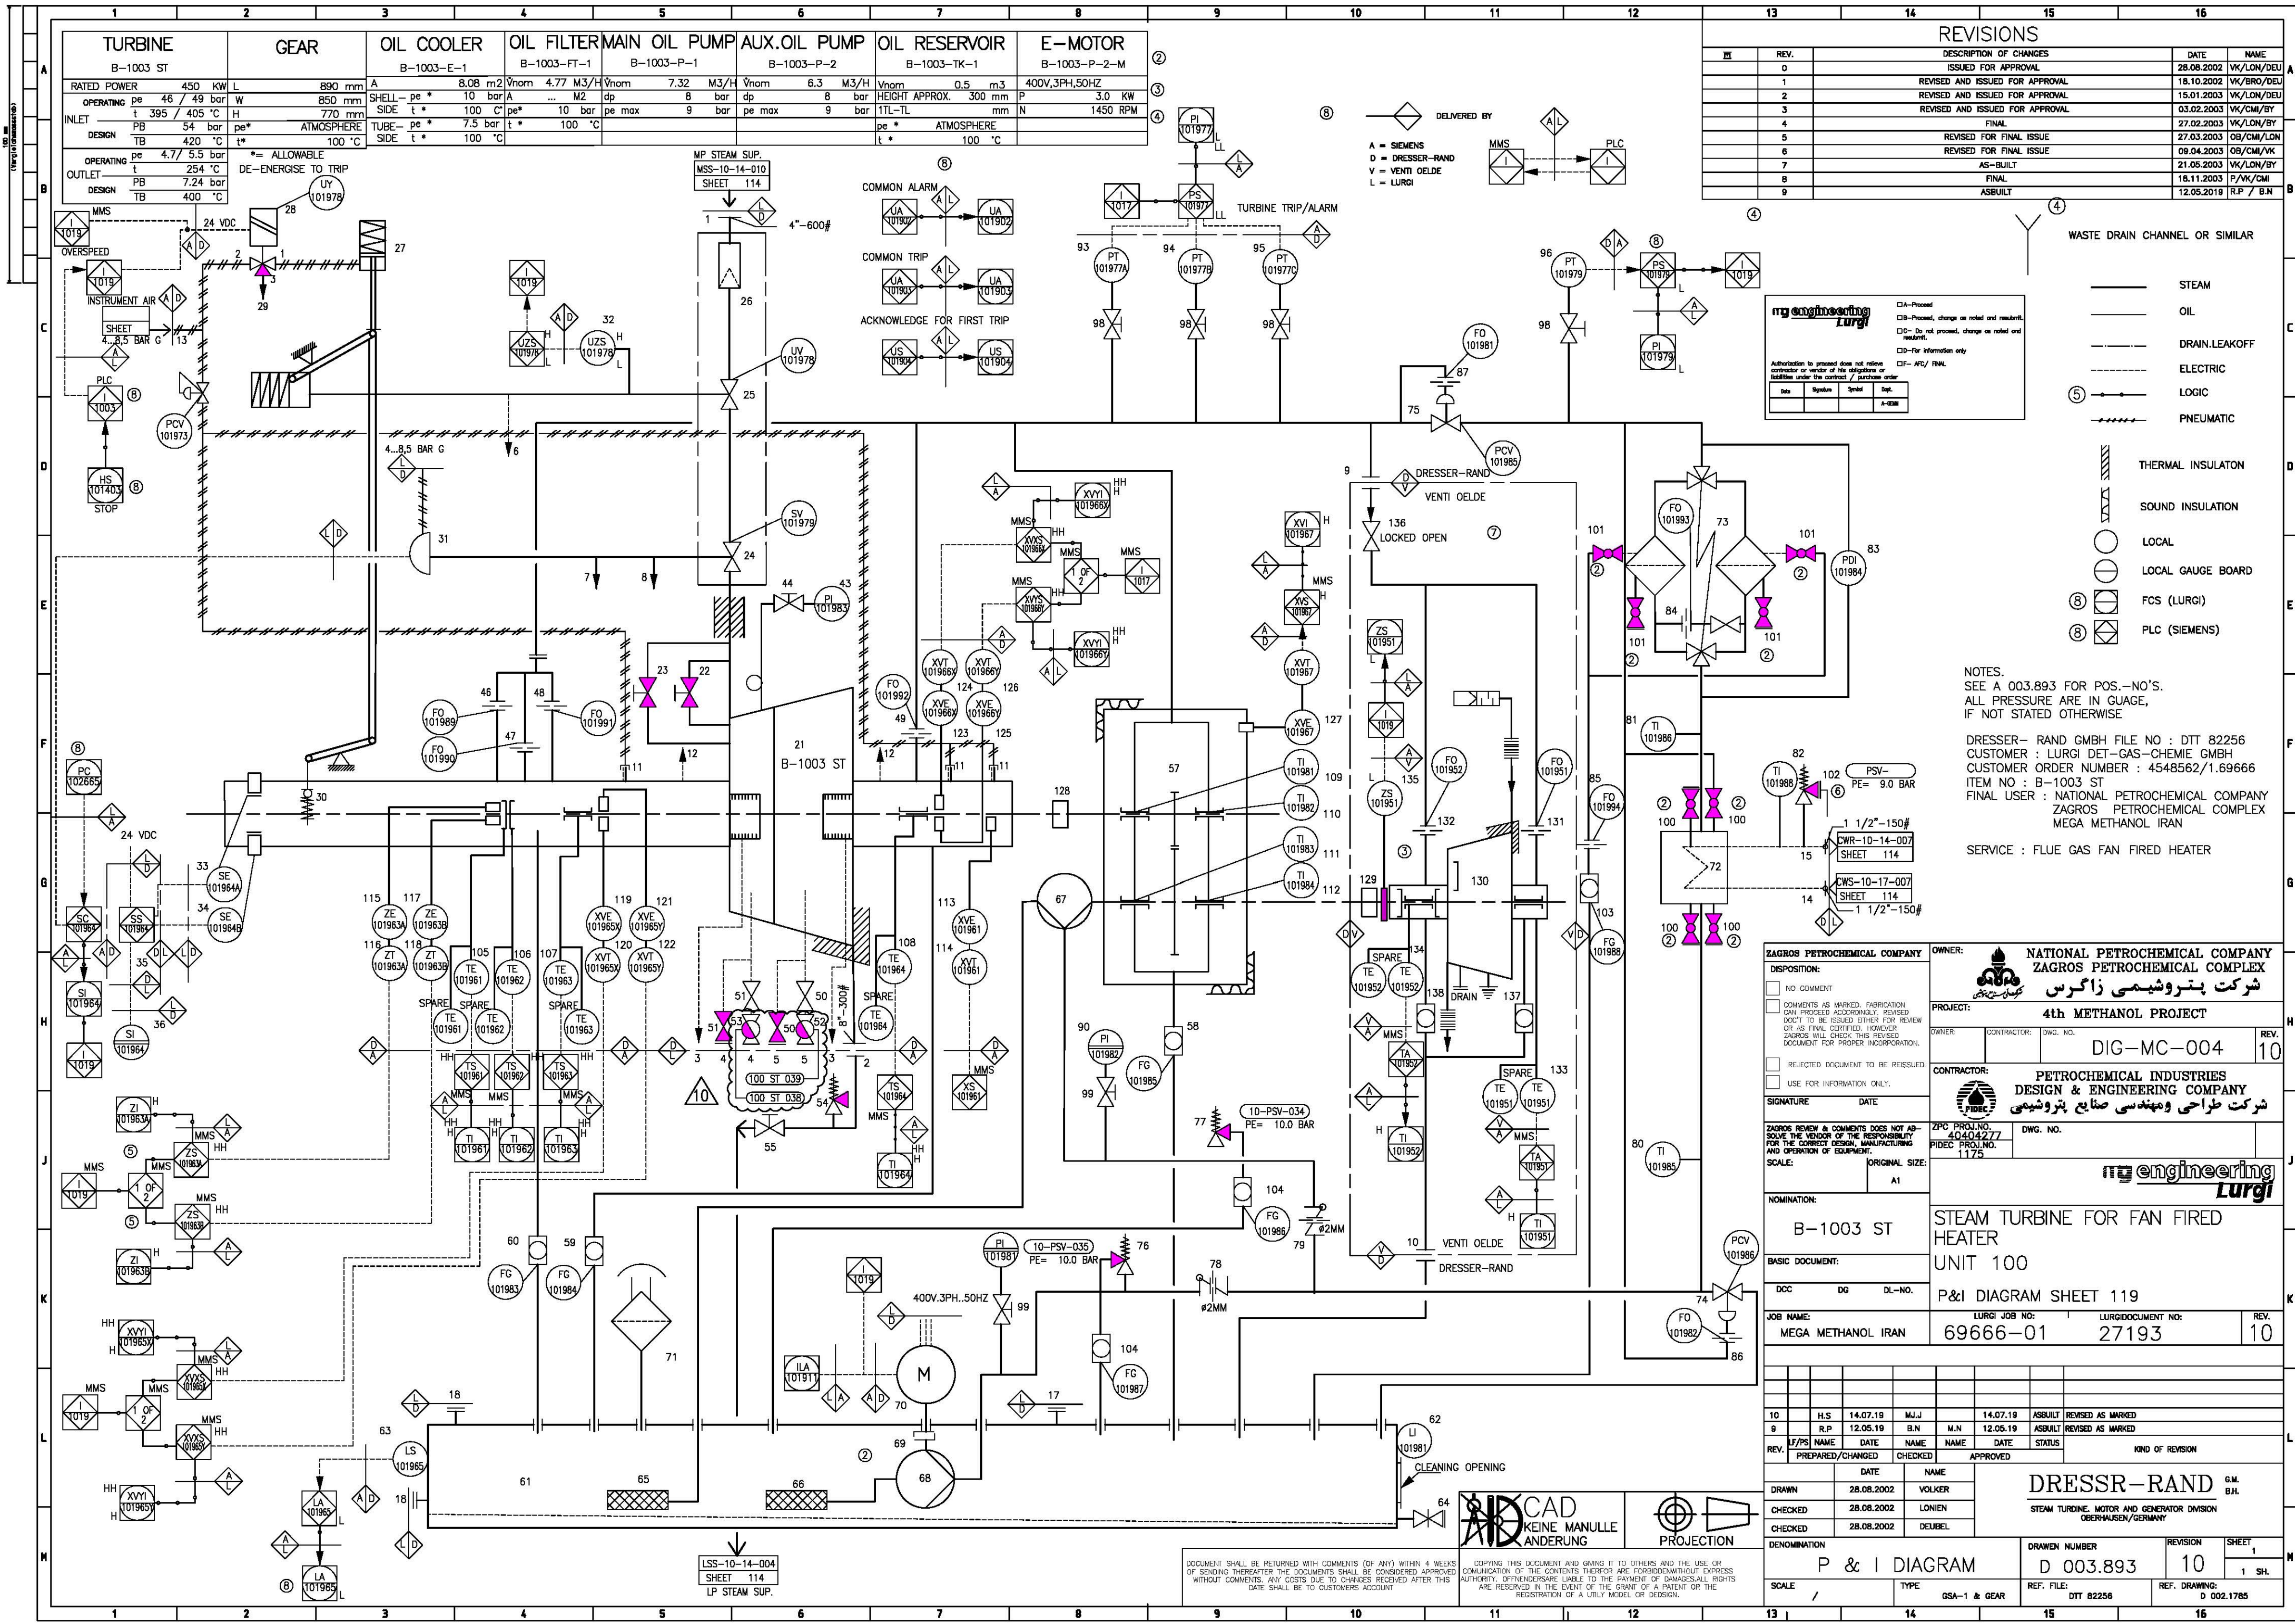

REVISIONS			
REV.	DESCRIPTION OF CHANGES	DATE	NAME
0	ISSUED FOR APPROVAL	28.08.2002	VK/LON/DEU
1	REVISED AND ISSUED FOR APPROVAL	18.10.2002	VK/BRO/DEU
2	REVISED AND ISSUED FOR APPROVAL	15.01.2003	VK/LON/DEU
3	REVISED AND ISSUED FOR APPROVAL	03.02.2003	VK/CM/DEU
4	FINAL	27.02.2003	VK/LON/DEU
5	REVISED FOR FINAL ISSUE	27.03.2003	OB/CM/LON
6	REVISED FOR FINAL ISSUE	09.04.2003	OB/CM/VK
7	AS-BUILT	21.05.2003	VK/LON/DEU
8	FINAL	18.11.2003	P/VK/CM
9	ASBUILT	12.05.2019	R.P. / B.N.

my engineering Lurgi

Authorization to proceed does not release contractor or vendor of his obligation or liability under the contract / purchase order.

Date	Signature	Symbol	Dept.
			A-028

- STEAM
- OIL
- DRAIN/LEAKOFF
- ELECTRIC
- LOGIC
- PNEUMATIC
- THERMAL INSULATION
- SOUND INSULATION
- LOCAL
- LOCAL GAUGE BOARD
- FCS (LURGI)
- PLC (SIEMENS)

NOTES:
SEE A 003.893 FOR POS.-NO'S.
ALL PRESSURE ARE IN GUAGE, IF NOT STATED OTHERWISE

DRESSER- RAND GMBH FILE NO : DTT 82256
CUSTOMER : LURGI DET-GAS-CHEMIE GMBH
CUSTOMER ORDER NUMBER : 4548562/1.69666
ITEM NO : B-1003 ST
FINAL USER : NATIONAL PETROCHEMICAL COMPANY
ZAGROS PETROCHEMICAL COMPLEX
MEGA METHANOL IRAN

SERVICE : FLUE GAS FAN FIRED HEATER

ZAGROS PETROCHEMICAL COMPANY		OWNER: NATIONAL PETROCHEMICAL COMPANY	
DISPOSITION:		ZAGROS PETROCHEMICAL COMPLEX	
☐ NO COMMENT		شركة پتروشیمی زاگرس	
☐ COMMENTS AS MARKED. FABRICATION CAN PROCEED UNPROBINGLY. REVISED DOCT TO BE ISSUED EITHER FOR REVIEW OR AS FINAL CERTIFIED. HOWEVER ZAGROS WILL CHECK THIS REVISED DOCUMENT FOR PROPER INCORPORATION.		PROJECT: 4th METHANOL PROJECT	
☐ REJECTED DOCUMENT TO BE REISSUED		OWNER: CONTRACTOR: DWG. NO. REV. 10	
☐ USE FOR INFORMATION ONLY.		DIG-MC-004	
SIGNATURE DATE		CONTRACTOR: PETROCHEMICAL INDUSTRIES	
		DESIGN & ENGINEERING COMPANY	
		شرکت طراحی و مهندسی صنایع پتروشیمی	
ZAGROS REVIEW & COMMENTS DOES NOT ABSOLVE THE VENDOR OF THE RESPONSIBILITY FOR THE CORRECT DESIGN, MANUFACTURING AND OPERATION OF EQUIPMENT.		ZPC PROJ.NO. 40404277	
SCALE: ORIGINAL SIZE: A1		DWG. NO. 1175	
NOMINATION: B-1003 ST		STEAM TURBINE FOR FAN FIRED HEATER	
BASIC DOCUMENT: DCC DG DL-NO. P&I DIAGRAM SHEET 119		UNIT 100	
JOB NAME: MEGA METHANOL IRAN		LURGI JOB NO: 69666-01	
		LURGI DOCUMENT NO: 27193	
		REV. 10	
REV. 10		H.S. 14.07.19	
REV. 9		R.P. 12.05.19	
REV. 8		DATE NAME DATE STATUS	
REV. 7		PREPARED/CHANGED CHECKED APPROVED	
REV. 6		DATE NAME	
REV. 5		DATE NAME	
REV. 4		DATE NAME	
REV. 3		DATE NAME	
REV. 2		DATE NAME	
REV. 1		DATE NAME	
REV. 0		DATE NAME	
DRAWN 28.08.2002 VOLKER		G.M. B.H.	
CHECKED 28.08.2002 LONEN		STEAM TURBINE, MOTOR AND GENERATOR DIVISION	
CHECKED 28.08.2002 DEUBEL		OBERHAUSEN/GERMANY	
DENOMINATION: P & I DIAGRAM		DRAWN NUMBER: D 003.893	
SCALE: /		REVISION: 10	
TYPE: GSA-1 & GEAR		SHEET: 1 SH.	
REF. FILE: DTT 82256		REF. DRAWING: D 002.1785	