


D-1501	
BFW-DRUM WITH DEAERATOR	
Vnom	265 m3
od	4500 mm
ITL-TL	14000 mm
pe	3.5/-1 bar
t	150 °C
* = MECH. DESIGN	

- REMARKS:
- ALL PRESSURES ARE IN GAUGE IF NOT STATED OTHERWISE
 - LOCATED DIRECTLY ON BFW-DRUM
 - TO BE OPERATED WITH CHAIN WHEEL
 - DELETED.
 - TIE-IN FROM TOP.

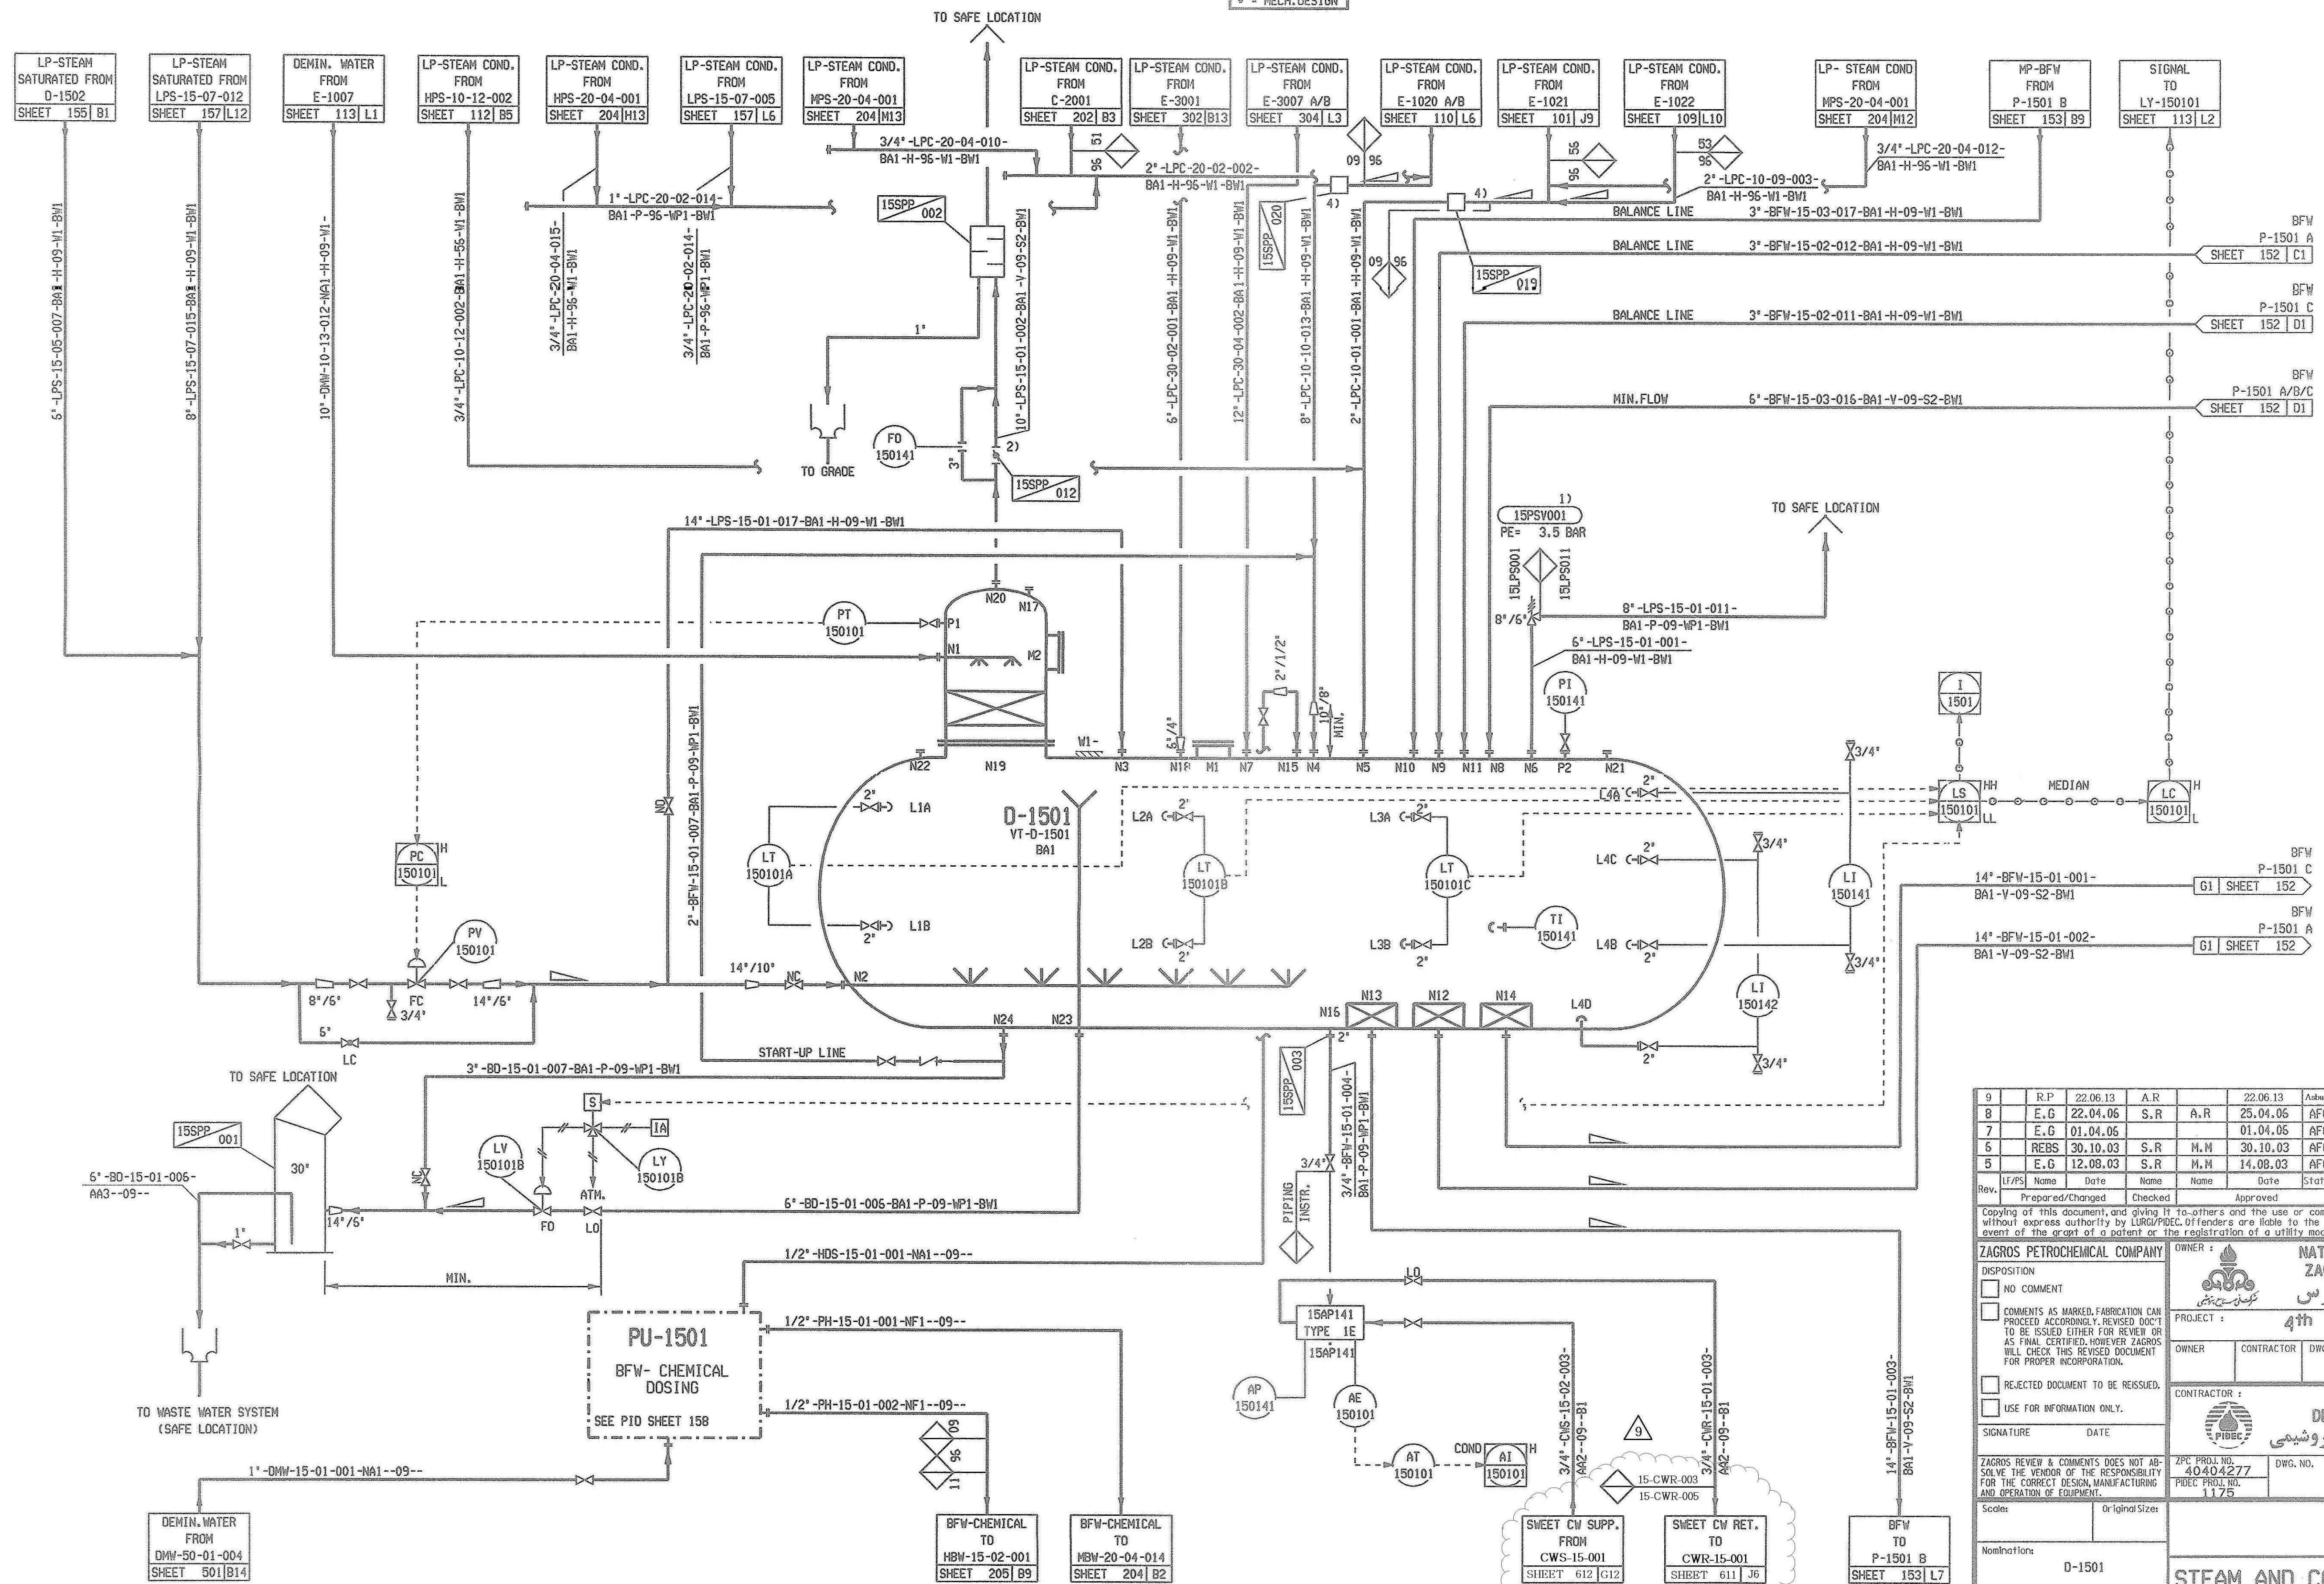

ZPC Doc. Center
As built

Rev.	LF/PS	Name	Date	Status	Kind of Revision
9	R.P.	22.06.13	A.R.	22.06.13	As built
8	E.G.	22.04.06	S.R.	25.04.06	AFC NO ISSUE
7	E.G.	01.04.06		01.04.06	AFC REVISED AS MARKED
6	REBS	30.10.03	S.R.	M.M.	30.10.03
5	E.G.	12.08.03	S.R.	M.M.	14.08.03
AFC REVISED AS MARKED (FROZEN)					
ZAGROS PETROCHEMICAL COMPANY					
OWNER: NATIONAL PETROCHEMICAL COMPANY					
PROJECT: 4th METHANOL PROJECT					
CONTRACTOR: PETROCHEMICAL INDUSTRIES DESIGN & ENGINEERING COMPANY					
SIGNATURE: DATE: P-15-1-PR-001					
ZAGROS REVIEW & COMMENTS DOES NOT ABSOLVE THE VENDOR OF THE RESPONSIBILITY FOR THE CORRECT DESIGN, MANUFACTURING AND OPERATION OF EQUIPMENT.					
Scales: Original Sizes					
Nominations: D-1501					
Basic document: DCC DG DL-No.					
Job name: MEGA METHANOL IRAN					
Lurgi Job No. 16966601 Lurgi Document No. 37151					
P&ID DIAGRAM SHEET 151					
Rev. 9					