



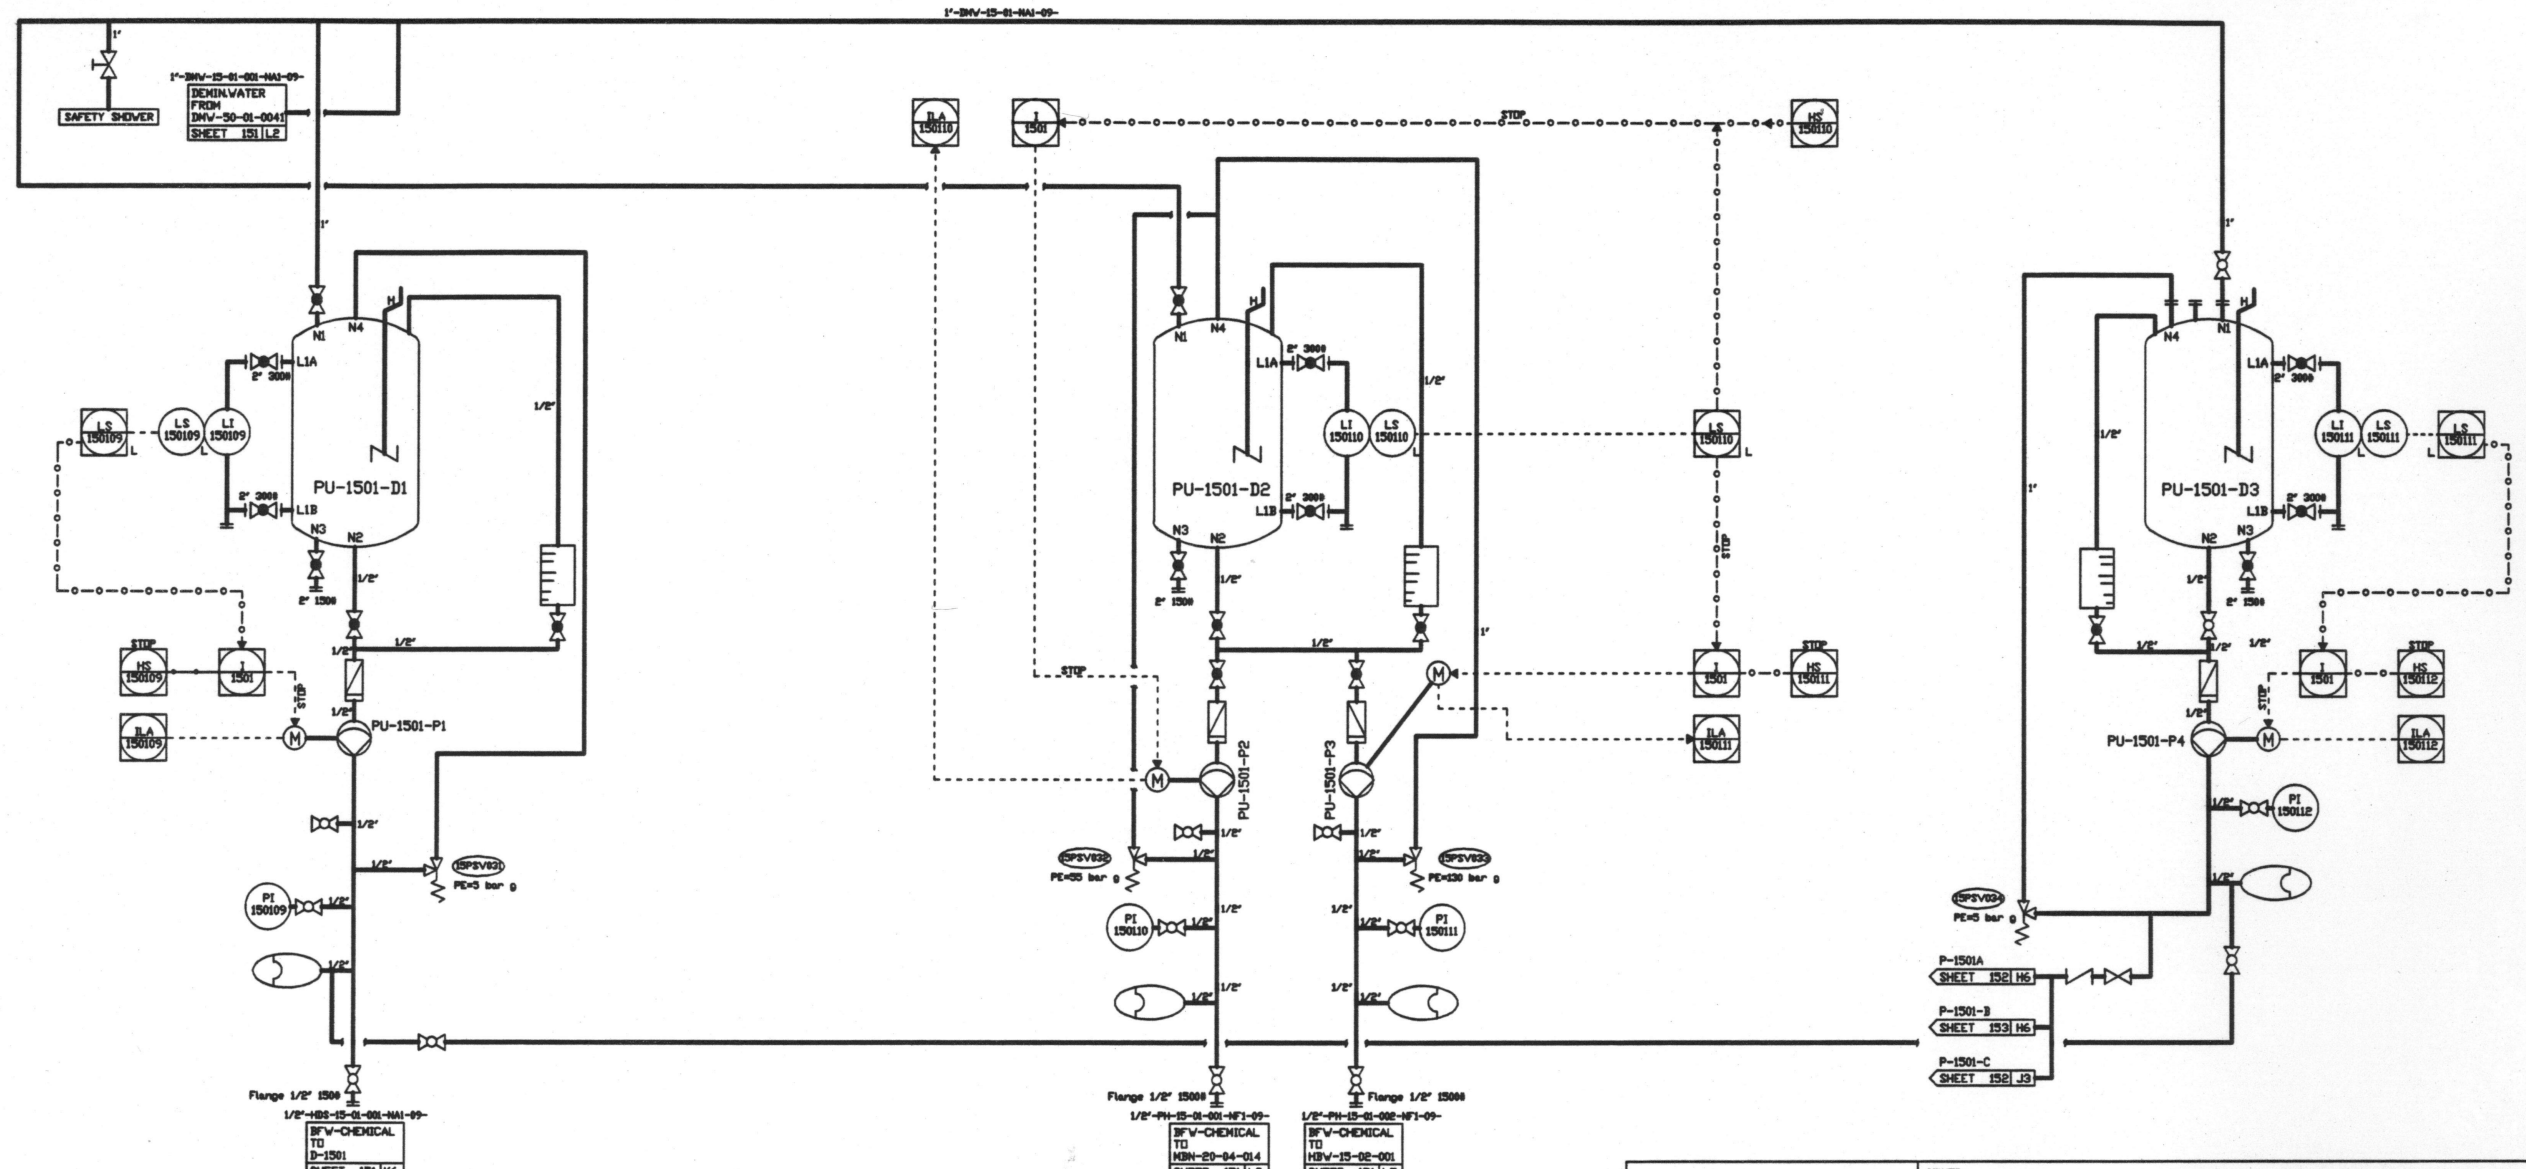

ZPC Doc. Center
As Built

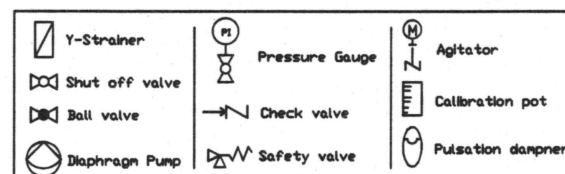

Rev.	LF/PS	Name	Date	Name	Date	Status
4		R.P	08.06.2014	A.T	M.N	08.06.2014
3		R.P	26.06.2013	A.F/A.T	M.N	26.06.2013
2		M.F	06.02.2004	A.V		
1		M.F	08.09.2003	A.V		
0		M.F	03.03.2003	A.V		
The copying, distribution and utilization of this document as well as the communication of its contents to others without expressed authorization by LURG/PIDEC is prohibited. DFenders will be held liable for the payment of damages. All rights reserved in the event of the grant of a patent, utility model or ornamental design registration.						

ZAGROS PETROCHEMICAL COMPANY		OWNER :		NATIONAL PETROCHEMICAL COMPANY ZAGROS PETROCHEMICAL COMPLEX شرکت پتروشیمی زاگرس	
DISPOSITION		PROJECT :		4 th METHANOL PROJECT	
☐ NO COMMENT ☐ COMMENTS AS MARKED. FABRICATION CAN PROCEED ACCORDINGLY. REVISED DOC'T TO BE ISSUED EITHER FOR REVIEW OR AS FINAL CERTIFIED. HOWEVER ZAGROS WILL CHECK THIS REVISED DOCUMENT FOR PROPER INCORPORATION. ☐ REJECTED DOCUMENT TO BE REISSUED. ☐ USE FOR INFORMATION ONLY.		OWNER		CONTRACTOR	
SIGNATURE		DATE		DIG-MC-011	
ZAGROS REVIEW & COMMENTS DOES NOT ABSOLVE THE VENDOR OF THE RESPONSIBILITY FOR THE CORRECT DESIGN, MANUFACTURING AND OPERATION OF EQUIPMENT.		ZPC PROJ. NO.		PIDEC PROJ. NO.	
Scale		Original Size		Rev. 4	
Identification		BFW Chemical Dosing Unit PU 1501 Unit 150 P & I DIAGRAM SHEET 158		Rev. 4	
Project name		Project No.		Document No.	
IT-Ident-No.		16966601		60979	