

R-2001 A/B
WATER COOLED
METHANOL REACTOR

A	6221	m ²
SHELL - pe	*	55 bar
SIDE - t	*	280 °C
TUBE - pe	*	88 bar
SIDE - t	*	280 °C

* = MECH.DESIGN

D-2001
STEAM DRUM

Vnom	57.2	m ³
od	2700	mm
1TL-TL	10000	mm
pe	*	54 bar
t	*	280 °C


* = MECH.DESIGN

J-2001 A/B/C/D
START UP EJECTOR

Vnom	m ³ /h
dp	bar
pe max	55 bar

REMARKS:

- ALL PRESSURES ARE IN GAUGE
IF NOT STATED OTHERWISE
- 1) LOCATED AT TOP
 - 2) ONLINE ANALYSIS ONLY IN SPECIAL CASES
 - 3) TIME DELAY 10 SEC.
 - 4) PART OF ANALYZER

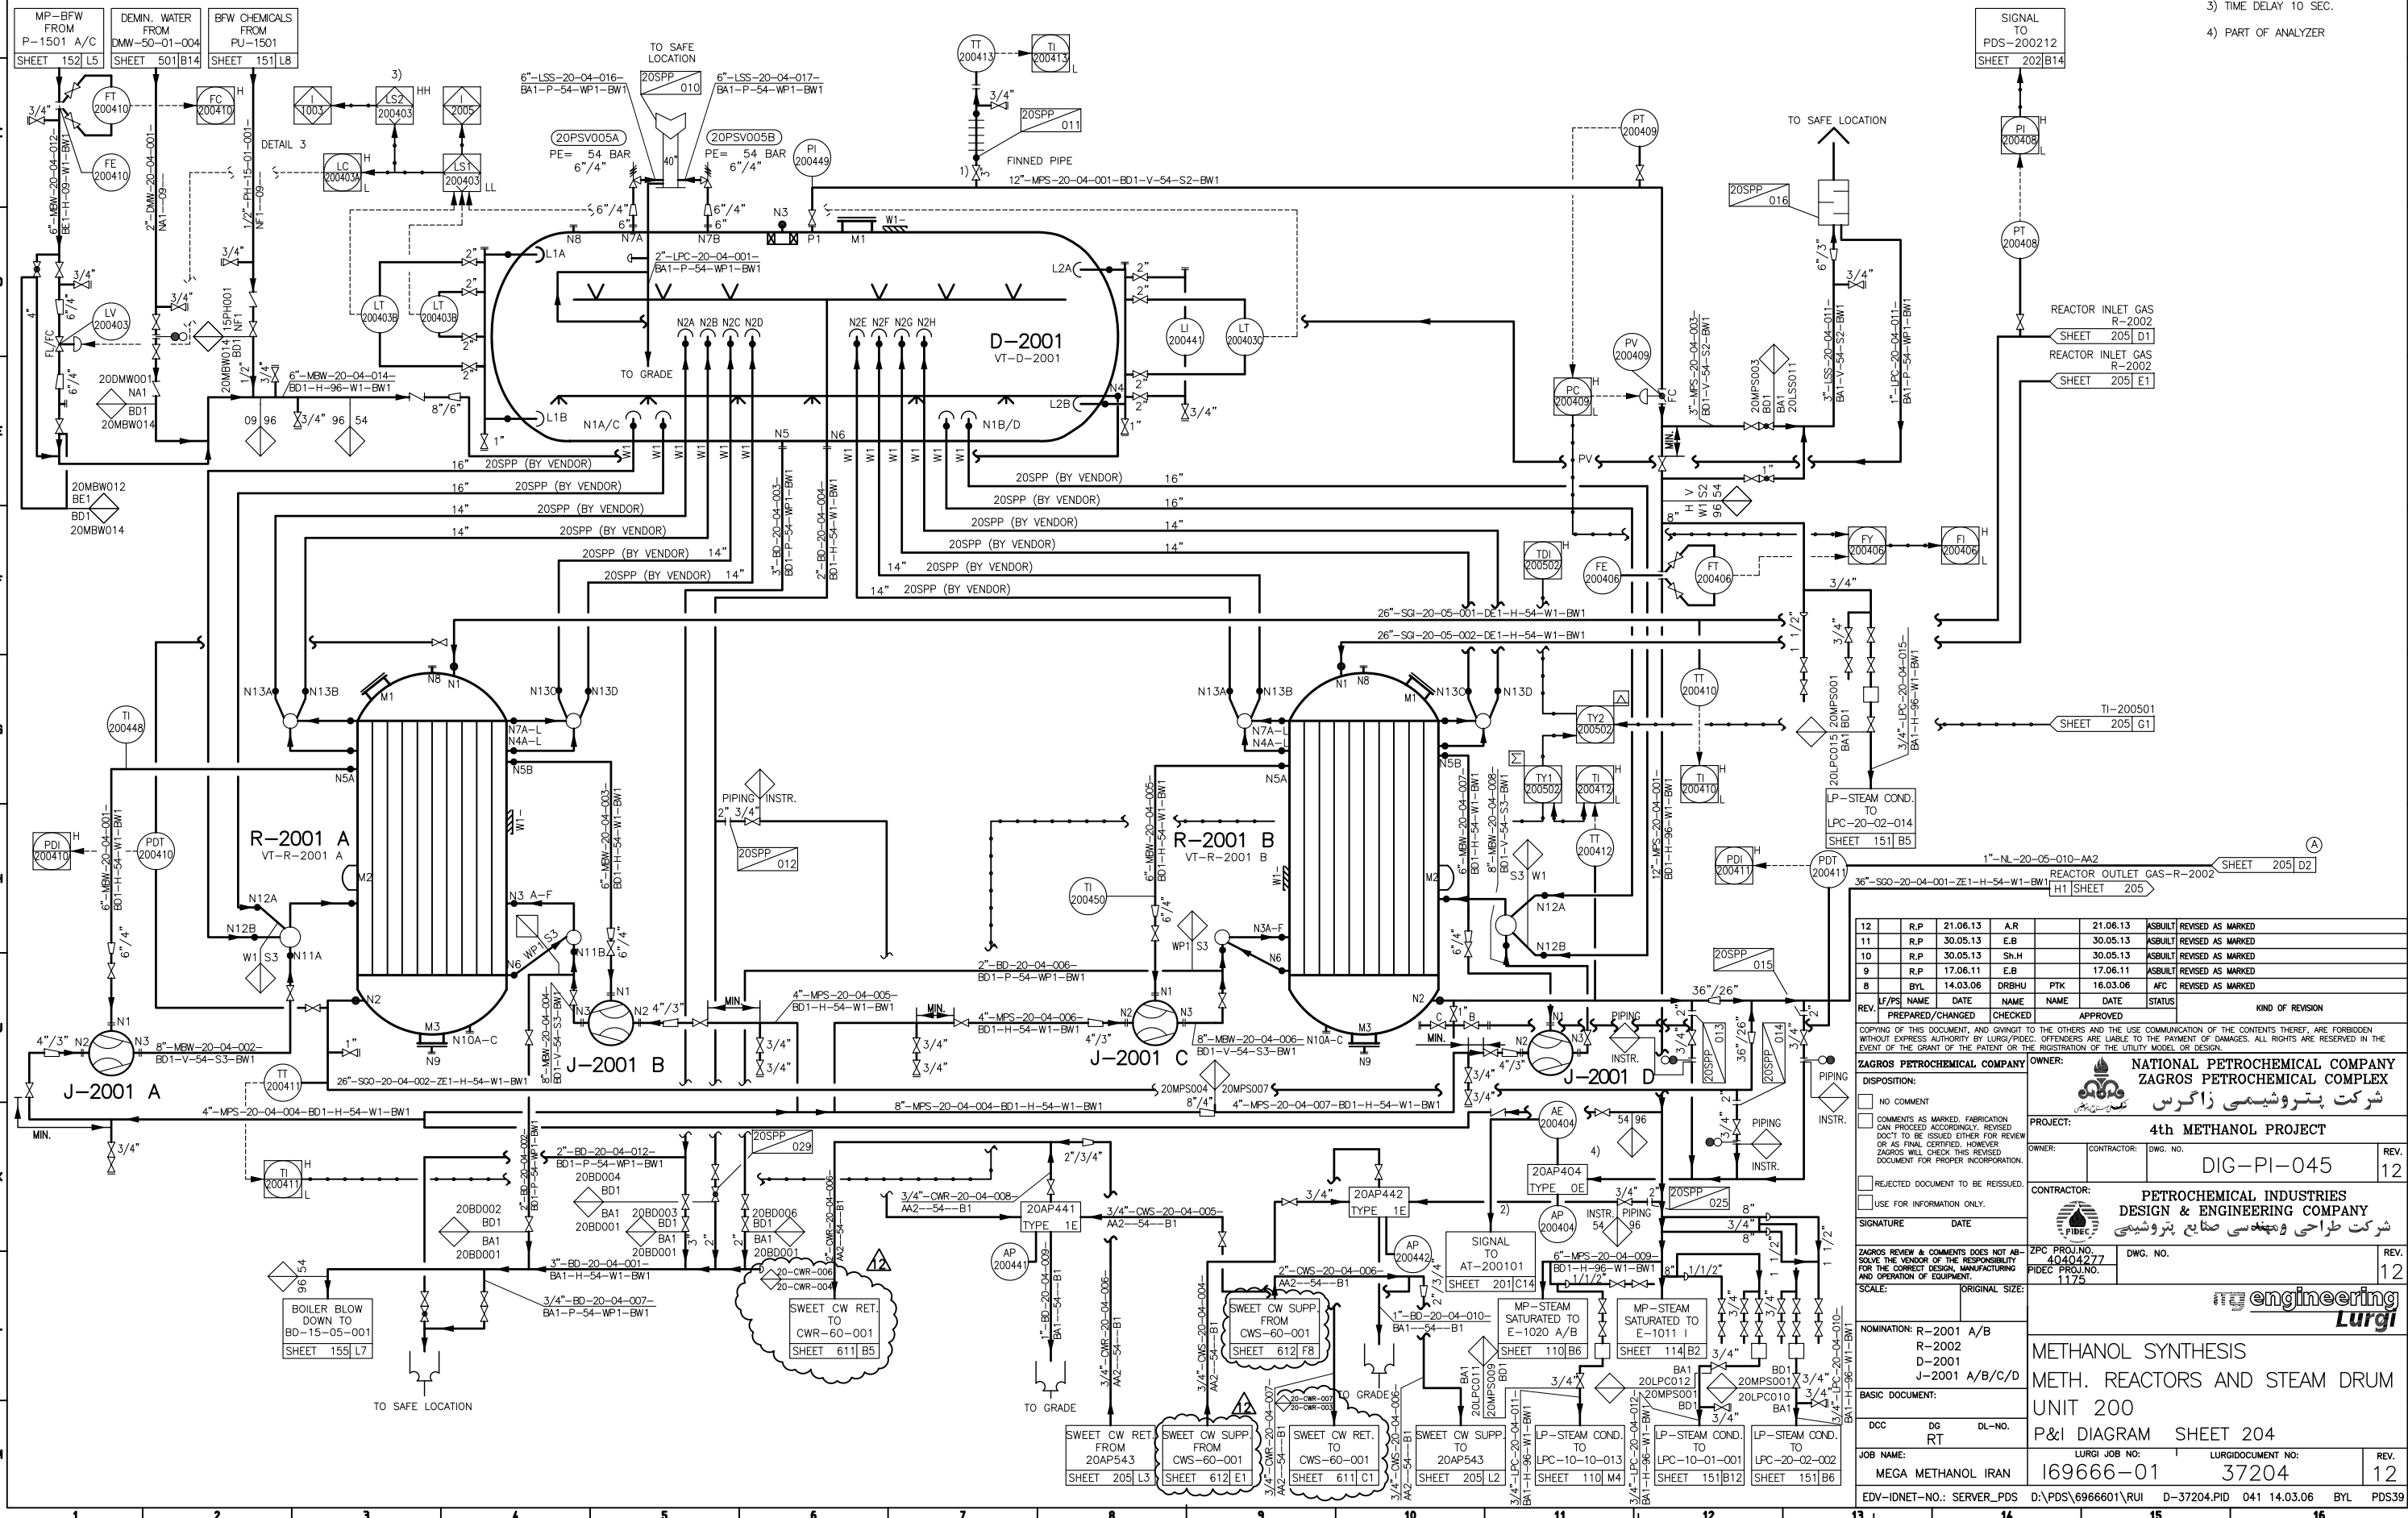

12	R.P	21.06.13	A.R	21.06.13	ASBUILT	REVISED AS MARKED
11	R.P	30.05.13	E.B	30.05.13	ASBUILT	REVISED AS MARKED
10	R.P	30.05.13	Sh.H	30.05.13	ASBUILT	REVISED AS MARKED
9	R.P	17.06.11	E.B	17.06.11	ASBUILT	REVISED AS MARKED
8	BYL	14.03.06	DRBHU	PTK	16.03.06	AFC REVISED AS MARKED
REV. / F/PS		NAME	DATE	NAME	DATE	STATUS
PREPARED/CHANGED		CHECKED		APPROVED		KIND OF REVISION
COPYING OF THIS DOCUMENT, AND GIVING IT TO THE OTHERS AND THE USE COMMUNICATION OF THE CONTENTS THEREOF, ARE FORBIDDEN WITHOUT EXPRESS AUTHORITY BY LURGI/PROJEC. OFFENDERS ARE LIABLE TO THE PAYMENT OF DAMAGES. ALL RIGHTS ARE RESERVED IN THE EVENT OF THE GRANT OF THE PATENT OR THE REGISTRATION OF THE UTILITY MODEL OR DESIGN.						
ZAGROS PETROCHEMICAL COMPANY			OWNER: NATIONAL PETROCHEMICAL COMPANY ZAGROS PETROCHEMICAL COMPLEX			
DISPOSITION:			شرکت پتروشیمی زاگرس			
☐ NO COMMENT			PROJECT: 4th METHANOL PROJECT			
☐ COMMENTS AS MARKED, FABRICATION CAN PROCEED ACCORDINGLY. REVISED DOCUMENT TO BE ISSUED EITHER FOR REVIEW OR AS FINAL CERTIFIED. HOWEVER ZAGROS WILL CHECK THIS REVISED DOCUMENT FOR PROPER INCORPORATION.			OWNER: CONTRACTOR: DWG. NO. DIG-PI-045			
☐ REJECTED DOCUMENT TO BE REISSUED.			CONTRACTOR: PETROCHEMICAL INDUSTRIES DESIGN & ENGINEERING COMPANY			
☐ USE FOR INFORMATION ONLY.			شرکت طراحی و مهندسی صنایع پتروشیمی			
SIGNATURE		DATE				
ZAGROS REVIEW & COMMENTS DOES NOT ABSOLVE THE VENDOR OF THE RESPONSIBILITY FOR THE CORRECT DESIGN, MANUFACTURING AND OPERATION OF EQUIPMENT.						
SCALE:		ORIGINAL SIZE:		engineering Lurgi		
NOMINATION: R-2001 A/B R-2002 D-2001 J-2001 A/B/C/D						
BASIC DOCUMENT:						
DOC		DG		DL-NO.		
		RT				
JOB NAME:		LURGI JOB NO:		LURGI DOCUMENT NO:		REV.
MEGA METHANOL IRAN		169666-01		37204		12
EDV-IDNET-NO.: SERVER_PDS		D:\PDS\6966601\RU		D-37204.PID 041 14.03.06 BYL		PDS39

13

14

15

16