


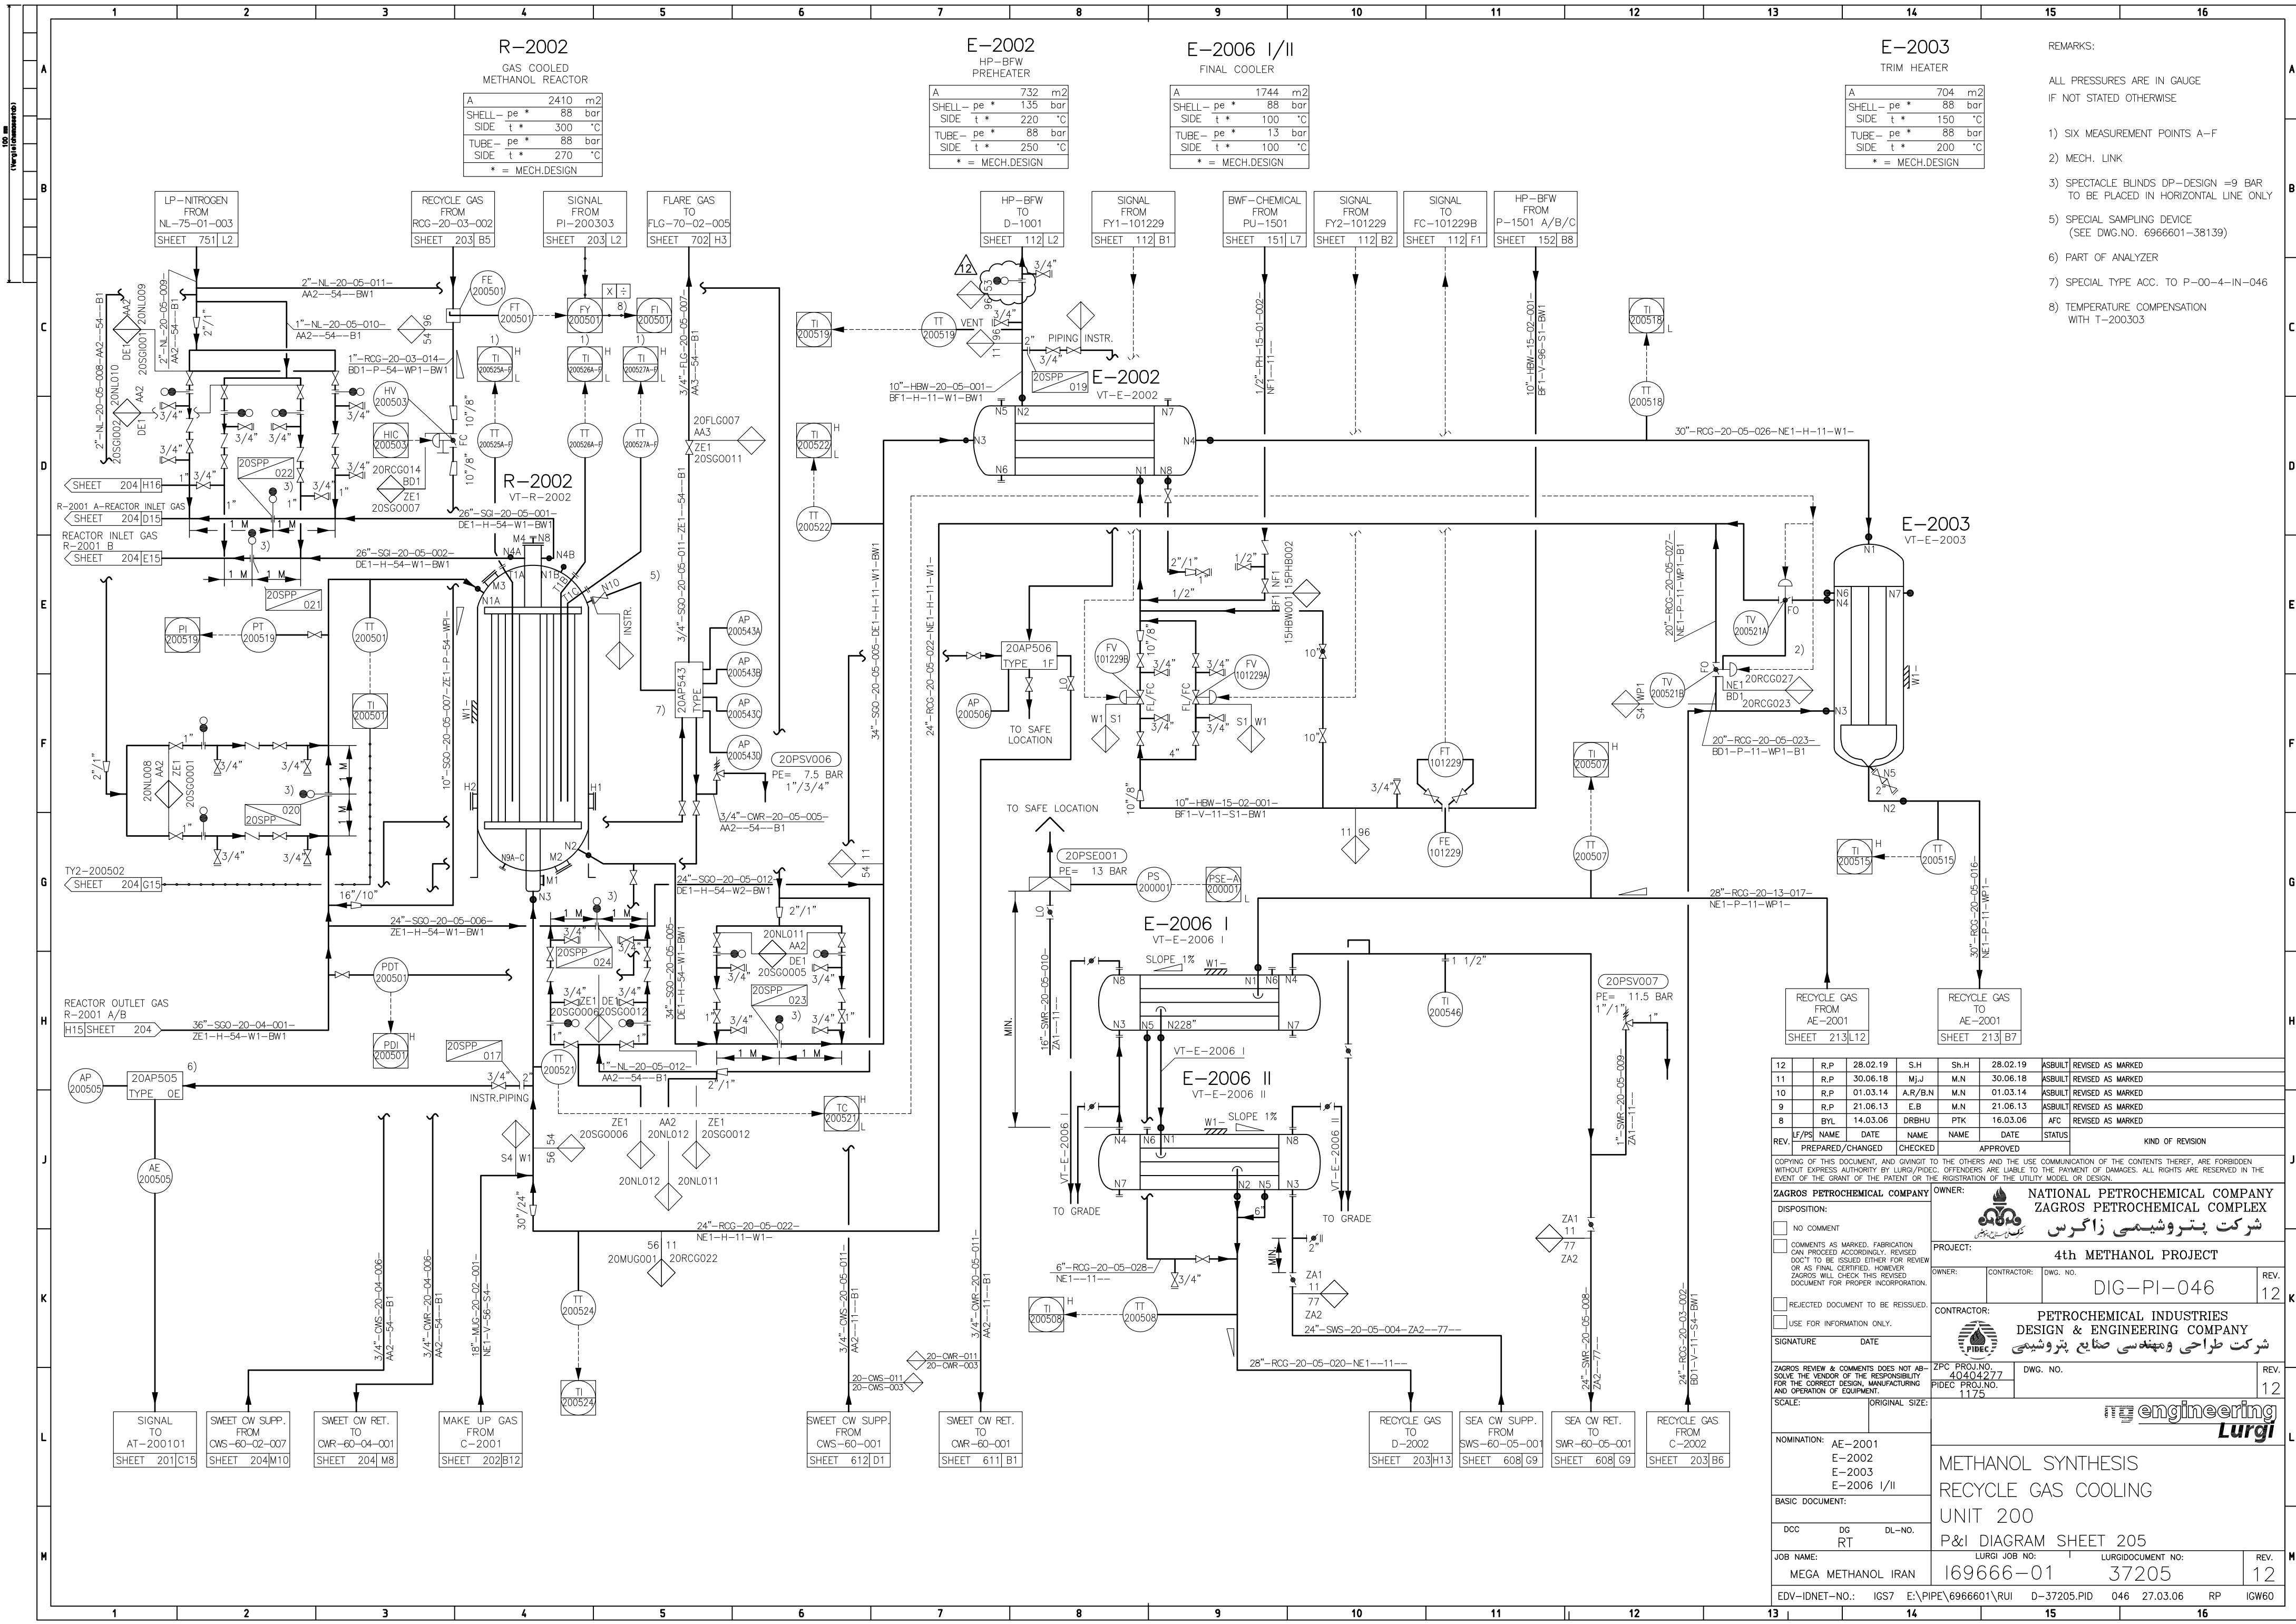

- REMARKS:
- ALL PRESSURES ARE IN GAUGE  
IF NOT STATED OTHERWISE
- SIX MEASUREMENT POINTS A-F  
TO BE PLACED IN HORIZONTAL LINE ONLY
  - MECH. LINK
  - SPECTACLE BLINDS DP-DESIGN =9 BAR  
TO BE PLACED IN HORIZONTAL LINE ONLY
  - SPECIAL SAMPLING DEVICE  
(SEE DWG.NO. 6966601-38139)
  - PART OF ANALYZER
  - SPECIAL TYPE ACC. TO P-00-4-IN-046
  - TEMPERATURE COMPENSATION  
WITH T-200303

|                                                                                                                                                                                                                                                                                                                                   |                  |          |                                                                                |       |          |                           |
|-----------------------------------------------------------------------------------------------------------------------------------------------------------------------------------------------------------------------------------------------------------------------------------------------------------------------------------|------------------|----------|--------------------------------------------------------------------------------|-------|----------|---------------------------|
| 12                                                                                                                                                                                                                                                                                                                                | R.P.             | 28.02.19 | S.H.                                                                           | Sh.H. | 28.02.19 | ASBUILT REVISED AS MARKED |
| 11                                                                                                                                                                                                                                                                                                                                | R.P.             | 30.06.18 | M.J.                                                                           | M.N.  | 30.06.18 | ASBUILT REVISED AS MARKED |
| 10                                                                                                                                                                                                                                                                                                                                | R.P.             | 01.03.14 | A.R./B.N.                                                                      | M.N.  | 01.03.14 | ASBUILT REVISED AS MARKED |
| 9                                                                                                                                                                                                                                                                                                                                 | R.P.             | 21.06.13 | E.B.                                                                           | M.N.  | 21.06.13 | ASBUILT REVISED AS MARKED |
| 8                                                                                                                                                                                                                                                                                                                                 | BYL              | 14.03.06 | DRBHU                                                                          | PTK   | 16.03.06 | AFC REVISED AS MARKED     |
| REV.                                                                                                                                                                                                                                                                                                                              | IF/PS            | NAME     | DATE                                                                           | NAME  | DATE     | STATUS                    |
|                                                                                                                                                                                                                                                                                                                                   | PREPARED/CHANGED | CHECKED  | APPROVED                                                                       |       |          | KIND OF REVISION          |
| COPYING OF THIS DOCUMENT, AND GIVING TO THE OTHERS AND THE USE COMMUNICATION OF THE CONTENTS THEREOF, ARE FORBIDDEN WITHOUT EXPRESS AUTHORITY BY LURGI/PIDEC. OFFENDERS ARE LIABLE TO THE PAYMENT OF DAMAGES. ALL RIGHTS ARE RESERVED IN THE EVENT OF THE GRANT OF THE PATENT OR THE REGISTRATION OF THE UTILITY MODEL OR DESIGN. |                  |          |                                                                                |       |          |                           |
| ZAGROS PETROCHEMICAL COMPANY                                                                                                                                                                                                                                                                                                      |                  |          | OWNER: NATIONAL PETROCHEMICAL COMPANY<br>ZAGROS PETROCHEMICAL COMPLEX          |       |          |                           |
| DISPOSITION:                                                                                                                                                                                                                                                                                                                      |                  |          | PROJECT: 4th METHANOL PROJECT                                                  |       |          |                           |
| <input type="checkbox"/> NO COMMENT                                                                                                                                                                                                                                                                                               |                  |          | OWNER: CONTRACTOR: DWG. NO. DIG-PI-046                                         |       |          |                           |
| <input type="checkbox"/> COMMENTS AS MARKED. FABRICATION CAN PROCEED ACCORDINGLY. REVISED DOC" TO BE ISSUED EITHER FOR REVIEW OR AS FINAL CERTIFIED. HOWEVER ZAGROS WILL CHECK THIS REVISED DOCUMENT FOR PROPER INCORPORATION.                                                                                                    |                  |          | CONTRACTOR: PETROCHEMICAL INDUSTRIES<br>DESIGN & ENGINEERING COMPANY           |       |          |                           |
| <input type="checkbox"/> REJECTED DOCUMENT TO BE REISSUED.                                                                                                                                                                                                                                                                        |                  |          | ZPC PROJ.NO. 40404277                                                          |       |          |                           |
| <input type="checkbox"/> USE FOR INFORMATION ONLY.                                                                                                                                                                                                                                                                                |                  |          | PIDEC PROJ.NO. 1175                                                            |       |          |                           |
| ZAGROS REVIEW & COMMENTS DOES NOT ABSOLVE THE VENDOR OF THE RESPONSIBILITY FOR THE CORRECT DESIGN, MANUFACTURING AND OPERATION OF EQUIPMENT.                                                                                                                                                                                      |                  |          | SCALE: ORIGINAL SIZE: engineering Lurgi                                        |       |          |                           |
| NOMINATION: AE-2001<br>E-2002<br>E-2003<br>E-2006 I/II                                                                                                                                                                                                                                                                            |                  |          | METHANOL SYNTHESIS<br>RECYCLE GAS COOLING<br>UNIT 200<br>P&I DIAGRAM SHEET 205 |       |          |                           |
| BASIC DOCUMENT:                                                                                                                                                                                                                                                                                                                   |                  |          | DCC DG DL-NO.                                                                  |       |          |                           |
| JOB NAME: MEGA METHANOL IRAN                                                                                                                                                                                                                                                                                                      |                  |          | LURGI JOB NO: 169666-01                                                        |       |          |                           |
| EDV-IDNET-NO.:                                                                                                                                                                                                                                                                                                                    |                  |          | LURGI DOCUMENT NO: 37205                                                       |       |          |                           |
| IGS7                                                                                                                                                                                                                                                                                                                              |                  |          | REV. 12                                                                        |       |          |                           |
| E:\PIPE\6966601\RU                                                                                                                                                                                                                                                                                                                |                  |          | D-37205.PID                                                                    |       |          |                           |
| 046                                                                                                                                                                                                                                                                                                                               |                  |          | 27.03.06                                                                       |       |          |                           |
| RP                                                                                                                                                                                                                                                                                                                                |                  |          | IGW60                                                                          |       |          |                           |