

FT-2501


HYDROGEN PRODUCT FILTER

DD	mm/	406
ITL-TL	mm/	---
pe	bar(g)/	39
t	°C/	80
*	=	DESIGN

D-2502

OFF GAS DRUM

DD	mm/	4000
ITL-TL	mm/	46000
pe	bar(g)/	4
t	°C/	80
*	=	DESIGN

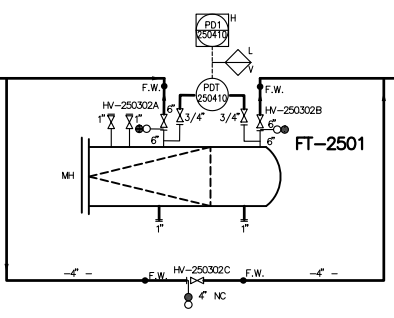

H2-PRODUCT
PPP 1001.02


H2-PRODUCT
SHEET 251

FLARE GAS
PPP 1001.02

FLARE GAS
SHEET 251

OFF GAS
PPP 1001.02

OFF GAS
SHEET 251

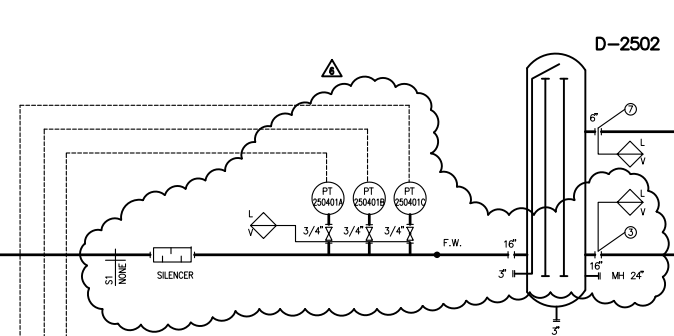

ITC engineering Lurgi Oil Gas Chemie			
Authorization to proceed does not release contractor or vendor of his obligations or liabilities under the contract, previous or otherwise.			
Date	Signature	Symbol	Dept.
			ASGMS

ZAGROS PETROCHEMICAL COMPANY		OWNER: NATIONAL PETROCHEMICAL COMPANY ZAGROS PETROCHEMICAL COMPLEX شرکت پتروشیمی زاگرس	
DISPOSITION: <input type="checkbox"/> NO COMMENT <input type="checkbox"/> COMMENTS AS MARKED, FABRICATION CAN PROCEED ACCORDINGLY. REVIEW DOCT TO BE ISSUED EITHER FOR REVIEW OR AS FINAL CERTIFIED. HONORER ZAGROS WILL CHECK THIS RECORD DOCUMENT FOR PROPER INCORPORATION. <input type="checkbox"/> REJECTED DOCUMENT TO BE REISSUED. <input type="checkbox"/> USE FOR INFORMATION ONLY.		PROJECT: 4th METHANOL PLANT	
SIGNATURE		DATE	REV. 6
ZAGROS REVIEW & COMMENTS DOES NOT ASSUME THE BURDEN OF THE RESPONSIBILITY FOR THE CORRECT DESIGN, MANUFACTURING AND OPERATION OF EQUIPMENT.		ZPC PROJ. NO. 40404277 PIEC: PROJ. NO. 1175	DWG. NO. REV. 6
SCALE: ORIGINAL SIZE: AT		CONTRACTOR: PETROCHEMICAL INDUSTRIES DESIGN & ENGINEERING COMPANY شرکت طراحی و مهندسی پتروشیمی	
NOMINATION: D-2502 FT-2501		DIG-PI-072 REV. 6	
BASIC DOCUMENT:		CONTRACTOR: ITC engineering Lurgi	
JOB NAME:		HYDROGEN RECOVERY UNIT (PSA) H2-FILTER AND OFF GAS DRUM UNIT PU-2501	
PREPARED/CHANGED		P&I DIAGRAM SHEET 254	
CHECKED		LURG JOB NO: 169666-01	
APPROVED		LURGDRAWING NO: 60949	
KIND OF REVISION		REV. 6	

LINDE ENGINEERING DIVISION B2049 HOELLREIGELSTRASSE		Linde PROJ. NO. 2210 1168 BANDAR ASSALUYE-M DOC.-NO. P PP 1001.03					
THIS DOCUMENT MUST BE TREATED AS CONFIDENTIAL AND NOT BE COPIED, REPRODUCED OR DISCLOSED IN ANY MANNER WITHOUT WRITTEN PERMISSION. ALL RIGHTS ARE RESERVED.							
0	E.N	13.06.21	M.NOORI	S.H	13.06.21	A.B	AS BUILT
5		04.11.03	S.H	H.S	04.11.03	A.B	AS BUILT
4	S.F	11.06.03	S.CH	H.S	11.06.03	A.B	AS BUILT
3	S.K	07.02.03	S.CH	N.D	07.02.03	A.FD	APPROVED FOR DESIGN
2	S.K	18.11.02	S.CH	N.D	18.11.02	A.FD	APPROVED FOR DESIGN
REV	PREPARED/CHANGED	DATE	NAME	DATE	STATUS		KIND OF REVISION
	CHECKED						
	APPROVED						

COPYING OF THIS DOCUMENT, AND GIVING IT TO OTHERS AND THE USE COMMUNICATION OF THE CONTENTS THEREOF, ARE FORBIDDEN WITHOUT EXPRESS AUTHORITY BY LURGI/P&I. OFFENDERS ARE LIABLE TO THE PAYMENT OF DAMAGES. ALL RIGHTS ARE RESERVED IN THE EVENT OF THE GRANT OF THE PATENT OR THE REGISTRATION OF THE UTILITY MODEL OR DESIGN.