



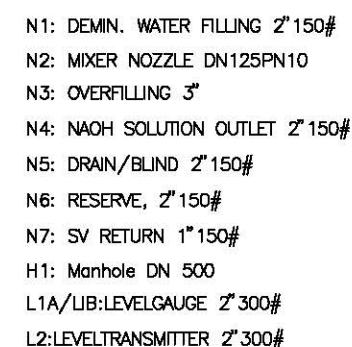

Client

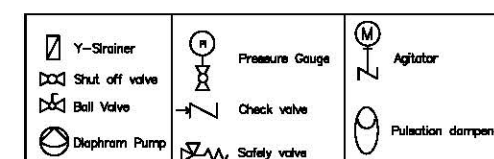

3	EN	26.08.2021	B.N/ARM	SH.H	26.08.2121		As Built
2	M.F	03.11.2003	A.V				ADD.DWG.NO
1	M.F	08.09.2003	A.V				AFC
0	M.F	03.03.2003	A.V				FIRST ISSUE
REV.	J/P/S	NAME	DATE	NAME	DATE	STATUS	KIND OF REVISION
		PREPARED/CHANGED	CHECKED		APPROVED		

THE COPYING, DISTRIBUTION AND UTILIZATION OF THIS DOCUMENT AS WELL AS THE COMMUNICATION OF ITS CONTENTS TO OTHERS WITH EXPRESS AUTHORIZATION BY LURGI/PIDEC IS PROHIBITED. OFFENDERS WILL BE HELD LIABLE FOR THE PAYMENT OF DAMAGES. ALL RIGHTS RESERVED IN THE IN THE EVENT OF THE GRANT OF A PATENT, UTILITY MODEL OR ORNAMENTAL DESIGN REGISTRATION.

ZAGROS PETROCHEMICAL COMPANY		OWNER:  شركت پتروشیمی زاگرس		NATIONAL PETROCHEMICAL COMPANY ZAGROS PETROCHEMICAL COMPLEX	
DISPOSITION: ☐ NO COMMENT ☐ COMMENTS AS MARKED, FABRICATION CAN PROCEED ACCORDINGLY, REVISED DOCUMENT TO BE ISSUED EITHER FOR REVIEW OR AS FINAL CERTIFIED, HOWEVER ZAGROS WILL CHECK THIS REVISED DOCUMENT FOR PROPER INCORPORATION. ☐ REJECTED DOCUMENT TO BE REISSUED. ☐ USE FOR INFORMATION ONLY.		PROJECT: 4th METHANOL PROJECT			
SIGNATURE DATE		OWNER:		CONTRACTOR: DWG. NO. DIG-MC-010	
		CONTRACTOR:  شركت طراحی ومهندسی صنایع پتروشیمی		PETROCHEMICAL INDUSTRIES DESIGN & ENGINEERING COMPANY REV. 3	
ZAGROS REVIEW & COMMENTS DOES NOT ABSOLVE THE VENDOR OF THE RESPONSIBILITY FOR THE CORRECT DESIGN, MANUFACTURING AND OPERATION OF EQUIPMENT.		ZPC PROJ.NO. 40404277		DWG. NO.	
		PIDEC PROJ.NO. 1175		REV. 3	
SCALE:		ORIGINAL SIZE:		engineering Lurgi	
		A2			
NOMINATION:		NAOH DOSING PACKAGE			
		PU-3001			
		UNIT 300			
BASIC DOCUMENT:		P&I DIAGRAM SHEET 315			
DOC DG DL-NO.					
JOB NAME:		LURGI JOB NO:		LURGI DOCUMENT NO:	
		16966601		60959	
IT-IDENT- NO:				REV. 3	