


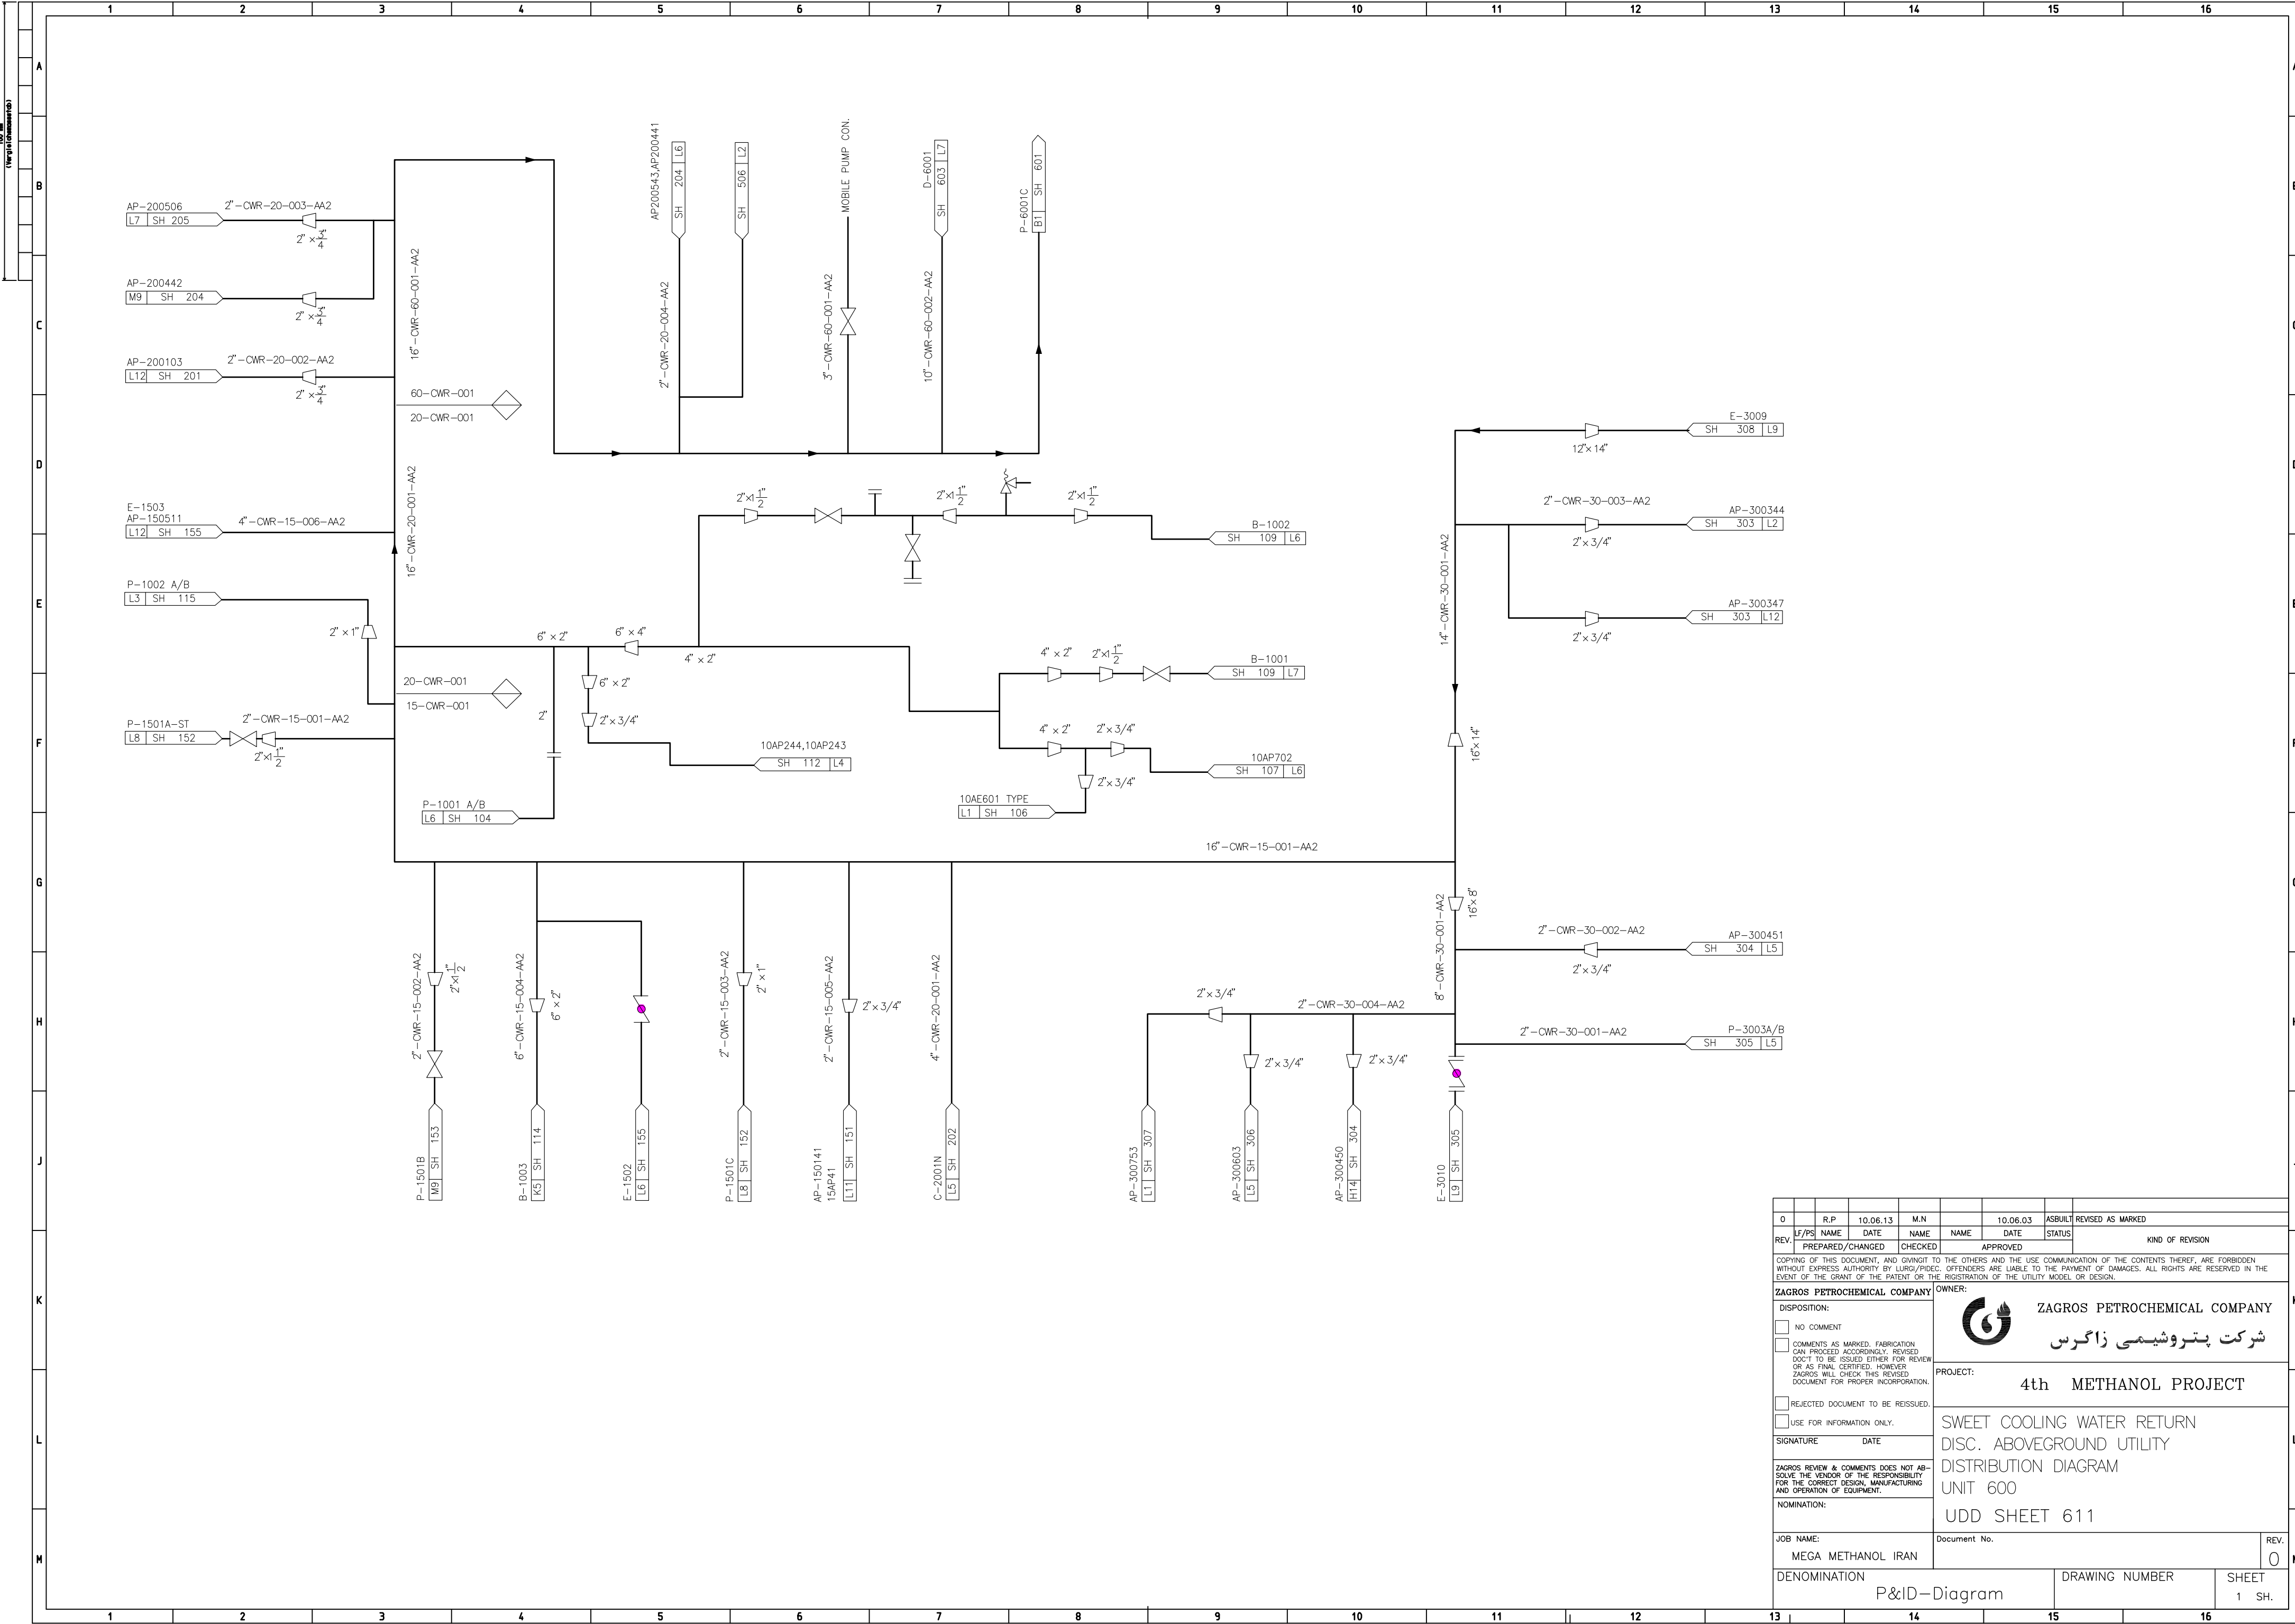

0		R.P	10.06.13	M.N			10.06.03	ASBUILT	REVISED AS MARKED	
REV.	F/PS	NAME	DATE	NAME	NAME	DATE	STATUS	KIND OF REVISION		
		PREPARED/CHANGED		CHECKED	APPROVED					
COPYING OF THIS DOCUMENT, AND GIVING IT TO THE OTHERS AND THE USE COMMUNICATION OF THE CONTENTS THEREOF, ARE FORBIDDEN WITHOUT EXPRESS AUTHORITY BY LUGR/PIEC. OFFENDERS ARE LIABLE TO THE PAYMENT OF DAMAGES. ALL RIGHTS ARE RESERVED IN THE EVENT OF THE GRANT OF THE PATENT OR THE REGISTRATION OF THE UTILITY MODEL OR DESIGN.										
ZAGROS PETROCHEMICAL COMPANY					OWNER:					
DISPOSITION:					 ZAGROS PETROCHEMICAL COMPANY شرکت پتروشیمی زاگرس					
☐ NO COMMENT										
☐ COMMENTS AS MARKED. FABRICATION CAN PROCEED ACCORDINGLY. REVISED DOCUMENT TO BE ISSUED EITHER FOR REVIEW OR AS FINAL CERTIFIED. HOWEVER ZAGROS WILL CHECK THIS REVISED DOCUMENT FOR PROPER INCORPORATION.										
☐ REJECTED DOCUMENT TO BE REISSUED.										
☐ USE FOR INFORMATION ONLY.					PROJECT:					
SIGNATURE					DATE					
ZAGROS REVIEW & COMMENTS DOES NOT ABSOLVE THE VENDOR OF THE RESPONSIBILITY FOR THE CORRECT DESIGN, MANUFACTURING AND OPERATION OF EQUIPMENT.					4th METHANOL PROJECT					
NOMINATION:					SWEET COOLING WATER RETURN DISC. ABOVEGROUND UTILITY DISTRIBUTION DIAGRAM UNIT 600 UDD SHEET 611					
JOB NAME:					Document No.					REV.
MEGA METHANOL IRAN										0
DENOMINATION					DRAWING NUMBER			SHEET		
P&ID-Diagram								1 SH.		