


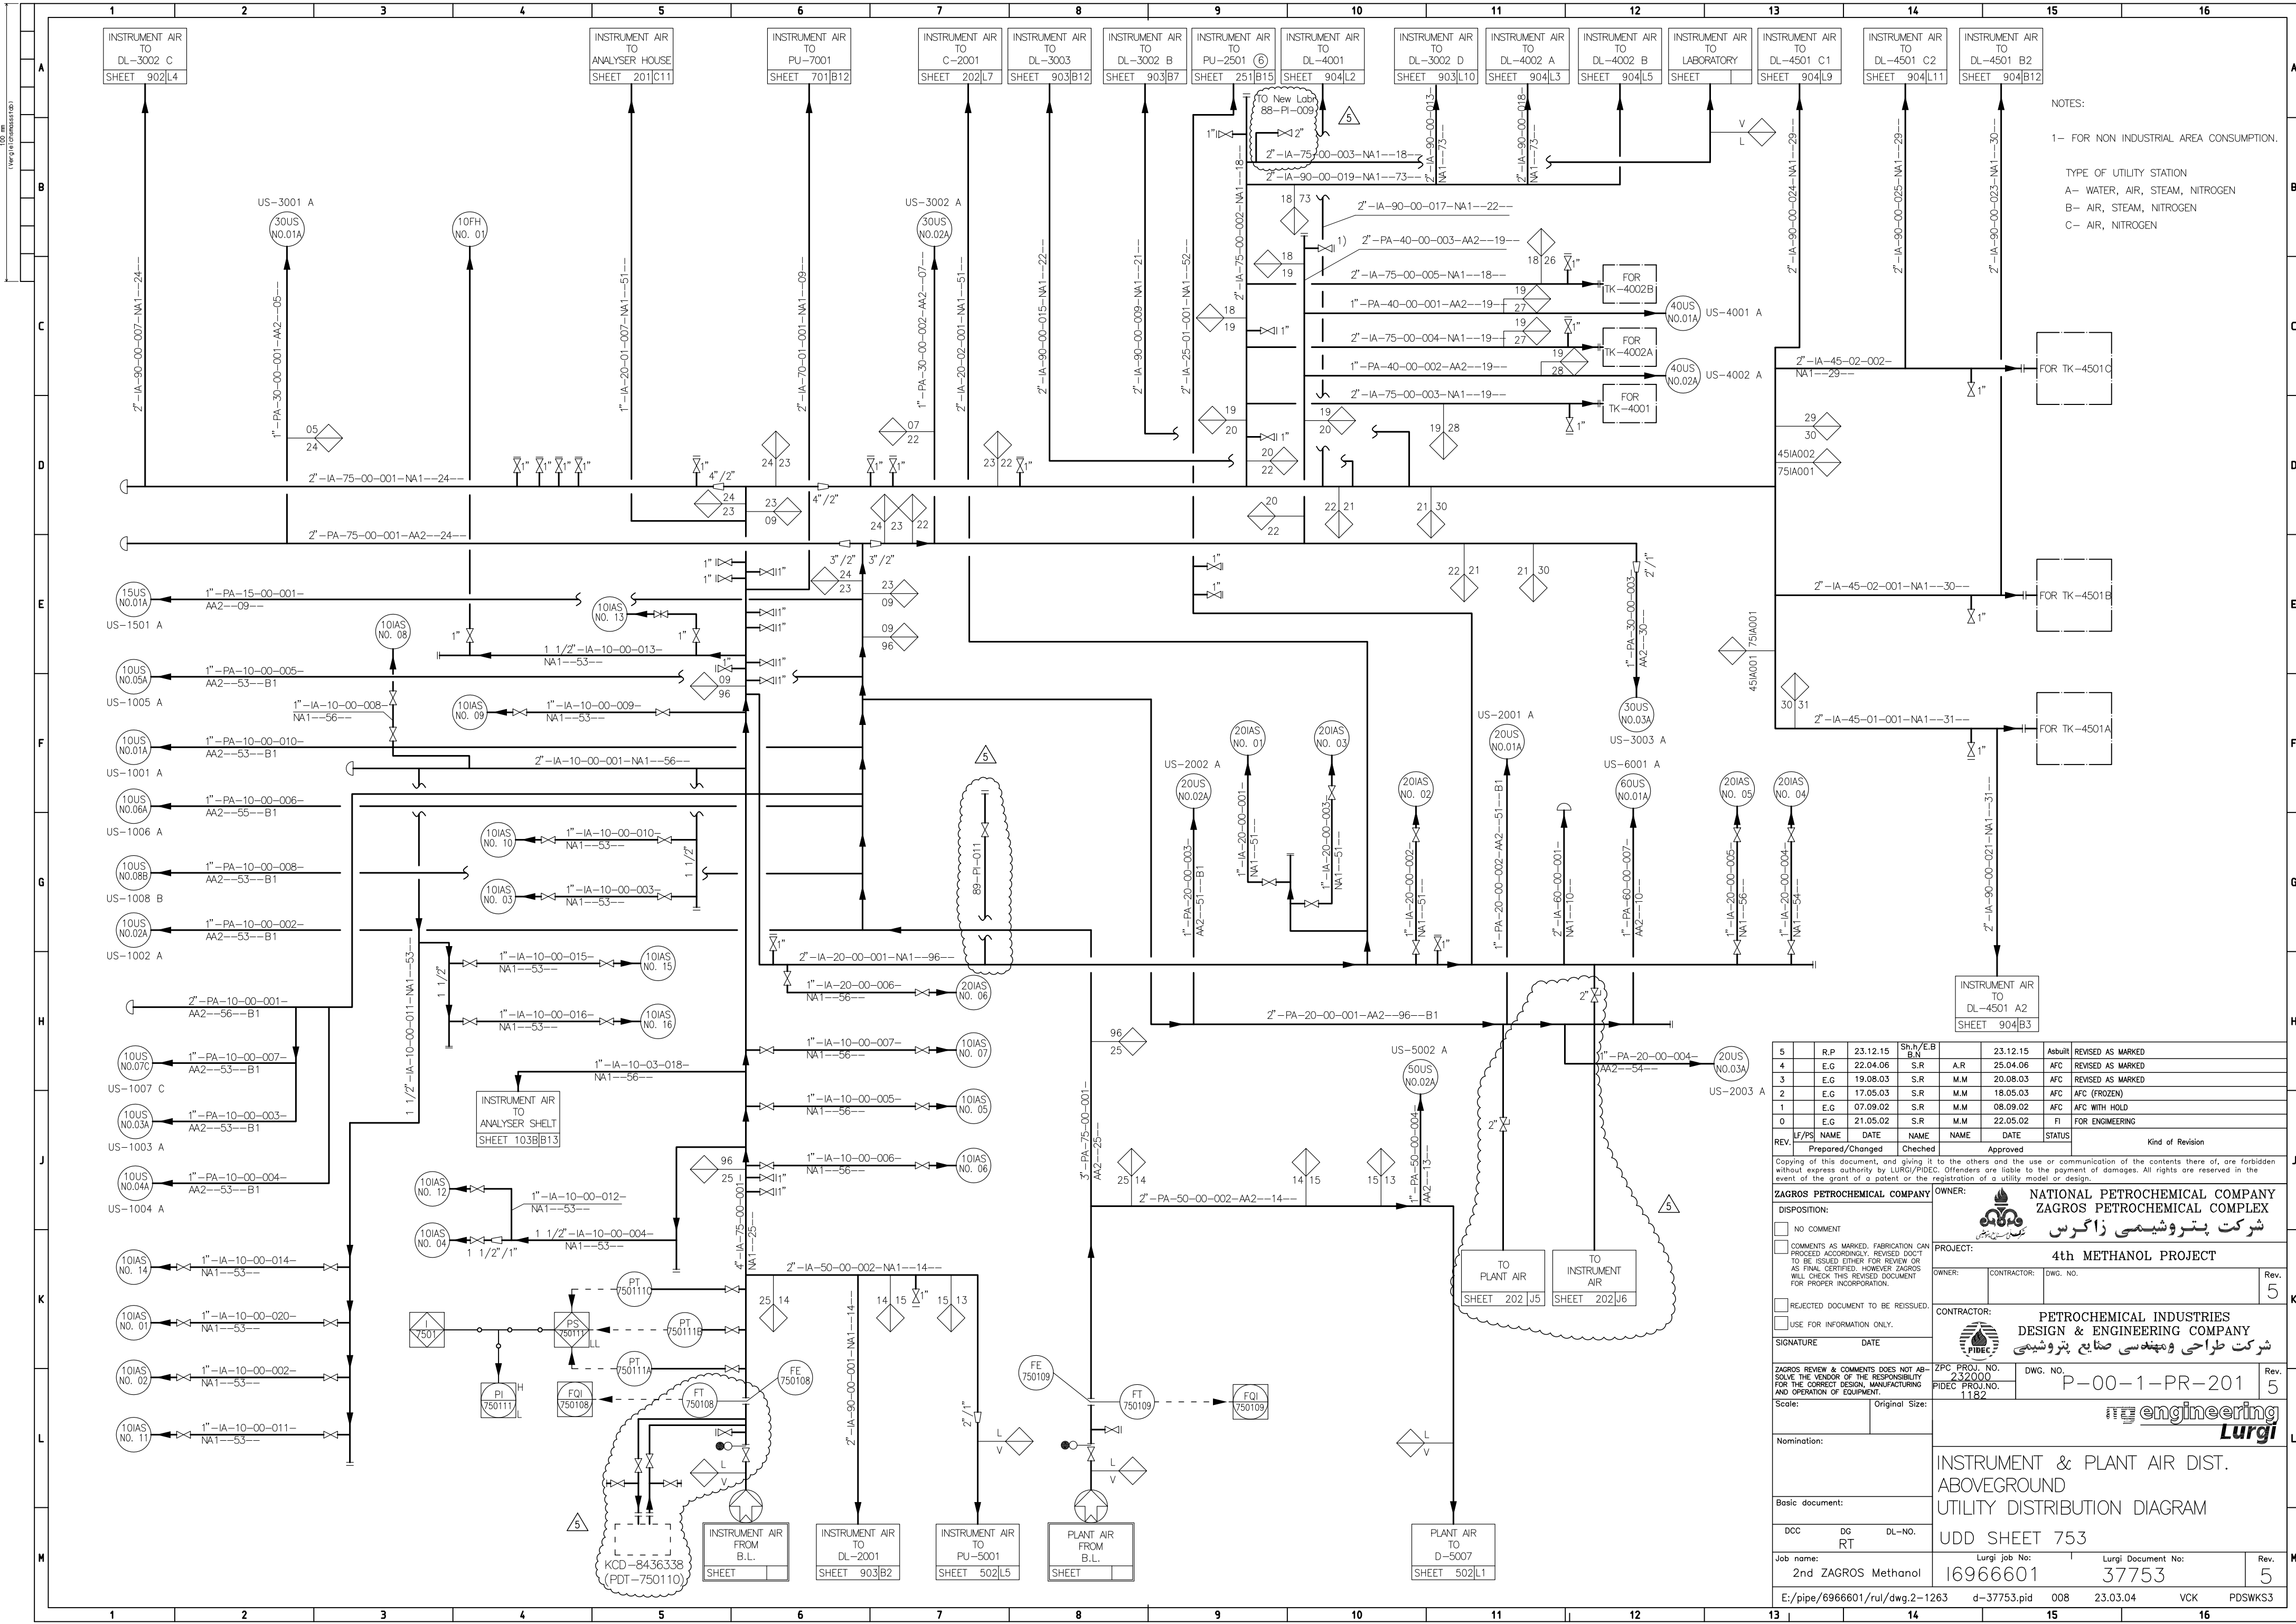

NOTES:

1- FOR NON INDUSTRIAL AREA CONSUMPTION.

TYPE OF UTILITY STATION

A- WATER, AIR, STEAM, NITROGEN

B- AIR, STEAM, NITROGEN

C- AIR, NITROGEN

5	R.P.	23.12.15	Sh.h/E.B B.N	23.12.15	Asbuilt	REVISED AS MARKED
4	E.G.	22.04.06	S.R	A.R	25.04.06	AFC REVISED AS MARKED
3	E.G.	19.08.03	S.R	M.M	20.08.03	AFC REVISED AS MARKED
2	E.G.	17.05.03	S.R	M.M	18.05.03	AFC AFC (FROZEN)
1	E.G.	07.09.02	S.R	M.M	08.09.02	AFC AFC WITH HOLD
0	E.G.	21.05.02	S.R	M.M	22.05.02	FI FOR ENGINEERING
REV.	LF/PS	NAME	DATE	NAME	DATE	STATUS
Prepared/Changed		Checked		Approved		Kind of Revision
Copying of this document, and giving it to the others and the use or communication of the contents there of, are forbidden without express authority by LURGI/PIDEC. Offenders are liable to the payment of damages. All rights are reserved in the event of the grant of a patent or the registration of a utility model or design.						
ZAGROS PETROCHEMICAL COMPANY			OWNER: NATIONAL PETROCHEMICAL COMPANY ZAGROS PETROCHEMICAL COMPLEX شرکت پتروشیمی زاگرس			
DISPOSITION:			PROJECT: 4th METHANOL PROJECT			
☐ NO COMMENT			OWNER: CONTRACTOR: DWG. NO.			
☐ COMMENTS AS MARKED. FABRICATION CAN PROCEED ACCORDINGLY. REVISED DOCT TO BE ISSUED EITHER FOR REVIEW OR AS FINAL CERTIFIED. HOWEVER ZAGROS WILL CHECK THIS REVISED DOCUMENT FOR PROPER INCORPORATION.			CONTRACTOR: PETROCHEMICAL INDUSTRIES DESIGN & ENGINEERING COMPANY شرکت طراحی و مهندسی صنایع پتروشیمی			
☐ REJECTED DOCUMENT TO BE REISSUED.			ZPC PROJ. NO. 232000 PIDEC PROJ. NO. 1182			
☐ USE FOR INFORMATION ONLY.			DWG. NO. P-00-1-PR-201			
SIGNATURE			Scale: Original Size: engineering Lurgi			
DATE			Nomination:			
ZAGROS REVIEW & COMMENTS DOES NOT ABSOLVE THE VENDOR OF THE RESPONSIBILITY FOR THE CORRECT DESIGN, MANUFACTURING AND OPERATION OF EQUIPMENT.			Basic document:			
DCC DG RT			DL-NO.			
Job name: 2nd ZAGROS Methanol			Lurgi job No: 16966601			
E:/pipe/6966601/ru/dwg.2-1263			Lurgi Document No: 37753			
d-37753.pid			Rev. 5			
008			23.03.04			
VCK			PDSWKS3			