


AE-2001
AIR COOLER

A	142.4	m2
Tube- pe	88	bar
side t	200	°C
* = MECH.DESIGN		

REMARKS:
ALL PRESSURES ARE IN GAUGE
IF NOT STATED OTHERWISE

- 1) TOTAL 32 FANS
2) I-1000 PULSE MOTOR TO STOP

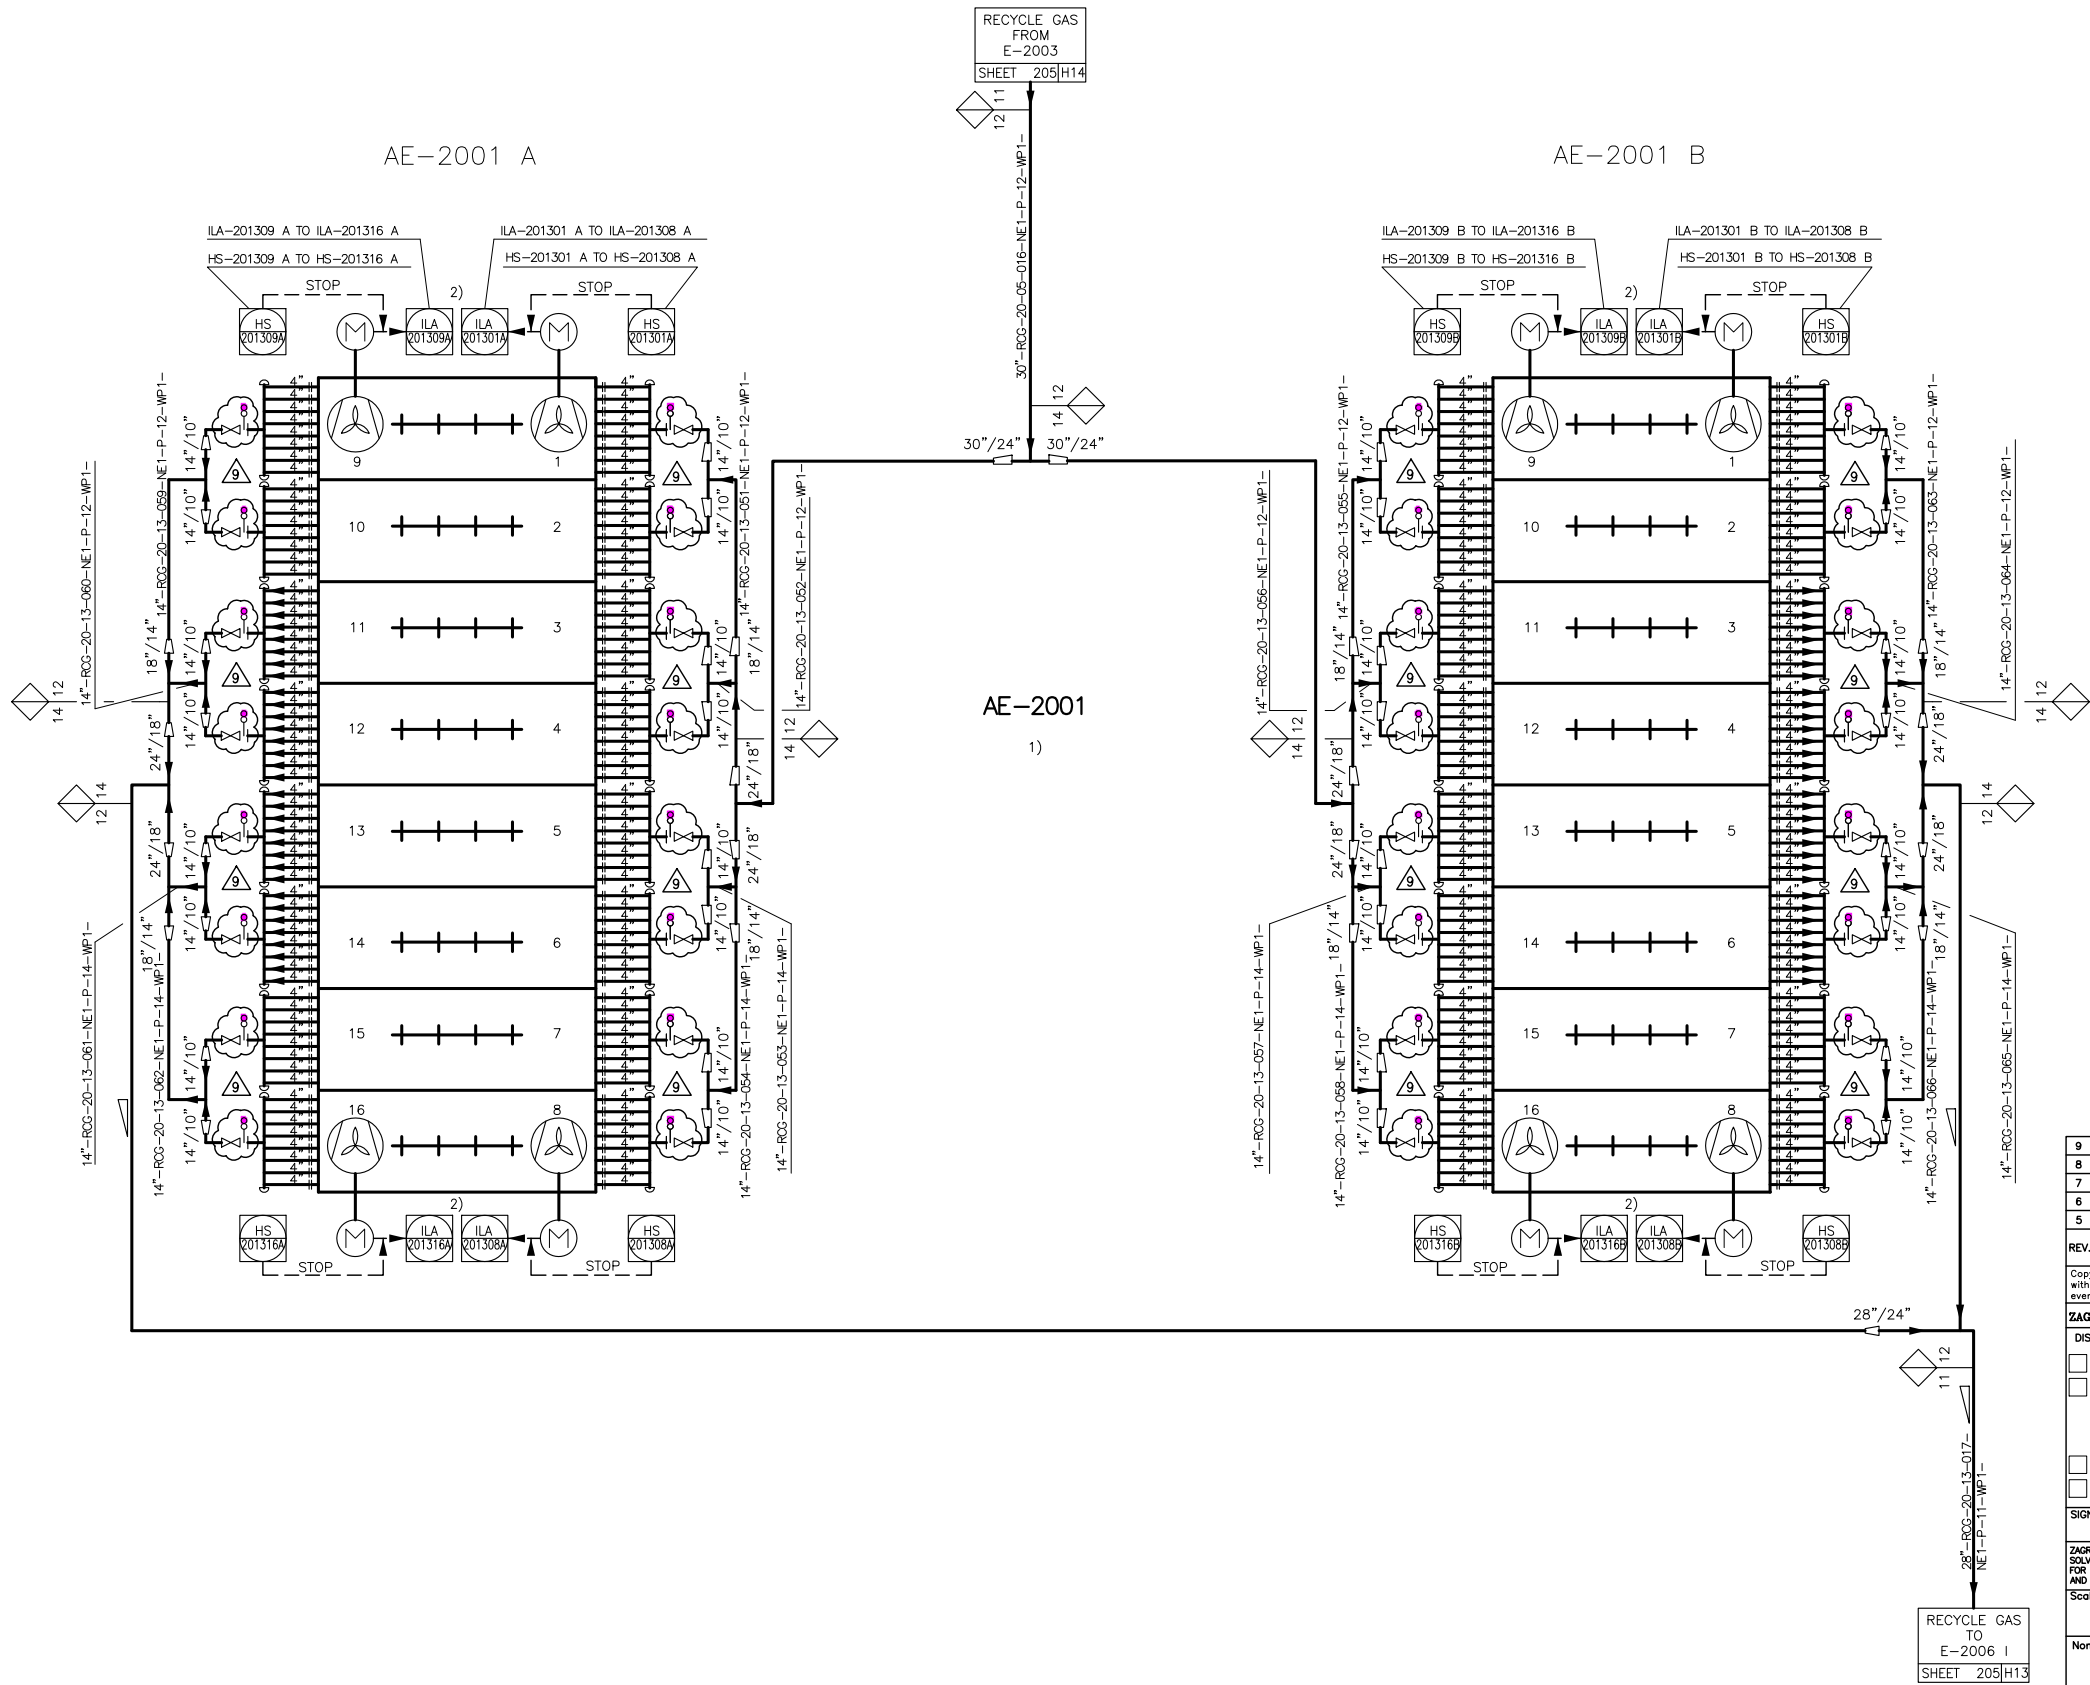

9	R.P	11.10.18	M.J.J	SH.H	11.10.18	ASBUILT REVISED AS MARKED
8	BYL	14.03.06	DRBHU	PTK	16.03.06	AFC REVISED AS MARKED
7	BYL	15.12.03	DRBHU	PTK	16.12.03	AFC NO CHANGES
6	KKP	07.08.03	DRBHU	PTK	08.08.03	AFC REVISED AS MARKED (FROZEN)
5	NOA	05.03.03	DRBHU	PTK	06.06.03	AFC REVISED AS MARKED (FROZEN)
REV.	L/F/PS	NAME	DATE	NAME	DATE	STATUS
Prepared/RT			Checked		Approved	
						Kind of Revision
Copying of this document, and giving it to the others and the use or communication of the contents there of, are forbidden without express authority by LURGI/PIDEC. Offenders are liable to the payment of damages. All rights are reserved in the event of the grant of a patent or the registration of a utility model or design.						
ZAGROS PETROCHEMICAL COMPANY				OWNER: NATIONAL PETROCHEMICAL COMPANY ZAGROS PETROCHEMICAL COMPLEX شرکت پتروشیمی زاگرس		
DISPOSITION:				PROJECT: 4th METHANOL PROJECT		
☐ NO COMMENT				OWNER: CONTRACTOR: DWG. NO.		
☐ COMMENTS AS MARKED, FABRICATION CAN PROCEED ACCORDINGLY. REVISED DOCUMENT TO BE ISSUED EITHER FOR REVIEW OR AS FINAL CERTIFIED. HOWEVER ZAGROS WILL CHECK THIS REVISED DOCUMENT FOR PROPER INCORPORATION.				DIG-PI-047		
☐ REJECTED DOCUMENT TO BE REISSUED.				CONTRACTOR: PETROCHEMICAL INDUSTRIES DESIGN & ENGINEERING COMPANY شرکت طراحی و مهندسی صنایع پتروشیمی		
☐ USE FOR INFORMATION ONLY.				DWG. NO.		
SIGNATURE		DATE		ZPC PROJ. NO. 40404277 PIDEC PROJ. NO. 1175		
Scale: Original Size:				DWG. NO.		
Nomination: AE-2001				engineering Lurgi		
Basic document: DCC DG DL-NO. RT				METHANOL SYNTHESIS RECYCLE GAS COOLING UNIT 200 P&I DIAGRAM SHEET 213		
Job name: MEGA METHANOL IRAN				Lurgi job No: 169666-01 Lurgi Document No: 37213		
EDV-ident-No.: Server_pds d:\PDS\696660\yui				d-37213.pid 012 14.03.06 BYL PDS39		