


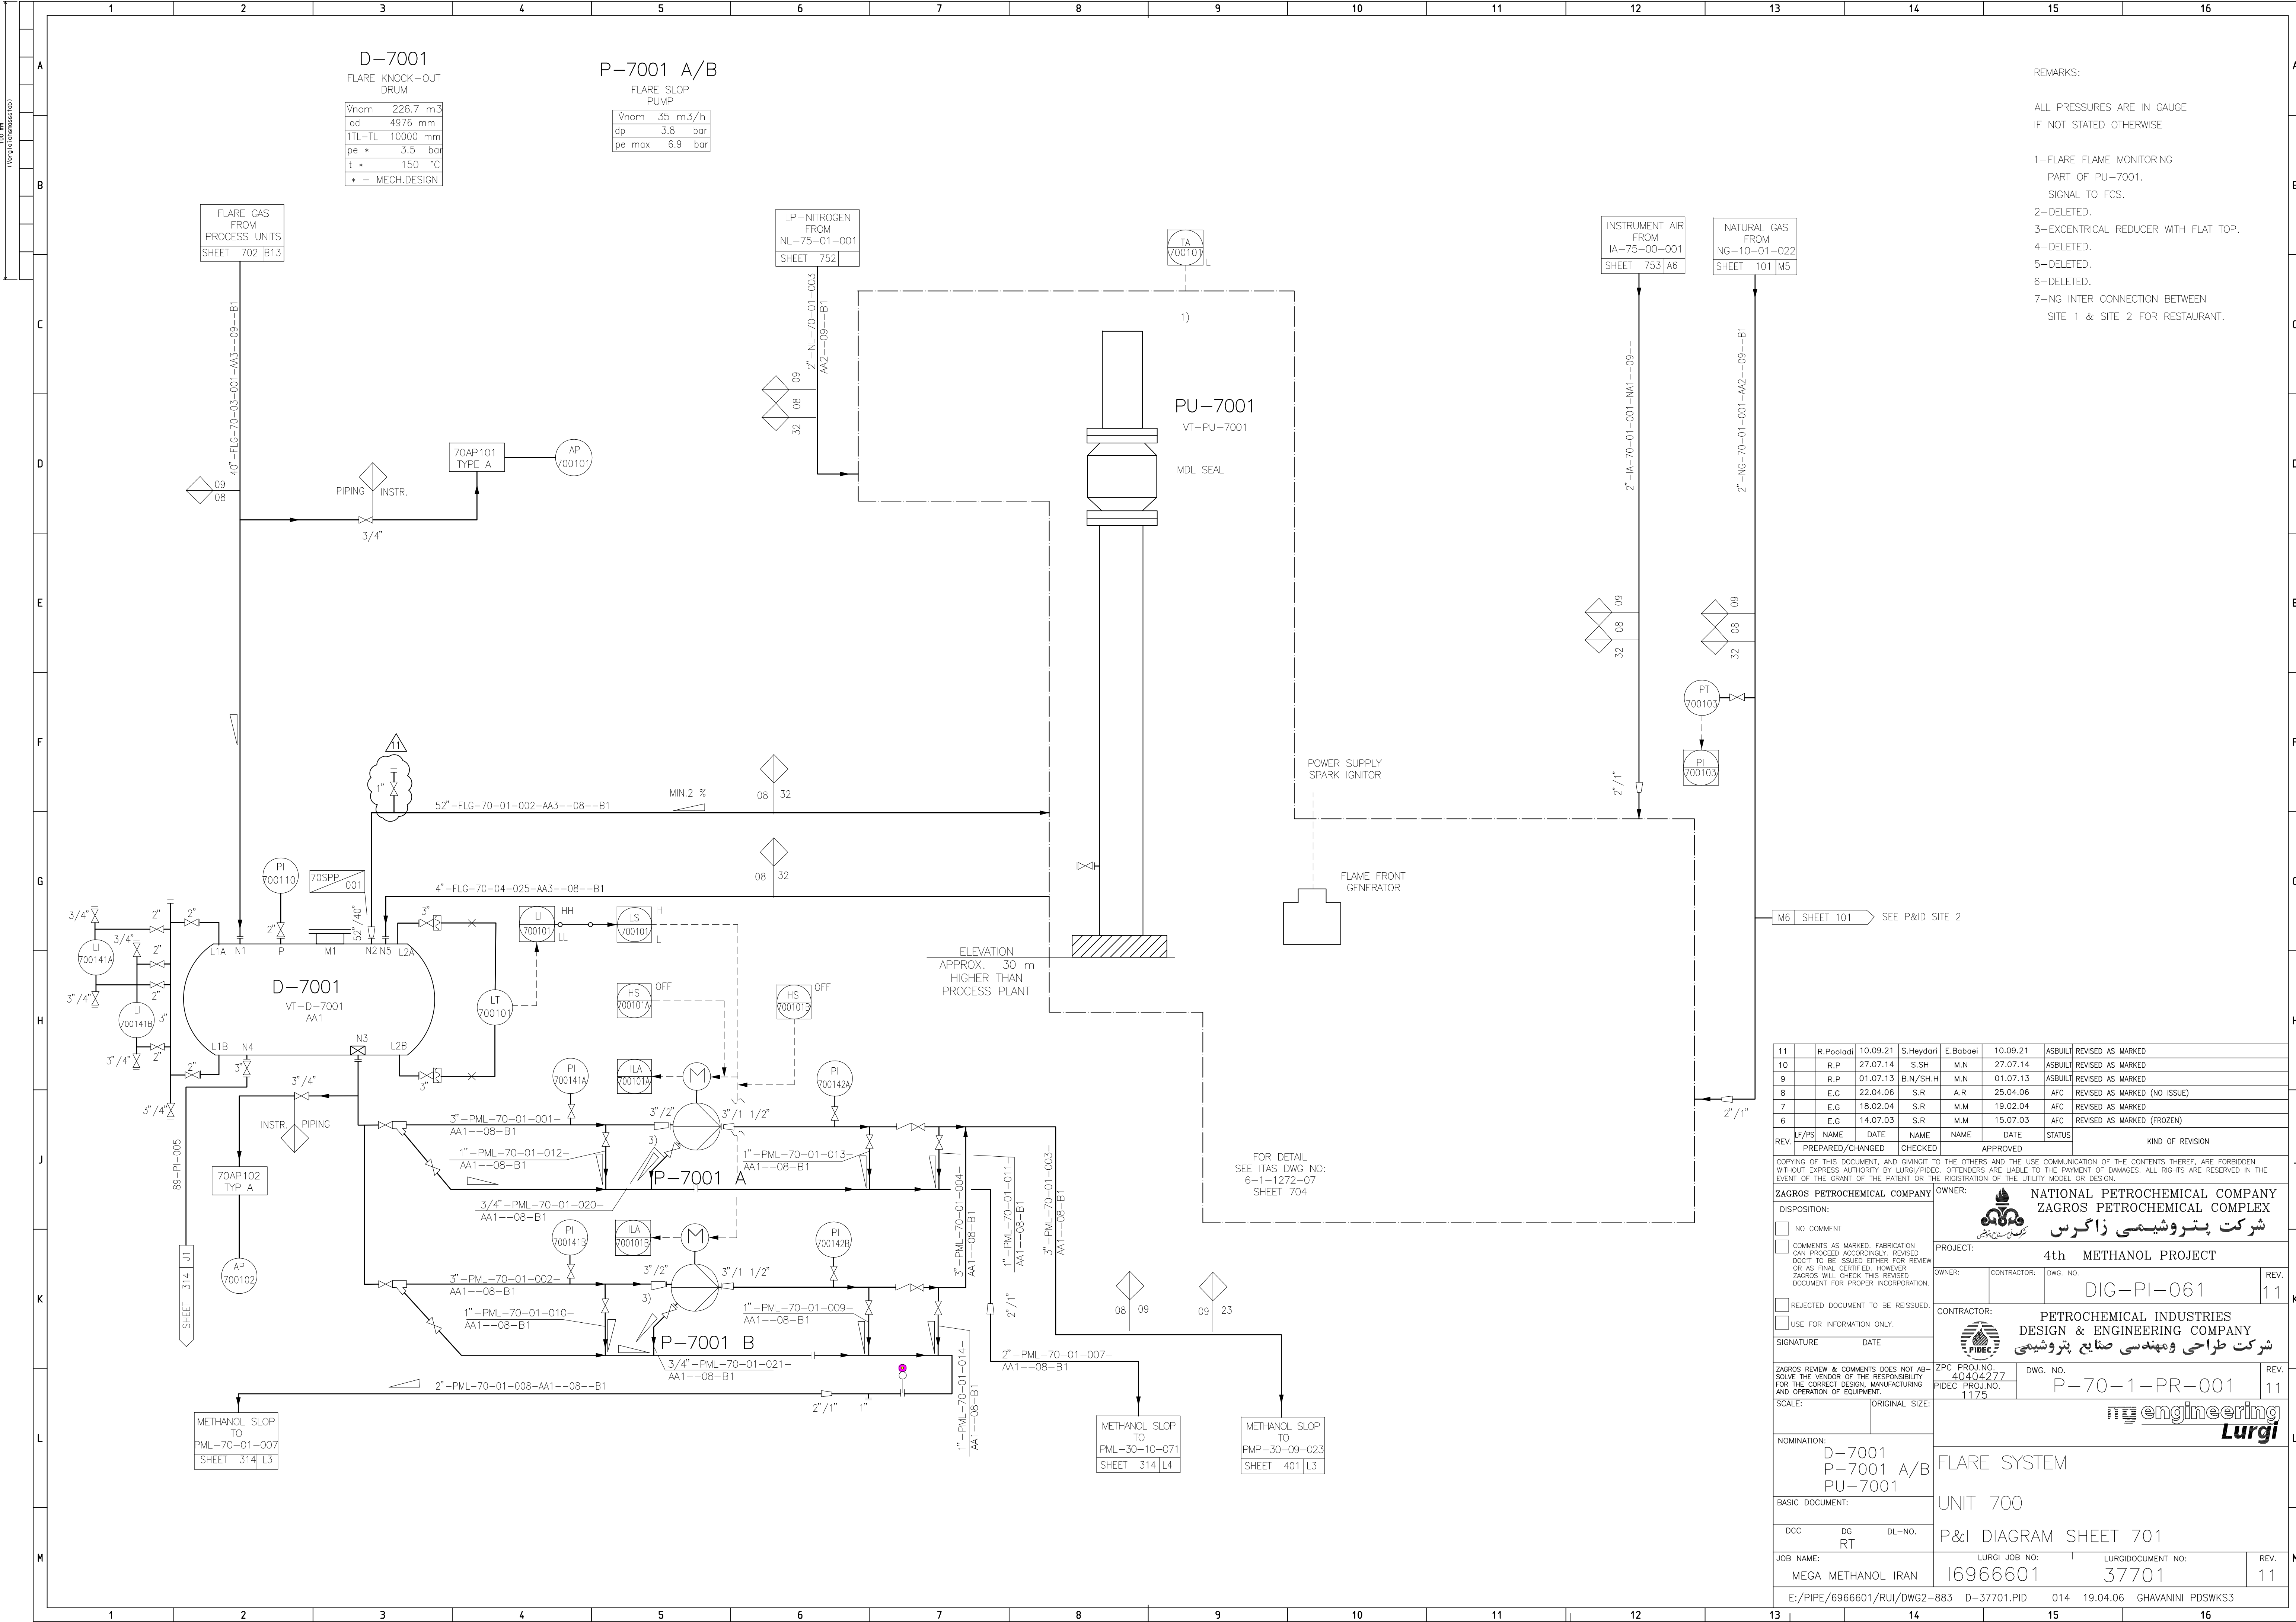

100 mm
(1 inch is 25.4 mm)

A
B
C
D
E
F
G
H
J
K
L
M

A
B
C
D
E
F
G
H
J
K
L
M

REMARKS:

ALL PRESSURES ARE IN GAUGE
IF NOT STATED OTHERWISE

1-FLARE FLAME MONITORING
PART OF PU-7001.
SIGNAL TO FCS.

2-DELETED.

3-EXCENTRIC REDUCER WITH FLAT TOP.

4-DELETED.

5-DELETED.

6-DELETED.

7-NG INTER CONNECTION BETWEEN
SITE 1 & SITE 2 FOR RESTAURANT.

11	R.Pooladi	10.09.21	S.Heydari	E.Babaei	10.09.21	ASBUILT	REVISED AS MARKED
10	R.P	27.07.14	S.SH	M.N	27.07.14	ASBUILT	REVISED AS MARKED
9	R.P	01.07.13	B.N/SH.H	M.N	01.07.13	ASBUILT	REVISED AS MARKED
8	E.G	22.04.06	S.R	A.R	25.04.06	AFC	REVISED AS MARKED (NO ISSUE)
7	E.G	18.02.04	S.R	M.M	19.02.04	AFC	REVISED AS MARKED
6	E.G	14.07.03	S.R	M.M	15.07.03	AFC	REVISED AS MARKED (FROZEN)

REV.	LF/PS	NAME	DATE	NAME	NAME	DATE	STATUS	KIND OF REVISION
	PREPARED/CHANGED			CHECKED			APPROVED	

COPYING OF THIS DOCUMENT, AND GIVING IT TO THE OTHERS AND THE USE COMMUNICATION OF THE CONTENTS THEREOF, ARE FORBIDDEN WITHOUT EXPRESS AUTHORITY BY LURGI/PIDEC. OFFENDERS ARE LIABLE TO THE PAYMENT OF DAMAGES. ALL RIGHTS ARE RESERVED IN THE EVENT OF THE GRANT OF THE PATENT OR THE REGISTRATION OF THE UTILITY MODEL OR DESIGN.

ZAGROS PETROCHEMICAL COMPANY		OWNER:	
DISPOSITION:		 NATIONAL PETROCHEMICAL COMPANY شركة پتروشیمی زاگرس	
☐ NO COMMENT		PROJECT: 4th METHANOL PROJECT	
☐ COMMENTS AS MARKED. FABRICATION CAN PROCEED ACCORDINGLY. REVISED DOCUMENT TO BE ISSUED EITHER FOR REVIEW OR AS FINAL CERTIFIED. HOWEVER ZAGROS WILL CHECK THIS REVISED DOCUMENT FOR PROPER INCORPORATION.		OWNER:	CONTRACTOR: DWG. NO.
☐ REJECTED DOCUMENT TO BE REISSUED.		DIG-PI-061	
☐ USE FOR INFORMATION ONLY.		REV. 11	
SIGNATURE		DATE	
ZAGROS REVIEW & COMMENTS DOES NOT ABSOLVE THE VENDOR OF THE RESPONSIBILITY FOR THE CORRECT DESIGN, MANUFACTURING AND OPERATION OF EQUIPMENT.		ZPC PROJ.NO. 40404277	DWG. NO. P-70-1-PR-001
SCALE:		PIDEC PROJ.NO. 1175	REV. 11
ORIGINAL SIZE:			
NOMINATION:		FLARE SYSTEM	
BASIC DOCUMENT:		UNIT 700	
DCC	DG	DL-NO.	
	RT		
JOB NAME:		LURGI JOB NO:	LURGI DOCUMENT NO:
MEGA METHANOL IRAN		16966601	37701
			REV. 11
E:/PIPE/6966601/RUI/DWG2-883 D-37701.PID 014 19.04.06 GHAVANINI PDSWSK3			