


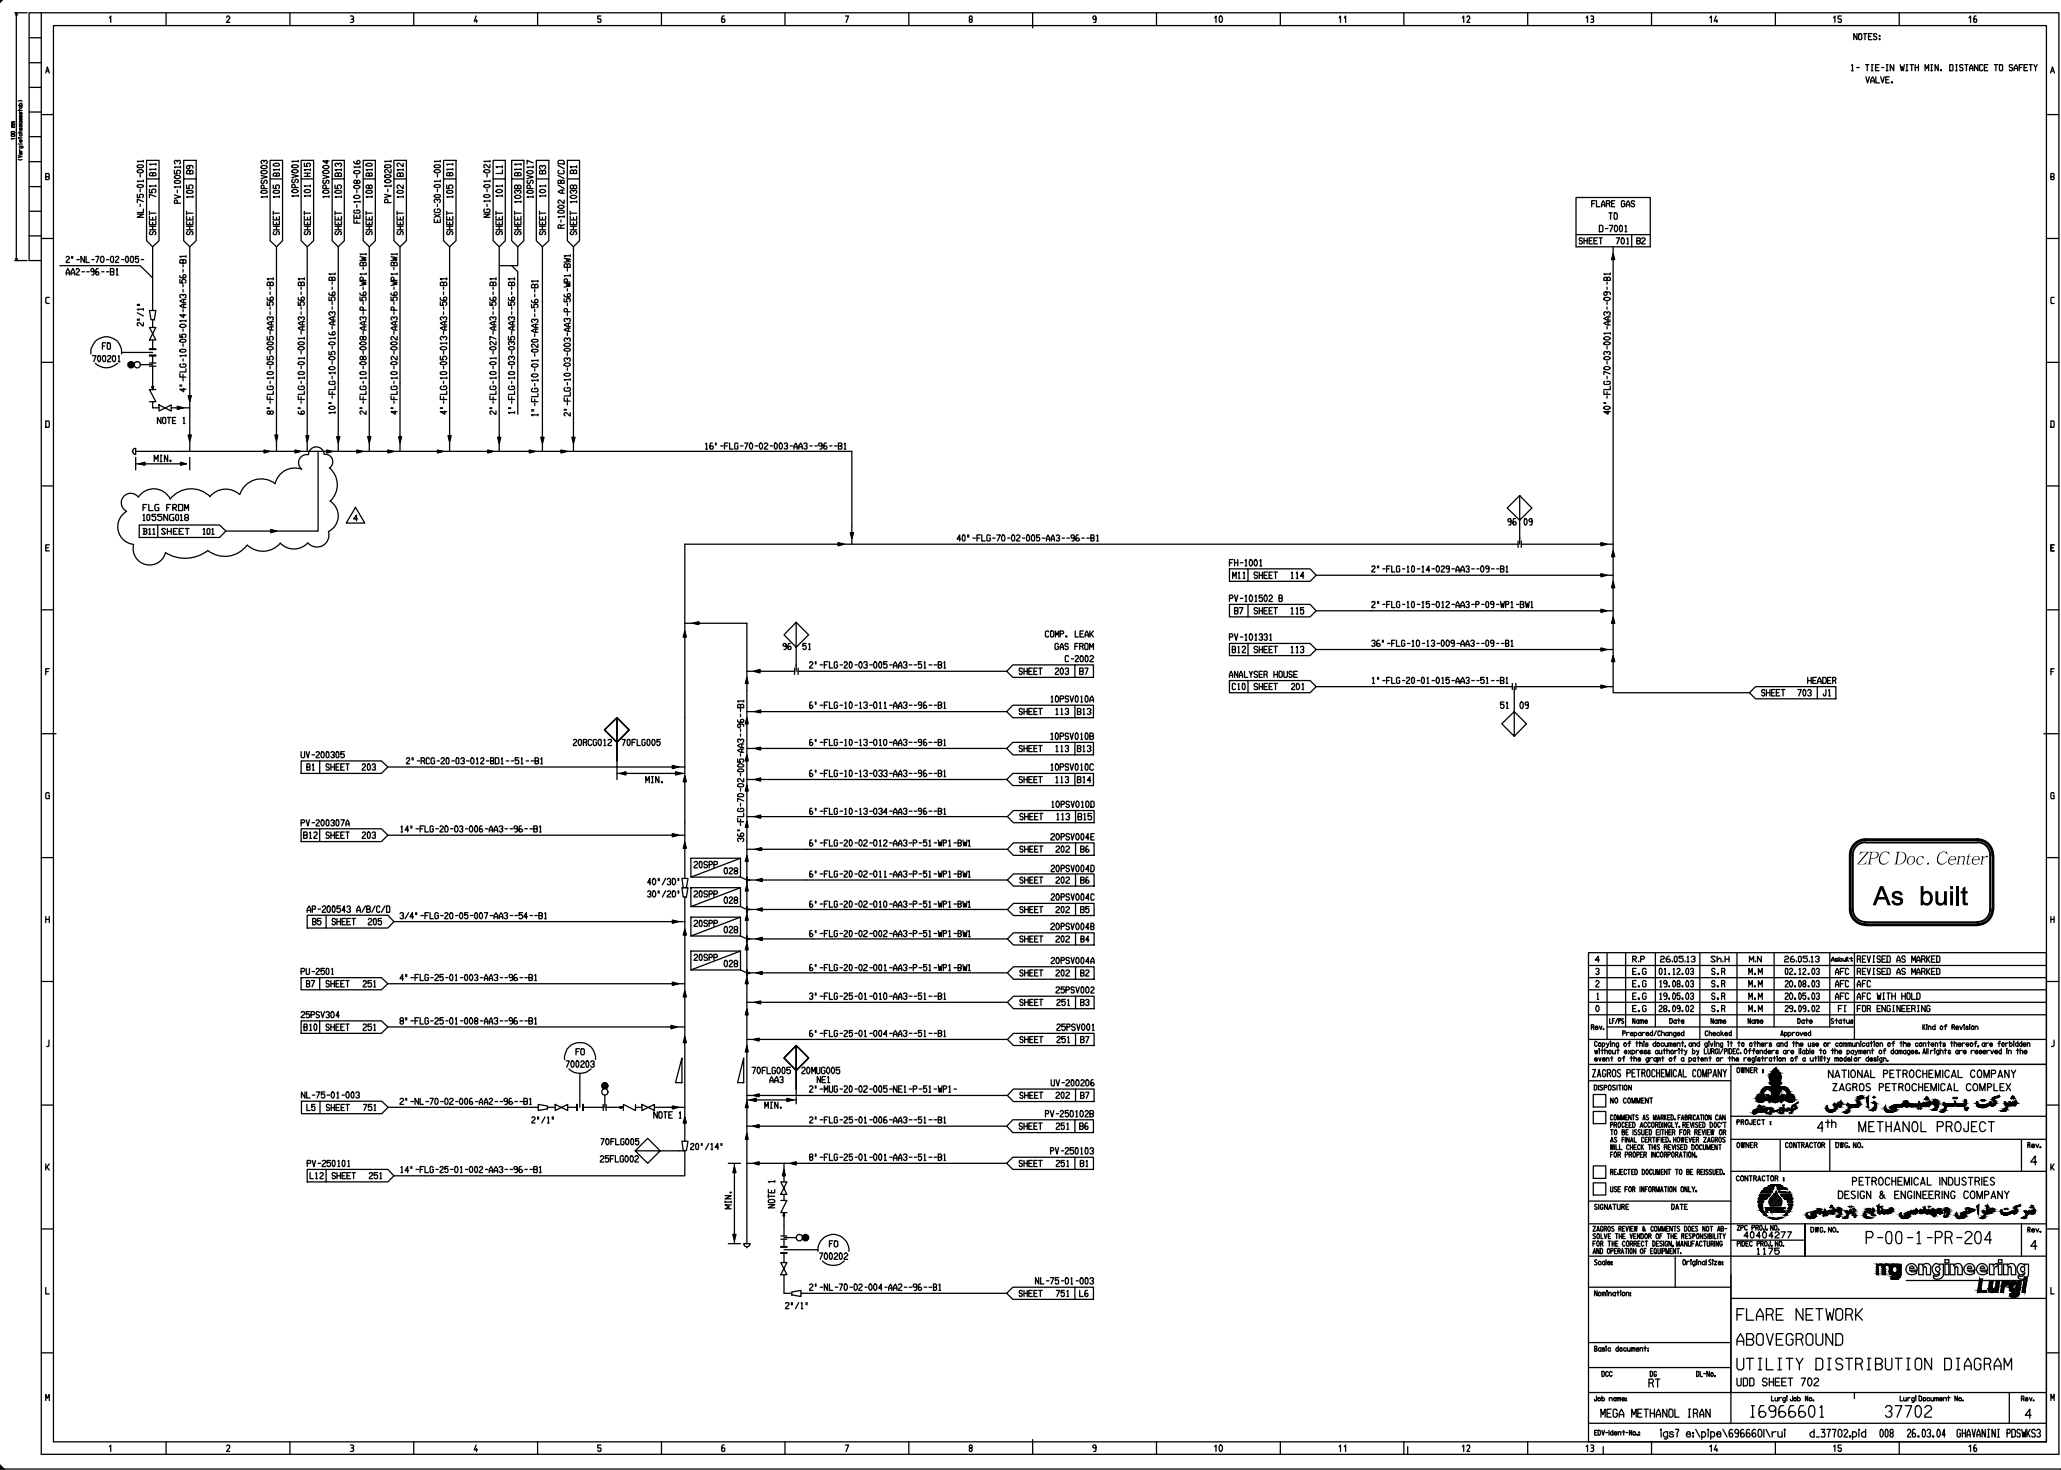

NOTES:
1- TIE-IN WITH MIN. DISTANCE TO SAFETY VALVE.

ZPC Doc. Center
As built

4	R.P	26.05.13	Sh.H	M.N	26.05.13	Revised	REVISED AS MARKED
3	E.G	01.12.03	S.R	M.M	02.12.03	AFC	REVISED AS MARKED
2	E.G	19.08.03	S.R	M.M	20.08.03	AFC	AFC
1	E.G	19.05.03	S.R	M.M	20.05.03	AFC	AFC WITH HOLD
0	E.G	28.09.02	S.R	M.M	29.09.02	FI	FOR ENGINEERING
COPYING OF THIS DOCUMENT AND GIVING IT TO OTHERS AND THE USE OR CONSULTATION OF THE CONTENTS THEREOF, ARE PROHIBITED WITHOUT THE WRITTEN AUTHORITY OF ZAGROS PETROCHEMICAL COMPANY. NO PART OF THIS DOCUMENT MAY BE REPRODUCED OR TRANSMITTED IN ANY FORM OR BY ANY MEANS, ELECTRONIC OR MECHANICAL, INCLUDING PHOTOCOPYING, RECORDING, OR BY ANY INFORMATION STORAGE AND RETRIEVAL SYSTEM.							
ZAGROS PETROCHEMICAL COMPANY				NATIONAL PETROCHEMICAL COMPANY ZAGROS PETROCHEMICAL COMPLEX			
PROJECT :				4th METHANOL PROJECT			
OWNER :		CONTRACTOR :		DWG. NO. :		Rev. :	
PROJECT :				CONTRACTOR :			
SIGNATURE :				DATE :			
ZAGROS REVIEW & COMMENTS DOES NOT SOLVE THE REASON OF THE RESPONSIBILITY FOR THE CORRECT DESIGN, MANUFACTURING AND OPERATION OF EQUIPMENT.				ZAGROS REVIEW & COMMENTS DOES NOT SOLVE THE REASON OF THE RESPONSIBILITY FOR THE CORRECT DESIGN, MANUFACTURING AND OPERATION OF EQUIPMENT.			
Scale :				Original Size			
Modifications :							
Basic documents :							
DOC :				DL-NO. :			
Job name :				Lurgi Job No. :		Rev. :	
MEGA METHANOL IRAN				I6966601		37702	
DWG. NO. :				Lurgi Document No. :		Rev. :	
E6966601				d.37702.pld		26.03.04	
E6966601				G966601		G966601	