

Contractor:  TIANCHEN CORP. CHINA	Project :	MKP Methanol Project			Owner :  شرکت کیمیای پارس خاورمیانه Middle East Kumiya Pars Co.
	Unit	General Technical	Phase	Detail Engineering	
	Doc. Title :	PACKAGE HAZOP			
Vendor :  新鼎信息技術(上海)有限公司 Advanced Control & Information Technologies Co., Ltd.	Owner No.	MKP-11-DE-9000-SF-RPT-001B			Rev. : 0
	Contr. No.:	MKP-11-DE-9000-SA01-RPT-001B			
	Vendor No.	16E2416A			Page : 1 of 25

PACKAGE HAZOP

REV.	DATE	PURPOSE OF ISSUE	PREPARE	CHECK	REVIEW	APPROVE
0	05-04-2017	Approved for Construction	YING YI NING	Wang Shih Huang	Wang Shih Huang	
A	03-24-2017	Issued for Comments	YING YI NING	Wang Shih Huang	Wang Shih Huang	

Table of Contents

Objectives

Scope

Methodology

Team Members

Schedule and Deliverables

Recommendations

Attachment 1 - Process Deviation Guidewords

Attachment 2 – HAZOP Worksheet

Attachment 3 – Attendance sheet

Attachment 4 – Mark-up P&ID

Objectives

The objective of this HAZOP project is Advanced Control and Information Technology, Inc. (ACIT) to contract TCC in conducting HAZOP study as well as the layer of protection analysis (LOPA) on “MEKPCO Methanol Project”. In order to finalize the design of process packages, it is imperative to have a third party conduct Hazard and Operability (HAZOP) study, so that the fitness of safety and risk control measures in the detailed design can be verified. Process and utility systems should include vendor packages. They are the subject of this second HAZOP when details are available.

The analysis methodology of HAZOP as implemented in this project is in accordance with relevant requirements of “Hazard and operability studies (HAZOP studies)—Application guide” (IEC 61882-2003), AIChE CCPS “Guidelines for Hazard Evaluation Procedures” (2008), and the assignment of required Safety Integrity Level (SIL) for Safety Instrumented System (SIS) is in accordance with “Functional safety—Safety instrumented systems for the process industry sector” National Standard (IEC 61511-2016).

Scope

The assessment scope includes Recycle hydrogen compressor C-2002, Start-up nitrogen compressor C-2001, Flue gas blower and turbine F-2001/FT-2001, Combustion air blower and turbine F-2002/FT-2002, Synthesis compressor package, P-7001A/B/C (BFW pump package), Turbine for P-0501 1/2 (CW pump), Flare system, POC, Polishing Unit and Cooling water system in “MEKPCO Methanol Project”. Description of each node and its associated P&ID’s are shown below.

Node ID_NO	Node Description	Relative Equipments	P&ID	Remark
2007	Recycle hydrogen compressor C-2002	C-2002, MC-2002, D-2070, D-2072, D-2071, D-2073, E-2070, D-2074, D-2075.	MKP-VD-9000-306-00 3-A1~MKP-VD-9000-3 06-007-A1	
2008	Start-up nitrogen compressor C-2001	C-2001	MKP-11-DE-9000-RE- REQ-308, 0514-JA 16704-PID	
2009	Flue gas blower and turbine F-2001/FT-2001	FT-2001, MP-1001, GB-1001, OT-1002, F-2001, MF-2001, OT-1001, AP-1001, OC-1001A/B, OF-1001A/B.	MKP-VD-2000-351-14 5-A1, SH-3~5; MKP-VD-2000-351-30 2-A0	

2010	Combustion air blower and turbine F-2002/FT-2002	FT-2002, MP-2001, GB-2002, OT-2002, F-2002, MF-2002, OT-2001, AP-2001, OC-2001A/B, OF-2001A/B.	MKP-VD-2000-351-12 0-A1, SH-3~5; MKP-VD-2000-351-30 3-A0	
3006	Synthesis compressor package	D-3011, E-3012, C-3001, E-3014, D-3012, C-3002-1, C-3002-2, E-3013, TK-3002, P-3013A/B, PM-3013A/B, E-3018A/B, X-3002A/B, D-3013, P-3012, PM-3012, D-3014, TK-3001, FT-3001, P-3014, PM-3014, E-3011, D-3015, E-3020, P-3011A/B, PM-3011A/B, J-3004, J-3005A/B, J-3006A/B, X-3004A/B, P-3015, E-3021A/B/C, X-3005A/B, E-3016, E-3022A/B/C.	SOK0887013, SH2~7; SOK0880159, SH5~14.	
7007	P-7001A/B/C (BFW pump package)	P-7001A/B/C, FT-7001A/B	DGN-P&ID-DST-01	
7008	Turbine for P-0501 1/2 (CW pump)	P-0501 1/2, FT-0501 1/2	DGN-P&ID-DS-01	
7009	Flare system	D-8511, P-8511, D-8501, E-8501, FL-8501, FL-8502, FL-8503, D-8502, X-8501, PIL-8501A~D.	MKP-11-DE-8500-PR-PID-001~005.	
7010	POC	PD-9401, PD-9402, PD-9403, PD-9404, PD-9406, PD-9407, PD-9408, PD-9409, PD-9410, PD-9411, P-9401A/B, P-9402A/B, P-9403A/B, P-9404A/B, P-9408A/B, P-9409A/B, P-9411.	MKP-11-DE-9400-PR-PID-002	
7201	Polishing Unit	TK-7001 1/2, P-7002A/B,	7200-PID-001~005	

		P-7204A/B, TK-7202/7204, P-7202/7203, J-7201/7202, D-7205, PD-7206, P-7205A/B, TK-7201, P-7201A/B, R-7201A/B, X-7201, E-7201A/B		
0501	Cooling water system(Side filter of cooling tower)	F-0502 1/2	0500-PID-005;	

Methodology

The description of HAZOP and LOPA assessment methodology as applied in this project is as follows.

1. Qualitative analysis: traditional HAZOP analysis method is applied to each process node. Guidewords (refer to the Attachment) are used to probe for potential process deviations in the node. List all possible causes for the process deviation, analyze its related hazardous consequences and identify existing safeguards that prevent the process deviation from occurring.
2. Assess the risk following the definitions listed in Tables 2~5. First determine the severity level of the hazard following Table 4, and by doing so one can determine its tolerable risk target (refer to Table 5).
3. If there is a dispute over the severity level in the process of determining severity level of the hazard following Table 4, or if the consequence under discussion is deemed a critical hazardous event by the assessment team, proceed with model-based consequence analysis.
4. For consequence with severity level 4 or above, proceed to LOPA. The assessment team can also proceed to LOPA for the consequence with severity level 3, if necessary.
5. LOPA format in IEC 61511-3 appendix F should be followed.
6. Principle and guidance listed below for each LOPA item should be considered,
 - (1) Impact event description - following the consequence in a process deviation from the HazOp study
 - (2) Severity - following the severity level for the consequence from the HazOp study
 - (3) Initiating cause - all potential causes for a process deviation from the HazOp study. Each cause will be discussed accordingly.
 - (4) Initiation likelihood – values of the typical initiating cause failure rate can be looked up from Mr. Safety software database. Alternatively, one can refer to

“Layer of Protection Analysis: Simplified Process Risk Assessment(2001)”
published by AIChE.

- (5) General process design – check to see if the process area for the initiating cause or impact event under discussion is designed with explosion proof classification, double cannula for toxic or incompatible material leakage prevention, vessel wall thickness or attached with refractory material or any other intrinsically safer design in accordance with the general safety design specifications such as API, ASME or NFPA. Such design must be independent and effective for protection against the event under discussion. Yes(0.1); No(1)
- (6) Basic process control system (BPCS) – check to see if in addition to the control system that fails, there is any other relevant monitor and control system such as DCS, PLC or PANEL to prevent or mitigate the hazardous event, and such monitor and control system is independent and effective. Yes(0.1); No(1)
- (7) Alarm, etc. – check to see if there is any independent safety system alarm in addition to the automatic operating system from item 4 or item 6, and if there is corresponding SOP to complement the alarm in preventing or mitigating the impact event under discussion. Yes (0.1); No(1)
- (8) Additional mitigation, restricted access – external mitigation measures with a lower degree of reliability such as working permit or restricted access to the operating area during process operation, etc. Such additional mitigation measures must be implemented against the initiating cause. Look for the additional mitigation data table in Mr. Safety software database. Alternatively, one can refer to *“Layer of Protection Analysis: Simplified Process Risk Assessment(2001)”* published by AIChE
- (9) IPL additional mitigation, dike, pressure relief – mitigating system with a higher degree of reliability such as dike, safety relief valve, rupture disc or automatic firefighting sprinkler system. The failure rate of IPL additional mitigation must be less than or equal to 0.01. Look for IPL data table in Mr. Safety software database. Alternatively, one can refer to *“Layer of Protection Analysis: Simplified Process Risk Assessment(2001)”* published by AIChE
- (10) Intermediate event likelihood – the product of multiplying assigned values of item 4 through item 9
- (11) Safety Instrumented Function (SIF) Integrity Level –Probability of Failure on Demand (PFD) and the Safety Integrity Level (SIL) that corresponds to it
- (12) Mitigated event likelihood – possibility of failure event in which all the risk control measures are in effect. The risk must be less than or equal to the tolerable risk target (Table 4).

7. Check the mitigated event likelihood against Table 4 to see if the risk meets the tolerable risk target.
8. If the risk of the mitigated event likelihood meets (less than or equal to the frequency of) the tolerable risk target, then determine the likelihood level based on Table 2, determine the risk class based on Table 1 and check whether the risk class is within 4. Also, if necessary, provide safety improvement recommendations with

regards to the operation

9.In case that the risk of the mitigated event likelihood does not meet (less than or equal to the frequency of) the tolerable risk target, then determine the required safety integrity level (SIL) as follows

$$(\text{Intermediate event likelihood}) = (\text{Mitigated event likelihood}) \times \text{RRF}$$

Where RRF = Risk Reduction Factor

$$\text{PFD} = 1/\text{RRF}$$

Proceed to determine the required SIL for the safety instrumented function (SIF) or other risk prevention or mitigation measures with a PFD that is equivalent to this SIL, and provide safety improvement recommendations. HAZOP and LOPA assessment workflow is depicted below in figure 1

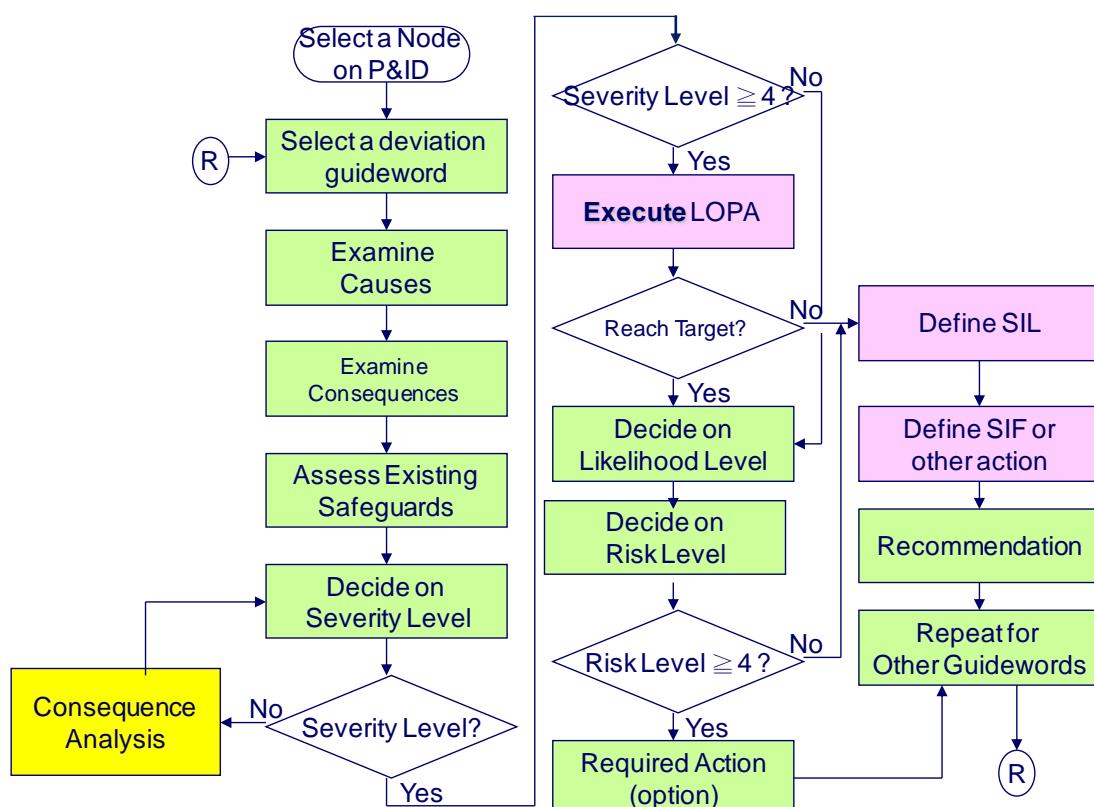


Figure 1 HAZOP/LOPA Assessment Workflow

Table 2 Risk Matrix

Risk matrix		Likelihood							
		1	2	3	4	5	6	7	8
Severity	7	4	5	6	7	7	7	7	7
	6	3	4	5	6	7	7	7	7
	5	2	3	4	5	6	7	7	7
	4	1	2	3	4	5	6	7	7
	3	1	1	2	3	4	5	6	7
	2	1	1	1	2	3	4	5	6
	1	1	1	1	1	2	3	4	5

Note:

	PFD _{avg}	RRF	Typical implementation
A1	No requirement	No minimum	Alarm only
A2	No requirement	No minimum	DCS action
SIL1	$0.01 \leq PFD < 0.1$	$100 \geq RRF > 10$	Trip separate from DCS
SIL2	$0.001 \leq PFD < 0.01$	$1000 \geq RRF > 100$	Trip separate from DCS
SIL3	$0.0001 \leq PFD < 0.001$	$10000 \geq RRF > 1000$	Redundant trip separate from DCS
B, SIL4			Single SIF is not sufficient, design other protection layers

(PFD_{avg}: Average Probability of Failure on Demand)

Table 3 Likelihood Level

	Description	Lower limit $10^{-x} (\geq)$	Upper limit $10^{-y} (<)$
1	Unlikely	7	6
2	Very rare	6	5
3	Rare	5	4
4	Maybe	4	3
5	Possible	3	2
6	Very possible	2	1
7	Frequently	1	0
8	Very frequently	0	0

Table 4 Severity Classification

	Description	Personnel Safety	Financial loss/ US dollar	Environmental influence	Tolerable target
1	Negligible	Injury=1	< 50,000	Equipment leakage	0.1
2	Moderate	1 < injury < 5	50,000~100,000	Unit leakage	0.01
3	Highly	Permanent partial disability ≥ 1 or Temporarily disability < 5	100,000~1 million	Plant leakage	0.001
4	Significant	1 death; Permanent partial disability or temporarily disability ≥ 5	1 million~10 million	Pollution confined in plant	0.0001
5	Massive	2~4 death or permanent disability	10 million~100 million	Regional pollution; $>10,000$ bbl oil spill	1E-05
6	Severe	5~29 death or permanent disability	100 million~1 trillion	National pollution; $>100,000$ bbl oil spill	1E-06
7	Extremely severe	≥ 30 death or permanent disability	> 1 trillion	single equipment leakage	1E-07

Table 5 Tolerable Risk Target

Risk Class	Description	Tolerable Frequency Target (/year)
7	Extremely severe / C _G	< 10 ⁻⁷
6	Severe / C _F	< 10 ⁻⁶
5	Massive / C _E	< 10 ⁻⁵
4	Significant / C _D	< 10 ⁻⁴
3	Highly / C _C	< 10 ⁻³
2	Moderate / C _B	< 10 ⁻²
1	Negligible / C _A	< 10 ⁻¹

Team Member

Leader –

Wang Shih Huang (consultant for Advanced Control and Information Technology, Inc. (ACIT)), ACIT is a member of CTCI Group)

Mr. Wang has over 24 years of experience in the oil and gas industry in the area of PHA/HAZOP. Prior to joining ACS, he had served as Department Manager for Industrial Safety Technology Department of Industrial Technology Research Institute in Taiwan (ITRI). He has participated in the following projects,

- (1) Project leader, RDS2 Process Safety Evaluation in Taoyuan Refinery, Taiwan CPC, 1991~1992
- (2) Project leader, Alkylation and Dehydrogenation Process Safety Evaluation, Taiwan Styrene Monomer Corporation, 1992~1996.
- (3) Project leader, PP Process Safety Evaluation, Taiwan Polypropylene Inc., 1994~1995.
- (4) Project leader, SBR/BR/TPE Process Hazard Analysis and Risk Assessment, Taiwan Synthesis Rubber Corporation, 1995~1998.
- (5) Auditor and Advisor, PSM Promotion Program and PTA3 HAZOP Review, CAPCO, 1996~1998.
- (6) Project leader, Semiconductor Process Safety Evaluation, Tsmc, 1998~2000.
- (7) Project leader, Liquid Chlorine Transportation QRA, Taiwan DuPont Inc., 2004.
- (8) Project leader, Earth Covered Tanks Quantitative Risk Analysis, FPCC, 2006~2008.
- (9) Project leader, Synlubes Process HAZOP, Cognis Shanghai, 2008.
- (10) Project leader, Ammonia ISO Tank Transportation QRA, Praxair, 2010.
- (11) Assessor, Nitrous Acid Process HAZOP, Taiwan Fertilizer CO., 2010.
- (12) Project leader, Alkylation Process HAZOP and LOPA in Talin Refinery, Taiwan

CPC, 2010~2011.

- (13) Advisor, Mr. Safety – Computer-aided HAZOP/LOPA Software Development, Advanced Control & Systems Inc., 2010~2012.
- (14) Coach, HAZOP Training Program and Workshop, Dowcorning Shanghai, BP/CNOOC Shenzhen, Conocophillips Beijing, Lanxess Qindao, and CNOOC Zhanjiang/Teinjing, 2004~2011.
- (15) Project leader, NO.10 SRU LOPA/SRS, RBI, FMEA/CA in Talin Refinery, Taiwan CPC, 2012~2013.
- (16) Project leader, SNG (Substitute Natural Gas) HAZOP in Xinjiang Yi Nan, ECEC, 2012.
- (17) Project leader, YUTAI Large Scale Natural Gas Liquefaction Technology Engineering Project HAZOP, CTYC, 2013.
- (18) China huaneng Methanol Produce FMTP Process HAZOP, TCC, 2013.

Scribe –

Ying Yi Ning 、Tracy Xie, Jay Liu, Gene Zhang (ACIT)

Core Team Members –

Owner:

Engineering Manager: Mahmood Nasrollahi

Process Engineers: Mojtaba Lame 、Morteza Faghihi

Instrumentation Engineer: Mehdi Movahedi 、Jalal Behrouzfar

Contractor:

Project Manager: Ji Quangong

Chief Engeer: Lin Binbin

Project Executive Manager: Liu Wei

Engineering Manager: Ai Xiaoxin

Deputy Engineering Manager: Gao Zihui

HSE Engineer: Ji Weiwei 、Liu Xianfan

Process Engineers : Xu Hang 、Tian Tao 、Jiang yu 、 Xu Yekun 、Wang Furui 、

Chen Tao 、Xu Jun 、Xu Binghao 、Li Zhijuan

Instrumentation Engineer: Ma Guoqiang 、Qin yajun

Machinery Engineer: Feng Wei

Experts:

ITT: Valerio Cicono 、Marcelo Della Coletta 、Wendy Xie

CW-Hydro: Sun Sy

SYCC: Pan Yi Sia 、Zheng nai chao

SBW: Li Yueyong 、Bai Lin 、Zhang Enyuan

GE: Giuseppe Stella 、Medagcioni Marta 、Gaia Cdetti 、Luca Conti

Schedule and Deliverables

Schedule

Date and Time	Agenda
Feb 20, 2017	HAZOP LOPA for Node 2009 / Flue gas blower and turbine F-2001/FT-2001.
Feb 21, 2017	HAZOP LOPA for Node 2010/ Combustion air blower and turbine F-2002/FT-2002.
Feb 22, 2017	HAZOP LOPA for Node 7007/ P-7001A/B/C (BFW pump package), Node 7008/ Turbine for P-0501 1/2 (CW pump), Node 7009/ Flare system.
Feb 23, 2017	HAZOP LOPA for Node 2007/ Recycle hydrogen compressor C-2002.
Feb 24, 2017	HAZOP LOPA for Node 2008/ Start-up nitrogen compressor C-2001.
Feb 27, 2017	HAZOP LOPA for Node 7201/ Polishing Unit.
Feb 28, 2017	HAZOP LOPA for Node 7010/ POC, Node 0501/ Cooling water system
Mar 1, 2017 Mar 3, 2017	HAZOP LOPA for Node 3006/ Synthesis compressor package.

Output:

Reforming Process Section: HAZOP LOPA analysis – 4 process nodes, 64 process deviations and 15 pcs of P&ID completed;

Methanol Synthesis Loop Process Section: HAZOP LOPA analysis – 1 process nodes, 60 process deviations and 16 pcs of P&ID completed;

Utility Process Section: HAZOP LOPA analysis – 4 process nodes, 52 process deviations and 8 pcs of P&ID completed;

Polishing Process Section: HAZOP LOPA analysis – 1 process nodes, 30 process deviations and 5 pcs of P&ID completed;

Cooling Water Process Section: HAZOP LOPA analysis – 1 process nodes, 5 process deviations and 1 pcs of P&ID completed.

Deliverables:

HAZOP Worksheet, please refer to Attachment 2.

Recommendations

Serial #	Risk	Recommendation	Accept	Not accept	Alternative/Comment	Follow up
501.3	3	Develop SOP for proper adjusting CW distribution in case of two pumps running and low plant loading situation.	Y			TCC
501.5	3	Add AT-0511 low pH alarm and interlock to auto-stop H ₂ SO ₄ injection pump.	Y			TCC
501.9	3	Add AT-0511 low pH alarm and interlock to auto-stop H ₂ SO ₄ injection pump.	Y			TCC
501.10	2	TCC to check: relation between ClO ⁻ and Cl ⁻ concentration and relevant reactions (for NaClO dosing in CW).	Y			TCC
501.12	3	Add high alarm to PIA-0514.	Y			TCC
501.13	2	1.Add TE-0511 low temperature alarm. 2.Add PT-0511 low pressure alarm.	Y			TCC
501.17	3	1.Lines from each filter to PD-0502 for discharge of CSW shall be sloped down towards PD-0502.	Y			TCC

501.18	1	Add flow indicator for FT-0516.	Y			TCC
501.23		HAZOP study should be done by vendor for CW filter system package, the owner will check CW filter package after receiving vendor data.	Y			TCC
3006.1	3	1.TCC and GE to review the IS-40 partial trip category (high level of liquid separator, high flow) of compressor 2.LT-3700A/B/C(2oo3) level high high trip, SIF should meet SIL 1.	Y			TCC/GE
3006.4	3	Handvalves at the recycle gas suction and discharge lines should be locked open.	Y			TCC/GE
3006.11	3	Handvalve at the discharge of 2nd stage compressor(C-3002-1) should be lock open.	Y			TCC/GE
3006.12	4	Add a PSV at the discharge of C-3002-2 or use PSHH-3747 high high pressure trip with SIL2.Those two solutions shall be discussed among GE, Owner and TCC.	Y			TCC/GE

3006.14	3	Add high level alarm at pot of sub flare header of compressor house area 3000 and show this pot on P&ID no. 8500-PID-002.	Y			TCC
3006.19	3	Add high temperature alarm on TT-3744.	Y			GE
3006.21	3	Add high temp. alarm for TI-3722.	Y			GE
3006.24	3	to check the capacity of the breathing valve according to the max. gas blow.	Y			TCC
3006.26	3	to check the capacity of the breathing valve according to the max. gas blow.	Y			TCC
3006.32	3	GE provide the information about the oil quantity between the main pumps suction loss level and emergency pump suction loss level.	Y			GE
3006.47	2	Operation Procedure should be placed that stop the steam turbine and remove the vacuum from the condenser in case of loss of LP steam. (To be mentioned in GE operation manual of the compressor package, and incorporated in the plant operation manual.)	Y			GE

2007.3	3	1.Add the branch suction line for AOP with strainer and valve in each line. 2.Add check valve on pump P-2004B discharge.	Y			SYCC
2007.5	3	TIA-2701/2703 add high high temperature trip.	Y			SYCC
2007.9	2	PIAS-2703 add high pressure alarm.	Y			SYCC
2007.11	3	PIAS-2703 add low pressure alarm.	Y			SYCC
2007.12	3	TIA-2701/2703 add high high temperature trip.	Y			SYCC
2007.14	2	Add LST-2474A/B/C (medium of three) high high alarm and trip C-2002 by way of DCS during start-up.	Y			TCC/SYCC
2007.16	2	1.Add level switch for crank shaft tank with low trip. 2.Forbdden to start compressor when the oil level is low.	Y			SYCC
2007.17	2	PT/PI-2706/2707 add low pressure alarm.	Y			SYCC
2008.2	3	1.Revise P&ID to show alarm and interlock for temperature, pressure and flow if any. 2.Add alarm high and high high trip for TT-2579.	Y			SBW

2008.4	2	Show check valve and manual valve on 2000-PID-018	Y			TCC
2008.7	2	PI-2579 add high pressure alarm.	Y			SBW
2008.9	1	Lube oil supply main line PT-9672 add high pressure alarm.	Y			SBW
2008.13	2	Show the autostart of lube oil heater in P&ID.	Y			SBW
2008.15	3	LS-9671 low level alarm change to low low level trip.	Y			SBW
2009.3	2	PDI-2811 add high d/p alarm.	Y			ITT
2009.7	1	Add desuperheater on the LP steam header.	Y			TCC
2009.8	1	1.PDI-2811 add high d/p alarm. 2.Add TI-2801 low temperature alarm.	Y			ITT
2009.9	2	Add blind flange after the drain valve.	Y			ITT
2009.13		Due to incomplete data of P&ID for MF-2001, it will be checked later. TCC shall be issued completed P&ID like other MV motors of plant and consider auto start and relevant signals for it.	Y			ITT/TCC
2010.3	2	PDI-2861 add high d/p alarm.	Y			ITT

2010.7	1	Add desuperheater on the LP steam header.	Y			TCC
2010.8	1	1.PDI-2861 add high d/p alarm. 2.Add TI-2862 low temperature alarm.	Y			ITT
2010.9	2	Add blind flange after the drain valve.	Y			ITT
2010.13		Due to incomplete data of P&ID for MF-2002, it will be checked later. TCC shall be issued completed P&ID like other MV motors of plant and consider auto start and relevant signals for it.	Y			ITT/TCC
2010.14	2	Add PICA-2163 high pressure alarm.	Y			ITT/TCC
7007.1	3	Add high pressure alarm and high high pressure trip at turbine inlet utilizing inlet PT to send signal to CW-Hydro PLC.	Y			CW-Hydro
7007.2	3	Add high pressure alarm and automatic stop auxiliary oil pump.	Y			CW-Hydro

7007.4	3	1.Cancel PSL-7710A/B/C switch. 2.Use transmitter instead of all switch(PDT-7710A/B/C, PT-7710A/B/C, 7720A/B/C, 7730A/B/C and others). 3.PT-7710A/B/C, 7720A/B/C, 7730A/B/C (medium of 3) low pressure alarm and start the auxiliary oil pump, low low pressure(2003) to trip.	Y			CW-Hydro
7007.6	3	Add high temperature alarm and high high temperature trip at turbine inlet pipe.	Y			CW-Hydro
7007.7	2	Add TT high temperature alarm and high high temperature trip at turbine outlet pipe.	Y			CW-Hydro
7007.8	2	Add low temperature alarm and auto start oil heater EH-7001A/B/C.	Y			CW-Hydro
7007.9	2	Add low level alarm and low low level trip for LSL-7710A/B/C.	Y			CW-Hydro

7007.11	3	1.Add low pressure and low temperature alarm at turbine inlet utilizing inlet PT and TT to send signal to CW-Hydro PLC. 2.Add minimum allowable low continuous speed alarm.	Y			CW-Hydro
7007.13		Due to absence of CW-Hydro representative in HAZOP meeting, some HAZOP items will be checked by Owner later. As the latest P&ID of vendor are not received in HAZOP meeting, further recommendations can be stated later. TCC should prepare the latest P&IDs of this package and send them to Owner during two weeks.	Y			CW-Hydro / TCC
7008.1	3	Add high pressure alarm and high high pressure trip at turbine inlet utilizing inlet PT to send signal to CW-Hydro PLC.	Y			CW-Hydro
7008.2	3	Add high pressure alarm and automatic stop auxiliary oil pump.	Y			CW-Hydro

7008.3	3	Add low pressure alarm at turbine inlet utilizing inlet PT to send signal to CW-Hydro PLC.	Y			CW-Hydro
7008.4	3	1.Cancel PSL-0541 1/2 switch. 2.Use transmitter instead of all switch(PDT-0541 1/2, PSLL-0541 1/2, 0542 1/2, 0543 1/2 and others). 3.PT-0541 1/2, 0542 1/2, 0543 1/2 (medium of 3) low pressure alarm and start the auxiliary oil pump, low low pressure(2oo3) to trip.	Y			CW-Hydro
7008.6	3	Add high temperature alarm and high high temperature trip at turbine inlet pipe.	Y			CW-Hydro
7008.7	2	Add TT high temperature alarm and high high temperature trip at turbine outlet pipe.	Y			CW-Hydro
7008.8	2	Add low temperature alarm and auto start oil heater EH-0501 1/2.	Y			CW-Hydro
7008.9	2	Add low level alarm and low low level trip for LSL-0541 1/2 .	Y			CW-Hydro

7008.11	3	1.Add low pressure and low temperature alarm at turbine inlet utilizing inlet PT and TT to send signal to CW-Hydro PLC. 2.Add minimum allowable low continuous speed alarm.	Y			CW-Hydro
7008.13		Due to absence of CW-Hydro representative in HAZOP meeting, some HAZOP items will be checked by Owner later. As the latest P&ID of vendor are not received in HAZOP meeting, further recommendations can be stated later. TCC should prepare the latest P&IDs of this package and send them to Owner during two weeks.	Y			CW-Hydro / TCC
7009.2	3	Add another level transmitter of D-8511 with high level alarm.	Y			TCC
7009.7	4	PG-8541 change to PT-8541 and send a signal to PLC and add high pressure alarm.	Y			TCC
7009.8	3	PG-8541 change to PT-8541 and send a signal to PLC and add low pressure alarm.	Y			TCC

7009.11	3	Vendor to advise: TIAS/TV-8544 as a safeguard.	Y			TCC
7009.13		HAZOP study should be done by vendor for flare gas system package, the owner will check flare package after receiving vendor data.	Y			TCC
7010.9	2	1.Add plant air connection for portable pumps.	Y			TCC
7010.13		1.Consider curb with anti-acid brick for H ₂ SO ₄ solution tank and NaOH solution tank.	Y			TCC
7201.3	2	1.Add a temperature transmitter and send the signal to control room, set high alarm in the 8"-TC-72-201-B50-N inlet line of X-7201A/B and X-7204.	Y			TCC
7201.5	3	1.Change FIQ-7204 to FI-7204.	Y			TCC
7201.6	2	1.Add low alarm for FT-7205.	Y			TCC
7201.7	2	1.Add low alarm for FI-7201. 2. Add FI and low alarm for FI-7204 (DMW from B.L)	Y			TCC
7201.8	2	1.Add low alarm for FT-7203A/B.	Y			TCC

7201.9	2	1.Add check valve on 8"-DMW-70-108-B50-N of 7000-PID-020.	Y			TCC
7201.10	2	1.Add check valve on 8"-TC-72-201-B50-N. 2.P-3011A/B should be considered as auto start(should be confirmed with GE).	Y			TCC
7201.11	3	Supply chemical from well known vendor, with high quality and test before use in plant.	Y			TCC
7201.12	2	1.Add alarm high for PT-7202. 2. Correct setpoint of PSV-7205 and PSV-7206A/B to 10 barg.	Y			TCC
7201.13	2	1.Add alarm high for PT-7203. 2.Correct setpoint of PSV-7205 and PSV-7206A/B to 10 barg.	Y			TCC
7201.14	3	1.Add alarm high for PT-7207A/B. 2. Correct setpoint of PSV-7203A/B to 7 barg.	Y			TCC
7201.15	1	1.Correct design pressure of discharge line from P-7002A/B to 14 barg.	Y			TCC
7201.23	2	1.Add high alarm for AT/AI-7208. 2.Add high alarm for AT/AI-7209.	Y			TCC

7201.30	1.HAZOP study should be done by vendor for polishing unit package, the owner will check polishing unit package after receiving vendor data.	Y			TCC
---------	---	---	--	--	-----

Attachment 1

Process Deviation Guidewords

High Flow
Low/ No Flow
Mal-distributed Flow
Incorrect Flow Direction
Reverse Flow
Part of Flow/Composition
As well as Flow/Impurity
Other than Flow/Incorrect Substance
High Concentration
Low Concentration
High Pressure
Low Pressure
Vacuum
High Temperature
Low Temperature
High Level
Low/ No Level
Heat Exchanger Tube Rupture/ Leak
Plate Heat Exchanger Failure
Action Not Execute
Extra Execute Action
Rupture/ Leak
Other

Attachment 2

HAZOP Worksheet

HAZOP analyzing record

2017/2/28

Project name : MKP Methanol Project

Establish dt : 2016/8/10 Am12:00:00

Company nam Middle East Kimiaye Pars Company

Plant site :

Project no :

Risk matrix : 8X7(TCC) (imported) (imported)

Process name : Cooling Water Unit

Node description Cooling water system

Pipe / equipment n F-0501A/B/C/D, T-0501A/B/C/D, PD-0501, P-0501 1/2, P-0502A/B, P-0504A/B, F-0502 1/2, P-0505A/B, PD-0502, P-0506A/B, TK-0503, P-0507, TK-0508, P-0510A/B, TK-0509, P-0511A/B, TK-0510, P-0512A/B, E-0501

Drawing no : 0500-PID-001~005;7000-PID-016

Design purpos Cooling water circulating, CW supply 38 degree C, CW return 48 degree C, Cl- less than 65 mg/L.

Serial #	Deviation	Cause	Consequence	Safeguard	Severity	Likelihood	Risk	LOPA	Recommendation
501 . 1	High flow(CW)	1 1.Incorrect pump selection which lead to high flow, pressure and velocity. 2.P-0501 1/2 turbine steam flow increased. 3.Manual valve of consumers abnormally open too big due to human error. 4.Exchanger or cooling water line leak or rupture. 5.Human error in opening manual valves at the end of CWS for circulating into CWR.	1.CW system pressure decreased. 2.Inlet pressure to all CW consumers decreased (especially E-3003 1/2/3 and E-5010 which are located the highest location) hence complete cooling is not achieved.	1.FIA-0514 high flow alarm. 2.FIA-0511 high flow alarm. 3.PIA-0514 low pressure alarm. 4.Turbine control system adjust turbine speed.	4	2	2	N	
. 2	High flow(FT-0501 1/2 steam)	1 HPS header pressure increasing.	1.High flow and pressure in CWS. 2.High speed of steam turbine shaft.	1.FIA-0514 high flow alarm. 2.FIA-0511 high flow alarm. 3.PIA-0514 low pressure alarm. 4.Turbine control system adjust turbine speed. 5.Same as high pressure(HPS inside plant) 7001.9.	2	2	1	N	

Serial #	Deviation	Cause	Consequence	Safeguard	Severity	Likelihood	Risk	LOPA	Recommendation
. 3	low/no flow(CW)	1 1.HPS flow decreased. 2.P-0501 1/2 or P-0502A/B failure. 3.Tubine of P-0501 1/2 failure. 4.Manual valve of consumers abnormally closed due to human error. 5.Exchanger or cooling water line blockage or rupture. 6.Pump strainers blockage. 7.Manual valves on inlet or outlet route closing due to human error. 8.Failure of check valve, remaining in semi-open situation.	1.Plant shutdown. 2.Shortage of CW in consumers, lead to high temperature and finally failure of cooling in CW exchanger.	1.PIA-0514 low pressure alarm at P-0501 1/2, P-0502A/B outlet. 2.FIA-0514 flow indicator. 3.FIA-0511 flow indicator. 4.CW pumps 3 operate 1 spare(two pumps running with steam turbine and one with electrical driven, so in this case only one pump will be in the service up to another electrical driven pump come in the service and the plant maybe face to the shutdown).	4	3	3	N	Develop SOP for proper adjusting CW distribution in case of two pumps running and low plant loading situation.
. 4	low/no flow(FT-0501 1/2 steam)	1 1.HPS header pressure decreasing. 2.Rupture of HPS pipe. 3.Loss of hydraulic oil pressure and close the steam valve.	1.Plant shutdown. 2.Shortage of CW in consumers, lead to high temperature and finally failure of cooling in CW exchanger.	1.PIA-0514 low pressure alarm at P-0501 1/2, P-0502A/B outlet. 2.FIQ-0514 indicator. 3.CW pumps 3 operate 1 spare(two pumps running be able to keep plant operation).	4	3	3	N	

Serial #	Deviation	Cause	Consequence	Safeguard	Severity	Likelihood	Risk	LOPA	Recommendation
. 5	part of flow/composition(H ₂ SO ₄)	1 1.P-0512A/B failure. 2.TK-0510 empty. 3.Blockage or rupture of pipe. 4.Concentration of H ₂ SO ₄ is lower than normal.	1.pH increase. 2.Increasing of exchanger and pipe fouling.	1.LALL-0517 low level alarm. 2.P-0512 A/B 1 operate 1 spare. 3.ML-0512A/B(running status), XA-0512A/B(fault status). 4.AIA-0511 online analyzer(for pH). 5.AIH-0511 high pH alarm and auto-start P-0512A/B. 6.AI-0512 online analyzer(for conductivity) 7.AI-0513 online analyzer(for ORP) 8.AP-0501 sampling point.	4	3	3	N	Add AT-0511 low pH alarm and interlock to auto-stop H ₂ SO ₄ injection pump.
. 6	part of flow/composition(anti-scaling)	1 1.P-0511A/B failure. 2.TK-0509 empty. 3.Pipe leakage or rupture.	Exchanger and pipe fouling	1.LALL-0516 low level alarm. 2.P-0511 A/B 1 operate 1 spare. 3.ML-0511A/B(running status), XA-0511A/B(fault status). 4.AIA-0515 online analyzer(for anti-scale agent). 5.AIL-5015 low alarm and auto-start P-0511A/B. 5.AP-0501 sampling point.	4	3	3	N	

Serial #	Deviation	Cause	Consequence	Safeguard	Severity	Likelihood	Risk	LOPA	Recommendation
. 7	part of flow/composition(inhibitor)	1 1.P-0510A/B failure. 2.TK-0508 empty. 3.Pipe leakage or rupture.	Exchanger and pipe corrosion.	1.LALL-0515 low level alarm. 2.P-0510 A/B 1 operate 1 spare. 3.ML-0510A/B(running status), XA-0510A/B(fault status). 4.AIA-0514 online analyzer(for corrosion inhibitor). 5.AIL-0514 low alarm and auto-start P-0510A/B. 6.AI-0512 online analyzer(for conductivity) 7.AI-0513 online analyzer(for ORP) 8.AP-0501 sampling point.	4	3	3	N	
. 8	part of flow/composition(NaClO)	1 1.P-0506A/B failure. 2.TK-0503 empty. 3.Pipe leakage or rupture. 4.Low concentration of NaClO in TK-0503.	1.Algae formation in CW. 2.Affect CW quality. 3.Increasing CW temperature for decreasing the cooling tower efficiency.	1.LALL-0503 low level alarm. 2.P-0506 A/B 1 operate 1 spare. 3.ML-0506A/B(running status), XA-0506A/B(fault status). 4.AP-0501 sampling point.	4	3	3	N	
. 9	high concentration(H ₂ SO ₄)	1 1.P-0512A/B adjustment failure cause H ₂ SO ₄ exceeding. 2.Human error. 3.AT-0511 failure. 4.High concentration of H ₂ SO ₄ in TK-0510.	1.Corrosion in the equipments and pipe. 2.High consumption of H ₂ SO ₄ .	1.AIA-0511 online analyzer(for pH). 2.AI-0512 online analyzer(for conductivity) 3.AI-0513 online analyzer(for ORP) 4.AP-0501 sampling point.	4	3	3	N	Add AT-0511 low pH alarm and interlock to auto-stop H ₂ SO ₄ injection pump.

Serial #	Deviation	Cause	Consequence	Safeguard	Severity	Likelihood	Risk	LOPA	Recommendation
. 10	high concentration(NaClO)	1. 1.P-0506A/B adjustment failure cause NaClO exceeding. 2.Human error in starting both pump at the same time. 3.High concentration NaClO in TK-0503.	CLO- increase in CW, cause stress corrosion in case of stainless steel exchanger.	1.AP-0501 sampling point. 2.COC of Cl- control to keep to 4. 3.AI-0512 conductivity analyzer. 4.AI-0512 ORP analyzer.	3	3	2	N	TCC to check: relation between ClO- and Cl- concentration and relevant reactions (for NaClO dosing in CW).
. 11	low concentration	1. Same as part of flow/composition(H ₂ SO ₄),part of flow/composition(anti-scale), part of flow/composition(inhibitor), part of flow/composition(NaClO) 0501.5/6/7/8	Same as part of flow/composition(H ₂ SO ₄),part of flow/composition(anti-scale), part of flow/composition(inhibitor), part of flow/composition(NaClO) 0501.5/6/7/8	Same as part of flow/composition(H ₂ SO ₄),part of flow/composition(anti-scale), part of flow/composition(inhibitor), part of flow/composition(NaClO) 0501.5/6/7/8				N	
. 12	high pressure	1.1.Exchanger blockage. 2.Manual valve abnormally closed (partial or total) due to human error(along the circulation route from pump discharge to cooling tower). 3.High pressure of HPS. 4.Low pressure in LPS header.	1.Circulation water pressure increased. 2.P-0501 1/2, P-0502A/B trip. 3.Plant shutdown. 4.Due to high discharge pressure of turbine driver pumps, electrical pumps may not be able to deliver the same pressure and may damage. 5.Rate of water circulation increased (in case of cause 3&4).	1.FIA-0514 high flow alarm(in case of cause 3&4). 2.FIA-0511 high flow alarm(in case of cause 3&4). 3.Turbine control system adjust turbine speed. 4.Same as high pressure(HPS inside plant) 7001.9.	4	3	3	N	Add high alarm to PIA-0514.

Serial #	Deviation	Cause	Consequence	Safeguard	Severity	Likelihood	Risk	LOPA	Recommendation
. 13	low pressure	1 1.Incorrect pump selection which lead to high flow, pressure and velocity. 2.P-0501 1/2 turbine steam flow or pressure decreased. 3.Manual valve of consumers abnormally open too big due to human error. 4.Exchanger or cooling water line leak or rupture. 5.Human error in opening manual valves at the end of CWS for circulating into CWR. 6.Strainers blockage.	1.Inlet pressure to all CW consumers decreased (especially E-3003 1/2/3 and E-5010 which are located the highest location) hence complete cooling is not achieved. 2.Loss of production capacity due to high temperature in C-3001 inlet and incomplete cooling in 5000 unit exchangers, finally high high temperature and shut down.	1.FIA-0514 high flow alarm. 2.FIA-0511 high flow alarm. 3.PIA-0514 low pressure alarm. 4.Turbine control system adjust turbine speed. 5.TIA-0511 high temperature alarm.	4	2	2	N	1.Add TE-0511 low temperature alarm. 2.Add PT-0511 low pressure alarm.
. 14	vacuum	1 Pump suction strainer blockage.	1.Damage to P-0501 1/2, P-0502A/B. 2.Loss of CW system, overtemperature and shut down.	PIA-0512A/B, PIA-0513A/B low pressure alarm and low low pressure alarm.	4	2	2	N	

Serial #	Deviation	Cause	Consequence	Safeguard	Severity	Likelihood	Risk	LOPA	Recommendation
. 15	high temperature	1 1.Cooling tower failure. 2.High temperature of CWR. 3.High temperature and humidity of ambient. 4.High flow rate of CW.	1.Process temperature increased, high temperature in process units, in extreme case plant shut down. 2.Excessive growth of algae, high consumption rate of NaClO.	1.TIA-0513 high temperature alarm. 2.Possibility of using all of 4 cooling towers to reduce the CWS temperature.	4	3	3	N	
. 16	low temperature	1 non actual hazard and operation identify						N	
. 17	action not execute(CW filter operation)	1 1.PDI-0518A/B failure. 2.Failure of valving system. 3.Human error in closing the valve. 4.P-0504A/B failure.	1.Affect CW quality, suspended solid formation. 2.Blockage of heat exchangers.	PIA-0515 low pressure alarm.	4	3	3	N	1.Lines from each filter to PD-0502 for discharge of CSW shall be sloped down towards PD-0502.
. 18	extra action execute(CW filter operation)	1 1.PDI-0518A/B failure. 2.Failure of valving system.	1.Waste CW and increase R.O. water as make-up. 2.Increasing CSW output from unit towards DMPC.	1.FIQ-0516 flow indicator. 2.LI-0512 level indicator.	2	3	1	N	1.Add flow indicator for FT-0516.
. 19	As well as flow(water quality)	1 1.Low quality make up water. 2.High d/p of filter.	1.Impact the purity of product. 2.More make up water. 3.Block exchanger.	1.AI-0512 conductivity indicator. 2.PDI-0518A/B high d/p alarm.	3	3	2	N	
. 20	low pressure(CW filter)	1 1.P-0504A/B failure.	1.No outlet of filter. 2.High impurity.	1.PT/PIA-0515 low pressure alarm.	3	3	2	N	

Serial #	Deviation	Cause	Consequence	Safeguard	Severity	Likelihood	Risk	LOPA	Recommendation
. 21	high temperature(CW filter)	1 1.Cooling tower failure. 2.High temperature of CWR. 3.High temperature and humidity of ambient. 4.High flow rate of CW.	1.Process temperature increased, high temperature in process units, in extreme case plant shut down. 2.Excessive growth of algae, high consumption rate of NaClO. 3.Low efficiency of filter.	1.TIA-0513 high temperature alarm. 2.Possibility of using all of 4 cooling towers to reduce the CWS temperature.	4	3	3	N	
. 22	no/low flow(CW filter)	1 same as 501.20						N	
. 23	other	1						N	HAZOP study should be done by vendor for CW filter system package, the owner will check CW filter package after receiving vendor data.

HAZOP analyzing record

2017/3/22

Project name : MKP methanol Project

Establish dt : 2016/8/10 Am12:00:00

Company nam Middle East Kimiaye Pars Company

Plant site :

Project no :

Risk matrix : 8X7(TCC) (imported) (imported) (imported)

Process name : 2000# AREA

Node description Recycle hydrogen compressor C-2002

Pipe / equipment n C-2002, MC-2002, D-2070, D-2072, D-2071, D-2073, E-2070, D-2074, D-2075.

Drawing no : MKP-VD-9000-306-003-A1~MKP-VD-9000-306-007-A1

Design purpos To provide H2 gas for reduction of catalyst during start-up, operation
condition:inlet 7/24 barG, 48 degree C; outlet 15/50.4barG, 48 degree C.

Serial #	Deviation	Cause	Consequence	Safeguard	Severity	Likelihood	Risk	LOPA	Recommendation
2007 . 1	High flow	1 FT/FIC/FV-2150 fails open	Decreasing pressure in hydrogen header,increasing hydrogen recycling.	1.PI-2150 low alarm. 2.PT/PIC/PV-2608 adjust pressure.				N	
. 2	low/no flow	1 1.PT/PIC/PV-2481 fail open. 2.USV-2482 abnormally open. 3.PT/PIC/PV-2406 fail open. 4.PSV-2354~2360 abnormally open.	1.Compressing ratio increase, and damage compressor in worst case. 2.Compressor outlet and capacity control valves temperature increase, and damage compressor in worst case.	1.PIA-2700 low pressure alarm at C-2002 inlet. 2.TIA-2701/2703 high temperature alarm and high high temperature alarm at C-2002 outlet. 3.PIAS-2701 open PV-2704 for keeping compression ratio when pressure \geq 52 barG. 4.VIAS-2700/2701 high vibration alarm and high high vibration trip.	3	4	3	N	
. 3	No flow(Lube oil)	1 1.Inlet strainer blocked. 2.Oil filter blocked. 3.Pipe leakage.	Damage crank shaft and bearings.	1.PIAS-2703 \leq 2.7 barG autimatic start auxiliary oil pump, and PIAS-2703/2704/2705(2003) \leq 2.0 barG shut down. 2.PDIA-2702 high d/p alarm for filter blockage.	3	4	3	N	1.Add the branch suction line for AOP with strainer and valve in each line. 2.Add check valve on pump P-2004B discharge.
. 4	incorrect flow direction	1 non actual hazard identify						N	
. 5	reverse flow	1 Capacity control valves (suction valves) failure.	Temperature increase, and damage piston ring,rider ring and packing ring.	1.TIA-2701/2703 high temperature alarm, and high high temperature alarm. 2.Check valve at C-2002 outlet.	3	4	3	N	TIA-2701/2703 add high high temperature trip.
. 6	part of flow/composition	1 non actual hazard identify						N	

Serial #	Deviation	Cause	Consequence	Safeguard	Severity	Likelihood	Risk	LOPA	Recommendation
. 7	as well as flow/impurity	1 non actual hazard identify						N	
. 8	high pressure(process side)	1.1.Manual valve abnormally closed at C-2002 outlet. 2.PT/PIC/PV-2608 fails open.	Overpressure and H ₂ 、CO leak cause fire and explosion and toxic release in worst case.	1.PV-2701 open (pressure \geq 52 barG). 2.PISA-2701 high high alarm (pressure \geq 53 barG), and high high trip (pressure \geq 54 barG). 3.PSV-2701 (set @ 55.4 barG). 4.PSV-2604/2605 (set @ 60barG).	5	2	3	Y	
. 9	high pressure(Lube oil)	1 P-2004A/B switch error cause two pumps running simultaneously.	Lube oil system pressure increase and cause pipe leak.	PIAS-2703 pressure \geq 4.5 barG automatic stop auxiliary oil pump.	2	4	2	N	PIAS-2703 add high pressure alarm.
. 10	low pressure(process side)	1 Same as 2007.2 low/no flow(process side).						N	
. 11	low pressure(Lube oil)	1.P-2004A/B failure. 2.Filter blockage. 3.PCV-2703 fail closed. 4.Pipe leak.	Damage crank shaft and bearings.	1.PIAS-2703 \leq 2.7 barG automatic start axuiliary oil pump, and PIAS-2703/2704/2705(2oo3) \leq 2.0 barG shut down. 2.PDIA-2702 high d/p alarm for filter blockage.	3	4	3	N	PIAS-2703 add low pressure alarm.
. 12	high temperature(Process gas outlet)	1.Cooling water supply failure. 2.Capacity control valves failure. 3.Feed gas low flow.	1.Compressing ratio increase 2.Temperature increase, and damage piston ring,rider ring and packing ring.	1.TIA-2701/2703 high temperature alarm, and high high temperature alarm at compressor outlet. 2.Process gas inlet low pressure alarm PIA-2700.	3	4	3	N	TIA-2701/2703 add high high temperature trip.

Serial #	Deviation	Cause	Consequence	Safeguard	Severity	Likelihood	Risk	LOPA	Recommendation
. 13	low temperature(Process gas)	1 non actual hazard identify						N	
. 14	high level(D-2074)	1 1.D-2005 LST/LIC/LV-2474 fail closed. 2.P-2003A/B failure and lead liquid carry to compressor C-2002.	Damage compressor.	LICA-2474 high level alarm.	3	3	2	Y	Add LST-2474A/B/C (medium of three) high high alarm and trip C-2002 by way of DCS during start-up.
. 15	low level(D-2074)	1 LV-2701 abnormally open.	Recycle H2 impact drain system.	LIAS-2700 low level to close LV-2701 and low low level alarm.	3	3	2	N	
. 16	low level(Oil tank/crank shaft tank)	1.Crank shaft casing leakage. 2.Piping leakage.	Damage bearings and oil pump.	1.LG-2700 2.PIAS-2703/2704/2705(2oo3) \leq 2.0 barG shut down.	3	3	2	N	1.Add level switch for crank shaft tank with low trip. 2.Forbidden to start compressor when the oil level is low.
. 17	rupture/leak(seal gas system)	1.PCV-2700/2701 fail closed. 2.Packing failure.	Loss of N2 and recycle hydrogen release and vent to flare.	1.PT/PI-2706/2707.	2	4	2	N	PT/PI-2706/2707 add low pressure alarm.
. 18	High Vibration	1 Parts loosing.	Damage crank shaft and bearings, and damage compressor in the worst case.	VIAS-2700/2701 high vibration alarm and high high vibration trip.	3	3	2	N	
. 19	other	1 non actual hazard identify						N	

HAZOP analyzing record

2017/3/22

Project name : MKP methanol Project

Establish dt : 2016/8/10 Am12:00:00

Company nam Middle East Kimiaye Pars Company

Plant site :

Project no :

Risk matrix : 8X7(TCC) (imported) (imported) (imported)

Process name : 2000# AREA

Pipe / equipment n C-2001

Node description Start-up nitrogen compressor C-2001

Design purpos Pressurizing system for start-up.

Drawing no : MKP-11-DE-9000-RE-REQ-308, 0514-JA 16704-PID

Serial #	Deviation	Cause	Consequence	Safeguard	Severity	Likelihood	Risk	LOPA	Recommendation
2008 . 1	High flow(Process Side)	1 non actual hazard identify						N	
. 2	low/no flow	1 1.Suction filter blockage. 2.HV-2750 fail closed.	1.Compressor surge and damage. 2.Increasing outlet line and compressor temperature.	1.Anti-surge valve FV-2575 open, and PLC set a delay time to trip. 2.VISA-2750~2753 high vibration alarm and high high vibration set a delay time to trip. 3.PDG-2754 d/p indicator for temporary filter blockage.	3	4	3	N	1.Revise P&ID to show alarm and interlock for temperature,pressure and flow if any. 2.Add alarm high and high high trip for TT-2579.
		2 1.Discharge manual valve abnormally closed. 2.PSV fail open. 3.C-2001 trip due to high temperature and lube oil low pressure, etc.	E-2002 tube side overtemperature and damage.	FST-2582 low flow alarm and low low flow trip to activate IS-1 with POS(process override switch).	3	4	3	Y	
. 3	incorrect flow direction	1 non actual hazard identify						N	
. 4	reverse flow	1 Trip of C-2001.	Back flow.	Check valve on discharge line.	2	4	2	N	Show check valve and manual valve on 2000-PID-018
. 5	part of flow/composition	1 non actual hazard identify						N	
. 6	as well as flow/impurity	1 non actual hazard identify						N	

Serial #	Deviation	Cause	Consequence	Safeguard	Severity	Likelihood	Risk	LOPA	Recommendation
. 7	high pressure(process side)	1 Discharge manual valve abnormally closed.	1.Overpressure and N2 realease. 2.Compressor inlet chocking.	PSV	2	4	2	N	PI-2579 add high pressure alarm.
. 8	low pressure(process side)	1 Leakage of system.	Reduce nitrogen flow, same as low/no flow (process side) cause 2.	Same as low/no flow (process side) cause 2.				N	
. 9	high pressure(lube oil)	1 MOP and AOP switch error cause two pumps running simultaneously.	Lube oil system pressure increase and cause pipe leak.	1.PCV-2750/2751 2.PSV-2750	2	3	1	N	Lube oil supply main line PT-9672 add high pressure alarm.
. 10	low pressure(lube oil)	1.Oil pump failure. 2.Filter blockage. 3.PCV-9671/9672 fail closed. 4.Pipe leak.	Gear and bearings wear out and compressor damage in worst case.	1.PT-9672 low alarm and low low pressure trip. 2.PDS-9671 high d/p alarm for filter blockage.	3	3	2	N	
. 11	high temperature(process side)	1 Same as 2008.2 low/no flow cause 1.						N	
. 12	high temperature(lube oil)	1 Cooling water supply failure.	Damage compressor.	1.TIA-9671 high temperature alarm on the lube oil pipe. 2.TISA-2760~2765,TISA-2766 ~2769, TISA-2770/2771 high temperattrue alarm and high high temperature trip.	3	3	2	N	
. 13	low temperature(lube oil)	1.External low temperature. 2.Cooling water overflow.	1.Viscosity of lube oil increase and cause shaft to wear out and damage turbine and CW pump. 2.Decrease the performance of lube oil pump and decrease the oil supply. 3.Increase d/p of the filter.	1.Lube oil heater will switch on when external low temperature. 2.PDS-9671 high d/p alarm for filter.	2	4	2	N	Show the autostart of lube oil heater in P&ID.

Serial #	Deviation	Cause	Consequence	Safeguard	Severity	Likelihood	Risk	LOPA	Recommendation
. 14	rupture/leak(seal gas system)	1 1.PDCV-12270 fail closed on primary sealing line. 2.Filter blockage on primary sealing line. 3.PCV-12270 on secondary sealing line. 4.Filter blockage on secondary sealing line.	Nitrogen and flammable gas release and vent to the atmosphere.	1.PDAL-12272 low d/p alarm and PDALL-12272 low low d/p alarm for primary sealing gas. 2.PDAH-12273 high d/p alarm for primary sealing gas filter. 3.PDAH-12270 high d/p alarm for secondary sealing gas filter. 4.PAH-12271 high pressure alarm and PAHH-12271 high high pressure alarm on vent line.	3	3	2	N	
. 15	low level(oil tank)	1 1.Oil tank leakage. 2.Oil pipe leakage.	Loosing of lube and compressor damage.	1.LS-9671 low level alarm. 2.Forbidden to start compressor when the oil level is low.	3	4	3	N	LS-9671 low level alarm change to low low level trip.
. 16	high vibration	1 Parts loosing.	Damage shaft and bearings, and damage compressor in the worst case.	VISA-2750~2753 high vibration alarm and high high vibration set a delay time to trip.	3	3	2	N	
. 17	other	1 Axial displacement.	Damage bearings.	ZISA-2750/2751 high axial displacement alarm and high high axial displacement trip.	2	4	2	N	

HAZOP analyzing record

2017/3/22

Project name : MKP methanol Project

Company nam Middle East Kimiaye Pars Company

Project no :

Process name : 2000# AREA

Node description Flue gas blower and turbine F-2001/FT-2001

Drawing no : MKP-VD-2000-351-145-A1, SH-3~5; MKP-VD-2000-351-302-A0

Establish dt : 2016/8/10 Am12:00:00

Plant site :

Risk matrix : 8X7(TCC) (imported) (imported) (imported)

Pipe / equipment n FT-2001, MP-1001, GB-1001, OT-1002, F-2001, MF-2001, OT-1001, AP-1001, OC-1001A/B, OF-1001A/B.

Design purpos Flue gas blower and turbine F-2001/FT-2001 for primary reformer.(inlet steam condition: 43 barG, 345 degree C, 44395 kg/hr ; trubine:4200 rpm , ID Fan: 1560 rpm)

Serial #	Deviation	Cause	Consequence	Safeguard	Severity	Likelihood	Risk	LOPA	Recommendation
2009 . 1	high pressure(Lube oil)	1 1.MP-1001/AP-1001 switch error cause two pumps running simultaneously. 2.Filter blocked. 3.Very low temperature.	Lube oil system pressure increase and cause pipe leak.	1.PT-2822 high pressure alarm and automatic stop auxiliary oil pump AP-1001. 2.PCV-2804 adjust pressure. 3.PSV-2802 on the circulating pipe(set pressure: 10kg/cm2G). 4.PSV-2803 on the outlet of auxiliary oil pump (set pressure: 10kg/cm2G). 5.Two filters, one run one spare.	2	3	1	N	
. 2	high pressure(turbine)	1 HPS from header high pressure.	Damage turbine(casing failure) and steam inlet pipe leak.	1.PT-2804 high pressure alarm and high high pressure trip. 2.PV-7004 open. 3.PSV-7010/7011/7012(set pressrue :52 barG).	3	2	1	N	
. 3	low pressure(Lube oil)	1 1.MP-1001/AP-1001 failure. 2.OF-1001A/B blocked or switch operation error. 3.PCV-2804 fail open. 4.Oil pipe leakage. 5.HO-1005 not correctly adjust.	Turbine and ID fan wear out and damage bearings in worst case.	1.PT-2822 low pressure alarm and start-up auxiliary L.O. pump. 2.PT-2822 low low pressure trip. 3.OT-1002 overhead tank. 4.PDI-2811 d/p indicator for filter blockage.	3	3	2	Y	PDI-2811 add high d/p alarm.

Serial #	Deviation	Cause	Consequence	Safeguard	Severity	Likelihood	Risk	LOPA	Recommendation
. 4	low pressure(turbine)	1 HPS from header low pressure.	1.Loss power of turbine and increase pressure of flue gas. 2.Increase consumption of the steam.	1.PT-2804 low pressure alarm and low low pressure to drive the fan by electric motor MF-2001. 2.PASH-2224(2oo3) high pressure alarm and trip IS-01. 3.PAHH-2224 high pressure trip I-15 open the damper on the top of H-2001.	4	3	3	N	
. 5	high temperature(Lube oil)	1 1.Cooling water failure. 2.Oil heater fail to overheating.	Loss of oil film cause shaft to wear out and damage turbine bearings and ID fan bearings.	1.High temperature alarms and high high temperature trip on bearings. 2.TI-2811 high temperature alarm and high high temperature switch off L.O. heater. 3.TI-2801 overheating protection.	3	3	2	N	
. 6	high temperature(inlet turbine)	1 HPS from header high temperature.	Turbine overtemperature, damage turbine and steam inlet pipe leak.	1.TT-2801 high temperature alarm and high high temperature trip. 2.Desuperheater on the steam header DS-7010A/B.	3	2	1	N	
. 7	high temperature(outlet turbine)	1 No load operation.	High temperature in exhaust of turbine.	TI-2802 high temperature alarm and high high temperature trip.	2	2	1	N	Add desuperheater on the LP steam header.
. 8	low temperature(Lube oil)	1.1.External low temperature. 2.Cooling water overflow.	1.Viscosity of lube oil increase and cause shaft to wear out and damage turbine and ID fan. 2.Decrease the performance of lube oil pump and decrease the oil supply. 3.Increase d/p of the filter.	1.Lube oil heater will switch on when external low temperature. 2.PDI-2811 d/p indicator for filter.	1	4	1	N	1.PDI-2811 add high d/p alarm. 2.Add TI-2801 low temperature alarm.

Serial #	Deviation	Cause	Consequence	Safeguard	Severity	Likelihood	Risk	LOPA	Recommendation
. 9	low level (OT-1001)	1 1.Oil tank leakage. 2.Pipe leakage. 3.Drain abnormally open.	1.No oil to the bearings. 2.Damage oil pump.	1.LI-2813 low level alarm and low low level trip. 2.PT-2822 low pressure alarm and low low pressure trip due to pipe leakage.	3	3	2	N	Add blind flange after the drain valve.
. 10	high speed	1 1.SE-2801A/B, SIC-2167 failure high. 2.HIC-2167 high input due to human error. 3.Actuator/governor valve fail open. 4.Coupling fracture.	Overspeed and damage turbine rotor and ID fan impeller.	1.SE-2802A/B/C(2oo3) high high speed trip SV-2801/2813 and drain control oil, close HPS. 2.Mechanical device ZE-2811 activate spring and drain control oil, close HPS.	4	2	2	Y	
. 11	low speed	1 1.Turbine running is lower than operating speed due to steam header low pressure 2.Governor valve fail closed.	1.Loss power of turbine and increase pressure of flue gas. 2.Increase consumption of the steam. 3.Decrease oil pressure.	1.PT-2804 low pressure alarm and low low pressure to drive the fan by electric motor MF-2001. 2.PASH-2224(2oo3) high pressure alarm and trip IS-01. 3.PAHH-2224 high pressure trip I-15 open the damper on the top of H-2001.	4	3	3	N	
. 12	high vibration	1 1.Turbine rotor unbalanced. 2.Oil film unstable between shaft and bearing. 3.Parts loosing. 4.Misalignment between equipments.	Damage turbine, gear box and ID fan.	VI-2803/2804/2805/2806/2811/2812/2813/2814 high vibration alarms and high high vibration trip.	4	2	2	N	

Serial #	Deviation	Cause	Consequence	Safeguard	Severity	Likelihood	Risk	LOPA	Recommendation
. 13	other	1 1.Axial displacement. 2.Excess force due to steam with water.	Damage thrust bearings and damage rotor.	1.ZI-2801 high axial displacement alarm and high high axial displacement trip on coupling with turbine and gear box. 2.ZI-2802 high axial displacement alarm and high high axial displacement trip on coupling with gear box and flue gas fan. 3.Desuperheater on the steam header DS-7010A/B. 4.Steam trap and condensate collector.	3	3	2	N	
		2						N	Due to incomplete data of P&ID for MF-2001, it will be checked later. TCC shall be issued completed P&ID like other MV motors of plant and consider auto start and relevant signals for it.

HAZOP analyzing record

2017/3/22

Project name : MKP methanol Project

Company nam Middle East Kimiaye Pars Company

Project no :

Process name : 2000# AREA

Node description Combustion air blower and turbine F-2002/FT-2002

Drawing no : MKP-VD-2000-351-120-A1, SH-3~5; MKP-VD-2000-351-303-A0

Establish dt : 2016/8/10 Am12:00:00

Plant site :

Risk matrix : 8X7(TCC) (imported) (imported) (imported)

Pipe / equipment n FT-2002, MP-2001, GB-2002, OT-2002, F-2002, MF-2002, OT-2001,
AP-2001, OC-2001A/B, OF-2001A/B.

Design purpos Combustion air blower and turbine F-2002/FT-2002 for primary reformer.(inlet
steam condition: 43 barG, 345 degree C, 27700 kg/hr ; trubine:5956 rpm , ID
Fan: 1560 rpm)

Serial #	Deviation	Cause	Consequence	Safeguard	Severity	Likelihood	Risk	LOPA	Recommendation
2010 . 1	high pressure(Lube oil)	1. MP-2001/AP-2001 switch error cause two pumps running simultaneously. 2. Filter blocked. 3. Very low temperature.	Lube oil system pressure increase and cause pipe leak.	1.PT-2872 high pressure alarm and automatic stop auxiliary oil pump AP-2001. 2.PCV-2001 adjust pressure. 3.PSV-2002 on the circulating pipe(set pressure: 10kg/cm2G). 4.PSV-2003 on the outlet of auxiliary oil pump (set pressure: 10kg/cm2G). 5.Two filters, one run one spare.	2	3	1	N	
. 2	high pressure(turbine)	1 HPS from header high pressure.	Damage turbine(casing failure) and steam inlet pipe leak.	1.PT-2854 high pressure alarm and high high pressure trip. 2.PV-7004 open. 3.PSV-7010/7011/7012(set pressrue :52 barG).	3	2	1	N	
. 3	low pressure(Lube oil)	1. MP-2001/AP-2001 failure. 2.OF-2001A/B blocked or switch operation error. 3.PCV-2001 fail open. 4.Oil pipe leakage. 5.HO-2005 not correctly adjust.	Turbine and ID fan wear out and damage bearings in worst case.	1.PT-2872 low pressure alarm and start-up auxiliary L.O. pump. 2.PT-2872 low low pressure trip. 3.OT-2002 overhead tank. 4.PDI-2861 d/p indicator for filter blockage.	3	3	2	Y	PDI-2861 add high d/p alarm.

Serial #	Deviation	Cause	Consequence	Safeguard	Severity	Likelihood	Risk	LOPA	Recommendation
. 4	low pressure(turbine)	1 HPS from header low pressure.	1.Loss power of turbine and air deficiency , low temperature afterburning ,flame out ,leakage of flammable gas, the system shut down possible explosion. 2.Decrease reaction conversion in reformer.	1.PT-2854 low pressure alarm and low low pressure to drive the fan by electric motor MF-2002. 2.PSAL-2163(2oo3) low pressure activate IS-01.	4	3	3	N	
. 5	high temperature(Lube oil)	1 1.Cooling water failure. 2.Oil heater fail to overheating.	Loss of oil film cause shaft to wear out and damage turbine bearings and ID fan bearings.	1.High temperature alarms and high high temperature trip on bearings. 2.TI-2861 high temperature alarm and high high temperature switch off L.O. heater. 3.TI-2862 overheating protection.	3	4	3	N	
. 6	high temperature(inlet turbine)	1 HPS from header high temperature.	Turbine overtemperature, damage turbine and steam inlet pipe leak.	1.TT-2851 high temperature alarm and high high temperature trip. 2.Desuperheater on the steam header DS-7010A/B.	3	3	2	N	
. 7	high temperature(outlet turbine)	1 No load operation.	High temperature in exhaust of turbine.	TI-2852 high temperature alarm and high high temperature trip.	2	2	1	N	Add desuperheater on the LP steam header.
. 8	low temperature(Lube oil)	1.1.External low temperature. 2.Cooling water overflow.	1.Viscosity of lube oil increase and cause shaft to wear out and damage turbine and ID fan. 2.Decrease the performance of lube oil pump and decrease the oil supply. 3.Increase d/p of the filter.	1.Lube oil heater will switch on when external low temperature. 2.PDI-2861 d/p indicator for filter.	1	4	1	N	1.PDI-2861 add high d/p alarm. 2.Add TI-2862 low temperature alarm.

Serial #	Deviation	Cause	Consequence	Safeguard	Severity	Likelihood	Risk	LOPA	Recommendation
. 9	low level (OT-2001)	1 1.Oil tank leakage. 2.Pipe leakage. 3.Drain abnormally open.	1.No oil to the bearings. 2.Damage oil pump.	1.LI-2863 low level alarm and low low level trip. 2.PT-2872 low pressure alarm and low low pressure trip due to pipe leakage.	3	3	2	N	Add blind flange after the drain valve.
. 10	high speed	1 1.SE-2851A/B, SIC-2119 failure high. 2.HIC-2119 high input due to human error. 3.Actuator/governor valve fail open. 4.Coupling fracture.	Overspeed and damage turbine rotor and ID fan impeller.	1.SE-2852A/B/C(2oo3) high high speed trip XY-2861 and drain control oil, close HPS. 2.Mechanical device ZE-2861 activate spring and drain control oil, close HPS.	4	2	2	Y	
. 11	low speed	1 1.Turbine running is lower than operating speed due to steam header low pressure 2.Governor valve fail closed.	1.Loss power of turbine and air deficiency , low temperature afterburning ,flame out ,leakage of flammable gas, the system shut down possible explosion. 2.Decrease reaction conversion in reformer.	1.PT-2854 low pressure alarm and low low pressure to drive the fan by electric motor MF-2002. 2.PSAL-2163(2oo3) low pressure activate IS-01.	4	3	3	N	
. 12	high vibration	1 1.Turbine rotor unbalanced. 2.Oil film unstable between shaft and bearing. 3.Parts loosing. 4.Misalignment between equipments.	Damage turbine, gear box and ID fan.	VI-2851/2852/2853/2854/2855/2856/21857/2858 high vibration alarms and high high vibration trip.	4	3	3	N	

Serial #	Deviation	Cause	Consequence	Safeguard	Severity	Likelihood	Risk	LOPA	Recommendation
. 13	other	1 1.Axial displacement. 2.Excess force due to steam with water.	Damage thrust bearings and damage rotor.	1.ZI-2851 high axial displacement alarm and high high axial displacement trip on coupling with turbine and gear box. 2.ZI-2852 high axial displacement alarm and high high axial displacement trip on coupling with gear box and flue gas fan. 3.Desuperheater on the steam header DS-7010A/B. 4.Steam trap and condensate collector.	3	4	3	N	
		2						N	Due to incomplete data of P&ID for MF-2002, it will be checked later. TCC shall be issued completed P&ID like other MV motors of plant and consider auto start and relevant signals for it.
. 14	High flow(air)	1 1.FT/FIC/FV-2111 fail open. 2.HIC/SIC-2119 set failure high by human error. 3.F-2002 loading too high during start up case and low operating load of plant.	Flame out and combust gas full of the chamber could cause explosion.	1.AIA-2223 2 combustibles high alarm. 2.AIA-2223 1 O2 high alarm. 3.TIC-2221 B temperature indicator. 4.SI-2852 speed high alarm.	4	2	2	N	Add PICA-2163 high pressure alarm.

Serial #	Deviation	Cause	Consequence	Safeguard	Severity	Likelihood	Risk	LOPA	Recommendation
. 15	High flow(fuel gas)	1 1.FT/FIC/FV-2531 1/2 fail open. 2.FT/FIC/FV-2536 A fail open. 3.FT/FIC/FV-3169 fail open. 4.PT/PIC/PV-1011 fail open.	Flame out and combust gas full of the chamber could cause explosion.	1.AIA-2223 2 combustibles high alarm. 2.AIA-2223 1 O2 high alarm. 3.TIC-2221 B temperature indicator.	4	2	2	N	

HAZOP analyzing record

2017/3/3

Project name : MKP Methanol Project

Establish dt : 2016/8/10 Am12:00:00

Company nam Middle East Kimiaye Pars Company

Plant site :

Project no :

Risk matrix : 8X7(TCC) (imported) (imported)

Process name : Methanol synthesis

Node description Synthesis Gas Compressing

Pipe / equipment n C-3001/C-3002, FT-3003 1/2

Drawing no : 3000-PID-001

Design purpos Synthesis Gas Compressing, 24.0~80.0 barG.48~74 degree C.

Serial #	Deviation	Cause	Consequence	Safeguard	Severity	Likelihood	Risk	LOPA	Recommendation
3001 . 1	High flow(Synthesis gas)	1 Refer to node 2005,2006.	1.C-3001/3002 outlet pressure decrease. 2.R-3001 1/2/3 low reaction and cause production decreasing, inert gas increasing. 3.C-3001/3002 overspeed and mechanical failure. 4.Incomplete separation of liquid droplet of synthesis gas cause problems in suction of compressor.	1.C-3001/3002 overspeed trip. 2.FIA-2476 high flow alarm.	4	3	3	Y	1.C-3001/3002 overspeed trip, SIF should be meet SIL 1. 2.Ask from compressor vendor for the proper safeguard about liquid droplet in compressor. GE has confirmed item 1. Item 2 has already been analyzed in the Node 3006.
. 2	High flow(Recycle gas)	1.1.Upstream synthesis gas high flow. 2.FT/FIC/FV-3169 fail closed. 3.High speed on synthesis turbine. 4.Overspeed of turbine. 5.Failure of damper(controlling flow of recycle gas).	1.C-3001/3002 circulator inlet pressure decrease, outlet pressure decrease.(Check by GE) 2.R-3001 1/2/3 low reaction and cause production increasing slightly, inert gas increasing. 3.C-3001/3002 overspeed and mechanical failure. 4.Incomplete separation of liquid droplet of synthesis gas cause problems in suction of compressor. 5.Higher pressure drop across the catalyst bed led to damage to catalyst support.	1.C-3001/3002 overspeed trip. 2.FIA-2476 high flow alarm. 3.FIA-3167 high flow alarm. 4.PDIA-3112/3115/3117 high d/p alarm.	4	4	4	N	1.Ask from compressor vendor for the proper safeguard about liquid droplet in compressor. 2.C-3001/3002 circulator inlet pressure decrease, outlet pressure decrease(for recycle gas high flow).(Check by GE) Item 1/2 has already been analyzed in the Node 3006.

Serial #	Deviation	Cause	Consequence	Safeguard	Severity	Likelihood	Risk	LOPA	Recommendation
. 3	low/no flow(Synthesis gas)	1. Manual valve abnormally closed due to operator error in inlet of C-3001/3002. 2.C-3001 synthesis gas inlet SDV valve abnormally closed. 3.Low/no flow of upstream. 4.Human error to open HV-3011. 5.Failure compressor or turbine.	C-3001/3002 surge and mechanical damage.	1.FIC-500 anti-surge control to open FCV-500.(Refer to GE P&IDs) 2.High vibration trip.	4	3	3	Y	1.High vibration trip, SIF should be meet SIL 1. (Check with GE) 2.Ask from compressor vendor for the proper safeguard about liquid droplet in compressor. 3.Ask and confirm from GE about SIL level. GE has confirmed item 1 for radial vibration. Item 2 have already been analyzed in Node 3006. Item 3 will be confirmed by way of SIL verification.
. 4	low/no flow(Recycle gas)	1. Upstream synthesis gas low flow. 2.FT/FIC/FV-3169 fail open. 3.C-3002 recycle gas inlet SDV valve abnormally closed. 4.PT/PIC/PV-3166 fail open. 5.Failure of compressor or turbine or damper.	C-3001/3002 surge and mechanical damage.	1.FIC-503 anti-surge control to open FCV-503.(Refer to GE P&IDs) 2.FI-3167 flow indicator.	4	3	3	N	High vibration trip, SIF should be meet SIL 1. (Check with GE) GE has confirmed item 1 for radial vibration.
. 5	incorrect flow direction	1. Operator mistake in opening HV-3011 or its bypass.	1.Same as low/no flow(synthesis gas) 3001.3 2.Environmental pollution.	1.FIC-500 anti-surge control to open FCV-500.(Refer to GE P&IDs) 2.High vibration trip. 3.PICA-3007 low pressure alarm.	4	3	3	N	

Serial #	Deviation	Cause	Consequence	Safeguard	Severity	Likelihood	Risk	LOPA	Recommendation
. 6	reverse flow	1 Surge in compressor.	Damage of compressor.	Anti-surge control.	4	4	4	N	
. 7	part of flow/composition	1 Same as upstream part of flow/composition.	Changing the molecular weight of synthesis gas and more consumption energy.	AI-3001/3002/3003 CO/CO2/H2 analyzer.	3	4	3	N	
. 8	as well as flow/impurity	1 Refer to 1000/2000 area.						N	
. 9	high concentration(synthesis gas)	1 High concentration(synthesis gas) in upstream.	Changing the molecular weight of synthesis gas and more consumption energy.	AI-3001/3002/3003 CO/CO2/H2 analyzer.	3	4	3	N	Check by GE for effect of (cause, consequence, safeguard) changing the molecular weight of synthesis gas. This item has already been analyzed in Node 3006.
. 10	low concentration(synthesis gas)	1 Upstream R-2004 abnormal conversion.	Affect methanol reaction.	AI-3001/3002/3003 CO/CO2/H2 analyzer.				N	Check by GE for effect of (cause, consequence, safeguard) changing the molecular weight of synthesis gas. This item has been already analyzed in Node 3006.
. 11	high pressure	1 1.C-3001/3002 discharge SDV abnormally closed. 2.High pressure in upstream.	Overpressure and flammable release.	1.PSV-502.(Refer to GE P&IDs) 2.High vibration trip. 3.High temperature trip. 4.Anti-surge control.	4	3	3	Y	

Serial #	Deviation	Cause	Consequence	Safeguard	Severity	Likeli hoo	Risk	LO PA	Recommendation
. 12	low pressure	1 1.HV-3011 fail open. 2.PV-3166 fail open. 3.FV-3169 fail open. 4.Low pressure in upstream.	Same as low/no flow(Synthesis gas) 3001.3.	Same as low/no flow(Synthesis gas) 3001.3.				N	
. 13	vacuum	1 Not possible.						N	
. 14	high temperature	1.1.Upstream RFG high temperature. 2.C-3001/2 intercooler CW failure. 3.High temperature of D-3001 outlet recycle gas. 4.High pressure in downstream synthesis gas compressor. 5.Low pressure in upstream synthesis gas compressor.	C-3001/3002 overtemperature and mechanical damage.	1.TIA-2476 high temperature alarm. 2.TIA-3164 high temperature alarm. 3.TIA-3113/3116/3118 high temperature alarm. 4.C-3001/3002 package high temperature alarm and trip.	4	3	3	Y	C-3001/3002 package high temperature alarm and trip, SIF should be meet SIL 1. (Check with GE) This item has been already analyzed in Node 3006.
. 15	low temperature	1.1.Low temperature of upstream. 2.High pressure of compressor suction.	No safety and operation hazard concern.					N	
. 16	rupture/leak	1 Flange/gasket or pipe fitting leak.	1.Fire and explosion. 2.CO toxic release.	1.Fire and gas detection system. 2.Fire fighting system.	4	2	2	N	

Serial #	Deviation	Cause	Consequence	Safeguard	Severity	Likelihood	Risk	LO PA	Recommendation
. 17	other	1 Refer to compressor C-3001/3002 package node.						N	

HAZOP analyzing record

2017/3/3

Project name : MKP Methanol Project

Establish dt : 2016/8/10 Am12:00:00

Company nam Middle East Kimiaye Pars Company

Plant site :

Project no :

Risk matrix : 8X7(TCC) (imported) (imported)

Process name : Methanol synthesis

Node description Synthesis compressor package

Pipe / equipment n D-3011, E-3012, C-3001, E-3014, D-3012, C-3002-1, C-3002-2, E-3013, TK-3002, P-3013A/B, PM-3013A/B, E-3018A/B, X-3002A/B, D-3013, P-3012, PM-3012, D-3014, TK-3001, FT-3001, P-3014, PM-3014, E-3011, D-3015, E-3020, P-3011A/B, PM-3011A/B, J-3004, J-3005A/B, J-3006A/B, X-3004A/B, P-3015, E-3021A/B/C, X-3005A/B, E-3016, E-3022A/B/C.

Drawing no : SOK0887013, SH2~7; SOK0880159, SH5~14.

Design purpos Synthesis Gas Compressing, operating conditions:24.0~80.0 barG, 48~122 degree C.

Serial #	Deviation	Cause	Consequence	Safeguard	Severity	Likelihood	Risk	LOPA	Recommendation
3006 . 1	High flow (syngas suction)	1 Upstream high flow.	1.C-3001/3002 outlet pressure decrease. 2.R-3001 1/2/3 low reaction and cause production decreasing, inert gas increasing. 3.Incomplete separation of liquid droplet of synthesis gas cause problems in suction of compressor, and damage compressor in worst case. 4.High pressure at the inlet of the compressor.	1.Same as high pressure. 2.FIA-2476 high flow alarm. 3.D-3011 syngas inlet seperator, LCV-3700 will open when level high, LSH-3700 level high alarm and LSHH-3700 level high high trip. 4.D-2005 is installed upstream for liquid separation, with LICA-2474 high level alarm and LSAH-2474 high high level trip.	4	3	3	Y	1.TCC and GE to review the IS-40 partial trip catagory (high level of liquid seperator, high flow) of compressor 2.LT-3700A/B/C(2oo3) level high high trip, SIF should meet SIL 1.
. 2	High flow(recycle gas)	1.1.Upstream synthesis gas high flow. 2.FT/FIC/FV-3169 fail closed. 3.High speed on synthesis turbine. 4.HIC/FCV-3725 failure open due to opeartor error.	1.Higher pressure drop across the catalyst bed led to damage to catalyst support. 2.Incomplete separation of liquid droplet of synthesis gas cause problems in suction of compressor, and damage compressor in worst case.	1.FIA-2476 high flow alarm. 2.FIA-3167 high flow alarm. 3.PDIA-3112/3115/3117 high d/p alarm. 4.LICA-3161 high level alarm. 5.LSAH-3161(2oo3) activate IS-03 to trip 3000 area.	4	3	3	N	
. 3	low/no flow(syngas suction)	1.1.Upstream low flow. 2.PV-2481/USV-2 482 fail open. 3.USV-3011 abnormally closed. 4.Handvalve at the syngas suction abnormally closed	1.C-3001 surge and damage. 2.No prodcution 3.C-3002-1 syngas 2nd stage compressor surge and damage.	1.FIC/FCV-3702 anti-surge control valve open. 2.PAL-3702 low pressure alarm. 3.XT-3555X/Y, XT-3556X/Y, XT-3520X/Y, XT-3521X/Y, XT-3557X/Y, XT-3558X/Y high vibration alarm and high high trip. 4.Handvalve at the syngas suction lock open. 5.FIC/FCV-3712 anti-surge control valve open.	4	3	3	Y	

Serial #	Deviation	Cause	Consequence	Safeguard	Severity	Likelihood	Risk	LOPA	Recommendation
. 4	low/no flow(recycle gas)	1 1.Upstream synthesis gas low flow. 2.FT/FIC/FV-3169 fail open. 3.Low speed on synthesis turbine. 4.HIC/FCV-3725 failure closed due to opearator error. 5.Handvalve at the recycle gas suction or discharge line is abnormally closed.	1.C-3002-2 surge and damage. 2.No/low production	1.FIC/FCV-3722 anti-surge control valve open. 2.PAL-3722 low pressure alarm. 3.XT-3555X/Y, XT-3556X/Y, XT-3520X/Y, XT-3521X/Y, XT-3557X/Y, XT-3558X/Y high vibration alarm and high high trip.	4	3	3	N	Handvalves at the recycle gas suction and discharge lines should be locked open.
. 5	incorrect flow direction	1 1.USV-3750 or 3751 fail open.	1.Low production. 2.High d/p between syngas and recycle gas discharge.	1.UZAH-3750/3751 open alarm 2.Balancing line UV-3714 open in case of high d/p between syngas and recycle gas discharge.	3	3	2	N	
. 6	reverse flow	1 1.Compressor sudden shut-off	1.Compressor counter rotation. 2.Compressor suction high pressure.	1.Anti-surge valves open. 2.Check valve at compressor suction. 3.Compressor suction design pressure high enough to bear shut-off pressure.	2	3	1	N	
. 7	part of flow/composition	1 1.Change composition from upstream.	1.Changing the molecular weight of synthesis gas and more consumption energy. 2.High pressure at discharge	1.AI-3001/3002/3003 CO/CO2/H2 analyzer. 2.Anti-surge control valves open.	3	4	3	N	
. 8	as well as flow/impurity	1 1.Change composition from upstream.	1.Changing the molecular weight of synthesis gas and more consumption energy. 2.Increase pressure of purge gas to fuel gas system. 3.Loss of production.	AI-3001/3002/3003 CO/CO2/H2 analyzer.	2	4	2	N	

Serial #	Deviation	Cause	Consequence	Safeguard	Severity	Likelihood	Risk	LOPA	Recommendation
. 9	high pressure(1st stage suction)	1 1.Upstream high pressure. 2.High flow 3.Discharge of C-3002-1 abnormally closed (interstage check valve blocked close isn't considered).	1.High pressure at discharge of C-3001. 2. C-3001 overpressure.	1.PT/PIC/PV-2481 vent to flare. 2.USV-2482 vent to flare. 3.PT-3740A/B/C(2oo3) high pressure alarm and high high pressure trip.	3	3	2	Y	
. 10	high pressure(1st stage discharge)	1 1.Same as high pressure(first stage suction). 2.High speed.	1.Same as high pressure(first stage suction). 2.Compressor, equipment and piping damage.	1.PT/PIC/PV-2481 vent to flare. 2.USV-2482 vent to flare. 3.PT-3740A/B/C(2oo3) high pressure alarm and high high pressure trip. 4.Overspeed trip. 5.PSV-3720A/B.	3	3	2	N	
. 11	high pressure(2nd stage discharge)	1 1.USV-3012 abnormally closed. 2.C-3002-1 outlet manual valve abnormally closed.	1.C-3002-1 overpressure,compressor, equipment and piping damage.	1.PT-3719A/B/C(2oo3) high pressure alarm and high high pressure trip. 2.PSV-3720A/B.	4	3	3	Y	1.Handvalve at the discharge of 2nd stage compressor(C-3002-1) should be lock open.
. 12	high pressure(recycle gas compressor)	1 1.USV-3014 abnormally closed. 2.C-3002-2 outlet manual valve abnormally closed. 3.High pressure upstream.	C-3002-2 overpressure, 2nd compressor,equipment and piping damage.	1.PT-3747A/B/C(2oo3) high pressure alarm and high high pressure trip. 2.PT/PIC/PV-3166 vent to flare.	4	4	4	Y	Add a PSV at the discharge of C-3002-2 or use PSHH-3747 high high pressure trip with SIL2.Those two solutions shall be discussed among GE, Owner and TCC.
. 13	low pressure(1st stage suction)	1 1.Low flow from upstream. 2.Malfunctioning of compressor speed control.	1.C-3001 surge and damage. 2.Effect reaction operation.	1.PAL-3702 low alarm. 2.Anti-surge valve FCV-3702.	4	3	3	N	

Serial #	Deviation	Cause	Consequence	Safeguard	Severity	Likelihood	Risk	LOPA	Recommendation
. 14	low pressure(1st stage discharge)	1 1.Malfunctioning of compressor speed control. 2.Anti-surge valve FCV-3702 fail open. 3.Tube rupture of E 3014.	1.C-3002-1 surge and damage. 2.Effect reaction operation. 3.Gas leaks into CW side of E 3014, causing shell side high pressure.	1.PI-3740A/B/C indicator. 2.Anti-surge valve FCV-3712. 3.PAL-3712 low alarm. 4.PSE-3744 protects shell of E 3014.	4	3	3	N	Add high level alarm at pot of sub flare header of compressor house area 3000 and show this pot on P&ID no. 8500-PID-002.
. 15	low pressure(2nd stage discharge)	1 1.Malfunctioning of compressor speed control. 2.Anti-surge valve FCV-3712 fail open.	1.Effect reaction operation.	1.PI-3719A/B/C indicator.	2	3	1	N	
. 16	low pressure(recycle gas compressor suction)	1 1.Malfunctioning of compressor speed control. 2.Tube rupture of E 3013. 3.Same as low flow of recycle gas.	1.Low production. 2.Gas leaks into CW side of E 3013, causing shell side high pressure. 3. Same as low flow.	1.PAL-3722 low pressure alarm. 2.PSE-3749 protects shell of E 3013. 3. Same as low flow.	4	3	3	N	
. 17	low pressure(recycle gas compressor discharge)	1 1.Malfunctioning of compressor speed control. 2.Anti-surge valve FCV-3722 fail open. 3.USV-3750 fail open.	1.Low production.	1.PI-3747(2003) indicator. 2.PI-3729 indicator. 3.UZAH-3750 alarms fail open of USV-3750.	2	3	1	N	

Serial #	Deviation	Cause	Consequence	Safeguard	Severity	Likelihood	Risk	LOPA	Recommendation
. 18	high temperature(1st stage suction)	1 1.Upstream high temperature. 2.Cooling water failure during surging.	Mechanical damage to compressor and piping.	1.TTA-2476 high temperature alarm. 2. TI-3701 indicator. 3. TIA-3709A/B/C(2oo3) high temperature alarm and high high temperature trip at 1st stage outlet. 4.TI-3740 indicator. 5. TI-3741 indicator.	4	3	3	N	
. 19	high temperature(2nd stage suction)	1 1.Cooling water failure of E 3014.	1.Mechanical damage to compressor and piping.	1.TI-3743/3744 indicators. 2.TI-3712 indicator. 3.TT-3719A/B/C(2oo3) high temperature alarm and high high temperature trip at 2nd stage outlet.	4	3	3	N	Add high temperature alarm on TT-3744.
. 20	high temperature(2nd stage discharge)	1 same as high temperature(2nd stage sucution).	same as high temperature(2nd stage sucution).	same as high temperature(2nd stage sucution).	4	3	3	N	
. 21	high temperature(recycle gas)	1 1.Upstream high temperature. 2.Cooling water failure during surging.	1.Mechanical damage to compressor and piping.	1.TT-3729A/B/C(2oo3) high temperature alarm and high high temperature trip at recycle gas compressor outlet. 2.TI-3722 indicator.	4	3	3	N	Add high temp. alarm for TI-3722.
. 22	low temperature(process gas)	1 1.Low temperature upstream.	no safety concern					N	
. 23	high level(D-3011)	1 1.Upstream high flow. 2.LCV-3700 fail close. 3.Low temperature.	Incomplete separation of liquid droplet of synthesis gas cause problems in suction of compressor, and damage compressor in worst case.	1.LAH-3700 level high alarm and LSHH-3700 level high high trip. 2.LZAL-3700 alarms fail open of LCV-3700.	4	3	3	N	

Serial #	Deviation	Cause	Consequence	Safeguard	Severity	Likelihood	Risk	LOPA	Recommendation
. 24	low level(D-3011)	1 LT/LIC/LCV-3700 abnormally open.	24 barG syngas impact drain header.	1.LT-3700A/B/C(2oo3) low level alarm and low low level trip. 2.Closed drain drum has a breathing valve with flame arrester.	4	3	3	N	1.to check the capacity of the breathing valve according to the max. gas blow.
. 25	high level(D-3012)	1 1.Upstream high flow. 2.LCV-3701 fail close. 3.Low temperature.	Incomplete separation of liquid droplet of synthesis gas cause problems in suction of compressor, and damage compressor in worst case.	1.LAH-3701 level high alarm and LSHH-3701 level high high trip. 2.LZAL-3701 alarms fail open of LCV-3701.	4	3	3	N	
. 26	low level(D-3012)	1 LT/LIC/LCV-3701 abnormally open.	High pressure syngas impact drain header.	LT-3701A/B/C(2oo3) low level alarm and low low level trip.	4	3	3	N	1.to check the capacity of the breathing valve according to the max. gas blow.
. 27	high pressure(Lube oil pump discharge side)	1.1.P-3013A/B switch error cause two pumps running simultaneously. 2.X-3002A/B clogging. 3.Manual valve of the L.O. pump discharge abnormally closed.	1.Damage the L.O. pumps and piping.	1.PCV-3505 will regulate the pressure in case of two pump running at the same time. 2. PSV-3503, 3504 on pump discharge. 3.PDT-3508 high d/p alarm.	3	3	2	N	

Serial #	Deviation	Cause	Consequence	Safeguard	Severity	Likelihood	Risk	LOPA	Recommendation
. 28	high pressure(Lube oil header)	1 1.PCV-3510 failure open.	1.Excessive lube oil to bearings, and potentially vibration.	1.PAH-3520A/B/C high pressure alarm. 2.XT-3555X/Y , XT-3556X/Y high vibration alarms and high high vibration trip on C-3001 shaft. 3.XT-3520X/Y , XT-3521X/Y high vibration alarms and high high vibration trip on FT-3001 shaft. 4.XT-3557X/Y , XT-3558X/Y high vibration alarms and high high vibration trip on C-3002 shaft.	4	2	2	N	

Serial #	Deviation	Cause	Consequence	Safeguard	Severity	Likelihood	Risk	LOPA	Recommendation
. 29	low pressure(Lube oil)	1 1.P-3013A/B, PM-3013A/B failure. 2.X-3002A/B clogging or switch operation error. 3.PCV-3510 fail closed. 4.Oil pipe leakage. 5.Tube rupture of E-3018A/B.	1.Damage the bearings. 2.Compressor vibration.	1.PT-3506 low pressure alarm and start-up standby L.O. pump. 2.PT-3520A/B/C(2oo3) low pressure alarm, and start standby L.O. pump, low low pressure trip. 3.TK-3001 run down tank for the first part of run down, and emergency pump P-3012 for the last part of run down, and emergency cool down. 4.PDSH-3508 high d/p alarm for falter blockage. 5.XT-3555X/Y , XT-3556X/Y high vibration alarms and high high vibration trip on C-3001 shaft. 6.XT-3520X/Y , XT-3521X/Y high vibration alarms and high high vibration trip on FT-3001 shaft. 7.XT-3557X/Y , XT-3558X/Y high vibration alarms and high high vibration trip on C-3002 shaft.	3	2	1	N	

Serial #	Deviation	Cause	Consequence	Safeguard	Severity	Likelihood	Risk	LOPA	Recommendation
. 30	high temperature(Lube oil)	1 1.Cooling water failure. 2.E-3015 failure. 3.TCV-3506 fully open.	1.Low oil viscosity causing potentially vibration. 2.Bearing damage.	1.TSH-3502 high temperature L.O. heater switch off. 2.TSHH-3503 overheating protection. 3.TSH-3506 high temeperature alarm. 4.High temperture alarm for bearings of compressor and turbine. 5. XT-3555X/Y , XT-3556X/Y high vibration alarms and high high vibration trip on C-3001 shaft. 6.XT-3520X/Y , XT-3521X/Y high vibration alarms and high high vibration trip on FT-3001 shaft. 7.XT-3557X/Y , XT-3558X/Y high vibration alarms and high high vibration trip on C-3002 shaft.	3	3	2	N	

Serial #	Deviation	Cause	Consequence	Safeguard	Severity	Likelihood	Risk	LOPA	Recommendation
. 31	low temperature(Lube oil)	1 External low temperature.	1.Viscosity of lube oil increase and cause shaft to wear out and damage compressor. 2.Damage L.O. pump P-3013A/B.	1.E-3015 electric heater and TSL-3502 low tempertaure L.O. heater switch on. 2.TSLL-3502 low low temperature inhibit to L.O. pumps start-up. 3.TAL-3506 low temperature alarm unit start inhibit. 4.XT-3555X/Y , XT-3556X/Y high vibration alarms and high high vibration trip on C-3001 shaft. 5.XT-3520X/Y , XT-3521X/Y high vibration alarms and high high vibration trip on FT-3001 shaft. 6.XT-3557X/Y , XT-3558X/Y high vibration alarms and high high vibration trip on C-3002 shaft.	3	3	2	N	
. 32	low level(oil tank TK-3002)	1 1.Drain valve abnormally open. 2. Oil piping leak. 3. No fill of the oil tank.	1.Damage of the E-3015 due to overtemperature. 2. P-3013A/B cavitation and damage. 3. Bearing damage.	1.TSHH-3503 heater cut off. 2. LSL-3501 low level alarm, heater switch off and inhibit lube oil pump start.	4	3	3	N	GE provide the information about the oil quantity between the main pumps suction loss level and emergency pump suction loss level.
. 33	low level(oil tank TK-3001)	1 1.Tank leak. 2.No fill to the tank.	1.No oil for machine run down, and damage the bearing.	1. LSL-3520 low level alarm, inhibit compressor start. 2.Emergency pump P-3012 for run down.	4	3	3	N	

Serial #	Deviation	Cause	Consequence	Safeguard	Severity	Likelihood	Risk	LOPA	Recommendation
. 34	high speed	1 1.PT-3701(load controller demand)、SE-352 5A/B/C、SY-3536 servovalve、SCV-3536 fail open. 2.PT-3701(load controller demand)、PT-359 4A/B/C (HP extraction pressure)、SE-352 5A/B/C、SY-3539 servovalve、FCV-3539 fail open. 3.PT-3701(load controller demand)、PT-3597 A/B/C (LP extraction pressure)、SE-352 5A/B/C、SY-3537 /3538 servovalve、FCV-3537/3538 fail open. 4.Coupling fracture.	Overspeed and damage compressor.	1.SE-3526A/B/C(2oo3) high high speed trip to solenoid valve XY-3532A/3532B, and XV-3534/3535 steam trubine inlet, 2.XY-3595 close command to HP steam extraction line check valve, XY-3598 close command to LP steam extraction line check valve.	4	3	3	Y	

Serial #	Deviation	Cause	Consequence	Safeguard	Severity	Likelihood	Risk	LOPA	Recommendation
. 35	high pressure(turbine inlet)	1 Upstream D-2001 high pressure.	1.Damage turbine. 2.Overspeed.	1.PSV-2376,2377,2378,2380. 2.PIA-2372 high pressure alarm. 3.PT-3590A/B/C(2oo3) high pressure alarm and high high pressure trip. 4.SE-3525A/B/C,3526A/B/C speed control. 5.SE-3526A/B/C(2oo3) high high speed trip to solenoid valve XY-3532A/3532B, and XV-3534/3535 steam trubine inlet, XY-3595 and close HP steam exrtation line, XY-3598 and close LP steam exrtation line.	4	2	2	N	
. 36	high pressure(turbine extraction)	1 1.FCV-3539 fail close. 2.FCV-3538/3537 fail close. 3.PT-3592 or PT-3593 control failure.	1.High pressure to damage the piping and turbine.	1.PAH-3594 high pressure alarm,PSHH-3594 high high pressure trip on HP steam turbine extraction. 2.PAH-3597 high pressure alarm,PSHH-3597 high high pressure trip on LP steam turbine extraction. 3.PSV-3594A/B/C on HP steam turbine extraction. 4.PSV-3597A/B/C on LP steam turbine extraction. 5.PIAC-7004 high pressure alarm. .	4	2	2	N	
. 37	low pressure(turbine inlet)	1.Uptream low pressure.	1.Low production. 2.Upset on extraction steam headers.	1.PICA-2363 low pressure alarm, PV-2363 open. 2.PIA-2372 low pressure alarm. 3.PI-3590 indicator.	2	3	1	N	

Serial #	Deviation	Cause	Consequence	Safeguard	Severity	Likelihood	Risk	LOPA	Recommendation
. 38	low pressure(turbine extraction)	1 1.PT-3592 or PT-3593 control failure. 2.Low pressure downstream header.	1.Damage the turbine blade due to high D/P.	1.PSL-3596 low pressure alarm, PSLL-3596 low low pressure trip or inhibit to start. 2.1.PSL-3599 low pressure alarm, PSLL-3599 low low pressure trip or inhibit to start.	3	3	2	N	
. 39	high pressure(E-3011)	1 1.Cooling water high temperature or failure. 2.Loss of vacuum unit.	1.Affect the efficiency and operation of turbine. 2.Overpressure to damage E-3011.	1.PT-3547A/B/C(2oo3) high pressure alarm and high high pressure trip. 2.PSV-3547. 3.TIA-0513 high temperature alarm in the cooling water supply. 4.FIA-0514 low flow alarm in the cooling water supply.	3	3	2	N	
. 40	high pressure(E-3020)	1 1.J-3006A/B malfunction due to no/low steam. 2.Discharge of J-3005A/B manual valve abnormally close.	1.Lose condensate. 2.Turbine efficiency decrease.	1.J3006A/B redundant 2.PSV-3587, PSV-3586	2	3	1	N	
. 41	high temperature(turbine inlet)	1 Upstream D-2001 high temperature.	1.Turbine damage due to overtemperature.	1.TT-3590A/B/C(2oo3) high temperature alarm and high high temperature trip. 2.TIA-2355/2356 high temperature alarm.	3	3	2	N	
. 42	high temperature(E-3011)	1 1.Cooling water high temperature or failure. 2.Loss of vacuum inside E-3011.	1.Affect the efficiency and operation of turbine. 2.Overpressure to damage E-3011.	1.PT-3547A/B/C(2oo3) high pressure alarm and high high pressure trip. 2.PSV-3547. 3.TIA-0513 high temperature alarm in the cooling water supply. 4.FIA-0514 low flow alarm in the cooling water supply.	3	3	2	N	

Serial #	Deviation	Cause	Consequence	Safeguard	Severity	Likelihood	Risk	LOPA	Recommendation
. 43	low temperature(turbine inlet)	1 1.Upstream low temperature.	1.Damage the turbine blade.	1.PIA-2372 low pressure alarm. 2.TICA-2360 low temperature alarm. 3.TAL-3590 low temperature alarm. 4.Steam quality protection USLL-3590 turbine trip/inhibit to start. 5.Proper warm-up line for startup.	3	3	2	N	
. 44	high level(E-3011)	1 1.P-3011A/B failure. 2.Steam condenser E-3011 tube rupture. 3.LCV-3540B failure open.	1.Condenser efficiency decrease. 2.High pressure of E-3011. 3.High impurity of condensate.	1.LT-3540A/B/C(2oo3) high level alarm and start stand-by condensate pump. 2.PT-3547A/B/C high pressure alarm, and high high trip. 3.Polishing unit.	3	3	2	N	
. 45	low level(E-3011)	1 1.Pipe leakage. 2.E-3011 shell leakage. 3.LCV-3540A fail open.	P-3011A/B cavitation and damage.	LT-3540A/B/C(2oo3) low level alarm and stop standby P-3011, low low level trip P-3011A/B.	2	3	1	N	
. 46	high pressure(turbine seal steam)	1 1.L.P.steam header high pressure. 2.PT/PIC/PCV-3549 fail open.	1.Increase the seal steam consumption. 2. Damage the sealing.	1.PSV-3550. 2.PSV-7057,7058,7059,7060,7061 at L.P.steam header.	2	2	1	N	
. 47	low pressure(turbine seal steam)	1 1.PT/PIC/PCV-3549 control loop failure. 2.L.P. steam header low pressure.	1.Loss of sealing and vacuum. 2. Thermal stress on the turbine rear end.	1.PAL-3548 low pressure alarm. 2.PCV-3548 fail open. 3.PICA-7056 low pressure alarm. 4.FO-3549 manual bypass 5. Vacuum Trip PT-3547A/B/C.	3	3	2	N	Operation Procedure should be placed that stop the steam turbine and remove the vacuum from the condenser in case of loss of LP steam. (To be mentioned in GE operation manual of the compressor package, and incorporated in the plant operation manual.)

Serial #	Deviation	Cause	Consequence	Safeguard	Severity	Likelihood	Risk	LOPA	Recommendation
. 48	high temperature(turbine seal steam)	1 non actual hazard identify						N	
. 49	low temperature(turbine seal steam)	1 L.P. steam header low temperature.	1.Condensate formed in the turbine steam and potentially damage the sealing and shaft.	1.TAL-3548 low temperature alarm. 2.TAL-7052/7053 low temperature alarm. 3.Steam quality UAL-3548 low alarm. 4.Drainage at the steam sealing LCV-3542. 5. Condensate from LP steam header is drained into the condensate recovery system.	3	3	2	N	
. 50	low flow(C-3001 seal gas)	1 FIC-3631A/B/F Y-3631/FCV-3631 control loop failure. 2.Filter X-3004A/B clogging. 3.Booster P-3015 failure during start-up and SOP.	1. Damage of dry gas seal. 2. Process gas leak into the atmosphere, cause fire and toxic release in worst case.	1.PDSH-3682 high d/p alarm for X-3004A/B clogging. 2.PDSL-3683 inhibit to compressor(s) pressurization. 3.FAL-3631A/B low flow alarm. 4.H2 and CO gas detector in the field. 5. PSHH-3660A/B/C and 3661A/B/C high high pressure trip with vent of the compressors. 6. FCV-3631 is fail-open type. 7.Redundant control loop of FIC-3631A/B.	4	2	2	N	

Serial #	Deviation	Cause	Consequence	Safeguard	Severity	Likelihood	Risk	LOPA	Recommendation
. 51	low pressure(C-3001 N2 isolation gas)	1 1.N2 supply failure. 2.X-3003A/B clogging. 3.PCV-3653 failure. 4.Manual valve in the N2 inlet abnormally closed.	1. Oil contamination to the dry gas seal, potentially dry gas seal to the bearings. 2. Process gas leak into the atmosphere, cause fire and toxic release in worst case.	1.PDSH-3652 high d/p alarm for X-3003A/B clogging. 2.PT-3660A/B/C(2oo3) low low pressure trip with vent. 3.PT-3661A/B/C(2oo3) low low pressure trip with vent. 4.PT-3655A/B/C low pressure alarm and inhibit the lube oil pump to start, low low pressure trip for oil contamination. 5.H2 and CO gas detector in the field.	4	2	2	N	
. 52	low flow(C-3002 seal gas)	1 1.FIC-3636A/B/F Y-3636/FCV-3636 control loop failure. 2.Filter X-3005A/B clogging. 3.Booster P-3016 failure during start-up and SOP.	1. Damage of dry gas seal. 2. Process gas leak into the atmosphere, cause fire and toxic release in worst case.	1.PDSH-3692 high d/p alarm for X-3005A/B clogging. 2.PDSL-3693 inhibit to compressor(s) pressurization. 3.FAL-3636A/B low flow alarm. 4.H2 and CO gas detector in the field. 5.PSHH-3660A/B/C and 3661A/B/C high high pressure trip with vent of the compressors. 6. FCV-3636 is fail-open type. 7.Redundant control loop of FIC-3636A/B.	4	2	2	N	

Serial #	Deviation	Cause	Consequence	Safeguard	Severity	Likelihood	Risk	LOPA	Recommendation
. 53	low pressure(C-3002 N2 isolation gas)	1 1.N2 supply failure. 2.X-3003A/B clogging. 3.PCV-3653 failure. 4.Manual valve in the N2 inlet abnormally closed.	1.Oil contamination to the dry gas seal, potentially dry gas seal to the bearings. 2. Process gas leak into the atmosphere, cause fire and toxic release in worst case.	1.PDSH-3652 high d/p alarm for X-3003A/B clogging. 2.PT-3676A/B/C(2oo3) low low pressure trip with vent. 3.PT-3677A/B/C(2oo3) low low pressure trip with vent. 4.PT-3655A/B/C low pressure alarm and inhibit the lube oil pump to start, low low pressure trip for oil contamination. 5.H2 and CO gas detector in the field.	4	2	2	N	
. 54	high pressure in the N2 line	1 1.Failure of primary dry gas seal.	1.Overpressure of N2 line, potentially contamination of N2 source.	1.PSV-3659 2.Check valves downstream FO-3654A/B.	3	3	2	N	
. 55	low temperature of seal gas(C-3001)	1 1.Condensation of seal gas due to the low temperature below the dew point during the SOP condition.	1.Potentially damage dry gas seal.	1.E-3021A/B/C, two operation and one stand by.	3	2	1	N	
. 56	low temperature of seal gas(C-3002)	1 1.Condensation of seal gas due to the low temperature below the dew point during the SOP condition.	1.Potentially damage dry gas seal.	1.E-3022A/B/C, two operation and one stand by.	3	2	1	N	
. 57	high vibration	1 1.Discuss in other deviation.						N	

Serial #	Deviation	Cause	Consequence	Safeguard	Severity	Likelihood	Risk	LOPA	Recommendation
. 58	axial displacement	1 1.Compressor surge. 2. Wear of thrust bearing.	1.High axial displacement. 2.Vibration.	1.ZT-3552A/B, ZT-3520A/B, ZT-3553A/B high axial displacement alarms and high high axial displacement trip. 2.XT-3555X/Y , XT-3556X/Y high vibration alarms and high high vibration trip on C-3001 shaft. 3.XT-3520X/Y , XT-3521X/Y high vibration alarms and high high vibration trip on FT-3001 shaft. 4.XT-3557X/Y , XT-3558X/Y high vibration alarms and high high vibration trip on C-3002 shaft.	3	3	2	N	
. 59	power failure	1 Cause form DMPC (loss of AC 400V and 230V).	1.Loss of turbine and compressor control. 2.Main lube Oil pump and condensate pump motors, heaters stop. 3.Turbine trip. 4.Refer to low flow of lube oil.	1.UPS and EDG feed UCP and emergency pump.	4	2	2	N	
. 60	instrument air failure	1.Causes from source. 2.Rupture of IA line.	1.Loss of control. 2.Plant including compressor shut down and depressuring.	1.N2 backup.	3	3	2	N	

HAZOP analyzing record

2017/3/22

Project name : MKP methanol Project

Establish dt : 2016/8/10 Am12:00:00

Company nam Middle East Kimiaye Pars Company

Plant site :

Project no :

Risk matrix : 8X7(TCC) (imported) (imported) (imported)

Process name : Utility

Node description P-7001A/B/C (BFW pump package)

Pipe / equipment n P-7001A/B/C, FT-7001A/B

Drawing no : DGN-P&ID-DST-01

Design purpos To provide HP BFW pump driving force.(turbine operation condition: steam inlet 43 barG, 345 degree C)

Serial #	Deviation	Cause	Consequence	Safeguard	Severity	Likelihood	Risk	LOPA	Recommendation
7007 . 1	high pressure(turbine)	1 HPS from header high pressure.	Damage turbine(casing failure) and steam inlet pipe leak.	1.PV-7004 open. 2.PSV-7010/7011/7012(set pressrue:52 barG).	3	4	3	N	Add high pressure alarm and high high pressure trip at turbine inlet utilizing inlet PT to send signal to CW-Hydro PLC.
. 2	high pressure(Lube oil)	1.Oil pumps switch error cause two pumps running simultaneously. 2.Filter blocked. 3.Very low temperature.	1.Lube oil system pressure increase and cause pipe leak. 2.Damage bearings and might be damage shaft.	1.PCV-7710A/B/C adjust pressure. 2.PSV-7710A/B/C, 7720A/B/C on the outlet of oil pumps. 3.PDSH-7710A/B/C high d/p alarm for filter blocked. 4.Two filters, one run one spare.	3	4	3	N	Add high pressure alarm and automatic stop auxiliary oil pump.
. 3	low pressure(trubine)	1 HPS from header low pressure.	1.Same as 2005.4 low/no flow(BFW). 2.Increase consumption of the steam.	1.PALL-7127 low pressure alarm and low low pressure auto start P-7001C. 2.LSAL-2372(2oo3) low level trip IS-01. 3.LIA-2373 low level alarm. 4.LICA-2372 low level alarm.	4	3	3	N	
. 4	low pressure(Lube oil)	1.Oil pumps failure. 2.Filter blocked or switch operation error. 3.PCV-7710A/B fail closed. 4.Oil pipe leakage.	Turbine and HP BFW pump wear out and damage in worst case.	1.PSL-7710A/B/C low pressure switch. 2.PSLL-7710A/B/C, 7720A/B/C, 7730A/B/C(2oo3) low low pressure switch. 3.PDSH-7710A/B/C high d/p alarm for filter blockage.	3	4	3	N	1.Cancel PSL-7710A/B/C switch. 2.Use transmitter instead of all switch(PDT-7710A/B/C, PT-7710A/B/C, 7720A/B/C, 7730A/B/C and others). 3.PT-7710A/B/C, 7720A/B/C, 7730A/B/C (medium of 3) low pressure alarm and start the auxiliary oil pump, low low pressure(2oo3) to trip.

Serial #	Deviation	Cause	Consequence	Safeguard	Severity	Likelihood	Risk	LOPA	Recommendation
. 5	high temperature(Lube oil)	1 1.Cooling water failure. 2.Oil heater fail to overheating.	Loss of oil film cause shaft to wear out and damage bearings .	1.High temperature alarms and high high temperature trip on bearings. 2.TSH-7710A/B/C high temperature alarm and high high temperature switch off L.O. heater. 3.TCV-7710A/B/C adjust temeprature.	2	3	1	N	
. 6	high temperature(inlet turbine)	1 HPS from header high temperature.	Turbine overtemperature, damage turbine and steam inlet pipe leak.	Desuperheater on the steam header DS-7010A/B.	3	4	3	N	Add high temperature alarm and high high temperature trip at turbine inlet pipe.
. 7	high temperature(outlet turbine)	1 No load operation.	High temperature in exhaust of turbine.		2	4	2	N	Add TT high temperature alarm and high high temperature trip at turbine outlet pipe.
. 8	low temperature(Lube oil)	1.External low temperature. 2.Cooling water overflow.	1.Viscosity of lube oil increase and cause shaft to wear out and damage turbine and BFW pump. 2.Decrease the performance of lube oil pump and decrease the oil supply. 3.Increase d/p of the filter.	1.Lube oil heater will switch on when external low temperature. 2.PDSH-7710A/B/C d/p switch for filter.	2	4	2	N	Add low temperature alarm and auto start oil heater EH-7001A/B/C.
. 9	low level (oil tank)	1 1.Oil tank leakage. 2.Pipe leakage. 3.Drain abnormally open.	1.No oil to the bearings. 2.Damage oil pump.	1.LSL-7710A/B/C low level switch. 2.PSLL-7710A/B/C, 7720A/B/C, 7730A/B/C low low pressure switch. 3.Blind after the drain valve.	3	3	2	N	Add low level alarm and low low level trip for LSL-7710A/B/C.

Serial #	Deviation	Cause	Consequence	Safeguard	Severity	Likelihood	Risk	LOPA	Recommendation
. 10	high speed	1 1.Increase turbine speed due to human error. 2.Actuator/governor valve fail open. 3.Coupling fracture or pump no load.	Overspeed and damage turbine and HP BFW pump.	1.SE(2oo3) overspeed trip and drain control oil, close HPS trip valve. 2.Mechanical device activate spring to close HPS trip valve. 3.HS bottom to close HPS trip valve.	4	2	2	N	
. 11	low speed	1 1.Turbine running is lower than minimum allowable operating speed due to steam header low pressure 2.Governor valve fail closed. 3.Pump overload.	1.Loss power of turbine and low pressure of BFW. 2.Increase consumption of the steam. 3.Decrease oil pressure.	PALL-7127 low pressure alarm and low low pressure auto start P-7001C.	3	4	3	N	1.Add low pressure and low temperature alarm at turbine inlet utilizing inlet PT and TT to send signal to CW-Hydro PLC. 2.Add minimum allowable low continuous speed alarm.
. 12	high vibration	1 1.Turbine rotor unbalanced. 2.Oil film unstable between shaft and bearing. 3.Parts loosing. 4.Misalignment between equipments.	Damage turbine, gear box and HP BFW pump.	High vibration alarms and high high vibration trip.	4	2	2	N	
. 13	other	1 1.Axial displacement. 2.Excess force due to steam with water.	Damage thrust bearings and damage rotor.	1.High axial displacement alarm and high high trip. 2.Steam trap in each steam turbine inlet and steam piping condensate will be collected by unit X-7020.	3	3	2	N	

Serial #	Deviation	Cause	Consequence	Safeguard	Severity	Likelihood	Risk	LOPA	Recommendation
. 13	other	2						N	Due to absence of CW-Hydro representative in HAZOP meeting, some HAZOP items will be checked by Owner later. As the latest P&ID of vendor are not received in HAZOP meeting, further recommendations can be stated later. TCC should prepare the latest P&IDs of this package and send them to Owner during two weeks.

HAZOP analyzing record

2017/3/22

Project name : MKP methanol Project

Establish dt : 2016/8/10 Am12:00:00

Company nam Middle East Kimiaye Pars Company

Plant site :

Project no :

Risk matrix : 8X7(TCC) (imported) (imported) (imported)

Process name : Utility

Node description Turbine for P-0501 1/2 (CW pump)

Pipe / equipment n P-0501 1/2, FT-0501 1/2

Drawing no : DGN-P&ID-DS-01

Design purpos To provide cooling water pump driving force.(operation condition: steam inlet
43 barG, 345 degree C)

Serial #	Deviation	Cause	Consequence	Safeguard	Severity	Likelihood	Risk	LOPA	Recommendation
7008 . 1	high pressure(turbine)	1 HPS from header high pressure.	Damage turbine(casing failure) and steam inlet pipe leak.	1.PV-7004 open. 2.PSV-7010/7011/7012(set pressrue:52 barG).	3	4	3	N	Add high pressure alarm and high high pressure trip at turbine inlet utilizing inlet PT to send signal to CW-Hydro PLC.
. 2	high pressure(Lube oil)	1.Oil pumps switch error cause two pumps running simultaneously. 2.Filter blocked. 3.Very low temperature.	1.Lube oil system pressure increase and cause pipe leak. 2.Damage bearings and might be damage shaft.	1.PCV-0541 1/2 adjust pressure. 2.PSV-0541 1/2, PSV-0542 1/2 on the outlet of oil pumps. 3.PDSH-0541 1/2 high d/p alarm for filter blocked. 4.Two filters, one run one spare.	3	4	3	N	Add high pressure alarm and automatic stop auxiliary oil pump.
. 3	low pressure(trubine)	1 HPS from header low pressure.	1.Plant shutdown. 2.Shortage of CW in consumers, lead to high temperature and finally failure of cooling in CW exchanger. 3.Increase consumption of the steam.	1.PIA-0514 low pressure alarm at P-0501 1/2, P-0502A/B outlet. 2.FIA-0514 flow indicator. 3.FIA-0511 flow indicator. 4.CW pumps 3 operate 1 spare(two pumps running with steam turbine and one with electrical driven, so in this case only one pump will be in the service up to another electrical driven pump come in the service and the plant maybe face to the shutdown).	4	3	3	N	Add low pressure alarm at turbine inlet utilizing inlet PT to send signal to CW-Hydro PLC.

Serial #	Deviation	Cause	Consequence	Safeguard	Severity	Likelihood	Risk	LOPA	Recommendation
. 4	low pressure(Lube oil)	1 1.Oil pumps failure. 2.Filter blocked or switch operation error. 3.PCV-0541 1/2 fail closed. 4.Oil pipe leakage.	Turbine and HP BFW pump wear out and damage in worst case.	1.PSL-0541 1/2 low pressure switch. 2.PSLL-0541 1/2, 0542 1/2, 0543 1/2(2oo3) low low pressure switch. 3.PDSH-0541 1/2 high d/p alarm for filter blockage.	3	4	3	N	1.Cancel PSL-0541 1/2 switch. 2.Use transmitter instead of all switch(PDT-0541 1/2, PSLL-0541 1/2, 0542 1/2, 0543 1/2 and others). 3.PT-0541 1/2, 0542 1/2, 0543 1/2 (medium of 3) low pressure alarm and start the auxiliary oil pump, low low pressure(2oo3) to trip.
. 5	high temperature(Lube oil)	1 1.Cooling water failure. 2.Oil heater fail to overheating.	Loss of oil film cause shaft to wear out and damage bearings .	1.High temperature alarms and high high temperature trip on bearings. 2.TSH-0541 1/2 high temperature alarm and high high temperature switch off L.O. heater. 3.TCV-0541 1/2 adjust temeprature.	2	3	1	N	
. 6	high temperature(inlet turbine)	1 HPS from header high temperature.	Turbine overtemperature, damage turbine and steam inlet pipe leak.	Desuperheater on the steam header DS-7010A/B.	3	4	3	N	Add high temperature alarm and high high temperature trip at turbine inlet pipe.
. 7	high temperature(outlet turbine)	1 No load operation.	High temperature in exhaust of turbine.		2	4	2	N	Add TT high temperature alarm and high high temperature trip at turbine outlet pipe.
. 8	low temperature(Lube oil)	1 1.External low temperature. 2.Cooling water overflow.	1.Viscosity of lube oil increase and cause shaft to wear out and damage turbine and CW pump. 2.Decrease the performance of lube oil pump and decrease the oil supply. 3.Increase d/p of the filter.	1.Lube oil heater will switch on when external low temperature. 2.PDSH-0541 1/2 d/p switch for filter.	2	4	2	N	Add low temperature alarm and auto start oil heater EH-0501 1/2.

Serial #	Deviation	Cause	Consequence	Safeguard	Severity	Likelihood	Risk	LOPA	Recommendation
. 9	low level (oil tank)	1 1.Oil tank leakage. 2.Pipe leakage. 3.Drain abnormally open.	1.No oil to the bearings. 2.Damage oil pump.	1.LSL-0541 1/2 low level switch. 2.PSLL-0541 1/2, 0542 1/2, 0543 1/2 low low pressure switch. 3.Blind after the drain valve.	3	3	2	N	Add low level alarm and low low level trip for LSL-0541 1/2 .
. 10	high speed	1 1.Increase turbine speed due to human error. 2.Actuator/governor valve fail open. 3.Coupling fracture or pump no load.	Overspeed and damage turbine and CW pump.	1.SE-0541 1/2, SE-0542 1/2, SE-0543 1/2 (2oo3) overspeed trip and drain control oil, close HPS trip valve. 2.Mechanical device activate spring to close HPS trip valve. 3.HS bottom to close HPS trip valve.	4	2	2	N	
. 11	low speed	1 1.Turbine running is lower than minimum allowable operating speed due to steam header low pressure 2.Governor valve fail closed. 3.Pump overload.	1.Loss power of turbine and low pressure of CW. 2.Increase consumption of the steam. 3.Decrease oil pressure.	Start standby pump.	3	4	3	N	1.Add low pressure and low temperature alarm at turbine inlet utilizing inlet PT and TT to send signal to CW-Hydro PLC. 2.Add minimum allowable low continuous speed alarm.
. 12	high vibration	1 1.Turbine rotor unbalanced. 2.Oil film unstable between shaft and bearing. 3.Parts loosing. 4.Misalignment between equipments.	Damage turbine, gear box and CW pump.	High vibration alarms and high high vibration trip.	4	2	2	N	

Serial #	Deviation	Cause	Consequence	Safeguard	Severity	Likelihood	Risk	LOPA	Recommendation
. 13	other	1 1.Axial displacement. 2.Excess force due to steam with water.	Damage thrust bearings and damage rotor.	1.High axial displacement alarm and high trip. 2.Steam trap in each steam turbine inlet and steam piping condensate will be collected by unit X-7020.	3	3	2	N	
		2						N	Due to absence of CW-Hydro representative in HAZOP meeting, some HAZOP items will be checked by Owner later. As the latest P&ID of vendor are not received in HAZOP meeting, further recommendations can be stated later. TCC should prepare the latest P&IDs of this package and send them to Owner during two weeks.

HAZOP analyzing record

2017/2/28

Project name : MKP Methanol Project

Establish dt : 2016/8/10 Am12:00:00

Company nam Middle East Kimiaye Pars Company

Plant site :

Project no :

Risk matrix : 8X7(TCC) (imported) (imported)

Process name : Utility

Node description Flare system

Pipe / equipment n D-8511, P-8511, D-8501, E-8501, FL-8501, FL-8502, FL-8503, D-8502,
X-8501, PIL-8501A~D.

Drawing no : MKP-11-DE-8500-PR-PID-001~005.

Design purpos Tail gas treatment.

Serial #	Deviation	Cause	Consequence	Safeguard	Severity	Likelihood	Risk	LOPA	Recommendation
7009 . 1	no flow(flare gas)	1 Same as 7009.10 vacuum.						N	
. 2	high level(D-8511)	1 1.Flare gas high flow and/or flare gas containing liquid too much. 2.Failure of LT-8511.	D-8511 overfill, cause explosion in worst case.	LIA-8511A high level alarm and high high level activate I-8511A to start P-8511 to remove liquid to TK-5003.	5	2	3	Y	Add another level transmitter of D-8511 with high level alarm.
. 3	low/no level(D-8511)	1 No significant issue identified.						N	
. 4	high level(D-8501)	1 Overflow of flare gas or content too much liquid.	D-8501 overfill, cause explosion in worst case.	LIAS-8502 high level alarm and high high level to start electric heater E-8501.	5	2	3	N	
. 5	low/no level(D-8501)	1 No significant issue identified.						N	
. 6	high pressure(flare gas)	1 1.Molecular seal FL-8503 blockage. 2.D-8511 overfill.	Flare system overprssure.	1.PIA-8514 high pressure alarm. 2.PIAS-8524A/B high pressure alarm.	4	3	3	N	
. 7	high pressure(D-8502)	1 PT/PIC/PV-8529 fail open.	D-8502 overpressure.	D-8502 have a PSV.	4	4	4	Y	PG-8541 change to PT-8541 and send a signal to PLC and add high pressure alarm.
. 8	low pressure(D-8502)	1 1.PSV of D-8502 open prematurely or leak. 2.PT/PIC/PV-8529 fail closed.	Pilot gas supply failure.	PIA-8527 low pressure alarm.	3	4	3	N	PG-8541 change to PT-8541 and send a signal to PLC and add low pressure alarm.
. 9	low pressure(flare gas)	1 No significant issue identified.						N	

Serial #	Deviation	Cause	Consequence	Safeguard	Severity	Likelihood	Risk	LOPA	Recommendation
. 10	vacuum(flare gas)	1 1.No flaring. 2.Flare gas condensation cause vacuum.	Back pressure, air to flare system.	1.N2 supply (FO-8501~8505) keep pressure in flare header . 2.PT/PIC/PV-8516 open. 3.PIA-8514 low pressure alarm. 4.PIAS-8524A/B low pressure alarm and low low pressure to activate I-8523 to open UV-8523 to make up fuel gas.	3	3	2	N	
. 11	high temperature(flare gas)	1 Low pressure cause flame in flare tips.	Back fire.	1.TIAS-8544 high temperature alarm. 2.TIAS/TV-8544 open. 3.TIAS-8541 high temperature alarm activate TV-8541 to open HPS.	4	3	3	Y	Vendor to advise: TIAS/TV-8544 as a safeguard.
. 12	low temperature(flare gas)	1 No significant issue identified.						N	
. 13	others	1 Ignition system failure.	No ignition function if pilot need to be ignited.					N	HAZOP study should be done by vendor for flare gas system package, the owner will check flare package after receiving vendor data.

HAZOP analyzing record

2017/2/28

Project name : MKP Methanol Project

Establish dt : 2016/8/10 Am12:00:00

Company nam Middle East Kimiaye Pars Company

Plant site :

Project no :

Risk matrix : 8X7(TCC) (imported) (imported)

Process name : Utility

Node description POC

Pipe / equipment n PD-9401, PD-9402, PD-9403, PD-9404, PD-9406, PD-9407, PD-9408,
PD-9409, PD-9410, PD-9411, P-9401A/B, P-9402A/B,
P-9403A/B, P-9404A/B, P-9408A/B, P-9409A/B, P-9411.

Drawing no : MKP-11-DE-9400-PR-PID-002

Design purpos

Serial #	Deviation	Cause	Consequence	Safeguard	Severity	Likelihood	Risk	LOPA	Recommendation
7010 . 1	high level(PD-9401/9402/9403/9404 for submerged pump)	1 Overflow blocked.	1.Flooding.	1.LT/LIA-9401/9402/9403/9404 High level alarm,manually start pump P-9401//9402/9403/9404A/B.	2	4	2	N	
. 2	low level(PD-9401/9402/9403/9404 for submerged pump)	1 non actual hazard identify						N	
. 3	high level(PD-9409/9410 for submerged pump)	1. Too much liquid from upstream. 2. Discharge of pump abnormally close.	1.Flooding.	1.LT/LIA-9409/9410 High level alarm,automatically start pump P-9409//9410A/B.	2	4	2	N	
. 4	low level(PD-9409/9410 for submerged pump)	1 non actual hazard identify						N	
. 5	high level(PD-9411 for submerged pump)	1. Too much liquid from upstream. 2. Discharge of pump abnormally close.	1.Flooding	1.LT/LIA-9411 High level alarm,manually start pump P-9411.	2	4	2	N	
. 6	low level(PD-9411 for submerged pump)	1 non actual hazard identify						N	
. 7	high level(PD-9408 for centrifugal pump)	1. Too much liquid from upstream. 2. Discharge of pump abnormally close.	Flooding	1.LT/LIA-9408 high level alarm,manually start pump P-9408A/B.	2	4	2	N	
. 8	low level(PD-9408 for centrifugal pump)	1 non actual hazard identify						N	

Serial #	Deviation	Cause	Consequence	Safeguard	Severity	Likelihood	Risk	LOPA	Recommendation
. 9	high level(PD-9406/9407 for portable pump)	1 1.Too much liquid from upstream. 2.Discharge of pump abnormally close.	Flooding	1.LT/LIA-9406/9407 high level alarm,manually start portable pump.	2	4	2	N	1.Add plant air connection for portable pumps.
. 10	low level(PD-9406/9407 for portable pump)	1 non actual hazard identify						N	
. 11	As well as flow(PD-9408)	1 1.High/low pH.	1.Pollution. 2.Water isn't accepted by DMPC.	1.AI-9402 pH indicator. 2.AI-9401 pH gauge on site.	3	4	3	N	
. 12	low pressure of discharge pump(PD-9411)	1 1.P-9411 broken.	1.Flooding.	1.LT/LIA-9411 high alarm.	2	4	2	N	
. 13	other	1						N	1.Consider curb with anti-acid brick for H ₂ SO ₄ solution tank and NaOH solution tank.

HAZOP analyzing record

2017/2/27

Project name : MKP Methanol Project

Establish dt : 2016/8/10 Am12:00:00

Company nam Middle East Kimiaye Pars Company

Plant site :

Project no :

Risk matrix : 8X7(TCC) (imported) (imported)

Process name : Polishing Unit

Node description Polishing Unit

Pipe / equipment n TK-7001 1/2, P-7002A/B, P-7204A/B, TK-7202/7204, P-7202/7203,
J-7201/7202, D-7205, PD-7206, P-7205A/B, TK-7201, P-7201A/B,
R-7201A/B, X-7201, E-7201A/B

Drawing no : 7200-PID-001~005

Design purpos cooling water circulating, CW supply 38 degree C, CW return 48 degree C, Cl-
less than 65 mg/L.

Serial #	Deviation	Cause	Consequence	Safeguard	Severity	Likelihood	Risk	LOPA	Recommendation
7201 . 1	High flow(DMW inlet)	1 1.DMW from BL high flow. 2.FV-7202 fail. 3.FV-7202 bypass valve abnormally open due to human error .	1.TK-7201 high level and flood. 2.High consumption of DMW.	1.LT/LIA-7201 high level alarm. 2.Overflow line.	3	3	2	N	
. 2	High flow(DMW outlet)	1 1.P-7201 A/B standby pump abnormally start. 2.FV-7091 fail open.	1.TK-7001 1/2 low level and P-7002 A/B damage. 2.D-7001 high level. Refer to node 7004 high level(D-7001). 3.DMW to deaerator temperature decrease and low deaerator efficiency.	1.LT-7202A/B low level alarm, low low level alarm and stop the P-7002A/B. 2.FIC-7091 high flow alarm. 3.FI-7205 flow indicator. 4.TV-2457 and TE-2457 control the temperature.	3	3	2	N	
. 3	High flow(condensate inlet)	1 1.High flow in upstream.	1.X-7201A/B and X-7204 high d/p and running period decrease. 2.High temperature of X-7201A/B and X-7204. 3.TK-7201 high level.	1.PDIA-7210/7211A/B high d/p alarm. 2.LIA-7201 high level alarm. 3.Overflow line TK-7201. 4.LICA-7202 A/B high level alarm. 5.FV-7202.	3	3	2	N	1.Add a temperature transmitter and send the signal to control room, set high alarm in the 8"-TC-72-201-B50-N inlet line of X-7201A/B and X-7204.
. 4	High flow(R-7201A/B inlet)	1 1.P-7201 A/B standby pump abnormally start.	1.Overflow of R-7201A/B.	1.FT-7203A/B. 2.PDT-7207/8 high alarm.	3	3	2	N	
. 5	low/no flow(DMW inlet)	1 1.Low/no flow in upstream. 2.FV-7202 fail closed.	1.TK-7201 low level and P-7201A/B cavitation and damage.	1.FT/FIQ-7204 alarm. 2.LICA-7201 low level alarm. 3.LALL-7201 activate I-721 to trip P-7201A/B.	4	3	3	N	1.Change FIQ-7204 to FI-7204.

Serial #	Deviation	Cause	Consequence	Safeguard	Severity	Likelihood	Risk	LO PA	Recommendation
. 6	low/no flow(DMW outlet)	1 1.P-7002 A/B failure. 2.P-7002 outlet manual valve abnormally closed due to operator error. 3.FT/FIC/FV-7091 fail closed. 4.TK-7001 1/2 outlet manual valve abnormally closed due to operator error. 5.ARV in the discharge of pump fail and return maximum possible flow back to TK-7001 1/2.	1.TK-7001 A/B high level and flood. 2.Refer to node 7004 low flow(DMW). 3.Low/no flow of BFW in downstream especially steam drum. 4.P-7002 A/B cavitation and damage.(in the case of cause 4)	1.P-7002 A/B 1 operate 1 spare. 2.FI-7205 flow indicator. 3.LICA-7202 A/B high level alarm. 4.Refer to node 7004 low flow(DMW).	3	3	2	N	1.Add low alarm for FT-7205.
. 7	low/no flow(condensate inlet)	1 1.Low/no flow in upstream,C-3001/2 FT-3001 shutdown. 2.Human error in closing manual valve. 3.X-7201A/B and X-7204 blocked. 4.E-7201 A/B blocked.	1.TK-7201 low level and P-7201 A/B cavitation and damage.	1.FI-7201 flow indicator. 2.LIA-7201 low level alarm. 3.LALL-7201 activate I-721 to trip P-7201A/B. 4.X-7201 standby. 5.E-7201 A/B, 1 operate 1 spare. 6.PT-7203/7202 low alarm. 7.PDT-7210/11A/B high d/p alarm.	3	3	2	N	1.Add low alarm for FI-7201. 2. Add FI and low alarm for FI-7204 (DMW from B.L)
. 8	low flow (R-7201A/B inlet)	1 1.P-7201A/B failure. 2. Manual valve abnormally close.	1.TK-7001 1/2 low level.	1.LT-7202A/B low level alarm. 2.FT-7203A/B indicator. 3.Auto start P-7201A/B by PT-7209.	2	4	2	N	1.Add low alarm for FT-7203A/B.

Serial #	Deviation	Cause	Consequence	Safeguard	Severity	Likeli hoo	Risk	LO PA	Recommendation
. 9	reverse flow(DMW)	1 1.Low pressure of DMW from B.L. 2. High pressure of TC.	1.Loss of condensate. 2.Low level TK-7201. 3.Pollution of DMW to B.L.	None	2	4	2	N	1.Add check valve on 8"-DMW-70-108-B50-N of 7000-PID-020.
. 10	reverse flow(condensate)	1 1.Low pressure/failure of TC from P-3011A/B. 2.High pressure of DMW.	1.Loss of DMW. 2.Low level TK-7201.	1.PSL-3584 on C-3001 Package.	2	4	2	N	1.Add check valve on 8"-TC-72-201-B50-N. 2.P-3011A/B should be considered as auto start(should be confirmed with GE).
. 11	as well as flow/impurity	1 1.R-7201A/B low efficiency. 2.Impurity in upstream(DMPC). 3.Failure of turbine surface exchanger lead to impurities in condensates. 4.Impurity in chemicals NaOH and H ₂ SO ₄ .	1.Fe2+ and SiO ₂ carry over to downstream and affect steam quality and damage turbine. 2.High demand to blowdown in deaerator and steam drum. 3.Incorrect pH in downstream and corrosion.	1.R-7201 A/B ,1 operate 1 spare. 2.AI-7203 high SiO ₂ alarm. 3.AI-7204A/B high conductivity alarm. 4.AAHH-7203,AAHH-7204A/B activate I-727A/B to regeneration. 5.AIA-7211A/B high/low pH alarm.	3	4	3	N	Supply chemical from well known vendor, with high quality and test before use in plant.
. 12	high pressure(condensate)	1 1.X-7201A/B,X-7204 blockage. 2.Human error in operating both P-3011A/B at the same time.	1.Overpressure damage equipment and pipe.	1.PT-7202 indicator. 2.PSV-7206A/B and PSV-7205 @9bar.	3	3	2	N	1.Add alarm high for PT-7202. 2. Correct setpoint of PSV-7205 and PSV-7206A/B to 10 barg.
. 13	high pressure(DMW)	1 1.X-7201A/B,X-7204 blockage. 2.High pressure in upstream.	1.Overpressure damage equipment and pipe. 2.Back pressure to P-3011A/B.	1.PT-7203 indicator. 2.PSV-7206A/B and PSV-7205 @9bar. 3.Check valve on discharge of P-3011A/B.	3	3	2	N	1.Add alarm high for PT-7203. 2.Correct setpoint of PSV-7205 and PSV-7206A/B to 10 barg.

Serial #	Deviation	Cause	Consequence	Safeguard	Severity	Likelihood	Risk	LOPA	Recommendation
. 14	high pressure(R-7201A/B)	1 1.R-7201A/B blocked; 2.XV-7209A/B abnormally closed. 3. P-7201A/B start at the same time.	1.Damage of R-7201A/B. 2.Low Mixed bed efficiency.	1.PSV-7203A/B @6bar. 2.PT-7207A/B indicator.	3	4	3	N	1.Add alarm high for PT-7207A/B. 2. Correct setpoint of PSV-7203A/B to 7 barg.
. 15	high pressure(DMW to user)	1 1.P-7002A/B start at the same time. 2.Closed failure of FV-7091.	1.High pressure of E-2025 shell side.	1.PSV-2458 @14 barg.	2	3	1	N	1.Correct design pressure of discharge line from P-7002A/B to 14 barg.
. 16	low pressure(Condensate)	1 1.Low pressure due to P-3011A/B failure.	1.Low level of TK-7201.	1.PT/PIA-7202 low pressure alarm. 2.PT/PAL-3584 low pressure alarm.	3	2	1	N	
. 17	low pressure(DMW)	1 1.Low pressure in B.L.	1.Low level of TK-7201.	1.PT/PIA-7203 low pressure alarm.	3	2	1	N	
. 18	low pressure(R-7201A/B)	1 1.P-7201A/B failure.	1.Low level of TK-7001 1/2.	1.PT/PIA-7209 low alarm and low low auto start standby pump.	3	3	2	N	
. 19	low pressure(DMW to user)	1 1.P-7002A/B failure.	1.DMW supply failure.	1.PT/PIA-7204 low pressure alarm and low low auto start standby pump.	3	3	2	N	
. 20	vacuum	1 Not possible.						N	
. 21	high temperature	1 1.CW failure. 2.High temperature from upstream. 3.TE/TT/TIC/TV-7201 fail closed.	1.Process condensate temperature increased and resin failure. 2.Fe2+ and SiO2 carry over to downstream and affect steam quality and damage turbine. 3.Damage pump due to low NPSHa.	1.FI-7202 flow indicator. 2.AI-7203 high SiO2 alarm. 3.AI-7204A/B high conductivity alarm. 4.AAHH-7203,AAHH-7204A/B activate I-727A/B to regeneration.	4	3	3	N	

Serial #	Deviation	Cause	Consequence	Safeguard	Severity	Likeli hoo	Risk	LO PA	Recommendation
. 22	low temperature	1 non actual hazard identify						N	
. 23	concentration of H ₂ SO ₄ and NaOH	1. Failure of H ₂ SO ₄ injection system. 2. Failure of NaOH injection system. 3. High or low concentration in upstream. 4. Low quality of raw chemical material. 5. Low flow rate of DMW for preparing solution.	1. Low quality and high impurity of final DMW product. 2. Incomplete resin regeneration(in case of low concentration), or high temperature inside ion exchanger(in case of high concentration). 3. Need for more blowdown in downstream. 4. More clean salty water.	1.AAHH-7203 high high SiO ₂ concentration alarm activate I-727A/B to regeneration. 2.AIA-7206 high conductivity alarm. 3.AIA-7207 pH indicator. 4.AT/AI-7208 H ₂ SO ₄ indicator. 5.AT/AI-7209 NaOH indicator.	3	3	2	N	1.Add high alarm for AT/AI-7208. 2.Add high alarm for AT/AI-7209.
. 24	high level(TK-7201)	1. XV-7201A/B failure. 2.XV-7209A/B failure. 3.P-7201A/B failure. 4.High flow in upstream.	1.TK-7201 overflow.	1.LIAH-7201 high level alarm. 2.Overflow line.	3	2	1	N	
. 25	high level(TK-7001 1/2)	1. Blockage of outlet. 2.P-7002A/B failure. 3.High flow in upstream.	1.TK-7001 1/2 high level and flood. 2.High consumption of DMW.	1.LICA-7202A/B high level alarm. 2.Overflow line.	3	2	1	N	
. 26	high level(PD-7206)	1.XV-7207~7210 A/B fail open after regeneration.	PD-7206 high level and may flood since liquid content is acid or base so environmental pollution or injury personnel is possible.	1.LIA-7205 high level alarm. 2.The pond is located in a curb.	3	4	3	N	

Serial #	Deviation	Cause	Consequence	Safeguard	Severity	Likelihood	Risk	LOPA	Recommendation
. 27	low/no level(TK-7201)	1 1.Low/no flow in upstream. 2.Human error in opening drain valve.	1.pump damage. 2.Low/no flow in downstream. 3.Loss of condensate.	1.LALL-7201 low low level activate I-721 trip P-7201A/B. 2.FI-7204 flow indicator.	3	3	2	N	
. 28	low/no level(TK-7001 1/2)	1 1.Low/no flow in upstream. 2.Human error in opening drain valve.	1.Pump damage. 2.Low/no flow in downstream, perhaps low/no of BFW.	1.LALL-7202A/B low low level activate I-723 to trip P-7002A/B, P-7204A/B. 2.FI-7205 flow indicator.	3	3	2	N	
. 29	low/no level(PD-7206)	1 Emptying the pond by manual turning on the pump.	1.Pump damage.	1.LIA-7205 low level alarm. 2.LALL-7205 low low level activate I-726 trip P-7205A/B.	2	4	2	N	
. 30	other	1						N	1.HAZOP study should be done by vendor for polishing unit package, the owner will check polishing unit package after receiving vendor data.

Attachment 3

Attendance sheet

TCC

公司

MKP

Methanol

项目

Flue gas blower and turbine Unit

(F-2001/HI-2001)

2017年2月20日 HAZOP、LOPA、SIL 分析签到表

会议提要:

序号	姓名 NAME	岗位 POSITION	专业 Discipline	手机 Mobile phone	邮箱 e-mail
1	S.H.Wang	HAZOP Leader			
2	Y.N.Ying	HAZOP Assistance			
3	Xin Taijun 辛泰军	TCC - Instrument			
4	Morteza Faghihi	MEKPCO. PROCESS Eng.			
5	Mostaba Lamie	MEKPCO PROCESS Eng.			
6	Mahmoud Nasrollahz	Eng. Manager	Eng	09122505127	
7	Wendy Xie	ITT Representative			
8	VALERIO Cicconi	IT PROJECT			
9	MARCELO DELLA COLETA	PROJECT ENGINEER	ENG		mcoleto@mgmetalc lurgica.com.br
10	Wang Furu Process	Process engineer			
11	Jr Werner	Process safety engineer			
12	Wang Haigun	TCC			
13	Gao Zhihui 高志辉	TCC. process Eng.			
14					
15					
16					
17					

TCC 公司 MKP Methanol Project
Combustion air blower and turbine (F-2002/FT-2002) Unit.

2017年2月21日 HAZOP、LOPA、SIL 分析签到表

会议提要:

序号	姓名 NAME	岗位 POSITION	专业 DISCIPLINE	手机 MOBILE PHONE	邮箱 E-MAIL
1	S.H. Wang	HAZOP Leader			shihhuang.wang@ctci.com
2	Y.N. Ying	HAZOP Assistant			Yining.ying@ctci.com
3	M. Faghihi	MEKPCO. Process Eng.			m.faghihi@mekpcoco.com
4	M. Lame	MEKPCO process			m.lame@mekpcoco.com
5	Din Yajun 秦晓军	TCC	Instrument		ea-gyj@ctcc.cn
6	Wang Haijun	TCC			
7	Ji Weiwei	TCC	PS		
8	Wang Furui	TCC	PS		
9	MARCELLO DELLA CALGHTA	NG METALLURGIA			mcoletta@gmetallurgica.com.br
10	Valerio Cicero	Process Engineer / ITT			Valerio.cicero@ittch.ch
11	Wendy Xie	ITT Representative in China			wendy.xie@188.com
12	Gao Zhibei	Deputy Big Manager			
13	Chen Tao	TCC			
14					
15					
16					
17					

TCC 公司 MKP Methanol Project
 Turbine for P-7001 (BFW pump) and
 P-0501 (cooling water pump) Unit

2017年2月22日 HAZOP、LOPA、SIL 分析签到表

会议提要: _____

序号	姓名 NAME	岗位 POSITION	专业 DISCIPLINE	手机 MOBILE PHONE	邮箱 E-MAIL
1	S.H. Wang	HAZOP Leader			shihuang.wang@ctci.com
2	Y.N. Ying	HAZOP Assistant			yining.ying@ctci.com
3	M. Lame	MEKPCO Process Eng.			M.Lame@mekpcoco.com
4	M. Faghribi	MEKPCO Process Eng.			m.faghribi@mekpcoco.com
5	许秉洪	2号			xx-xbh@ctccn.cn
6	高锐	Depay eng. major			
7	樊涛	Process			tiantao@ctccn.cn
8	Ji Weiwei	PS			
9	侯晓伟	TCC	Instrument		
10	王丽华	TCC	Mechanical		
11	孙少华	Dresser-Rand	steam turbine		sun.sy@siemens.com
12					
13					
14					
15					
16					
17					

TCC 公司 MKP Methanol 项目(Project)
 C-2002 H₂ Recycle Compressor Unit

2017年 2月 23 日 HAZOP、LOPA、SIL 分析签到表

会议提要: _____

序号	姓名 NAME	岗位 POSITION	专业 DISCIPLINE	手机 MOBILE PHONE	邮箱 E-MAIL
1	S.H. Wang	HAZOP Leader.			shihuang.wang@ctci.com
2	谢 飞 Tracy	HAZOP engineer			
3	刘松林	HAZOP Engineer			songlin.liu@ctrish.com.cn
4	清昌霞	YuanDa mech. Engineer		18640099857	ydtc@yuanndacompressor.co
5	邹乃飞	YuanDa elec. Engineer		15998109324	ydtc@yuanndacompressor.com
6	M. Lame	MEKPCO Process			m.lame@mekpcoco.com
7	M. Faghihi	MEKPCO Process			m.faghihi@mekpcoco.com
8	Gao Zhishui	Deputy Eng. manager			
9	Wang Furui	Process			
10	吉伟伟	TCC	Instrument		
11	Ji Weiwei	TCC	PS		
12					
13					
14					
15					
16					
17					

TCC

公司 MKP Methanol 项目 (Project)

C-2001 start-up nitrogen compressor Unit

2017年 2月 24日 HAZOP、LOPA、SIL 分析签到表

会议提要: _____

序号	姓名 NAME	岗位 POSITION	专业 DISCIPLINE	手机 MOBILE PHONE	邮箱 E-MAIL
1	S.H. Wang	HAZOP Leader			shihkuang.wang@ctci.com
2	Tracey Xie	HAZOP engineer			
3	刘松林	engineer			
4	M. Lane	MEKPCO Process Eng.			
5	M. Faghihi	MEKPCO Process Eng.			m.faghihi@mekpcoco.com
6	徐静	process			
7	Jianzhixin	Deputy Eng. Manager			
8	李冬洋	项目经理			yueyang.li@shenturbo.com
9	周林	Engineer			
10	张恩远	Engineer			
11					
12					
13					
14					
15					
16					
17					

TCC

公司 MEKPCO Methanol 项目 (Project)

Polishing Unit

2011年 2月 27 日 HAZOP、LOPA、SIL 分析签到表

会议提要: _____

序号	姓名 NAME	岗位 POSITION	专业	手机 MOBILE-PHONE	邮箱 E-MAIL
1	S. H. Wang	HAZOP Leader			shihhuang.wang@ctci.com
2	Gene Zhang	Engineer			ait-zhanghuixian@ctcih.com.cn
3	M. Lame	MEKPCO Process Eng.			m.lame@mekpcoco.com
4	M. Faghili	MEKPCO Process Eng.			m.faghili@mekpcoco.com
5	王磊	工程师			wanglei@cntec.cn
6	Tian Tan	Process Enginner			tiantan@cntec.cn
7	Nie Xiao	Process Eng.			niexiao@cntec.cn
8	��晓东	Assistance			
9					
10					
11					
12					
13					
14					
15					
16					
17					

TCC

公司 MEKPCO Methanol

项目 (project)

POC ponds, side filter of cooling tower Unit

2017 年 2 月 28 日 HAZOP、LOPA、SIL 分析签到表

会议提要: _____

序号	姓名 NAME	岗位 POSITION	专业	手机 MOBILE PHONE	邮箱 E-MAIL
1	S. H. Wang	HAZOP Leader			
2	Gene Zhang	Assistance			
3	M. Lane	Process MEKPCO			M. Lane
4	M. Faghghi	Process MEKPCO			m. faghghi@mekpcocom
5	Tian Tao	process Engineer			tiantao@cntrcc.cn
6	刘松林	Assistance			
7	Ji Wuwei	PS			
8	Nie Xiao	process Engineer			
9					
10					
11					
12					
13					
14					
15					
16					
17					

TCC

公司 MEKPCO Methanol 项目 (project)

Synthesis compressor package: C3001/C3002/FT3001 Unit

2017年3月1日 HAZOP、LOPA、SIL 分析签到表

会议提要:

序号	姓名 NAME	岗位 POSITION	专业	手机 MOBILE PHONE	邮箱 E-MAIL
1	S.H.Wang	HAZOP Leader			shihhuang.wang@ctci.com
2	Gene Zhang	HAZOP Assistance			
3	尹祺义	工艺工程师		18622208111	hqy@cntcc.cn
4	李晓娟	工艺			liaojxj@cntcc.cn
5	孙晓霞	工艺			
6	M.lame	MEKPCO Process			M.lame@mekpcoco.com
7	M.Faghghi	MEKPCO process Eng.			m.faghbibia@mekpcoco.com
8	Giuseppe Stella	ENGINEERING MANAGER		18918322585	giuseppe.stella@ge.com
9	Marta Conti	SYSTEM ENGINEER		3386608522	marta.medaglia@ge.com
10	Gaia Conti	PROCESS ENGINEER		+393423302466	gaia.conti@ge.com
11	Luca Conti	GE SYSTEM/CONTROL ENG			luca.conti@ge.com
12	江山	工艺		18698080527	jiang.yu@cntcc.cn
13					
14					
15					
16					
17					

TCC

公司 MEKPCO Methanol 项目 (project)

Synthesis Compressor package (3001/3002/FT300) Unit

2017年 3月 2日 HAZOP、LOPA、SIL 分析签到表

会议提要:

序号	姓名 NAME	岗位 POSITION	专业	手机 MOBILE PHONE	邮箱 E-MAIL
1	S.H. Wang	HAZOP Leader			
2	Gene Zhang	HAZOP ASSISTANCE			
3	M.lame	MEKPCO PROCESS			m.lame@mekpcocom
4	M.Faghghi	MEKPCO PROCESS			m.faghghi@mekpcocom
5	GIUSEPPE STELLA	GE ENGINEERING MANAGER		18918372585	
6	MEDAGLIONI DALETA	SYSTEM ENGINEER			medata.meda@hotmail.it
7	CONTI LUCA	SYSTEM ENGINEER			luca.conti@ge.com
8	GAIA COLETTI	PROCESS ENGINEER			gaiacoletti@ge.com
9	Qin Yajun 秦江军	TCC Instrument			en-qyj@cntcc.cn
10	许俊 Xujun	TCC process			xujun@cntcc.cn
11	李丽娟	TCC			aa-ljj@cntcc.cn
12	卢秋义	TCC			hqi@cntcc.cn
13	江颖	TCC			13819181111 jiangyu@cntcc.cn
14					
15					
16					
17					

TCC 公司 MEKPCO Methanol 项目 (Project)
 Synthesis Compressor package. C3001/C3002/FTU³⁰⁰¹


2017年3月3日 HAZOP、LOPA、SIL 分析签到表


会议提要: _____

序号	姓名 NAME	岗位 POSITION	专业	手机 MOBILE PHONE	邮箱 E-MAIL
1	S.H. Wang	HAZOP Leader			
2	Gene Zhang	HAZOP Assistance			act-Zhanghuixian@ctsl.com.cn
3	江山	TCC Process			jiangyu@ch-tcc.cn
4	许波	TCC process			
5	李伟	TCC process			wei-lv@cnstec.cn
6	M. Faghihi	MEKPCO Process			m.faghihi@mekpcocom
7	M. lame	MEKPCO Process			m.lame@mekpcocom
8	MARTA MEDAGLIONI	SYSTEM GE ENGINEER			marta.medagliioni@ge.com
9	GIOSEPPE STELLA	GE ENGINEERING MANAGER			giuseppe.stella@ge.com
10	LUCA CONTI	GE SYSTEM ENGINEER			luca.conti@ge.com
11					
12					
13					
14					
15					
16					
17					


Attachment 4

Mark-up P&ID

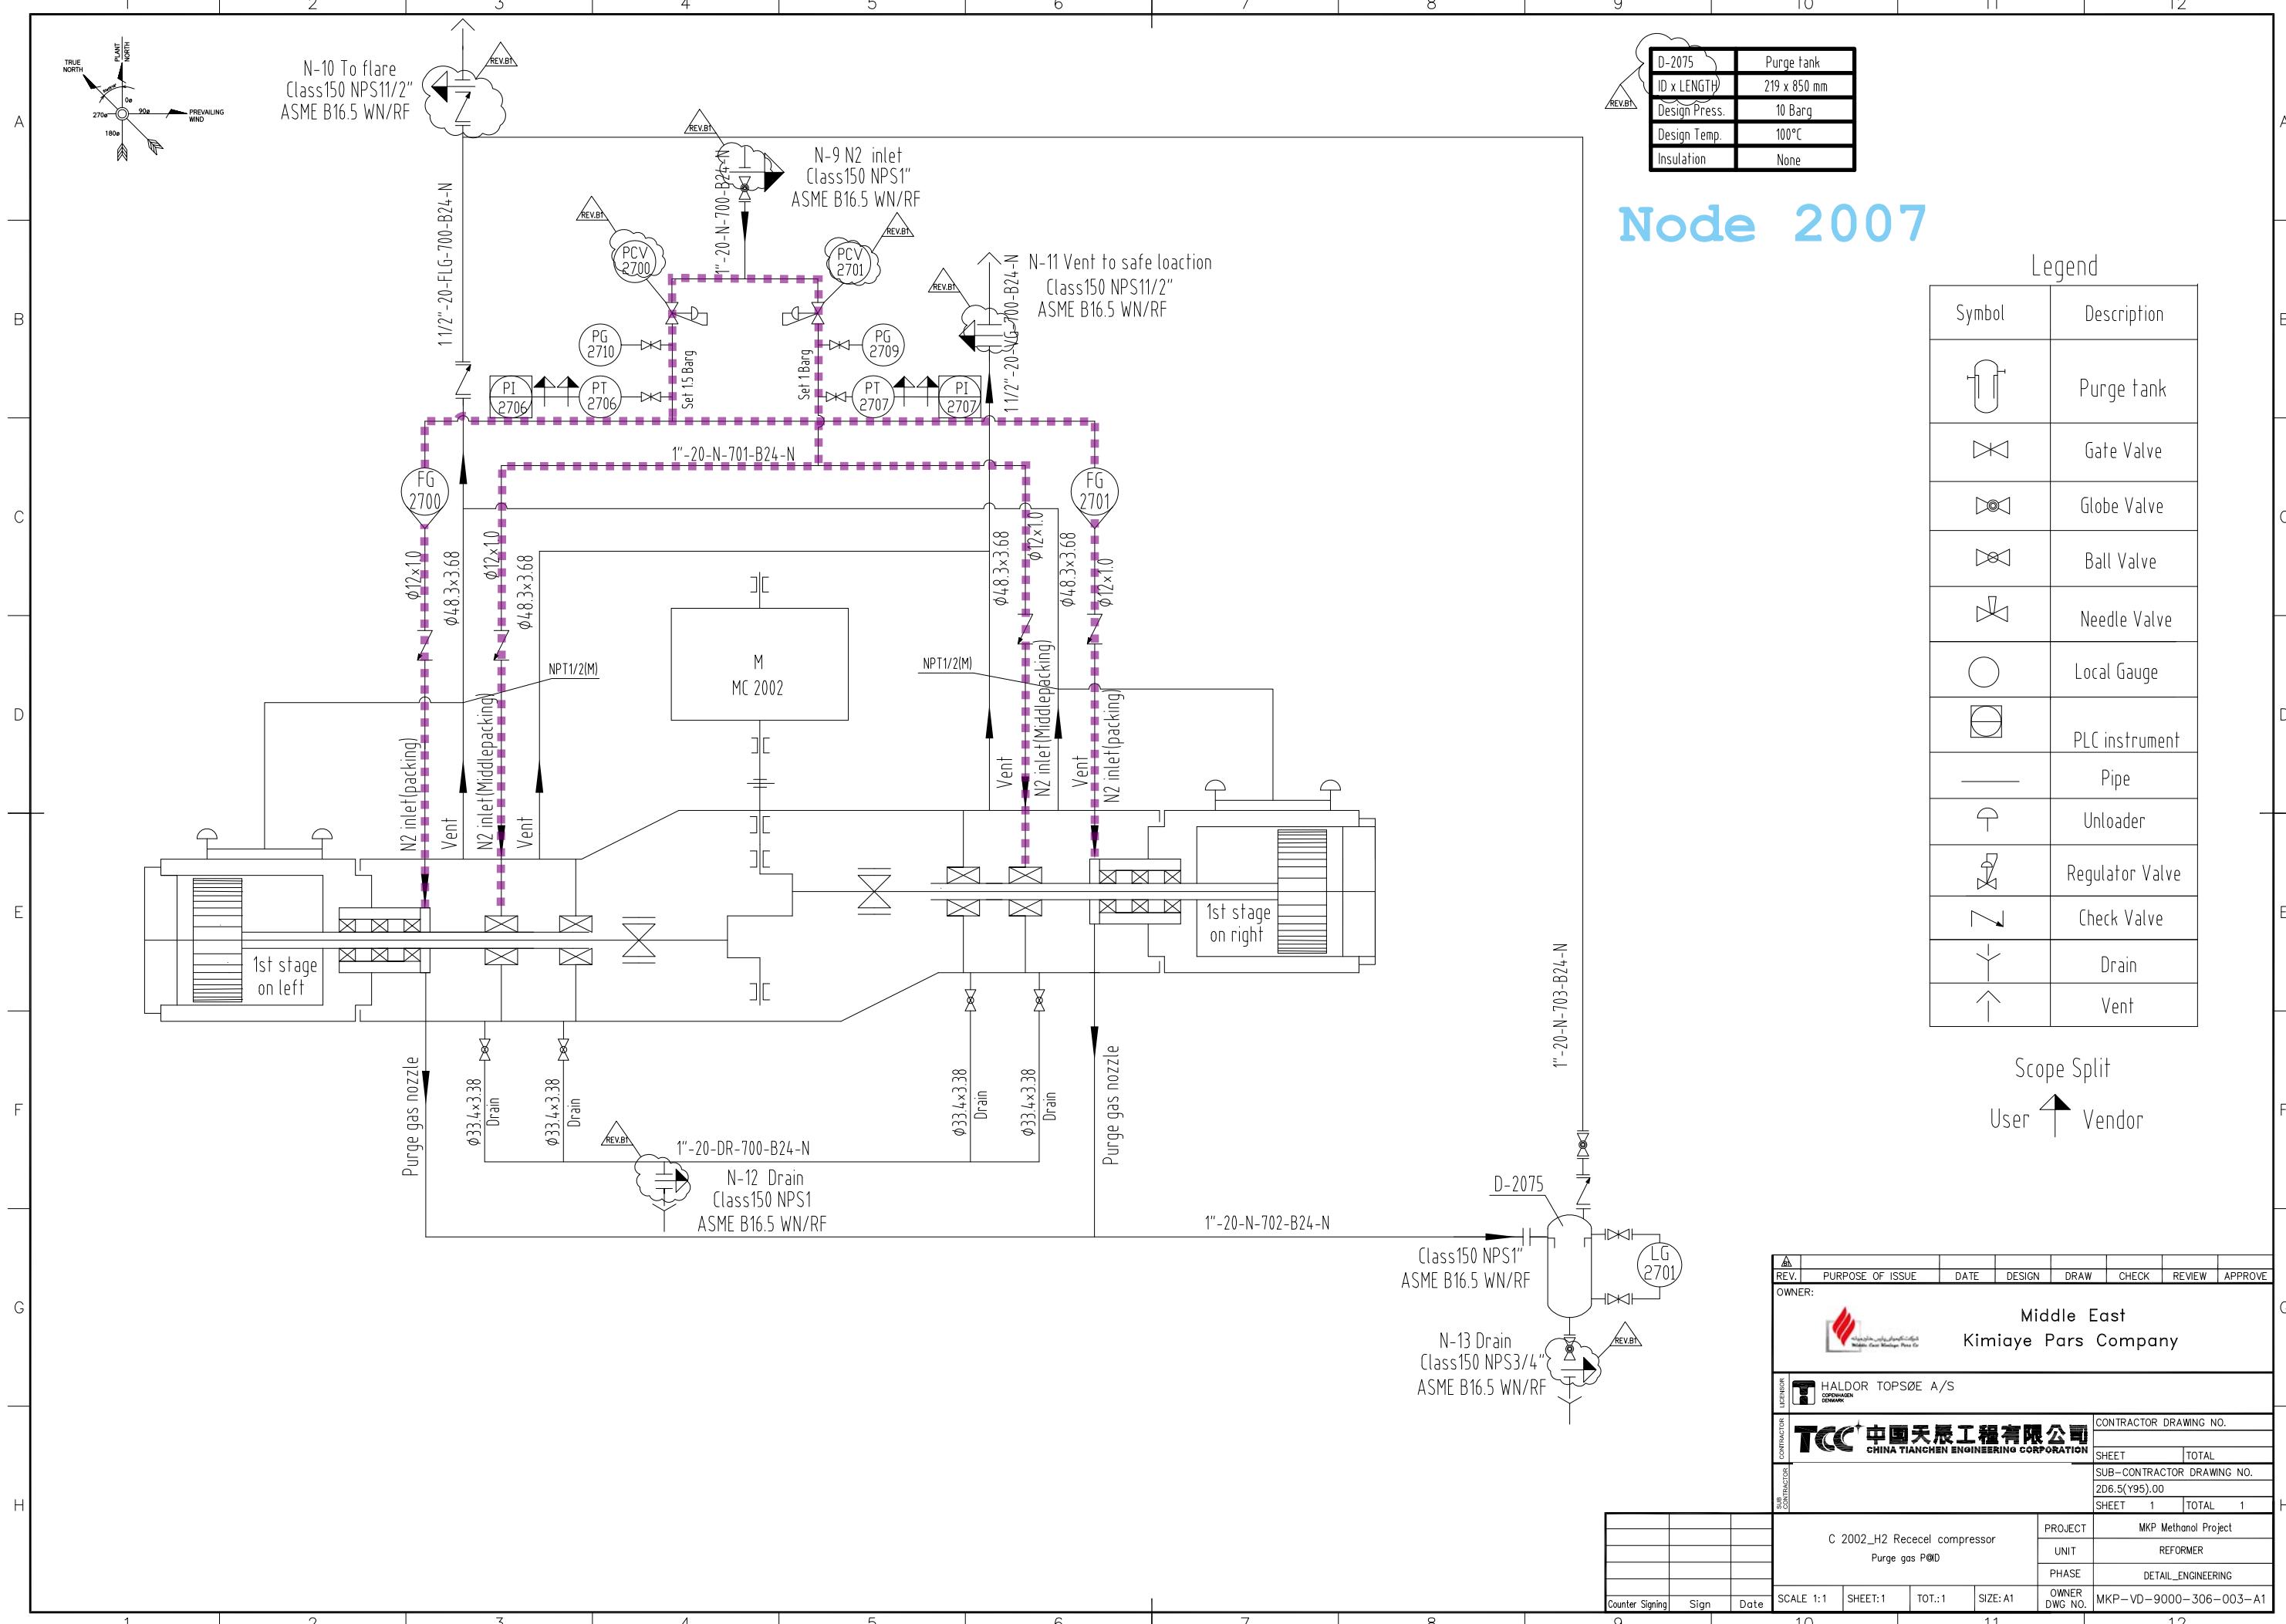

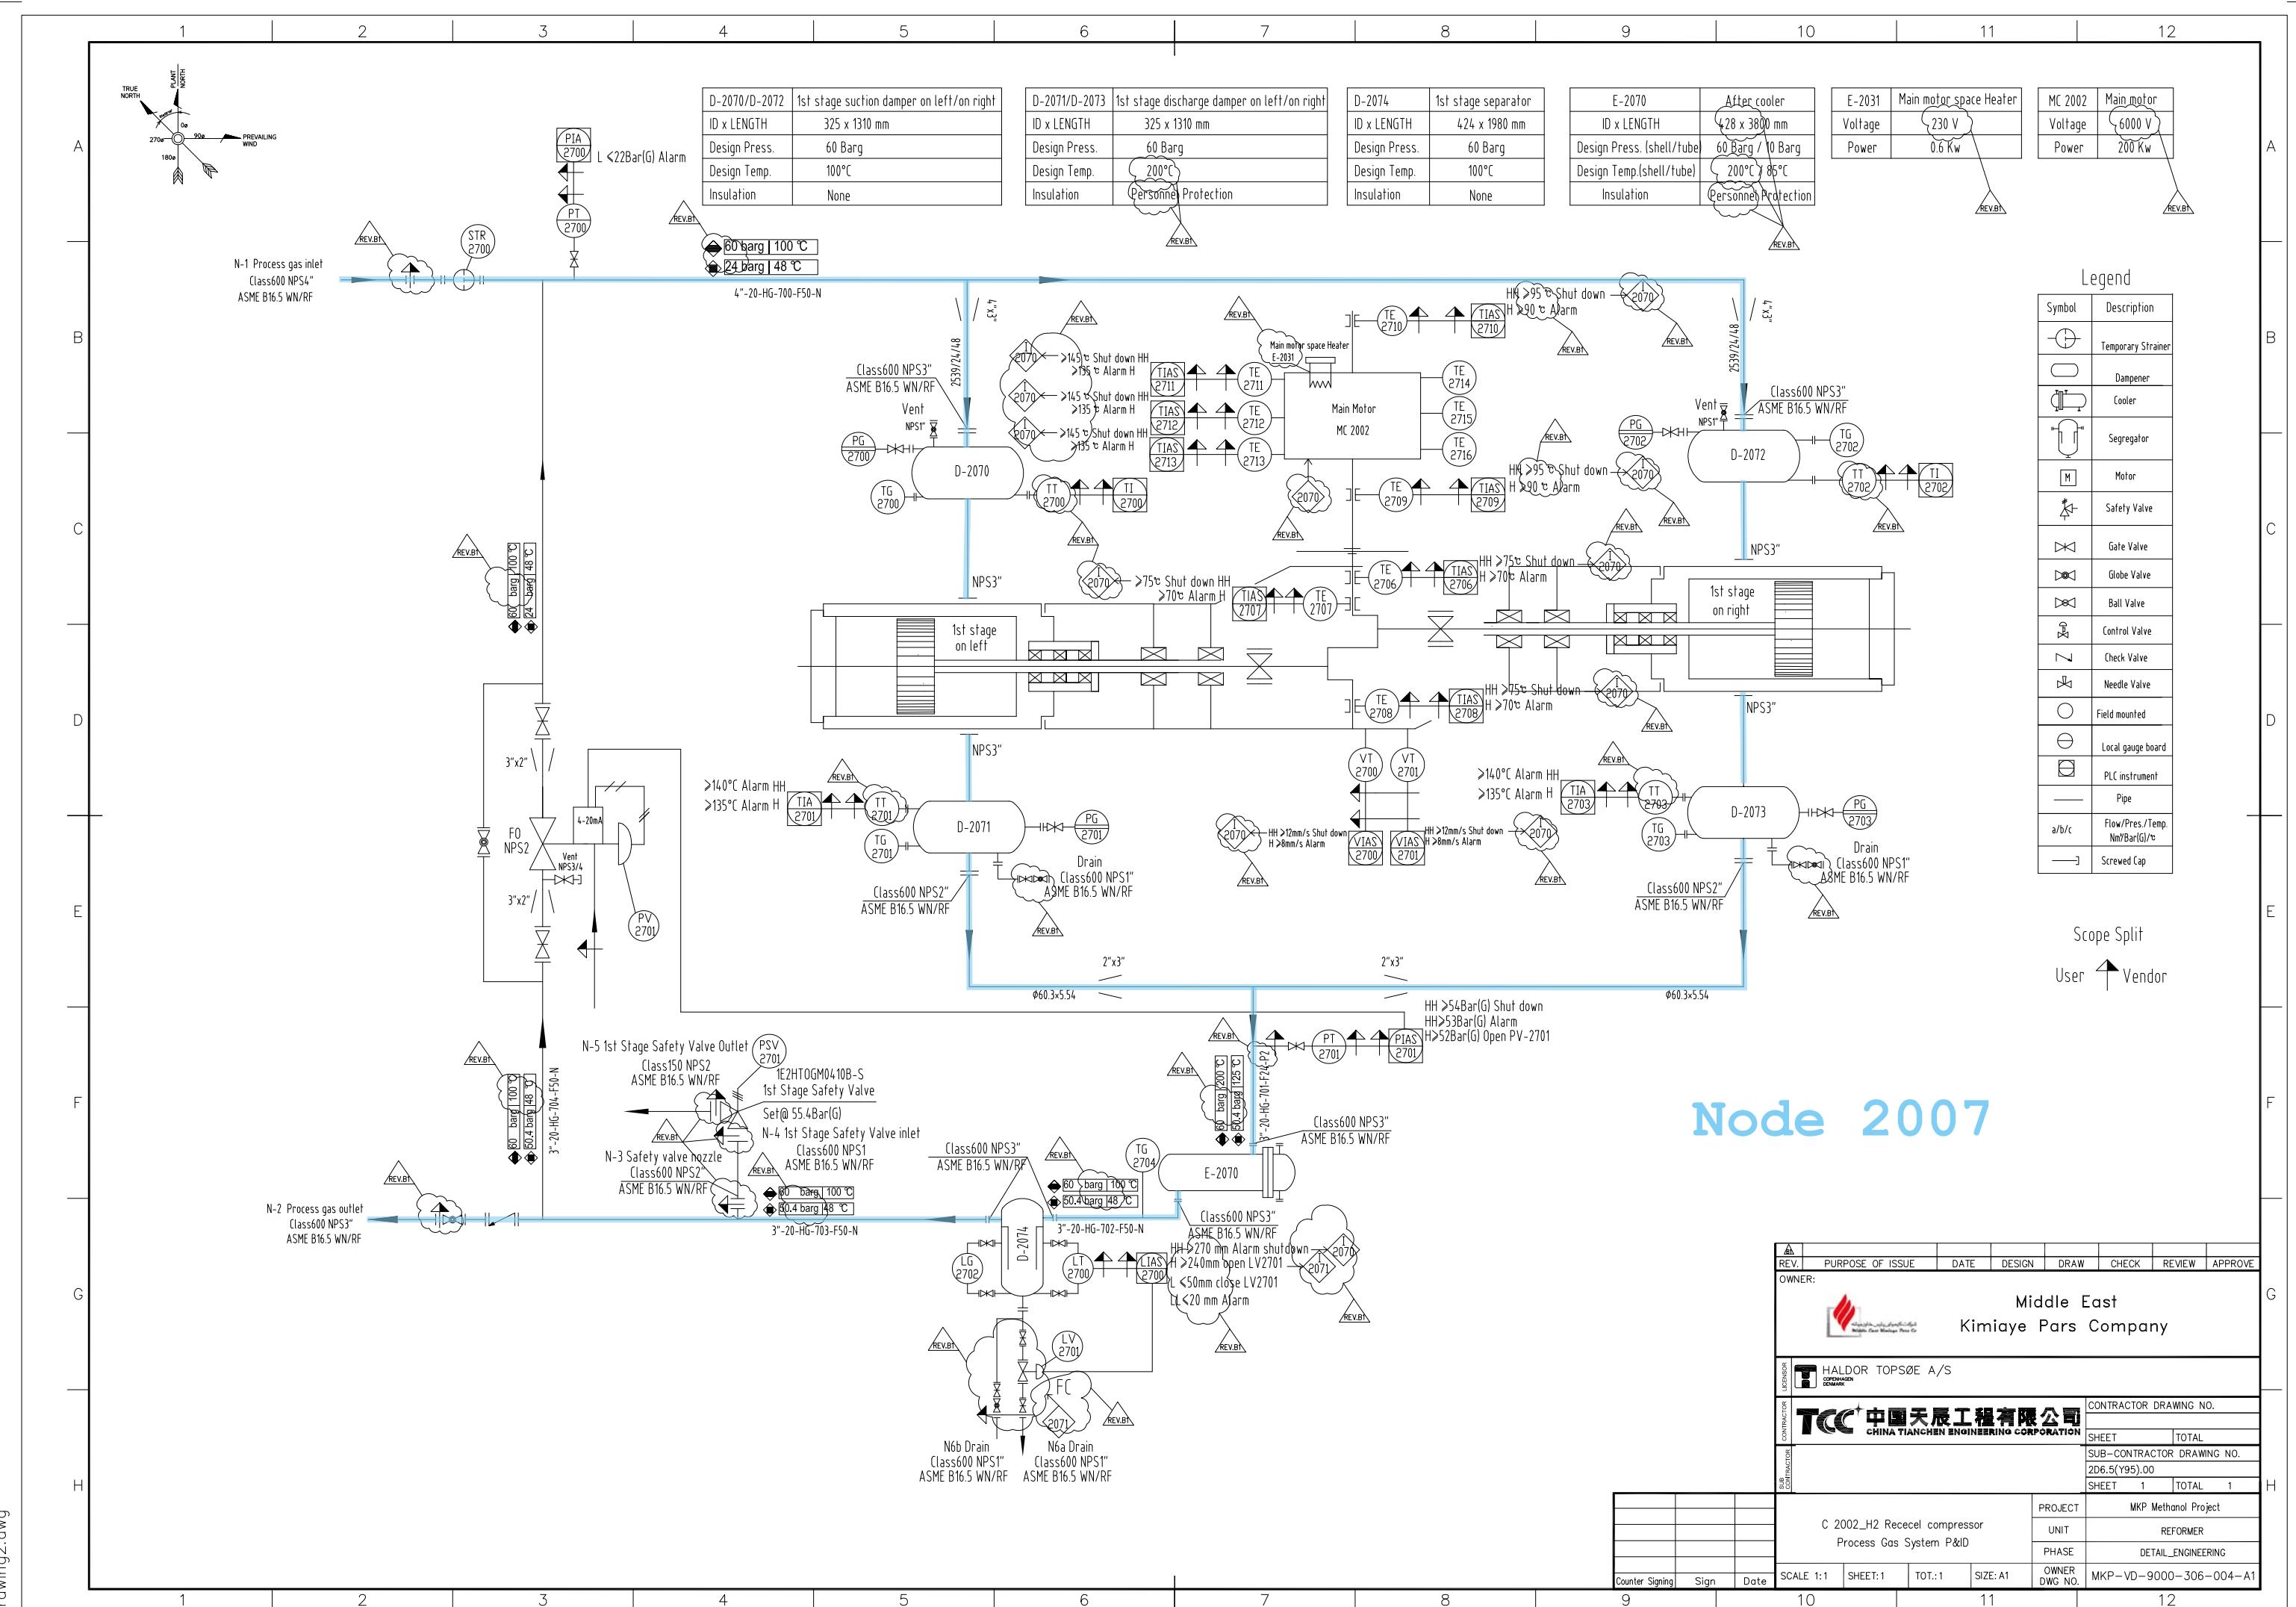


Node 2007

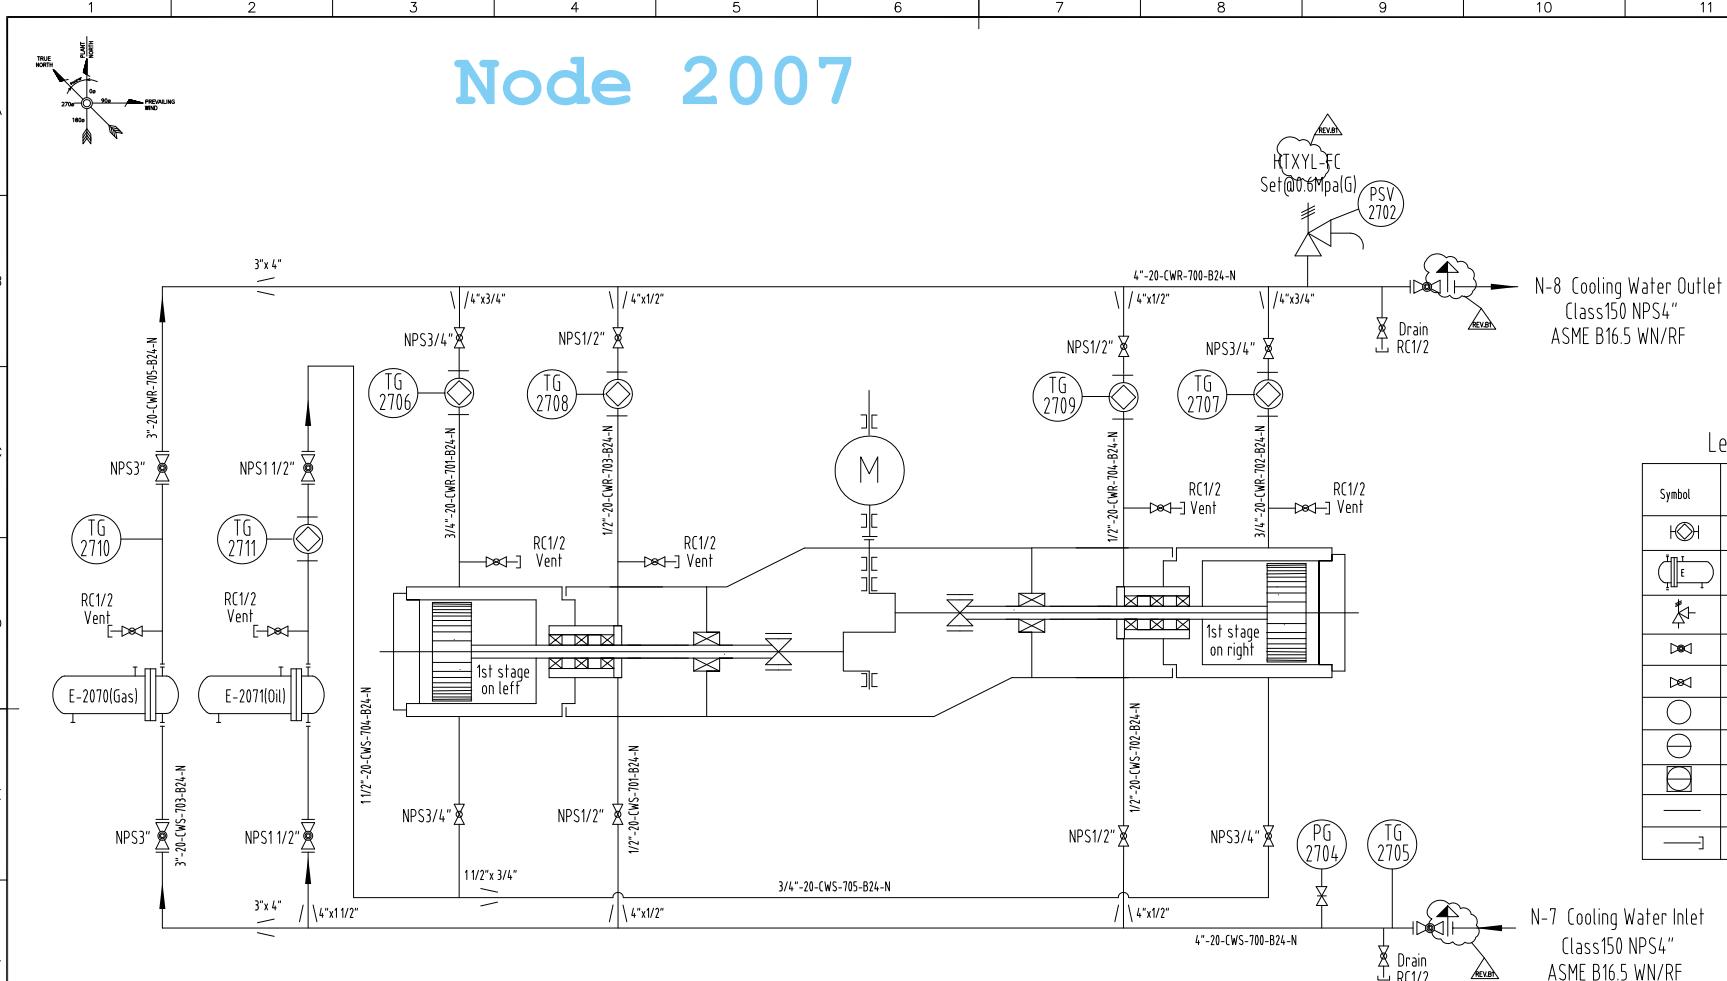

REV.	PURPOSE OF ISSUE	DATE	DESIGN	DRAW	CHECK	REVIEW	APPROVE
OWNER: Middle East Kimia Pars Company							
LICENDEE: HALDOR TOPSOE A/S							
CONTRACTOR DRAWING NO. TCC CHINA TIANCHEN ENGINEERING CORPORATION							
SHEET 1 TOTAL 1 SUB-CONTRACTOR DRAWING NO. 206.5(Y95).00							
PROJECT MKP Methanol Project UNIT REFORMER PHASE DETAILED ENGINEERING							
SCALE 1:1 SHEET:1 TOT:1 SIZE:1 OWNER DWG NO. MKP-VD-9000-306-005-A1							

1 | 2 | 3 | 4 | 5 | 6 | 7 | 8 | 9 | 10 | 11 | 12

Node 2007

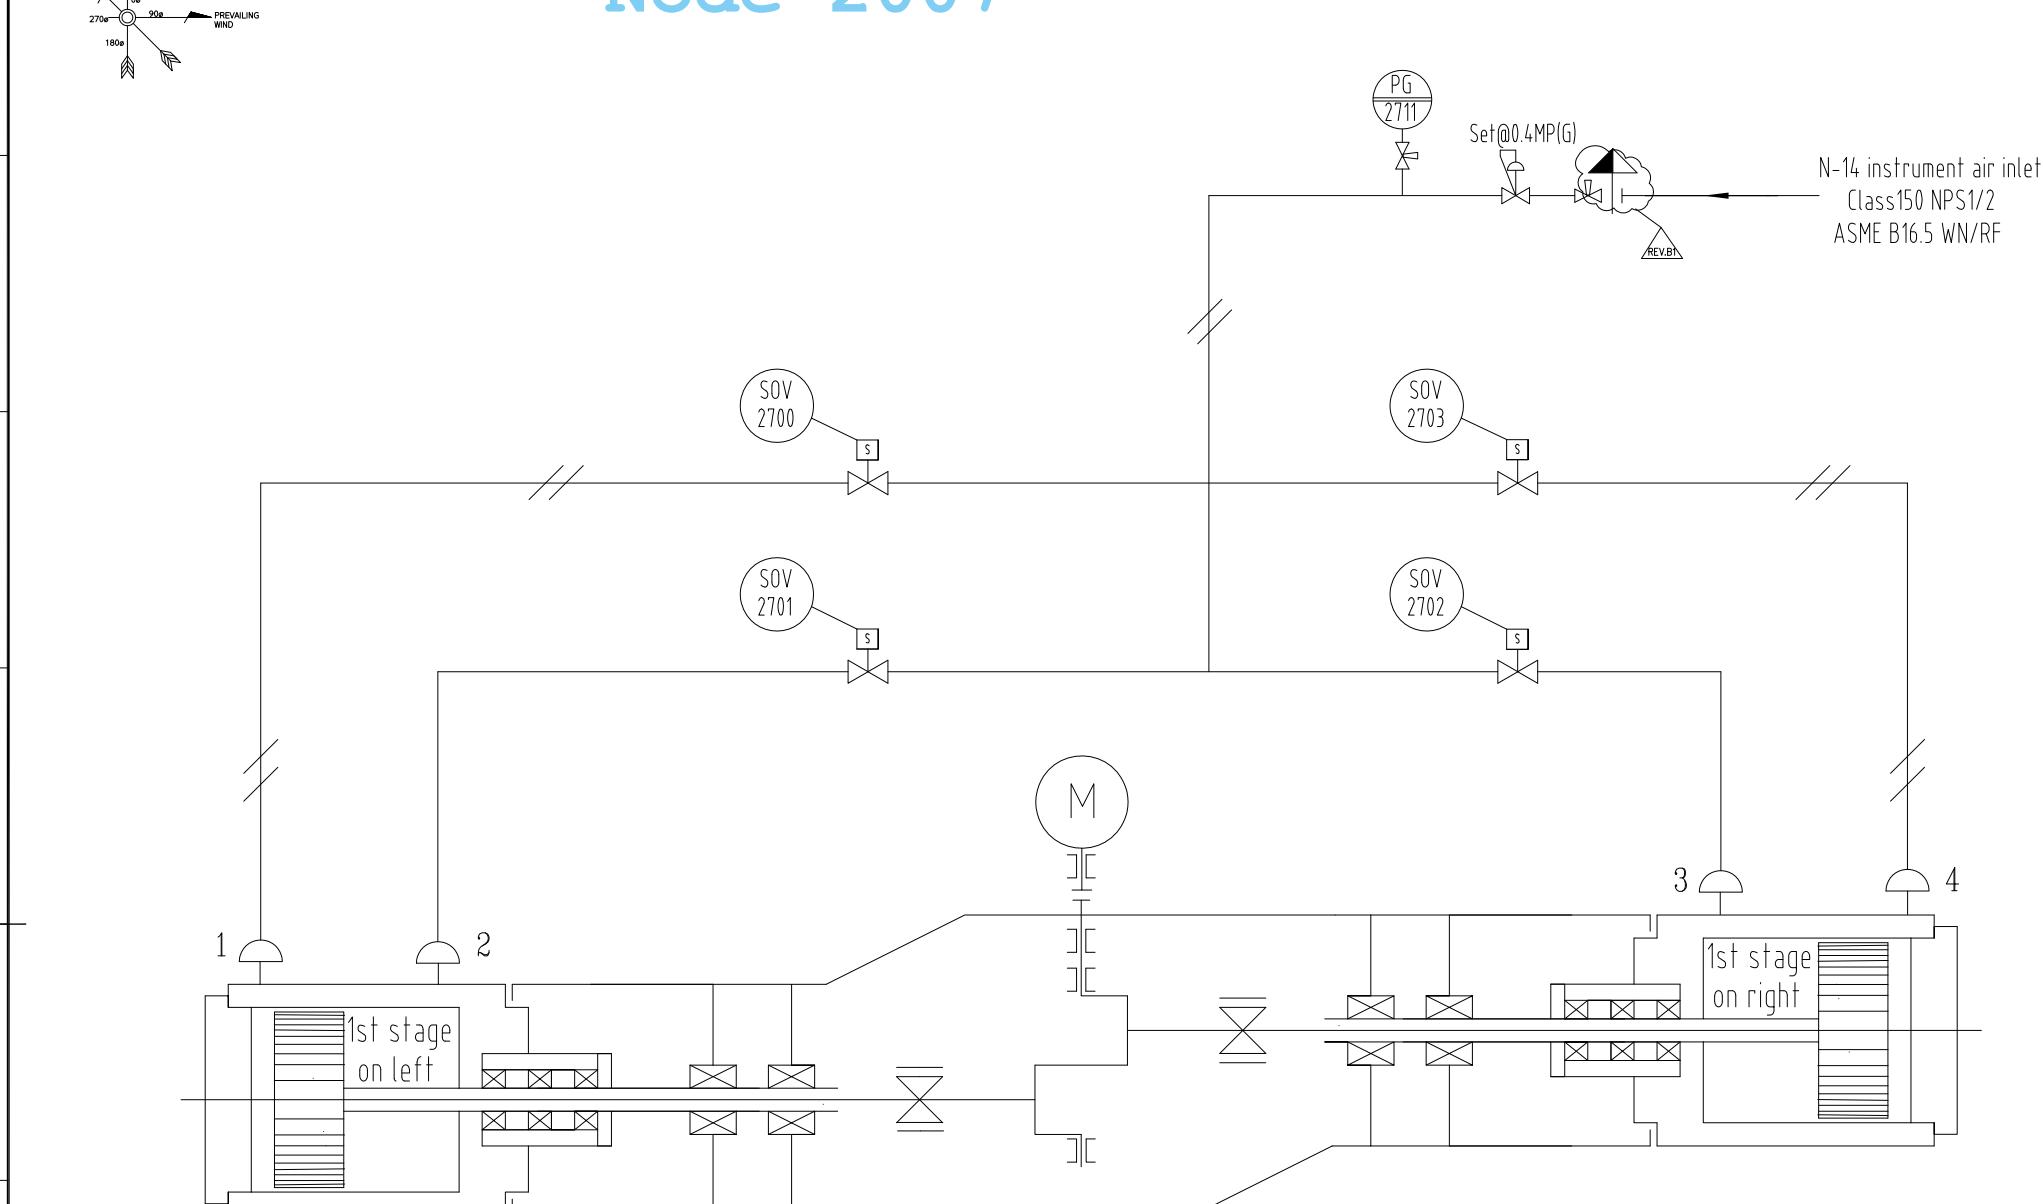


Capacity Control Method								
Stage	1st stage on left		1st stage on right		solenoid valve			
Capacity	HE-1	CE-2	HE-4	CE-3	SOV-2700	SOV-2701	SOV-2702	SOV-2703
0%	NA	NA	NA	NA	E	E	E	E
25%	NA	A	NA	NA	E	DE	E	E
50%	NA	A	NA	A	E	DE	DE	E
75%	NA	A	A	A	E	DE	DE	DE
100%	A	A	A	A	DE	DE	DE	DE

C-Close NA-No Acting HE-Head End DE-De Energized



O-Open A-Acting CE-Crank End E-Energized

REV.	PURPOSE OF ISSUE	DATE	DESIGN	DRAW	CHECK	REVIEW	APPROVE
OWNER: Middle East Kimiaye Pars Company							
LICENSOR	HALDOR TOPSØE A/S						
CONTRACTOR	CHINA TIANCHEN ENGINEERING CORPORATION						
SUB-CONTRACTORS	CONTRACTOR DRAWING NO. SHEET TOTAL SUB-CONTRACTOR DRAWING NO. 206.5(Y95).00 SHEET 1 TOTAL 1						
PROJECT MKP Methanol Project UNIT REFORMER PHASE DETAIL ENGINEERING OWNER DWG NO. MKP-VD-9000-306-A1							
Counter Signing	Sign	Date	SCALE 1:1	SHEET:1	TOT.:1	SIZE:A1	DWG NO. MKP-VD-9000-306-A1

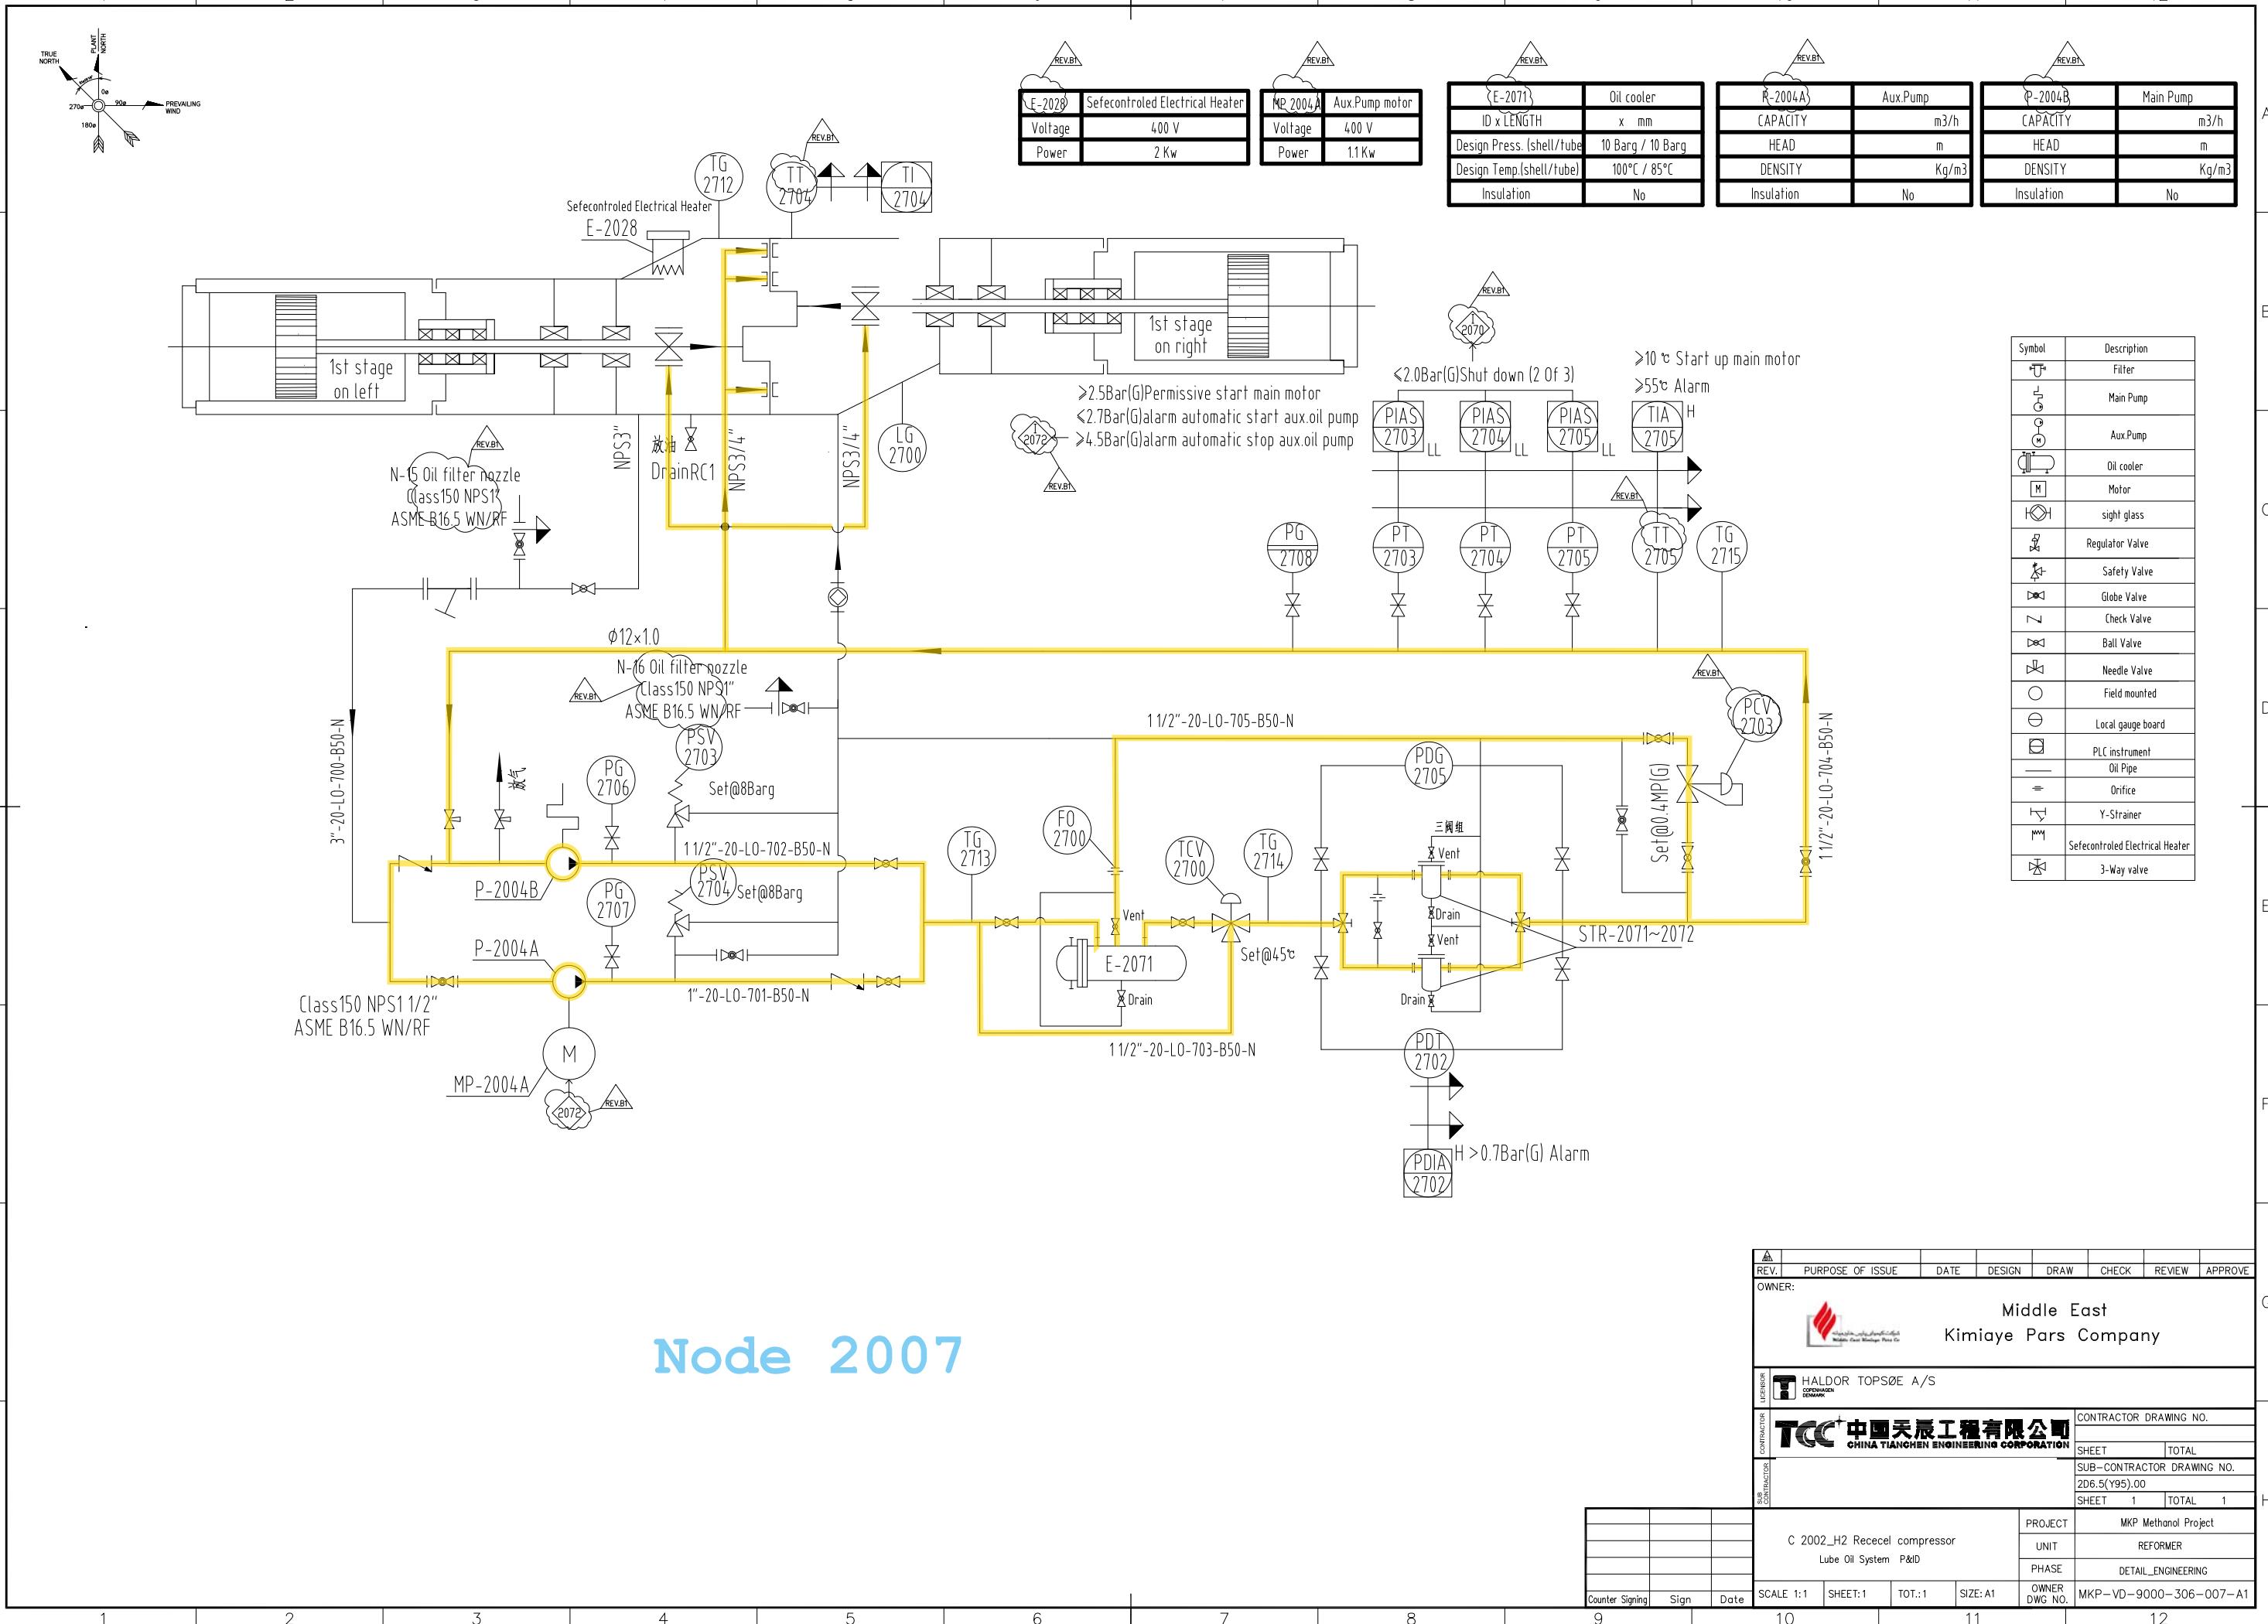

Node 2007

Node 2008

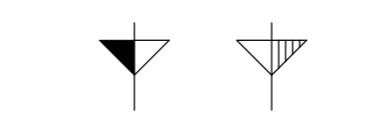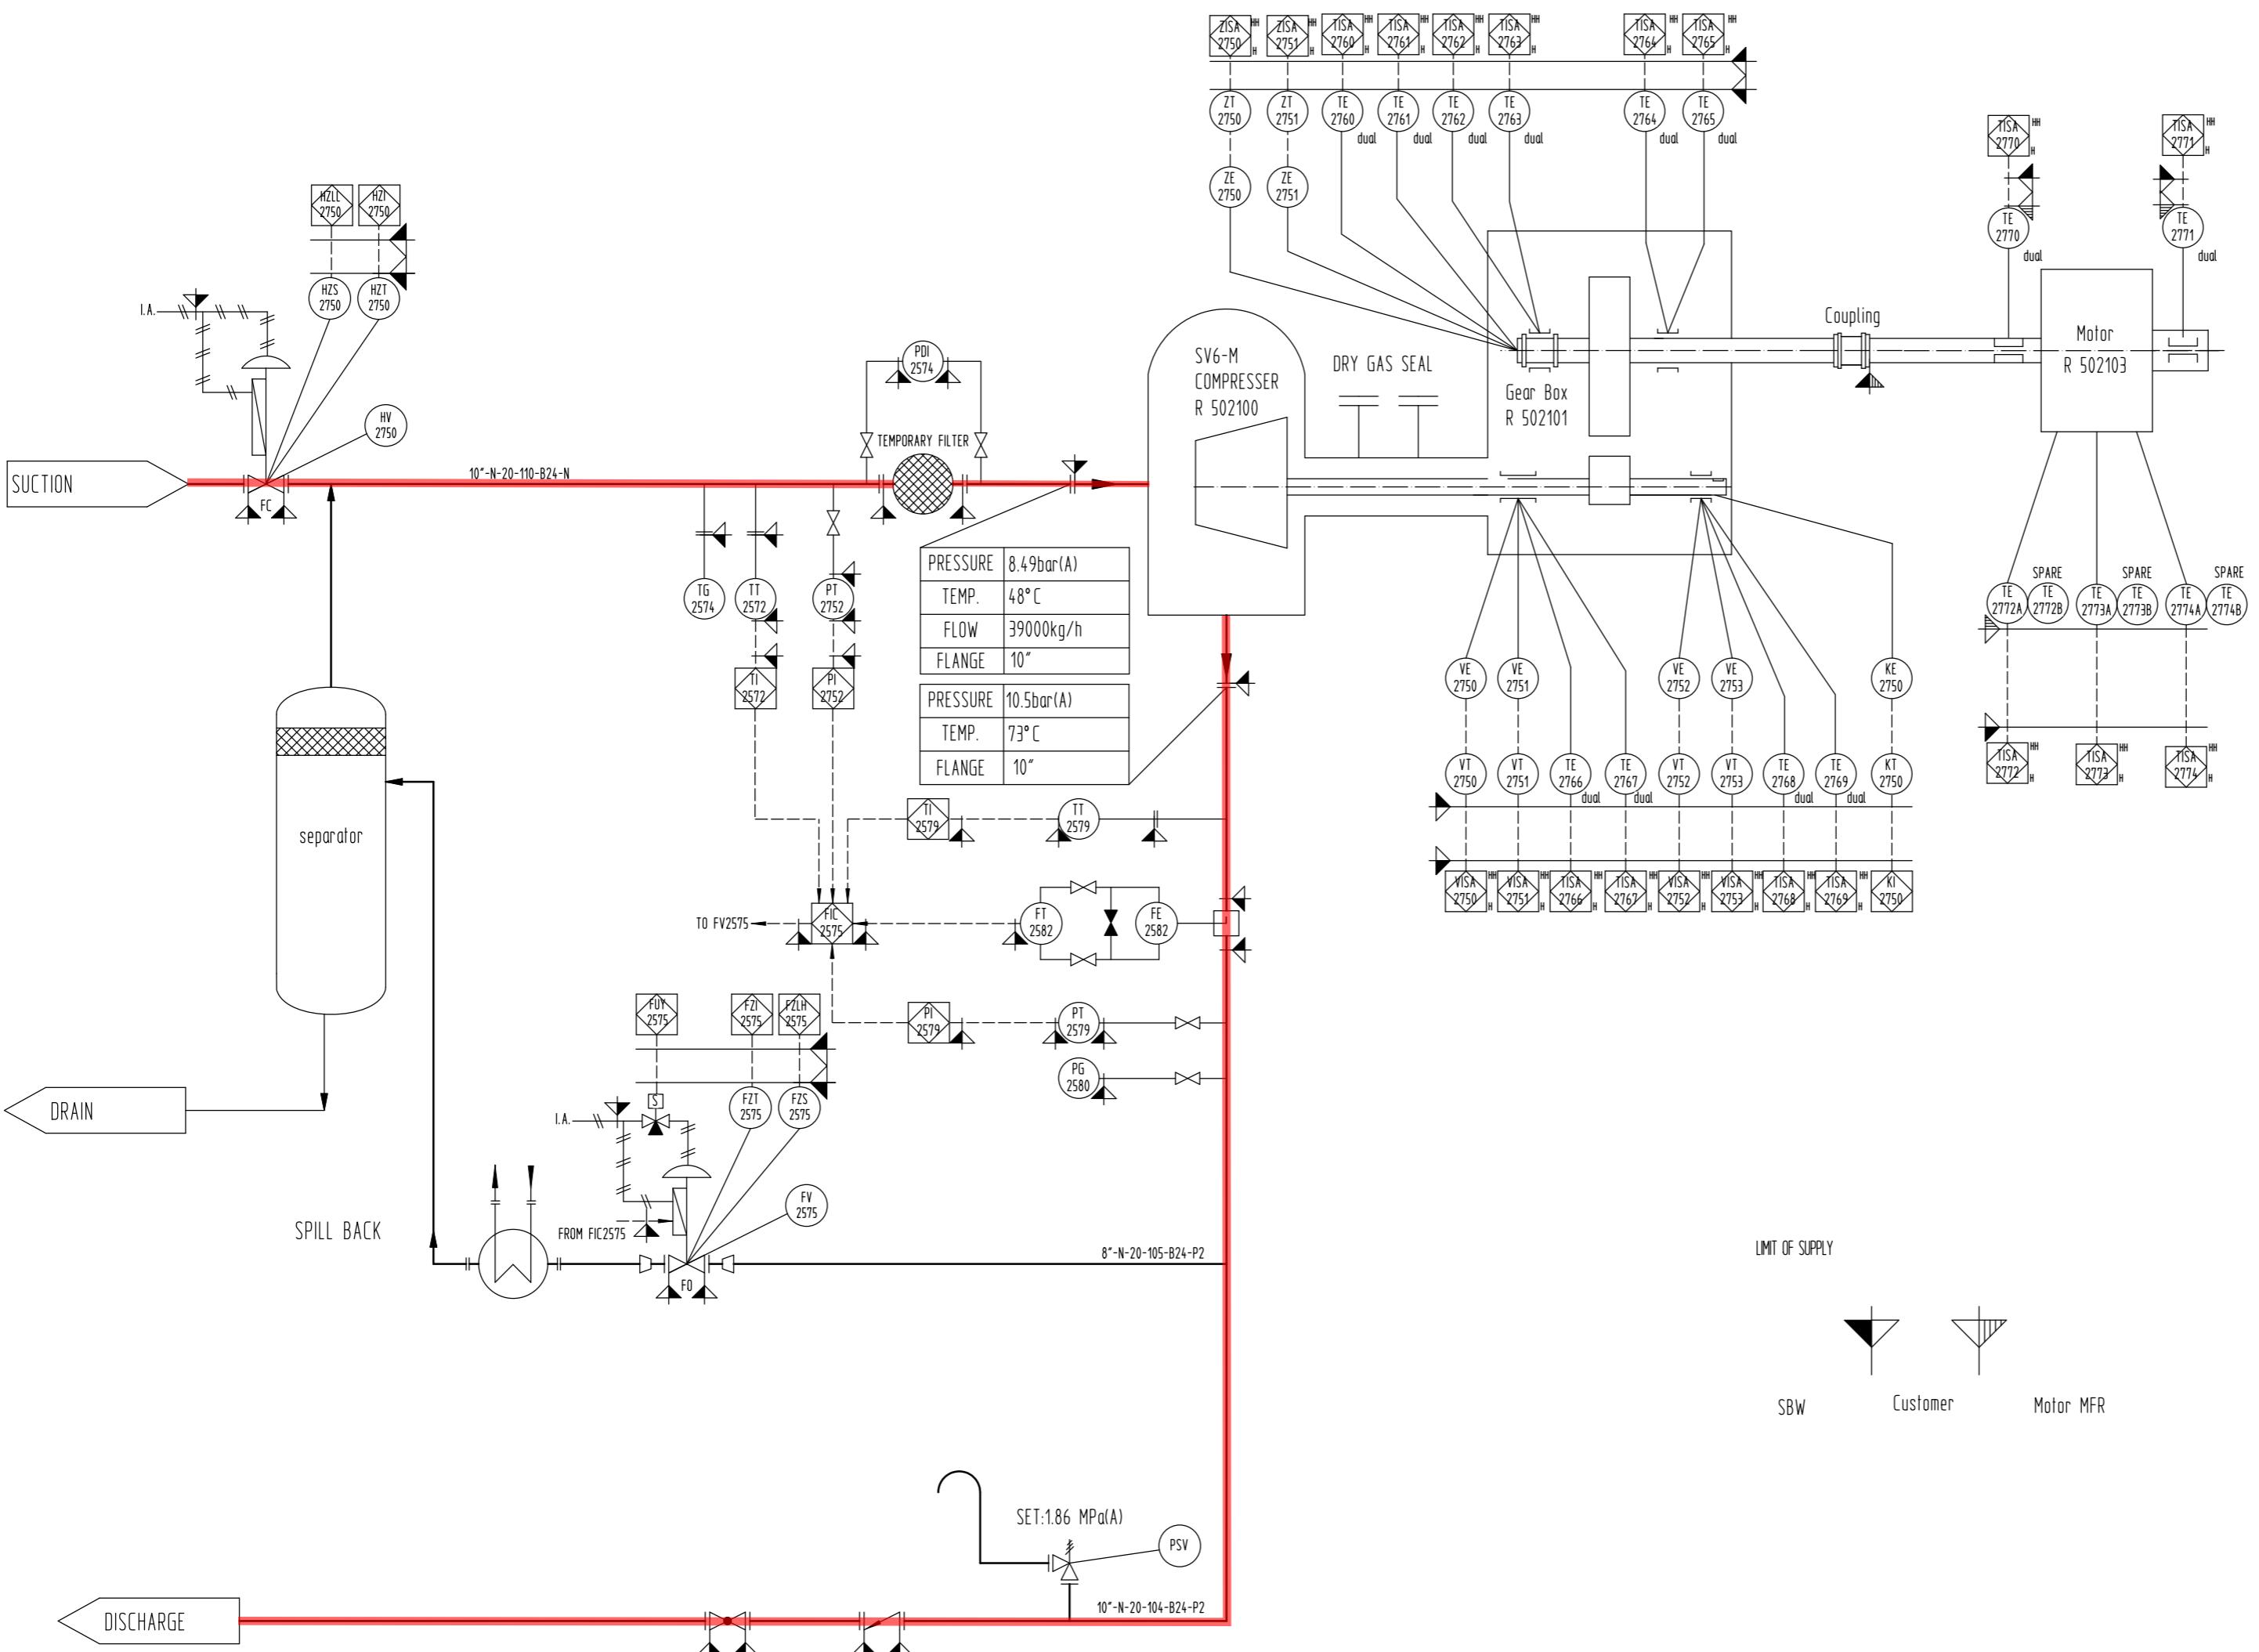

▲	Issued For Review	15.2.2017	Han Yang	Zhang Siyuan	Qu Luan	00.11.2015	Tian Sheng
▲	Issued For Review	12.1.2017	Han Yang	Zhang Siyuan	Qu Luan	00.11.2015	Tian Sheng
REV.	PURPOSE OF ISSUE	DATE	DESIGN	DRAW	CHECK	REVIEW	APPROVE


THIS DOCUMENT IS THE PROPERTY OF TCC. NO PART OF THIS DOCUMENT SHALL BE REPRODUCED OR DISCLOSED TO OTHERS OR USED FOR ANY PURPOSE WHATSOEVER EXCEPT WITH THE PRIOR WRITTEN PERMISSION OF TCC.

OWNER:

 Middle East
Kimya Pars Company

UICENSOR	 Haldor Topsøe A/S COPENHAGEN DENMARK			
CONTRACTOR	 TCC 中国天辰工程有限公司 CHINA TIANCHEN ENGINEERING CORPORATION	CONTRACTOR DRAWING NO. MKP-11-DE-9000-MP86-REQ-008		
		SHEET	01	TOTAL 01
VENDOR	 Shenyang Blower Works Group Co., LTD.	VENDOR DRAWING NO. MKP-VD-9000-308-060-A4		
		SHEET	01	TOTAL 01
Item No.:	C2001		PROJECT	MKP Methanol Project
Service:	Centrifugal Compressor		UNIT	General Technical
Document:	Gas system		PHASE	Detail Engineering
SCALE	SHEET	TOT.	SIZE	OWNER DWG NO. MKP-11-DE-9000-RE-REQ-308

Node 2008

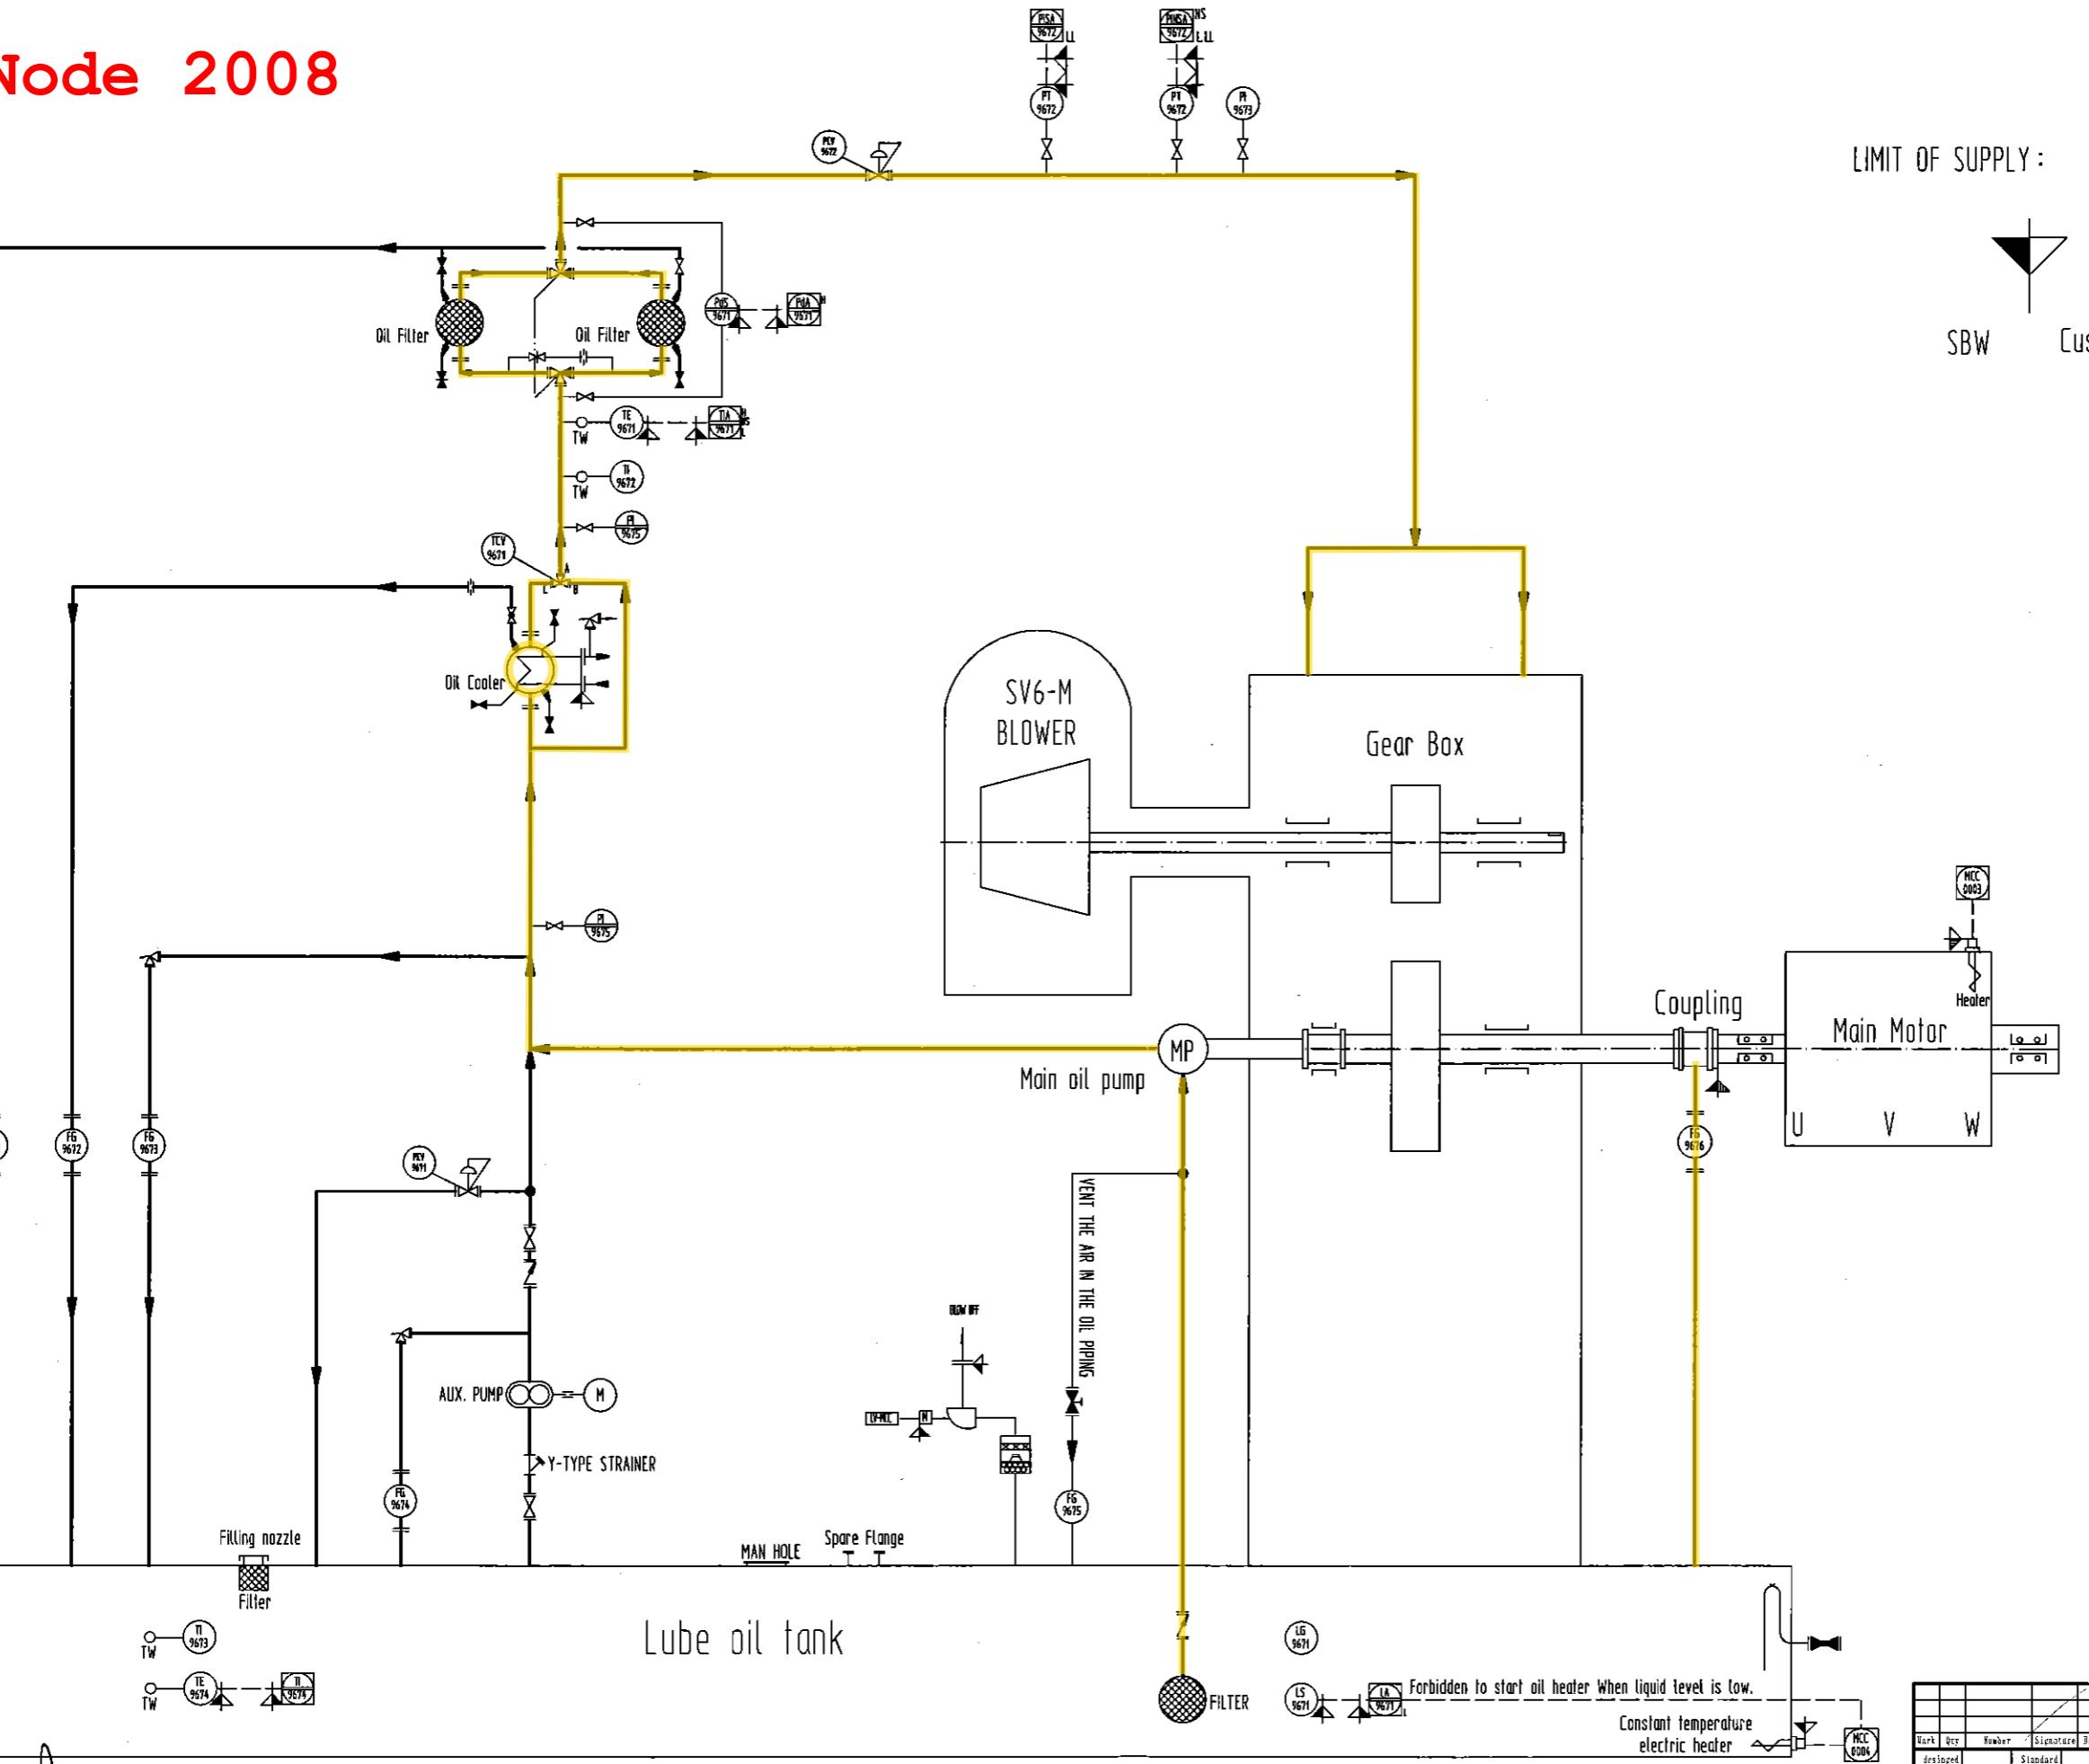


LIMIT OF SUPPLY:

SBW

umer


otor MFR

Mark	Date	Signature	Number	Design	SV6-M
designed		Standard			 Siemens Blower Works Group Co., LTD.
approved		process			
reviewed		approved			Drawing mark
checked		Rev.			Weight
examined					Scale
				Total 1 pages	1/1
Lube Oil System					

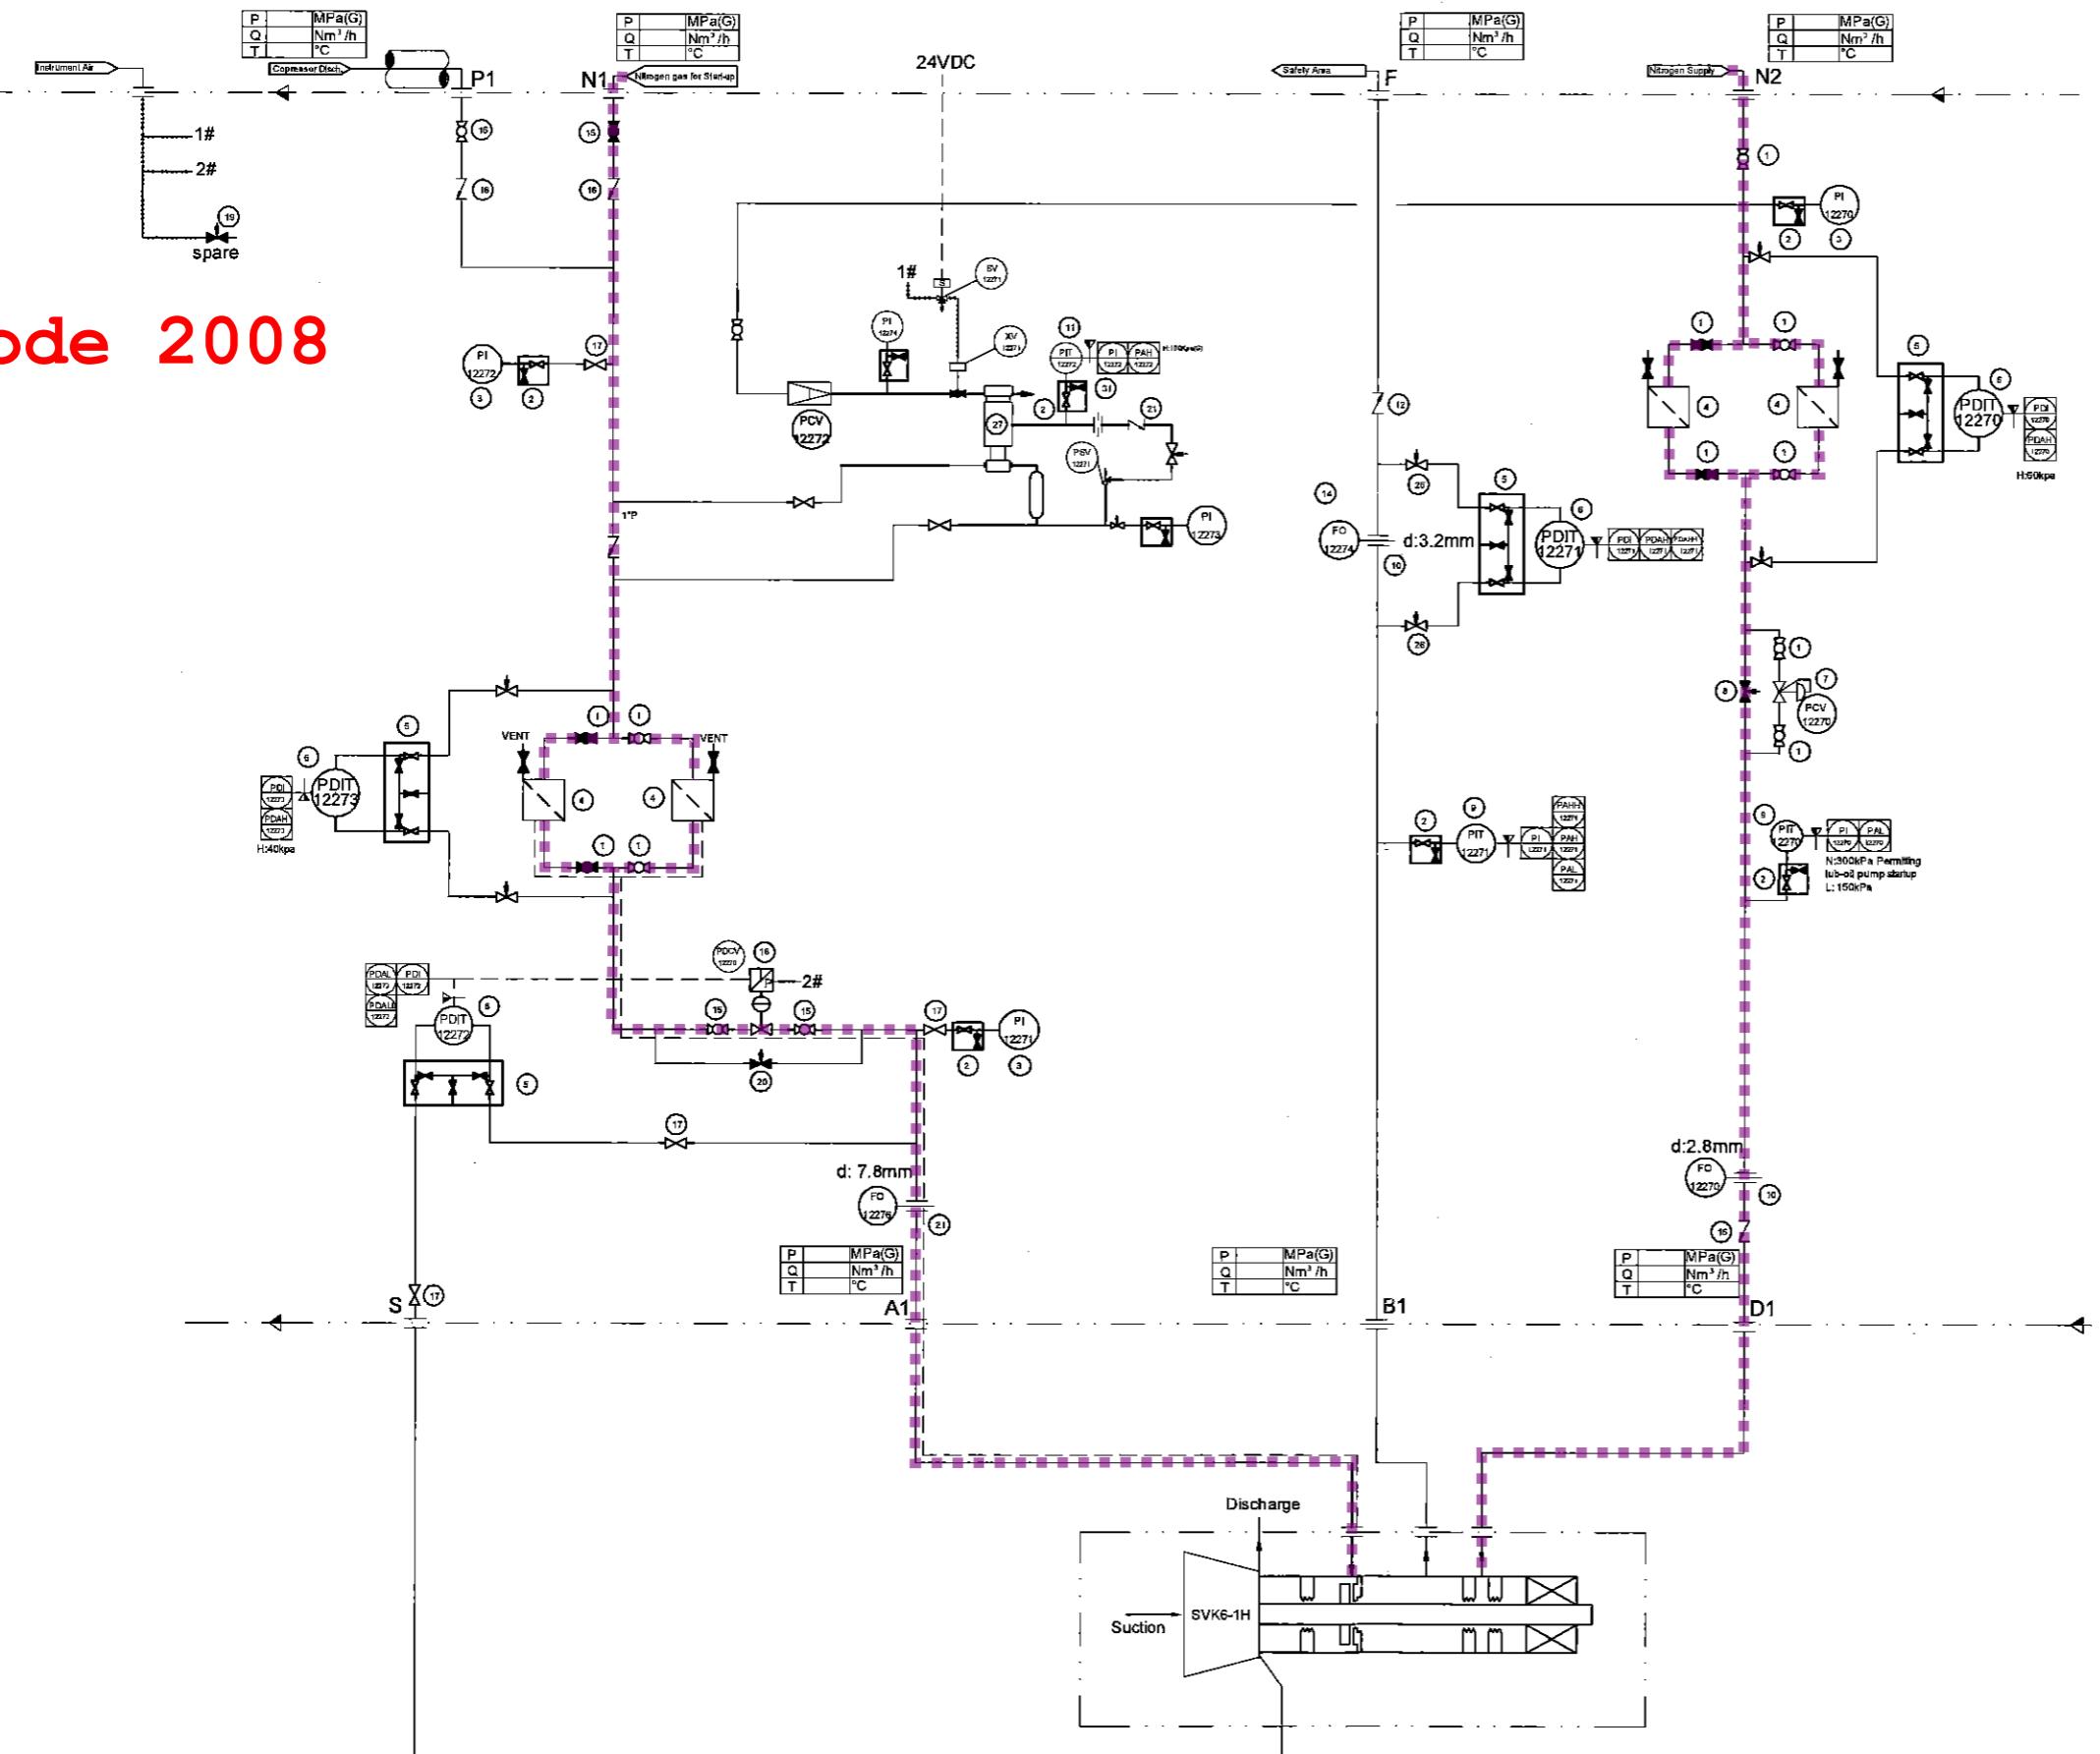


Project	IRAN ME PROJECT						Name	Date	APPD.	REV.D1
Customer	MEKPCO						Drawn	WB	2016.09.30	
Site	ASSALUYEH						Checked			
Compressor	SV6-M						Appd.			
Item No.	C-2001						Scale	P&I DIAGRAM SEAL MANAGEMENT SYSTEM		
Dry Gas Seal	Single Seals						NTS			
							Drawing No.	0541-JA16704-PID	Actual Wt./Ref No.	
							Originated from	Replacement for	Replaced by	CAI

Node 2009

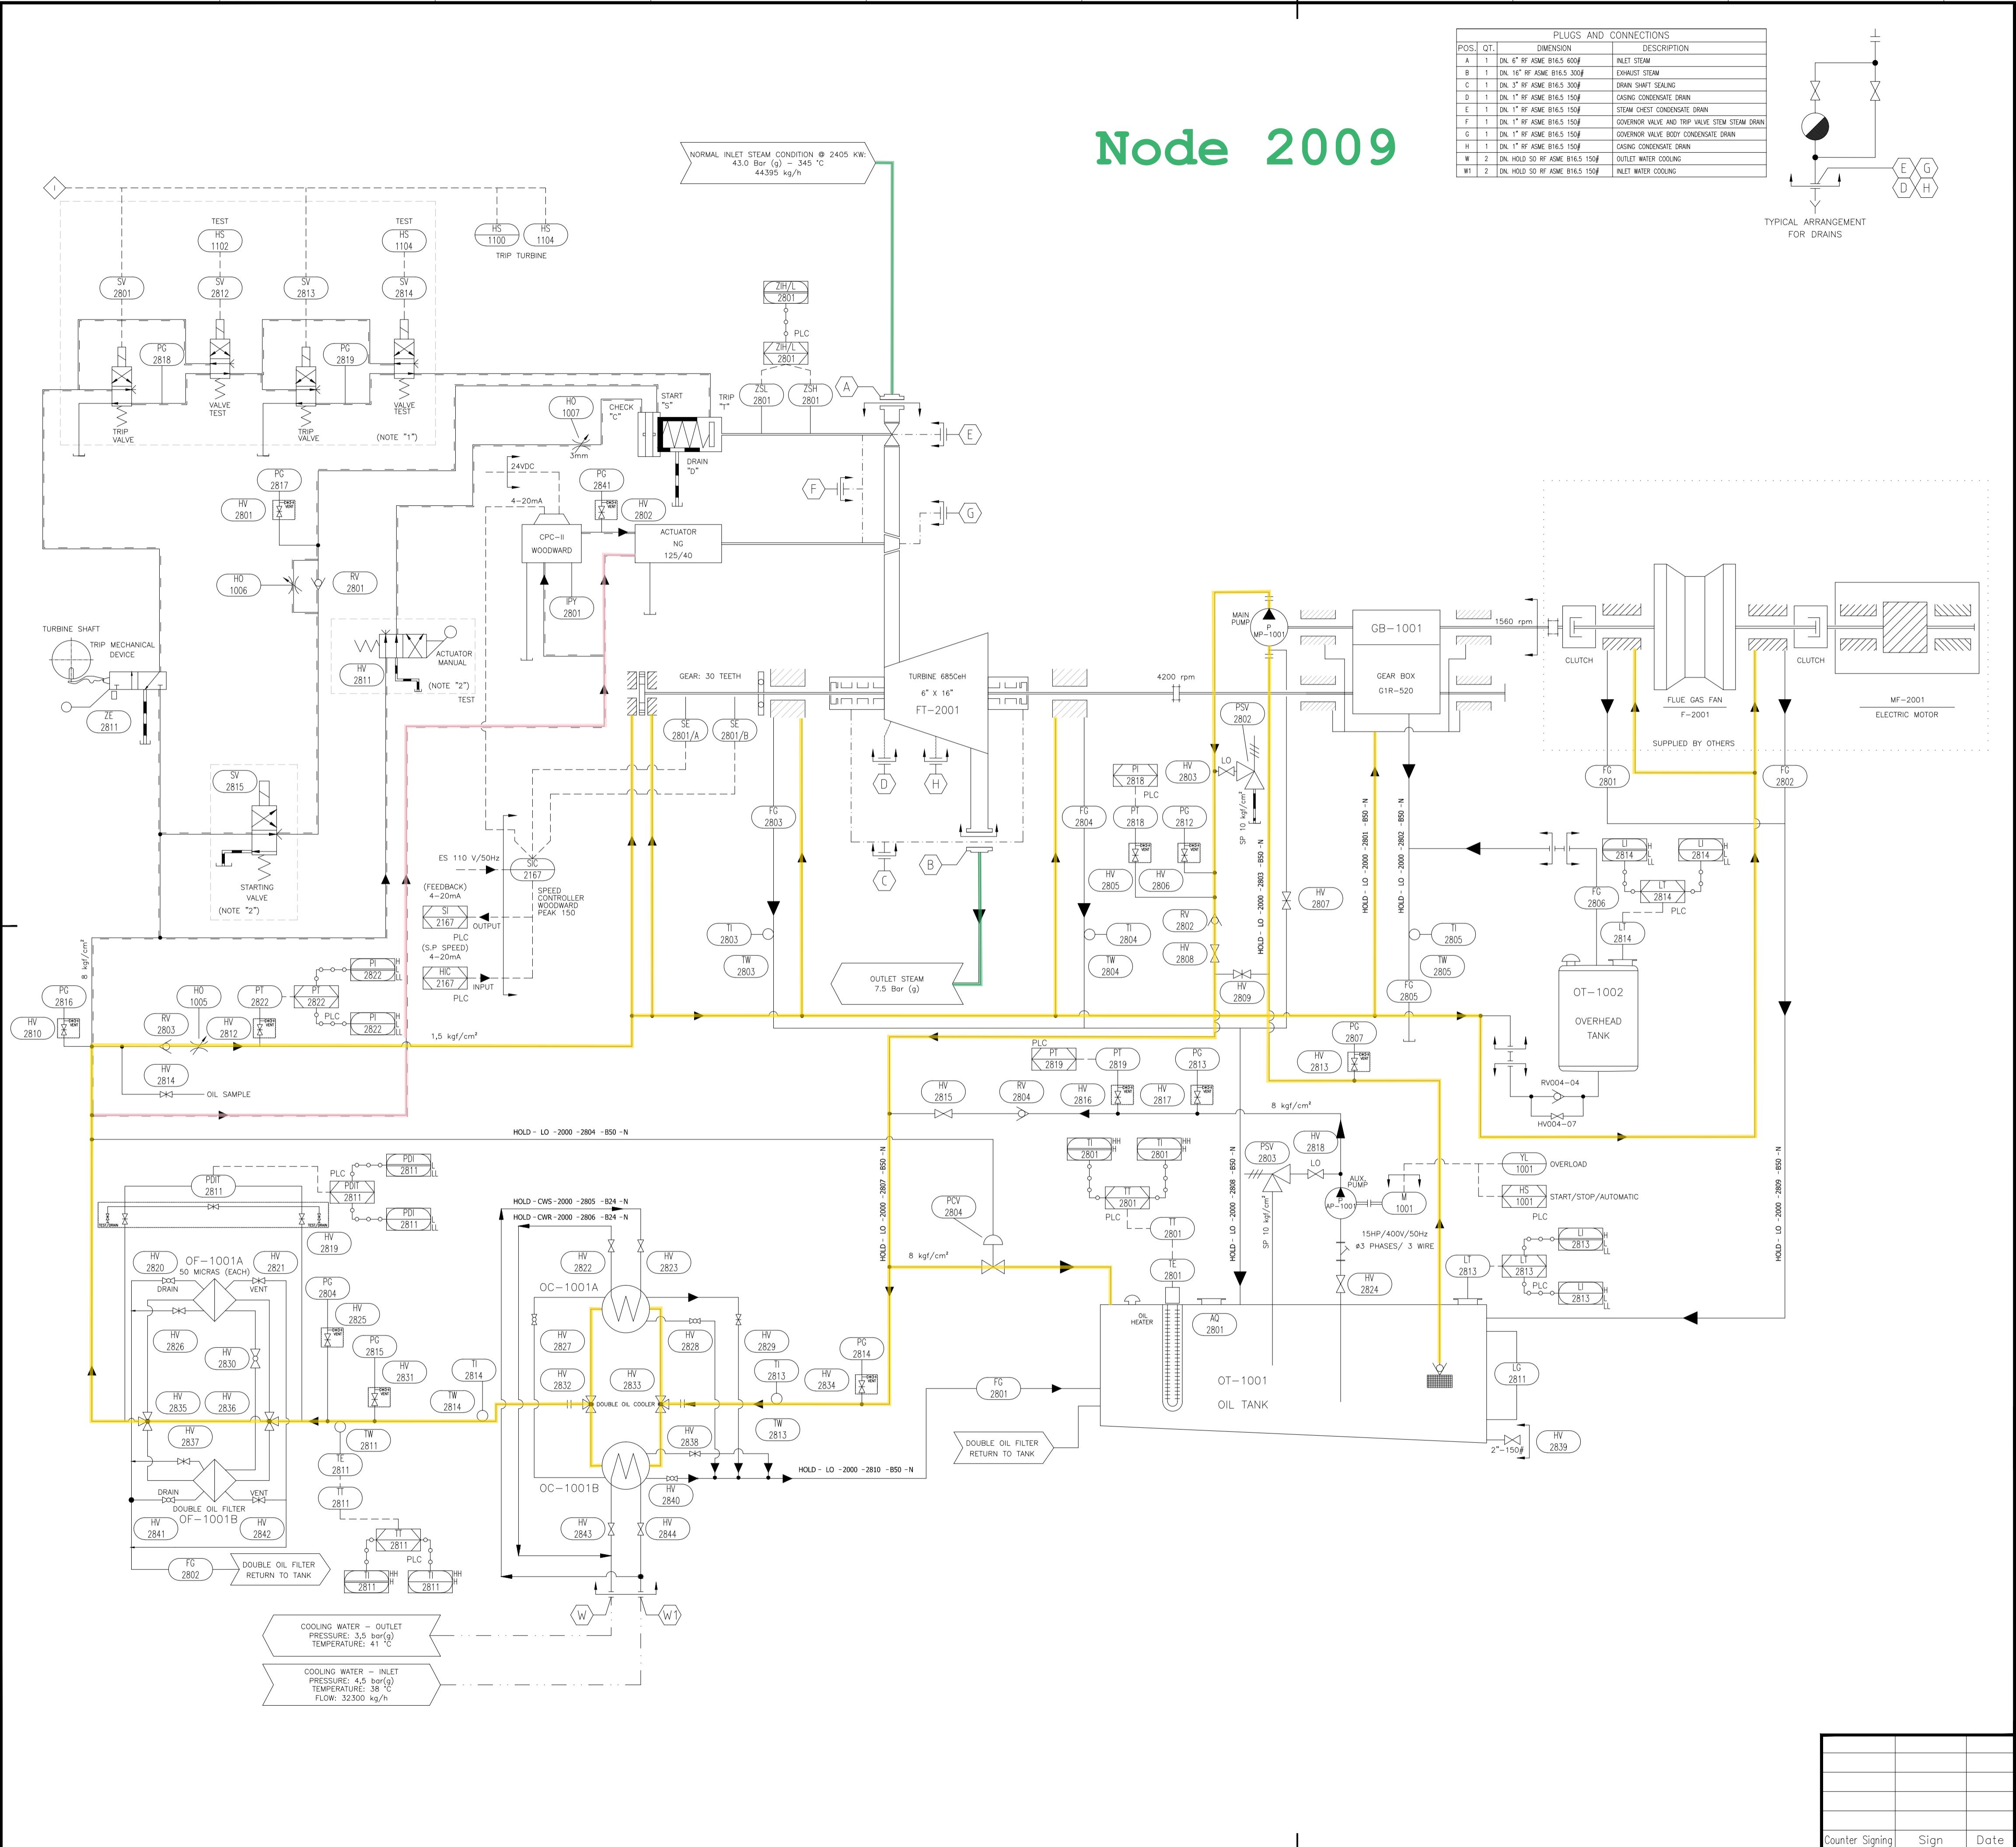

1 - VALVES SV-2801, SV-2802, SV-2803 AND SV-2804 FORM A SINGLE MANIFOLD BLOCK;
2 - VALVES HV-2803 AND SV-2805 FORM A SINGLE MANIFOLD BLOCK;
3 - CONNECTIONS D, E, G, H, SHOULD BE DRAINED TO AN ATMOSPHERIC COLLECTOR (PIPING) SUPPLIED BY CLIENT.


REV.	ISSUED FOR COMMENTS	09.12.2016	ADTC	ADTC	ADCF	ADCF	HCC
THIS DOCUMENT IS THE PROPERTY OF TCC. NO PART OF THIS DOCUMENT SHALL BE REPRODUCED OR DISCLOSED TO OTHERS OR USED FOR ANY PURPOSE WHATSOEVER EXCEPT WITH THE PRIOR WRITTEN PERMISSION OF TCC.							
OWNER:	 Middle East Kimiaye Pars Company						
LICENSOR:	 HALDOR TOPSOE A/S DENMARK						
CONTRACTOR:	 TCC CHINA TIANCHEN ENGINEERING CORPORATION						
VENDOR DRAWING NO.							
I.T.T. SpA - Milano - Italy							
PROCESS INSTRUMENTATION DIAGRAM	PROJECT	MKP Methanol Project					
TURBINE: 685 CeH	UNIT	PRIMARY REFORMER PACKAGE (H 2001)					
CUSTOMER: MKP - IRAN	PHASE	DETAIL ENGINEERING					
SCALE N/S	Sheet	03	TOT.	05	SIZE	A1	OWNER DWG NO.
							MKP-VD-2000-351-145-A1

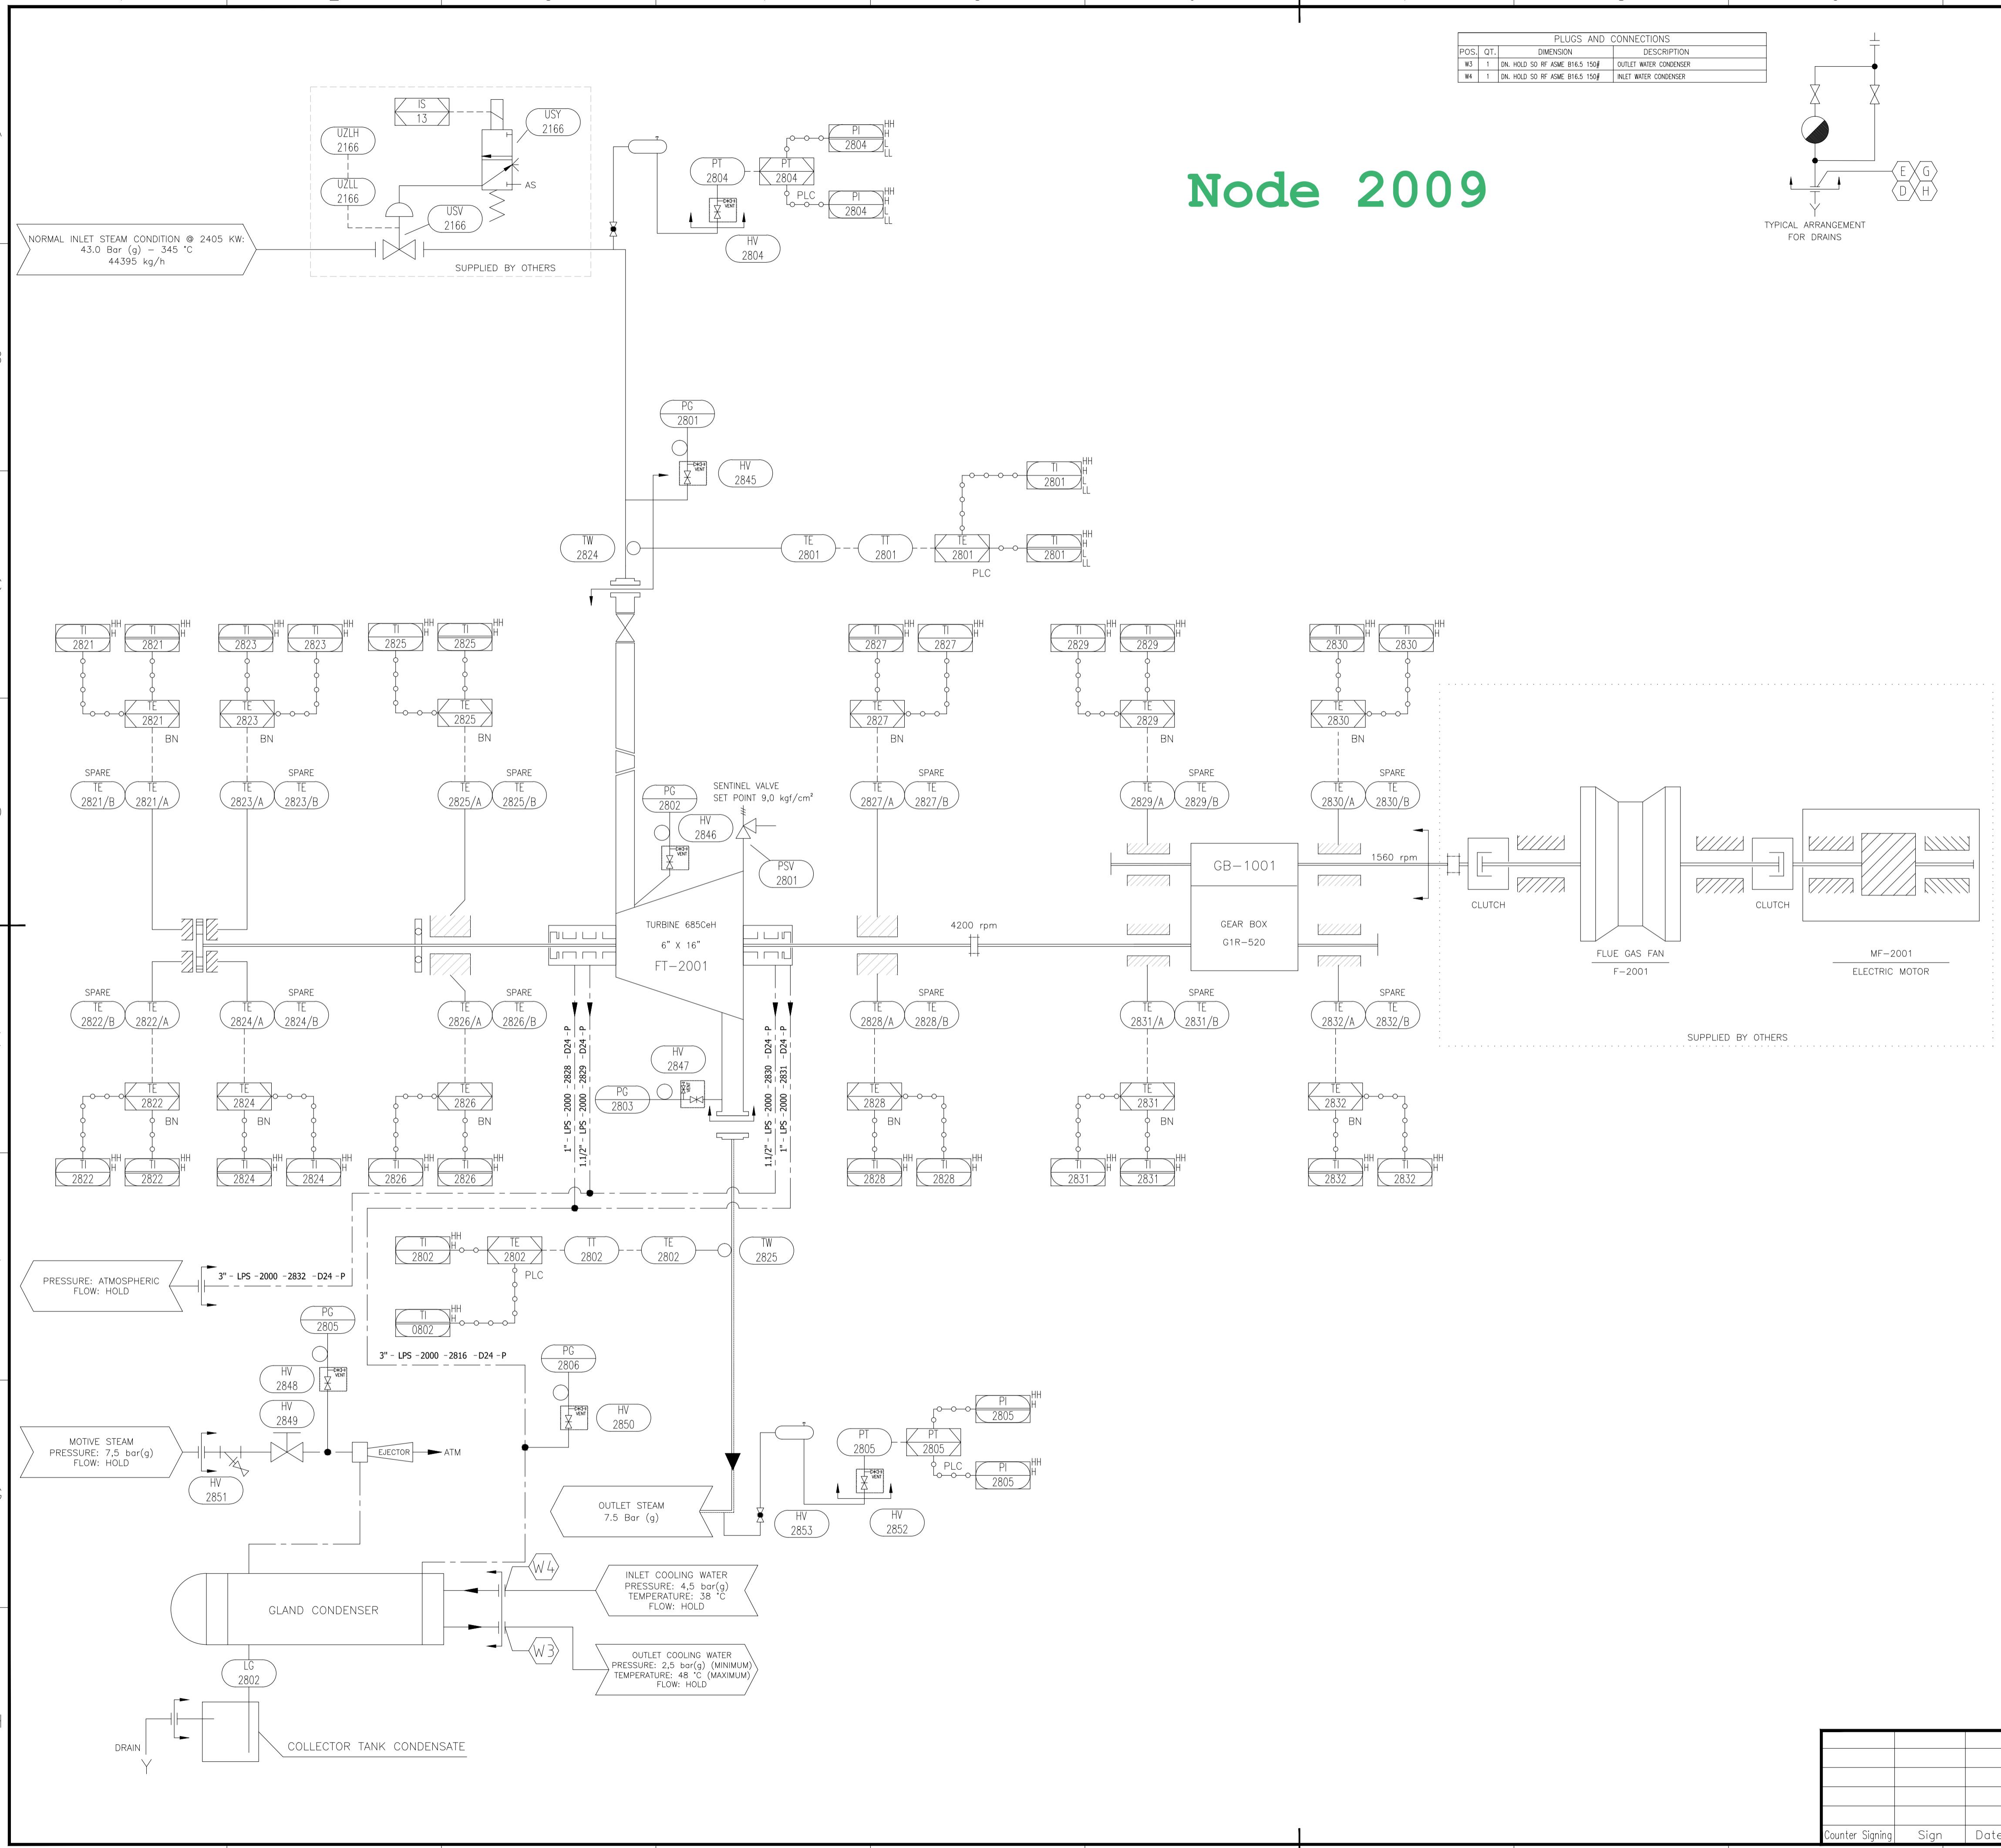

Node 2009

PLUGS AND CONNECTIONS		
. QT.	DIMENSION	DESCRIPTION
1	DN. HOLD SO RF ASME B16.5 150#	OUTLET WATER CONDENSER
1	DN. HOLD SO RF ASME B16.5 150#	INLET WATER CONDENSER

1 - USV-2801 TO SUPPLIED BY ITT.

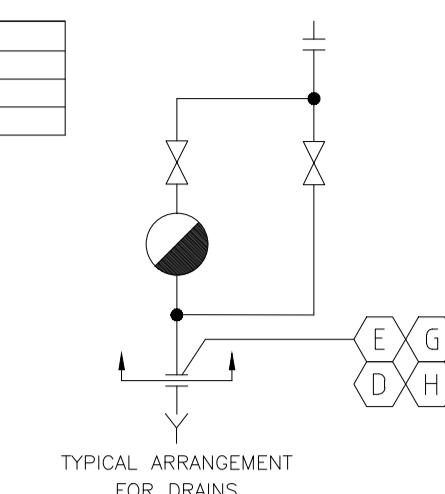


GENERAL NOTES

1 - USV-2801 TO SUPPLIED BY ITT.


REFERENCE DRAWINGS



SYMBOLS AND LEGENDS

 

KEY PLAN

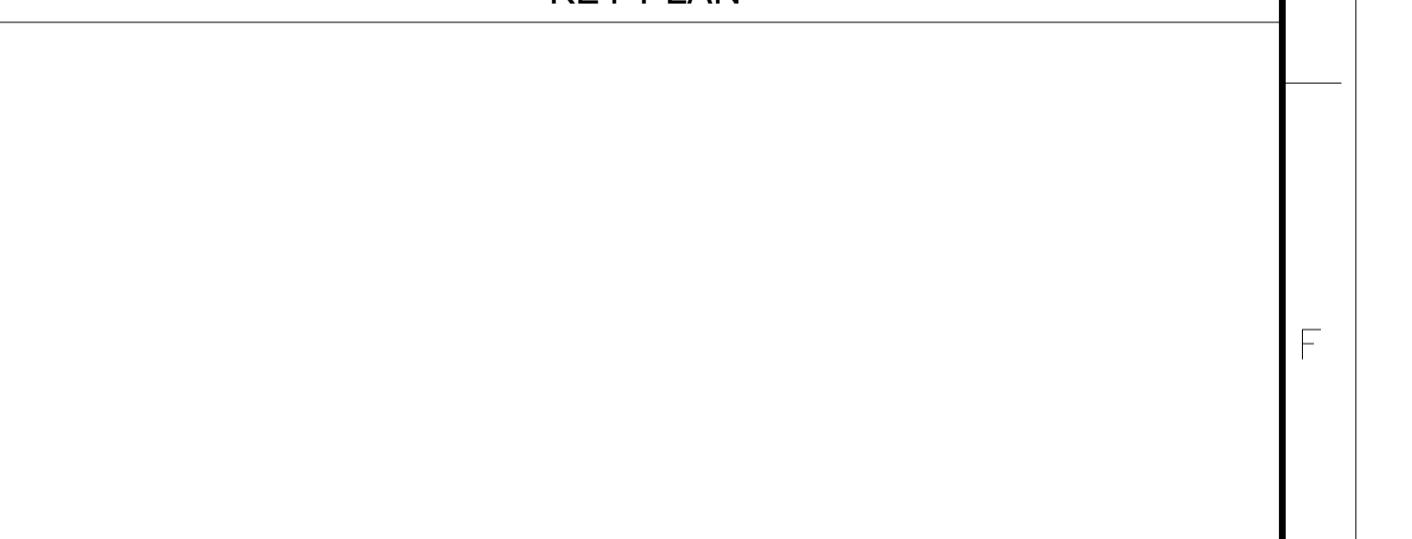


This document is the property of TCC. No part of this document shall be reproduced or disclosed to others or used for any purpose whatsoever except with the prior written permission of TCC.

OWNER:

Middle East migye Pars Company

 HALDOR TOPSØE A/S COPENHAGEN DENMARK		
 TCC 中国天辰工程有限公司 CHINA TIANCHEN ENGINEERING CORPORATION		
 I.T.T. SpA - Milano - Italy		
 SPA	VENDOR DRAWING NO.	
	15104B-VND-22-608_16	
PROCESS INSTRUMENTATION DIAGRAM TURBINE: 685 CeH TAG: FT-2001 CUSTOMER: MKP - IRAN	PROJECT	MKP Methanol Project
	UNIT	PRIMARY REFORMER PACKAGE (H 2001)
	PHASE	DETAIL ENGINEERING
CALE N/S	SHEET 04	TOT. 05 SIZE A1
		OWNER DWG NO.
		MKP-VD-2000-351-145-A1

Node 2009

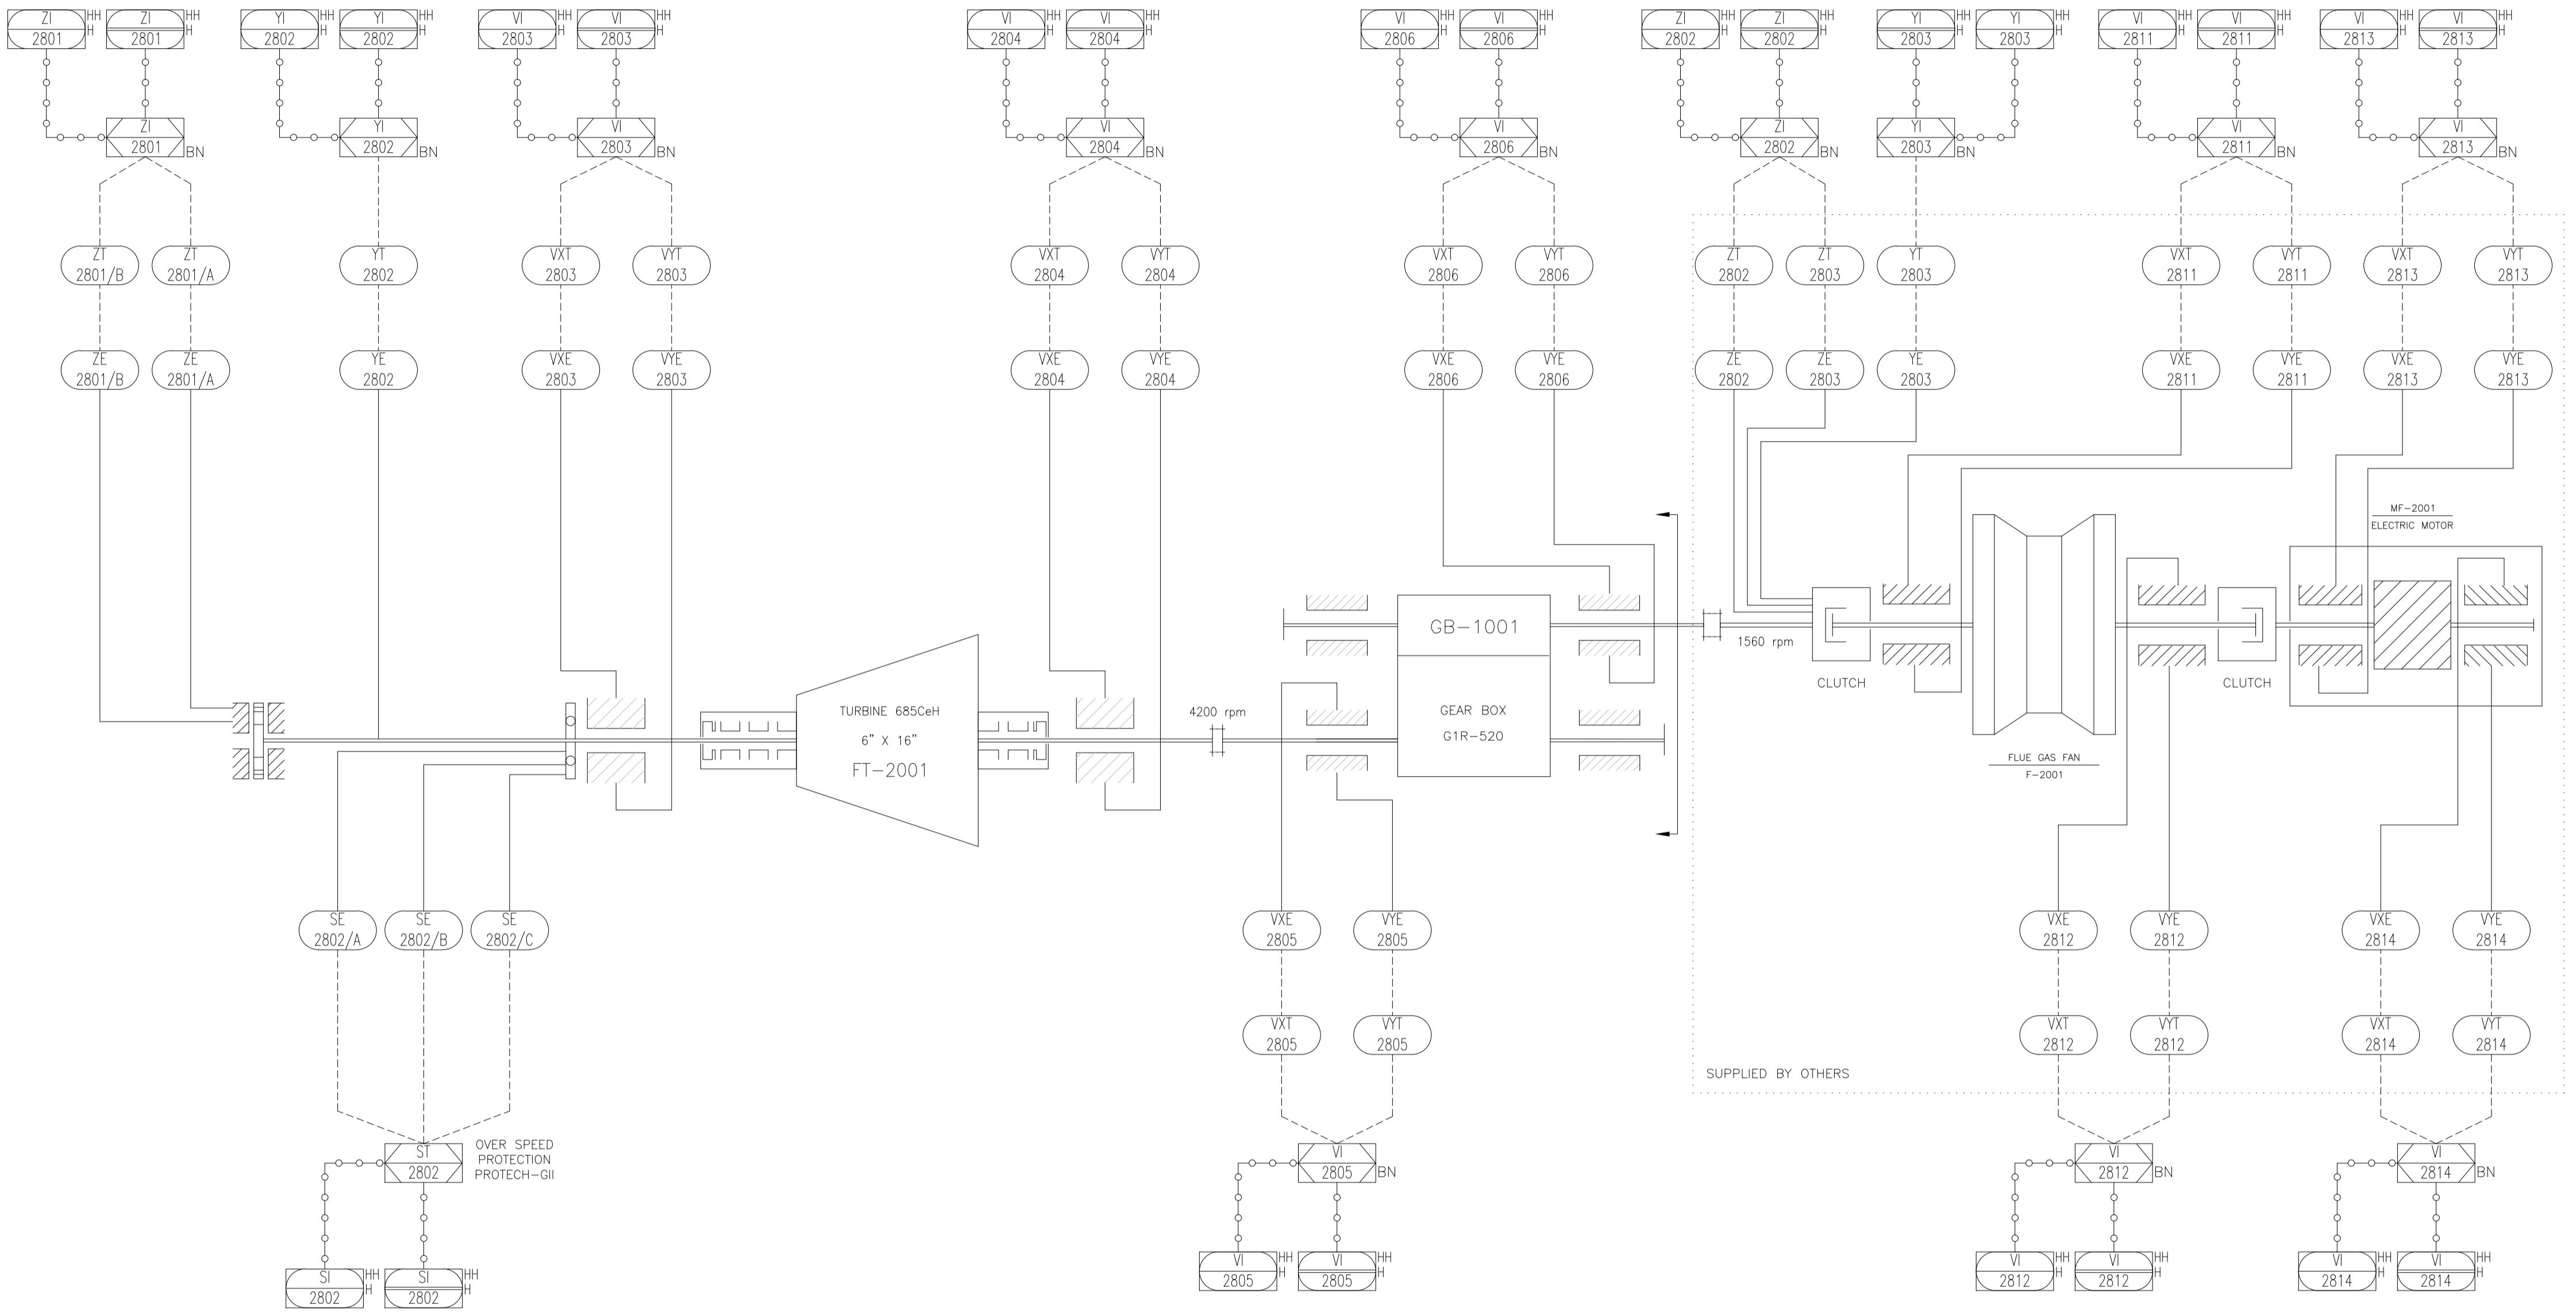

GENERAL NOTES

- 1 - FOR BENTLY NEVADA TAG USE BN-2816.
2 - FOR TRIP FAN TO PCS/ESD TAG USE USY-2802.
3 - FOR TRIP ELECTRIC MOTOR TO PCS/ESD TAG USE USY-2803.

REFERENCE DRAWINGS


SYMBOLS AND LEGENDS

KEY PLAN

REV.	Issued For Comments	09.12.2016	ADTC	ADTC	ADCF	ADCF	HCC
REV.	PURPOSE OF ISSUE	DATE	DESIGN	DRAW	CHECK	REVIEW	APPROVE

THIS DOCUMENT IS THE PROPERTY OF TCC. NO PART OF THIS DOCUMENT SHALL BE REPRODUCED OR DISCLOSED TO OTHERS OR USED FOR ANY PURPOSE WHATSOEVER EXCEPT WITH THE PRIOR WRITTEN PERMISSION OF TCC.

OWNER:

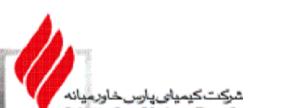


Middle East
Kimiaye Pars Company

HALDOR TOPSØE A/S

TCC 中国天辰工程有限公司
CHINA TIANCHEN ENGINEERING CORPORATION

CONTRACTOR	I.T.T. SpA - Milano - Italy	VENDOR DRAWING NO.	MKP Methanol Project
		TURBINE: 685 CeH	UNIT: PRIMARY REFORMER PACKAGE (H 2001)
		TAG: FT-2001	CUSTOMER: MKP - IRAN
PHASE	DETAIL ENGINEERING	PROJECT	MKP Methanol Project
SCALE N/S	SHEET 05	UNIT	PRIMARY REFORMER PACKAGE (H 2001)
TOT. 05	SIZE A1	PHASE	DETAIL ENGINEERING
Counter Signing	Sign	OWNER DWG NO.	MKP-VD-2000-351-145-A1
Date			

Node 2009

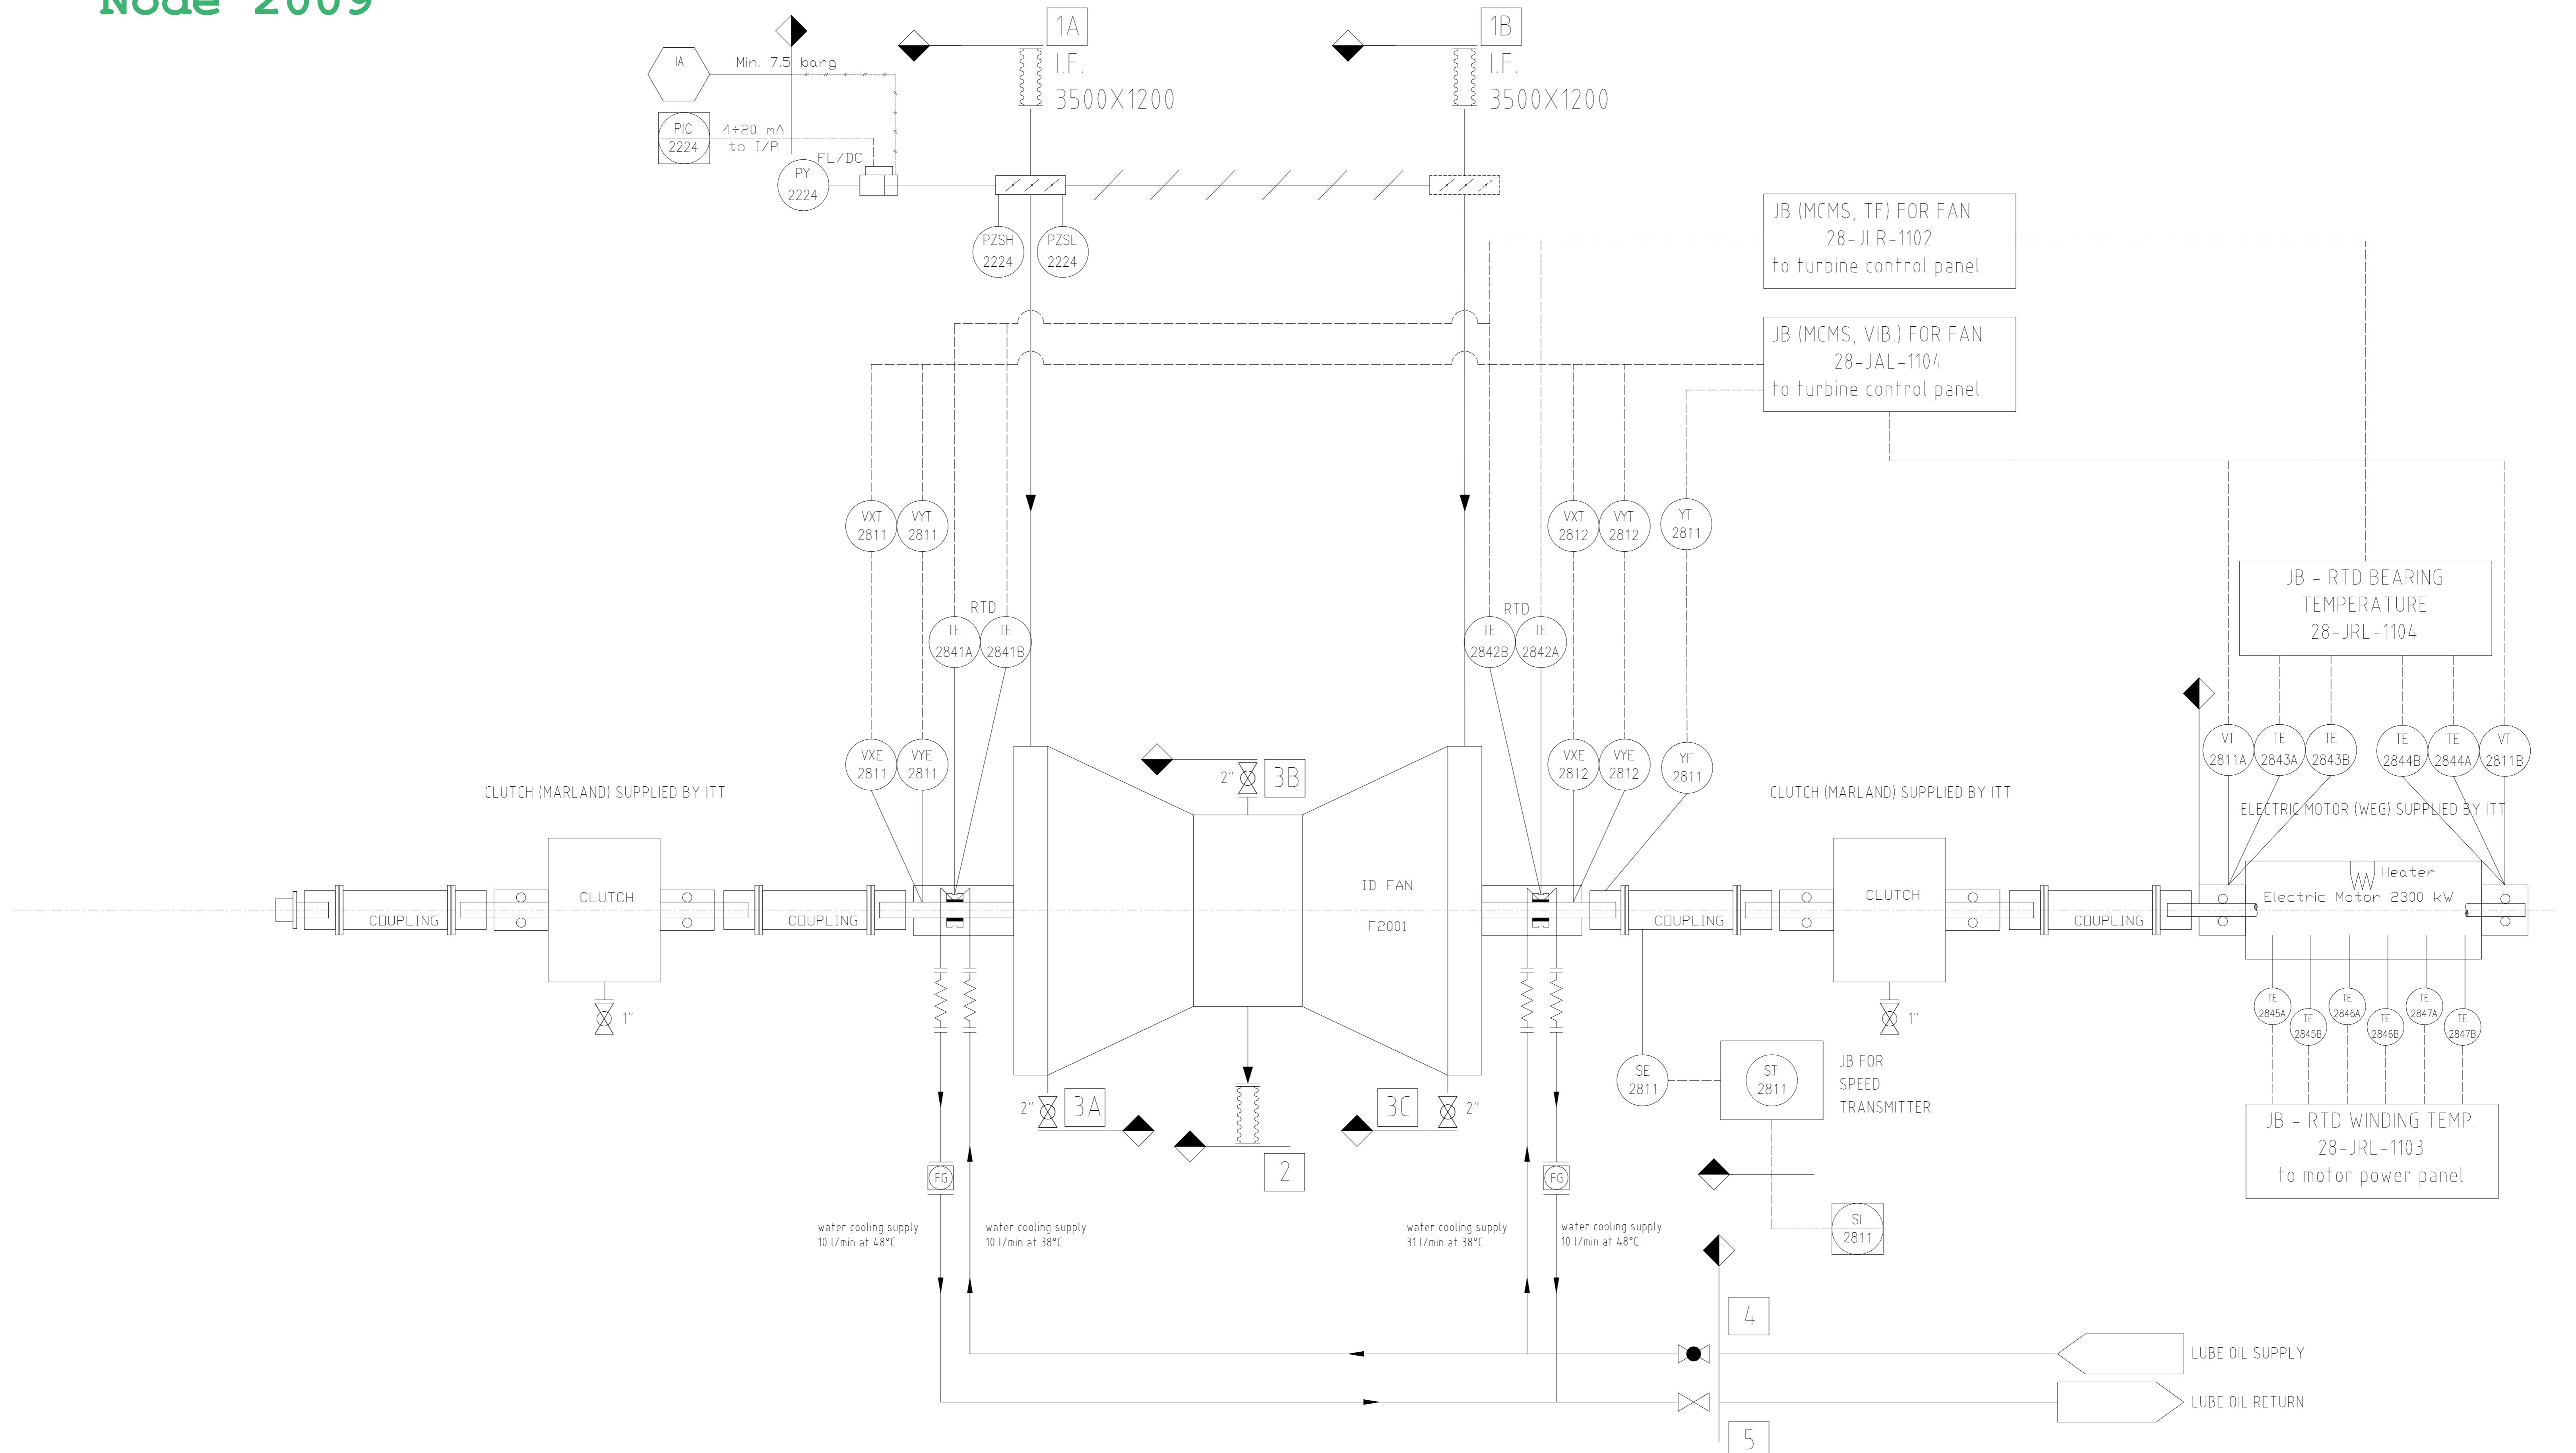

LEGENDA	
MECHANICAL LINK	WATER COOLING LINE
WATER COOLING LINE	Flexible pipe for adjustments
PNEUMATIC SIGNAL LINE	FLOW GLASS
OIL PIPING	FIELD INSTRUMENT
STEAM PIPING	MAIN CONTROL ROOM INSTRUMENT
INSTRUMENT CAPILLARY TUBING	REMOTE/LOCAL PANEL - MOUNTED INSTRUMENT
SOFTWARE LINK	DCS BY CUSTOMER
ELECTRICAL SIGNAL LEAD	INTERLOCK IN CUSTOMER ESD
BALL VALVE	
GLOBE VALVE	
GATE VALVE	
CHECK VALVE	
SAFETY VALVE	
A) ALL OIL PIPING STAINLESS STEEL AISI 316L SCH 40	
B) ALL TUBING AND FITTINGS STAINLESS STEEL AISI 317L	

SE = SPEED PROBE
 VXE = VIBRATION SENSOR AXIS X
 VYE = VIBRATION SENSOR AXIS Y
 YE = KEY PHASOR SENSOR
 VT = VELOMOTOR SENSOR


LIST OF CONNECTION			
POS	SIZE	RATING	SERVICE
1A-1B	I.F. 3500 x 1200	-	INLET COUNTERFLANGE
2	I.F. 2078 x 2514	-	OUTLET COUNTERFLANGE
3A-3B-3C	2"	#150 RF	HOUSING DRAIN
4	1" 1/2	#150 RF	INLET WATER COOLED
5	1" 1/2	#150 RF	OUTLET WATER COOLED


PURCHASER (IT) VENDOR
SCOPE OF SUPPLY

Issued For Comments 26.07.2016 C.V. C.V. N.Z. M.C. GFA
REV. PURPOSE OF ISSUE DATE DESIGN DRAW CHECK REVIEW APPROVE
THIS DOCUMENT IS THE PROPERTY OF TCC. NO PART OF THIS DOCUMENT SHALL BE REPRODUCED OR DISCLOSED TO OTHERS OR USED FOR ANY PURPOSE WHATSOEVER EXCEPT WITH THE PRIOR WRITTEN PERMISSION OF TCC.

OWNER: Middle East
Kimiaye Pars Company

TCC CHINA TIANJIN ENGINEERING CORPORATION	PROJECT MKP Methanol Project	UNIT PRIMARY REFORMER	PHASE DETAIL ENGINEERING	P&ID FOR_FAN_(F-2001)		
				151048-PID-001	OWNER DWG NO. MKP-VD-2000-351-302-A0	
CONTRACTOR HALDOR TOPSØE A/S						
CONTRACTOR I.T.T. SpA - Milano - Italy						
Counter Signing	Sign	Date				
SCALE 1:50	HEET 01	TOT. 01	SIZE A0			

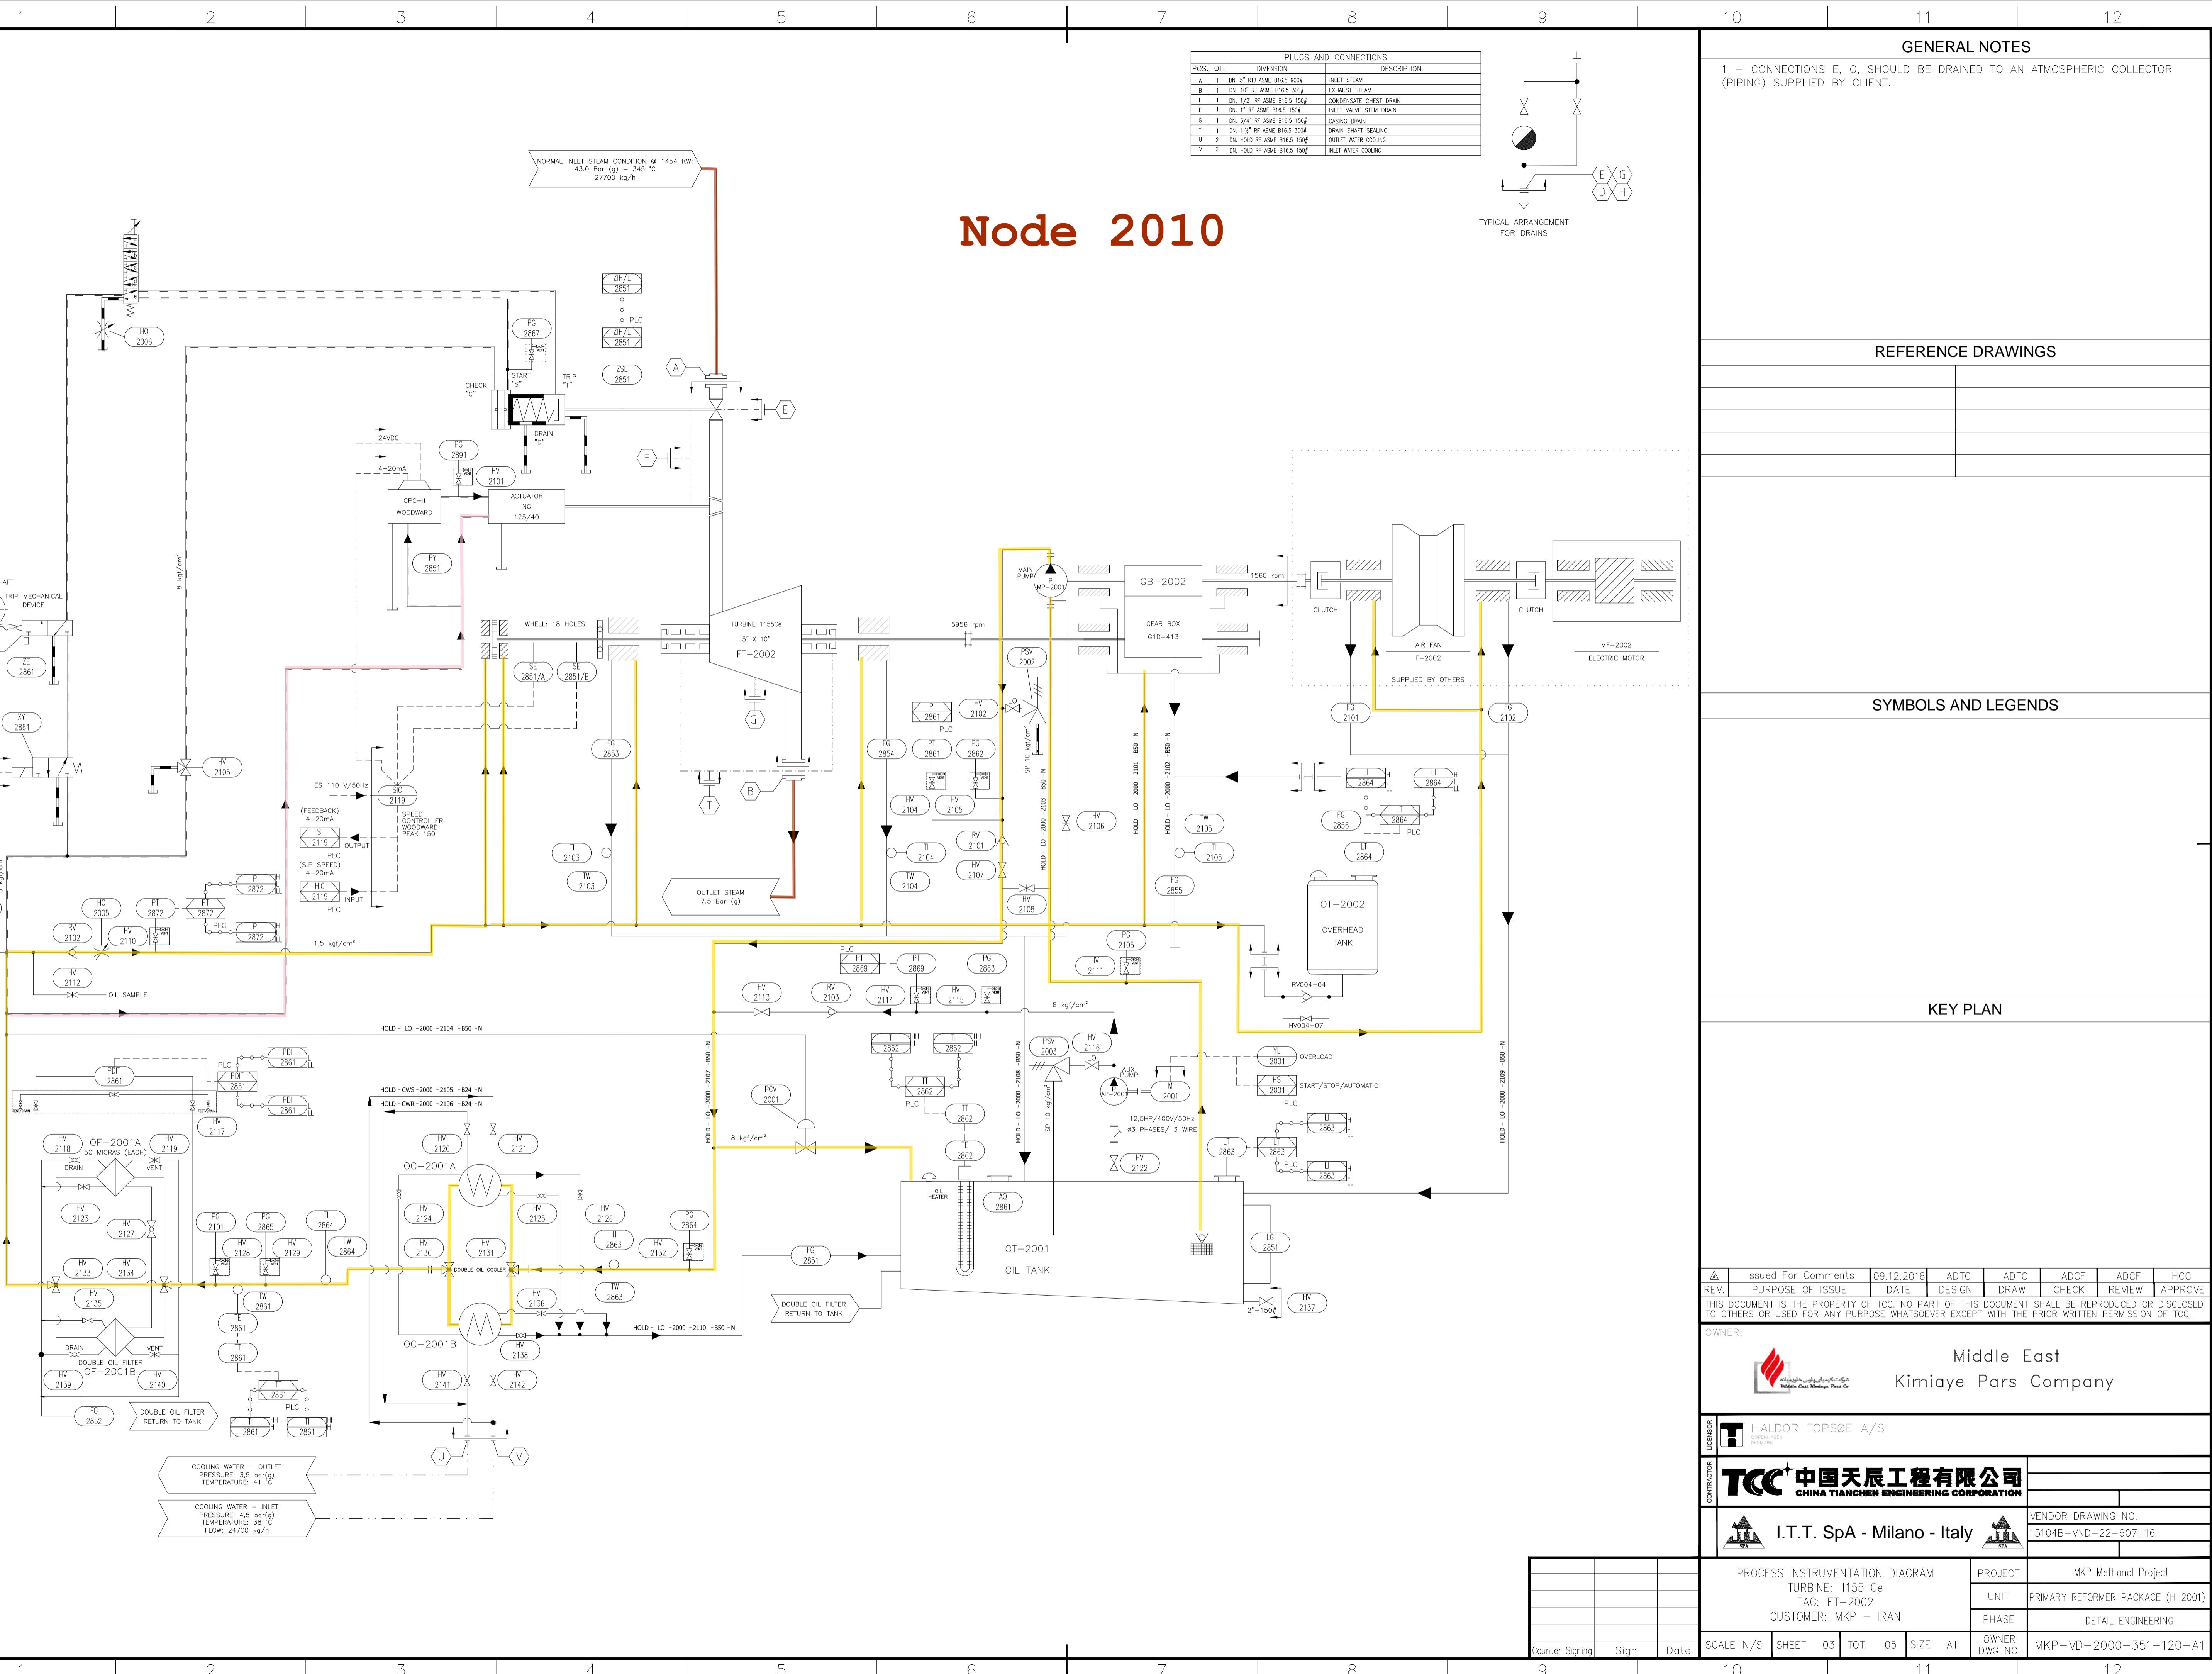

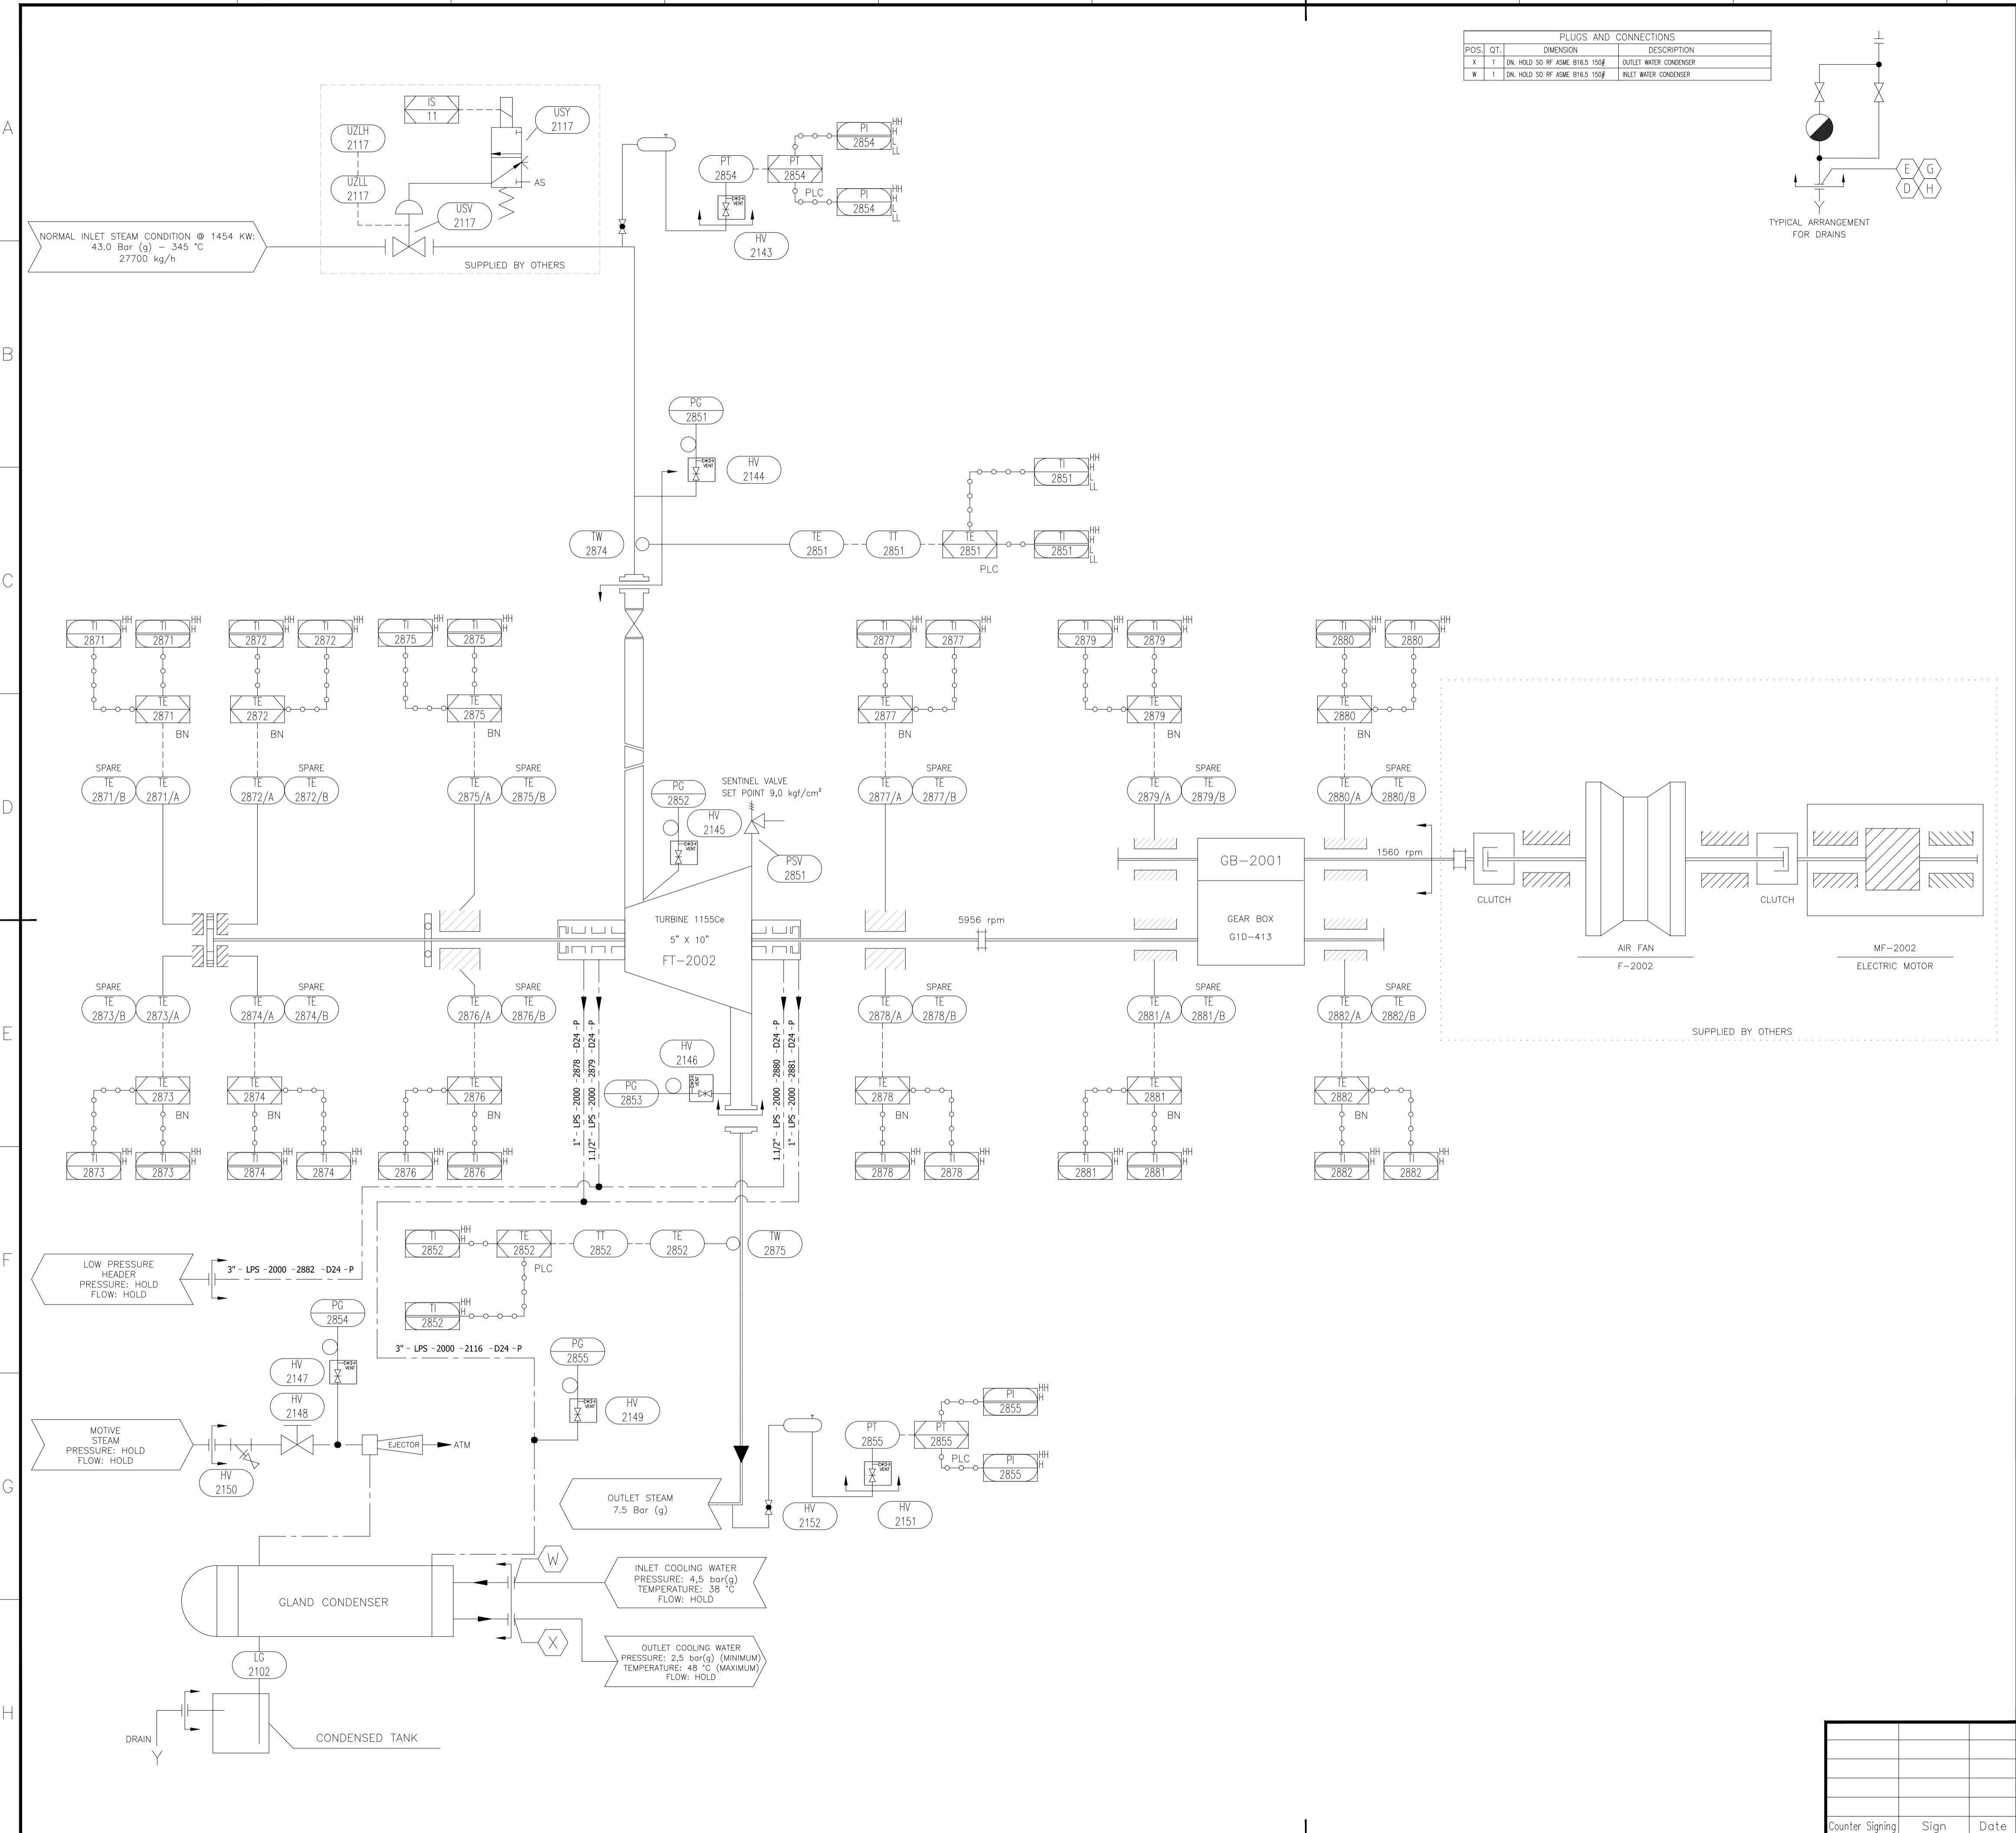

PLUGS AND CONNECTIONS		
. QT.	DIMENSION	DESCRIPTION
1	DN. HOLD SO RF ASME B16.5 150#	OUTLET WATER CONDENSER
1	DN. HOLD SO RF ASME B16.5 150#	INLET WATER CONDENSER


- USV-2101 TO SUPPLIED BY ITT.

GENERAL NOTES

- USV-2101 TO SUPPLIED BY ITT.

REFERENCE DRAWINGS

SYMBOLS AND LEGENDS

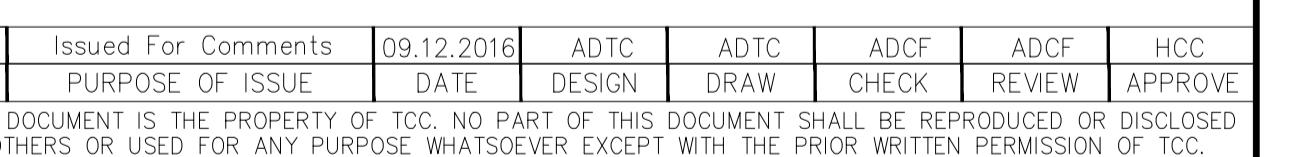

ER:

1

Middle East niave Pars Company

 HALDOR TOPSØE A/S
COPENHAGEN

TCC 中国天辰工程有限公司 CHINA TIANCHEN ENGINEERING CORPORATION

 I.T.T. SpA - Milano - Italy VENDOR DRAWING NO.
15104B-VND-22-607_16

SPA

PROCESS INSTRUMENTATION DIAGRAM PROJECT MKP Methanol Project


TURBINE: 1155 Ce	UNIT	PRIMARY REFORMER PACKAGE (H 2001)
TAC: ET 2002		

TAG: FT-2002						
CUSTOMER: MKP - IRAN	PHASE	DETAIL ENGINEERING	MANUFACTURE	TESTING	DELIVERY	WARRANTY

OWNER	PHASE	DETAIL ENGINEERING


LE N/S SHEET 04 TOT. 05 SIZE A1 OWNER
DWG NO. MKP-VD-2000-351-120-A1

10 11 12

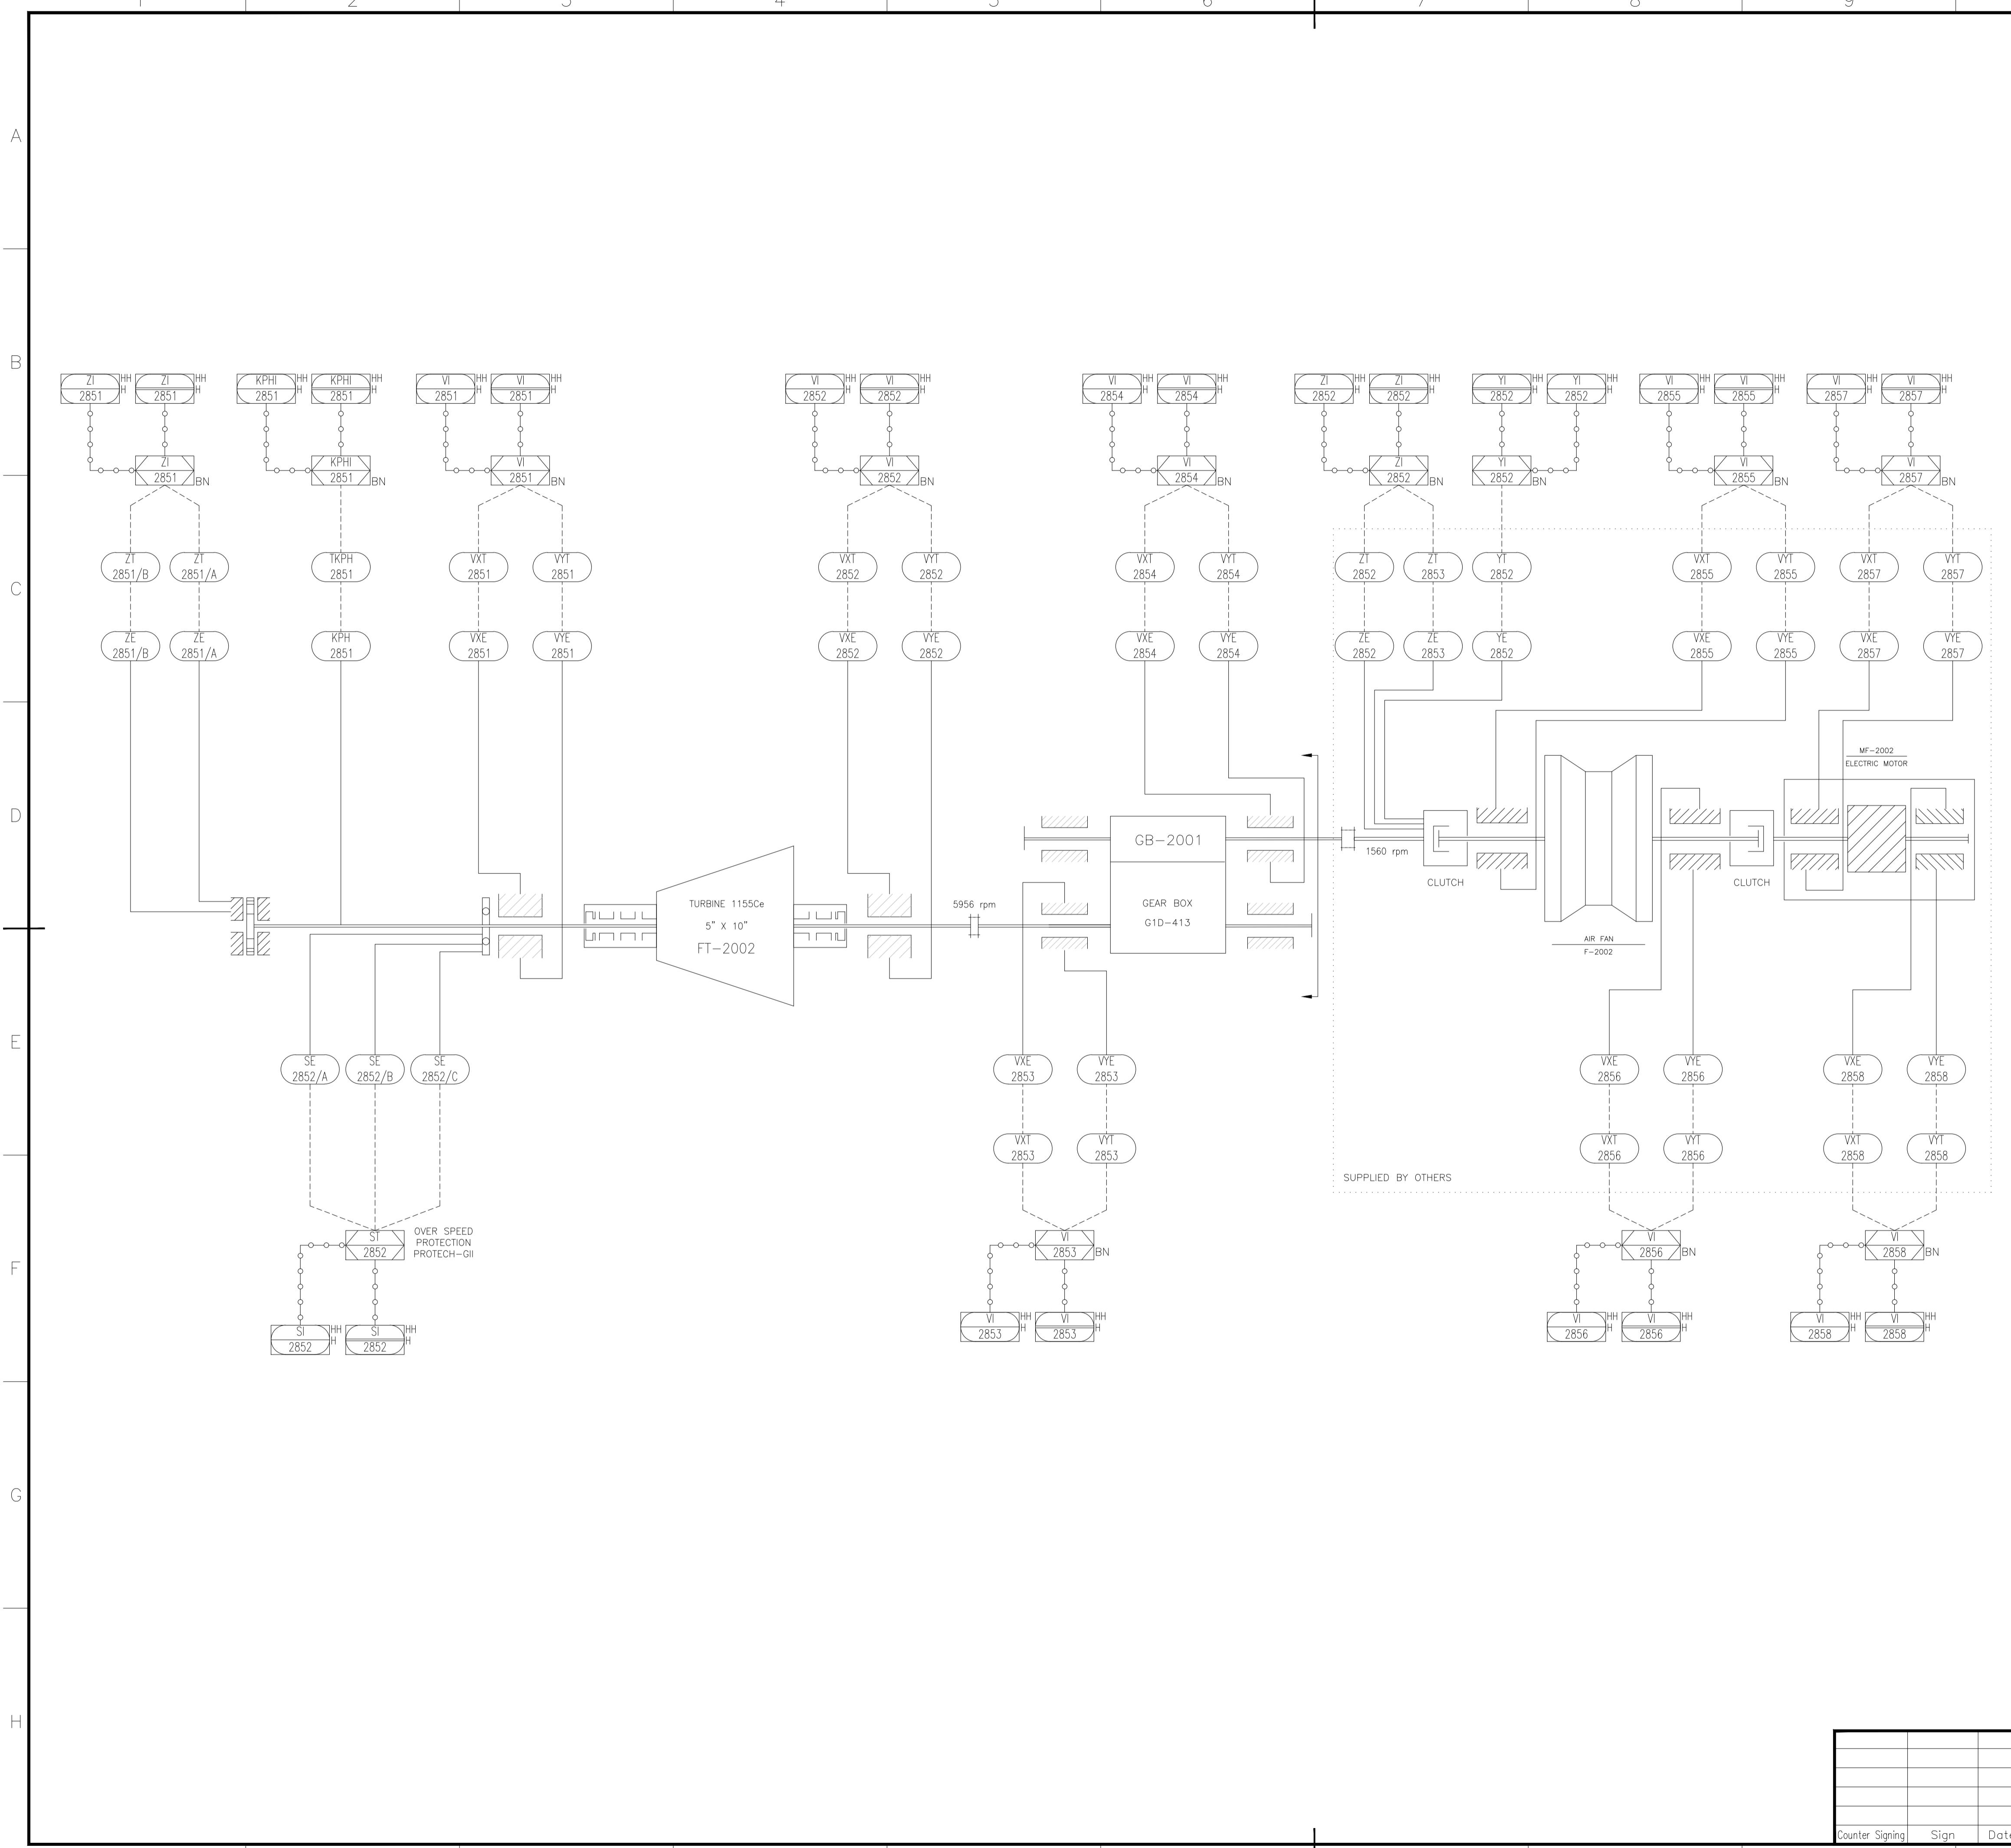

▲ EV.	Issued For Comments	09.12.2016	ADTC	ADTC	ADCF	ADCF	HCC
	PURPOSE OF ISSUE	DATE	DESIGN	DRAW	CHECK	REVIEW	APPROVE
THIS DOCUMENT IS THE PROPERTY OF TCC. NO PART OF THIS DOCUMENT SHALL BE REPRODUCED OR DISCLOSED TO OTHERS OR USED FOR ANY PURPOSE WHATSOEVER EXCEPT WITH THE PRIOR WRITTEN PERMISSION OF TCC.							
OWNER:							
	Middle East Kimiaye Pars Company						G
	HALDOR TOPSØE A/S COPENHAGEN DENMARK						
							
							H
PROCESS INSTRUMENTATION DIAGRAM TURBINE: 1155 Ce TAG: FT-2002 CUSTOMER: MKP – IRAN				PROJECT	VENDOR DRAWING NO. 15104B-VND-22-607_16		
				UNIT	PRIMARY REFORMER PACKAGE (H 2001)		
				PHASE	DETAIL ENGINEERING		
CALE N/S	SHEET 05	TOT. 05	SIZE A1	OWNER DWG NO.	MKP-VD-2000-351-120-A1		

Node 2010

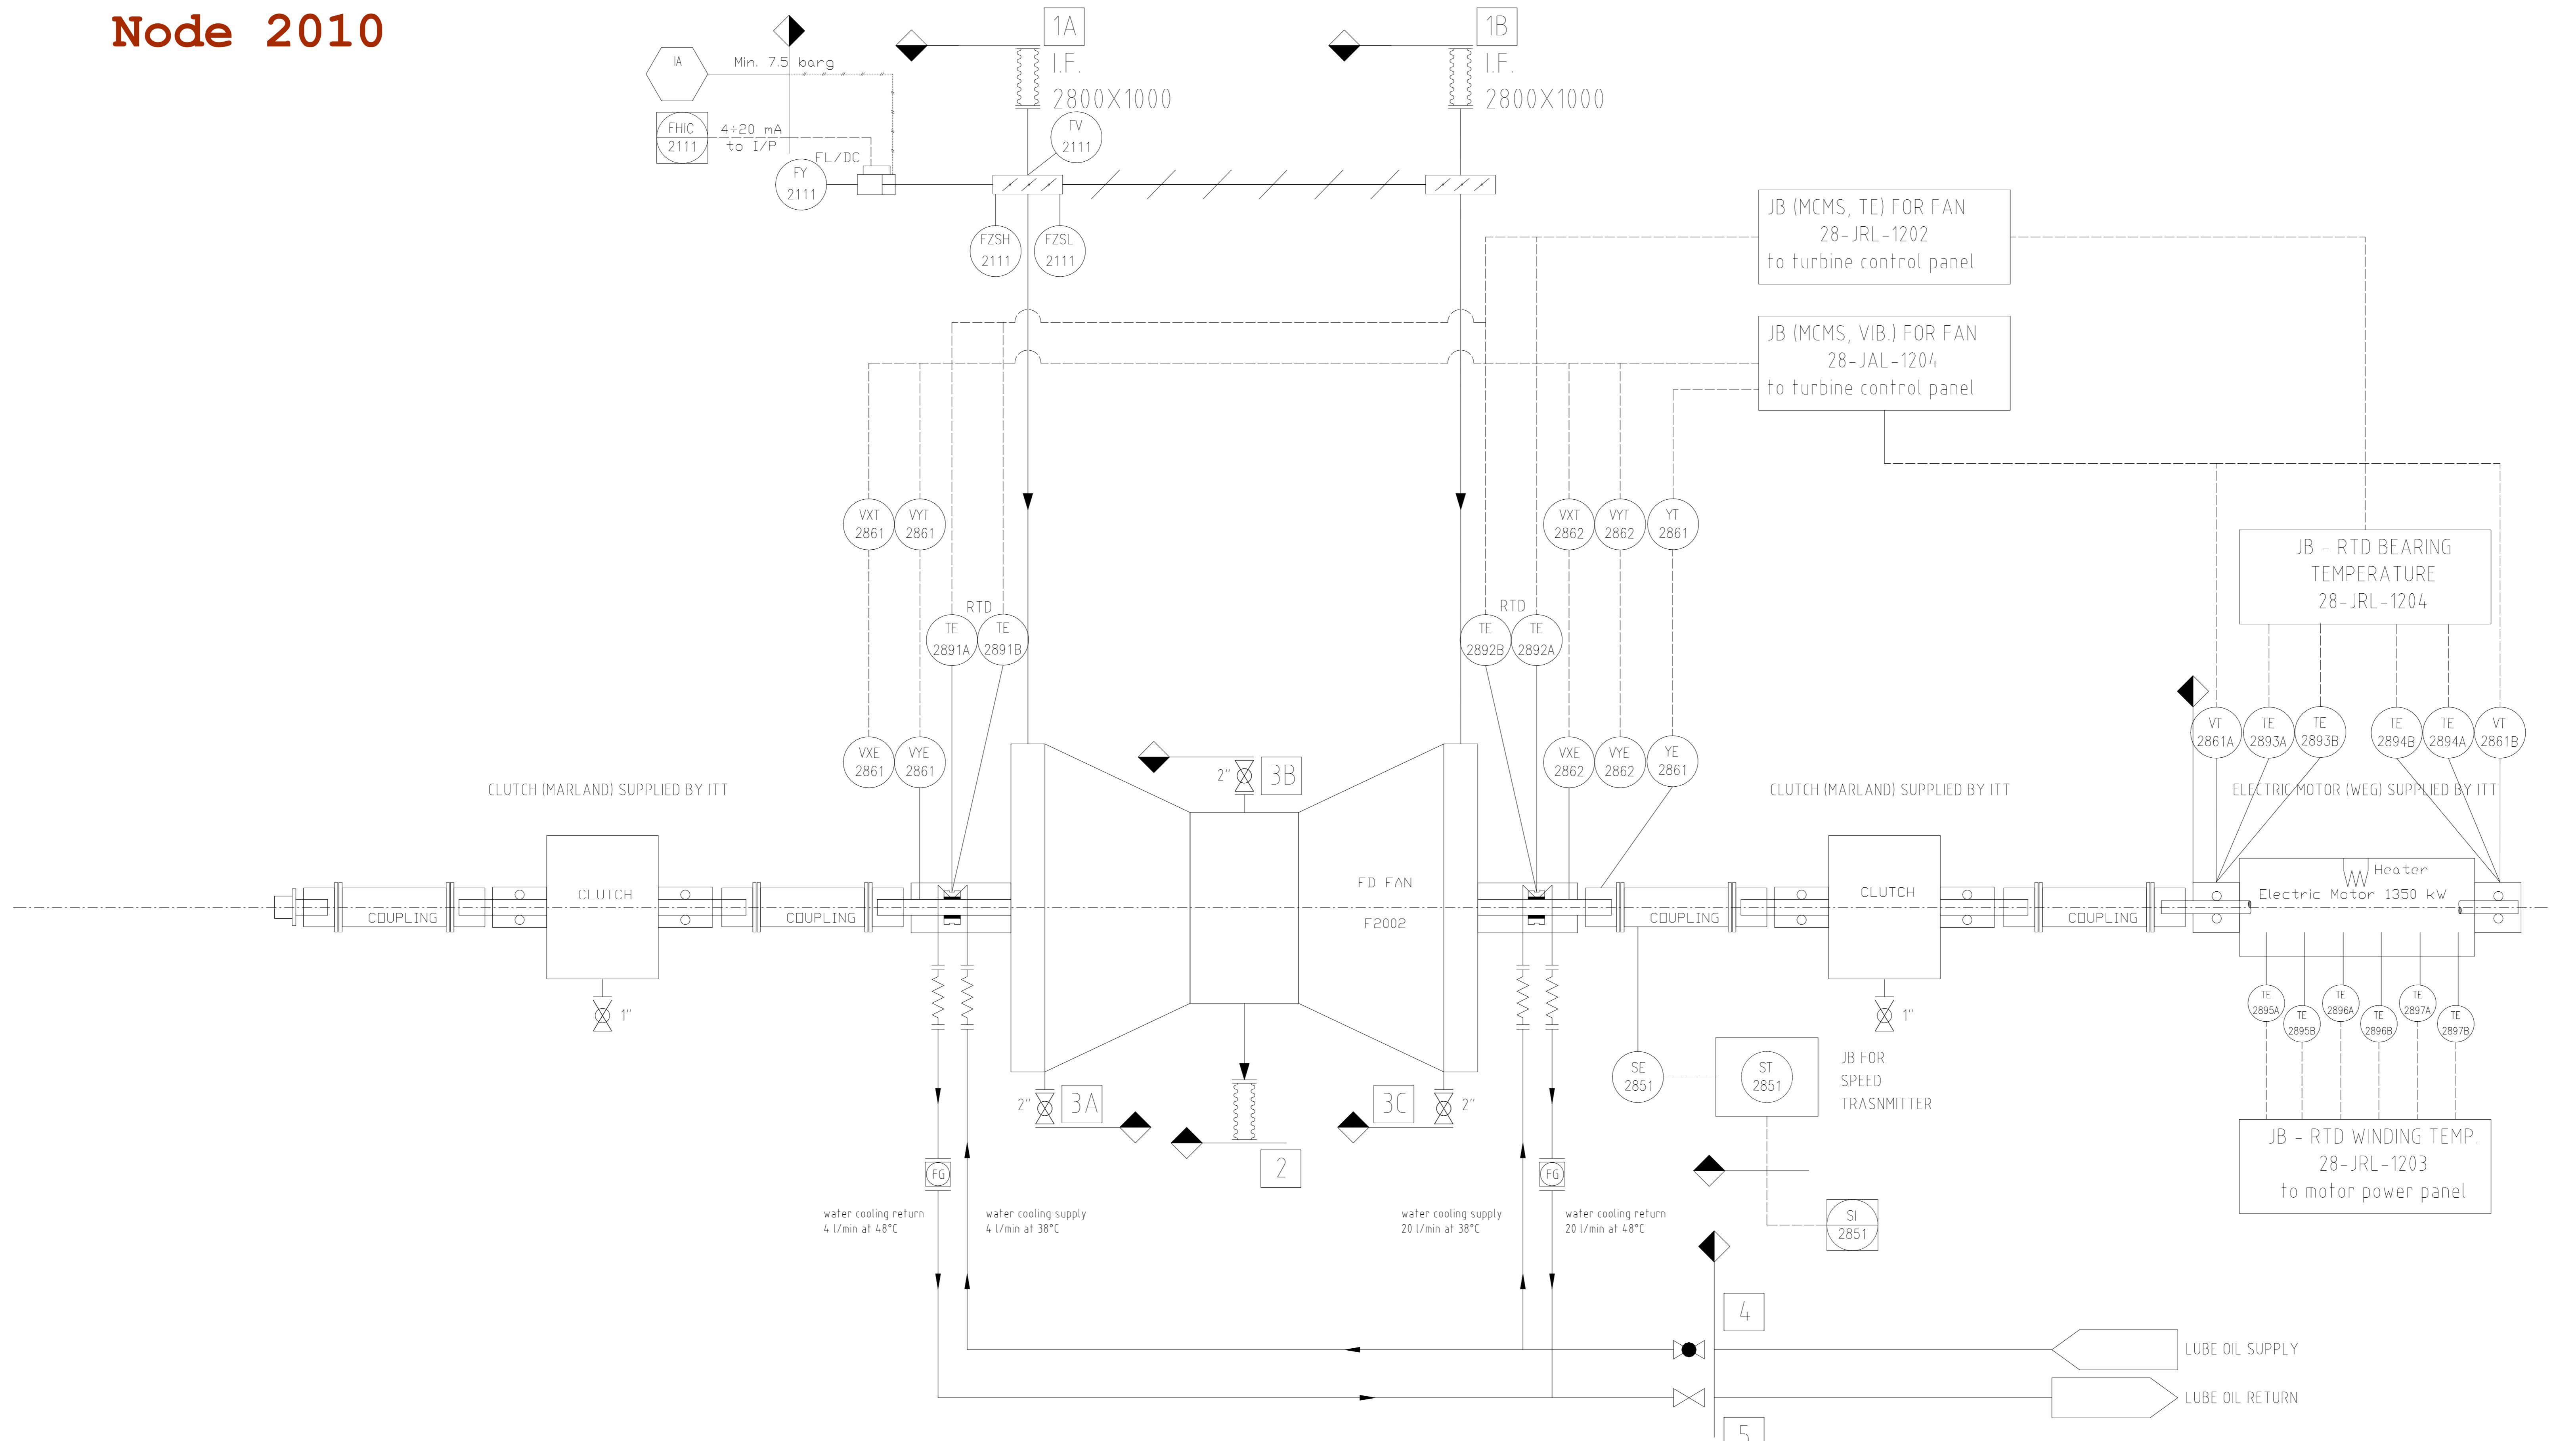

LEGENDA	
MECHANICAL LINK	WATER COOLING LINE
WATER COOLING LINE	Flexible pipe for adjustments
PNEUMATIC SIGNAL LINE	FLOW GLASS
OIL PIPING	FIELD INSTRUMENT
STEAM PIPING	MAIN CONTROL ROOM INSTRUMENT
INSTRUMENT CAPILLARY TUBING	REMOTE/LOCAL PANEL - MOUNTED INSTRUMENT
SOFTWARE LINK	DCS BY CUSTOMER
ELECTRICAL SIGNAL LEAD	INTERLOCK IN CUSTOMER ESD
BALL VALVE	
GLOBE VALVE	
GATE VALVE	
CHECK VALVE	
SAFETY VALVE	
A) ALL OIL PIPING STAINLESS STEEL AISI 316L SCH 40	
B) ALL TUBING AND FITTINGS STAINLESS STEEL AISI 317L	

SE = SPEED PROBE
 VXE = VIBRATION SENSOR AXIS X
 VYE = VIBRATION SENSOR AXIS Y
 YE = KEY PHASOR SENSOR
 VT = VELOMOTOR SENSOR

PURCHASER (ITT) VENDOR (AS)
 SCOPE OF SUPPLY

LIST OF CONNECTION


POS	SIZE	RATING	SERVICE
1A-1B	IF 2800 x 1000	-	INLET COUNTERFLANGE
2	IF 2278 x 1878	-	OUTLET COUNTERFLANGE
3A-3B-3C	2"	#150 RF	HOUSING DRAIN
4	1" 1/2	#150 RF	INLET WATER COOLED
5	1" 1/2	#150 RF	OUTLET WATER COOLED


Issued For Comments 26.07.2016 C.V. C.V. N.Z. M.C. G.F.A.
 REV. PURPOSE OF ISSUE DATE DESIGN DRAW CHECK REVIEW APPROVE
 THIS DOCUMENT IS THE PROPERTY OF TCC. NO PART OF THIS DOCUMENT SHALL BE REPRODUCED OR DISCLOSED TO OTHERS OR USED FOR ANY PURPOSE WHATSOEVER EXCEPT WITH THE PRIOR WRITTEN PERMISSION OF TCC.

OWNER: Middle East
 Kimia Pars Company

CONTRACTOR	HALDOR TOPSOE A/S	TCC 中国天辰工程有限公司 CHINA TIANCHEN ENGINEERING CORPORATION	I.T.T. SpA - Milano - Italy	PROJECT	M&P Methanol Project
				UNIT	PRIMARY REFORMER
SCOPE OF WORK				PHASE	DETAIL ENGINEERING
				SCALE 1:50	SHEET 01 TOT. 01 SIZE A0
				OWNER DWG NO.	M&P-VD-2000-351-303-A0
Counter Signing	Sign	Date			

Node 3006

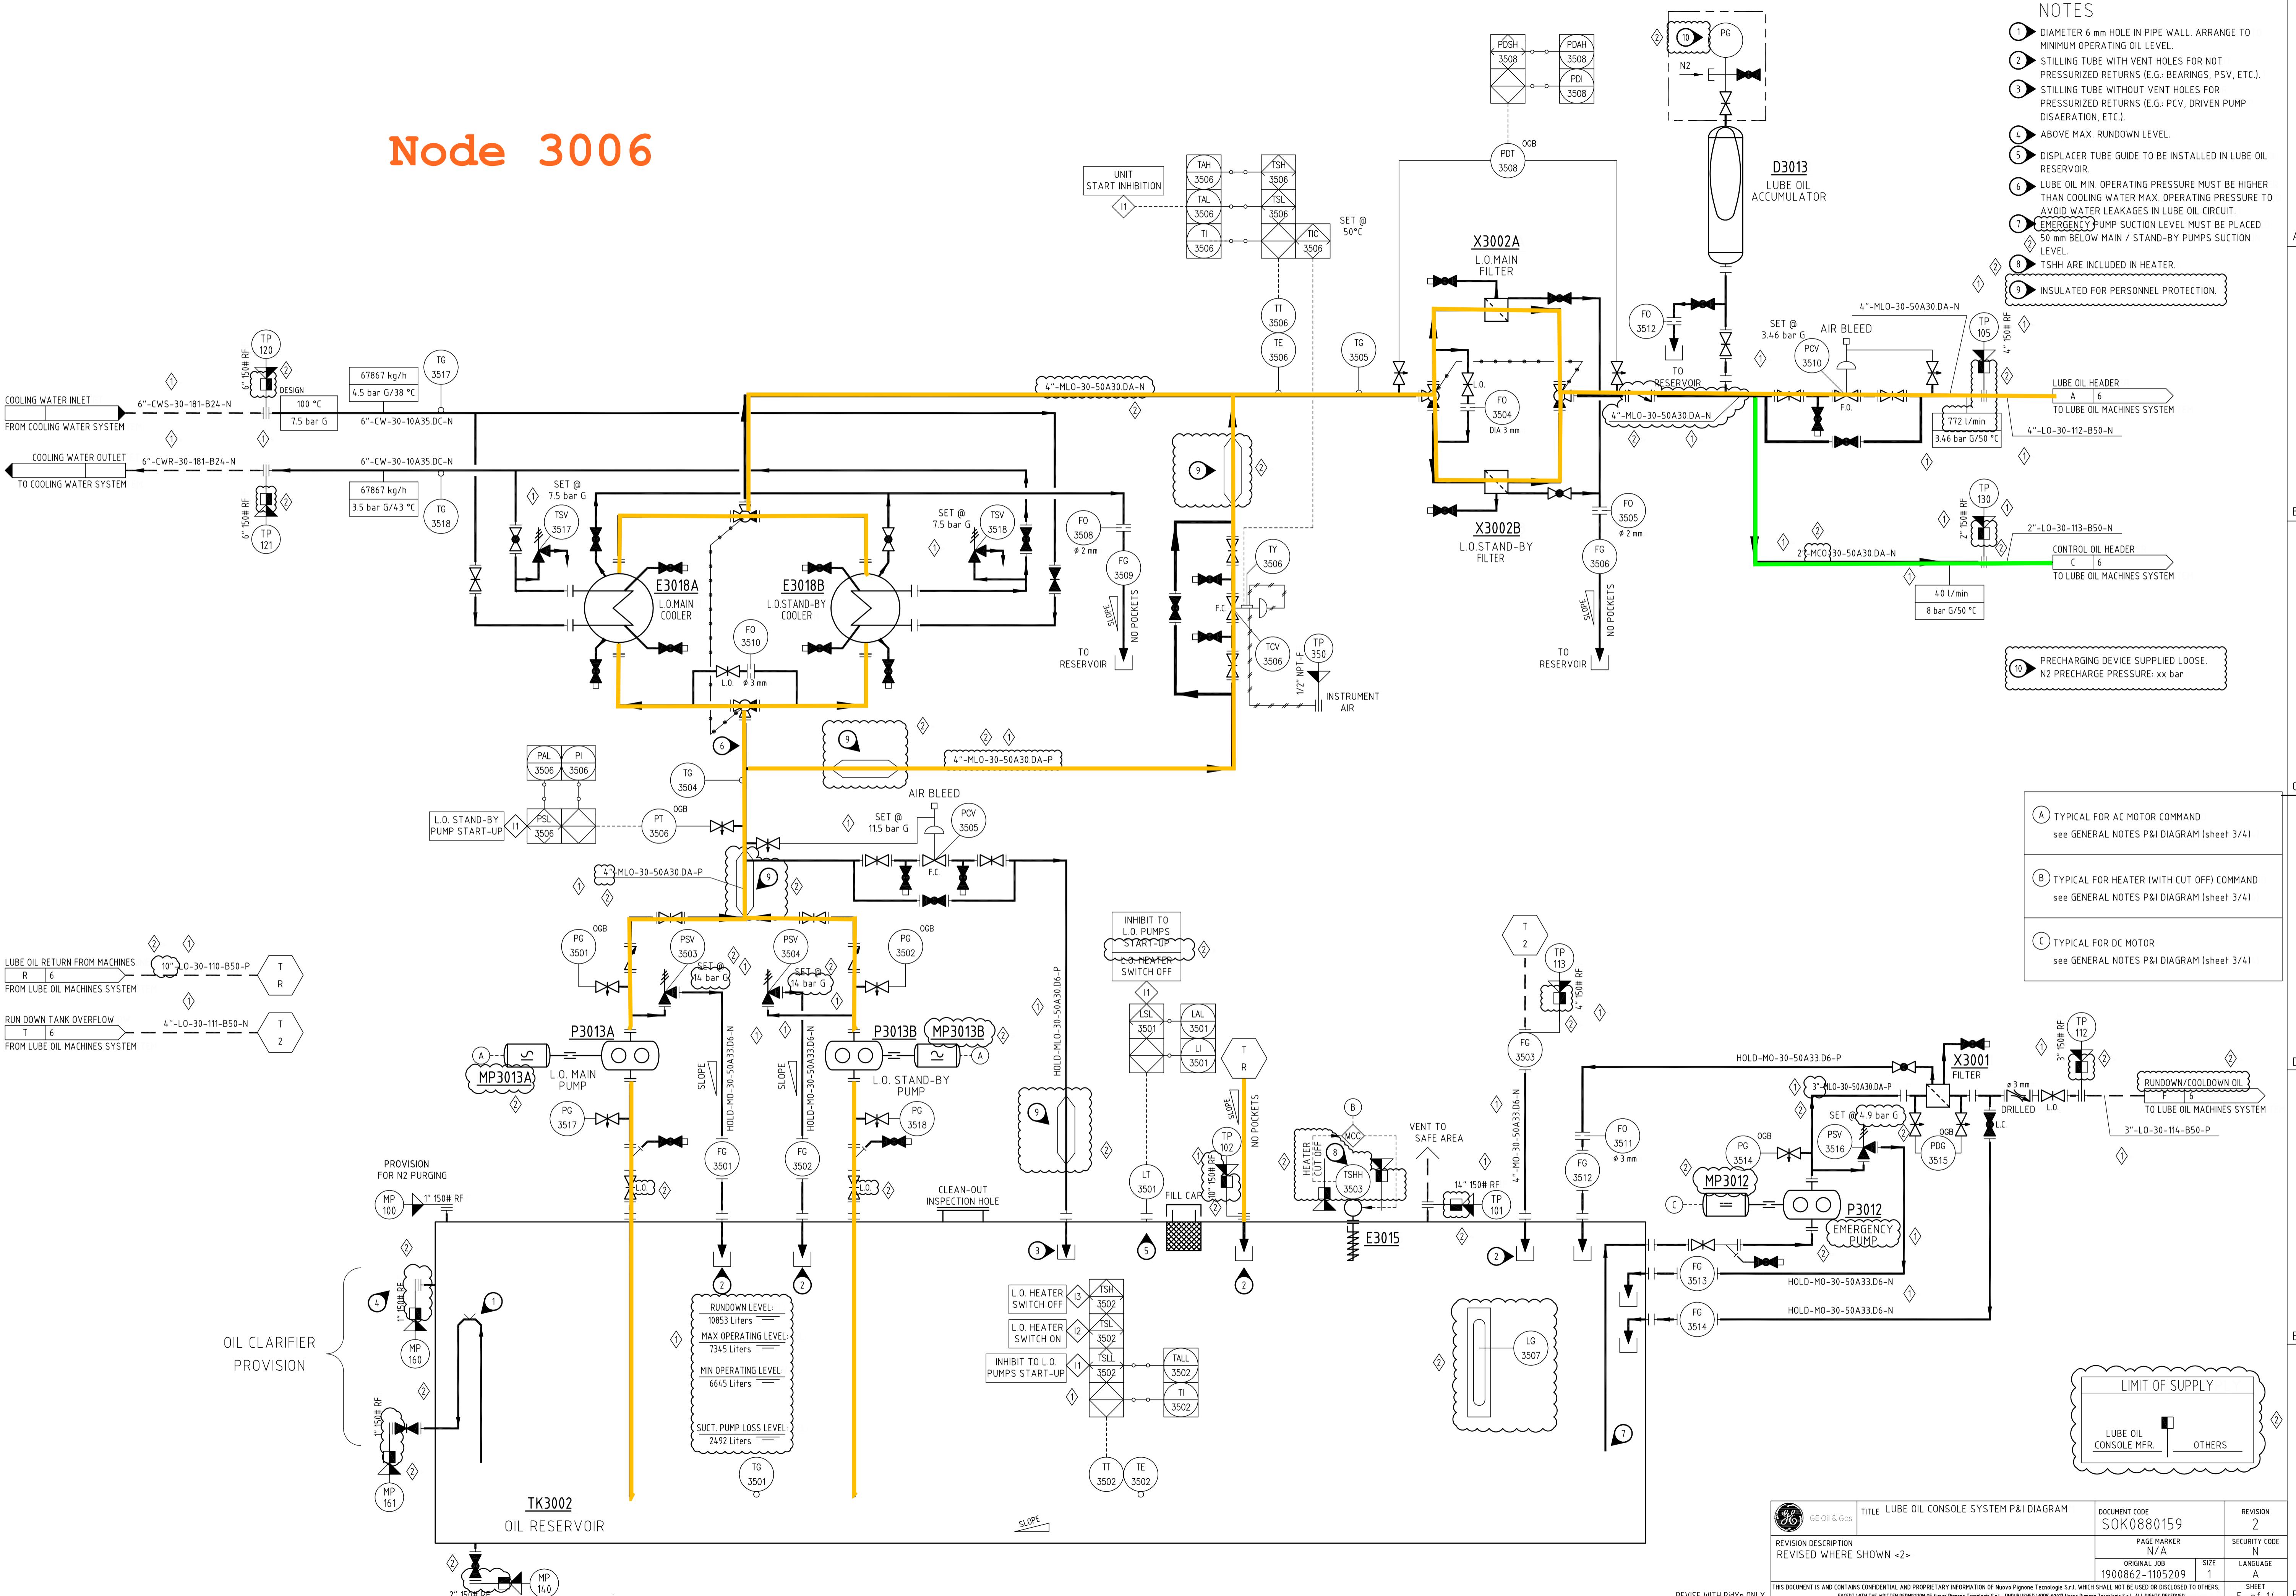


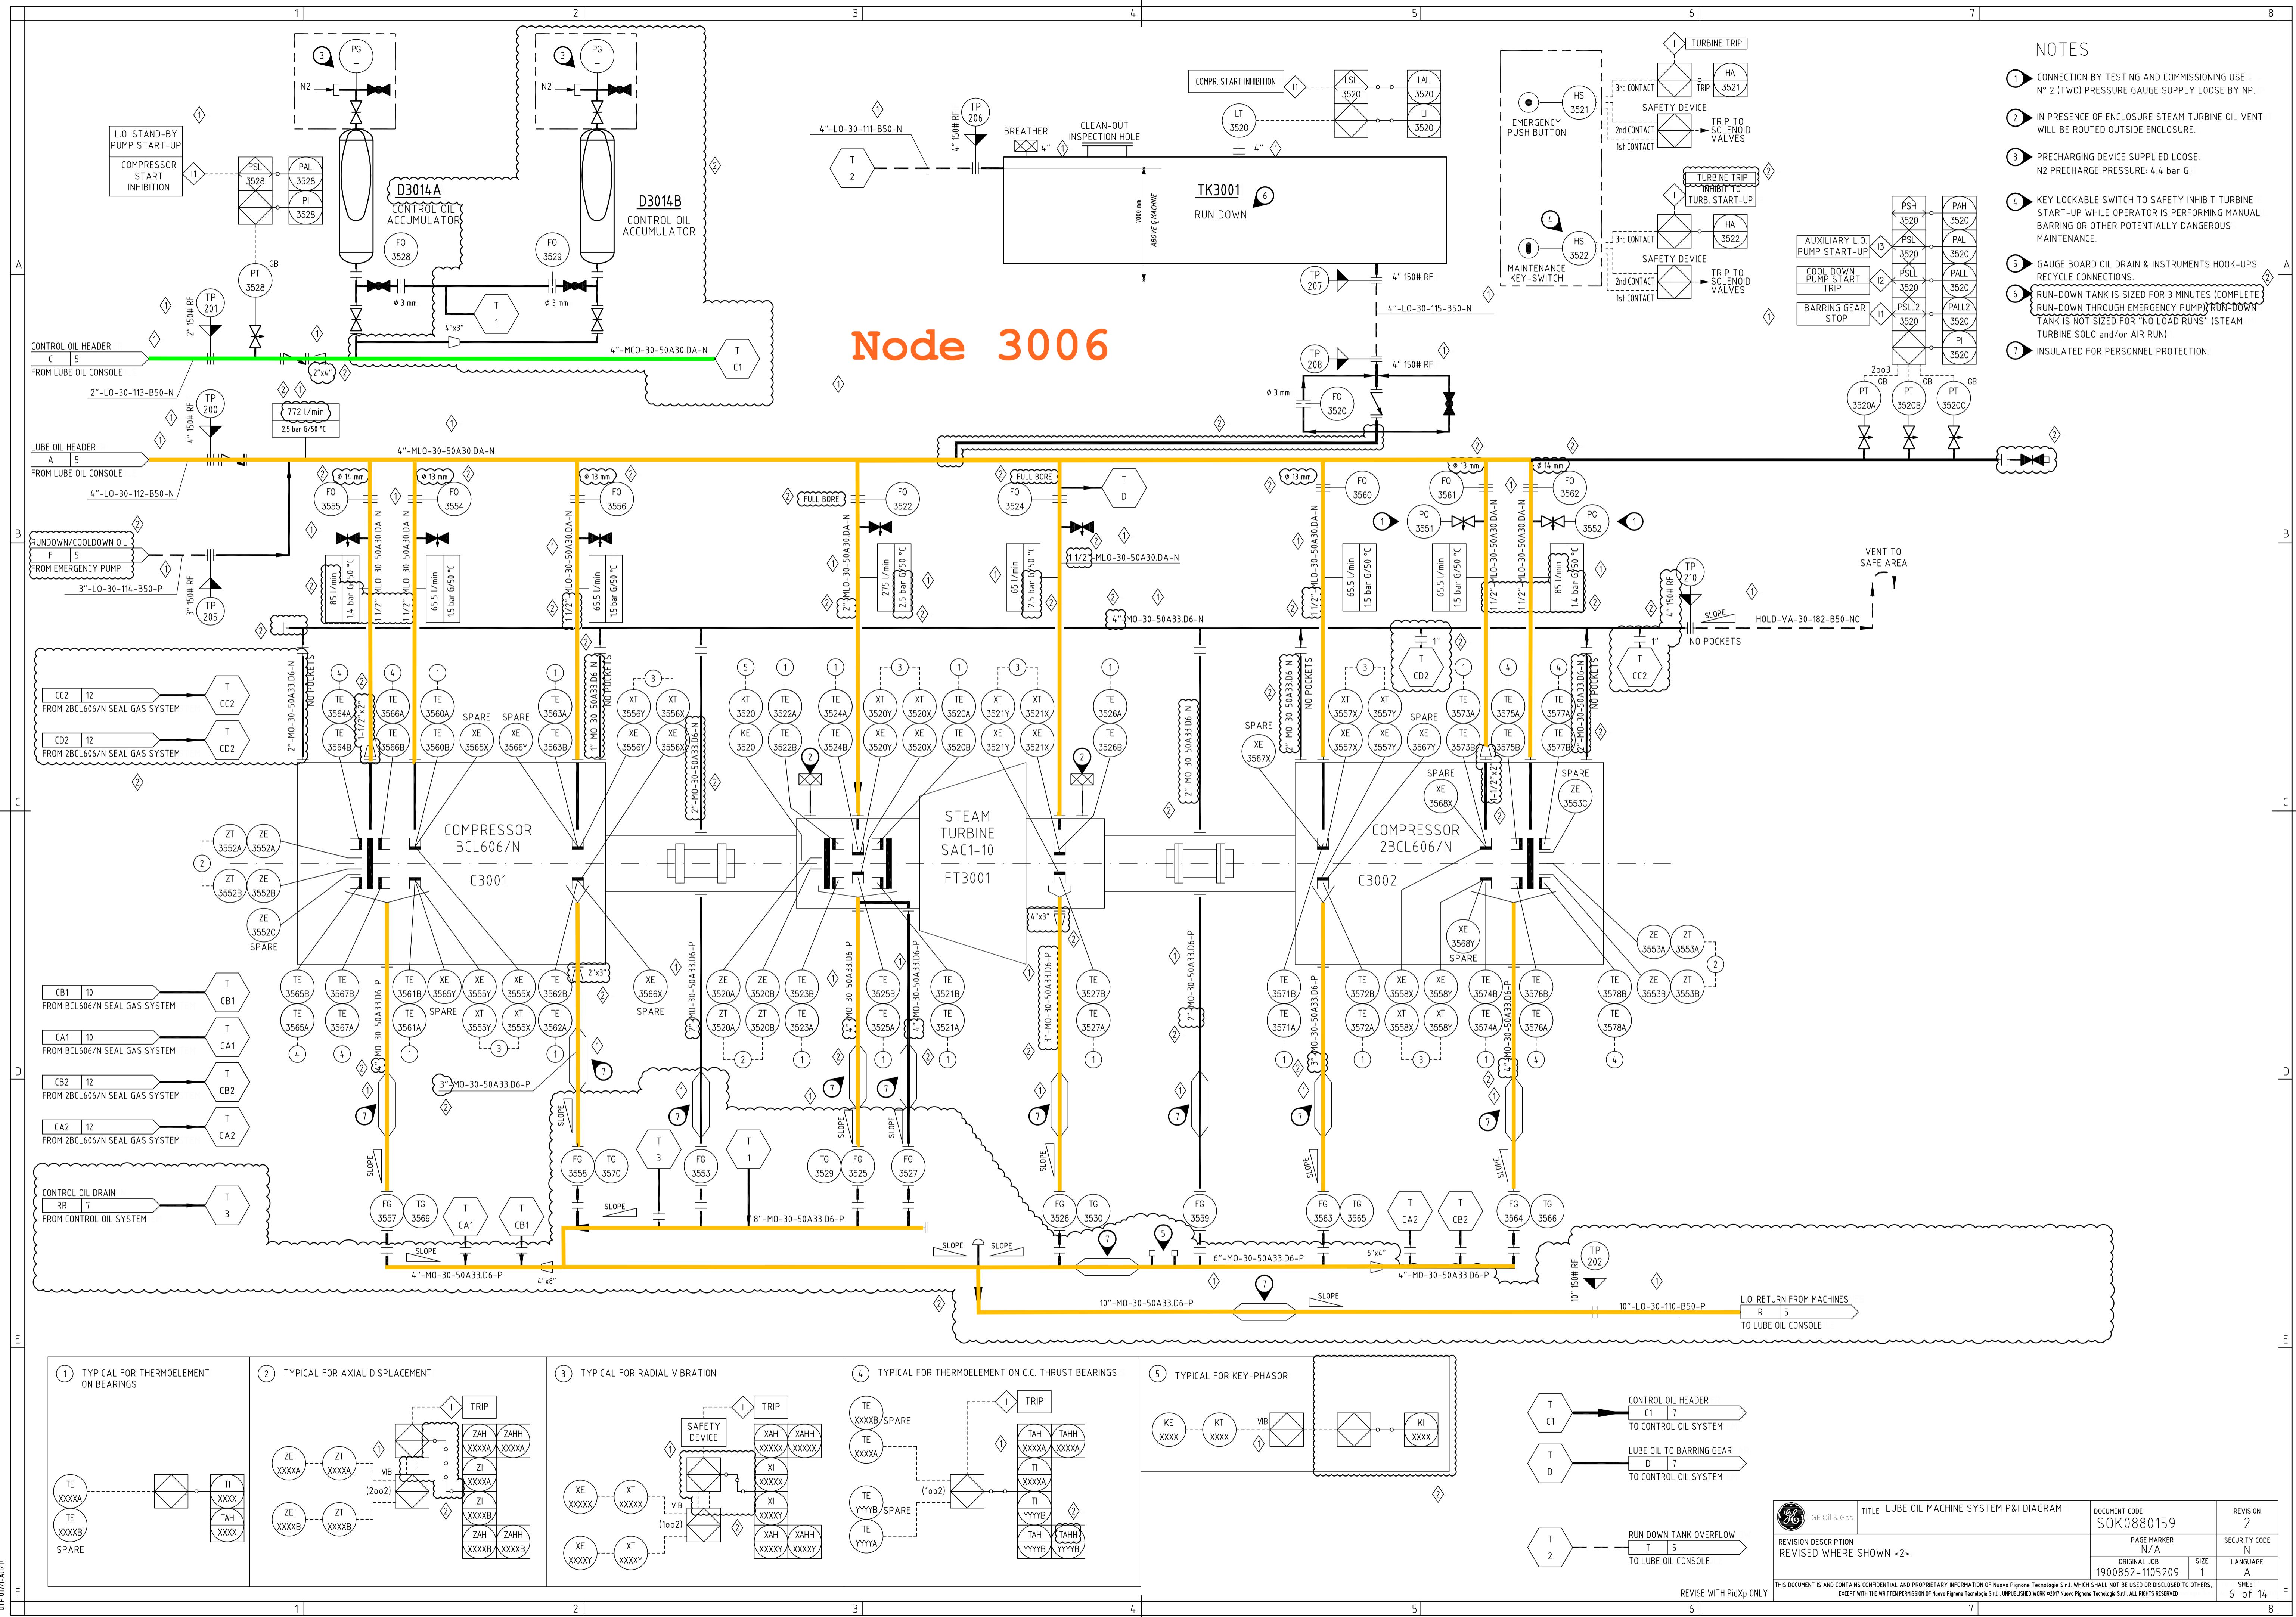

Node 3006

NOTES

- (1) PIPING/TUBING, FITTING, VALVES, ETC... WITH NO RESTRICTION - 1" DIA. AS MINIMUM.
- (2) THIS PIPELINE IS PART OF THE MACHINE.
- (3) TO BE ADJUSTED DURING COMMISSIONING.
- (4) TURBINE THERMAL INSULATION SUPPLIED BY NP.
- (5) BARRING GEAR PROVIDED WITH DEVICE FOR MANUAL TURNING

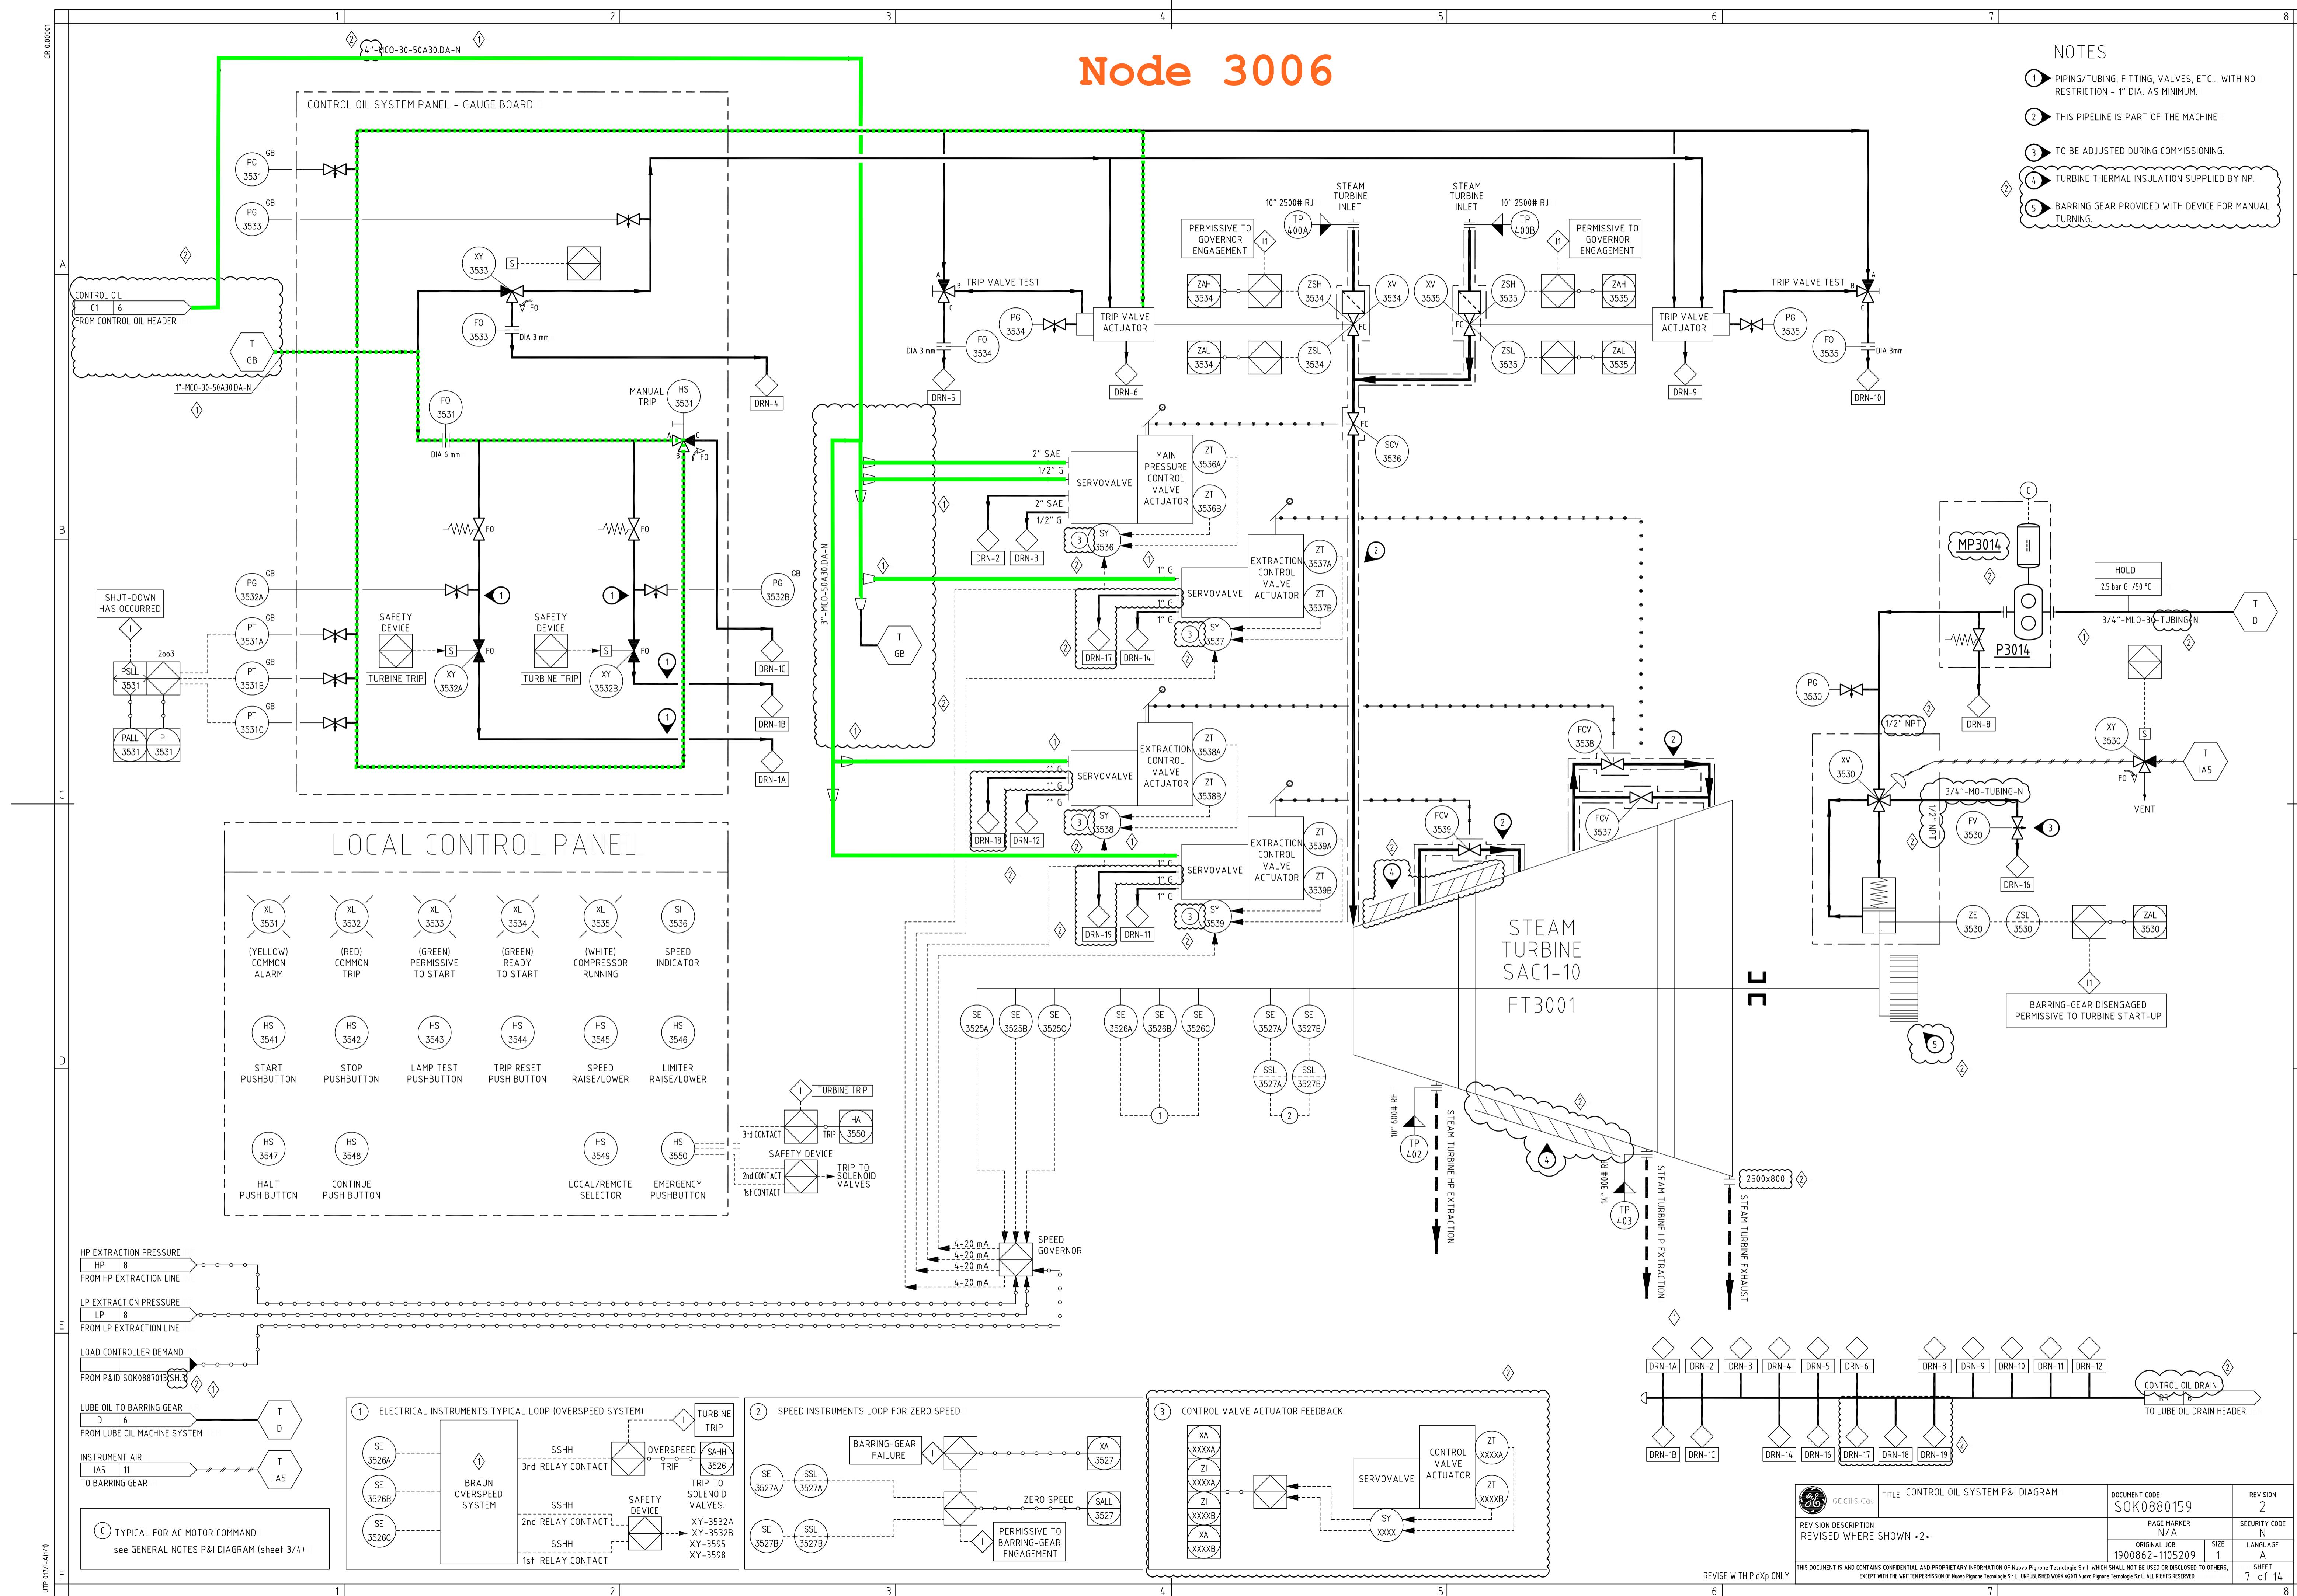


GE Oil & Gas		TITLE CONTROL OIL SYSTEM P&I DIAGRAM		DOCUMENT CODE SOK0880159		REVISION 2	
REVISION DESCRIPTION REVISED WHERE SHOWN ~2~		PAGE MARKER N/A		SECURITY CODE N		ORIGINAL 08 1900862-1105209	
SIZE 1		LANGUAGE A		SHEET 1		7 of 14	
THIS DOCUMENT IS AND CONTAINS CONFIDENTIAL AND PROPRIETARY INFORMATION OF Nuovo Pignone Tecnologie S.r.l. WHICH SHALL NOT BE DISCLOSED TO OTHERS, EXCEPT WITH THE WRITTEN PERMISSION OF Nuovo Pignone Tecnologie S.r.l. UNPUBLISHED WORK ©2011 Nuovo Pignone Tecnologie S.r.l. ALL RIGHTS RESERVED							
REVISE WITH PidXp ONLY							

Node 3006


GENERAL NOTE
SYSTEM DESIGN AND OPERATION TO MEET SOL1220838 (STEAM
URBINE INSTALLATION REQUIREMENTS) AND ASME TDP-1-2013
PREVENTION OF WATER DAMAGE TO STEAM TURBINES USED
OR ELECTRIC POWER GENERATION) TO PREVENT WATER
INDUCTION AND ARCHIVE SUITABLE STEAM PROPERTIES AT
ANY OPERATING CONDITIONS.

NOTES


- (1) THIS PIPELINE IS PART OF THE MACHINE.
- (2) THE PLANT DESIGN AND OPERATION MUST BE SUITABLE TO PREVENT ANY INJECTION OF CONDENSATE SLUGS AT ANY TURBINE CONNECTION, TO AVOID RISK OF SEVERE DAMAGES TO THE UNIT (SEE ALSO INSTRUCTION & OPERATING MANUAL); THIS INCLUDE, BUT IS NOT LIMITED TO, A SUITABLE DRAIN SYSTEM (SEE ASME TDP-1-2013). FOR EXTRACTION AND INJECTION LINES, DRAIN SYSTEM MUST BE ALSO ABLE TO AUTOMATICALLY PREVENT CONDENSATE ACCUMULATION AT ANY NORMAL AND ABNORMAL OPERATING CONDITIONS, DURING AND AFTER TURBINE WARM-UP, LIKE LOW FLOW / LOAD OPERATIONS, VALVE(S) CLOSURE AND OTHER.
- (3) PSV TO PROTECT STEAM INLET PIPELINE (SET @ 112 bar G ON STEAM BOILER). IT MUST BE INSTALLED AND PROPERLY SIZED BY CUSTOMER.
- (4) TE SHALL BE MOUNTED IN SUITABLE POSITION (AND AS CLOSE AS POSSIBLE TO STEAM TURBINE FLANGE) TO AVOID ANY POSSIBILITY OF CONDENSATE INLET DURING START-UP PHASE.
- (5) THE DRAINS SHALL BE CONNECTED TO THE HEADER BASED ON PRESSURE DECREASING SEQUENCE IN ORDER TO AVOID ANY POSSIBLE IMPACT DUE TO FLASHING.
- (6) STEAM TURBINE DRAIN LINES HAVE TO BE USED ONLY FOR CASING DRAINING PURPOSE. STEAM LINES HAVE TO BE PROVIDED BY INDEPENDENT DRAINING SYSTEM.
- (7) PIC-3549 PRESSURE CONTROLLER SET-POINT WILL BE TUNED ON SITE ACCORDING TO GE INSTALLATION AND COMMISSIONING PROCEDURE (SIC0056).
- (8) LP STEAM SUPPLY LINES MUST BE EQUIPPED WITH A SUITABLE AUTOMATIC DRAIN SYSTEM TO AVOID CONDENSATE INLET AT TURBINE SEALS AND ACCUMULATION WHEN PVC-3549 IS FULLY CLOSED.
- (9) CUSTOMER TO SIZE ORIFICE IN ORDER TO KEEP THE MINIMUM REQUIRED TEMPERATURE AT BATTERY LIMIT (TP 417) WHEN PVC-3549 IS FULLY CLOSED.
- (10) VALVE SHALL BE MOUNTED IN HORIZONTAL POSITION AND AS CLOSE AS POSSIBLE TO EXTRACTION FLANGE TO MINIMIZE STEAM VOLUME THAT, AFTER VALVE CLOSING, WILL EXPAND IN TURBINE, IN ORDER TO AVOID THE POSSIBILITY OF UNIT OVERSPEED, THE MAXIMUM ALLOWED TRAPPED VOLUME BETWEEN VALVE AND TURBINE CONNECTION INCLUDING PSV BRANCHES HAS TO BE:
- 3 m³ FOR HP STEAM EXTRACTION
- 5 m³ FOR LP STEAM EXTRACTION
- (11) FOR VALVE ACTUATION, SEE CONTROL OIL P&ID.
- (12) PSV FLOW CAPACITY SIZED FOR:
- 286000 kg/h (FOR HP EXTRACTION)
- 172000 kg/h (FOR LP EXTRACTION)
- (13) INSULATED FOR PERSONNEL PROTECTION.
- (14) INSULATED FOR HEAT CONSERVATION.

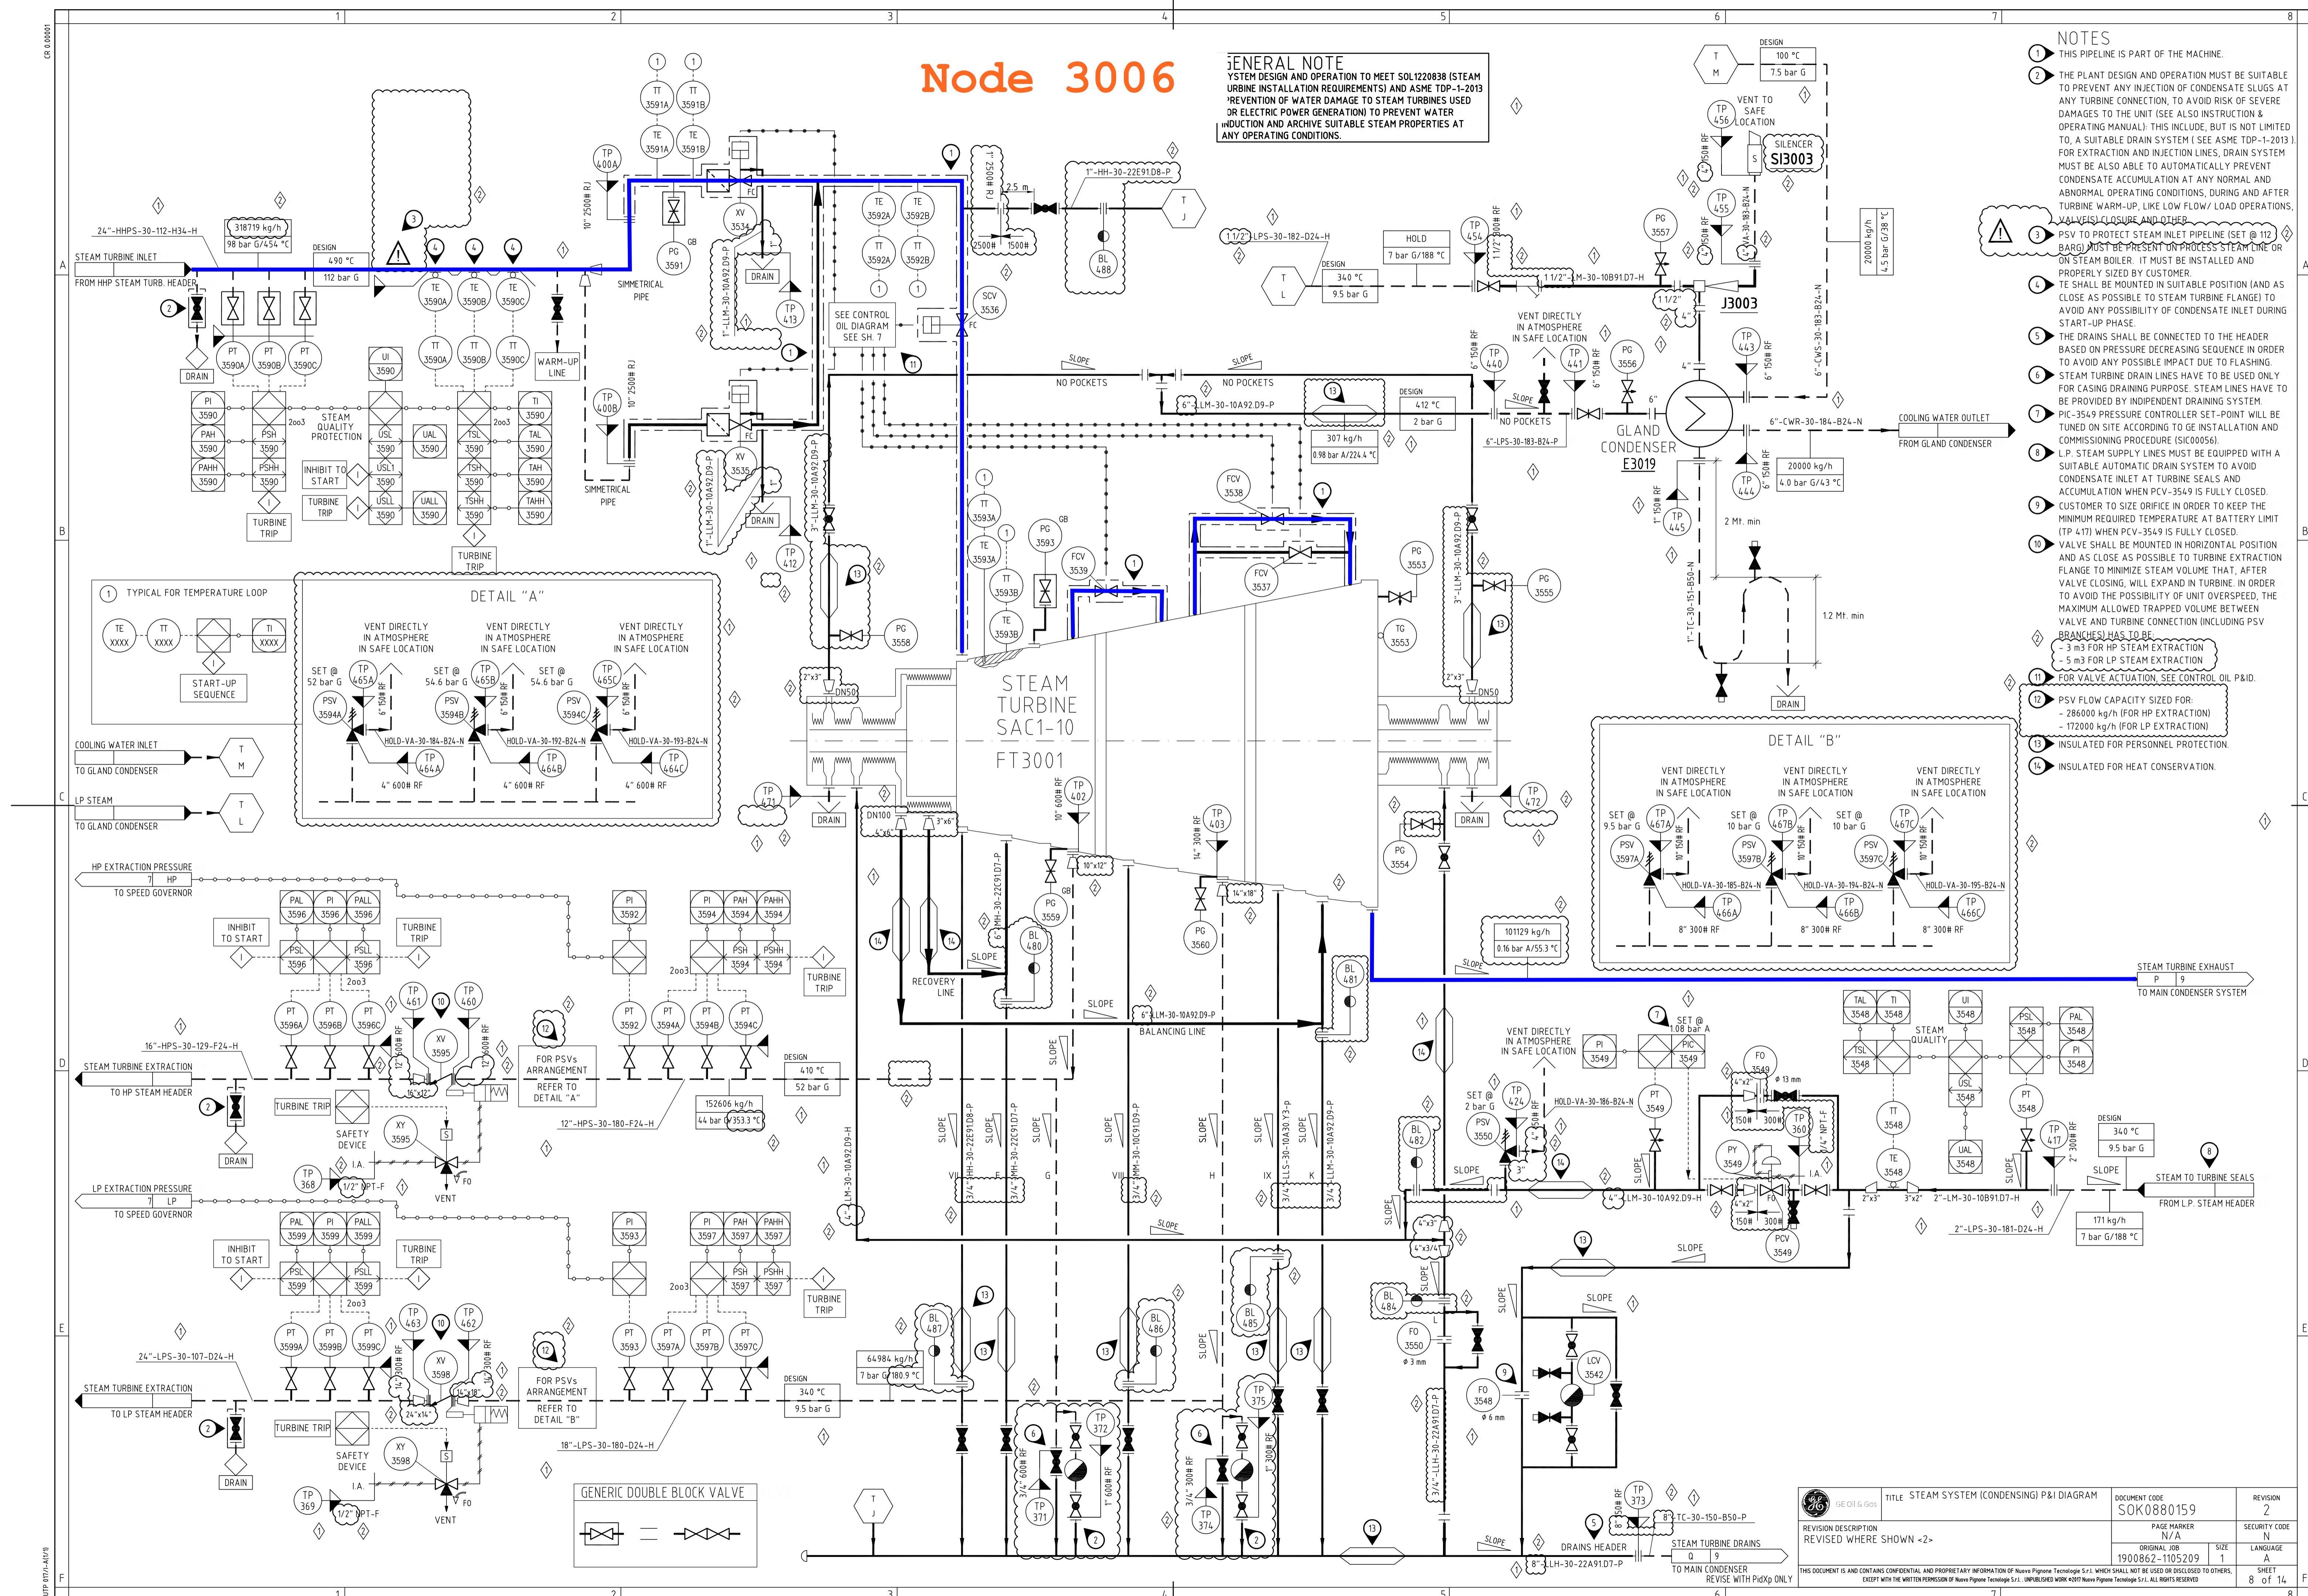


GE Oil & Gas		TITLE STEAM SYSTEM (CONDENSING) P&I DIAGRAM		DOCUMENT CODE SOK0880159		REVISION 2	
REVISION DESCRIPTION REVISED WHERE SHOWN ~2~		PAGE MARKER N/A		SECURITY CODE N		SIZE 1	
ORIGINAL 06 1900862-1105209		LANGUAGE A		SHEET 8 of 14			
THIS DOCUMENT IS AND CONTAINS CONFIDENTIAL AND PROPRIETARY INFORMATION OF Nuovo Pignone Tecnologie S.r.l. WHICH SHALL NOT BE USED OR DISCLOSED TO OTHERS, EXCEPT WITH THE WRITTEN PERMISSION OF Nuovo Pignone Tecnologie S.r.l. UNPUBLISHED WORK ©2019 Nuovo Pignone Tecnologie S.r.l. ALL RIGHTS RESERVED							

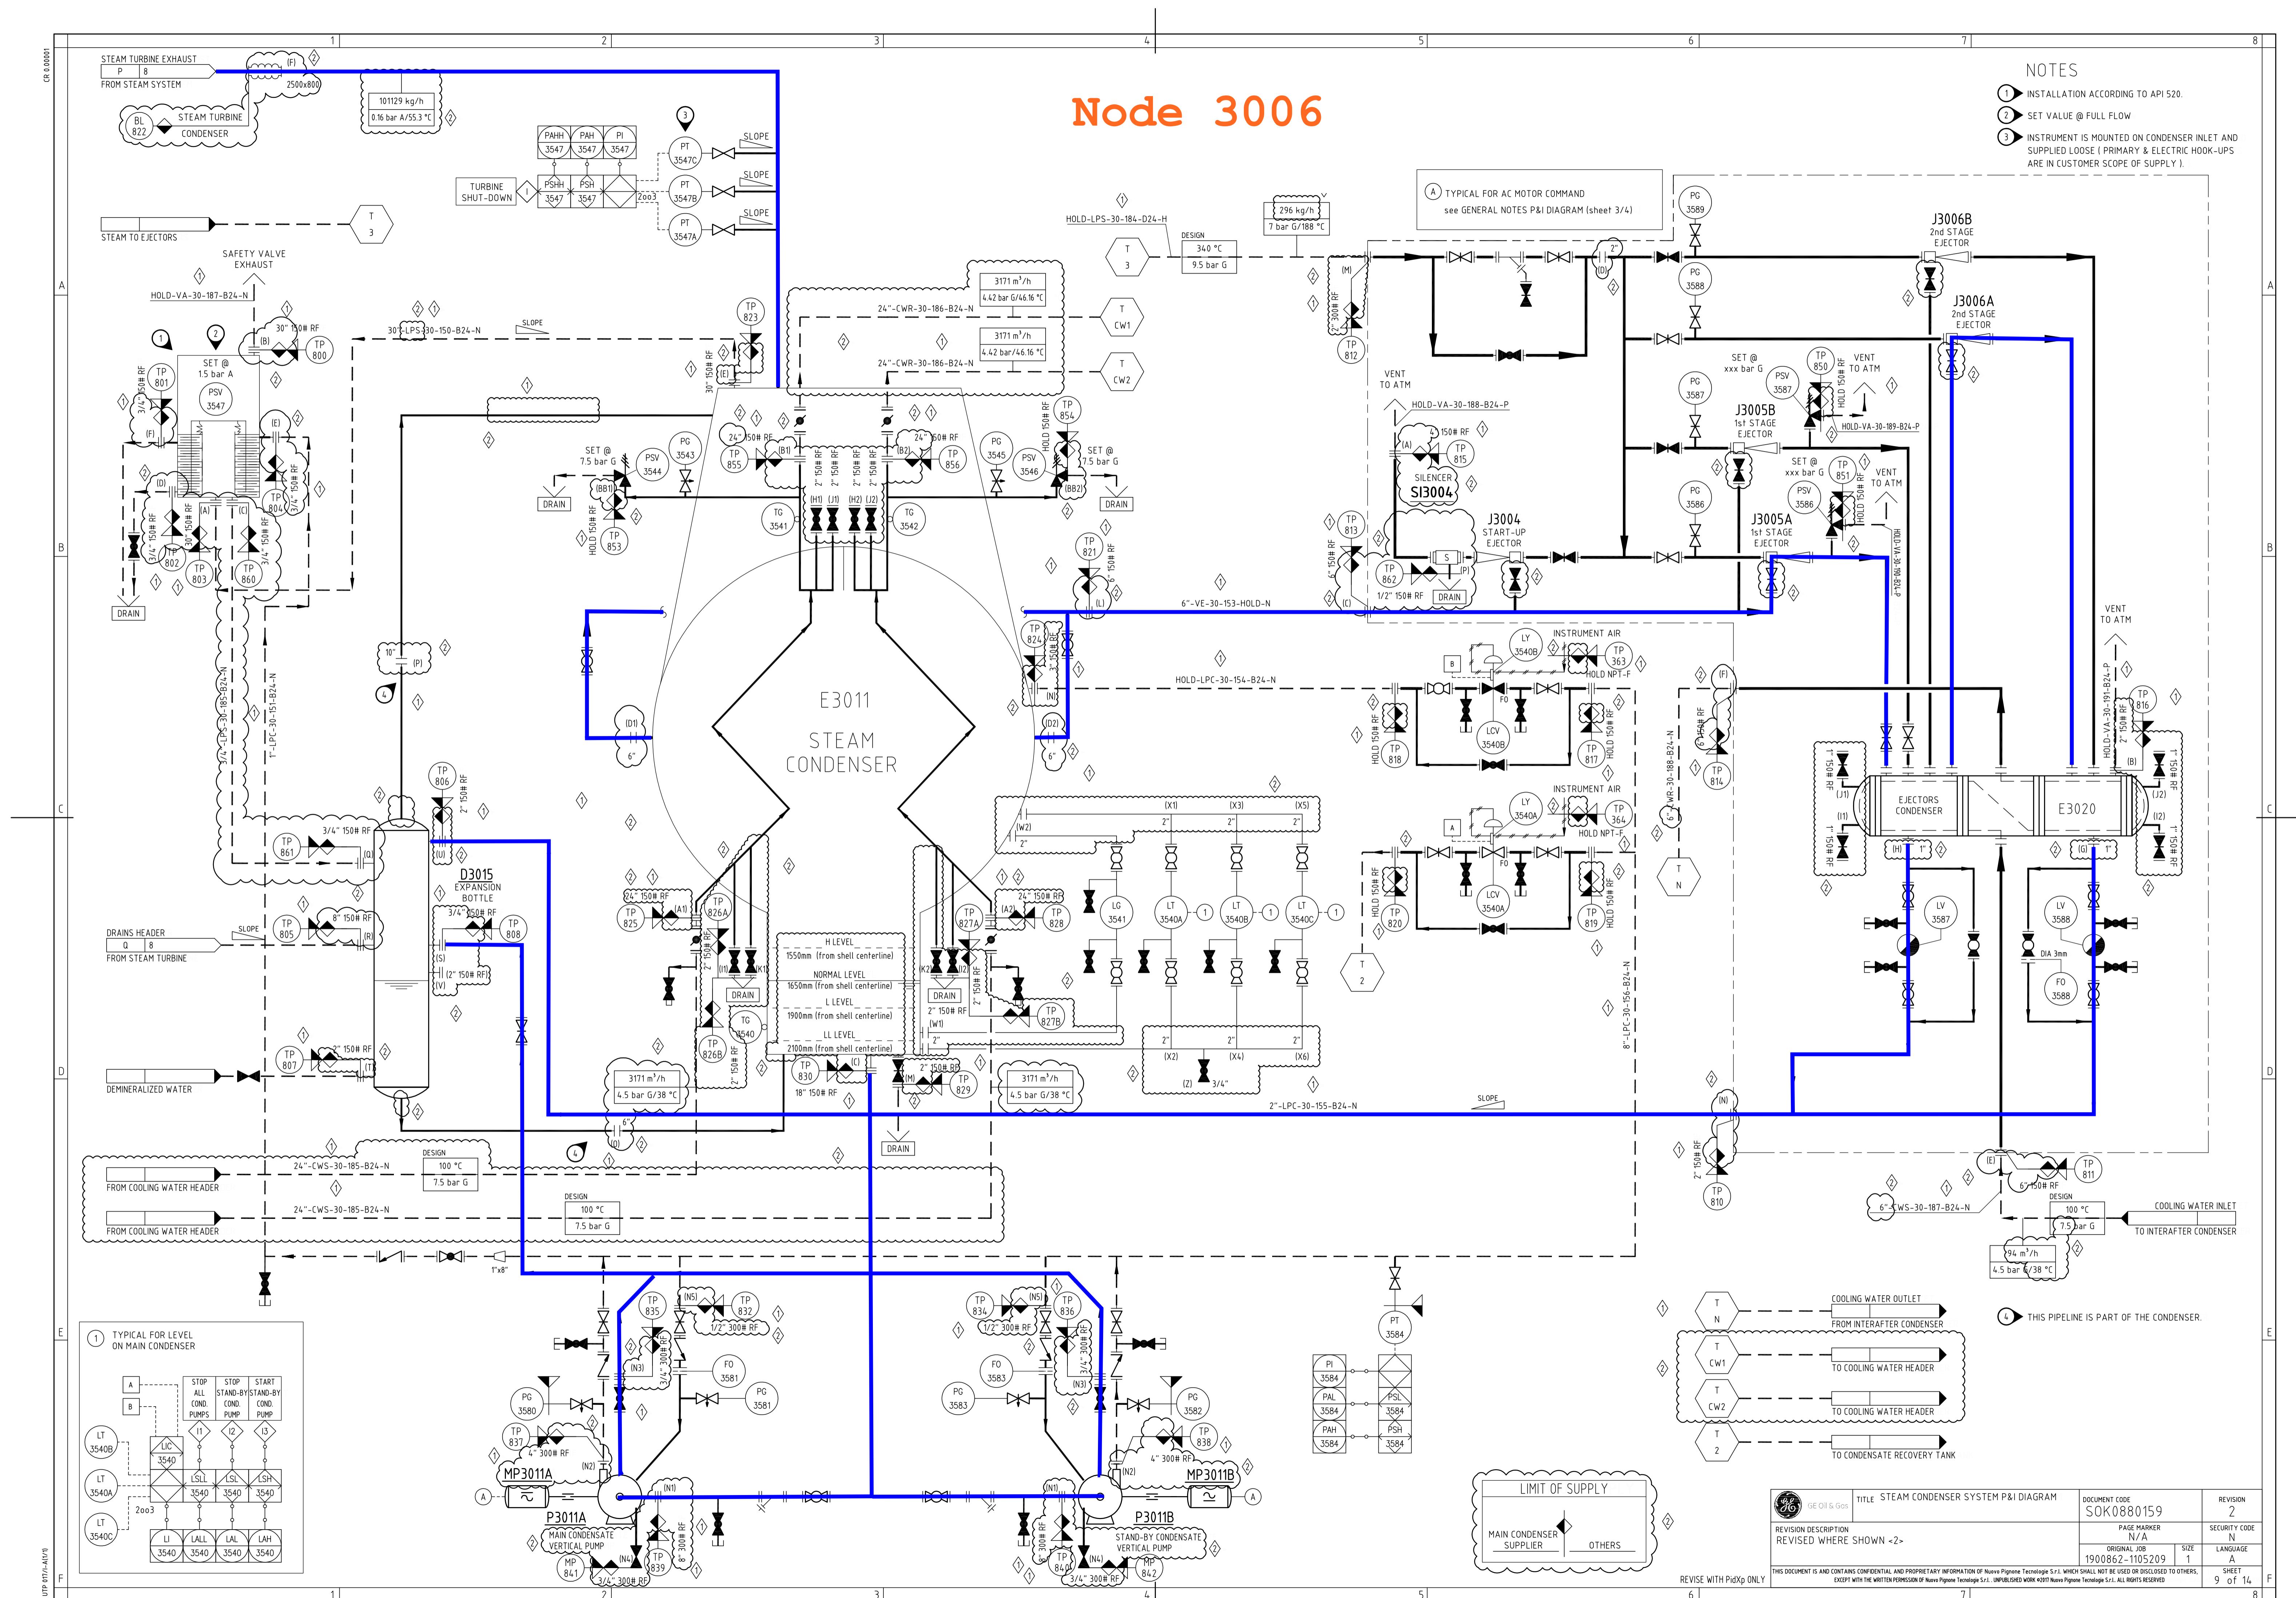


Node 3006

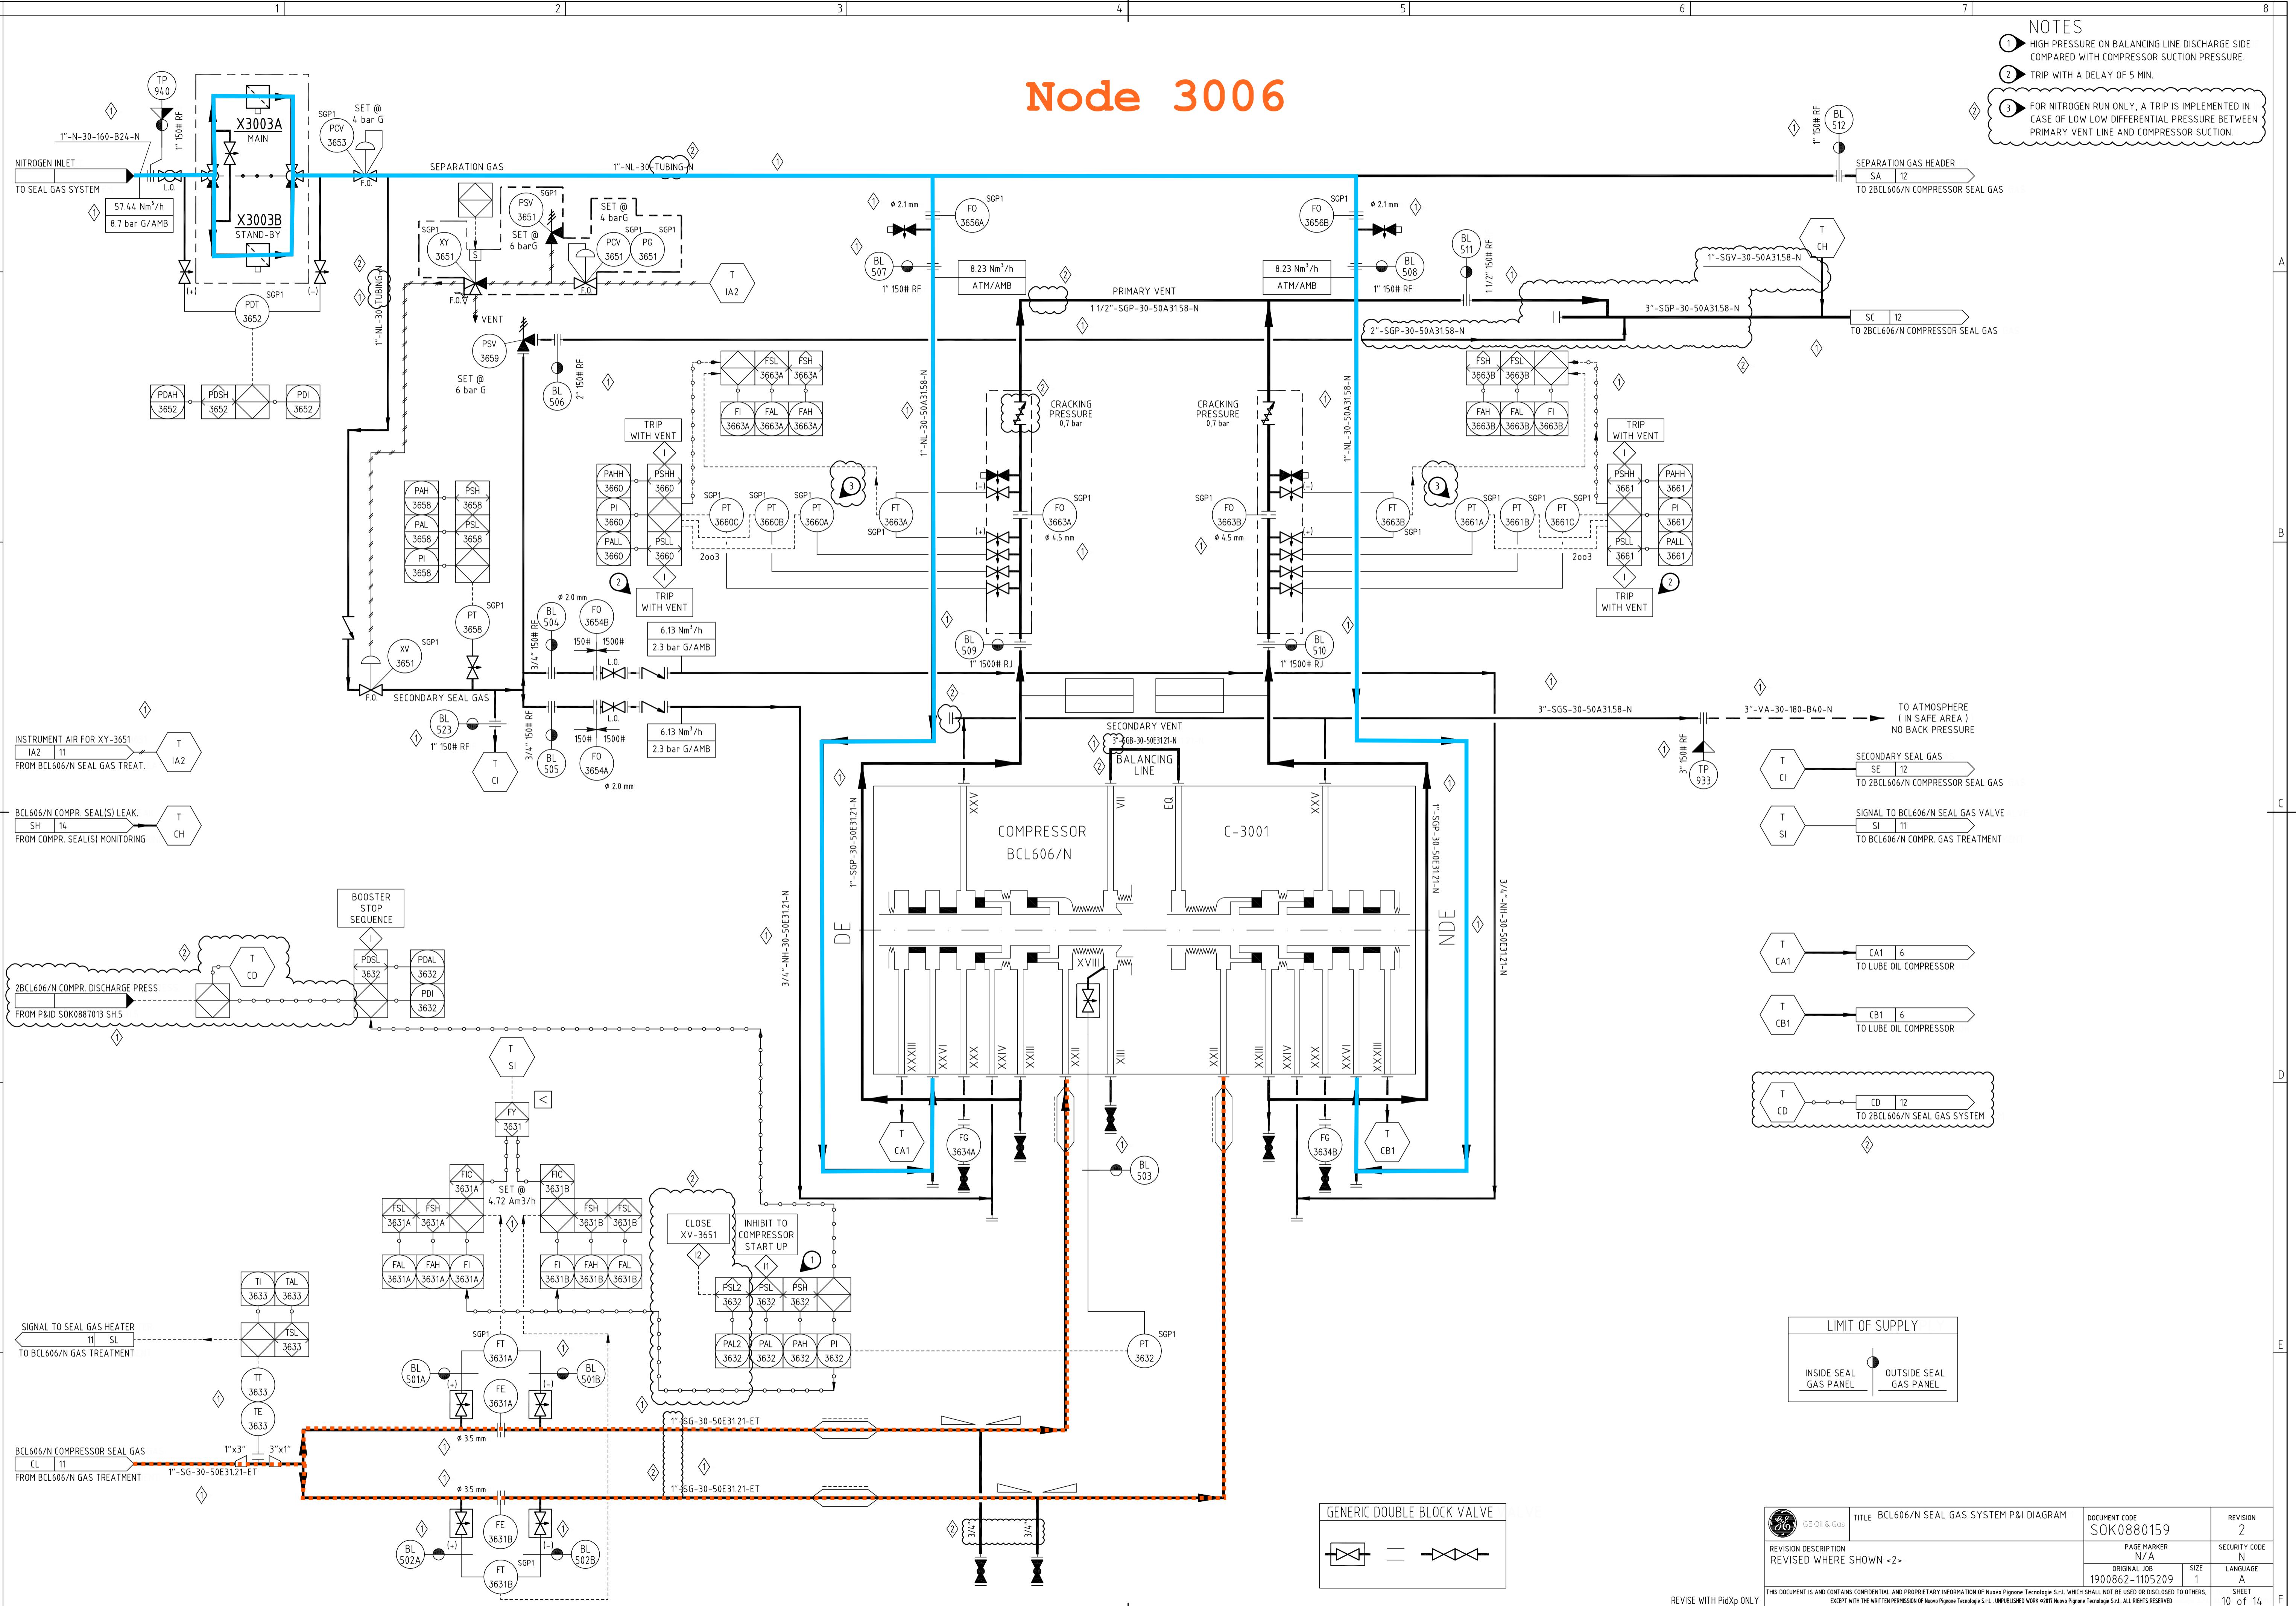



Node 3006

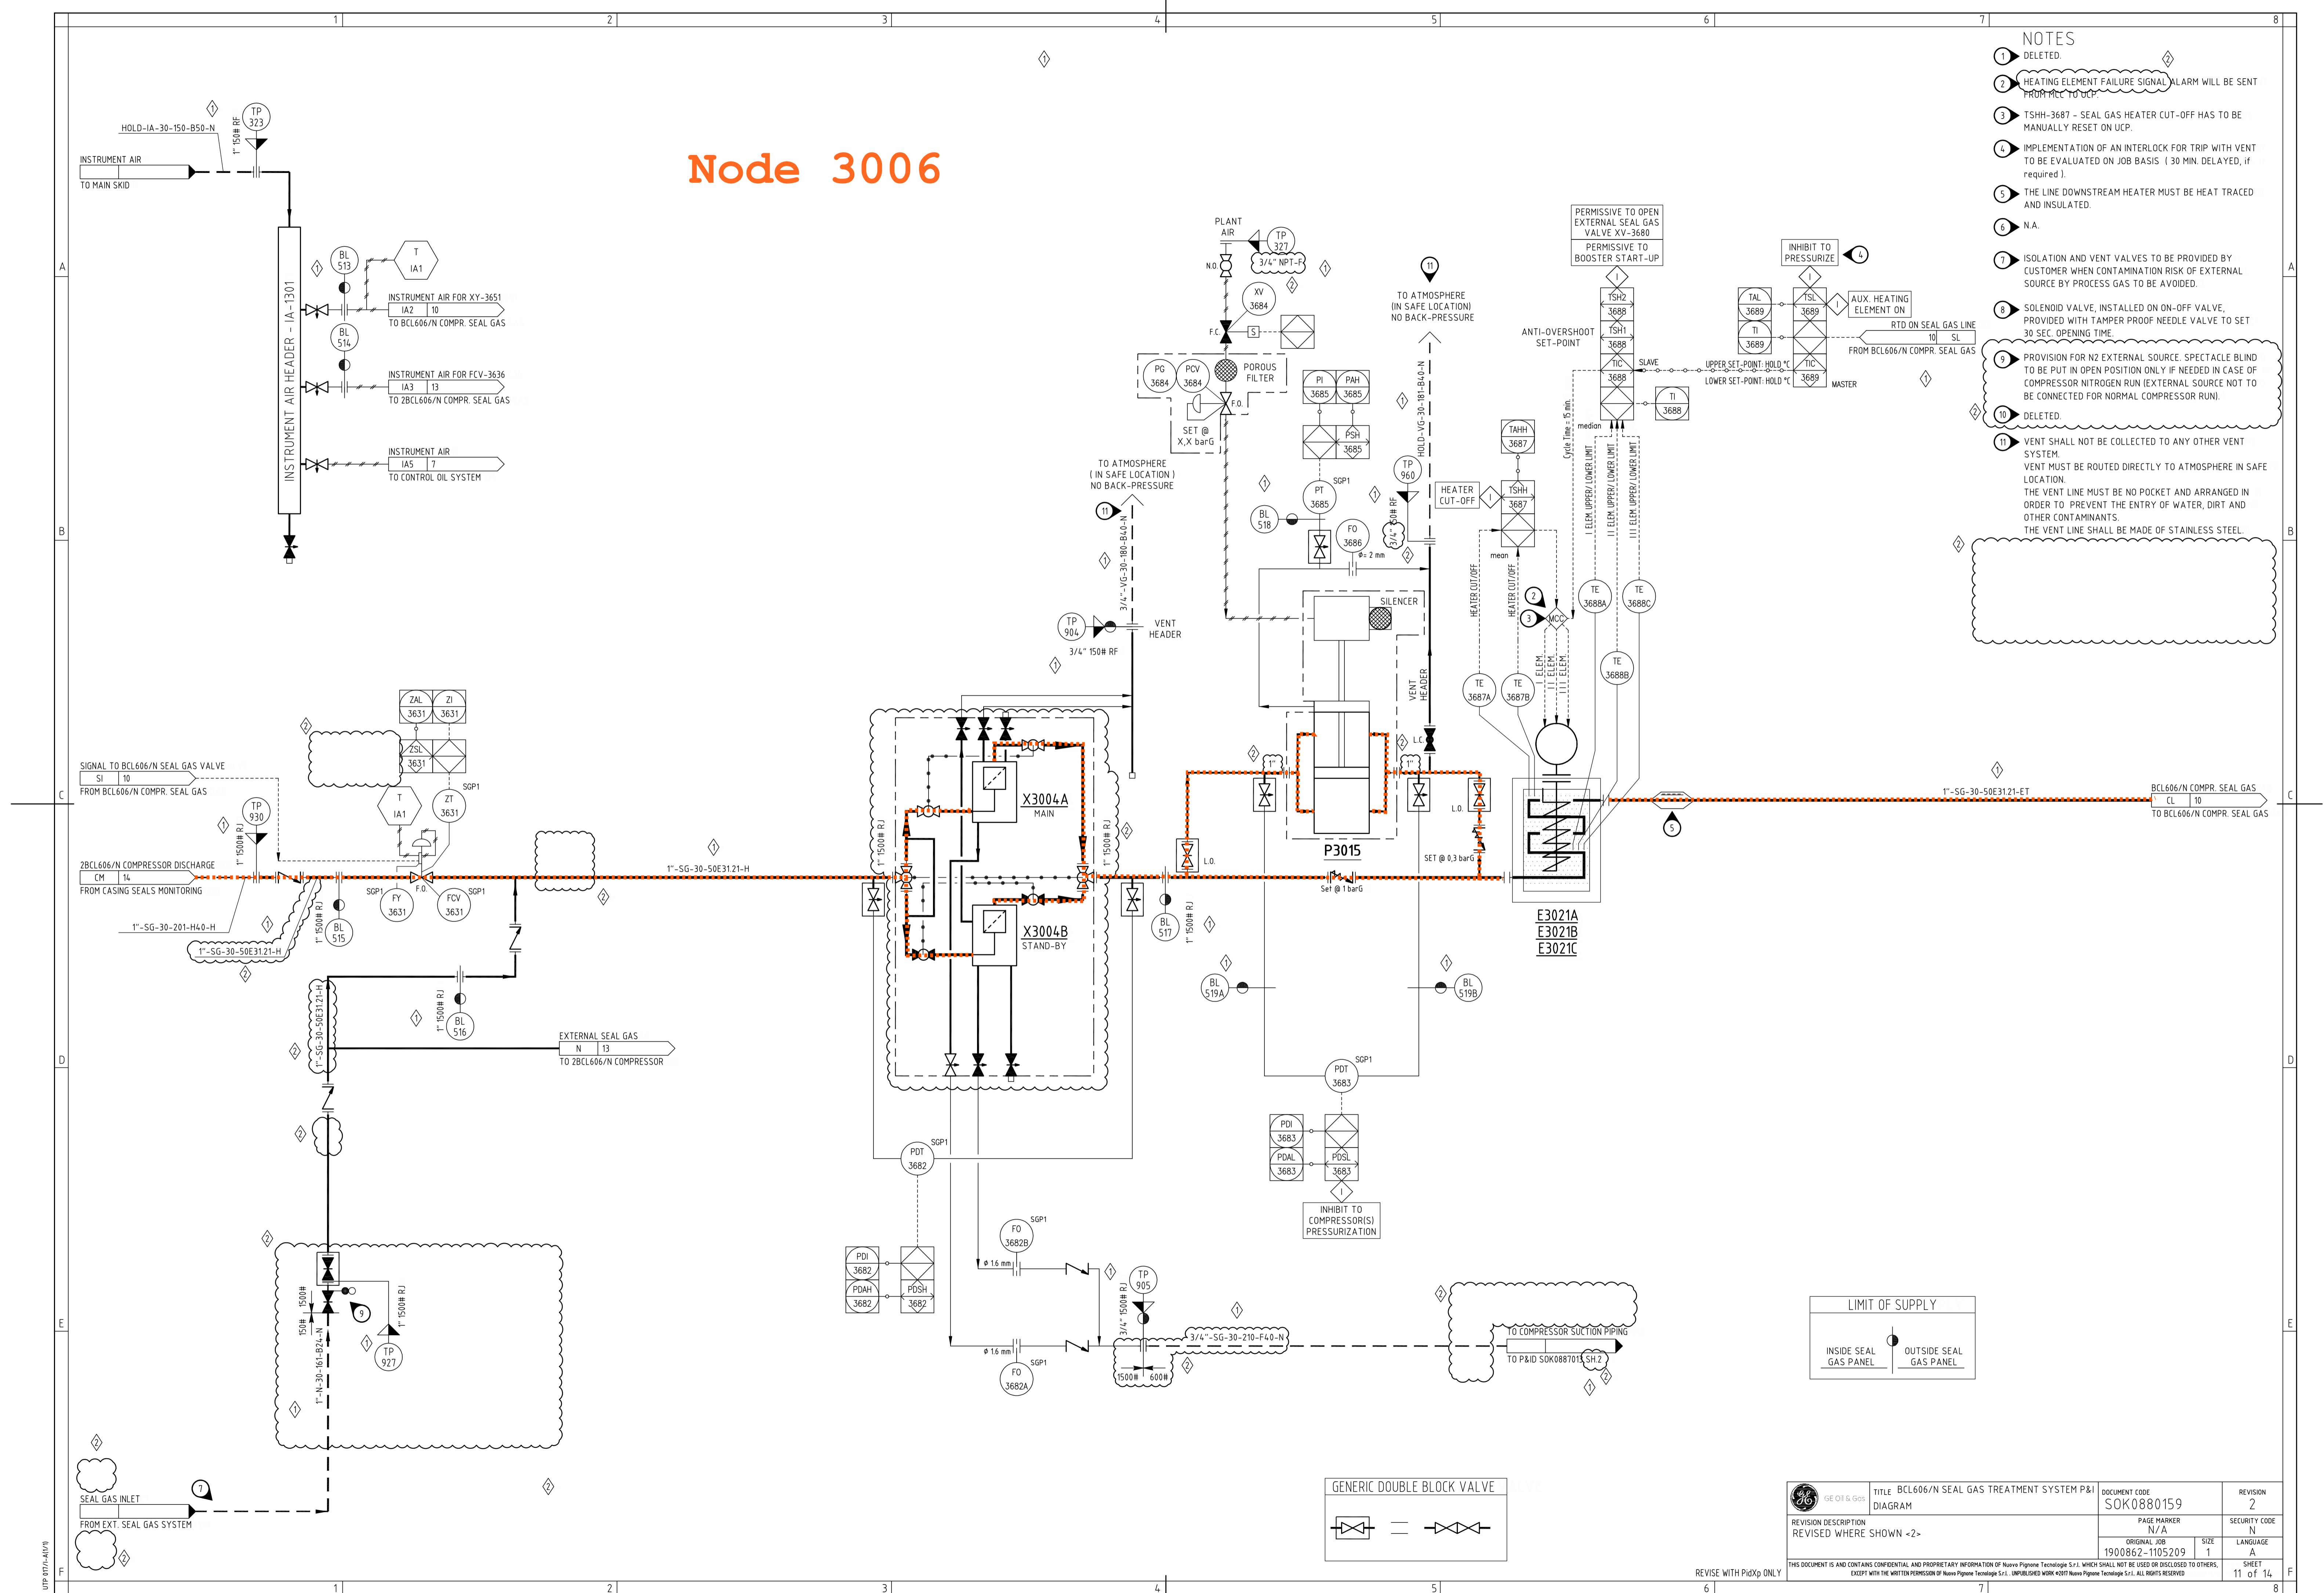

Node 3006

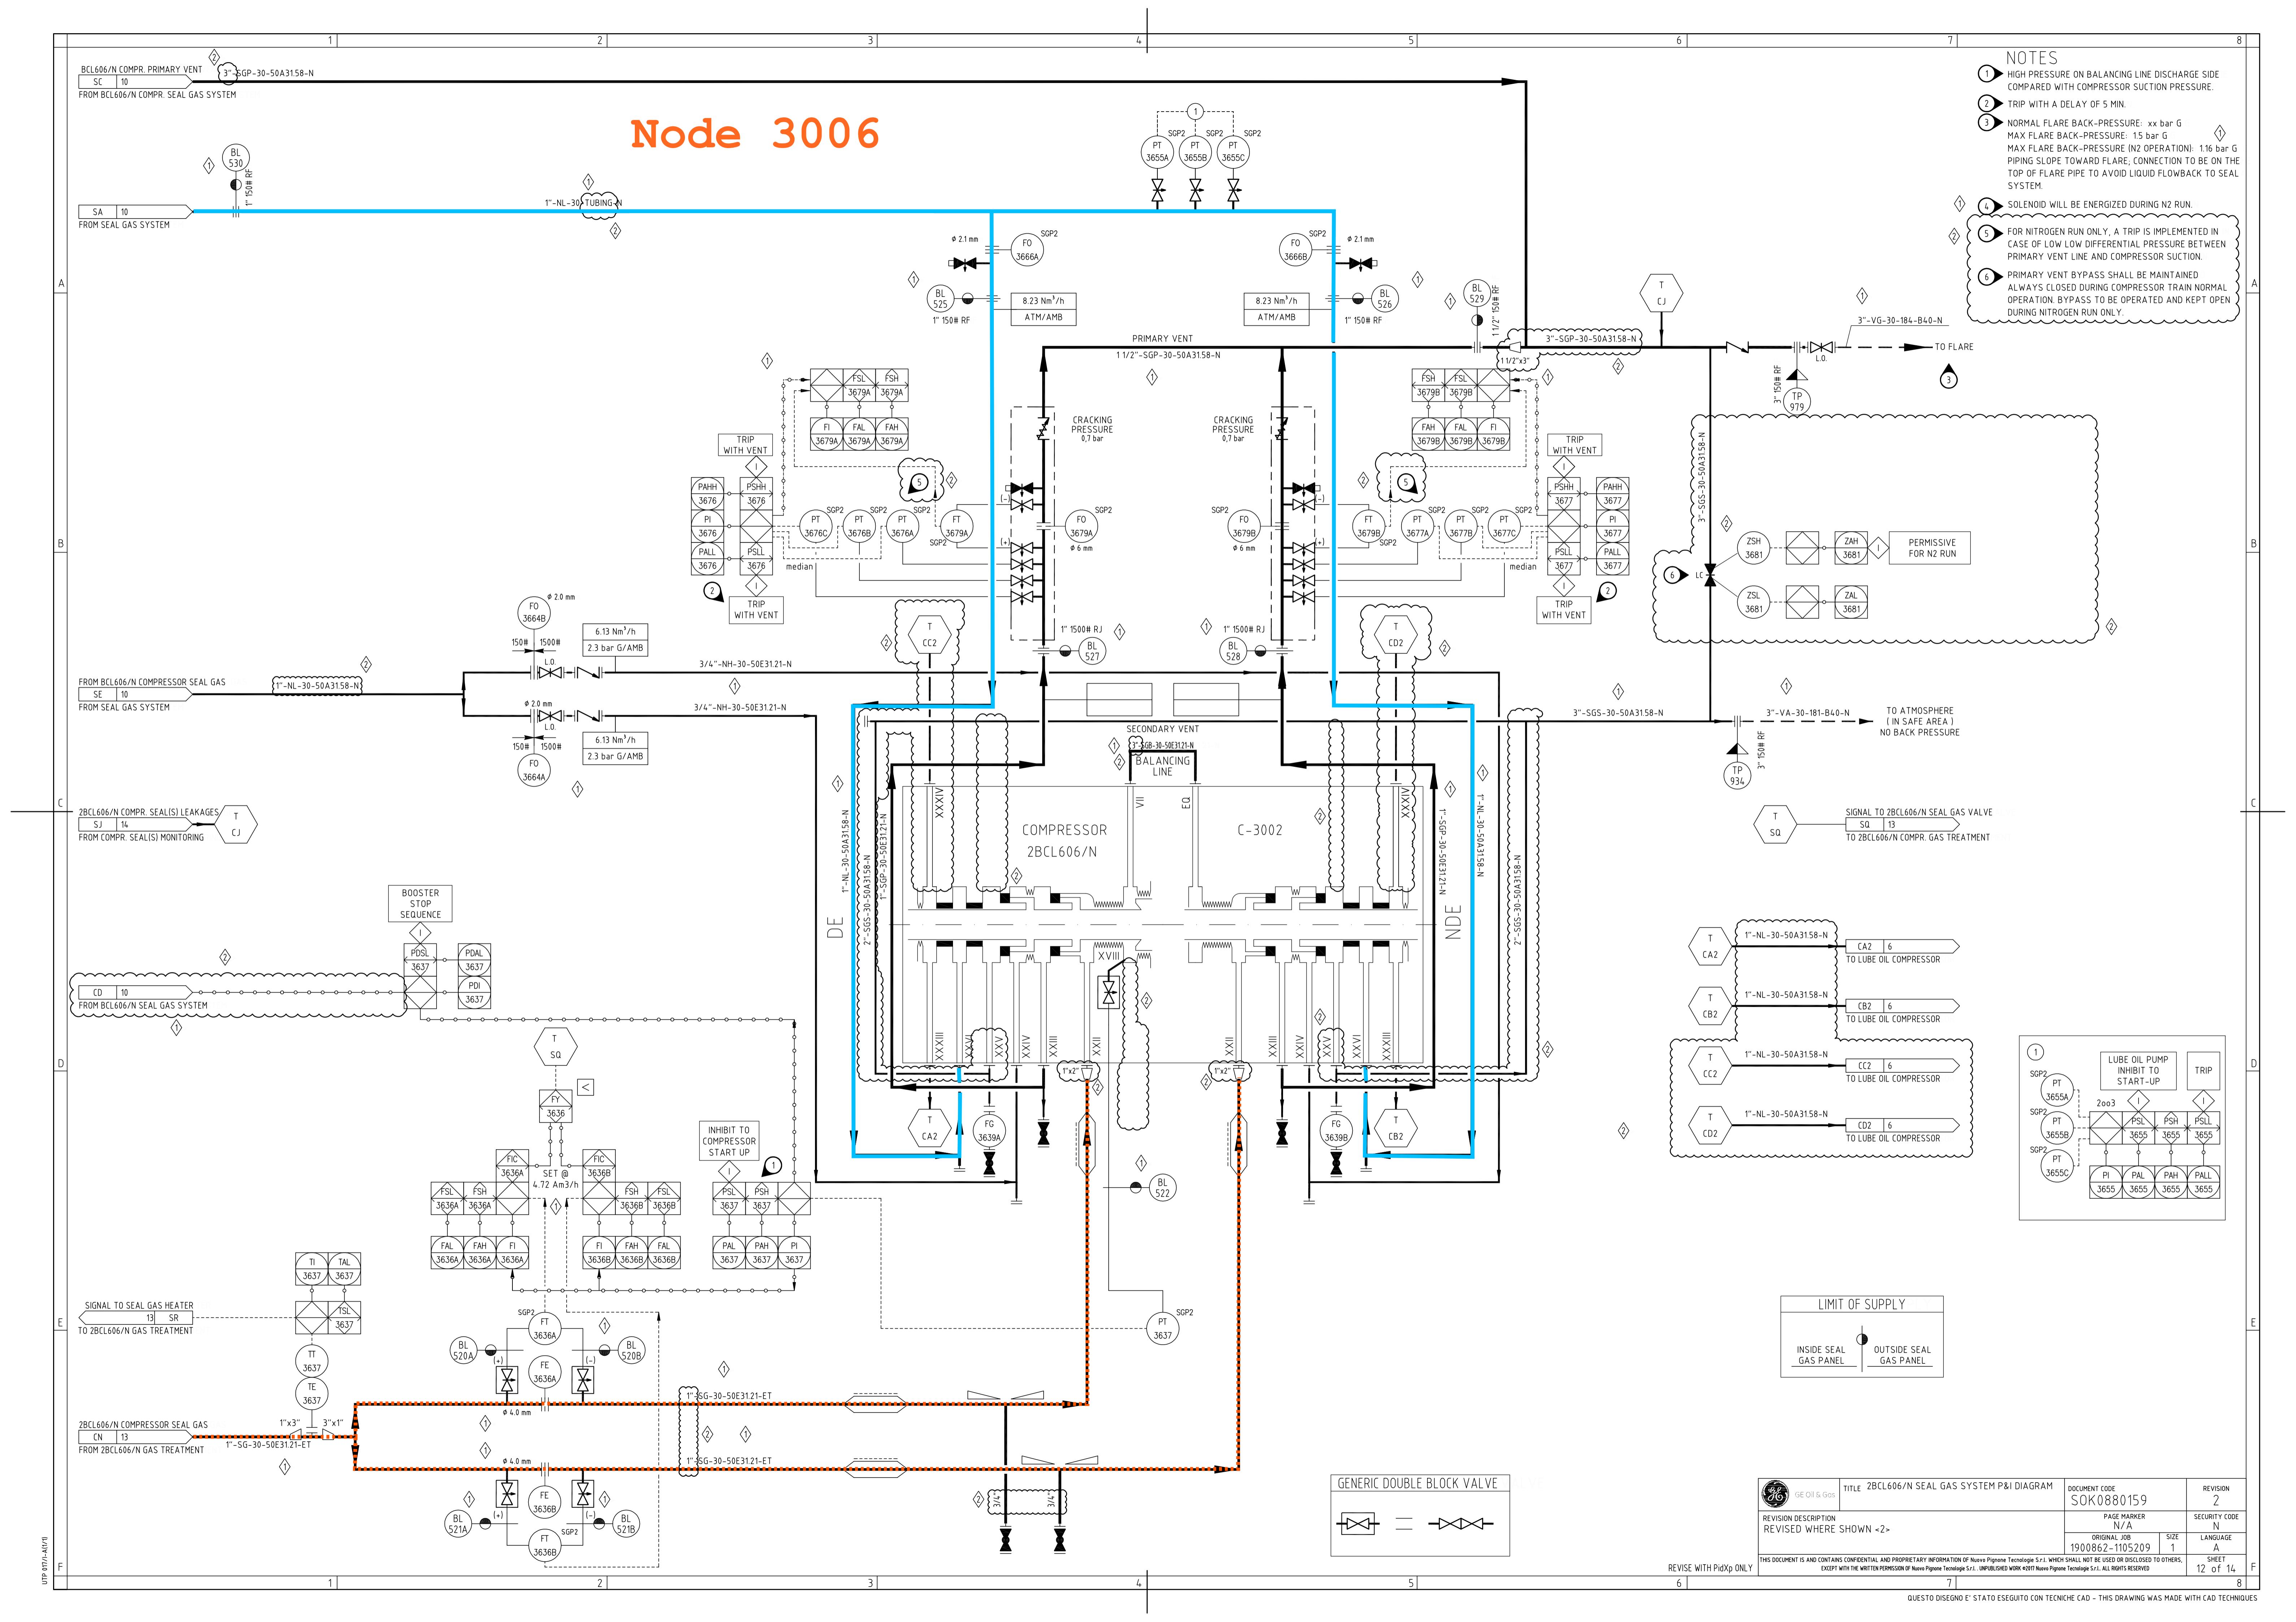

Node 3006

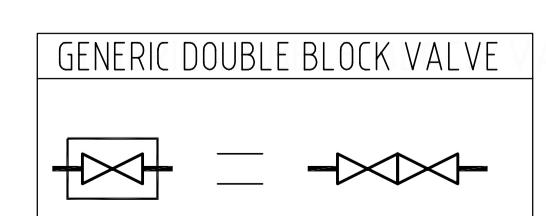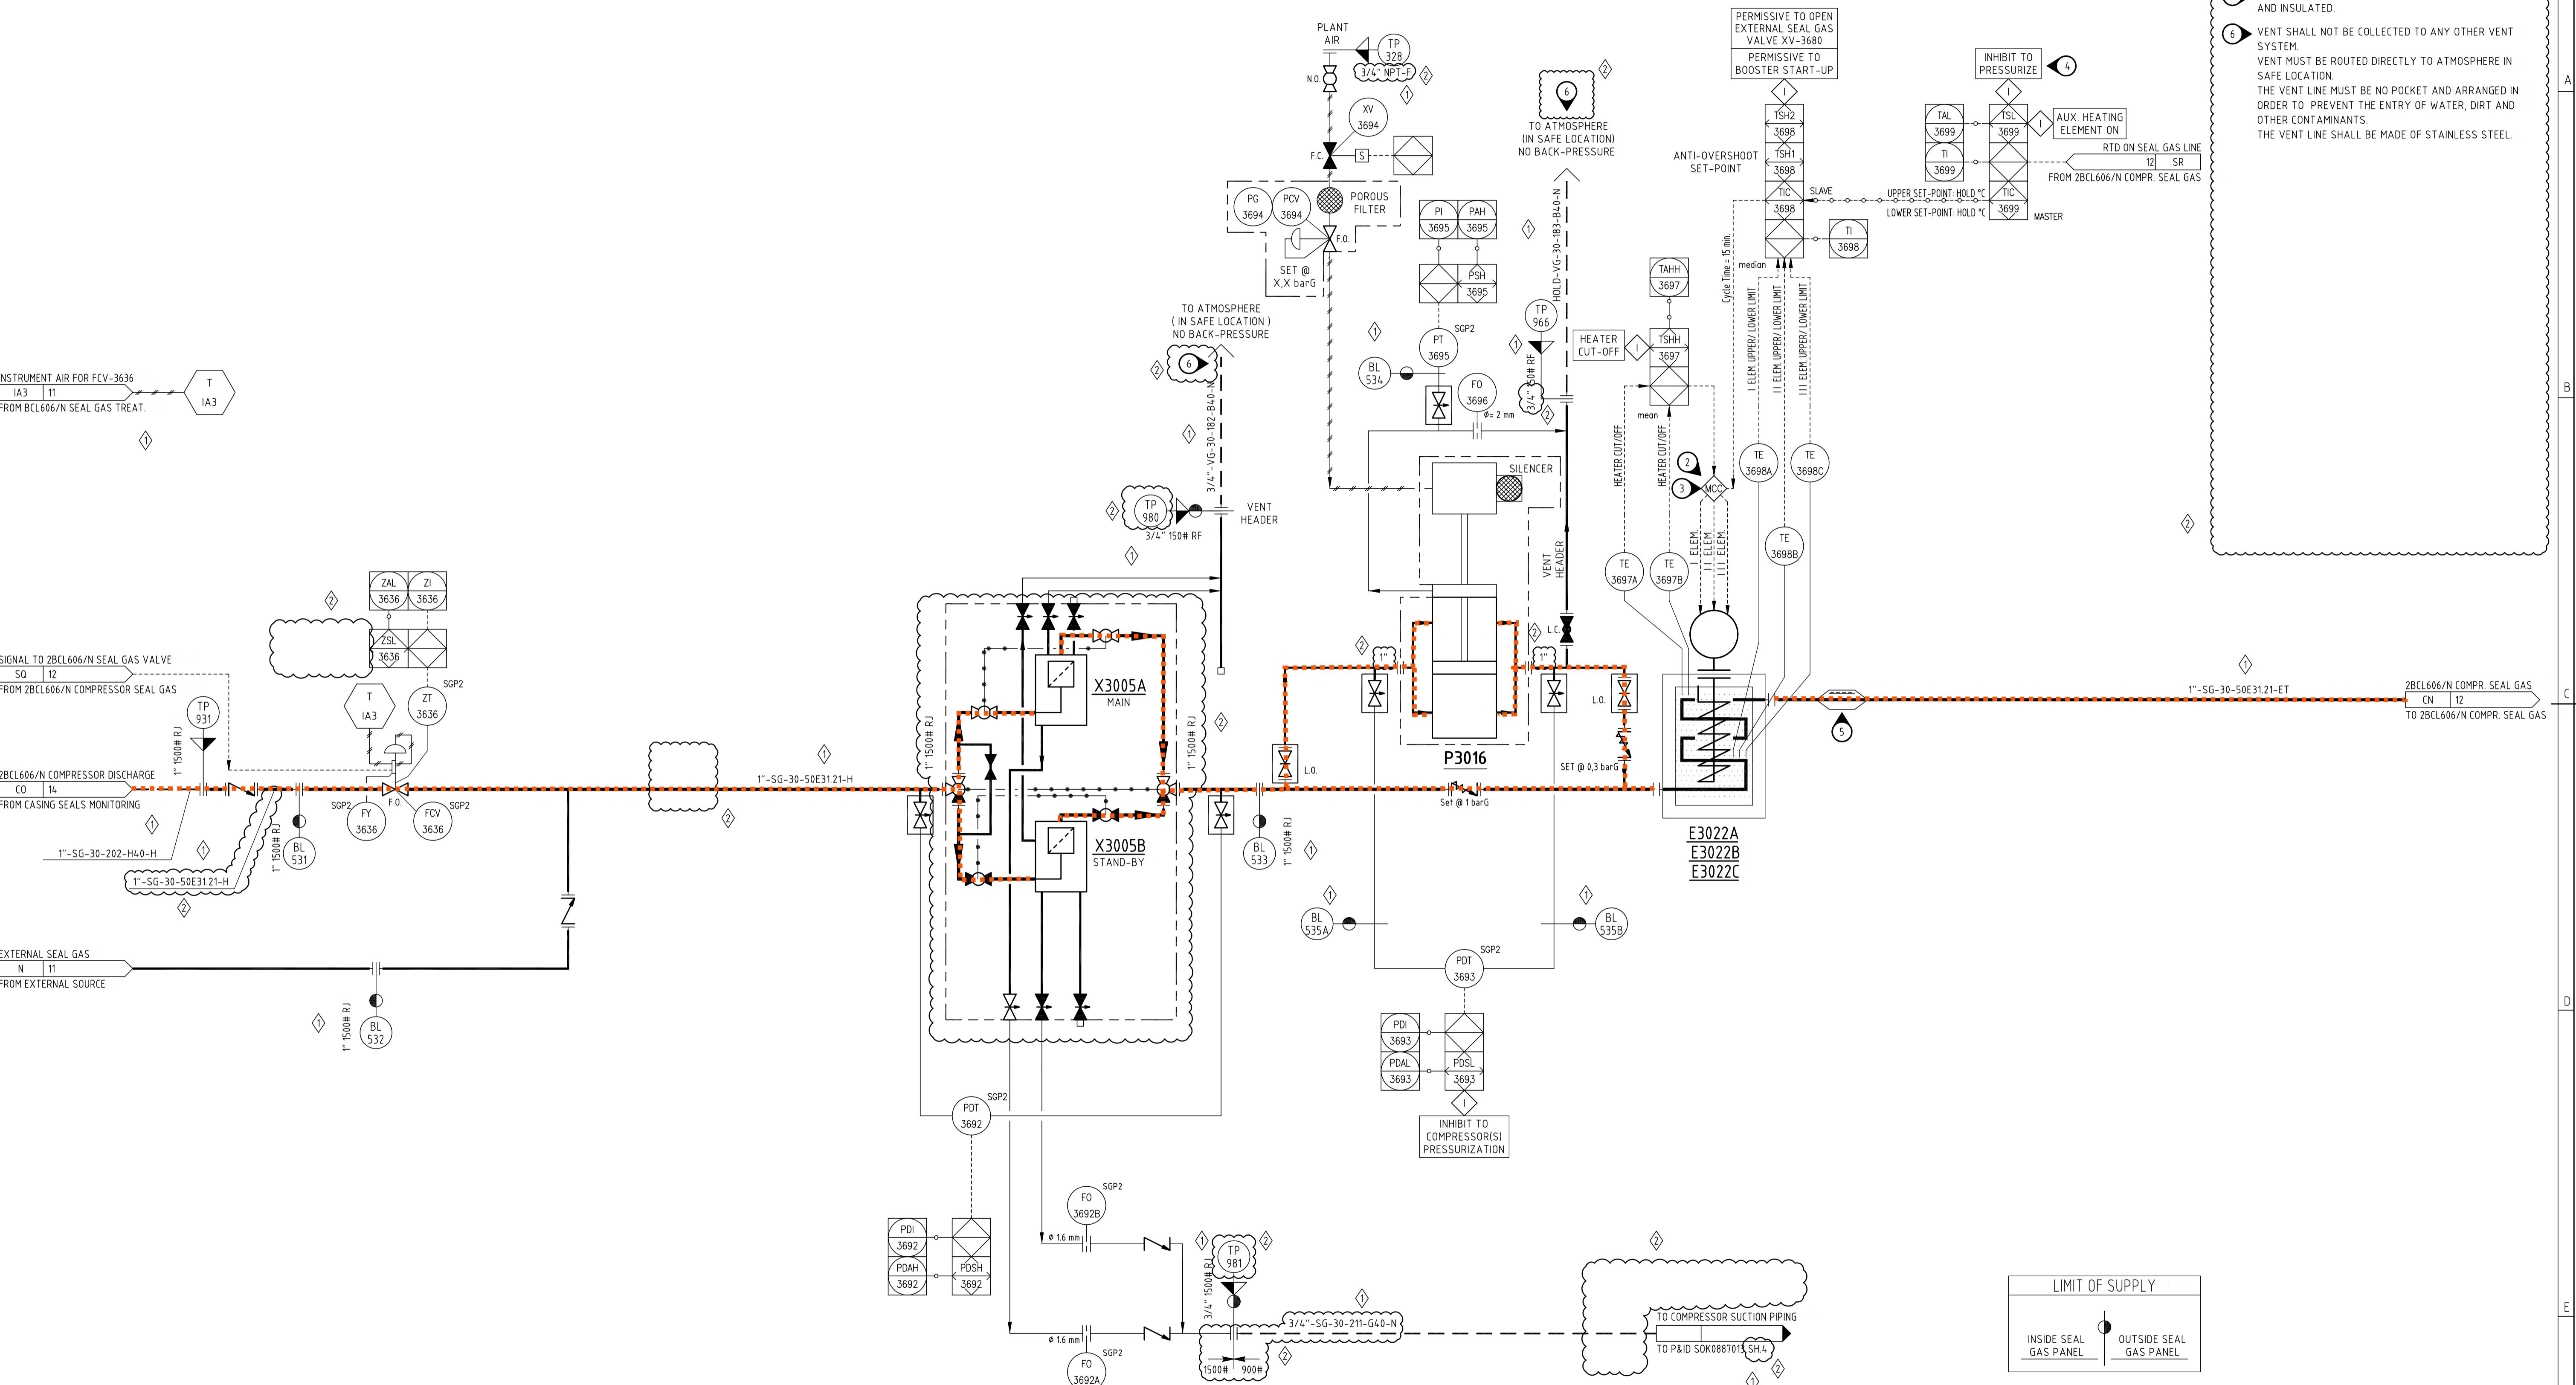

THIS DOCUMENT

 GE Oil & Gas	TITLE 2BCL606/N SEAL GAS TREATMENT SYSTEM P&I DIAGRAM	DOCUMENT CODE SOK0880159	REVISION 2
	REVISION DESCRIPTION REVISED WHERE SHOWN <2>	PAGE MARKER N/A	SECURITY CODE N
	ORIGINAL JOB 1900862-1105209	SIZE 1	LANGUAGE A
THIS DOCUMENT IS AND CONTAINS CONFIDENTIAL AND PROPRIETARY INFORMATION OF Nuovo Pignone Tecnologie S.r.l. WHICH SHALL NOT BE USED OR DISCLOSED TO OTHERS,			SHEET

CUSTOMER : MIDDLE EAST KIMIAYE PARS COMPANY
PUMP MODEL : DST 200x150-11S
ITEM NO. : P 7001C
SERVICE : BFW PUMP
SITE : ASSLUYEH, IRAN

Node 7007

MEASURING ITEM 1ST LETTER	SERVICE 2ND LETTER	SERVICE 3RD LETTER
P PRESSURE	C CONTROL	H HIGH
PD DIFF. PRESSURE	E ELEMENT	HH HIGH HIGH
T TEMPERATURE	G GAUGE	L LOW
L LEVEL	S SWITCH	LL LOW LOW
F FLOW	T TRANSMITTER	
V VIBRATION	P PROXIMITOR	
K KEY PHASER	A ACCELEROMETER	
S SPEED / SATFTY	V VALVE	
Z POSITION		


LOCAL FIELD MOUNTED INSTRUMENT	► NORMAL OPEN GATE VALVE
LOCAL PANEL MOUNTED INSTRUMENT	► NORMAL OPEN GLOBE VALVE
FIELD -> DCS	► NORMAL CLOSE BALL VALVE
INTERLOCK	► NORMAL CLOSE NEEDLE VALVE
SEALING WATER LINE	► NORMAL CLOSE CHECK VALVE
LUB. OIL RECIRCULATION LINE	► SCREW DOWN CHECK VALVE
COOLING WATER LINE	► 3-WAY BALL VALVE
ELECTRIC SIGNAL	► TEMPERATURE CONTROL VALVE(TCV)
	► PRESSURE REDUCING VALVE(PPV)
	► PRESSURE REGULATING VALVE(PRV)
	► SAFETY RELIEF VALVE
	► 2-WAY MANIFOLD VALVE
	► 5-WAY MANIFOLD VALVE
	► DUPLEX FILTER
	► Y-STRAINER
	► SIGHT GLASS
	► ORIFICE

GENERAL NOTES

1.	REFERENCE DRAWINGS


SYMBOLS AND LEGENDS

KEY PLAN

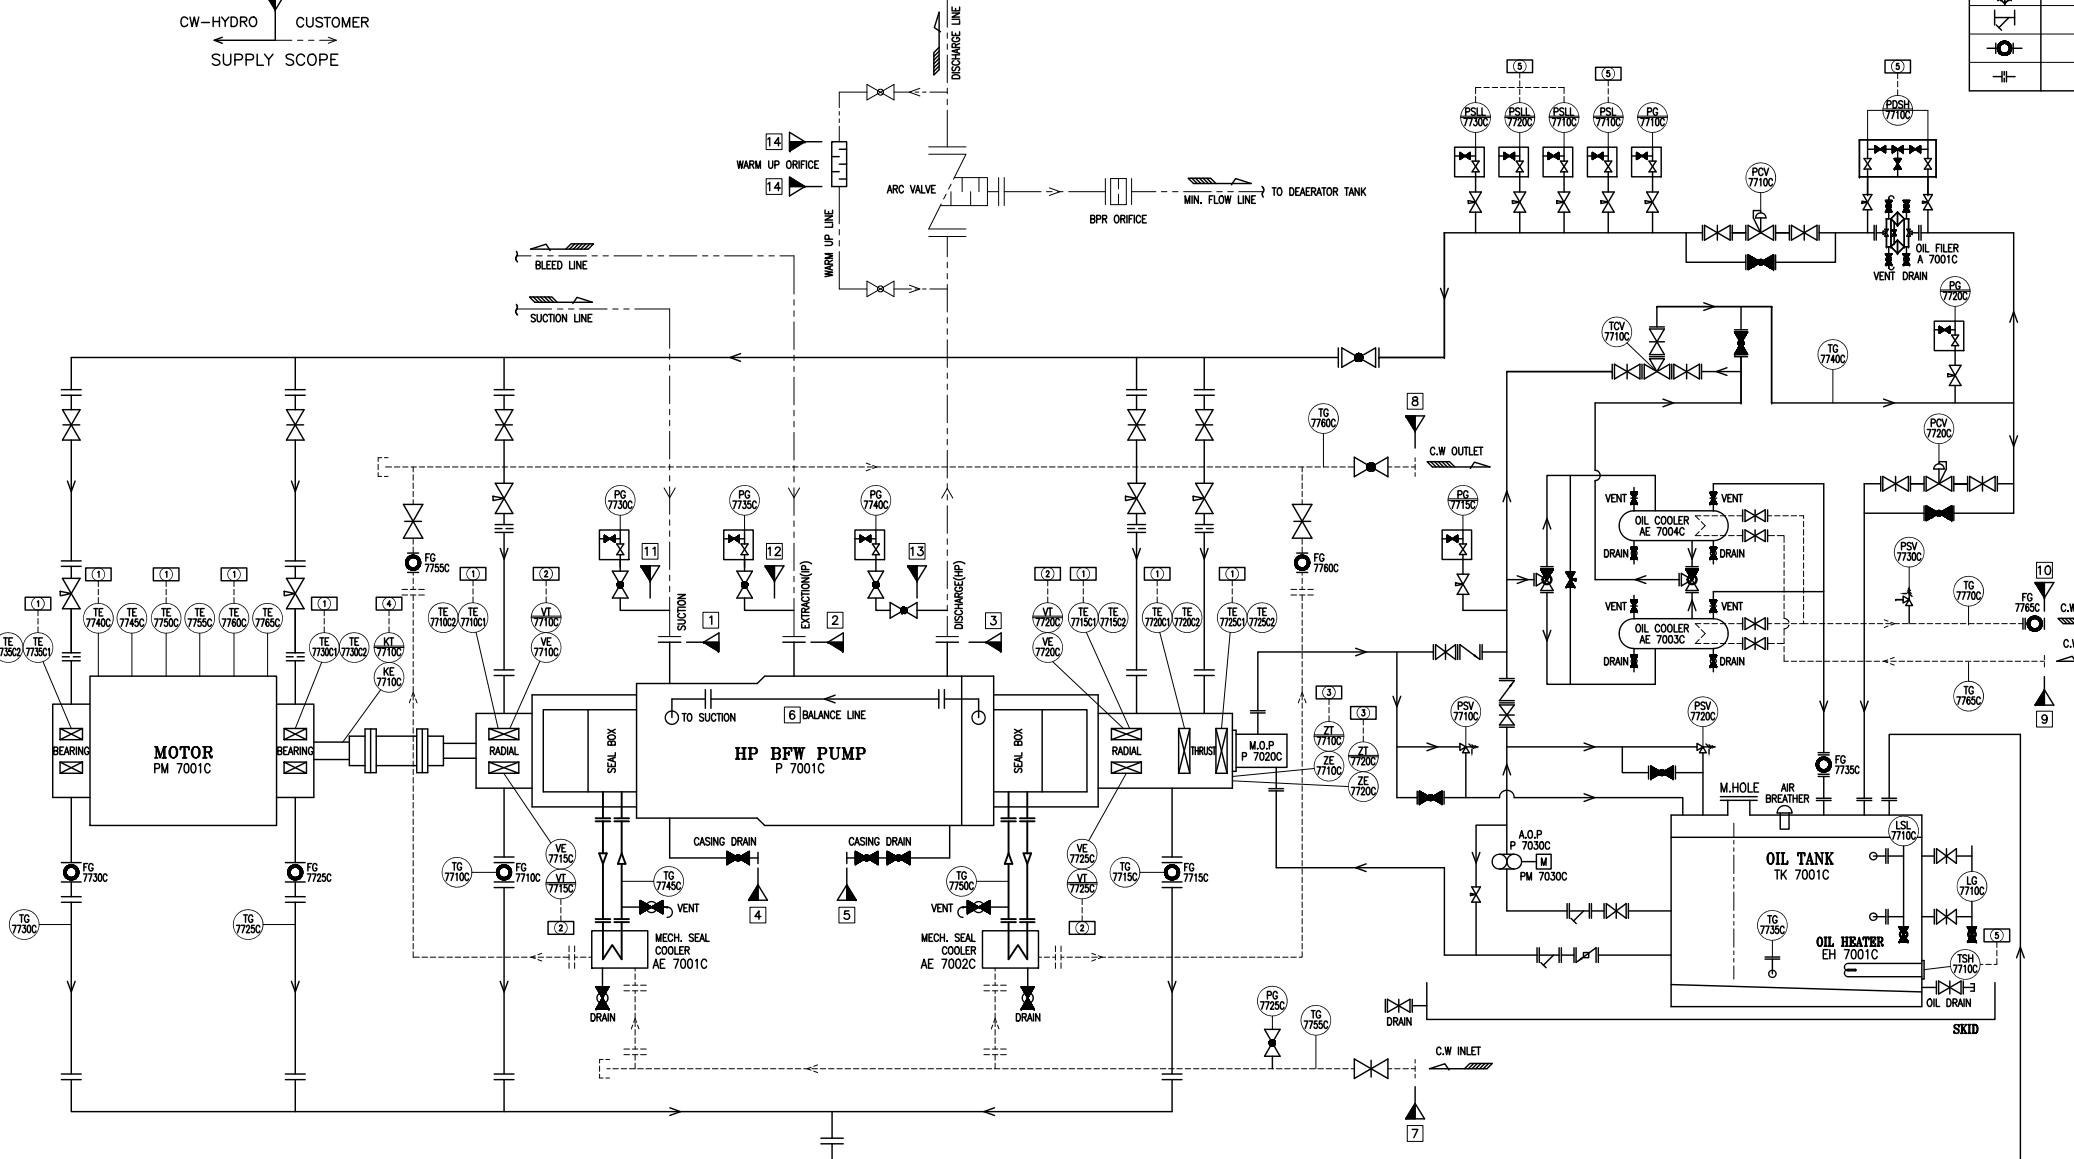

TERMINAL POINTS

NO.	DESCRIPTION	RATING & SIZE
1	PUMP SUCTION	DN200 ASME 150LB RF
2	PUMP EXTRACTION	DN50 ASME 600LB WN RF
3	PUMP DISCHARGE	DN150 ASME 1500LB RJT
4	CASING DRAIN(SUCTION SIDE)	DN25 ASME 300LB SW RF
5	CASING DRAIN(DISCHARGE SIDE)	DN25 ASME 1500LB SW RF
6	BALANCE LINE	DN40 ASME 300LB SW RF
7	C.W. INLET FOR M/S COOLER	DN40 ASME 150LB SW RF
8	C.W. OUTLET FOR M/S COOLER	DN40 ASME 150LB SW RF
9	C.W. INLET FOR LUBE. OIL COOLER	DN40 ASME 150LB SW RF
10	C.W. OUTLET FOR LUBE. OIL COOLER	DN40 ASME 150LB SW RF
11	SUCTION PRESSURE GAUGE	DN15 600LB SW
12	EXTRACTION PRESSURE GAUGE	DN15 600LB SW
13	DISCHARGE PRESSURE GAUGE	DN15 1500LB SW
14	WARM UP LINE ORIFICE	DN20 ASME 1500LB SW RF

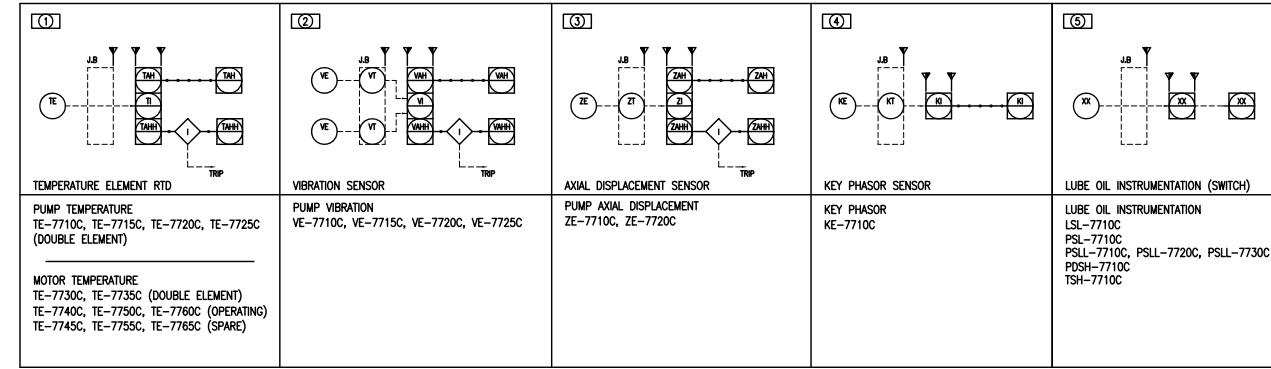

▲ Issued For Approval 21.02.2017 Y.S. HAN Y.S. HAN GM. KANG M.Y. LEE M.Y. LEE
REV. PURPOSE OF ISSUE DATE DESIGN DRAW CHECK REVIEW APPROVE
THIS DOCUMENT IS THE PROPERTY OF TOC. NO PART OF THIS DOCUMENT SHALL BE REPRODUCED OR DISCLOSED
TO OTHERS OR USED FOR ANY PURPOSE WHATSOEVER EXCEPT WITH THE PRIOR WRITTEN PERMISSION OF TOC.

OWNER:
 Middle East Kimiaye Pars Company

CONTRACTOR DRAWING NO.
MKP-VD-9000-303-155-A3
SHEET 03 TOTAL 03

CONTRACTOR
 HALDOR TOPSØE A/S
VENDOR DRAWING NO.
- SHEET 03 TOTAL 03

CONTRACTOR
 TCC CHINA TIANCHEN ENGINEERING CORPORATION
VENDOR
 CW-Hydro, Inc.

PROJECT MKP Method Project
UNIT General Technical
PHASE Detail Engineering
Counter Signing Sign Date
SCALE 1:1 SHEET 03 TOT. 03 SIZE A3 OWNER DWG NO. MKP-VD-9000-303-155-A3

CUSTOMER : MIDDLE EAST KIMIAYE PARS COMPANY
PUMP MODEL : DST 200x150-11S
ITEM NO. : P 7001A/B
SERVICE : BFW PUMP
SITE : ASSLUYEH, IRAN


TERMINAL POINTS for Pump		
NO.	DESCRIPTION	RATING & SIZE
1	PUMP SUCTION	DN200 ASME 150LB RF
2	PUMP EXTRACTION	DN50 ASME 600LB WN RF
3	PUMP DISCHARGE	DN150 ASME 1500LB RJT
4	CASING DRAIN(SUCTION SIDE)	DN25 ASME 300LB SW RF
5	CASING DRAIN(DISCHARGE SIDE)	DN25 ASME 1500LB SW RF
6	BALANCE LINE	DN40 ASME 300LB SW RF
7	C.W. INLET FOR M/S COOLER	DN40 ASME 150LB SW RF
8	C.W. OUTLET FOR M/S COOLER	DN40 ASME 150LB SW RF
9	C.W. INLET FOR LUBE. OIL COOLER	DN40 ASME 150LB SW RF
10	C.W. OUTLET FOR LUBE. OIL COOLER	DN40 ASME 150LB SW RF
11	SUCTION PRESSURE GAUGE	DN15 600LB SW
12	EXTRACTION PRESSURE GAUGE	DN15 600LB SW
13	DISCHARGE PRESSURE GAUGE	DN15 1500LB SW
14	WARM UP LINE ORIFICE	DN20 ASME 1500LB SW RF

MEASURING ITEM	1ST LETTER	SERVICE 2ND LETTER	SERVICE 3RD LETTER
P PRESSURE	C	CONTROL	H HIGH
PD DIFF. PRESSURE	E	ELEMENT	HH HIGH HIGH
T TEMPERATURE	G	GAUGE	L LOW
L LEVEL	S	SWITCH	LL LOW LOW
F FLOW	T	TRANSMITTER	
V VIBRATION	P	PROXIMITOR	
K KEY PHASER	A	ACCELEROMETER	
S SPEED / SAFETY	V	VALVE	
Z POSITION			

LOCAL FIELD MOUNTED INSTRUMENT	●	NORMAL OPEN	GATE VALVE
LOCAL PANEL MOUNTED INSTRUMENT	○	NORMAL CLOSE	GLOBE VALVE
FIELD -> DCS	□	NORMAL OPEN	BALL VALVE
INTERLOCK	◇	NORMAL CLOSE	NEEDLE VALVE
SEALING WATER LINE	→	NORMAL OPEN	CHECK VALVE
LUB. OIL RECIRCULATION LINE	→	NORMAL CLOSE	SCREW DOWN CHECK VALVE
COOLING WATER LINE	—	NORMAL OPEN	3-WAY BALL VALVE
STEAM LINE	●	NORMAL CLOSE	TEMPERATURE CONTROL VALVE(TCV)
INSTRUMENT AIR	—	NORMAL OPEN	PRESSURE REDUCING VALVE(PCR)
MECHANICAL LINK	—	NORMAL CLOSE	PRESSURE REGULATING VALVE(PRV)
ELECTRIC SIGNAL	—	NORMAL OPEN	SAFETY RELIEF VALVE
	—	NORMAL CLOSE	2-WAY MANIFOLD VALVE
	—	NORMAL OPEN	5-WAY MANIFOLD VALVE
	—	NORMAL CLOSE	DUPLEX FILTER
	—	NORMAL OPEN	Y-STRAINER
	—	NORMAL CLOSE	STEAM INLET-STRAINER
	—	NORMAL OPEN	SIGHT GLASS
	—	NORMAL CLOSE	ORIFICE

GENERAL NOTES
1.
REFERENCE DRAWINGS
SYMBOLS AND LEGENDS
1. MECHANICAL ACTION ON TRIP VALVE CAN OCCURE FROM ANY OF THE 3 CONDITIONS HAND TRIP LEVER, MECHANICAL OVERSPEED OR LOP
KEY PLAN

Node 7007

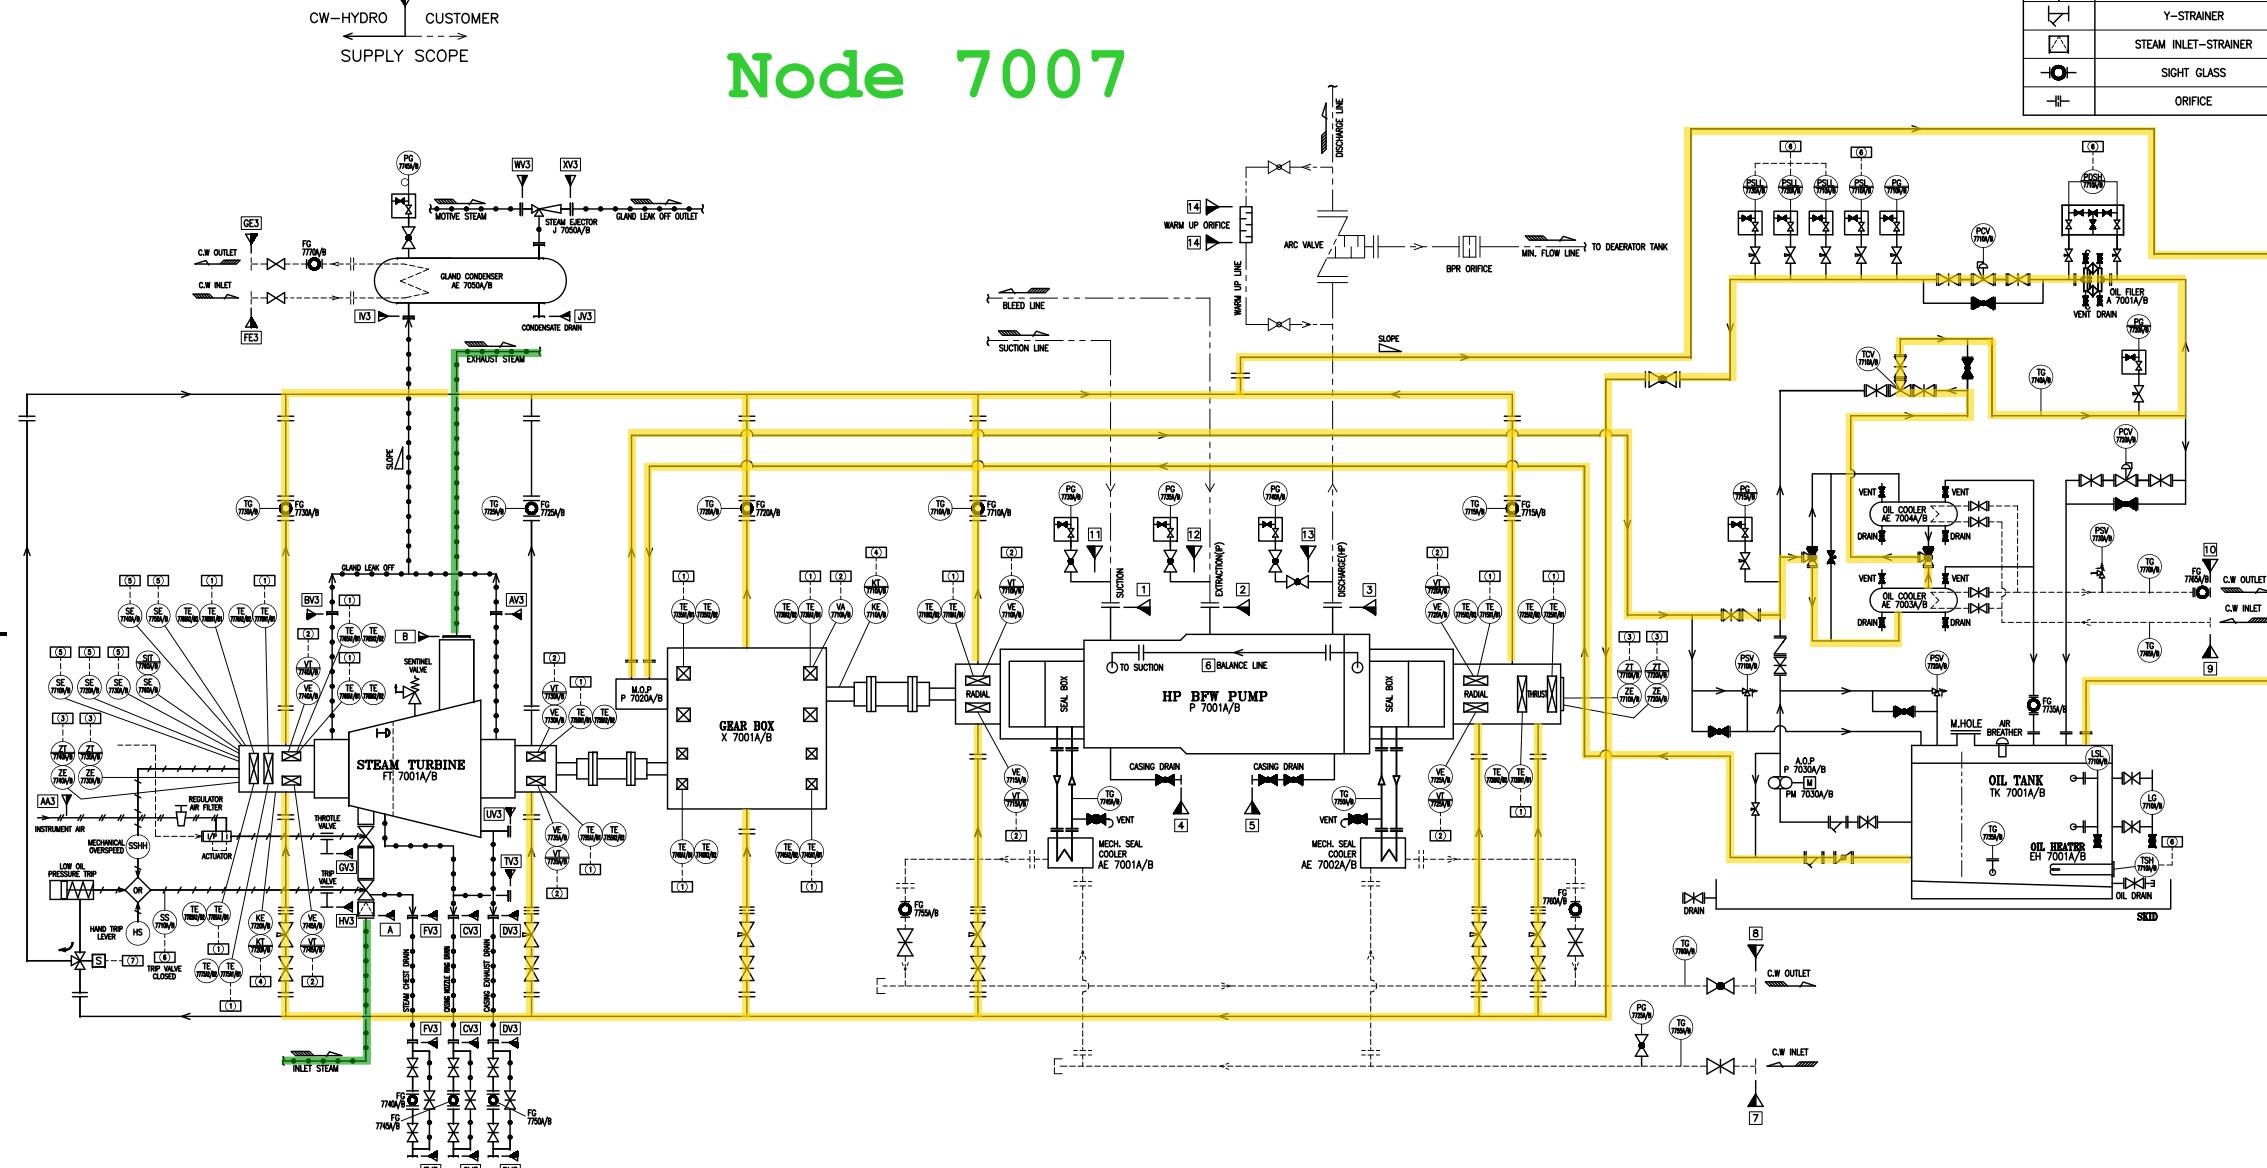

TERMINAL POINTS for TURBINE

NO.	DESCRIPTION	RATING & SIZE
A	STEAM TURBINE INLET	DN150 ASME 600LB RF
B	STEAM TURBINE EXHAUST	DN300 ASME 150LB RF
AV3	PACKING CASE LEAK OFF	LATER
BV3	PACKING CASE LEAK OFF	LATER
CV3	STEAM TURBINE CASE NOZZLE RING DRAIN	DN20 ASME 600LB RF
DV3	STEAM TURBINE CASING EXHAUST	DN20 ASME 150LB RF
FV3	STEAM CHEST DRAIN	DN20 ASME 600LB RF
GV3	STEAM CHEST COVER LEAK OFF - GOVERNOR V/V	DN15 ASME 150LB SW RF
HV3	STEAM CHEST COVER LEAK OFF - TRIP V/V	DN20 ASME 150LB SW RF
IW3	GLAND CONDENSER - STEAM INLET	LATER
JV3	GLAND CONDENSER - CONDENSATE OUTLET	LATER
TV3	PROVISION FOR 1ST STAGE PRESS. MEASUREMENT	DN20 ASME 600LB RF
UV3	PROVISION FOR EXHAUST PRESS. MEASUREMENT	DN20 ASME 150LB RF
XV3	STEAM EJECTOR - OUTLET	LATER
WV3	STEAM EJECTOR - INLET MOTIVE STEAM	LATER
FE3	C.W. INLET FOR STEAM GLAND	LATER
GE3	C.W. OUTLET FOR STEAM GLAND	LATER
AA3	ACTUATOR AIR INLET	1/4" NPT F

(1)	TEMPERATURE ELEMENT RTD	(2)	VIBRATION SENSOR	(3)	AXIAL DISPLACEMENT SENSOR	(4)	KEY PHASOR SENSOR	(5)	SPEED SENSOR	(6)	SWITCH
	TE-7710A/B, TE-7715A/B, TE-7720A/B, TE-7725A/B (DOUBLE ELEMENT)		VE-7710A/B, VE-7715A/B, VE-7720A/B, VE-7725A/B		ZE-7710A/B, ZE-7715A/B, ZE-7720A/B		KE-7710A/B, KE-7720A/B		SLB-7710A/B, SLB-7715A/B, SLB-7720A/B		PC-7710A/B
	GEAR BOX TEMPERATURE TE-7730A/B, TE-7735A/B, TE-7740A/B, TE-7745A/B (DOUBLE ELEMENT)		GEAR BOX VIBRATION VA-7710A/B		STEAM TURBINE AXIAL DISPLACEMENT ZE-7730A/B, ZE-7740A/B				STEAM TURBINE OVERSPEED PROTECTION SE-7710A/B, SE-7720A/B, SE-7730A/B		
	STEAM TURBINE TEMPERATURE TE-7750A/B, TE-7755A/B, TE-7760A/B, TE-7765A/B TE-7770A/B, TE-7775A/B, TE-7780A/B, TE-7785A/B (DOUBLE ELEMENT)		STEAM TURBINE VIBRATION VE-7730A/B, VE-7735A/B, VE-7740A/B, VE-7745A/B						PSL-7710A/B, PSL-7720A/B, PSL-7730A/B PSL-7710A/B, PSLL-7720A/B, PSLL-7730A/B TSH-7710A/B		
									STEAM TURBINE LIMIT SWITCH SS-7710A/B		

▲ Issued For Approval	21.02.2017	Y.S. HAN	Y.S. HAN	G.M. KANG	M.Y. LEE	M.Y. LEE
REV. PURPOSE OF ISSUE	DATE	DESIGN	DRAW	CHECK	REVIEW	APPROVE
THIS DOCUMENT IS THE PROPERTY OF TOC. NO PART OF THIS DOCUMENT SHALL BE REPRODUCED OR DISCLOSED TO OTHERS OR USED FOR ANY PURPOSE WHATSOEVER EXCEPT WITH THE PRIOR WRITTEN PERMISSION OF TOC.						
OWNER:						
Middle East						
Kimiaye Pars Company						
CONTRACTOR:	HALDOR TOPSØE A/S					
CONTRACTOR:	TCC CHINA TIANCHEN ENGINEERING CORPORATION					
CONTRACTOR:	CW-Hydro, Inc.					
PROJECT	MKP-VD-9000-303-150-A3					
UNIT	General Technical					
PHASE	Detail Engineering					
SCALE 1:1	Sheet 03	Total 03	Size A3	Owner DWG No.	MKP-VD-9000-303-150-A3	
Counter Signing	Sign	Date				

CUSTOMER : MIDDLE EAST KIMIAYE PARS COMPANY
 PUMP MODEL : DST 200x150-11S
 ITEM NO. : P 7001A/B
 SERVICE : BFW PUMP
 SITE : ASSLUYEH, IRAN

INSTRUMENTS		
MEASURING ITEM 1ST LETTER	SERVICE 2ND LETTER	SERVICE 3RD LETTER
P	C	H HIGH
PD	E	HH HIGH HIGH
T	G	L LOW
L	S	LL LOW LOW
F	T	
V	P	
K	A	
S	V	
G		


SYMBOL	DESCRIPTION	SYMBOL	DESCRIPTION
○	LOCAL FIELD MOUNTED INSTRUMENT	△	OPEN GATE VALVE
○	LOCAL PANEL MOUNTED INSTRUMENT	△	CLOSED GATE VALVE
□	FIELD → DCS	△	GLOBE VALVE
◇	INTERLOCK	△	BALL VALVE
—	SEALING WATER LINE	△	NEEDLE VALVE
→	LUB. OIL RECIRCULATION LINE	△	CHECK VALVE
—	COOLING WATER LINE	△	SCREW DOWN CHECK VALVE
—	STEAM LINE	△	J-WAY BALL VALVE
—	INSTRUMENT AIR	△	TEMPERATURE CONTROL VALVE(TCV)
—	DATALINE OR SOFTWARE	△	PRESSURE REDUCING VALVE(PRV)
—	ELECTRIC SIGNAL	△	PRESSURE REGULATING VALVE(PRV)
		△	SAFETY RELIEF VALVE
		□	2-WAY MANIFOLD VALVE
		□	5-WAY MANIFOLD VALVE
		□	DUPLEX FILTER
		□	Y-STRAINER
		○	SIGHT GLASS
		—	ORIFICE

GENERAL NOTES


1.
 REFERENCE DRAWINGS

SYMBOLS AND LEGENDS

KEY PLAN

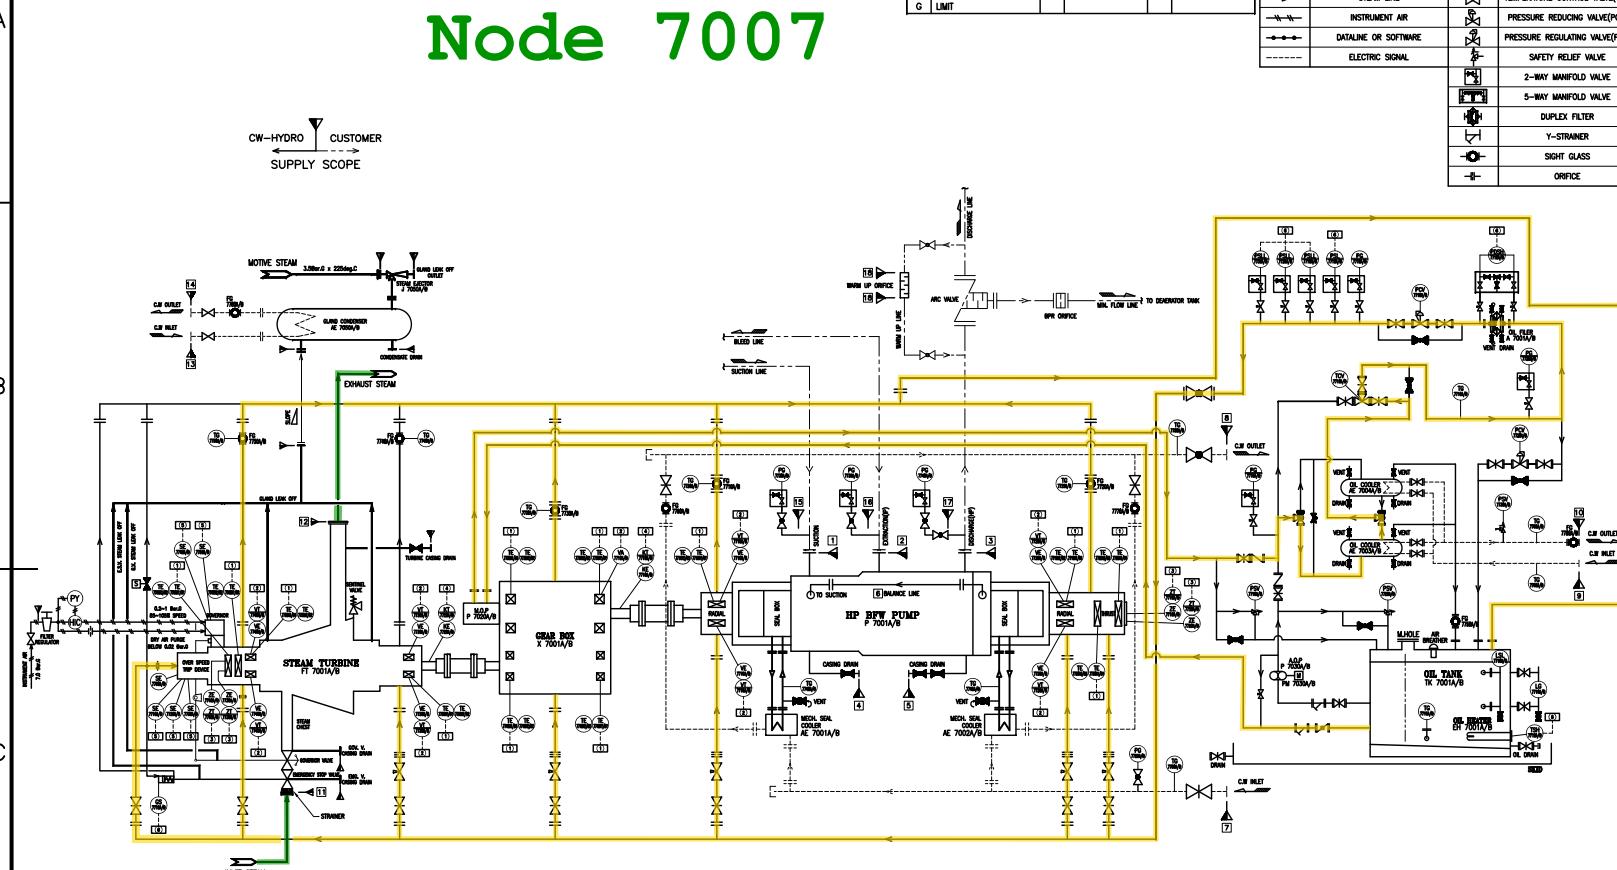

TERMINAL POINTS		
NO.	DESCRIPTION	RATING & SIZE
1	PUMP SUCTION	DN20 ASME 150LB RF
2	PUMP EXTRACTION	DN50 ASME 600LB SW RF
3	PUMP DISCHARGE	DN150 ASME 1500LB RJT
4	CASING DRAIN(SUCTION SIDE)	DN25 ASME 300LB SW RF
5	CASING DRAIN(DISCHARGE SIDE)	DN25 ASME 1500LB SW RF
6	BALANCE LINE	DN40 ASME 300LB SW RF
7	C.W. INLET FOR M/S COOLER	DN40 ASME 150LB SW RF
8	C.W. OUTLET FOR M/S COOLER	DN40 ASME 150LB SW RF
9	C.W. INLET FOR LUBE. OIL COOLER	DN40 ASME 150LB SW RF
10	C.W. OUTLET FOR LUBE. OIL COOLER	DN40 ASME 150LB SW RF
11	STEAM TURBINE INLET	DN150 ASME 600LB RF
12	STEAM TURBINE EXHAUST	DN300 ASME 150LB RF
13	C.W. INLET FOR STEAM GLAND	DN65 ASME 150LB SW RF
14	C.W. OUTLET FOR STEAM GLAND	DN65 ASME 150LB SW RF
15	SUCTION PRESSURE GAUGE	DN15 600LB SW
16	EXTRACTION PRESSURE GAUGE	DN15 600LB SW
17	DISCHARGE PRESSURE GAUGE	DN15 1500LB SW
18	WARM UP LINE ORIFICE	DN20 ASME 1500LB SW RF

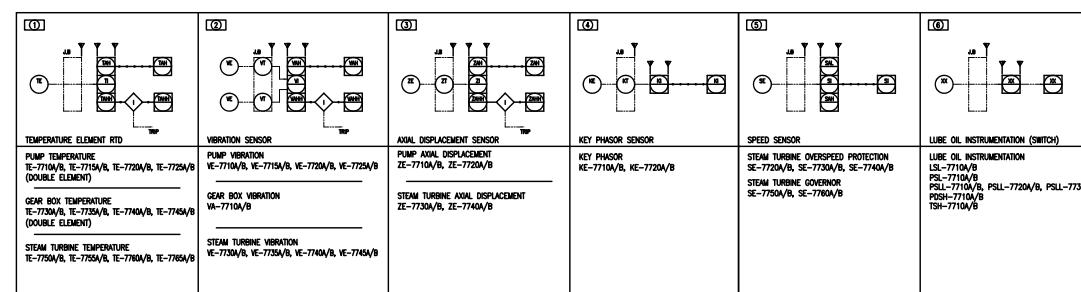

APPROVED FOR ISSUE 14/02/2017 Y.S. HAN Y.S. JAHN G.M. KWON M.Y. LEE K.Y. LEE
 PURPOSE OF ISSUE DESIGN DRAWING
 THIS DOCUMENT IS THE PROPERTY OF TOC. NO PART OF THIS DOCUMENT SHALL BE REPRODUCED OR DISCLOSED
 TO OTHERS OR USED FOR ANY PURPOSE WHATSOEVER EXCEPT WITH THE PRIOR WRITTEN PERMISSION OF TOC.

OWNER: Middle East Kimiaye Pars Company

HALDOR TOPSØE A/S	CONTRACTOR DRAWING NO.
TCC + 中国天机工程有限公司	MOP-VO-9000-303-150-A3
	SHEET 03 TOTAL 03
	VENDOR DRAWING NO.
	PROJECT IMP Methanol Project
	UNIT General Technical
	PHASE Detail Engineering
Customer Status	Date
Sign	Date
Scale 1:1	Sheet 03
Total 03	Size A3
Owner DWG NO.	MOP-VO-9000-303-150-A3

CUSTOMER : MIDDLE EAST KIMIAYE PARS COMPANY
PUMP MODEL : DS 700x600-8G
ITEM NO. : P 0501 1/2
SERVICE : TURBINE DRIVEN COOLING WATER PUMP
SITE : ASSLUYEH, IRAN

TERMINAL POINTS for PUMP		
NO.	DESCRIPTION	RATING & SIZE
[1]	PUMP SUCTION	DN700 ASME 150LB RF
[2]	PUMP DISCHARGE	DN600 ASME 150LB RF
[3]	SUCTION PRESSURE GAUGE	DN15 150LB SW
[4]	DISCHARGE PRESSURE GAUGE	DN15 150LB SW
[5]	C.W. INLET FOR LUBE. OIL COOLER	DN40 150LB SW
[6]	C.W. OUTLET FOR LUBE. OIL COOLER	DN40 150LB SW

INSTRUMENTS		
MEASURING ITEM	SERVICE	SERVICE
1ST LETTER	2ND LETTER	3RD LETTER
P	PRESSURE	C CONTROL
PD	DIFF. PRESSURE	E ELEMENT
T	TEMPERATURE	G GAUGE
L	LEVEL	S SWITCH
F	FLOW	T TRANSMITTER
V	VIBRATION	P PROXIMITOR
K	KEY PHASER	A ACCELEROMETER
S	SPEED / SAFETY	V VALVE
Z	POSITION	

SYMBOL	DESCRIPTION	SYMBOL	DESCRIPTION
○	LOCAL FIELD MOUNTED INSTRUMENT	△	NORMAL OPEN
○	LOCAL PANEL MOUNTED INSTRUMENT	□	NORMAL CLOSE
□	FIELD -> DCS	△	NORMAL OPEN
□	INTERLOCK	□	NORMAL CLOSE
→	SEALING WATER LINE	↑↓	CHECK VALVE
→	LUB. OIL RECIRCULATION LINE	↑↓	SCREW DOWN CHECK VALVE
---	COOLING WATER LINE	☒	3-WAY BALL VALVE
●●	STEAM LINE	☒	TEMPERATURE CONTROL VALVE(TCV)
##	INSTRUMENT AIR	☒	PRESSURE REDUCING VALVE(PRV)
-/-	MECHANICAL LINK	☒	PRESSURE REGULATING VALVE(PRV)
---	ELECTRIC SIGNAL	☒	SAFETY RELIEF VALVE
---		☒	2-WAY MANIFOLD VALVE
---		☒	5-WAY MANIFOLD VALVE
---		☒	DUPLEX FILTER
---		☒	Y-STRAINER
---		☒	STEAM INLET-STRAINER
○○	SIGHT GLASS	---	ORIFICE


GENERAL NOTES

1.	REFERENCE DRAWINGS

SYMBOLS AND LEGENDS

1. ☐ MECHANICAL ACTION ON TRIP VALVE CAN OCCURE FROM ANY OF THE 3 CONDITIONS HAND TRIP LEVER, MECHANICAL OVERSPEED OR LOPT

KEY PLAN

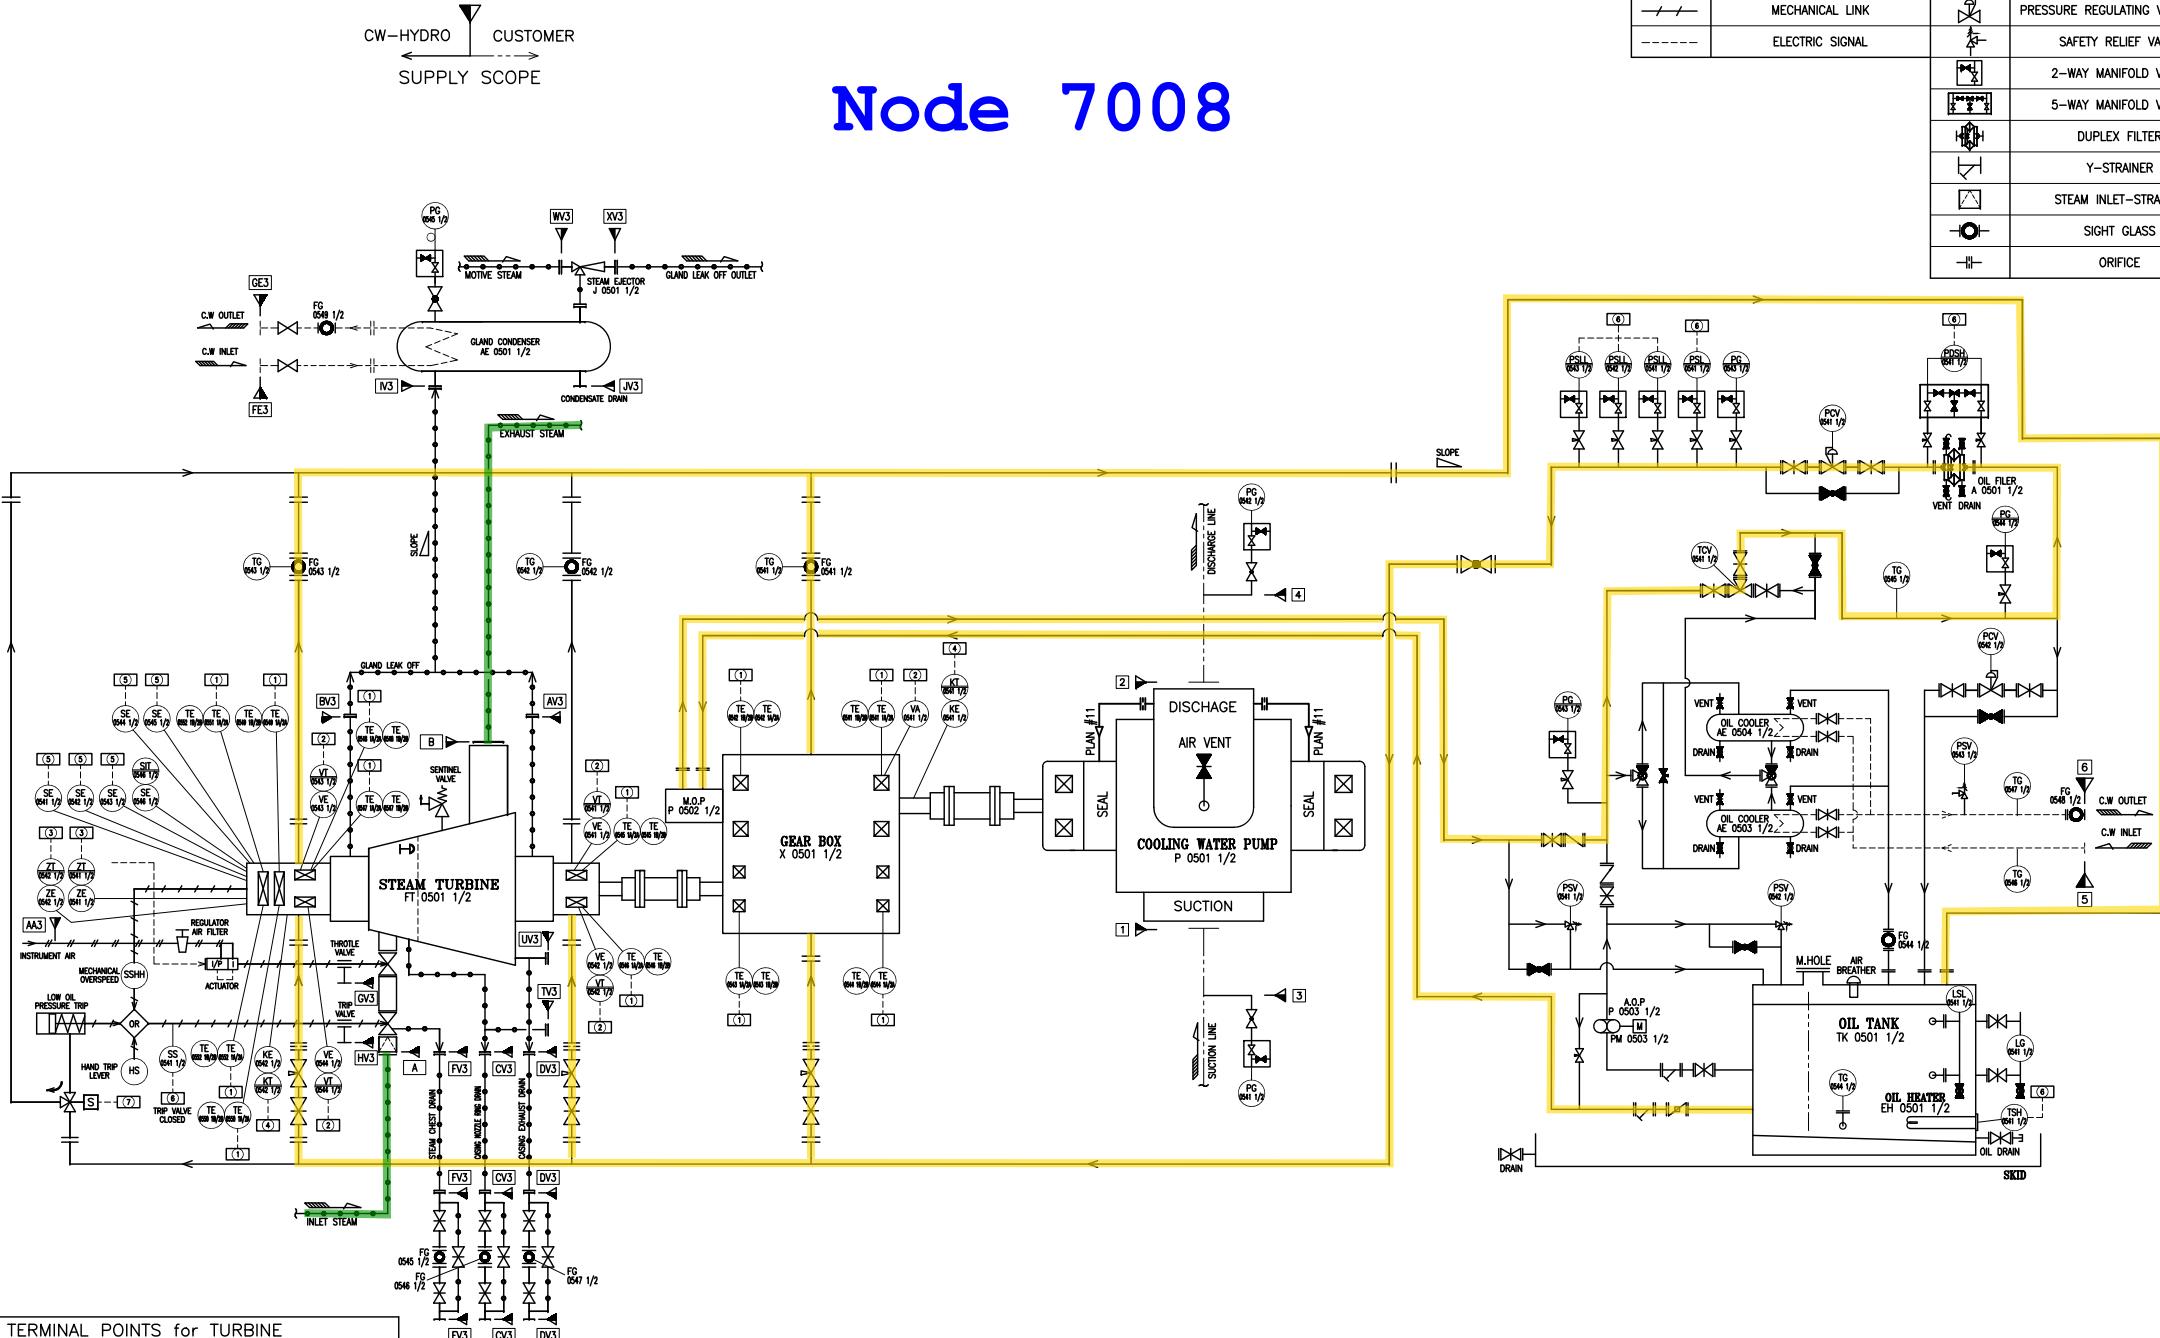

TERMINAL POINTS for TURBINE

NO.	DESCRIPTION	RATING & SIZE
[A]	STEAM TURBINE INLET	DN100 ASME 600LB RF
[B]	STEAM TURBINE EXHAUST	DN200 ASME 150LB RF
[AV3]	PACKING CASE LEAK OFF	LATER
[BV3]	PACKING CASE LEAK OFF	LATER
[CV3]	STEAM TURBINE CASE NOZZLE RING DRAIN	DN20 ASME 600LB RF
[DV3]	STEAM TURBINE Casing EXHAUST	DN20 ASME 150LB RF
[FV3]	STEAM CHEST DRAIN	DN20 ASME 600LB RF
[GV3]	STEAM CHEST COVER LEAK OFF - GOVERNOR V/V	DN15 ASME 150LB SW RF
[HV3]	STEAM CHEST COVER LEAK OFF - TRIP V/V	DN20 ASME 150LB SW RF
[IV3]	GLAND CONDENSER - STEAM INLET	LATER
[JV3]	GLAND CONDENSER - CONDENSATE OUTLET	LATER
[TV3]	PROVISION FOR 1ST STAGE PRESS. MEASUREMENT	DN20 ASME 600LB RF
[UV3]	PROVISION FOR EXHAUST PRESS. MEASUREMENT	DN20 ASME 150LB RF
[XV3]	STEAM EJECTOR - OUTLET	LATER
[WV3]	STEAM EJECTOR - INLET MOTIVE STEAM	LATER
[FE3]	C.W. INLET FOR STEAM GLAND	LATER
[GE3]	C.W. OUTLET FOR STEAM GLAND	LATER
[AA3]	ACTUATOR AIR INLET	1/4" NPT F

(1)	GEAR BOX TEMPERATURE TE-0541 1/2, TE-0542 1/2, TE-0543 1/2 TE-0544 1/2(DOUBLE ELEMENT)	(2)	GEAR BOX VIBRATION VA-0541 1/2	(3)	STEAM TURBINE AXIAL DISPLACEMENT ZE-0541 1/2, ZE-0542 1/2, SE-0543 1/2	(4)	KEY PHASOR KE-0541 1/2, KE-0542 1/2, SE-0543 1/2	(5)	STEAM TURBINE OVERSPEED PROTECTION LSL-0541 1/2 PSL-0541 1/2 PSL-0541 1/2, PSL-0542 1/2, PS66-0543 1/2
(6)	STEAM TURBINE TEMPERATURE TE-0548 1/2, TE-0549 1/2, TE-0550 1/2 TE-0551 1/2, TE-0552 1/2(DOUBLE ELEMENT)	(7)	STEAM TURBINE VIBRATION VE-0541 1/2, VE-0542 1/2 VE-0543 1/2, VE-0544 1/2	(8)	STEAM TURBINE AXIAL DISPLACEMENT ZE-0541 1/2, ZE-0542 1/2, SE-0543 1/2	(9)	STEAM TURBINE GOVERNOR SE-0544 1/2, SE-0545 1/2	(10)	STEAM TURBINE LIMIT SWITCH SS-0541 1/2

▲ Issued For Approval 21.02.2017 Y.S. HAN Y.S. HAN G.M. KANG M.Y. LEE M.Y. LEE
REV. PURPOSE OF ISSUE DATE DESIGN DRAW CHECK REVIEW APPROVE
THIS DOCUMENT IS THE PROPERTY OF TOC. NO PART OF THIS DOCUMENT SHALL BE REPRODUCED OR DISCLOSED
TO OTHERS OR USED FOR ANY PURPOSE WHATSOEVER EXCEPT WITH THE PRIOR WRITTEN PERMISSION OF TOC.
OWNER:

Middle East
Kimiaye Pars Company

HALDOR TOPSE A/S
CONTRACTOR DRAWING NO.
MKP-VD-9000-311-200-A3
SHEET 03 TOTAL 03
TCC CHINA TIANCHEN ENGINEERING CORPORATION
VENDOR DRAWING NO.
CW-Hydro, Inc.
PROJECT MKP Method Project
UNIT General Technical
PHASE Detail Engineering
SHEET 03 TOTAL 03
Counter Signing Sign Date
SCALE 1:1 SHEET 03 TOT. 03 SIZE A3
OWNER NO. MKP-VD-9000-311-200-A3

CUSTOMER : MIDDLE EAST KIMIYE PARS COMPANY
PUMP MODEL : DS 700x600-8G
ITEM NO. : P 0502 A/B
SERVICE : MOTOR DRIVEN COOLING WATER PUMP
SITE : ASSLUYEH, IRAN

INSTRUMENTS	
MEASURING ITEM 1ST LETTER	SERVICE 2ND LETTER
P PRESSURE	E ELEMENT
T TEMPERATURE	G GAUGE

SYMBOL	DESCRIPTION
↗	NORMAL OPEN GATE VALVE
↘	NORMAL CLOSE GLOBE VALVE
↔	NORMAL OPEN 2-WAY MANIFOLD VALVE
↔	NORMAL CLOSE ORIFICE
○	LOCAL FIELD MOUNTED INSTRUMENT
□	FIELD -> DCS
◇	INTERLOCK
→	SEALING WATER LINE

GENERAL NOTES

1.

REFERENCE DRAWINGS



Node 7008

TERMINAL POINTS

NO.	DESCRIPTION	RATING & SIZE
[1]	PUMP SUCTION	DN700 ASME 150LB RF
[2]	PUMP DISCHARGE	DN600 ASME 150LB RF
[3]	SUCTION PRESSURE GAUGE	DN15 150LB SW
[4]	DISCHARGE PRESSURE GAUGE	DN15 150LB SW

SYMBOLS AND LEGENDS

KEY PLAN

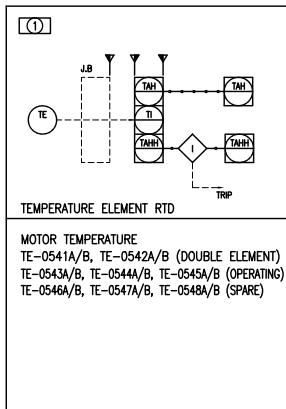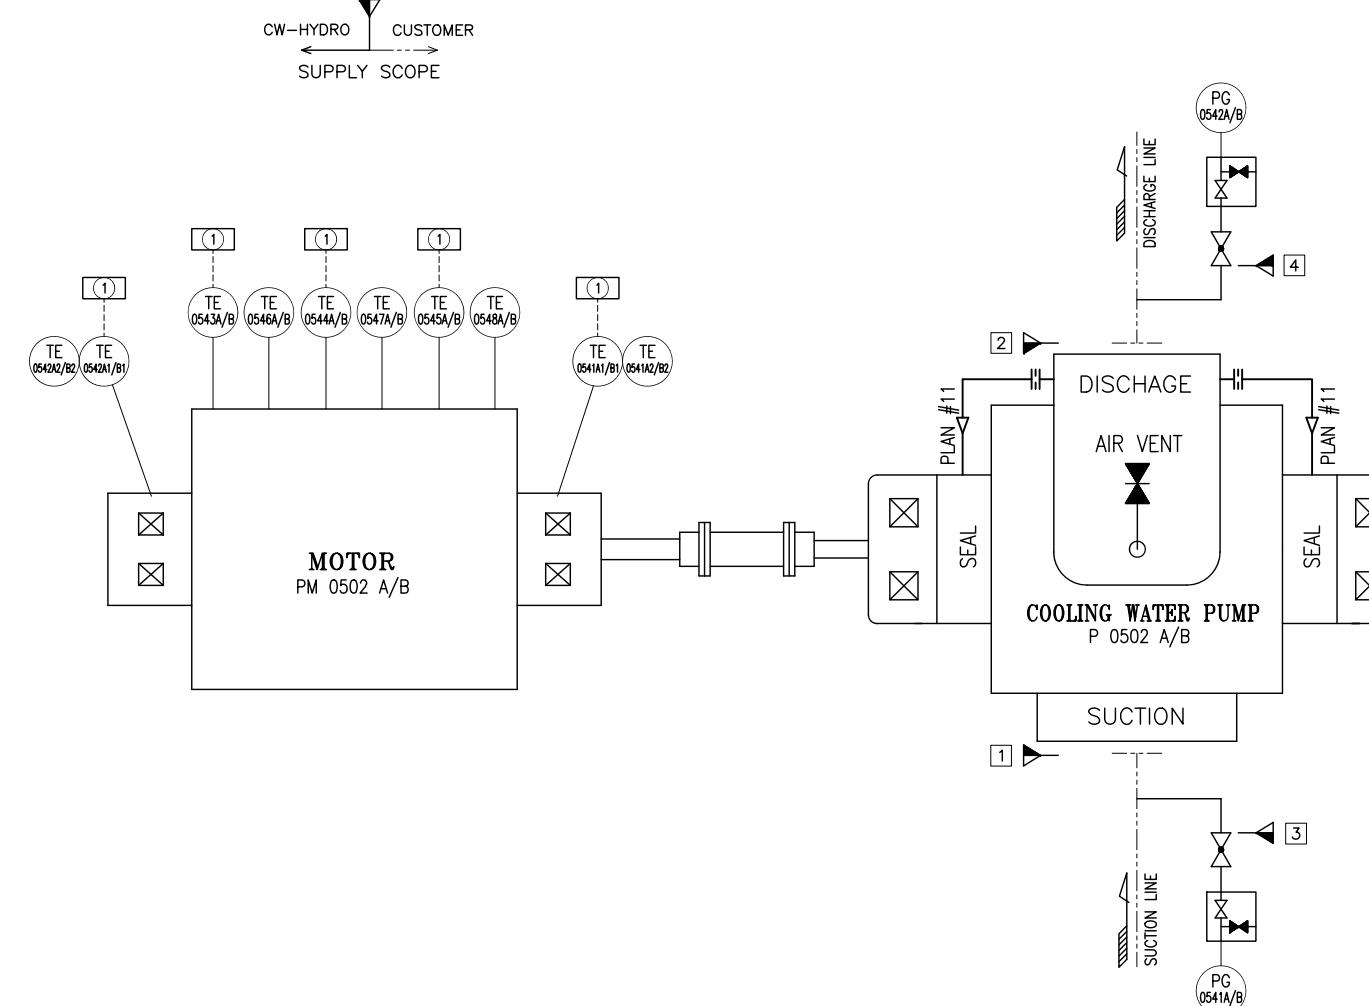

▲ Issued For Approval 20.02.2017 Y.S. HAN Y.S. HAN GM. KANG M.Y. LEE M.Y. LEE
REV. PURPOSE OF ISSUE DATE DESIGN DRAW CHECK REVIEW APPROVE
THIS DOCUMENT IS THE PROPERTY OF TOC. NO PART OF THIS DOCUMENT SHALL BE REPRODUCED OR DISCLOSED
TO OTHERS OR USED FOR ANY PURPOSE WHATSOEVER EXCEPT WITH THE PRIOR WRITTEN PERMISSION OF TOC.

OWNER:

Middle East
Kimiye Pars Company

HALDOR TOPSE A/S
CONTRACTOR

CONTRACTOR DRAWING NO.
MKP-V0-9000-311-205-A3
SHEET 03 TOTAL 03

VENDOR


VENDOR DRAWING NO.
-
SHEET 03 TOTAL 03

PROJECT MKP Method Project
UNIT General Technical
PHASE Detail Engineering
OWNER DWG NO. MKP-V0-9000-311-205-A3
Counter Signing Sign Date SCALE 1:1 SHEET 03 TOT. 03 SIZE A3 OWNER DWG NO. MKP-V0-9000-311-205-A3

TCC CHINA TIANCHEN ENGINEERING CORPORATION

CW-Hydro, Inc.

P0502A/B_CW_PUMP
P&ID_WITH_SUPPLY_LIMIT_&_CONNECTION
PROJECT MKP Method Project
UNIT General Technical
PHASE Detail Engineering
OWNER DWG NO. MKP-V0-9000-311-205-A3
Counter Signing Sign Date SCALE 1:1 SHEET 03 TOT. 03 SIZE A3 OWNER DWG NO. MKP-V0-9000-311-205-A3

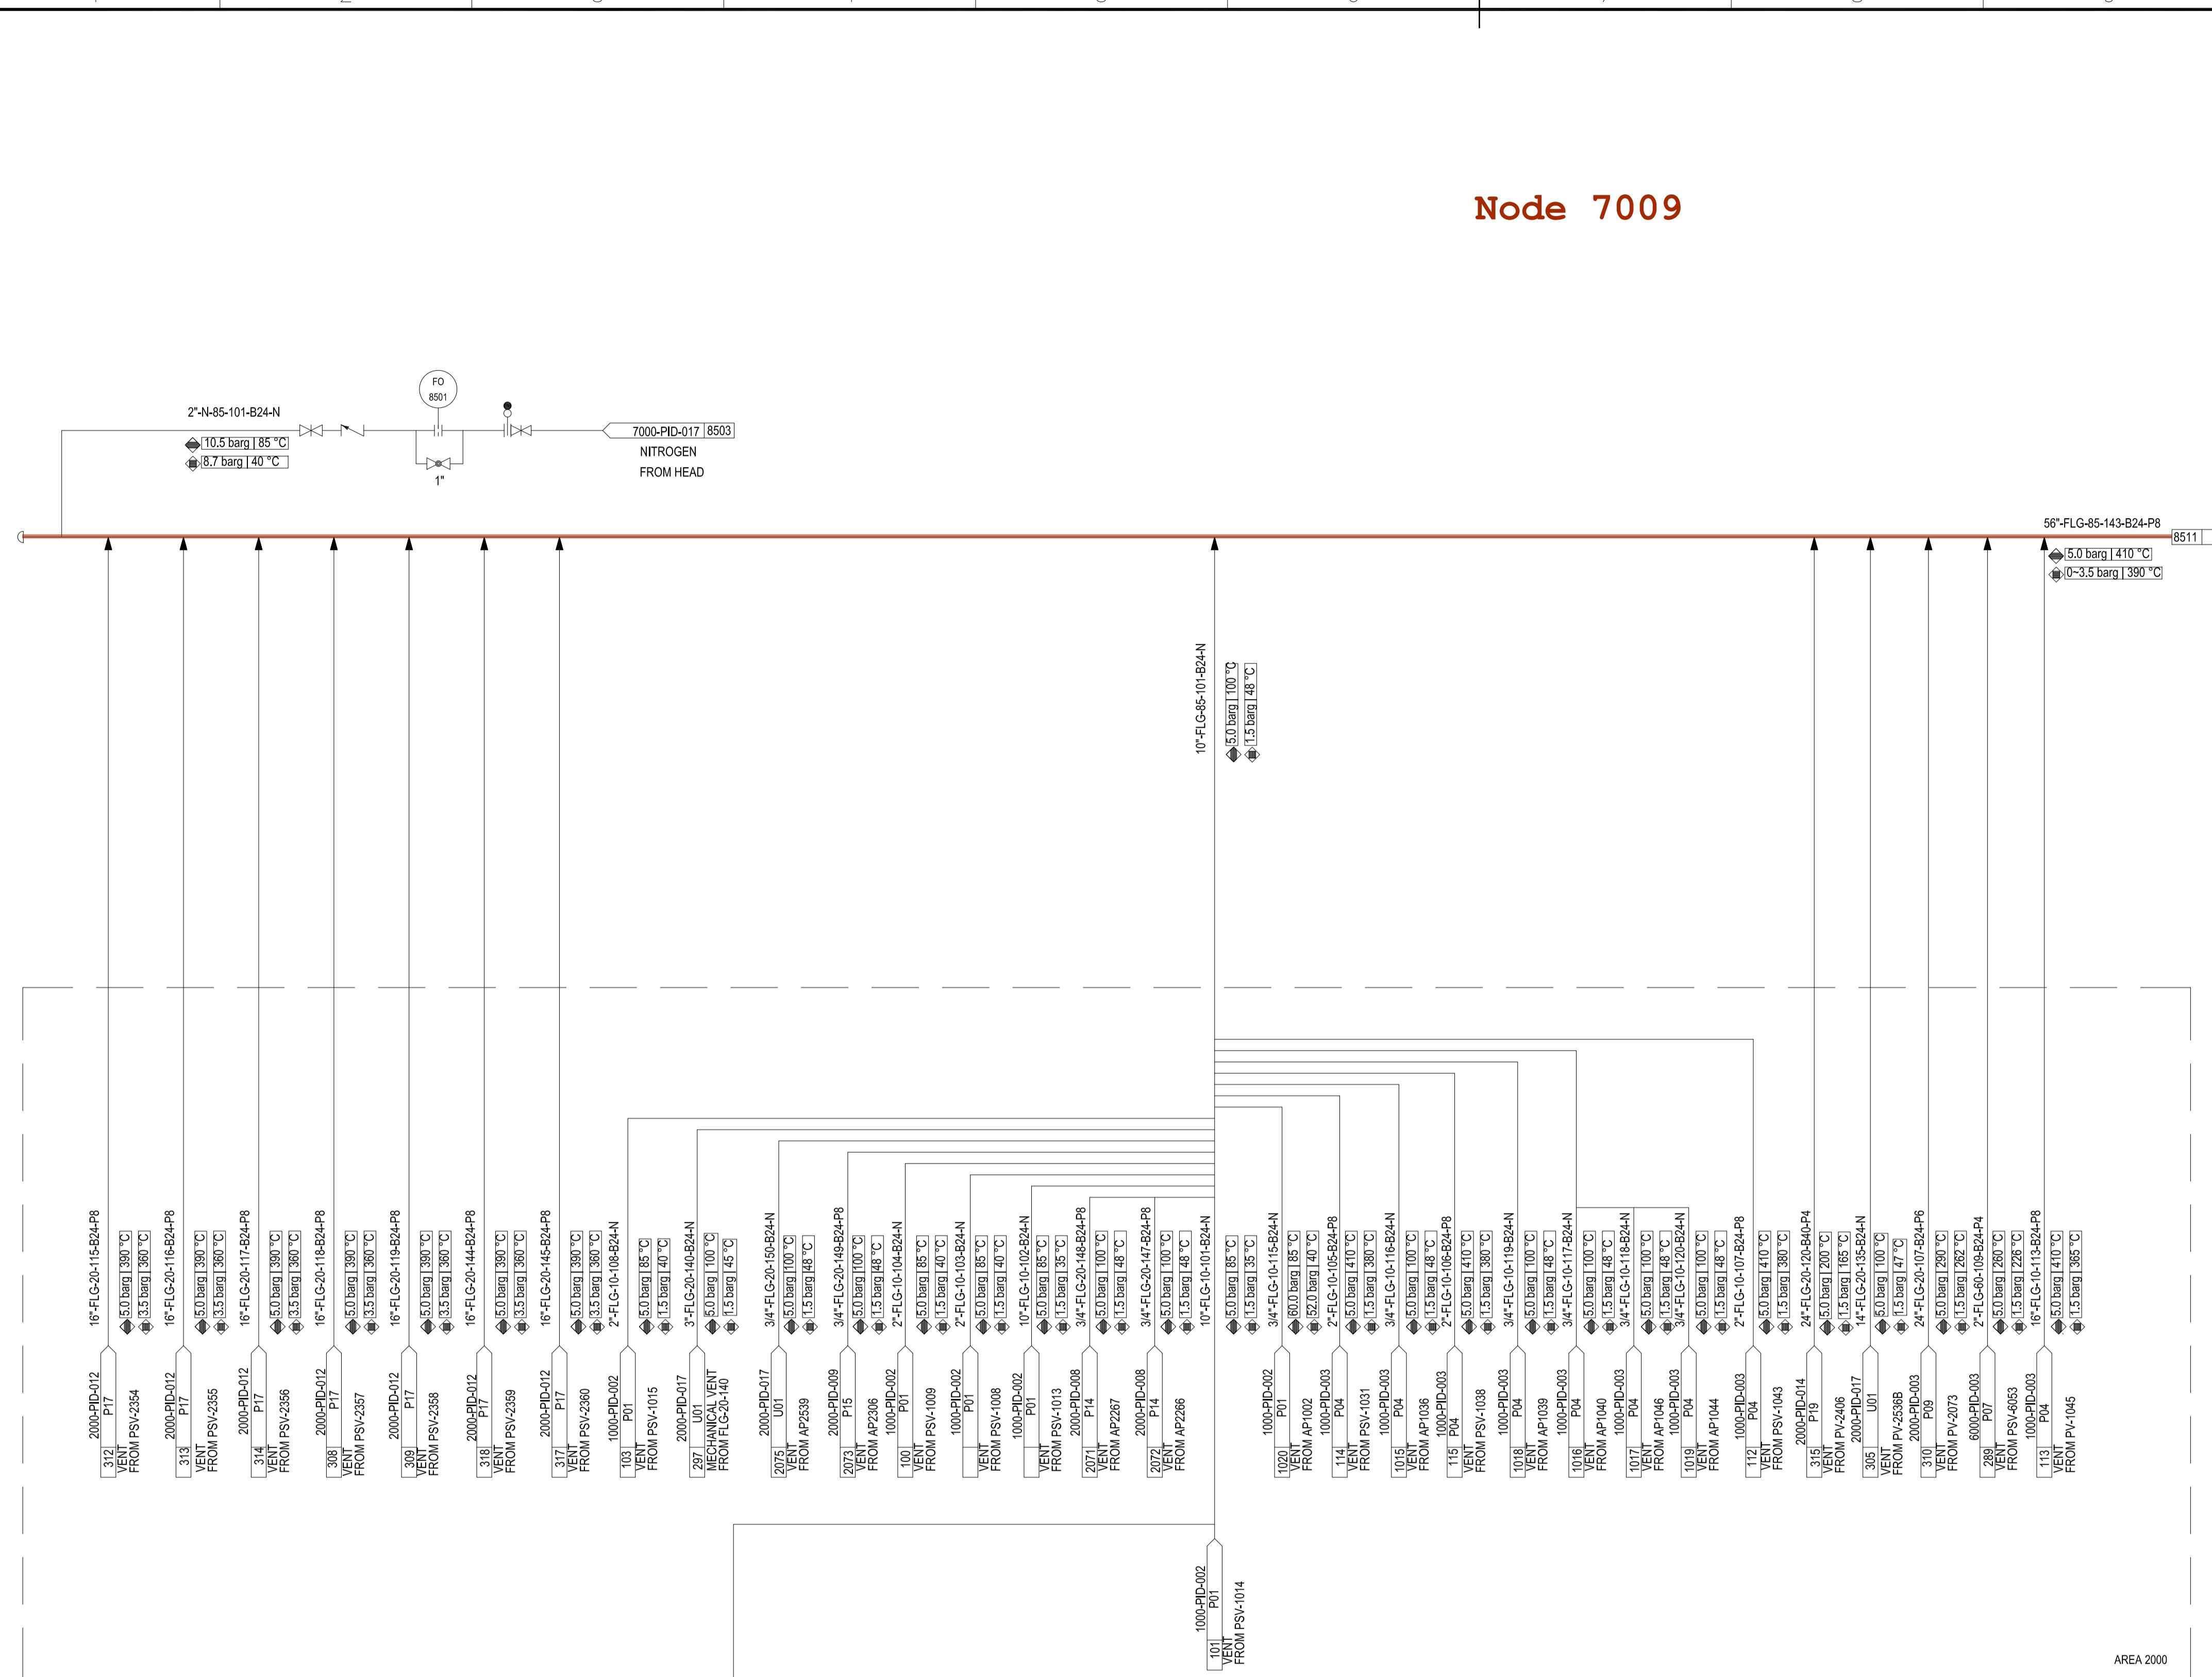

AREA 2000

GENERAL NOTES

*GENERAL NOTE:
LOW POINT DRAINS AND HIGH POINT VENT MUST BE ADDED.

*NOTE:
1) THE DIRECT ROUTING DISTANCE BETWEEN THE TIE-IN POINT LOCATION OF THE METHANOL PLANT AND THE ACTUAL FLARE SITE IS ABOUT 1600 M.
2) FOR THE FLARE PIPING ROUTING, ONE STRESS EXPANSION LOOP IS SET AT ABOUT EVERY 60M DISTANCE.

REFERENCE DRAWINGS

SYMBOLS AND LEGENDS

KEY PLAN

△ Approved For Construction	20.12.2016	Chen Tao	Xu Hong	Shi Jing		
△ Issued For Approval	12.10.2016	Chen Tao	Xu Hong	Shi Jing		
△ Issued For Review	31.8.2016	Chen Tao	Xu Hong	Shi Jing		
△ Issued For Comments	29.4.2016	Chen Tao	Xu Hong	Shi Jing		
REV. DESCRIPTION	DATE	DESIGN	DRAW	CHECK	REVIEW	APPROVE

THIS DOCUMENT IS THE PROPERTY OF TCC. NO PART OF THIS DOCUMENT SHALL BE REPRODUCED OR DISCLOSED TO OTHERS OR USED FOR ANY PURPOSE WHATSOEVER EXCEPT WITH THE PRIOR WRITTEN PERMISSION OF TCC.

OWNER:




Middle East
Kimiaye Pars Company

CONTRACTOR	LICENSOR	DOCUMENT NAME:	JOB NO. S-02115		DOC. GRP. 42	REV. ③
			DWG. NO. 1341775	DIAGRAM U19		
CONTRACTOR DRAWING NO. MKP-11-DE-8500-PS09-PID-001						
CHINA TIANCHEN ENGINEERING CORPORATION	Haldor Topsøe A/S	UTILITY DISTRIBUTION DIAGRAM FLARE HEADER I	SHEET 01	TOTAL 01		
SUB-CONTRACTOR DRAWING NO. —						
PROJECT MKP Methanol Project						
UNIT Flare						
PHASE Detail Engineering						
SCALE: -	SHEET: 1	TOT: 1	SIZE: A1	OWNER DWG. NO. MKP-11-DE-8500-PR-PID-001		
Counter Signing	Sign	Date				

GENERAL NOTES

- ⁺GENERAL NOTE:
LOW POINT DRAINS AND HIGH POINT VENT MUST BE ADDED.
- ⁺NOTE:
1) THE DIRECT ROUTING DISTANCE BETWEEN THE TIE-IN POINT LOCATION OF THE METHANOL PLANT AND THE ACTUAL FLARE SITE IS ABOUT 1600 M.
2) FOR THE FLARE PIPING ROUTING, ONE STRESS EXPANSION LOOP IS SET AT ABOUT EVERY 60M DISTANCE.

Node 7009

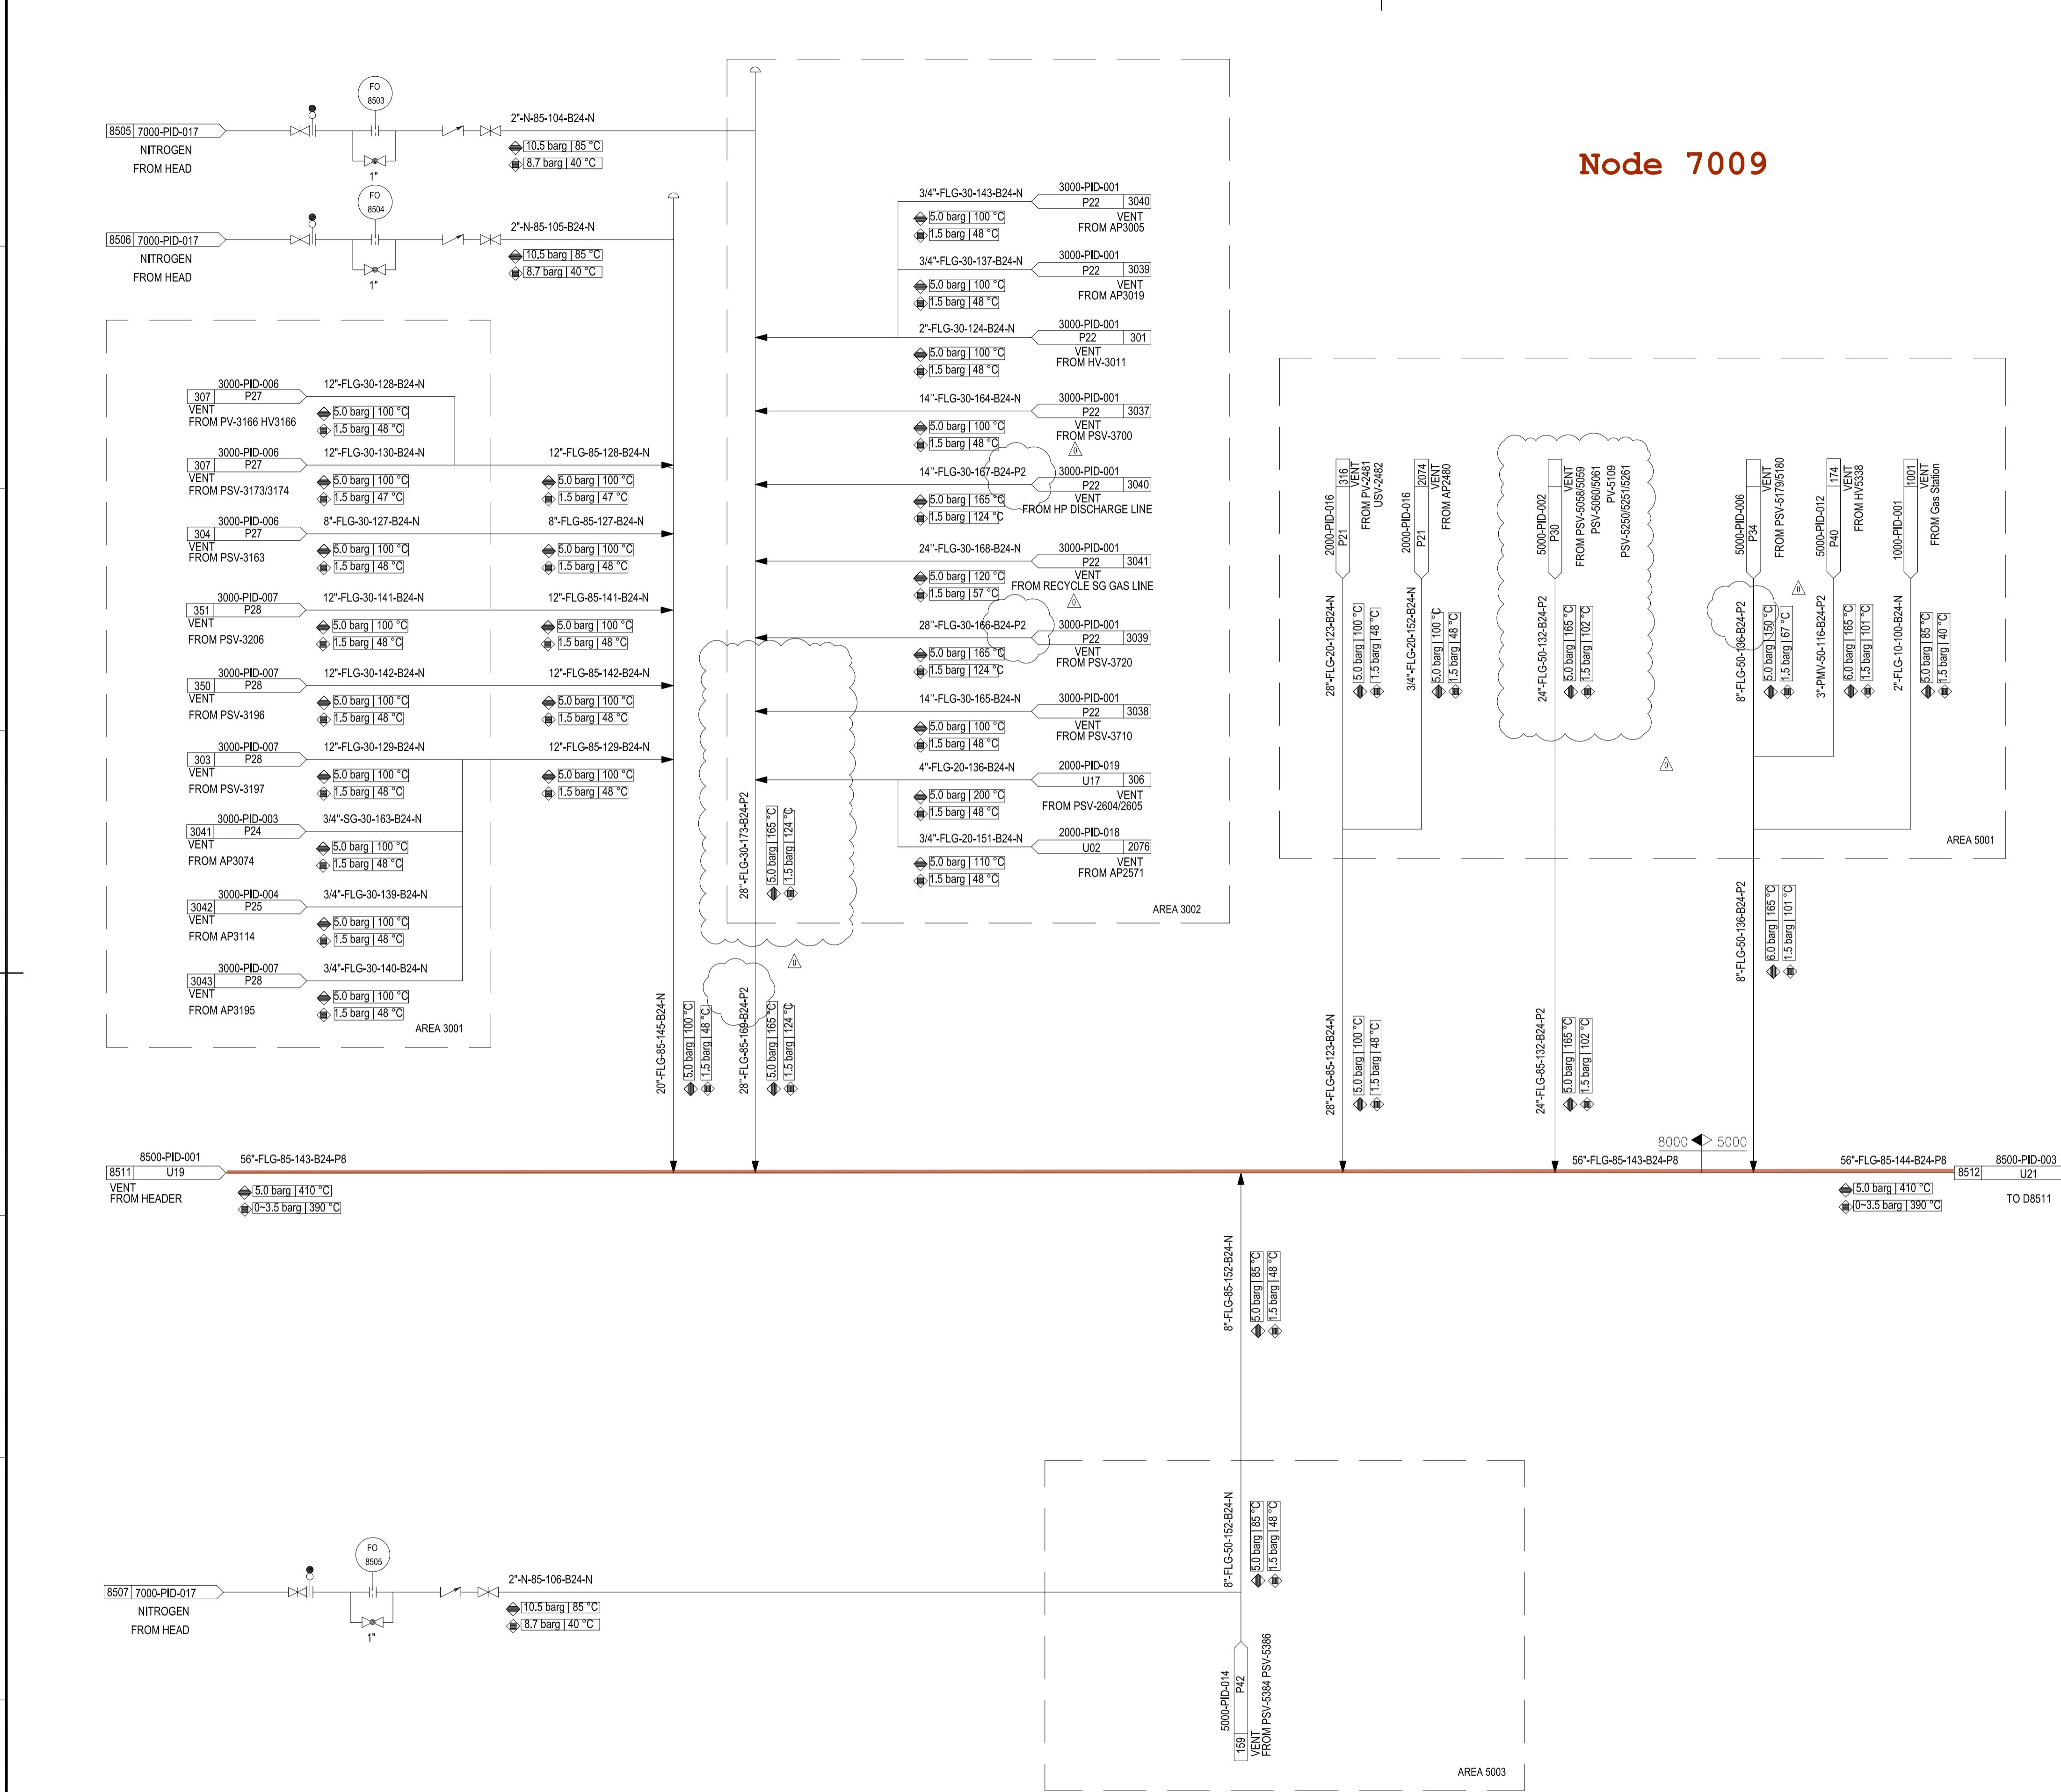

REFERENCE DRAWINGS

SYMBOLS AND LEGENDS

KEY PLAN


△	Approved For Construction	20.12.2016	Chen Tao	Xu Hong	Shi Jing		
△	Issued For Approval	12.10.2016	Chen Tao	Xu Hong	Shi Jing		
△	Issued For Review	31.8.2016	Chen Tao	Xu Hong	Shi Jing		
△	Issued For Comments	29.4.2016	Chen Tao	Xu Hong	Shi Jing		
REV.	DESCRIPTION	DATE	DESIGN	DRAW	CHECK	REVIEW	APPROVE
THIS DOCUMENT IS THE PROPERTY OF TCC. NO PART OF THIS DOCUMENT SHALL BE REPRODUCED OR DISCLOSED TO OTHERS OR USED FOR ANY PURPOSE WHATSOEVER EXCEPT WITH THE PRIOR WRITTEN PERMISSION OF TCC.							
OWNER:							
 Middle East Kimiaye Pars Company							
LICENSOR	HALDOR TOPSØE A/S COPENHAGEN DENMARK	DOCUMENT NAME: FLARE HEADER II UTILITY DIAGRAM	JOB NO. S-02115	DOC. GRP. 42	REV. 1		
CONTRACTOR	TCC CHINA TIANCHEN ENGINEERING CORPORATION	DWG NO. 1341776	DIAGRAM U20	CONTRACTOR DRAWING NO. MKP-11-DE-8500-PS09-PID-002			
SUB-CONTRACTOR	SUB-CONTRACTOR DRAWING NO. -					SHEET 01 TOTAL 01	
UTILITY DISTRIBUTION DIAGRAM FLARE HEADER II						PROJECT MKP Methanol Project	
						UNIT Flare	
						PHASE Detail Engineering	
SCALE:-	SHEET:1	TOT.:1	SIZE: A1	OWNER MKP-11-DE-8500-PR-PID-002	DWG NO.		
Counter Signing	Sign	Date					

1 2 3 4 5 6 7 8 9 10 11 12

P 8511	KNOCK OUT DRUM PUMP
CAPACITY	30 m ³ /h
HEAD	22 m
DENSITY	990 kg/m ³
INSULATION/TRACING	NONE
AUXILIARY PIPING	By Vendor
ELEV. of FOUNDATION	EL+100.600m

D 8511	FLARE KNOCK OUT DRUM
ID x LENGTH/T-T	5000 x 11000 mm
DESIGN PRESS.	5.5 barg
DESIGN TEMP.	410 °C
INSULATION	YES
CLADDING/LINING	NONE
ELEV. of FOUNDATION	EL+101.600m


Node 7009

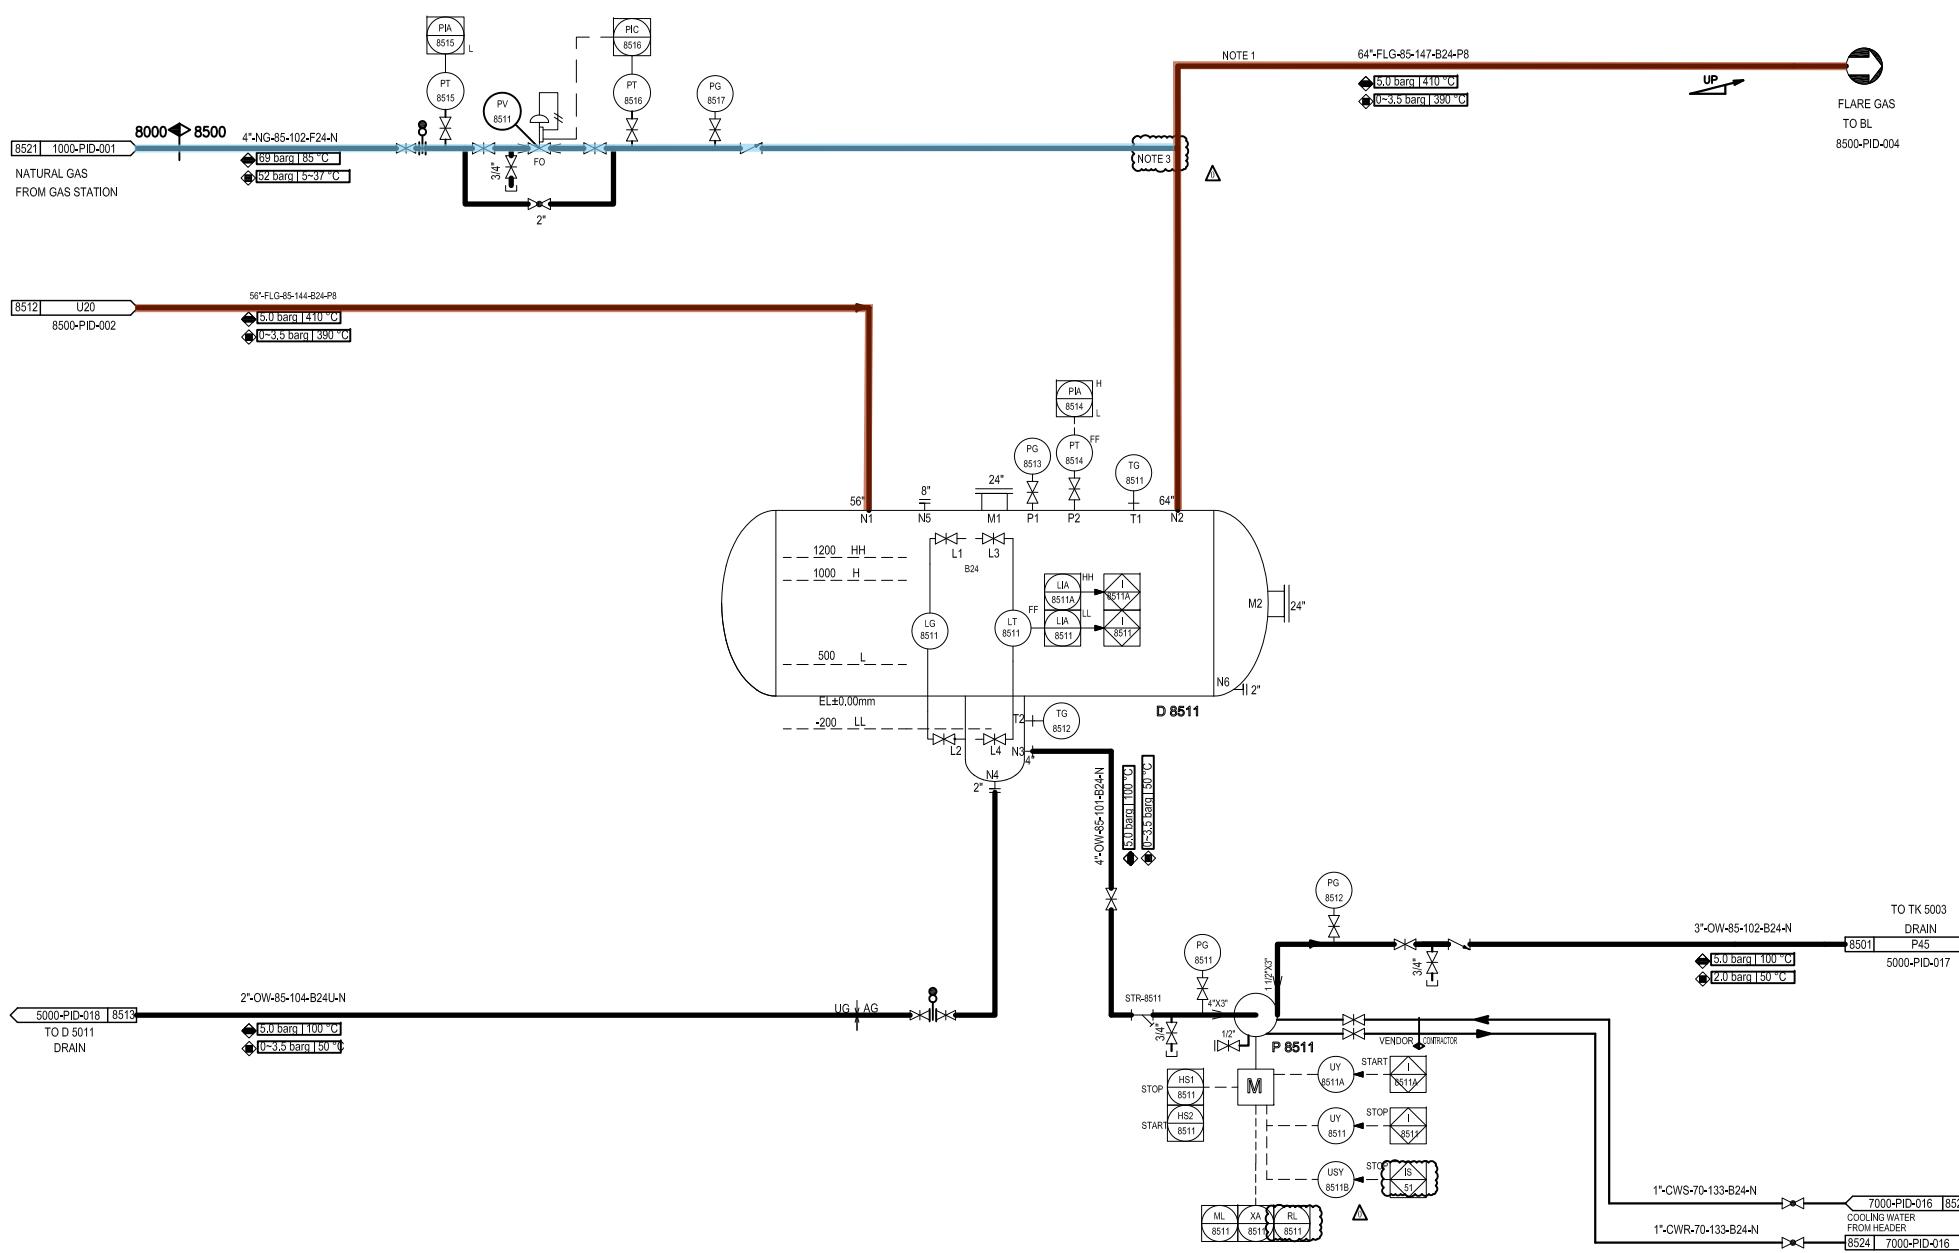

GENERAL NOTES

- + GENERAL NOTE:
 - 1) LOW POINT DRAINS AND HIGH POINT VENT MUST BE ADDED.
 - 2) FLARE LINE WITH AN UPWARD SLOPE SHALL ADD LOW POINT DRAINS.
- + NOTE:
 - 1) THE DIRECT ROUTING DISTANCE BETWEEN THE TIE-IN POINT LOCATION OF THE METHANOL PLANT AND THE ACTUAL FLARE SITE IS ABOUT 1600 M.
 - 2) FOR THE FLARE PIPING ROUTING, ONE STRESS EXPANSION LOOP IS SET AT ABOUT EVERY 60M DISTANCE.
 - 3) THIS CONNECTION POINT IS NEAR TO K.O.D INSIDE OF PLANT B.L.

REFERENCE DRAWINGS

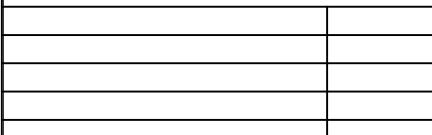

SYMBOLS AND LEGENDS



KEY PLAN

REV.	DESCRIPTION	DATE	DESIGN	DRAW	CHECK	REVIEW	APPROVE
THIS DOCUMENT IS THE PROPERTY OF TCC. NO PART OF THIS DOCUMENT SHALL BE REPRODUCED OR DISCLOSED TO OTHERS OR USED FOR ANY PURPOSE WHATSOEVER EXCEPT WITH THE PRIOR WRITTEN PERMISSION OF TCC.							

OWNER:




Middle East
Kimiaye Pars Company

LICENSOR	HALDOR TOPSØE A/S	DOCUMENT NAME: FLARE STACK SHEET DIAGRAM	JOB NO.: S-02115	DOC. NO.: 42	REV.: 1
CONTRACTOR					
CONTRACTOR	TCC + CHINA TIANCHEN ENGINEERING CORPORATION	CONTRACTOR DRAWING NO. MKP-11-DE-8500-PS09-PID-003	SHEET NO.: 01	TOTAL NO.: 01	
		SUB-CONTRACTOR DRAWING NO.	-	-	
		SHEET NO.: -	TOTAL NO.: -		
P&ID FLARE K.O. DRUM			PROJECT	MKP Methanol Project	
			UNIT	Flare	
			PHASE	Detail Engineering	
Counter Signing	Sign	Date	SCALE: -	SHEET: 1	TOT.: 1
OWNER DWG NO.			MKP-11-DE-8500-PR-PID-003		

1 2 3 4 5 6 7 8 9 10 11 12

1	2	3	4	5	6	7	8	9	10	11	12
A	D 8501 Knock-Out Drum ID x LENGTH(T-T) DESIGN PRESS. DESIGN TEMP. INSULATION CLADDING/LINING	2 HOLD mm 7.0 barg 410 °C YES NONE	FL 8501 Flare Stack ID x LENGTH(T-T) DESIGN PRESS. DESIGN TEMP. INSULATION	FL 8502 Flare Tip ID x LENGTH(T-T) DESIGN PRESS. DESIGN TEMP. INSULATION	FL 8503 Molecular Seal ID x LENGTH(T-T) DESIGN PRESS. DESIGN TEMP. INSULATION	E 8501 Electric Heater Power DESIGN PRESS. DESIGN TEMP. INSULATION					

Node 7009

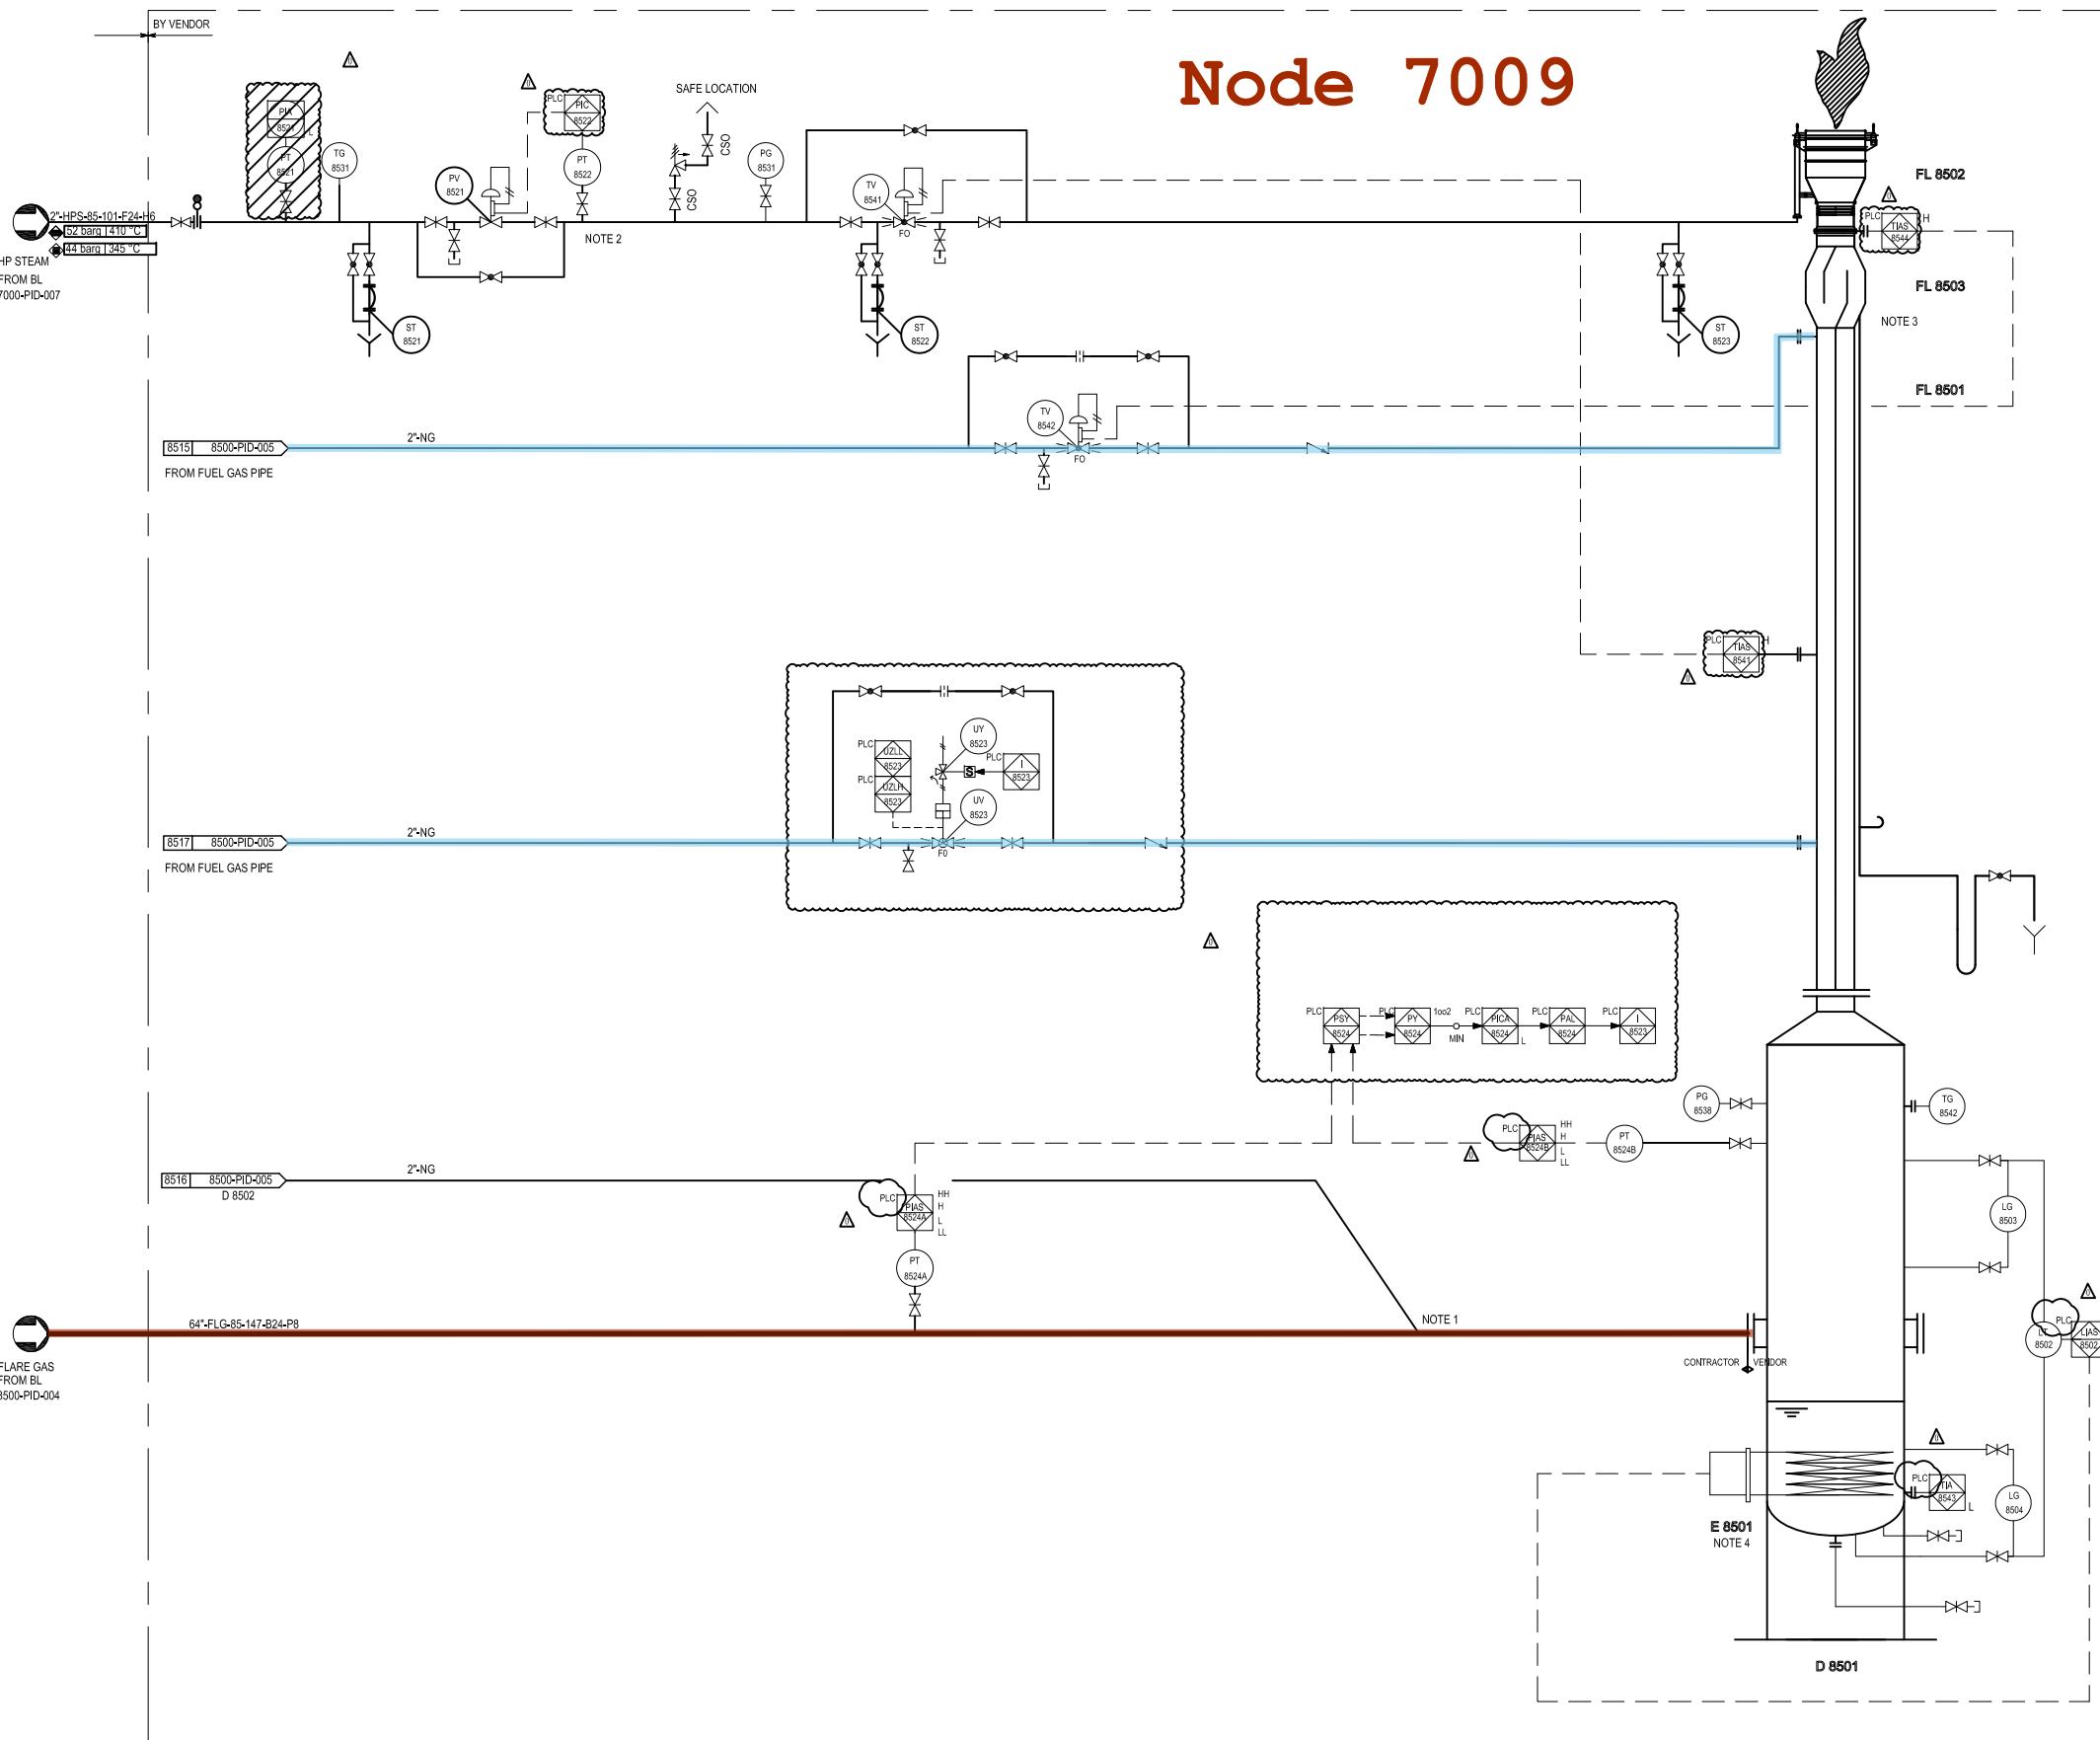

GENERAL NOTES

+ GENERAL NOTE:
 1) LOW POINT DRAINS AND HIGH POINT VENT MUST BE ADDED DURING DETAILED ENGINEERING.
 2) FLARE LINE WITH AN UPWARD SLOPE SHALL ADD LOW POINT DRAINS, THE DETAIL INFORMATION ABOUT IT SHOULD SPECIFY IN DE PHASE.

* NOTE:
 1) TO ENTER VENT TO FLARE HEADER AT 45 DEGREES TO HEADER AXIS IN DIRECTION OF FLOW.
 2) PIPE PRESSURE AFTER PRESSURE REDUCING VALVE SHALL BE VERIFIED DURING DETAILED ENGINEERING PHASE.
 3) MOLECULAR SEAL FLARE TYPE INSTEAD OF WATER SEAL TYPE, UTILIZING NATURAL GAS AS THE EMERGENCY SUPPLEMENTARY PRESSURE, MAKE UP GAS) WITH PRESSURE CONTROL VALVE.
 4) DELETE THE SERVICE WATER AND FLARE CONDENSATE LINES, TREATING FLARE CONDENSATE WITH ELECTRIC HEATER OR OTHER WAYS INSTEAD OF PUMPS.

REFERENCE DRAWINGS

SYMBOLS AND LEGENDS

KEY PLAN

▲ Approved For Construction	20.1.2017	Chen Tao	Xu Hang	Shi Jing
▲ Issued For Approval	20.12.2016	Chen Tao	Xu Hang	Shi Jing
▲ Issued For Approval	12.10.2016	Chen Tao	Xu Hang	Shi Jing
▲ Issued For Comments	31.8.2016	Chen Tao	Xu Hang	Shi Jing

REV. DESCRIPTION DATE DESIGN DRAW CHECK REVIEW APPROVE
THIS DOCUMENT IS THE PROPERTY OF TCC. NO PART OF THIS DOCUMENT SHALL BE REPRODUCED OR DISCLOSED TO OTHERS OR USED FOR ANY PURPOSE WHATSOEVER EXCEPT WITH THE PRIOR WRITTEN PERMISSION OF TCC.

OWNER:



Middle East
Kimiaye Pars Company

LICENSOR	HALDOR TOPSØE A/S	DOCUMENT NAME:	JOB NO.	DOC. NO.	REV.
CONTRACTOR	TCC + CHINA TIANCHEN ENGINEERING CORPORATION	CONTRACTOR DRAWING NO.			
		MKP-11-DE-8500-PS09-PID-004			
		SHEET 01 TOTAL 01			
		SUB-CONTRACTOR DRAWING NO.			
		-			
		SHEET - TOTAL -			
		P&ID FLARE STACK I	PROJECT	MKP Methanol Project	
			UNIT	Flare	
			PHASE	Detail Engineering	
			OWNER DWG NO.	MKP-11-DE-8500-PR-PID-004	
		Counter Signing	Sign	Date	SCALE: - SHEET: 1 TOT.: 1 SIZE: A1

1 2 3 4 5 6 7 8 9 10 11 12

D 8502	Fuel Gas Buffer Drum
ID x LENGTHT-T	600x1500 mm
DESIGN PRESS.	10 barg
DESIGN TEMP.	85 °C
INSULATION	NONE
CLADDING/LINING	NONE


X 8501	Flame Front Generator

PIL 8501A~D	Pilot with FFG & HED

GENERAL NOTES

+GENERAL NOTE:
 1) LOW POINT DRAINS AND HIGH POINT VENT MUST BE ADDED DURING DETAILED ENGINEERING.
 2) FLARE LINE WITH AN UPWARD SLOPE SHALL ADD LOW POINT DRAINS, THE DETAIL INFORMATION ABOUT IT SHOULD SPECIFY IN DE PHASE.

+NOTE:
 1) XL-01-04: PILOT CONDITION INDICATION LAMP, WHEN PIL-8501A/B/C/D ARE IN NORMAL CONDITION, THE RELEVANT LAMP IS ON.
 2) TAL-01-04: PILOT TEMPERATURE LOW ALARM LAMP, WHEN THE TEMPERATURE OF ANY ONE IN PIL-8501A/B/C/D IS LOWER THAN 150°C, THE RELEVANT LAMP IS ON.
 3) PIPE PRESSURE AFTER PRESSURE REDUCING VALVE SHALL BE VERIFIED DURING DETAILED ENGINEERING PHASE.
 4) THERMOCOUPLE IS THE K TYPE DUAL SHEATH THERMOCOUPLE, ONE IS DUTY, ANOTHER ONE IS SPARE.
 5) FFG WILL BE SUPPLIED AS THE COMPLETE SUPPLY SET BY VENDOR.

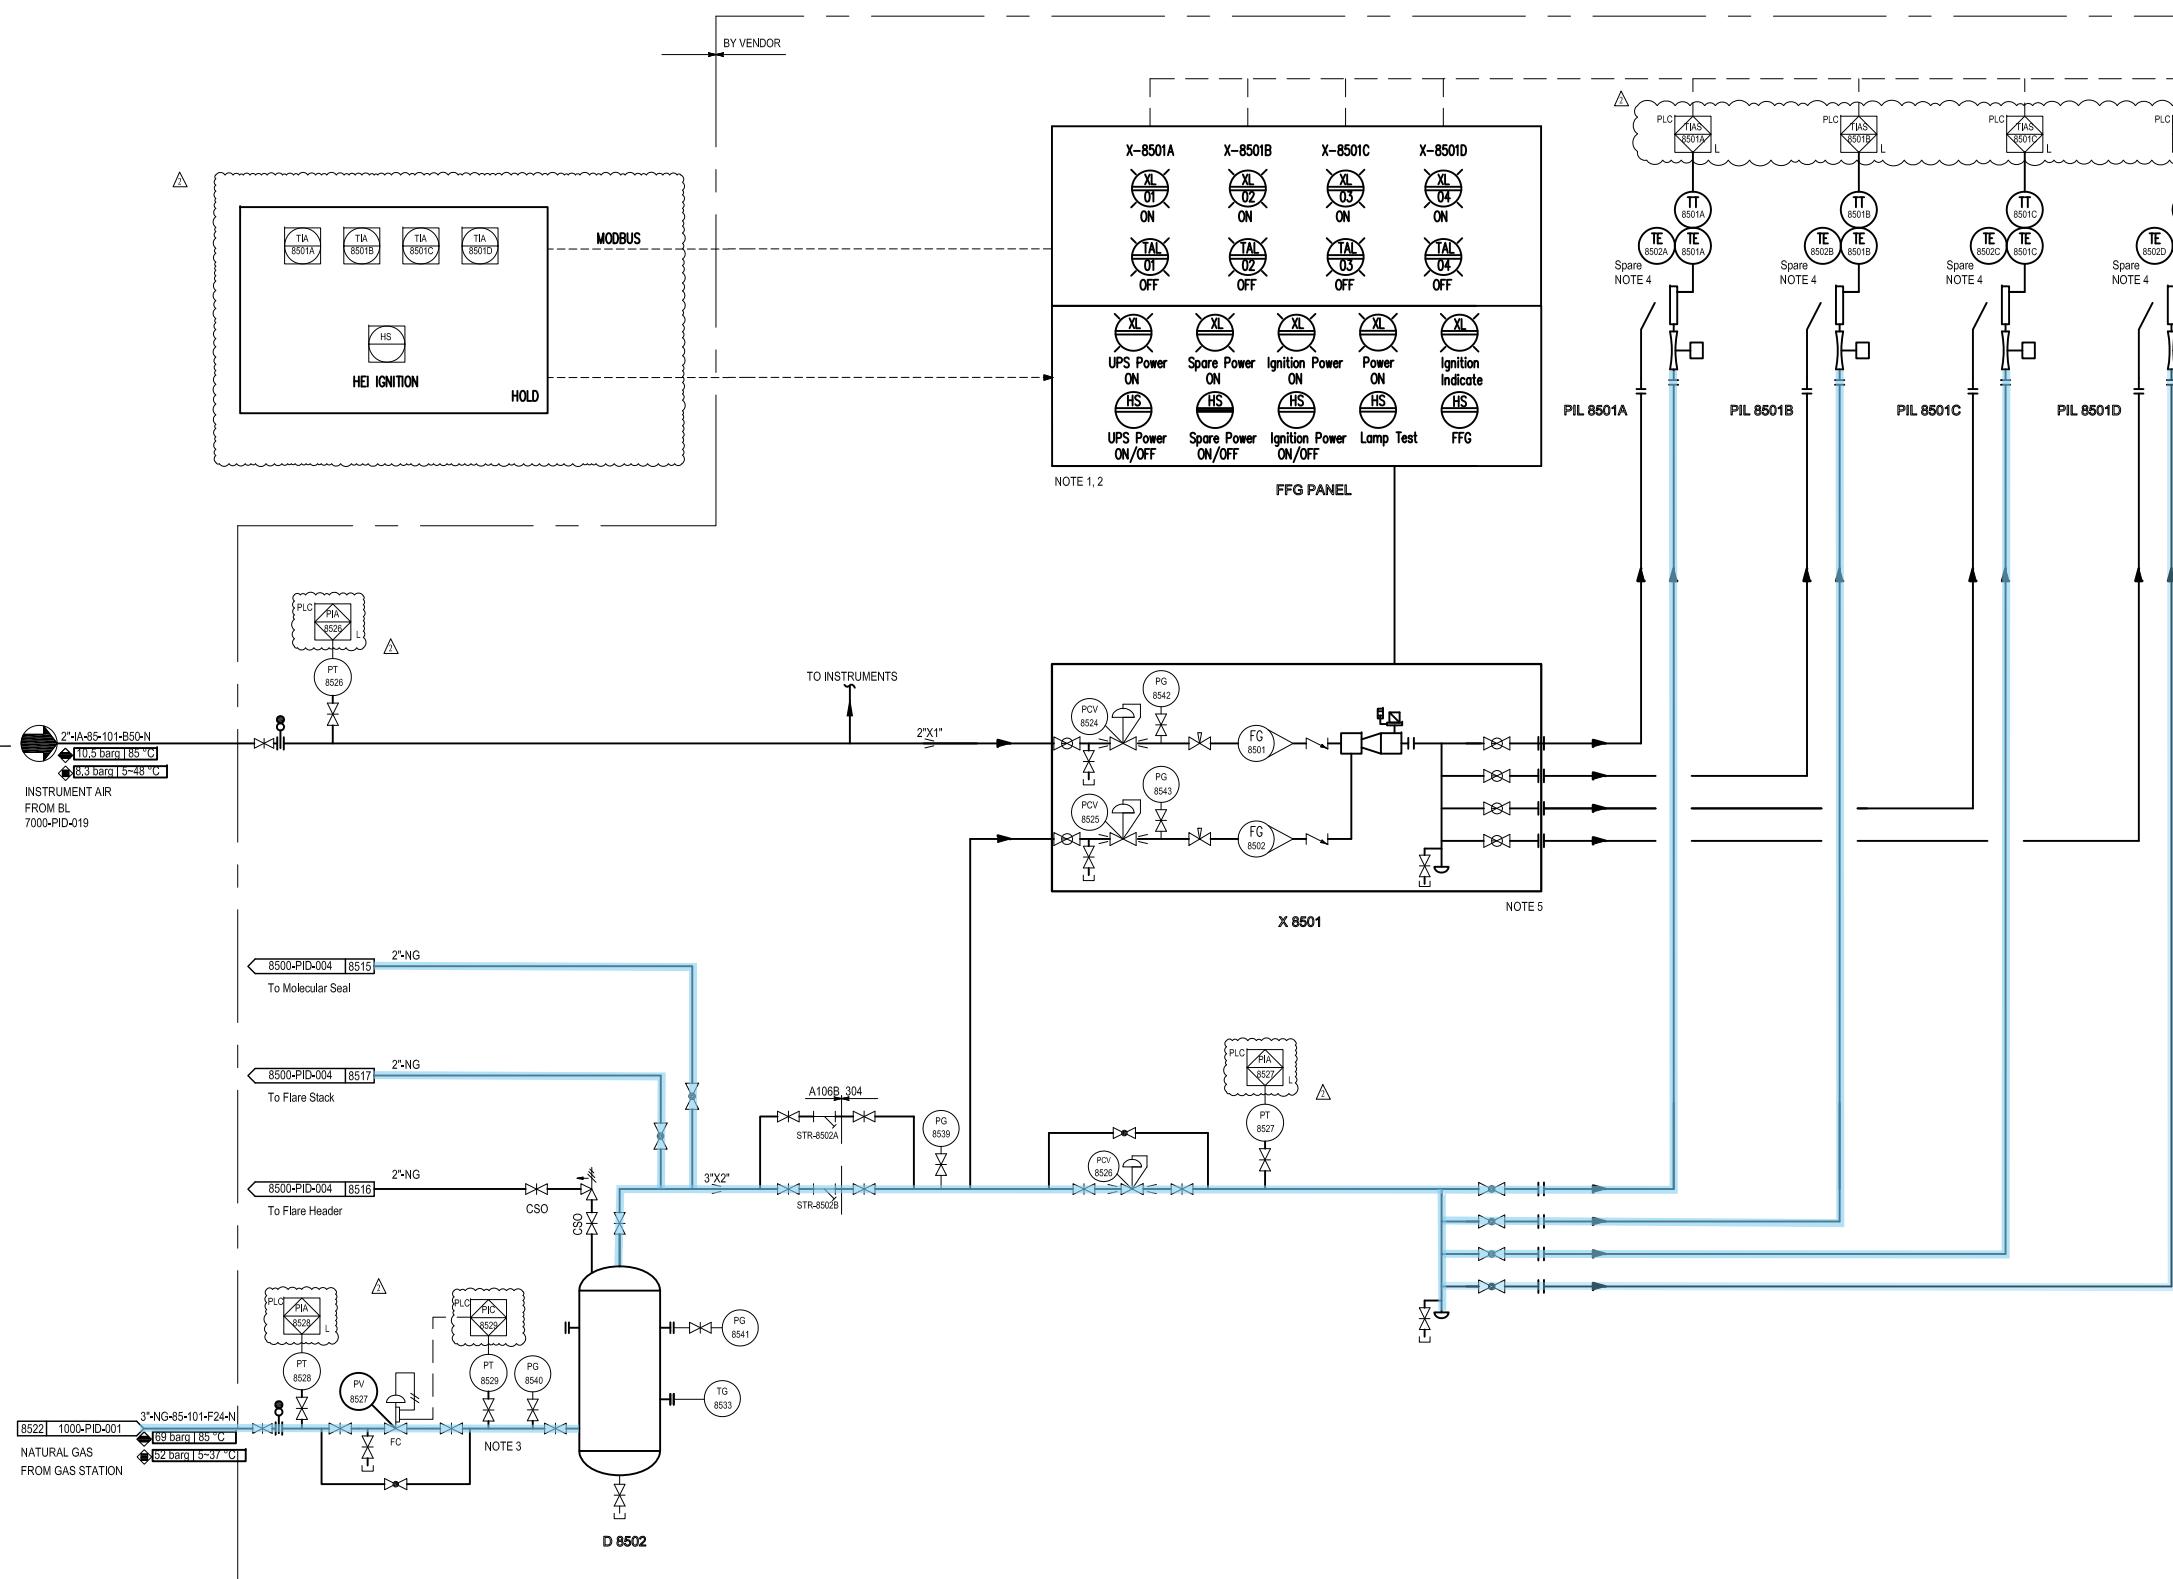Node 7009

P&ID FLARE STACK II				PROJECT	MKP Methanol Project
				UNIT	Flare
				PHASE	Detail Engineering
Counter Signing	Sign	Date	SCALE: -	SHEET: 1	TOT.: 1
OWNER DWG NO.	MKP-11-DE-8500-PR-PID-005		SIZE: A1		

△ Approved For Construction	20.1.2017	Chen Tao	Xu Hang	Shi Jing
△ Approved For Construction	20.12.2016	Chen Tao	Xu Hang	Shi Jing
△ Approved For Construction	12.10.2016	Chen Tao	Xu Hang	Shi Jing
△ Issued For Comments	31.8.2016	Chen Tao	Xu Hang	Shi Jing

REV. DESCRIPTION DATE DESIGN DRAW CHECK REVIEW APPROVE

THIS DOCUMENT IS THE PROPERTY OF TCC. NO PART OF THIS DOCUMENT SHALL BE REPRODUCED OR DISCLOSED TO OTHERS OR USED FOR ANY PURPOSE WHATSOEVER EXCEPT WITH THE PRIOR WRITTEN PERMISSION OF TCC.


OWNER:




Middle East
Kimiaye Pars Company

LICENSOR	HALDOR TOPSØE A/S	DOCUMENT NAME:	JOB NO.	DOC NO.	REV.
CONTRACTOR	TCC + CHINA TIANCHEN ENGINEERING CORPORATION	CONTRACTOR DRAWING NO.			
		SHEET 01 TOTAL 01			
		SUB-CONTRACTOR DRAWING NO.			
		-			
		SHEET - TOTAL -			
		PROJECT MKP Methanol Project			
		UNIT Flare			
		PHASE Detail Engineering			
		SCALE: -	SHEET: 1	TOT.: 1	SIZE: A1
		OWNER DWG NO.	MKP-11-DE-8500-PR-PID-005		

Node 7010

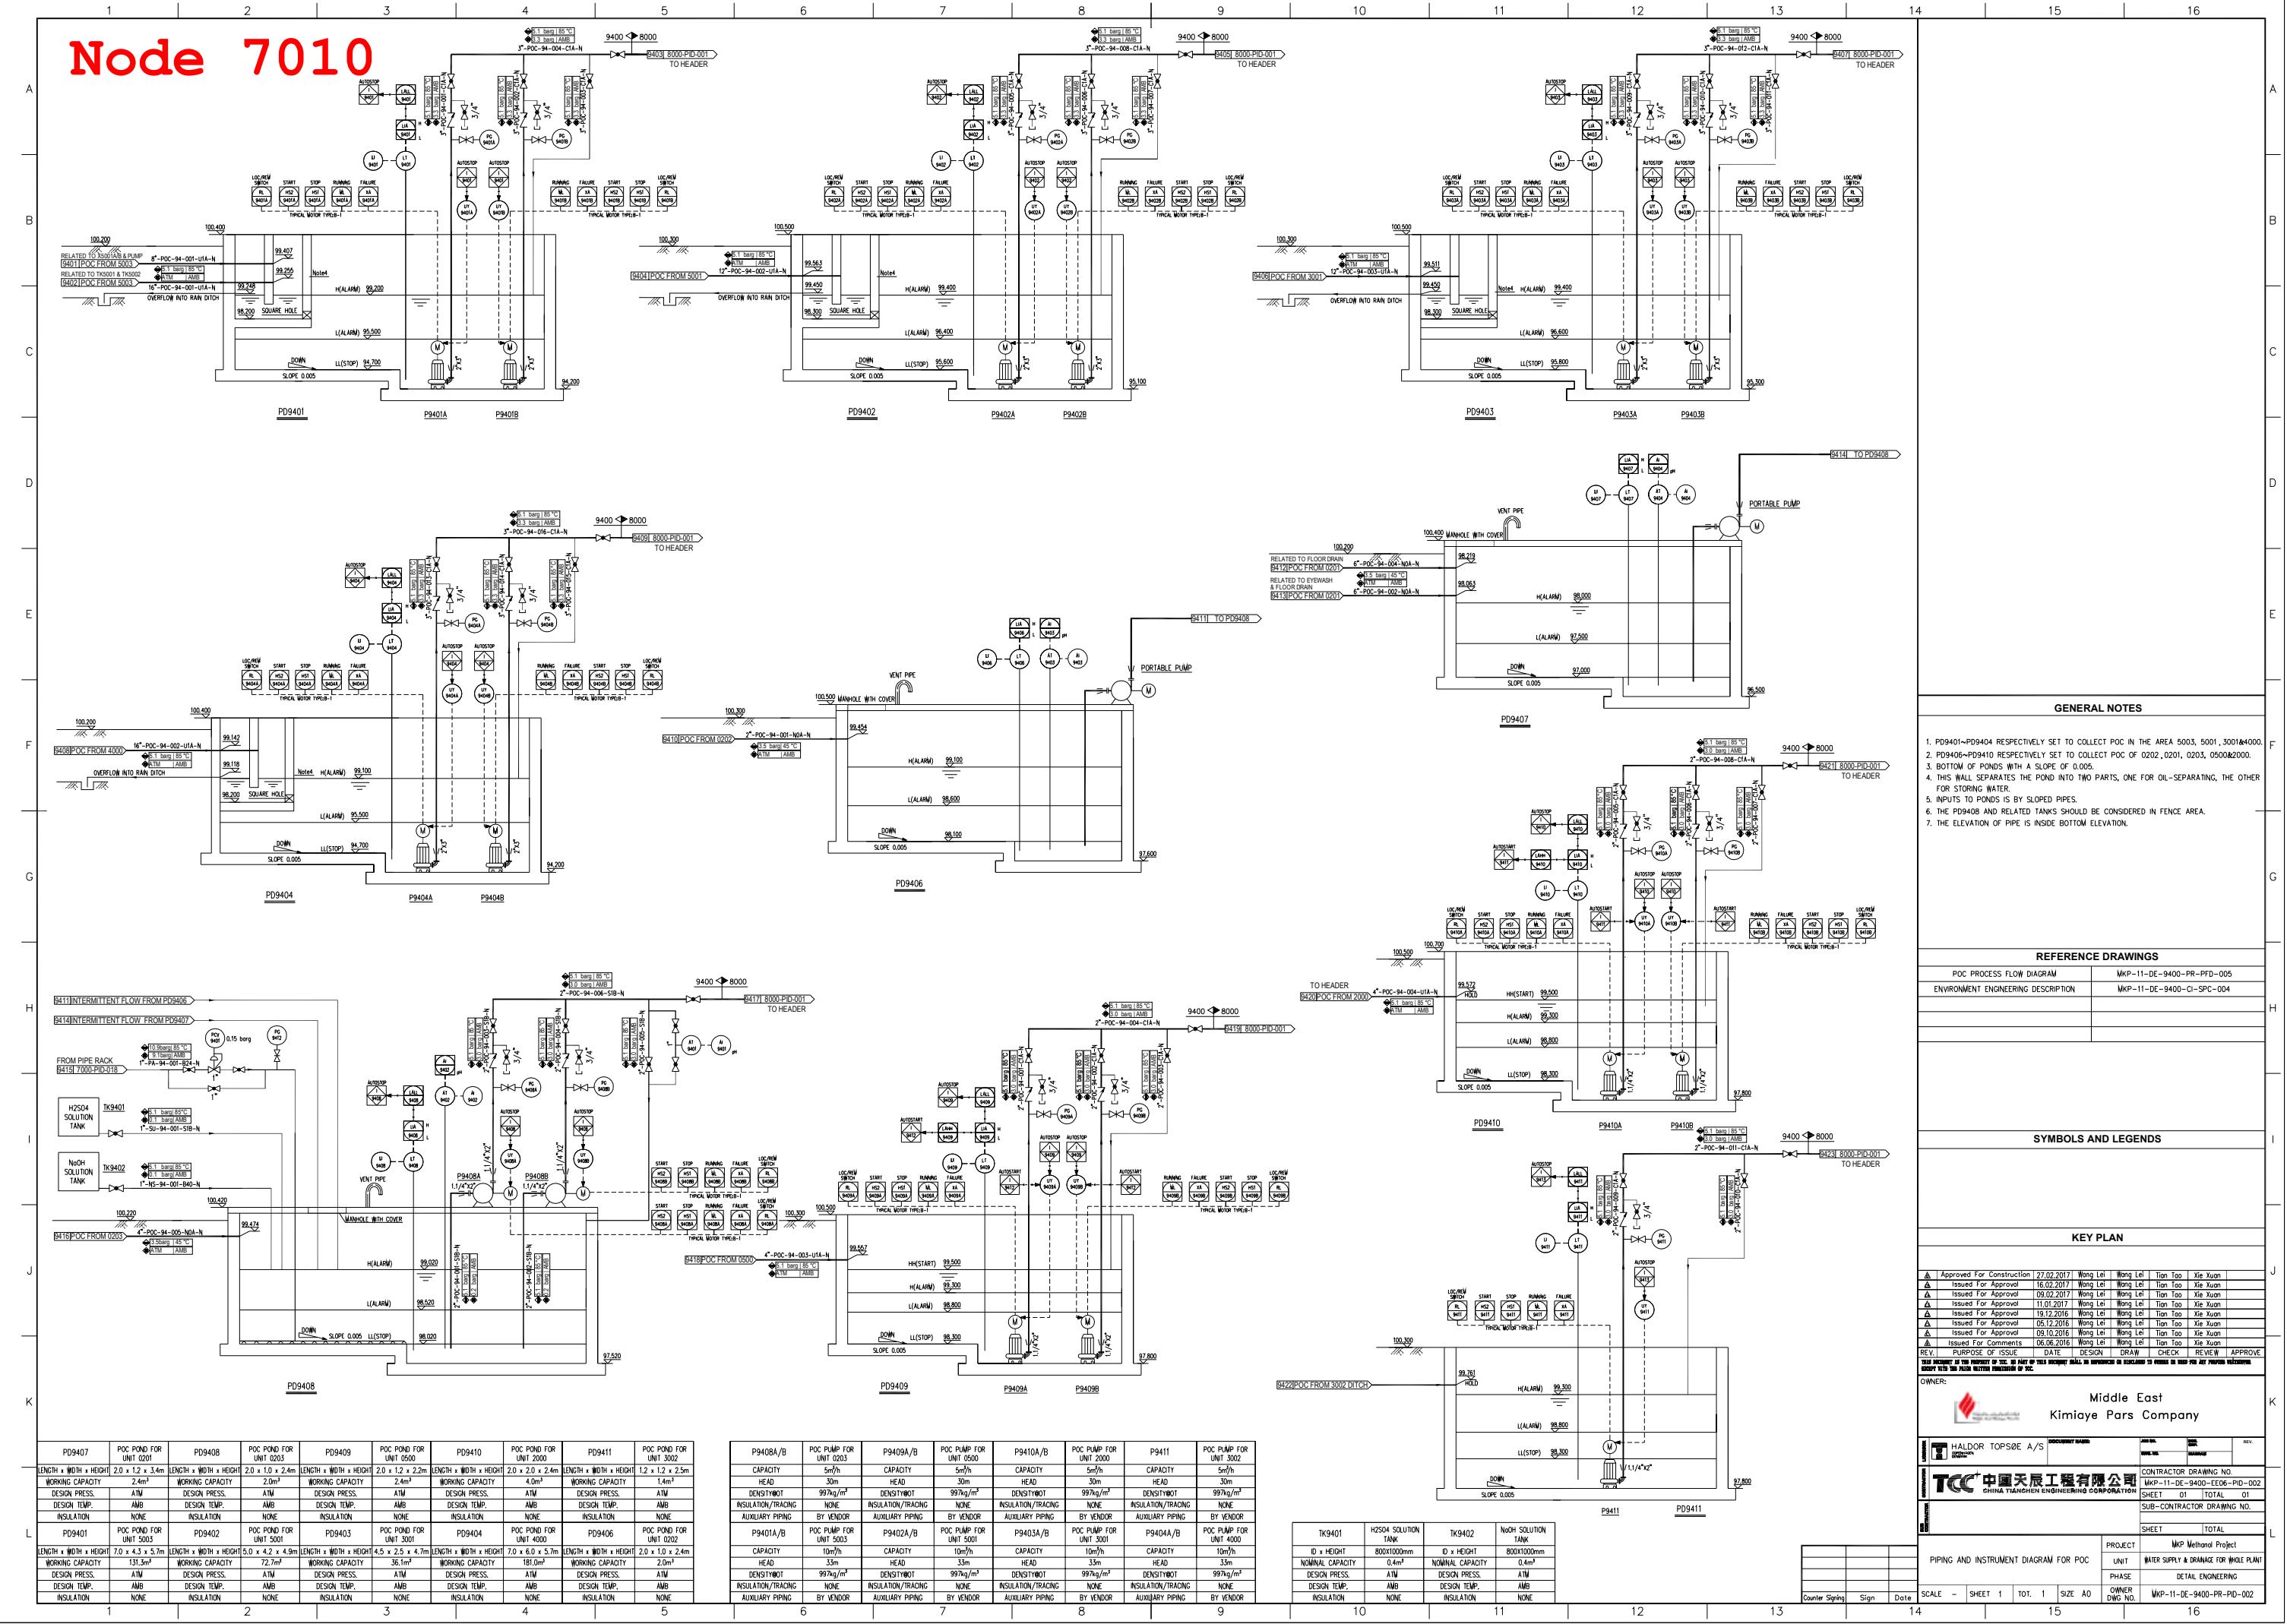


Node 7201

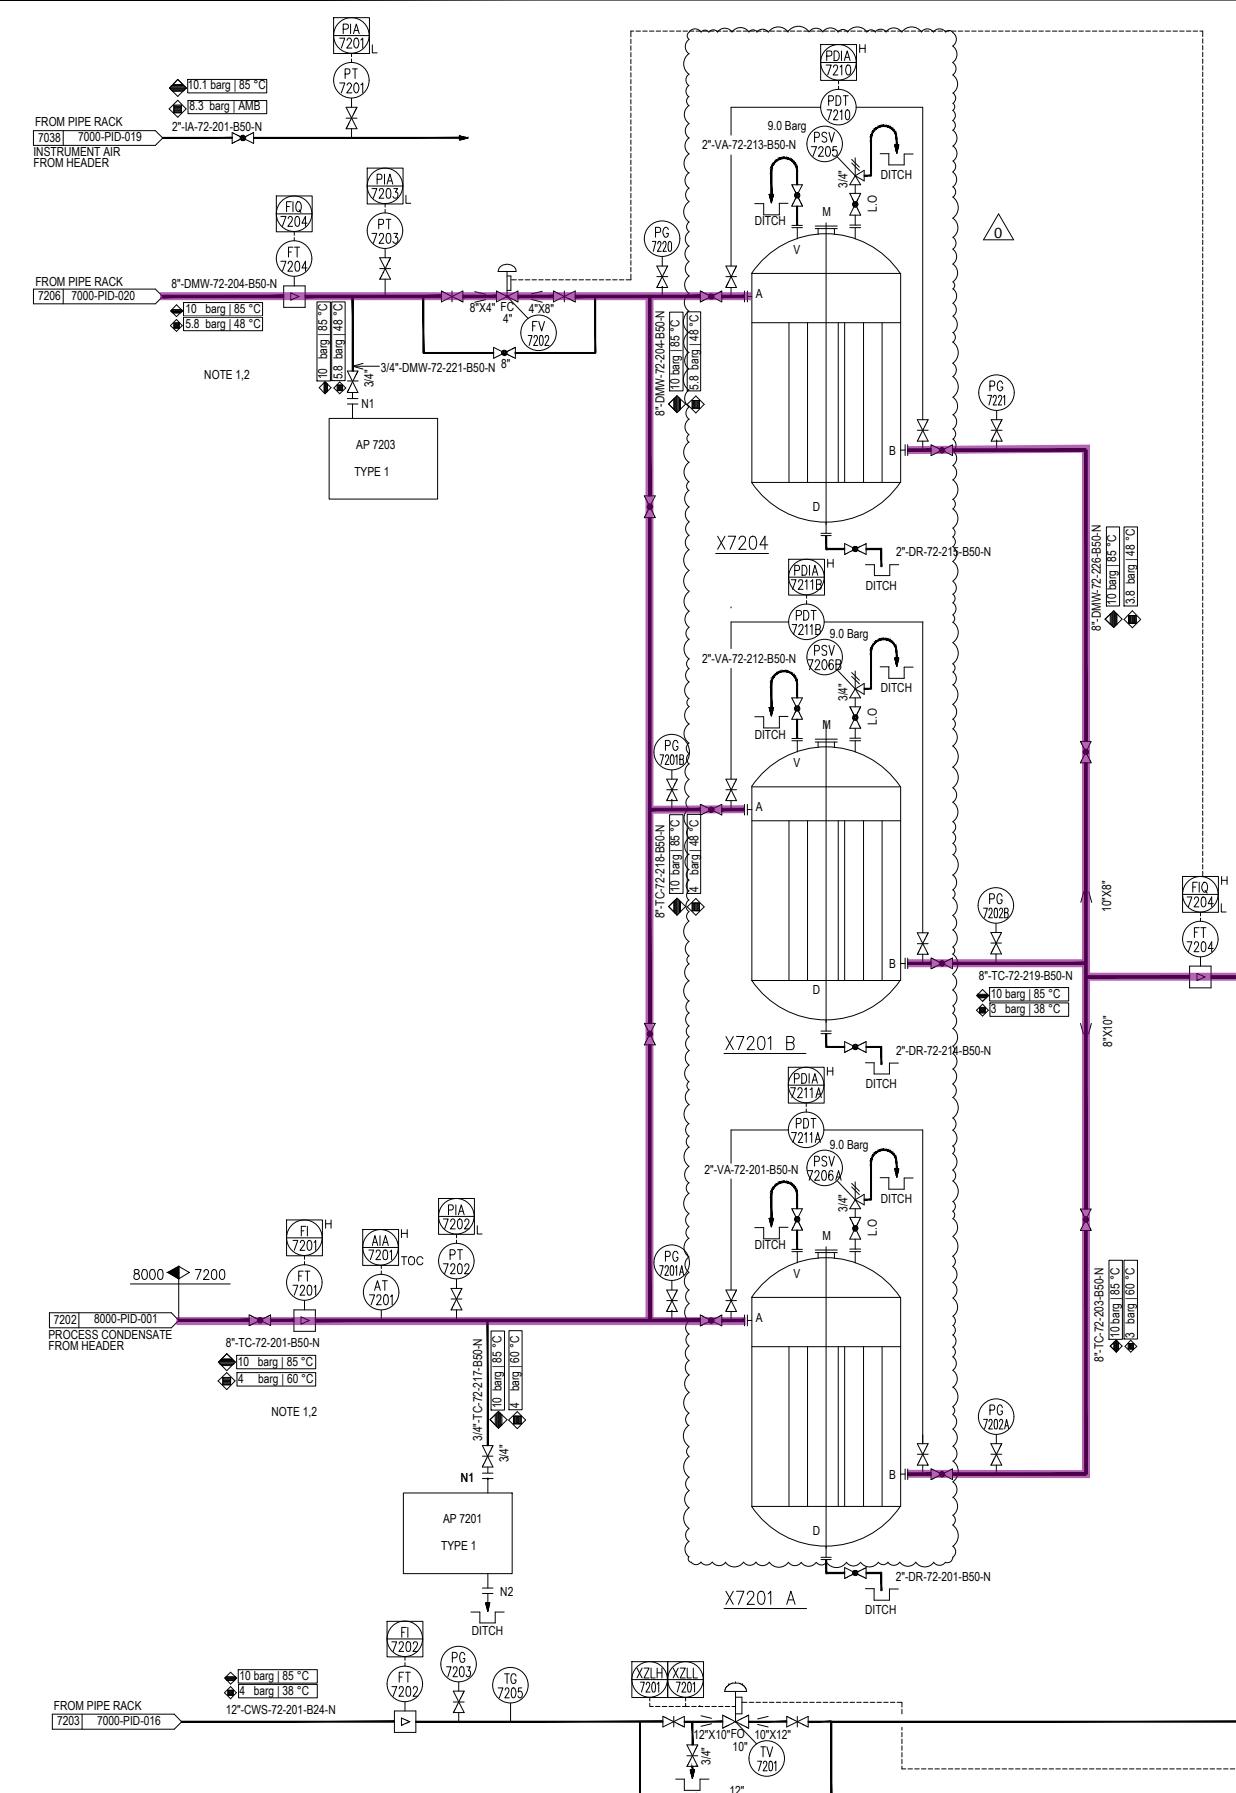


E 7201 A/B	PLATE HEAT EXCHANGER	X 7201 A	CARTRIDGE FILTER	X 7201 B	CARTRIDGE FILTER	X 7204	CARTRIDGE FILTER
EXCHANGE AREA	280 m ²	CAPACITY	150 m ³ /h	CAPACITY	150 m ³ /h	CAPACITY	150 m ³ /h
DESIGN PRESS.	10 barg	ID x HEIGHT	1000 x 1500 mm	ID x HEIGHT	1000 x 1500 mm	ID x HEIGHT	1000 x 1500 mm
DESIGN TEMP.	85 °C	DESIGN PRESS.	10 barg	DESIGN PRESS.	10 barg	DESIGN PRESS.	10 barg
TYPE	PLATE	DESIGN TEMP.	85 °C	DESIGN TEMP.	85 °C	DESIGN TEMP.	85 °C
MATERIAL	SS304	MATERIAL CASING	C+S+R.L	MATERIAL CASING	C+S+R.L	MATERIAL CASING	C+S+R.L
INSULATION	NONE	MATERIAL FILTER ELEMENT	PP	MATERIAL FILTER ELEMENT	PP	MATERIAL FILTER ELEMENT	PP
ELEV. OF FOUNDATION	EL 100.80 m	INSULATION	NONE	INSULATION	NONE	INSULATION	NONE

FILTER AND HEAT EXCHANGER P&ID FOR POLISHING UNIT			
PROJECT	MKP Methanol Project	UNIT	POLISHING UNIT
PHASE	DETAIL ENGINEERING	OWNER	Kimiaye Pars Company
SCALE	-	SHEET 1	TOT. 1
OWNER DWG NO.	MKP-11-DE-7200-PR-PID-001	SIZE A1	

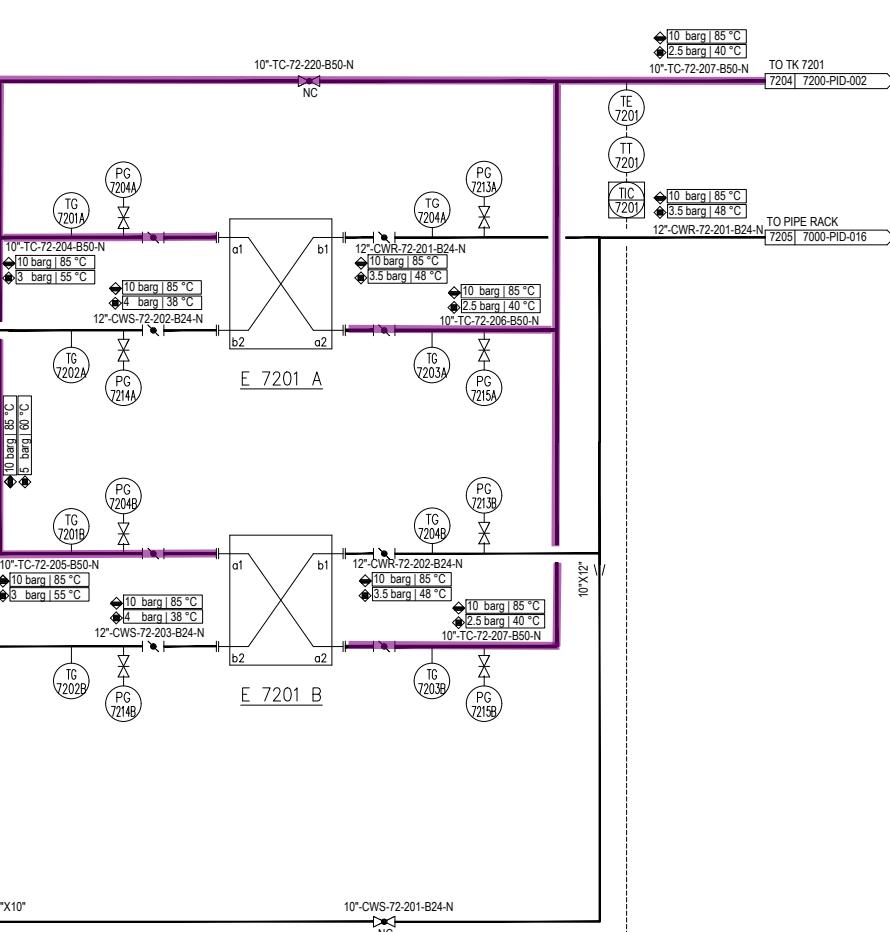

GENERAL NOTES	
NOTE 1: POLISHING UNIT IS GENERALLY REVISED BECAUSE DMW WATER FROM DAMAVAND NEEDS TO BE POLISHED, THE CAPACITY OF POLISHING UNIT WAS REVISED FROM 126 M3/H TO 250 M3/H. THE DRAWING IS ONLY FOR REFERENCE. VENDOR SHALL FINISH THE DETAILED DESIGN OF THIS DRAWING AND APPROVED BY TCC.					A	
NOTE 2: POLISHING UNIT SHOULD BE PACKAGE SUPPLIED, INCLUDING ALL THE EQUIPMENT, PLC, INSTRUMENT, CONTROL VALVE SHOWN IN P&ID, MOTORS AND PUMPS. THE MAIN PROCESS P7002 A/B, M7002 AB, TK7201 AND T7K001 1/2 WITH LEVEL TRANSMITTER AND GAUGE SHALL BE IN TCC'S WORKING SCOPE.					B	
REFERENCE DRAWINGS	
SYMBOLS AND LEGENDS	
KEY PLAN	
<table border="1"> <tr> <td>▲ Approved for Construction</td><td>23.01.2017</td><td>Liang Zhipeng</td><td>Tian Tao</td><td>Xie Xuan</td><td></td></tr> <tr> <td>▲ Issued For Approval</td><td>05.01.2017</td><td>Liang Zhipeng</td><td>Tian Tao</td><td>Xie Xuan</td><td></td></tr> <tr> <td>▲ Issued For Approval</td><td>12.12.2016</td><td>Liang Zhipeng</td><td>Tian Tao</td><td>Xie Xuan</td><td></td></tr> <tr> <td>▲ Issued For Approval</td><td>10.10.2016</td><td>Liang Zhipeng</td><td>Tian Tao</td><td>Xie Xuan</td><td></td></tr> <tr> <td>▲ Issued For Approval</td><td>27.07.2016</td><td>Liang Zhipeng</td><td>Tian Tao</td><td>Xie Xuan</td><td></td></tr> <tr> <td>▲ Issued For Review</td><td>05.07.2016</td><td>Liang Zhipeng</td><td>Tian Tao</td><td>Xie Xuan</td><td></td></tr> <tr> <td>▲ Issued For Comments</td><td>06.06.2016</td><td>Liang Zhipeng</td><td>Tian Tao</td><td>Xie Xuan</td><td></td></tr> <tr> <td>REV.</td><td>PURPOSE OF ISSUE</td><td>DATE</td><td>DESIGN</td><td>DRAW</td><td>CHECK</td></tr> <tr> <td></td><td></td><td></td><td></td><td></td><td>REVIEW APPROVE</td></tr>
THIS DOCUMENT IS THE PROPERTY OF TCC. NO PART OF THIS DOCUMENT SHALL BE REPRODUCED OR DISCLOSED TO OTHERS OR USED FOR ANY PURPOSE WHATSOEVER EXCEPT WITH THE PRIOR WRITTEN PERMISSION OF TCC.	
OWNER:	
 Middle East Kimiaye Pars Company	
<table border="1"> <tr> <td>HALDOR TOPSØE A/S</td><td>DOCUMENT NAME:</td><td>JOB NO.:</td><td>DOC. GRP.:</td><td>REV.:</td><td></td></tr> <tr> <td>LICENSOR</td><td></td><td>7000</td><td>DIAGRAM</td><td></td><td></td></tr> <tr> <td>CONTRACTOR</td><td>TCC + CHINA TIANJIN ENGINEERING CORPORATION</td><td>MKP-11-DE-7200-EE06-PID-001</td><td></td><td></td><td></td></tr> <tr> <td>SUB-CONTRACTOR</td><td></td><td>SHEET 01</td><td>TOTAL 01</td><td></td><td></td></tr> <tr> <td></td><td></td><td>SUB-CONTRACTOR DRAWING NO.</td><td></td><td></td><td></td></tr> <tr> <td></td><td></td><td>SHEET</td><td>TOTAL</td><td></td><td></td></tr> <tr> <td></td><td></td><td>PROJECT</td><td>MKP Methanol Project</td><td></td><td></td></tr> <tr> <td></td><td></td><td>UNIT</td><td>POLISHING UNIT</td><td></td><td></td></tr> <tr> <td></td><td></td><td>PHASE</td><td>DETAIL ENGINEERING</td><td></td><td></td></tr>

Node 7201

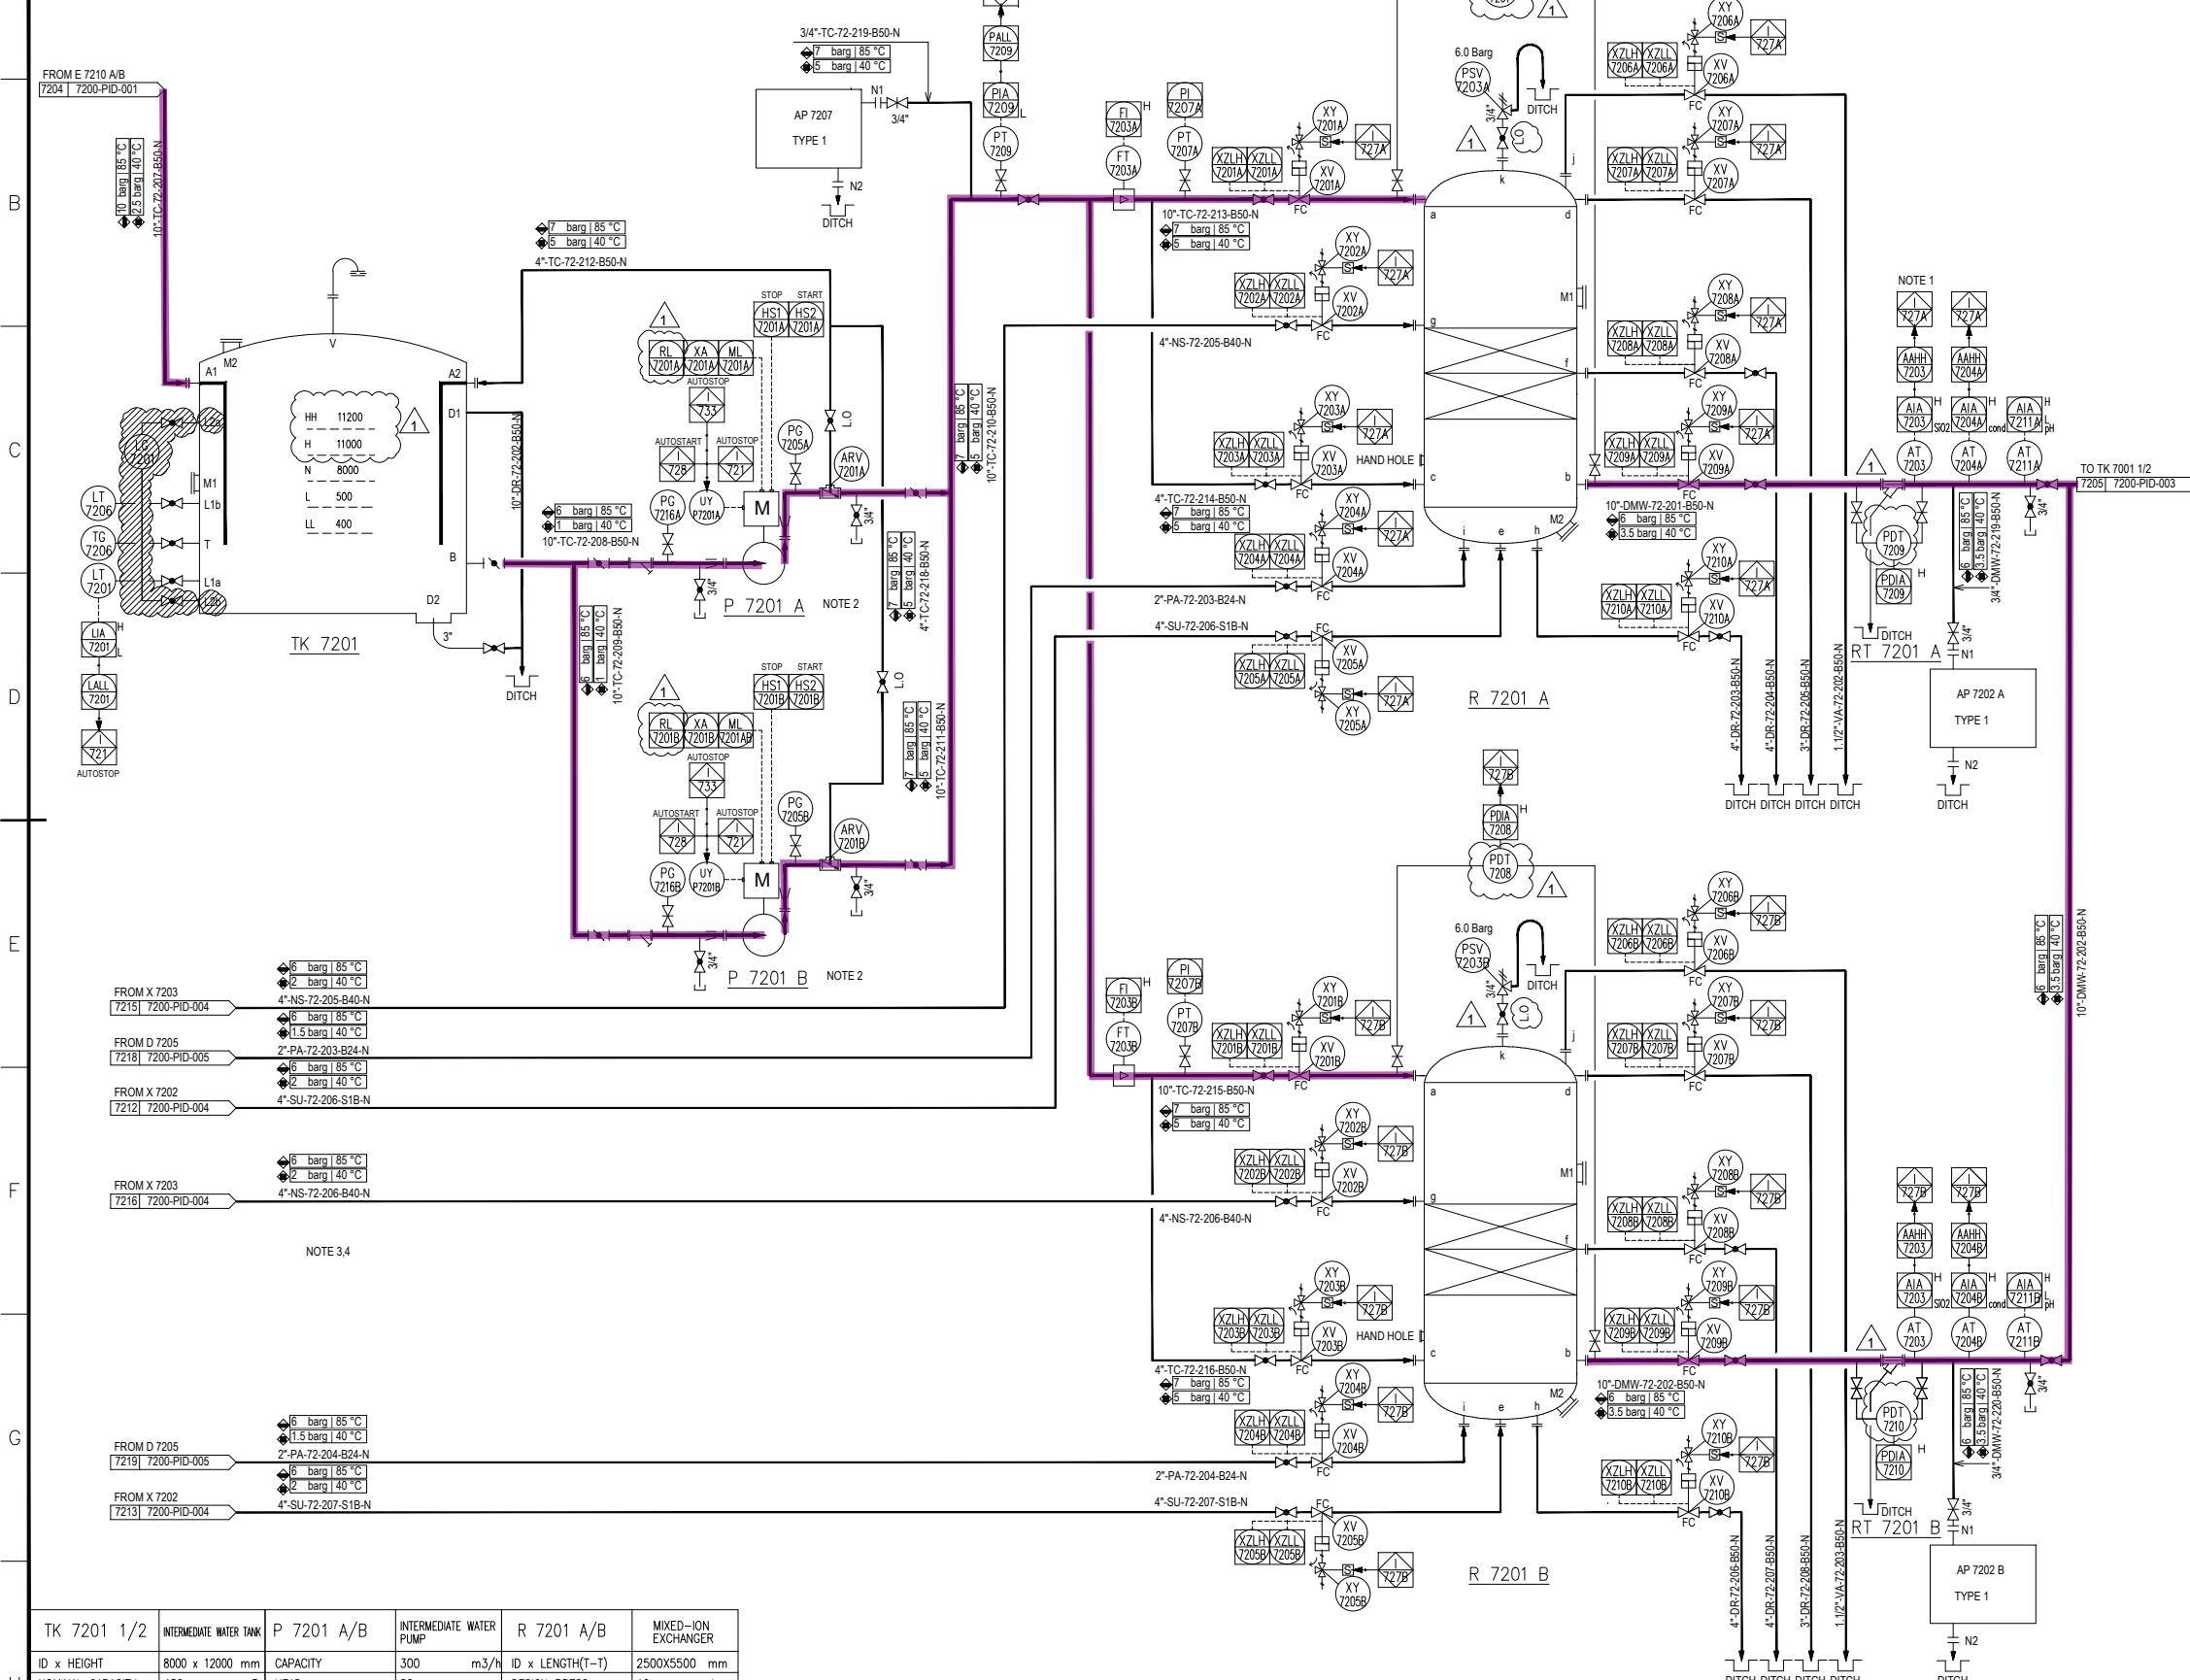

TK 7201 1/2	INTERMEDIATE WATER TANK	P 7201 A/B	INTERMEDIATE WATER PUMP	R 7201 A/B	MIXED-ION EXCHANGER
ID x HEIGHT	8000 x 12000 mm	CAPACITY	300 m3/h	ID x LENGTH(T-T)	2500X5500 mm
NOMINAL CAPACITY	450 m3	HEAD	50 m	DESIGN PRESS.	10 barg
DESIGN PRESS.	ATM	DENSITY@OT	992.2 kg/m3	DESIGN TEMP.	85 °C
DESIGN TEMP.	85 °C	INSULATION/TRACING	NONE	INSULATION	NONE
INSULATION	NONE	AUXILIARY PIPING	By Vendor	MATERIAL	C.S.
MATERIAL	SS304	TYPE	CENTRIFUGAL	CLADDING/LINING	RUBBER
ELEV. OF FOUNDATION	EL 100.80 m	MATERIAL	SS304	ELEV. OF FOUNDATION	EL 100.80 m
		ELEV. OF FOUNDATION	EL 100.80 m		

GENERAL NOTES

NOTE 1: THIS INSTRUMENT IS A TWO-CHANNEL SILICON TRANSMITTER.

NOTE 2: P7201 A/B STANDBY PUMP AUTOSTARTS WHEN PRESSURE INDICATED ON PT-7209 IS 1 BAR.

NOTE 3: POLISHING UNIT IS GENERALLY REVISED BECAUSE DMW WATER FROM DAMAVAND NEEDS TO BE
POLISHED, THE CAPACITY OF POLISHING UNIT WAS REVISED FROM 126 M³/H TO 250 M³/H.
THE DRAWING IS ONLY FOR REFERENCE, VENDOR SHALL FINISH THE DETAILED DESIGN OF
THIS DRAWING AND APPROVED BY TCC.

NOTE 4: POLISHING UNIT SHOULD BE PACKAGE SUPPLIED, INCLUDING ALL THE EQUIPMENT, PLC,
INSTRUMENT, CONTROL VALVE SHOWN IN P&ID, MOTORS AND PUMPS. THE MAIN PROCESS
P7002 A/B, MP 7002 A/B, TK 7201 AND TK7001 1/2 WITH LEVEL TRANSMITTER AND GAUGE SHALL
BE IN TCC'S WORKING SCOPE.

REFERENCE DRAWINGS

SYMBOLS AND LEGENDS

KEY PLAN

Approved For Construction	23.01.2017	Liang Zhipeng	Tian Tao	Xie Xuan		
Approved For Construction	05.01.2017	Liang Zhipeng	Tian Tao	Xie Xuan		
Issued For Approval	12.12.2016	Liang Zhipeng	Tian Tao	Xie Xuan		
Issued For Approval	10.10.2016	Liang Zhipeng	Tian Tao	Xie Xuan		
Issued For Approval	27.07.2016	Liang Zhipeng	Tian Tao	Xie Xuan		
Issued For Review	05.07.2016	Liang Zhipeng	Tian Tao	Xie Xuan		
Issued For Comments	06.06.2016	Liang Zhipeng	Tian Tao	Xie Xuan		
PURPOSE OF ISSUE	DATE	DESIGN	DRAW	CHECK	REVIEW	APPROVE


DOCUMENT IS THE PROPERTY OF TCC. NO PART OF THIS DOCUMENT SHALL BE REPRODUCED OR DISCLOSED
OTHERS OR USED FOR ANY PURPOSE WHATSOEVER EXCEPT WITH THE PRIOR WRITTEN PERMISSION OF TCC.

ER:

Middle East
Kimiye Pars Company

HALDOR TOPSØE A/S COPENHAGEN DENMARK		DOCUMENT NAME:		JOB NO.	DOC. GRP.	REV.
				DWG. NO.	DIAGRAM	
 中国天辰工程有限公司 CHINA TIENCHEN ENGINEERING CORPORATION		CONTRACTOR DRAWING NO.				
		MKP-11-DE-7200-EE06-PID-002				
		SHEET 01		TOTAL 01		
		SUB-CONTRACTOR DRAWING NO.				
		SHEET			TOTAL	
MIXED-ION EXCHANGER P&ID FOR POLISHING UNIT		PROJECT		MKP Methanol Project		
		UNIT		POLISHING UNIT		
		PHASE		DETAIL ENGINEERING		
LE -	SHEET 1	TOT. 1	SIZE A1	OWNER DWG. NO.	MKP-11-DE-7200-PR-PID-002	

Node 7201

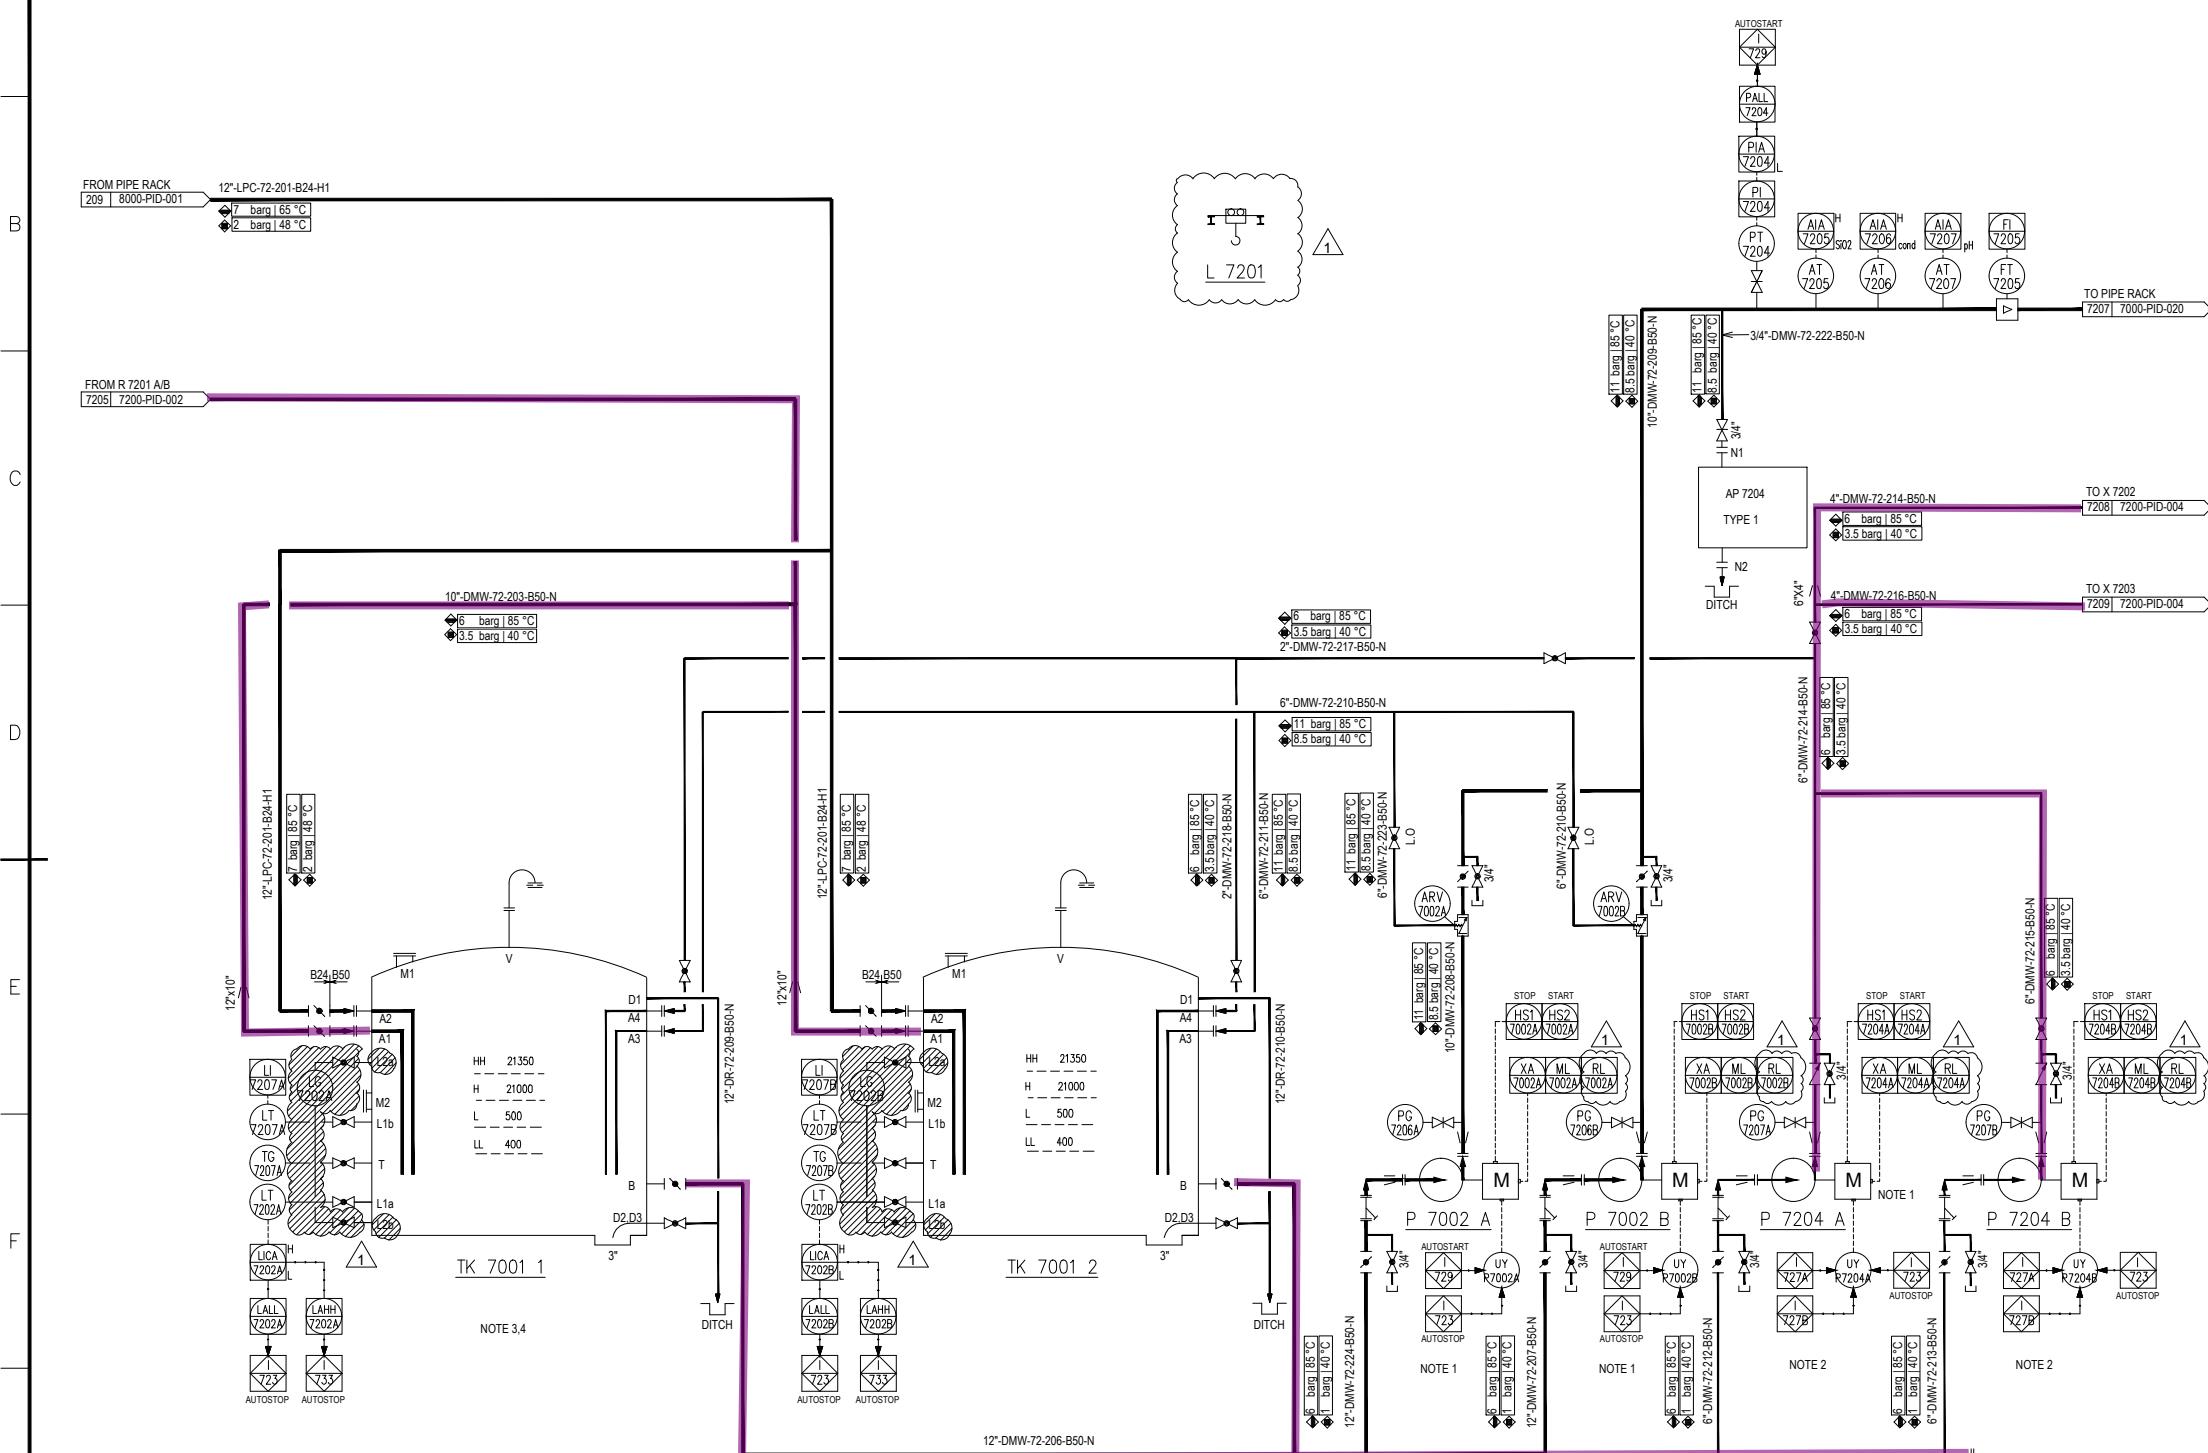

TK 7001 1/2	DEMIN WATER TANK	P 7002 A/B	DEMIN WATER PUMP	P 7204 A/B	REGENERATION PUMP	L 7201	HOIST
ID x HEIGHT	15000 x 22000 mm	CAPACITY	265 m ³ /h	CAPACITY	85 m ³ /h	TYPE	ELECTRICAL HOIST
NOMINAL CAPACITY	3500 m ³	HEAD	85 m	HEAD	35 m	CAPACITY	2 t
DESIGN PRESS.	barg	DENSITY@OT	992.2 kg/m ³	DENSITY@OT	992.2 kg/m ³	LIFT HEIGHT	4.5 m
DESIGN TEMP.	85 °C	INSULATION/TRACING	NONE	INSULATION/TRACING	NONE	SLIDING DISTANCE	41 m
INSULATION	NONE	AUXILIARY PIPING	By Vendor	AUXILIARY PIPING	By Vendor		
MATERIAL	SS 304	TYPE	CENTRIFUGAL	TYPE	CENTRIFUGAL		
ELEV. OF FOUNDATION	EL 100.80 m	MATERIAL	SS304	MATERIAL	SS304		
	ELEV. OF FOUNDATION EL 100.80 m	ELEV. OF FOUNDATION	EL 100.80 m	ELEV. OF FOUNDATION	EL 100.80 m		

- NOTE 1: PUMP P7002 A/B AUTOSTARTS WHEN PRESSURE INDICATED ON PT-7204 IS 1 BAR.
- NOTE 2: PUMP P7204 A/B AUTOSTARTS WHEN REGENERATION PROCESS STARTS, STANDBY PUMP STARTS WHEN THE WORKING PUMP IS MALFUNCTIONING.
- NOTE 3: POLISHING UNIT IS GENERALLY REVISED BECAUSE DMW WATER FROM DAMAVAND NEEDS TO BE POLISHED, THE CAPACITY OF POLISHING UNIT WAS REVISED FROM 126 M3H TO 250 M3H. THE DRAWING IS ONLY FOR REFERENCE, VENDOR SHALL FINISH THE DETAILED DESIGN OF THIS DRAWING AND APPROVED BY TCC.
- NOTE 4: POLISHING UNIT SHOULD BE PACKAGE SUPPLIED, INCLUDING ALL THE EQUIPMENT, PLC, INSTRUMENT, CONTROL VALVE SHOWN IN P&ID, MOTORS AND PUMPS. THE MAIN PROCESS P7002 A/B, MP 7002 AB, TK 7201 AND TK 7001 1/2 WITH LEVEL TRANSMITTER AND GAUGE SHALL BE IN TCC'S WORKING SCOPE.

REFERENCE DRAWINGS

SYMBOLS AND LEGENDS

KEY PLAN

Approved For Construction	23.01.2017	Liang Zhipeng	Tian Tao	Xie Xuan
Approved For Construction	05.01.2017	Liang Zhipeng	Tian Tao	Xie Xuan
Issued For Approval	12.12.2016	Liang Zhipeng	Tian Tao	Xie Xuan
Issued For Approval	10.10.2016	Liang Zhipeng	Tian Tao	Xie Xuan
Issued For Approval	27.07.2016	Liang Zhipeng	Tian Tao	Xie Xuan
Issued For Review	05.07.2016	Liang Zhipeng	Tian Tao	Xie Xuan
Issued For Comments	06.06.2016	Liang Zhipeng	Tian Tao	Xie Xuan

THIS DOCUMENT IS THE PROPERTY OF TCC. NO PART OF THIS DOCUMENT SHALL BE REPRODUCED OR DISCLOSED TO OTHERS OR USED FOR ANY PURPOSE WHATSOEVER EXCEPT WITH THE PRIOR WRITTEN PERMISSION OF TCC.


OWNER:





Middle East
Kimiaye Pars Company

CONTRACTOR	HALDOR TOPSØE A/S	DOCUMENT NAME:	JOB NO.:	DOC. GRP.:	REV.:
			DRWS NO.:	DIAGRAM	
CONTRACTOR	TCC 中国天辰工程有限公司 CHINA TIANCHEN ENGINEERING CORPORATION	CONTRACTOR DRAWING NO.:	MKP-11-DE-7200-EE06-PID-003	SHEET 01	TOTAL 01
SUB-CONTRACTOR		SUB-CONTRACTOR DRAWING NO.:			
		SHEET			
		PROJECT	MKP Methanol Project		
		UNIT	POLISHING UNIT		
		PHASE	DETAIL ENGINEERING		
		OWNER DWG NO.	MKP-11-DE-7200-PR-PID-003		
Counter Signing	Sign	Date			
SCALE -	SHEET 1	TOT. 1	SIZE A1		

Node 7201

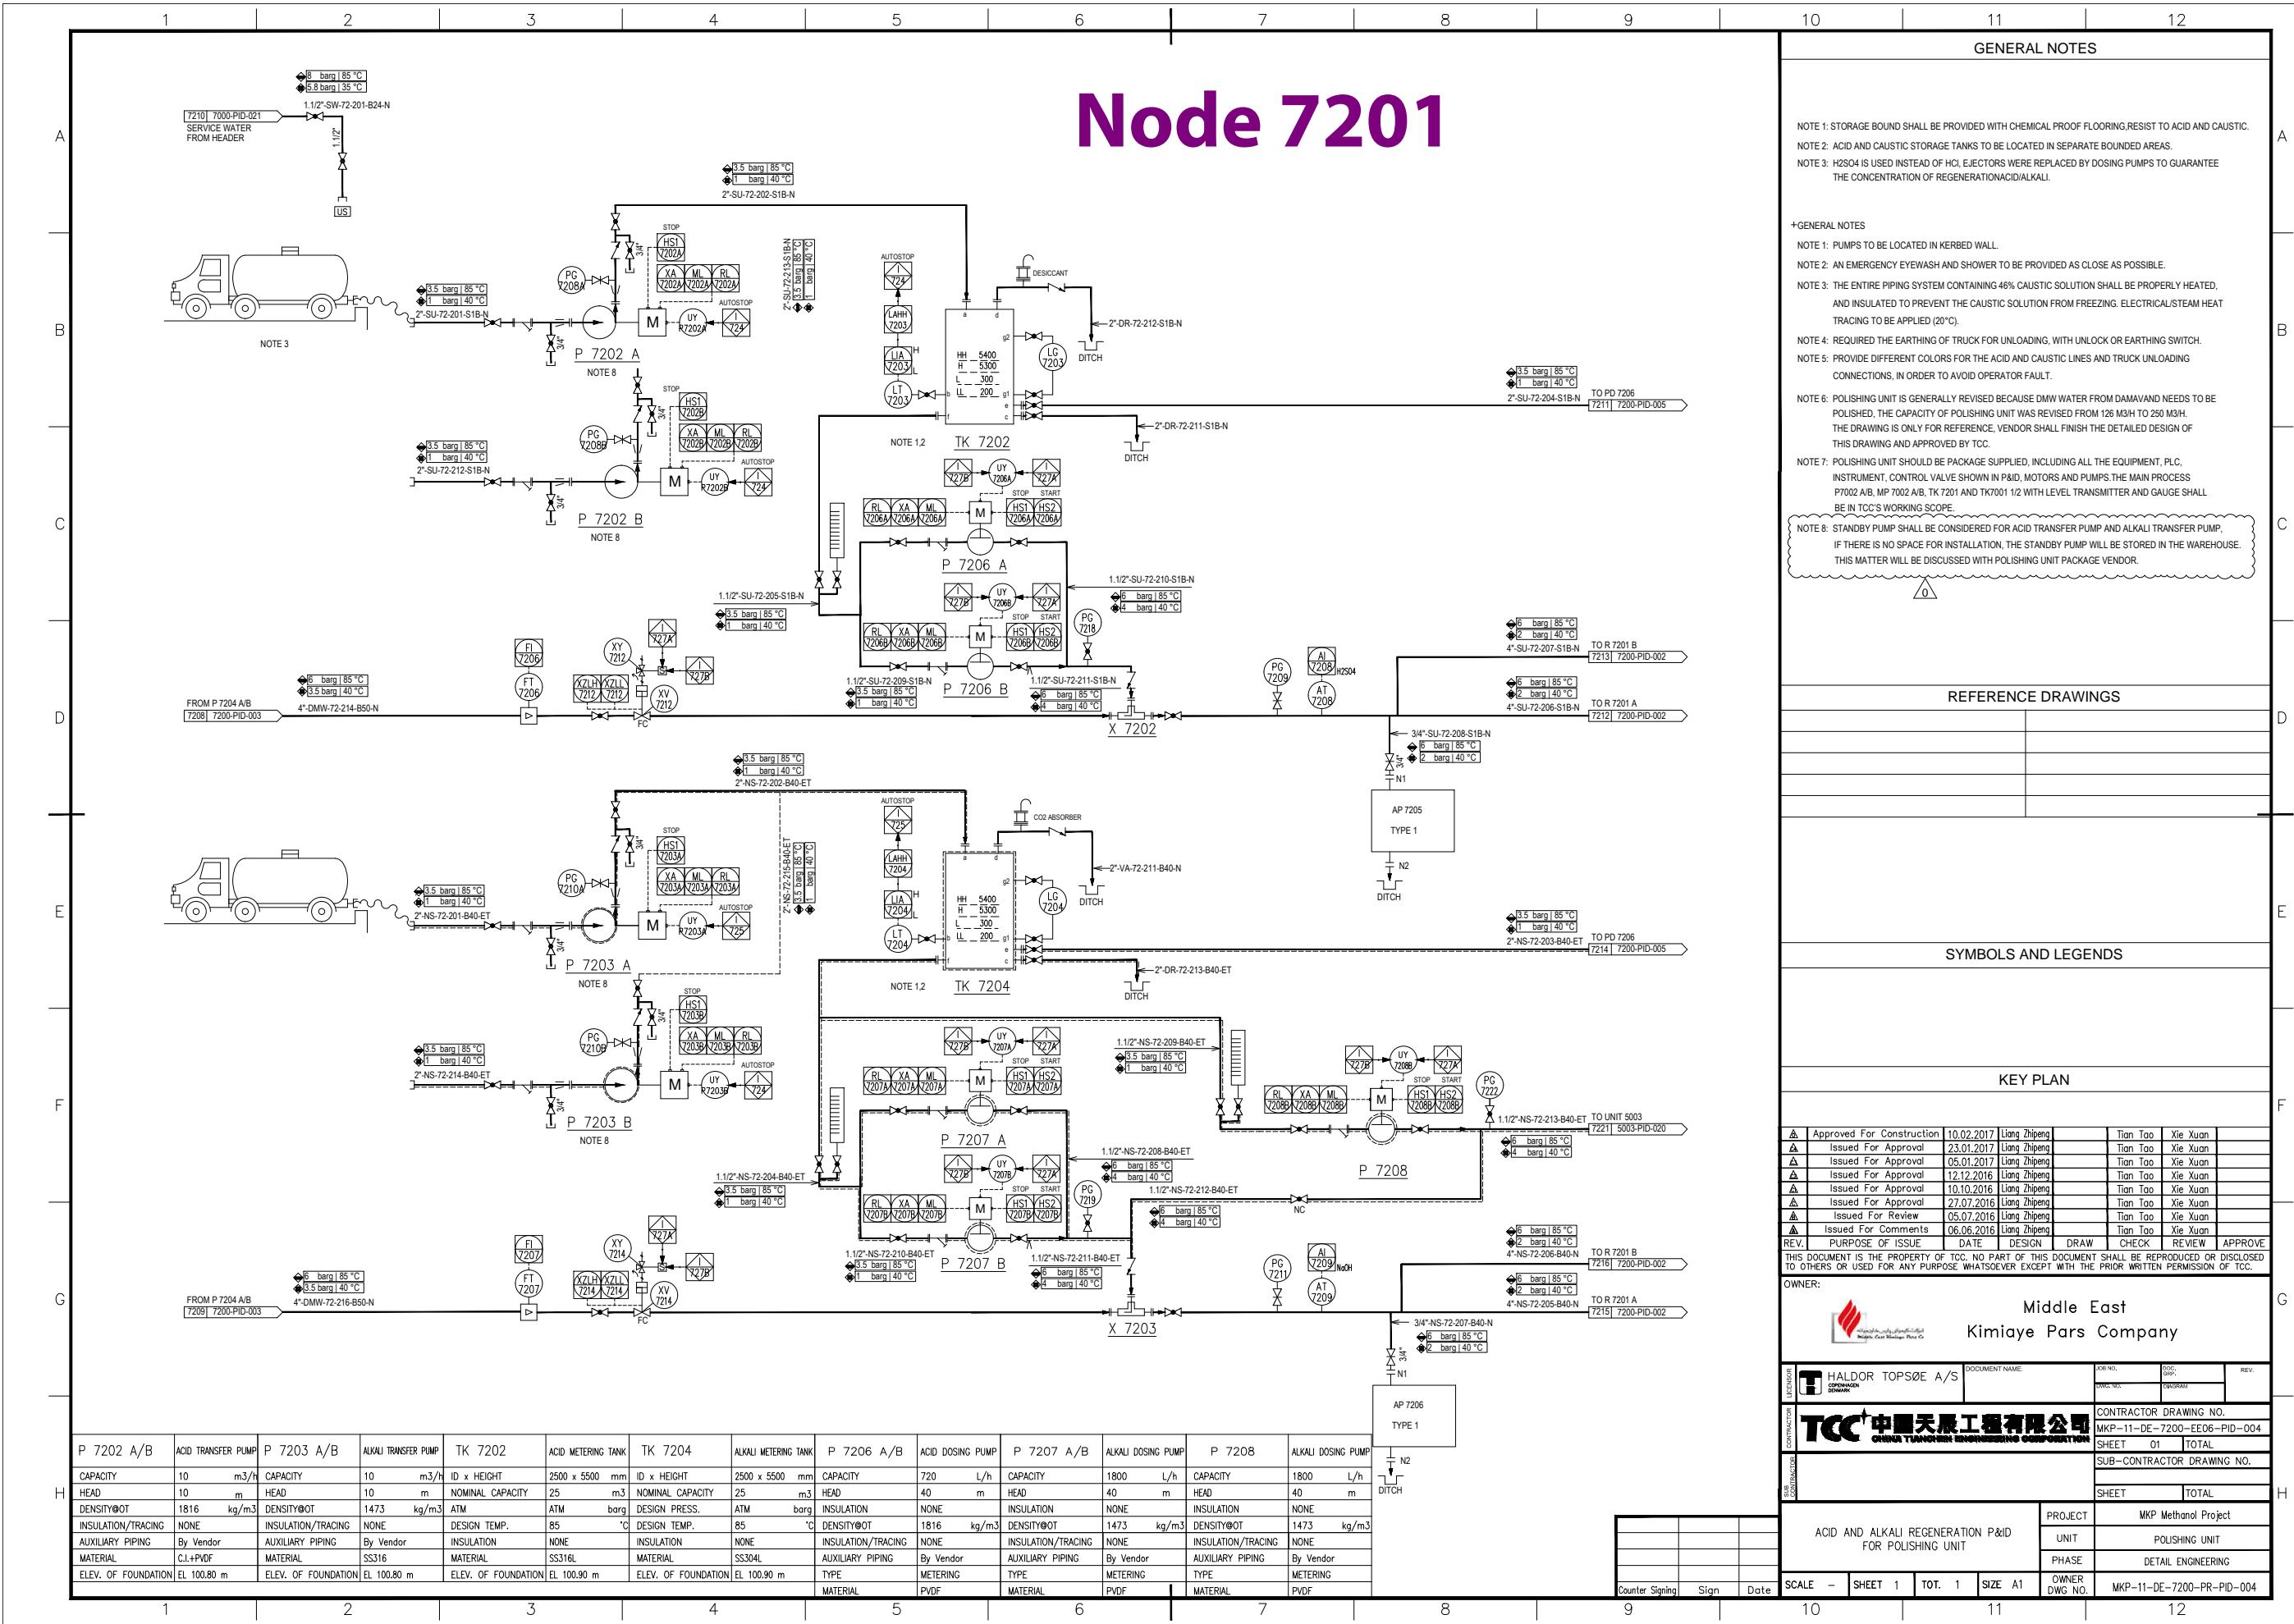

Node 7201

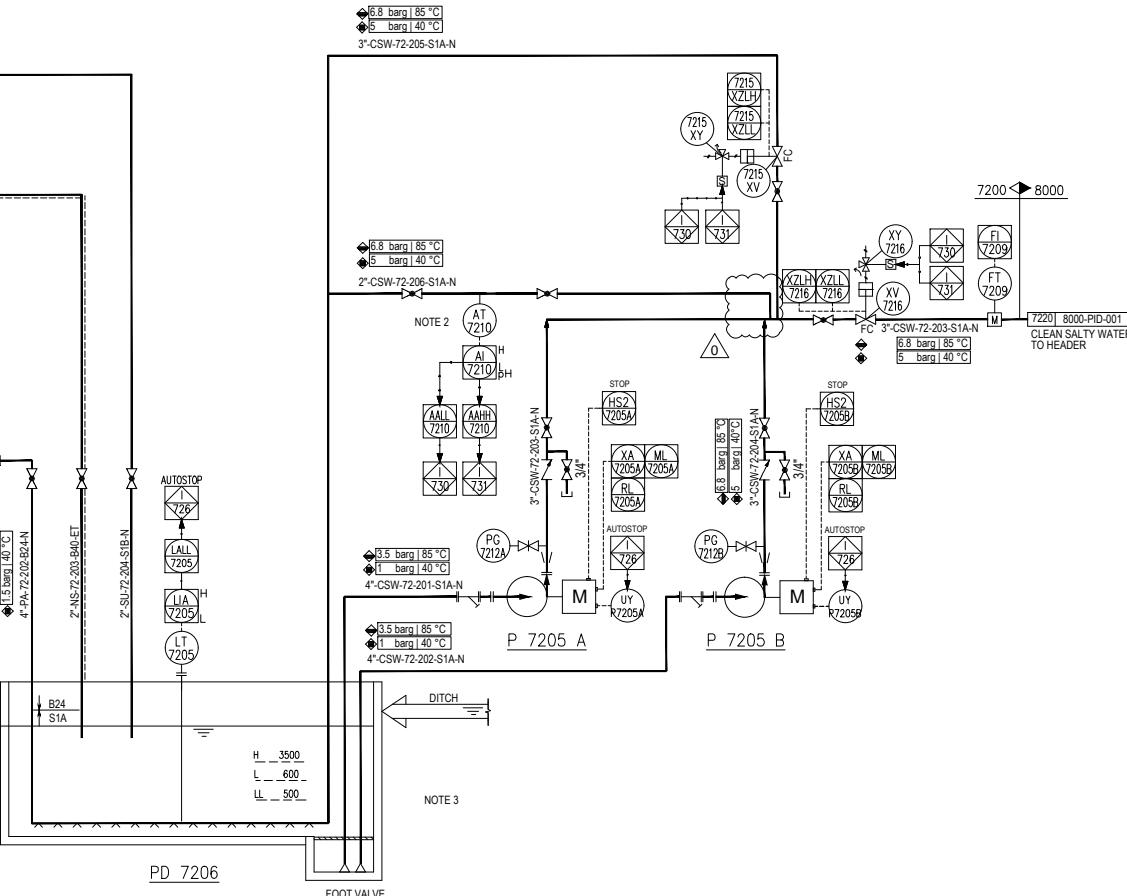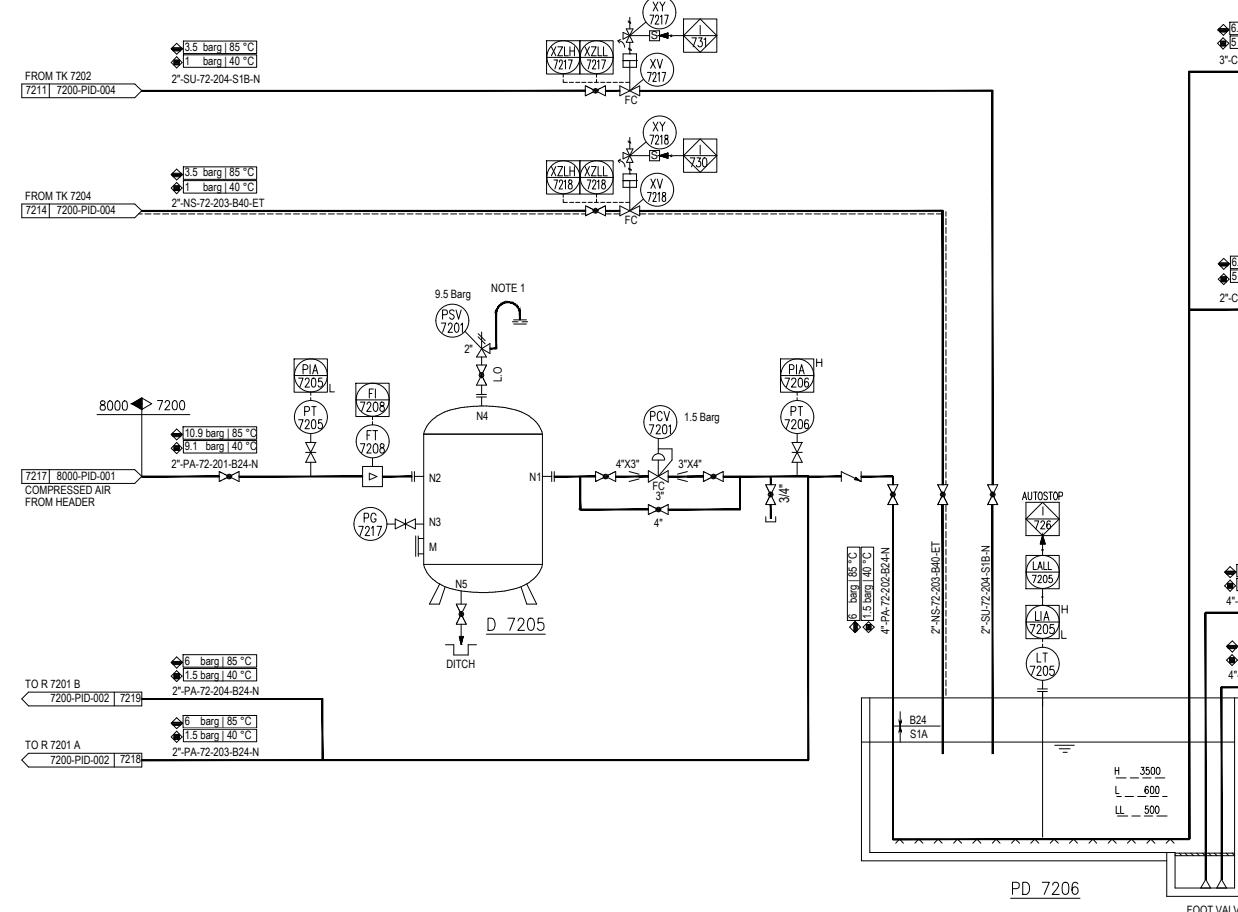

GENERAL NOTES

NOTE 1: VENT WILL CONNECT TO A SAFE LOCATION

NOTE 2: AT-7210 HAS AN INDICATOR ON THE SITE, TO BE VISIBLE FROM THE LOCATION OF ALKALI AND ACID VALVES ON THE LINE SU-204 AND NS-203. PD 7206 WILL BE NEUTRALIZED AUTOMATICALLY.

NOTE 3: INTERNAL SURFACE OF PD-7206 SHALL BE EQUIPPED WITH UNIT ACID BRICK.

NOTE 4: POLISHING UNIT IS GENERALLY REVISED BECAUSE DMW WATER FROM DAMAVAND NEEDS TO BE POLISHED. THE CAPACITY OF POLISHING UNIT WAS REVISED FROM 126 M3/H TO 250 M3/H. THE DRAWING IS ONLY FOR REFERENCE, VENDOR SHALL FINISH THE DETAILED DESIGN OF THIS DRAWING AND APPROVED BY TCC.

NOTE 5: POLISHING UNIT SHOULD BE PACKAGE SUPPLIED, INCLUDING ALL THE EQUIPMENT, PLC, INSTRUMENT, CONTROL VALVE SHOWN IN P&ID, MOTORS AND PUMPS. THE MAIN PROCESS P7002 AIR, MP 7002 AIR, TK 7201 AND TK7001 1/2 WITH LEVEL TRANSMITTER AND GAUGE SHALL BE IN TCC'S WORKING SCOPE.

REFERENCE DRAWINGS

SYMBOLS AND LEGENDS

KEY PLAN

▲	Approved For Construction	10.02.2017	Liang Zhipeng	Tian Tao	Xie Yuan	
▲	Issued For Approval	23.01.2017	Liang Zhipeng	Tian Tao	Xie Yuan	
▲	Issued For Approval	05.01.2017	Liang Zhipeng	Tian Tao	Xie Yuan	
▲	Issued For Approval	12.12.2016	Liang Zhipeng	Tian Tao	Xie Yuan	
▲	Issued For Approval	10.10.2016	Liang Zhipeng	Tian Tao	Xie Yuan	
▲	Issued For Approval	27.07.2016	Liang Zhipeng	Tian Tao	Xie Yuan	
▲	Issued For Review	05.07.2016	Liang Zhipeng	Tian Tao	Xie Yuan	
▲	Issued For Comments	06.06.2016	Liang Zhipeng	Tian Tao	Xie Yuan	
E.V.	PURPOSE OF ISSUE	DATE	DESIGN	DRAW	CHECK	REVIEW
						APPROVE

THIS DOCUMENT IS THE PROPERTY OF TCC. NO PART OF THIS DOCUMENT SHALL BE REPRODUCED OR DISCLOSED TO OTHERS OR USED FOR ANY PURPOSE WHATSOEVER EXCEPT WITH THE PRIOR WRITTEN PERMISSION OF TCC.

OWNER:

Middle East
Kimiaye Pars Company

HALDOR TOPSØE A/S COMPAGNIE DENMARK		DOCUMENT NAME:		JOB NO.	DOC. NO.	REV.
				DWG. NO.	PROGRAM	
 中國天辰工程有限公司 CHINA TIANCHEN ENGINEERING CORPORATION				CONTRACTOR DRAWING NO.		
				MKP-11-DE-7200-EF06-PID-005		
				SHEET	01	TOTAL 01
				SUB-CONTRACTOR DRAWING NO.		
				SHEET		TOTAL
NEUTRALIZATION P&ID FOR POLISHING UNIT		PROJECT		MKP Methanol Project		
		UNIT		POLISHING UNIT		
		PHASE		DETAIL ENGINEERING		
CALE -	SHEET 1	TOT. 1	SIZE A1	OWNER DWG NO.	MKP-11-DE-7200-PR-PID-005	