NOTES:
1-DELETED.

CB : CATCH BASIN
VB : VALVE BOX
MO : MANHOLE OPENING

A-0001
SUMP
WORKING CAPACITY = 400 M3
WIDTH = 5 M
DEPTH = 8 M
LENGTH = 16 M

P-0002 A/B
WASTE WATER DISCHARGE PUMP

Vnom	8	m3/h
dp	3.4	bar
pe max		bar

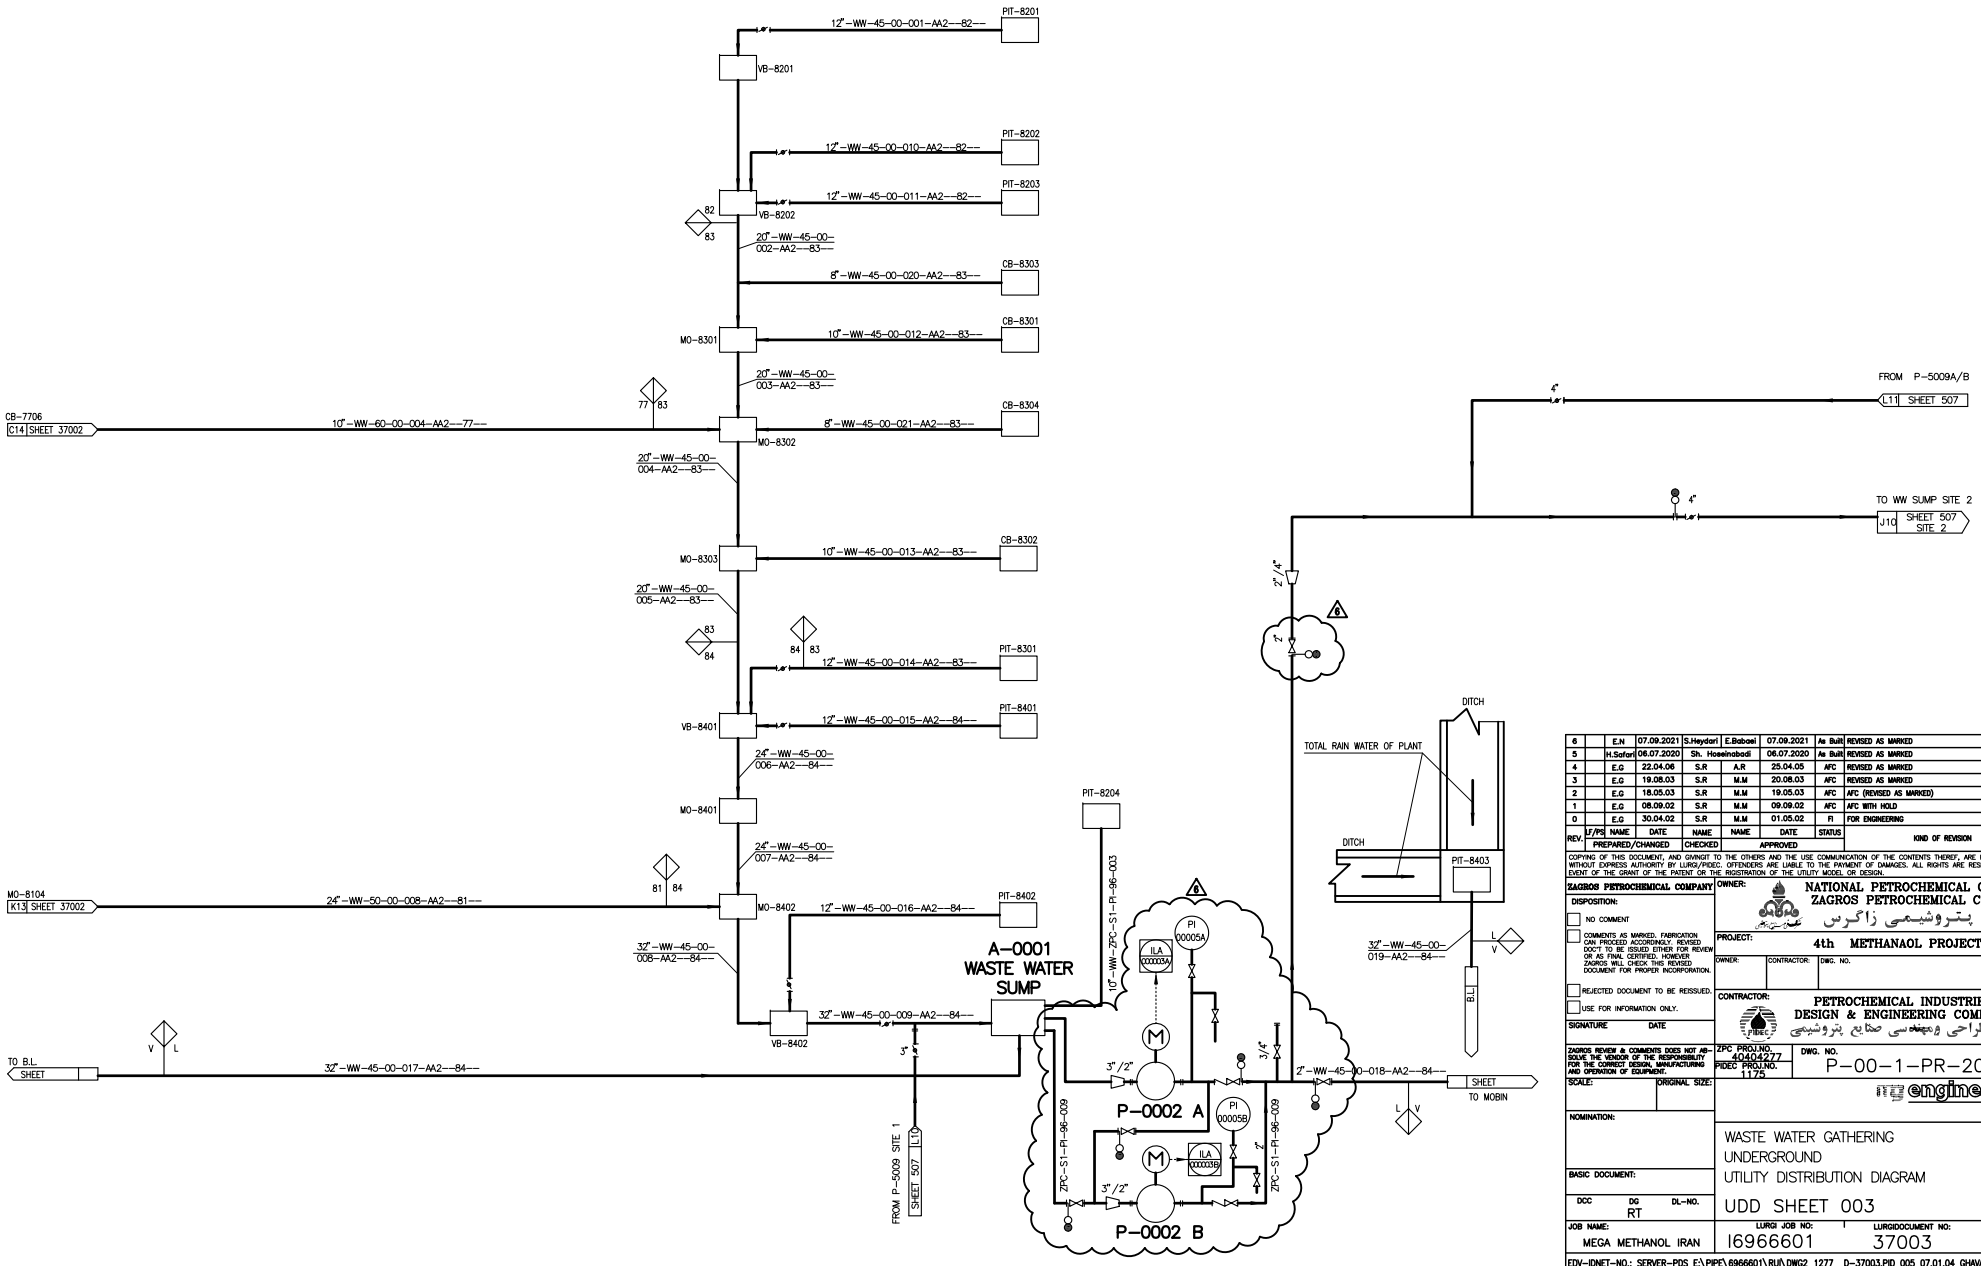

REV.	F/PS	NAME	DATE	NAME	NAME	DATE	STATUS	KIND OF REVISION
	PREPARED/CHANGED			CHECKED	APPROVED			
6		E.N	07.09.2021	S.Heydari	E.Babaei	07.09.2021	As Built	REVISED AS MARKED
5		H.Safari	06.07.2020	Sh. Hoseinabadi		06.07.2020	As Built	REVISED AS MARKED
4		E.G	22.04.06	S.R	A.R	25.04.05	AFC	REVISED AS MARKED
3		E.G	19.08.03	S.R	M.M	20.08.03	AFC	REVISED AS MARKED
2		E.G	18.05.03	S.R	M.M	19.05.03	AFC	AFC (REVISED AS MARKED)
1		E.G	08.09.02	S.R	M.M	09.09.02	AFC	AFC WITH HOLD
0		E.G	30.04.02	S.R	M.M	01.05.02	FI	FOR ENGINEERING

COPYING OF THIS DOCUMENT, AND GIVINGIT TO THE OTHERS AND THE USE COMMUNICATION OF THE CONTENTS THEREF, ARE FORBIDDEN WITHOUT EXPRESS AUTHORITY BY LURGI/PIDEC; OFFENDERS ARE LIABLE TO THE PAYMENT OF DAMAGES. ALL RIGHTS ARE RESERVED IN THE EVENT OF THE GRANT OF THE PATENT OR THE REGISTRATION OF THE UTILITY MODEL OR DESIGN.

ZAGROS PETROCHEMICAL COMPANY

DISPOSITION:
- [ ] NO COMMENT
- [ ] COMMENTS AS MARKED. FABRICATION CAN PROCEED ACCORDINGLY. REVISED DOC'T TO BE ISSUED EITHER FOR REVIEW OR AS FINAL CERTIFIED. HOWEVER ZAGROS WILL CHECK THIS REVISED DOCUMENT FOR PROPER INCORPORATION.
- [ ] REJECTED DOCUMENT TO BE REISSUED.
- [ ] USE FOR INFORMATION ONLY.

SIGNATURE DATE

ZAGROS REVIEW & COMMENTS DOES NOT ABSOLVE THE VENDOR OF THE RESPONSIBILITY FOR THE CORRECT DESIGN, MANUFACTURING AND OPERATION OF EQUIPMENT.

SCALE: ORIGINAL SIZE:

NOMINATION:

BASIC DOCUMENT:

DCC DG DL-NO.
RT

JOB NAME: MEGA METHANOL IRAN

OWNER: NATIONAL PETROCHEMICAL COMPANY
ZAGROS PETROCHEMICAL COMPLEX
شرکت پتروشیمی زاگرس

PROJECT: 4th METHANAOL PROJECT

OWNER: CONTRACTOR: DWG. NO. REV. 6

CONTRACTOR: PETROCHEMICAL INDUSTRIES DESIGN & ENGINEERING COMPANY
شرکت طراحی و مهندسی صنایع پتروشیمی

ZPC PROJ.NO. 40404277
PIDEC PROJ.NO. 1175
DWG. NO. P-00-1-PR-206 REV. 6

engineering Lurgi

WASTE WATER GATHERING
UNDERGROUND
UTILITY DISTRIBUTION DIAGRAM

UDD SHEET 003

LURGI JOB NO: 16966601
LURGIDOCUMENT NO: 37003
REV. 6

EDV-IDNET-NO.: SERVER-PDS E:\PIPE\6966601\RUA\DWG2_1277 D-37003.PID 005 07.01.04 GHAVANINI PDSWKS3