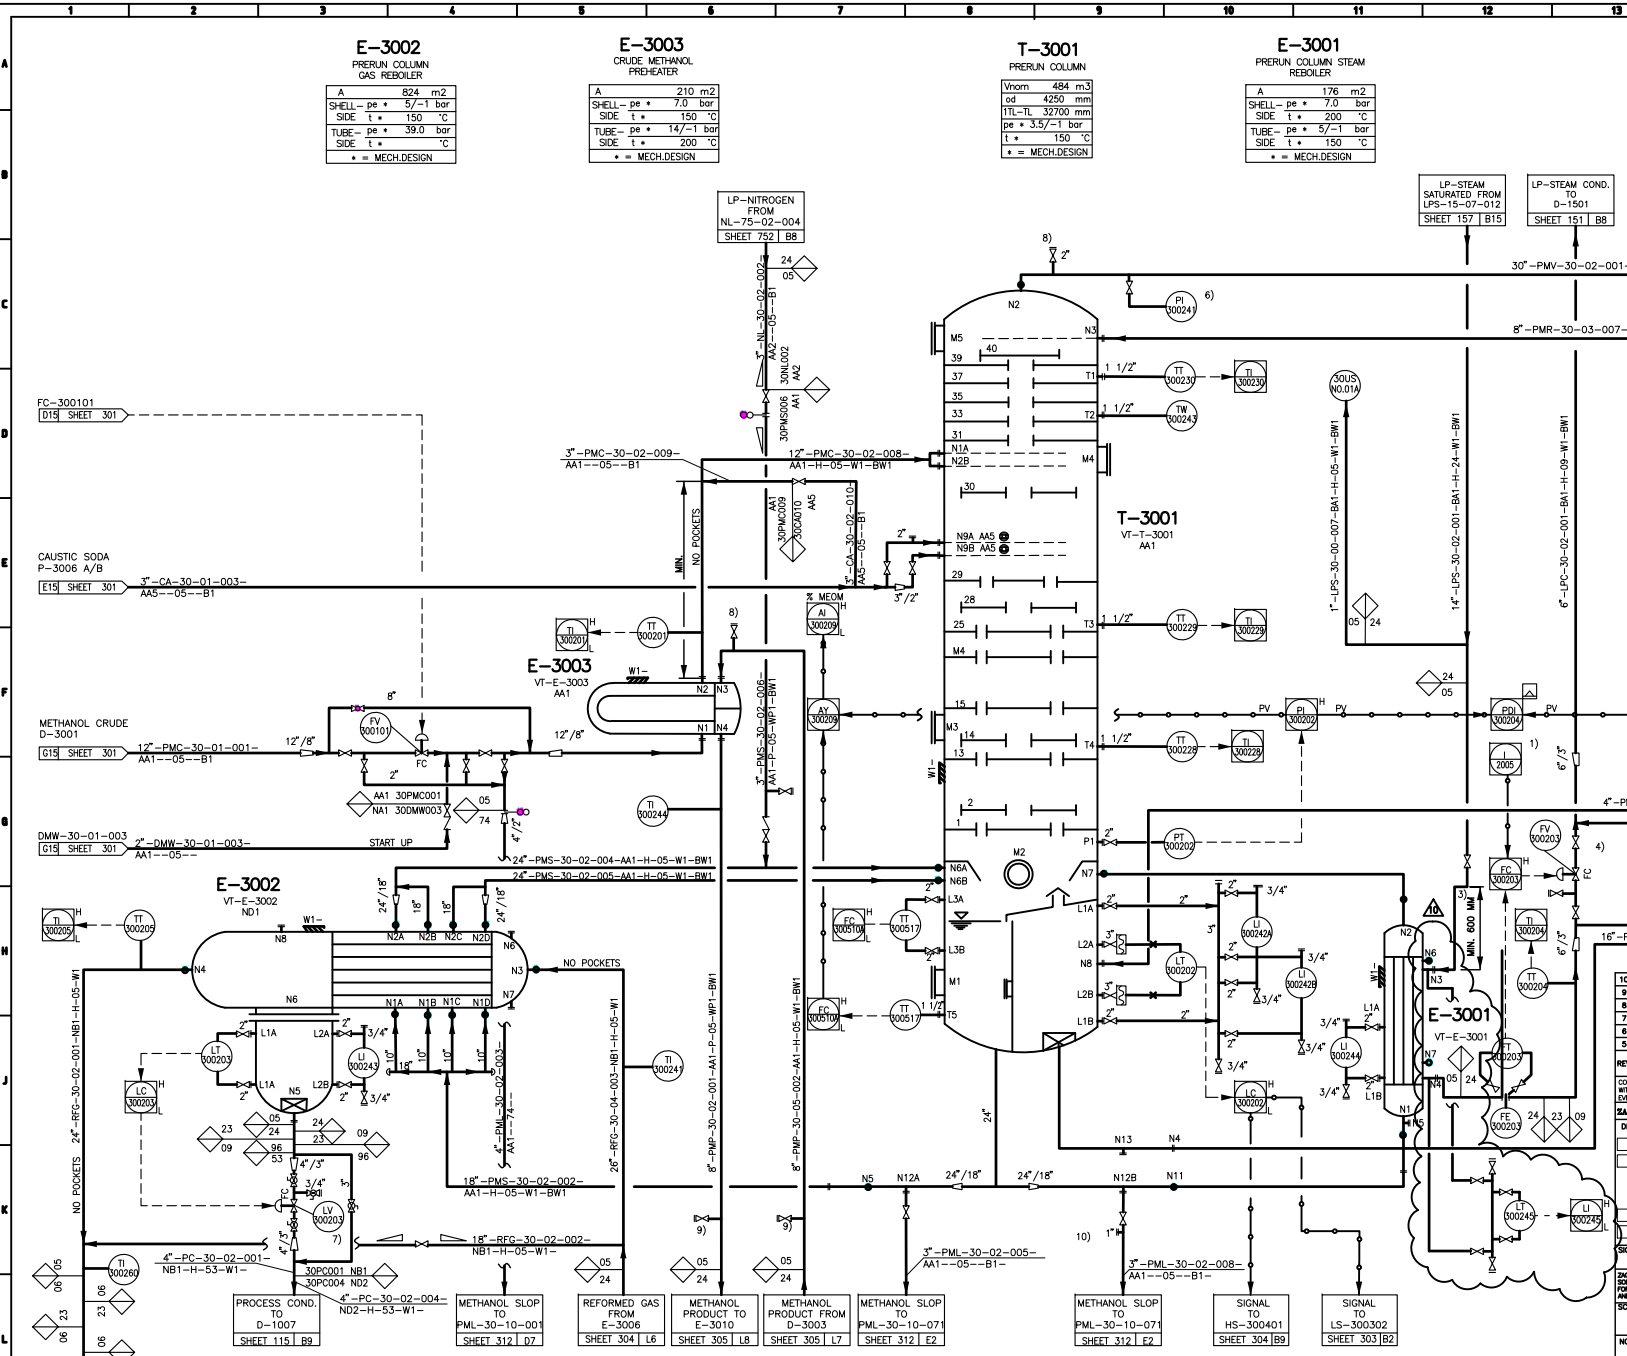

REMARKS:

ALL PRESSURES ARE IN GAUGE
IF NOT STATED OTHERWISE

1) CLOSE TO MANUAL
2) DELETED
3) LP-STEAM LINE TO BE CONNECTED TO E-3001 FROM ABOVE (600 MM)
4) LOCATION OF CONTROL VALVE CLOSE TO D-1501
5) DELETED
6) LOCATE CLOSE TO AE-3001
7) LEVEL CONTROL VALVE TO BE MIN. TO D-1007
8) VENT VALVE TO BE ACCESSIBLE FOR OPERATION
9) DARIN VALVE TO BE ACCESSIBLE FROM GROUND
10) FOR NITROGEN PURGE

REV.	JF/PS	NAME	DATE	NAME	DATE	STATUS	KIND OF REVISION
10		E.N	11.10.21	B.N	SH.SH 11.10.21	ASBUILT	REVISED AS MARKED
9		R.P	11.09.14	S.SH	M.N 11.09.14	ASBUILT	REVISED AS MARKED
8		E.G	22.04.06	S.R	A.R 25.04.06	AFC	REVISED AS MARKED
7		E.G	26.11.03	S.R	M.M 27.11.03	AFC	REVISED AS MARKED
6		E.G	15.08.03	S.R	M.M 16.08.03	AFC	REVISED AS MARKED
5		E.G	01.05.03	S.R	M.M 02.05.03	AFC	REVISED AS MARKED (FROZEN)
		PREPARED/CHANGED		CHECKED	APPROVED		

COPYING OF THIS DOCUMENT, AND GIVING IT TO THE OTHERS AND THE USE COMMUNICATION OF THE CONTENTS THEREF, ARE FORBIDDEN WITHOUT EXPRESS AUTHORTY BY LURGI/PIDEC. OFFENDERS ARE LIABLE TO THE PAYMENT OF DAMAGES. ALL RIGHTS ARE RESERVED IN THE EVENT OF THE GRANT OF THE PATENT OR THE REGISTRATION OF THE UTILITY MODEL OR DESIGN.

ZAGROS PETROCHEMICAL COMPANY

DISPOSITION:
- NO COMMENT
- COMMENTS AS MARKED. FABRICATION CAN PROCEED ACCORDINGLY. REVISED DOC'T TO BE ISSUED EITHER FOR REVIEW OR AS FINAL CERTIFIED. HOWEVER ZAGROS WILL CHECK THIS REVISED DOCUMENT FOR PROPER INCORPORATION.
- REJECTED DOCUMENT TO BE REISSUED.
- USE FOR INFORMATION ONLY.

SIGNATURE DATE

ZAGROS REVIEW & COMMENTS DOES NOT ABSOLVE THE VENDOR OF THE RESPONSIBILITY FOR THE CORRECT DESIGN, MANUFACTURING AND OPERATION OF EQUIPMENT.

SCALE: ORIGINAL SIZE:

NOMINATION: E-3001 E-3002 E-3003 T-3001

BASIC DOCUMENT:

DCC DG DL-NO.
RT

JOB NAME: MEGA METHANOL IRAN

OWNER: NATIONAL PETROCHEMICAL COMPANY
ZAGROS PETROCHEMICAL COMPLEX
شرکت پتروشیمی زاگرس

PROJECT: 4th METHANOL PROJECT

OWNER: CONTRACTOR: DWG. NO. DIG-PI-31 REV. 10

CONTRACTOR: PETROCHEMICAL INDUSTRIES DESIGN & ENGINEERING COMPANY
شرکت طراحی و مهندسی صنایع پتروشیمی

ZPC PROJ.NO. 40404277
PIDEC PROJ.NO. 1175
DWG. NO. P-30-1-PR-002 REV. 10

engineering Lurgi

METHANOL DISTILLATION
PRERUN COLUMN
UNIT 300

P&ID DIAGRAM SHEET 302

LURGI JOB NO: I69666-01
LURGIDOCUMENT NO: 37302
REV. 10

EDV-IDNET-NO.:IGS7 E:\PIPE\696660\RU\ D-37302.PID 026 01.03.04 GHAVANINI PDSWKS0