P-3007
SLOP PUMP

Vnom	20	m3/h
dp	3.3	bar
pe max	6.2	bar

D-3006
SLOP VESSEL

Vnom	11.5	m3
od	1900	mm
ITL-TL	3500	mm
pe *	3.5	bar
t *	130	°C
* = MECH.DESIGN		

REMARKS :

ALL PRESSURES ARE IN GAUGE
IF NOT STATED OTHERWISE

1) A PORTABLE PUMP TO BE USED FOR DRAINING, IF REQUIRED. D-3006 TO BE PROTECTED AGAINST BUOYANCY
2) FLAME ARRESTOR
3) DELETED.
4) REFER TO UDD NO. P-00-1-PR-205 FOR PML DISTRIBUTION.
5) VENT VALVE TO BE ACCESSIBLE FOR OPERATION.
6) DRAIN VALVE
7) FOR UNLOADING DRAINED METHANOL

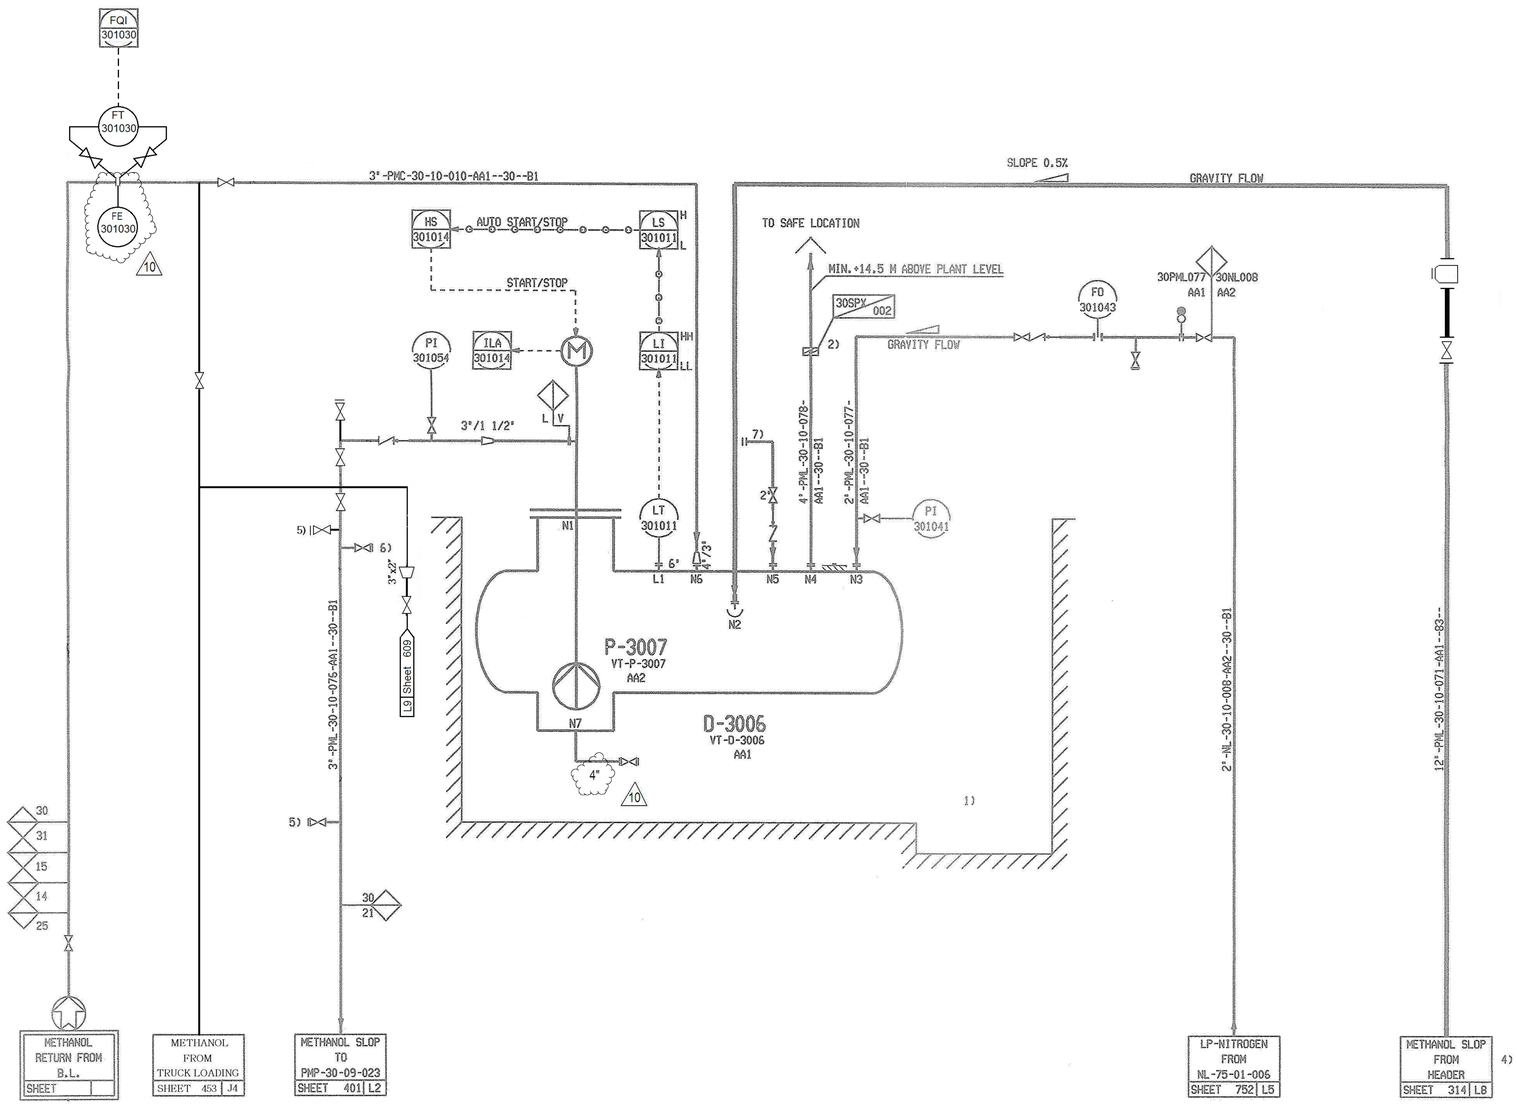

ZPC Doc. Center
As built

Rev.	LF/PS	Name	Date	Name	Name	Date	Status	Kind of Revision
10		R.P	26.08.14	S.Sh/A.F	M.N	26.08.14	Asbuilt	REVISED AS MARKED
9		R.P	25.05.13	E.B/A.R	M.N	25.05.13	Asbuilt	REVISED AS MARKED
8		E.G	22.04.06	S.R	A.R	25.04.06	AFC	REVISED AS MARKED
7		E.G	26.11.03	S.R	M.M	27.11.03	AFC	REVISED AS MARKED (NO ISSUE)
6		E.G	15.08.03	S.R	M.M	15.08.03	AFC	REVISED AS MARKED
		Prepared/Changed		Checked	Approved			

Copying of this document, and giving it to others and the use or communication of the contents thereof, are forbidden without express authority by LURGI/PIDEC. Offenders are liable to the payment of damages. All rights are reserved in the event of the grant of a patent or the registration of a utility model or design.

ZAGROS PETROCHEMICAL COMPANY

DISPOSITION
- [ ] NO COMMENT
- [ ] COMMENTS AS MARKED. FABRICATION CAN PROCEED ACCORDINGLY. REVISED DOC'T TO BE ISSUED EITHER FOR REVIEW OR AS FINAL CERTIFIED. HOWEVER ZAGROS WILL CHECK THIS REVISED DOCUMENT FOR PROPER INCORPORATION.
- [ ] REJECTED DOCUMENT TO BE REISSUED.
- [ ] USE FOR INFORMATION ONLY.

SIGNATURE DATE

ZAGROS REVIEW & COMMENTS DOES NOT ABSOLVE THE VENDOR OF THE RESPONSIBILITY FOR THE CORRECT DESIGN, MANUFACTURING AND OPERATION OF EQUIPMENT.

OWNER : NATIONAL PETROCHEMICAL COMPANY
ZAGROS PETROCHEMICAL COMPLEX
شرکت پتروشیمی زاگرس

PROJECT : 4th METHANOL PROJECT

OWNER	CONTRACTOR	DWG. NO.	Rev.
		DIG-PI-39	10

CONTRACTOR : PETROCHEMICAL INDUSTRIES DESIGN & ENGINEERING COMPANY
شرکت طراحی ومهندسی صنایع پتروشیمی

ZPC PROJ. NO. 40404277
PIDEC PROJ. NO. 1175
DWG. NO. P-30-1-PR-010 Rev. 10

Scale: Original Size:

Nomination: D-3006
P-3007

Basic document:

DCC DG DL-No.
RT

engineering Lurgi

METHANOL DISTILLATION
SLOP SYSTEM
UNIT 300
P&I DIAGRAM SHEET 310

Job name: MEGA METHANOL IRAN

Lurgi Job No. I6966601 Lurgi Document No. 37310 Rev. 10

Filename: \plpe\696660l\rul\dwg2_684 d_37310.pld 021 17.04.06 GHAVANINI POSMKS3