NOTES:

1-FOR NON INDUSTRIAL AREA CONSUMPTION

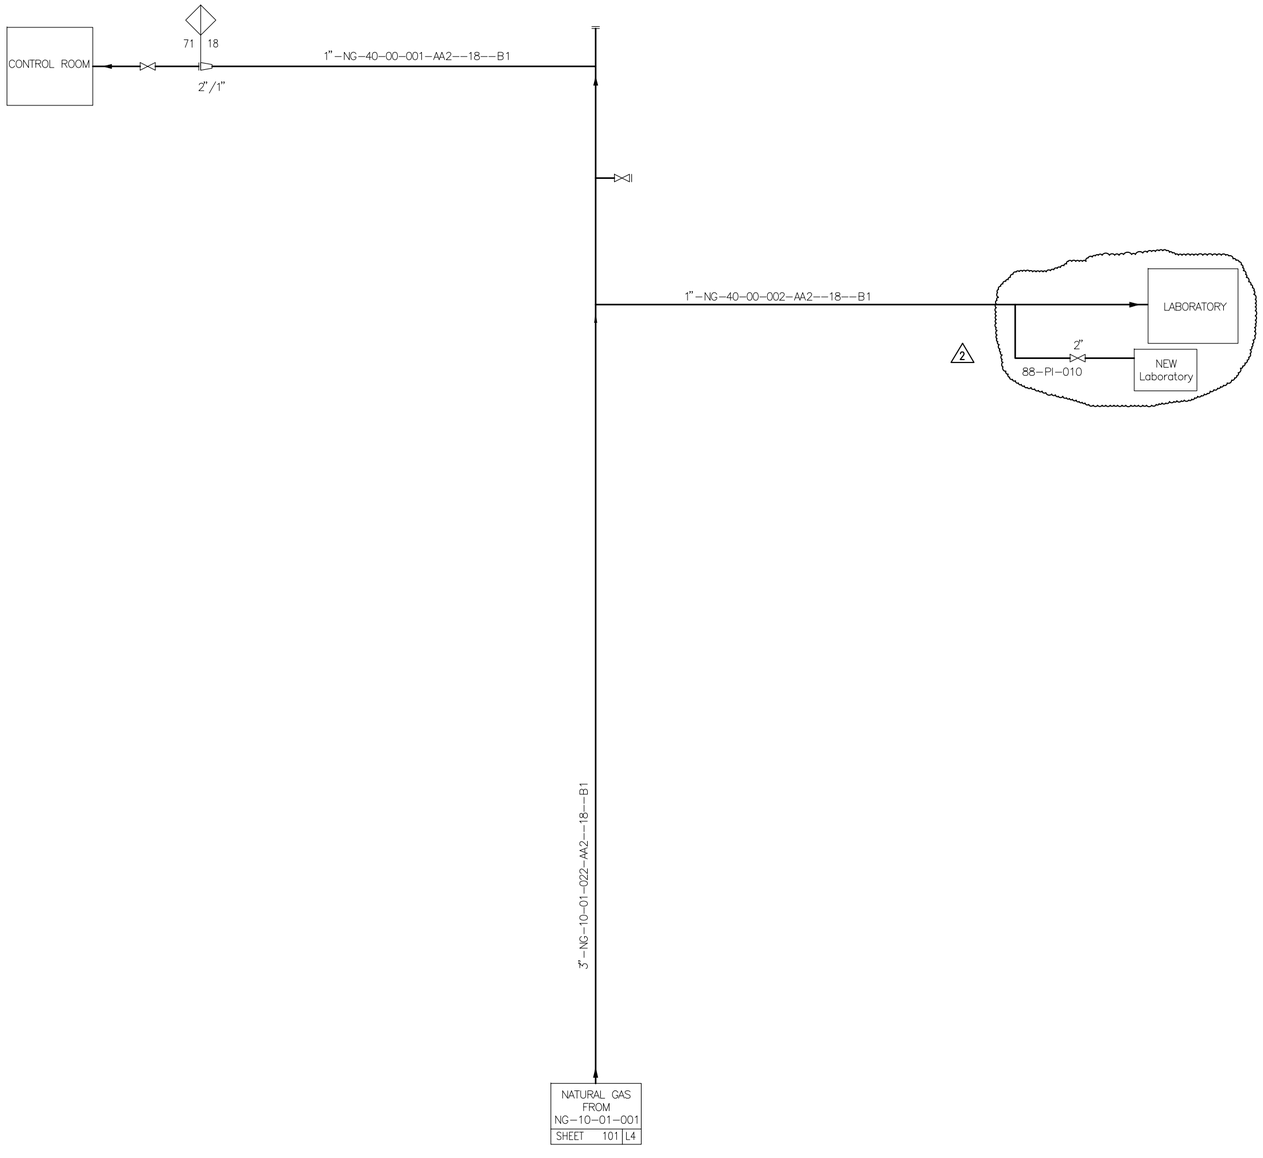

REV.	LF/PS	NAME	DATE	NAME	NAME	DATE	STATUS	KIND OF REVISION
2		R.P	28.08.14	S.SH	M.M	28.08.14	ASBUILT	REVISED AS MARKED
1		E.G	09.02.04	S.R	M.M	10.02.04	AFC	GENERAL REVISION
0		E.G	21.09.03	S.R	M.M	22.09.03	FI	FOR ENGINEERING
	PREPARED/CHANGED			CHECKED	APPROVED			

COPYING OF THIS DOCUMENT, AND GIVINGIT TO THE OTHERS AND THE USE COMMUNICATION OF THE CONTENTS THEREF, ARE FORBIDDEN WITHOUT EXPRESS AUTHORITY BY LURGI/PIDEC. OFFENDERS ARE LIABLE TO THE PAYMENT OF DAMAGES. ALL RIGHTS ARE RESERVED IN THE EVENT OF THE GRANT OF THE PATENT OR THE RIGISTRATION OF THE UTILITY MODEL OR DESIGN.

ZAGROS PETROCHEMICAL COMPANY

DISPOSITION:

- [ ] NO COMMENT
- [ ] COMMENTS AS MARKED. FABRICATION CAN PROCEED ACCORDINGLY. REVISED DOC'T TO BE ISSUED EITHER FOR REVIEW OR AS FINAL CERTIFIED. HOWEVER ZAGROS WILL CHECK THIS REVISED DOCUMENT FOR PROPER INCORPORATION.
- [ ] REJECTED DOCUMENT TO BE REISSUED.
- [ ] USE FOR INFORMATION ONLY.

SIGNATURE DATE

ZAGROS REVIEW & COMMENTS DOES NOT AB-SOLVE THE VENDOR OF THE RESPONSIBILITY FOR THE CORRECT DESIGN, MANUFACTURING AND OPERATION OF EQUIPMENT.

SCALE: ORIGINAL SIZE:

NOMINATION:

BASIC DOCUMENT:

DCC DG DL-NO.
RT

JOB NAME: MEGA METHANOL IRAN

OWNER: NATIONAL PETROCHEMICAL COMPANY
ZAGROS PETROCHEMICAL COMPLEX
شرکت پتروشیمی زاگرس

PROJECT: 4th METHANAOL PROJECT

OWNER:	CONTRACTOR:	DWG. NO.	REV.
			2

CONTRACTOR: PETROCHEMICAL INDUSTRIES DESIGN & ENGINEERING COMPANY
شرکت طراحی ومهندسی صنایع پتروشیمی

ZPC PROJ.NO. 40404277
PIDEC PROJ.NO. 1175

DWG. NO. P-00-1-PR-208 REV. 2

lg engineering Lurgi

FUEL NATURAL GAS
ABOVEGROUND
UTILITY DISTRIBUTION DIAGRAM

UDD SHEET 851

LURGI JOB NO: I6966601
LURGIDOCUMENT NO: 37851
REV. 2

EDV-IDNET-NO.: IGS7 E:\PIPE\6966601\RUI D-37851.PID 003 26.03.04 GHAVANINI PDSWKS3