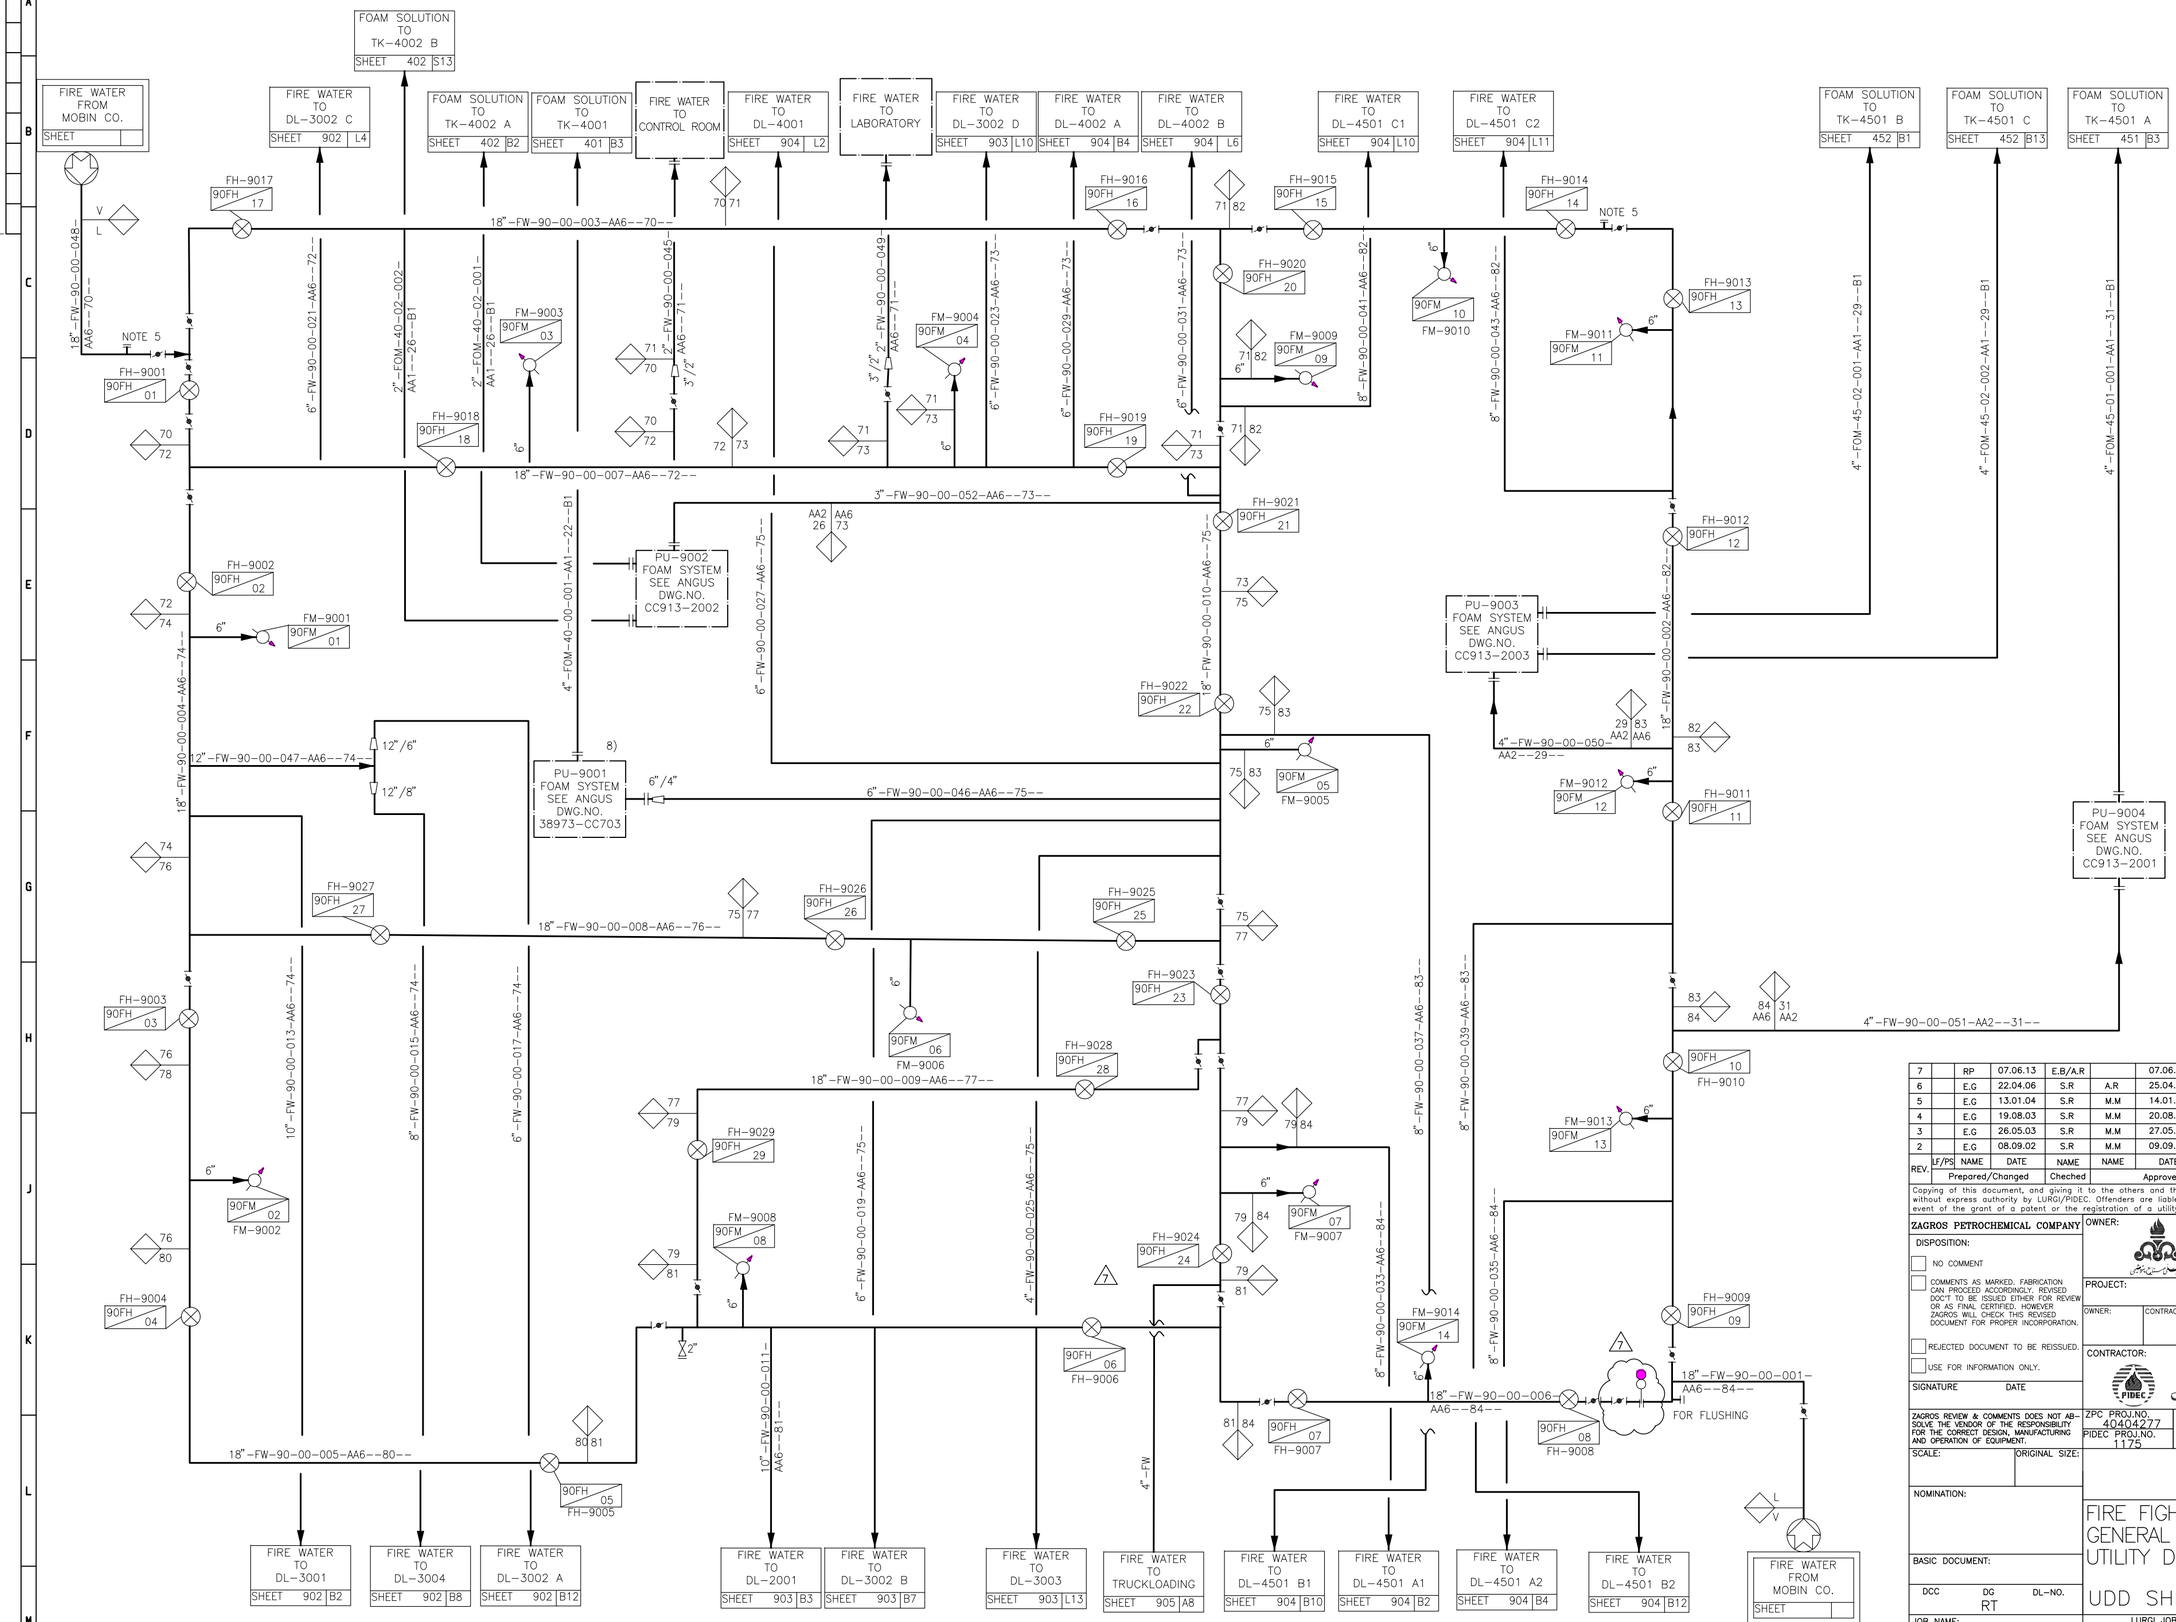

NOTES:

1- THIS UDD IS PREPARED IN ACCORDANCE WITH BASIC DESIGN PACKAGE AND ACTUAL UNDERGROUND PIPING LAYOUT
2- DELETED
3- DELETED
4- DELETED
5- CONNECTION FOR NON-INDUSTRIAL AREA
6- A HOSE HOUSE SHALL BE INSTALLED NEXT TO EACH FIRE HYDRANT
7- DELETED
8- FOAM SYSTEM PACKAGE INCLUDES THREE FOAM POURERS, FOO-4001 A/B/C ,WITH IN/OUTLET SIZE OF 3"/6" (ANGUS TPS-80)

REV.	LF/PS	NAME	DATE	NAME	NAME	DATE	STATUS	Kind of Revision
7		RP	07.06.13	E.B/A.R		07.06.13	ASBUILT	REVISED AS MARKED
6		E.G	22.04.06	S.R	A.R	25.04.06	AFC	REVISED AS MARKED
5		E.G	13.01.04	S.R	M.M	14.01.04	AFC	REVISED AS MARKED (NO ISSUE)
4		E.G	19.08.03	S.R	M.M	20.08.03	AFC	REVISED AS MARKED
3		E.G	26.05.03	S.R	M.M	27.05.03	AFC	AFC (FROZEN)
2		E.G	08.09.02	S.R	M.M	09.09.02	AFC	AFC WITH HOLD
		Prepared/Changed		Checked		Approved		

Copying of this document, and giving it to the others and the use or communication of the contents there of, are forbidden without express authority by LURGI/PIDEC. Offenders are liable to the payment of damages. All rights are reserved in the event of the grant of a patent or the registration of a utility model or design.

ZAGROS PETROCHEMICAL COMPANY

DISPOSITION:

- [ ] NO COMMENT
- [ ] COMMENTS AS MARKED. FABRICATION CAN PROCEED ACCORDINGLY. REVISED DOC'T TO BE ISSUED EITHER FOR REVIEW OR AS FINAL CERTIFIED. HOWEVER ZAGROS WILL CHECK THIS REVISED DOCUMENT FOR PROPER INCORPORATION.
- [ ] REJECTED DOCUMENT TO BE REISSUED.
- [ ] USE FOR INFORMATION ONLY.

SIGNATURE DATE

ZAGROS REVIEW & COMMENTS DOES NOT AB-SOLVE THE VENDOR OF THE RESPONSIBILITY FOR THE CORRECT DESIGN, MANUFACTURING AND OPERATION OF EQUIPMENT.

SCALE: ORIGINAL SIZE:

NOMINATION:

BASIC DOCUMENT:

DCC DG DL-NO.
RT

JOB NAME: MEGA METHANOL IRAN

OWNER: NATIONAL PETROCHEMICAL COMPANY
ZAGROS PETROCHEMICAL COMPLEX
شرکت پتروشیمی زاگرس

PROJECT: 4th METHANOL PROJECT

OWNER: CONTRACTOR: DWG. NO. REV. 7

CONTRACTOR: PETROCHEMICAL INDUSTRIES DESIGN & ENGINEERING COMPANY
شرکت طراحی ومهندسی صنایع پتروشیمی

ZPC PROJ.NO. 40404277
PIDEC PROJ.NO. 1175
DWG. NO. P-00-1-PR-001 REV. 7

engineering Lurgi

FIRE FIGHTING SYSTEM GENERAL LAYOUT UTILITY DISTRIBUTION DIAGRAM

UDD SHEET 901

LURGI JOB NO: I6966601
LURGIDOCUMENT NO: 37901
REV. 7

EDV-Ident-No.: igs7e:\pipe\6966601\rui\dwg.2_1303 d-37901.pid006 20.01.04 GHAVANINI PDSWKS3